



14 MILE SLOUGH PUMP STATION UPGRADES

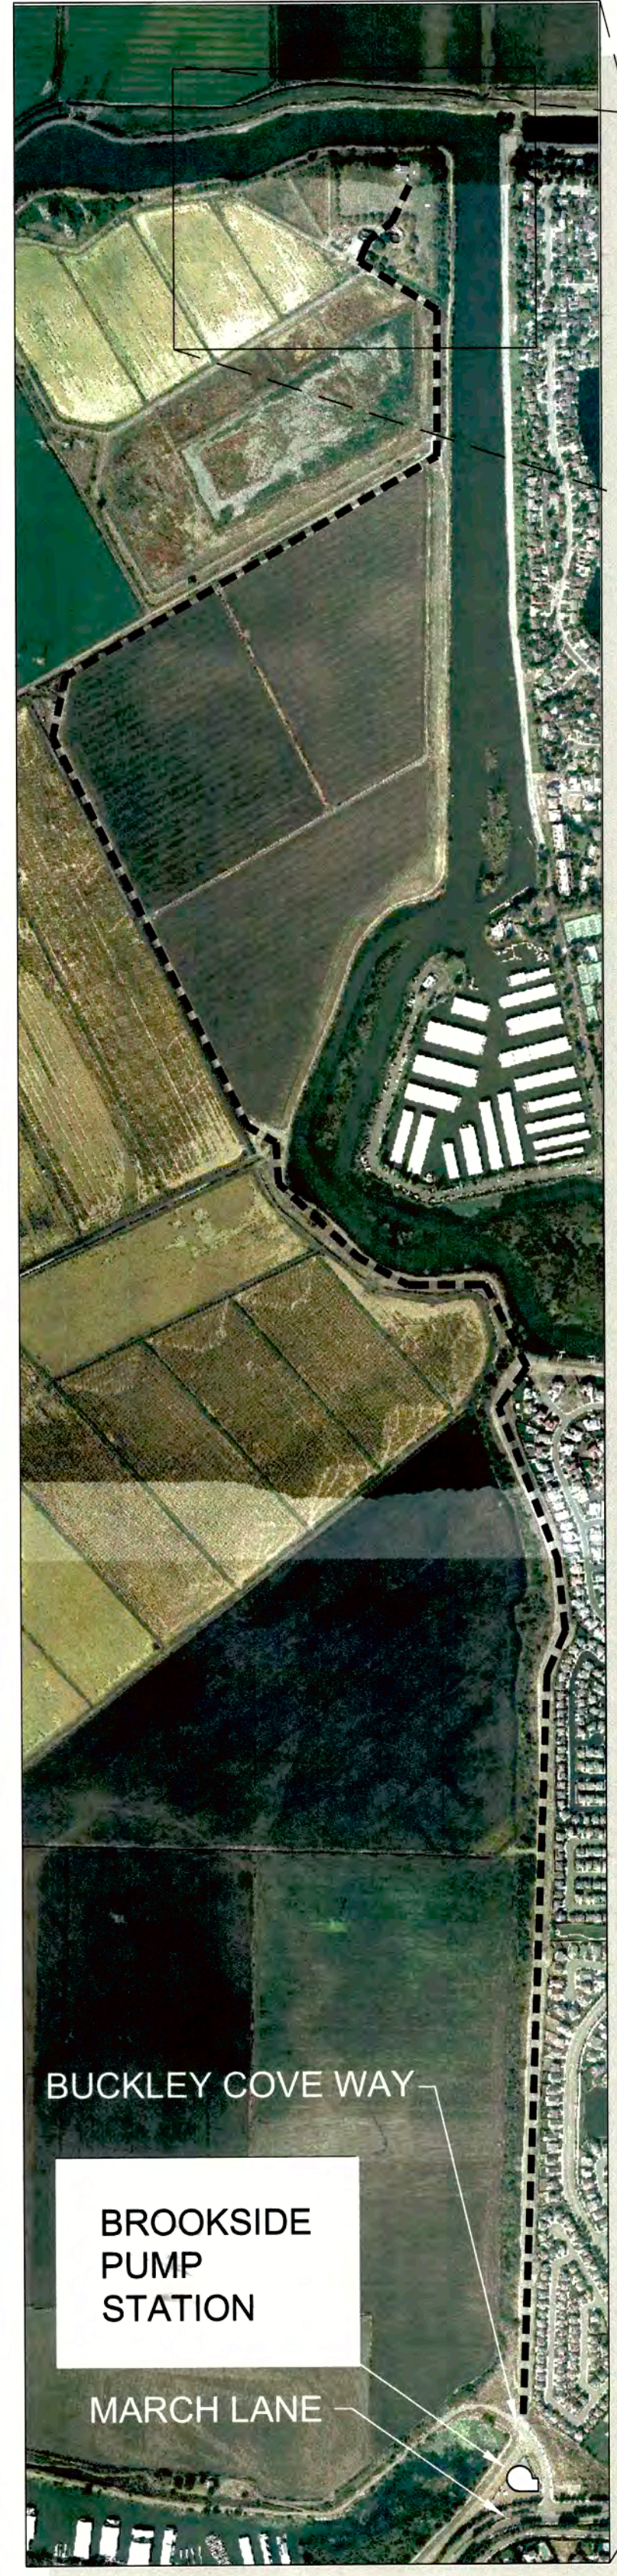

PROJECT LOCATION

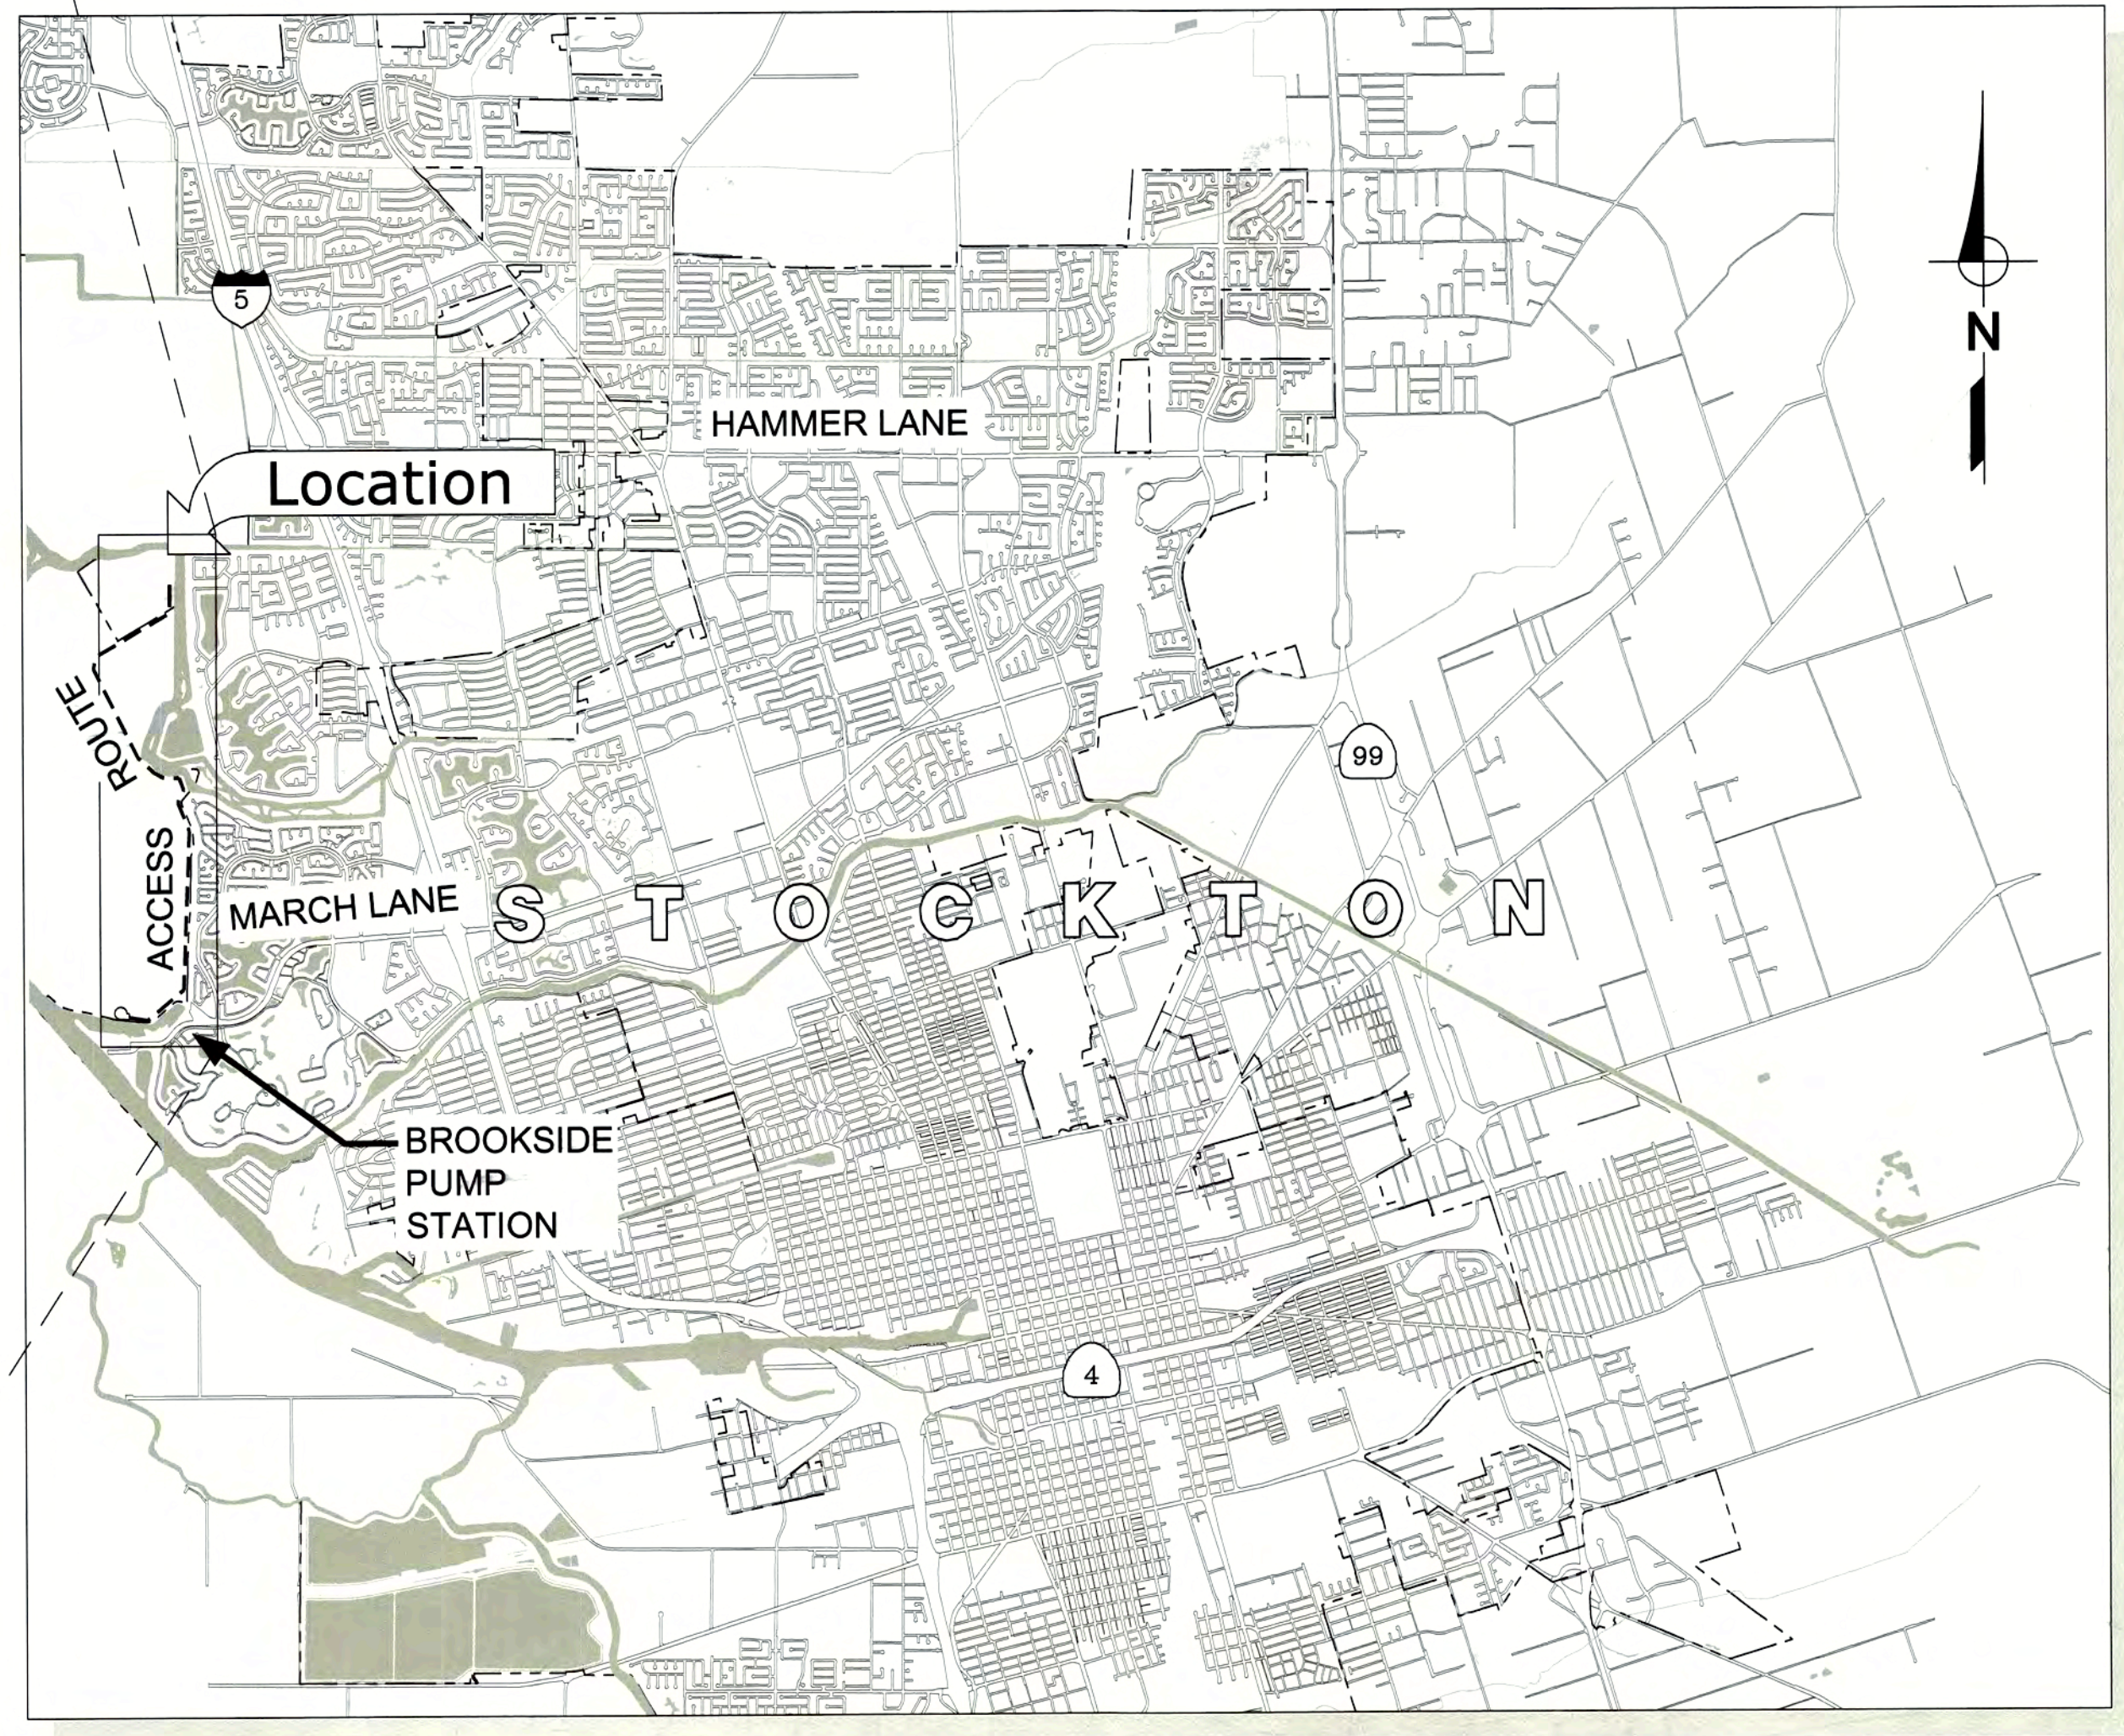

VICINITY MAP

SHEET INDEX

1	G1	TITLE SHEET, VICINITY MAP, SHEET INDEX	55	H1	HVAC SYMBOLS, ABBREVIATIONS, & EQUIPMENT SCHEDULES
2	G2	LEGEND & ABBREVIATIONS	56	H2	HVAC FLOOR PLAN
3	G3	HYDRAULIC PROFILE, GENERAL NOTES	57	H3	HVAC TITLE 24
4	G4	SITE PLAN DRAWING REFERENCE SHEET			
5	G5	SITE PLAN OVERVIEW			
6	C1	PAVING & GRADING PLAN 1	58	E1	ELECTRICAL SYMBOLS & ABBREVIATIONS
7	C2	PAVING & GRADING PLAN 2	59	E2	METER/MAIN SWITCHBOARD SWBD-2 ONE LINE DIAGRAM
8	C3	PAVING & GRADING PLAN 3	60	E3	METER/MAIN SWITCHBOARD SWBD-2 ELEVATION
9	C4	BORROW AREA PLAN & SECTION 1	61	E4	CONTROL PANEL ELEVATION
10	C5	BORROW AREA PLAN & SECTION 2	62	E5	EXISTING MCC-M ONE LINE DIAGRAM
11	C6	BORROW AREA PLAN & SECTION 3	63	E6	EXISTING MCC-M ELEVATION
12	C7	YARD PIPING PLAN 1	64	E7	TYPICAL 18 PULSE VFD PANEL ELEVATION
13	C8	YARD PIPING PLAN 2	65	E8	VFD DRIVE MCC START/STOP ELEMENTARY DIAGRAM
14	C101	CIVIL SECTIONS 1	66	E9	FULL SPEED ELEMENTARY DIAGRAM
15	C102	CIVIL SECTIONS 2	67	E10	CONTROL PANEL 100 ELEVATION & BACKPAN LAYOUT
16	C103	ACCESS ROAD PROFILE	68	E11	CP-100 ELEMENTARY DIAGRAM
17	C104	CIVIL PLAN & PROFILES 1	69	E12	EXAMPLE INTERCONNECTION DIAGRAM
18	C105	CIVIL PLAN & PROFILES 2	70	E13A	CONTROL BUILDING ELECTRICAL REFLECTIVE PLAN
19	C201	CIVIL DETAILS 1	71	E13B	CONTROL BUILDING ELECTRICAL BASE PLAN
20	C202	CIVIL DETAILS 2	72	E13C	CONTROL BUILDING ELECTRICAL POWER PLAN
21	C203	CIVIL DETAILS 3	73	E14	OVERALL ELECTRICAL SITE PLAN
22	C203A	MANHOLE NO. 2 5 MSFM THRUST RESTRAINT	74	E15	PUMP STATION ELECTRICAL SITE PLAN
23	C204	CIVIL DETAILS 4	75	E16	EXISTING CONTROL BUILDING ELECTRICAL SITE PLAN
24	C205.1	CIVIL DETAILS 5	76	E17	DISCHARGE GATE ELECTRICAL SITE PLAN
25	C206	CIVIL DETAILS 6	77	E18	CONDUIT SCHEDULE
26	C207	CIVIL DETAILS 7	78	E19	TITLE 24 LIGHTING CALCULATIONS
		ADDENDUM SKETCHES: A3-1 & A3-2	79	E21	TYPICAL ELECTRICAL DETAILS No.1
27	CC1	CATHODIC PROTECTION PLAN & NOTES	80	E22	TYPICAL ELECTRICAL DETAILS No.2
28	CC2	CATHODIC PROTECTION DETAILS-1	81	E23	TYPICAL ELECTRICAL DETAILS No.3
29	CC3	CATHODIC PROTECTION DETAILS-2			
30	CC4	CATHODIC PROTECTION DETAILS-3	82	I1	INSTRUMENTATION SYMBOLS & ABBREVIATIONS
31	S1	GENERAL NOTES, SPECIFICATIONS, & TYPICAL DETAILS	83	I2	HEADWORKS P&ID
32	S2.1	BUILDING ELEVATIONS	84	I3	PUMP STATION 1 P&ID
33	S3.1	FLOOR PLAN	85	I4	PUMP STATION 2 P&ID
34	S4.1	ROOF PLAN, SECTIONS & DETAILS	86	I5	MAGNESIUM HYDROXIDE SYSTEM P&ID
35	S5.1	FOUNDATION PLAN, SECTIONS, & DETAILS	87	I6	CP-100 AUXILIARY SYSTEMS P&ID
36	S6.1	ROOF FRAMING PLAN, SECTIONS & DETAILS	88	I7	REMOTE MONITORING SYSTEM P&ID
37	S7	PUMP STATION PLAN, NOTES & DETAILS	89	I8	DISCHARGE GATE CONTROL P&ID
38	S8	PUMP STATION SECTIONS & DETAILS			
39	S9	PUMP STATION SECTIONS			
40	S10	PUMP STATION BRIDGE CRANE SECTIONS & DETAILS			
41	S11	METER VAULT & MANHOLE No. 1 PLANS, SECTIONS, DETAILS & NOTES			
42	S12	INTERCONNECTION VAULT, ISOLATION VAULT & JUNCTION STRUCTURE PLANS, DETAILS & NOTES			
43	S13	INTERCONNECTION VAULT, ISOLATION VAULT & JUNCTION STRUCTURE SECTIONS & DETAILS			
44		ADDENDUM SKETCHES: A3-3 & A3-4			
45	M101	PUMP STATION BOTTOM PLAN			
46	M102	PUMP STATION TOP PLAN			
47	M103	PUMP STATION SECTIONS 1			
48	M104	PUMP STATION SECTIONS 2			
49	M105	PUMP STATION DETAILS 1			
50	M106	PUMP STATION DETAILS 2			
51	M107	PUMP STATION DETAILS 3			
52	M108	PUMP STATION DETAILS 4			
53	M201	CONTROL BUILDING GENERATOR-ENCLOSURE			
54	M401.1	EXISTING CONTROL BUILDING			
	M401.2	EXISTING CONTROL BUILDING			
	M401.A	CONTROL BUILDING BATHROOM DETAIL			
	M401.B	RESTROOM INTERIOR ELEVATIONS			

ACCESS ROUTE LOCATION

Underground Service Alert

 TWO DAYS BEFORE YOU DIG
 Call TOLL FREE: 1-800-642-2444

RECOMMENDED BY: **REFER TO BID SET**
FOR SIGNATURE
 ASSISTANT DIRECTOR, DEPARTMENT OF MUNICIPAL UTILITIES

APPROVED BY: **REFER TO BID SET**
FOR SIGNATURE
 DIRECTOR, DEPARTMENT OF MUNICIPAL UTILITIES

REFER TO BID SET
FOR SIGNATURE
 No. 24118

REV. No.	DISCRPTION	DATE	BY	Apr'd By
1	ADDENDUM No. 3	5/25/06	TTT	PDF
2	RECORD DRAWINGS			
3				
4				
5				
6				
7				

WEST YOST ASSOCIATES

 Consulting Engineers
 1260 Lake Boulevard
 Suite 240
 Davis, California 95616
 (530) 756-5905
 FAX (530) 756-5991

RECORD DRAWINGS
14-Mile Slough Pump Station Upgrades
 TITLE SHEET, VICINITY MAP, SHEET INDEX
 DEPARTMENT OF MUNICIPAL UTILITIES
 CITY OF STOCKTON, CALIFORNIA
 SCALE: NONE
 DESIGNED BY: WYA
 DRAWN BY: DTD
 CHECKED BY: PDF
 RECORD Dwg.:
 SHEET No. **G1**
 1 of 89 SHEETS
 PROJECT No. 293-00-05-01

N:\Clients\293_Sponsor\00-05-01 14-MSPS Upgrades\CAD\Design\Submittals\293-0501G01.dwg 11-12-08 01:48:05 PM areimer

LEGEND - CIVIL

	NATURAL GROUND OR GRADE		CONCRETE SECTION	\times 34.8	EXISTING SPOT ELEVATION
	COMPACTED MATERIAL		ROCK RIP RAP	\times -2.0	FINISH GRADE SPOT ELEVATION
	GRANULAR MATERIAL SUCH AS CRUSHED ROCK OR GRAVEL		OFF-LIMITS BARRIER	\times EP: -0.5	EDGE OF PAVEMENT
	ROAD W/CURB & GUTTER		EQUIPMENT NUMBER	\times HP: -1.0	HIGH POINT
	EXISTING FENCE		SLOPE	0.5%	DEGREE OF SLOPE
	NEW FENCE		FLOW LINE OF DRAINAGE COURSE	*•	STREET LIGHT
	EXISTING GRADE CONTOURS		POWER POLE	•	MANHOLE
	EXISTING FACILITY		TEMPORARY SURVEY MONUMENT	o	MANHOLE
	NEW FACILITY		EXISTING PIPELINE	o	MANHOLE
	FUTURE FACILITY		NEW PIPELINE	o	MANHOLE
	CENTERLINE		NEW PIPELINE UNDER CONCRETE	o	MANHOLE
	ABANDON IN PLACE		EXISTING ELECTRICAL	o	MANHOLE
	DEMOLISH		PROPOSED ELECTRICAL	o	MANHOLE

LEGEND - PIPING

	SINGLE LINE		DOUBLE LINE		SINGLE LINE		DOUBLE LINE
	FLANGED JOINT		RESTRAINED FLANGED COUPLING ADAPTER		TEE UP		TEE DOWN
	PLAIN OR GROOVED END MECHANICAL COUPLING		GROOVED END ADAPTER FLANGE		LATERAL UP		LATERAL DOWN
	PUSH ON, MECHANICAL OR BALL & SOCKET JOINT		UNION		CONCENTRIC REDUCER		ECCENTRIC REDUCER
	WELDED JOINT		ELASTOMER & FABRIC EXPANSION JOINT		ELBOW UP		ELBOW DOWN
	SLEEVE TYPE MECHANICAL COUPLING		EXPANSION JOINT (SEE SPECS FOR TYPE)		THREE WAY VALVE		DIAPHRAGM VALVE
	RESTRAINED SLEEVE TYPE MECHANICAL COUPLING		FLEXIBLE METAL HOSE		GATE VALVE (NORMALLY OPEN)		GATE VALVE (NORMALLY CLOSED)
	FLANGED COUPLING ADAPTER		DIAPHRAGM VALVE		PLUG VALVE (NORMALLY OPEN)		PLUG VALVE (NORMALLY CLOSED)

	THREE WAY VALVE		DIAPHRAGM VALVE		BALANCING COCK		SOLENOID VALVE
	GATE VALVE (NORMALLY OPEN)		ANGLE VALVE		PRESSURE & VACUUM RELIEF VALVE		DIAPHRAGM OPERATED VALVE
	GATE VALVE (NORMALLY CLOSED)		PINCH VALVE		VACUUM RELIEF VALVE		MOTOR OPERATED VALVE
	PLUG VALVE (NORMALLY OPEN)		NEEDLE VALVE		PRESSURE RELIEF VALVE		WHARF HYDRANT
	PLUG VALVE (NORMALLY CLOSED)		DOUBLE LEAF CHECK VALVE		STRAINER		FIRE HYDRANT
	BALL VALVE (NORMALLY OPEN)		CHECK VALVE		PRESSURE REGULATING VALVE		UTILITY STATION
	BALL VALVE (NORMALLY CLOSED)		KNIFE GATE VALVE		BACK PRESSURE REGULATING VALVE		HOSE BIBB VALVE
	GLOBE VALVE		FLAP GATE				


ABBREVIATIONS

AB	AGGREGATE BASE	MH	MANHOLE
AC	ASPHALT CONCRETE	MJ	MECHANICAL JOINT
ADJ	ADJUSTED	MOV	MOTOR OPERATED VALVE
AL, ALUM	ALUMINUM	N	NORTH, NORTHING
AP	ANGLE POINT	NGVD29	NATIONAL GEODETIC VERTICAL DATUM OF 1929
APPROX.	APPROXIMATE	NIC	NOT IN CONTRACT
ASPH	ASPHALT	NTS	NOT TO SCALE
BC	BEGIN CURVE	NW	NORTHWEST
BF	BLIND FLANGE	OC	ON CENTER
BUILDG	BUILDING	OD	OUTSIDE DIAMETER
BSS	BERM SIDE SLOPE	OD	OUTSIDE DIAMETER
BVC	BEGIN VERTICAL CURVE	PAV'T	PAVEMENT
CL	CENTER LINE	PG	PRESSURE GAUGE
CLR	CLEAR	PJF	PREFORMED JOINT FILLER
CO	CLEAN OUT	PL	PLATE, PROPERTY LINE
CONC	CONCRETE	PV	PLUG VALVE
CONT	CONTINUOUS	PVI	POINT OF VERTICAL INFLECTION
COS	CITY OF STOCKTON	R	RADIUS
CMU	CONCRETE MASONRY UNIT	PVC	POLYVINYL CHLORIDE
CV	CHECK VALVE	R	RADIUS
CY	CUBIC YARDS	RCP	REINFORCED CONCRETE PIPE
DIA, Ø	DIAMETER	RD2119	RECLAMATION DISTRICT 2119
DIP	DUCTILE IRON PIPE	REQ'D	REQUIRED
DWG	DRAWING	R&R	REMOVE & RELOCATE
E	EAST, EASTING	R&S	REMOVE & SALVAGE
EC	END CURVE	R/W	RIGHT OF WAY
EF	EACH FACE	S	SLOPE
EL, ELEV	ELEVATION	SCH	SCHEDULE
ELEC	ELECTRIC	SHT	SHEET
EP	EDGE OF PAVEMENT	SQ	SQUARE
EQUIP	EQUIPMENT	SS	STAINLESS STEEL
EV	ELECTRICAL VAULT	SSB	STAINLESS STEEL BOLT
EVC	END VERTICAL CURVE	SSPC	SOCIETY OF PROTECTIVE COATINGS
EW	EACH WAY	STA	STATION
EX, E	EXISTING	STD	STANDARD
EXP	EXPANSION	STL	STEEL
FCA	FLANGED COUPLING ADAPTER	T&B	TOP & BOTTOM
FCO	FLOOR CLEANOUT	TAN	TANGENT
FD	FLOOR DRAIN	TBM	TEMPORARY BENCHMARK
FF	FINISH FLOOR	TEL	TELEPHONE
FL	FLOW LINE	TEL	TELEPHONE
FLG	FLANGE	TOC	TOP OF CONCRETE
FOC	FACE OF CURB	TOS	TOP OF STEEL OR TOP OF STRUCTURAL FRAME
FRP	FIBERGLASS REINFORCED PLASTIC	TS	TUBULAR STEEL
GS	GROUND SURFACE	TYP	TYPICAL
GSP	GROUND SURFACE PROFILE	UG	UNDERGROUND
GYP	GYPSUM	UNO	UNLESS NOTED OTHERWISE
HP	HIGH POINT IN PAV'T	VC	VERTICAL CURVE
HSB	HIGH STRENGTH BOLTS	VAR	VARIOUS
ID	INSIDE DIAMETER	VERT	VERTICAL
IE	INVERT ELEVATION	VG	VALLEY GUTTER
INV	INVERT	W	WATER
IIPS	IRON PIPE SIZE	W/	WITH
MAX	MAXIMUM	W/O	WITHOUT
MB	MOLLY BOLT	WS	WATER SURFACE
MEK	METHYL ETHYL KEYTONE	WWF	WELDED WIRE FABRIC
MIN	MINIMUM		


PIPING SYSTEM ABBREVIATIONS

ABCMP	ASBESTOS BONDED CORRUGATED METAL PIPE
CD	CHEMICAL DRAIN
CMP	CORRUGATED METAL PIPE
CP	CONCRETE PIPE
D	DRAIN
EF	EFFLUENT
FM	FORCE MAIN
FOS	FUEL OIL SUPPLY
FOR	FUEL OIL RETURN
IN	INFLUENT
MgOH	MAGNESIUM HYDROXIDE
NPW	NON-POTABLE WATER
PD	PERFORATED DRAIN
PG	PROPANE GAS
RCP	REINFORCED CONCRETE PIPE
SA	SITE AIR
SD	STORM DRAIN
SS	SANITARY SEWER
SW	SITE WATER
V	VENT
2W	FORMER WWTP WELL WATER

SECTION & DETAIL DESIGNATIONS

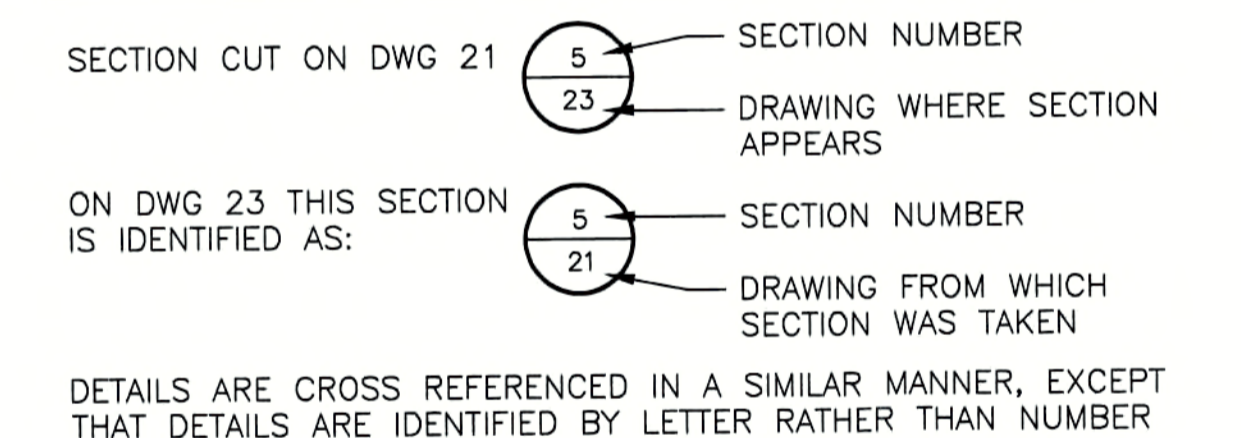

PIPING DESIGNATIONS

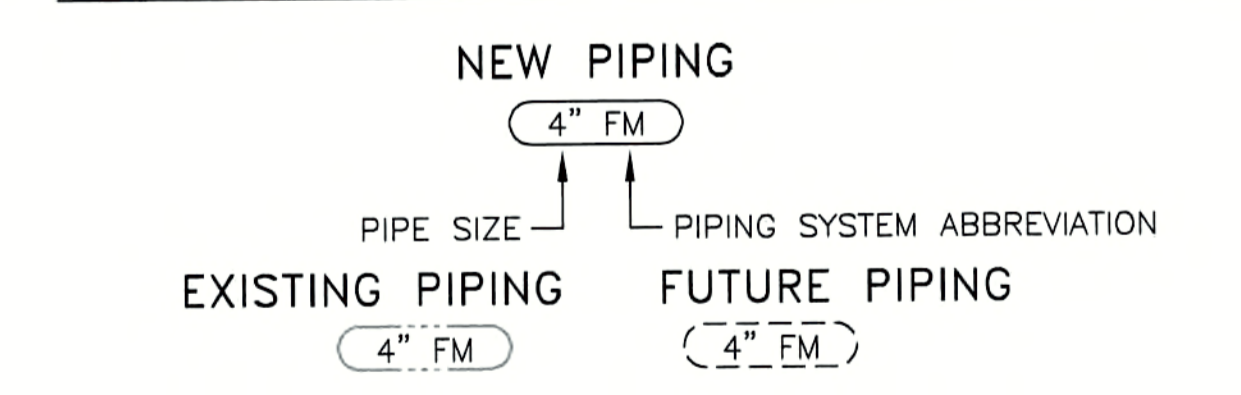

RECORD DRAWINGS		
14-Mile Slough Pump Station Upgrades		
LEGEND & ABBREVIATIONS		
DEPARTMENT OF MUNICIPAL UTILITIES CITY OF STOCKTON, CALIFORNIA		
SCALE: NONE	APPROVED BY: DATE:	SHEET No. G2
DESIGNED BY: TTT		2 of 89 SHEETS
DRAWN BY: DTD		PROJECT No. 293-00-05-01
CHECKED BY: PDF	ASSISTANT DIRECTOR, DEPT. OF MUNICIPAL UTILITIES	
RECORD Dwg.:		



REV. No.	DISCRPTION	DATE	By	Apr'd By
1				
2				
3				
4				
5				
6				
7				

WEST YOST ASSOCIATES
Consulting Engineers

1260 Lake Boulevard
Suite 240
Davis, California 95616
(530) 756-5905
FAX (530) 756-5991

Underground Service Alert

TWO DAYS BEFORE YOU DIG

Call TOLL FREE: 1-800-642-2444

N:\Clients\293 - Sponos\00-05-01 14-Mile Slough Pump Station Upgrades\CAD\Design\Utilities\293-00-05-01 G02.dwg 11-12-08 01:49:10 PM ornamer

GENERAL NOTES

- CITY OF STOCKTON STANDARD SPECIFICATIONS AND STANDARD DRAWINGS ARE DEEMED TO BE INCLUDED IN THE CONTRACT DOCUMENTS BY REFERENCE.
- CONTRACTOR SHALL ARRANGE FOR ALL REQUIRED INSPECTION. PRESENCE OR ABSENCE OF AN INSPECTOR SHALL NOT RELIEVE CONTRACTOR OF FULL RESPONSIBILITY FOR PROPER PERFORMANCE OF THE WORK.
- CONTRACTOR IS ADVISED OF THE HIGH GROUND WATER CONDITIONS AND SOFT ORGANIC SOILS IN THE PROJECT AREA. CONTRACTOR'S ATTENTION IS BROUGHT REFER TO THE GEOTECHNICAL ENGINEERING REPORT PREPARED FOR THIS PROJECT.
- CONTRACTOR SHALL COMPLY WITH CONFINED SPACE ENTRY REQUIREMENTS OF CAL-OSHA AND CITY OF STOCKTON. CONTRACTOR SHALL SUBMIT SAFETY PLAN, COMPLY WITH ALL STATE AND COUNTY LAWS AND ORDINANCES RELATING TO SAFETY AND CHARACTER OF WORK, AND SUPPLY ALL EQUIPMENT AND LABOR PERSONNEL. THIS SHALL INCLUDE BUT NOT BE LIMITED TO, SHORING OF TRENCHES AND EXCAVATIONS AND VENTILATING CONFINED SPACES.
- THE BASIS OF SURVEY IS CITY OF STOCKTON BENCHMARKS. HORIZONTAL CONTROL: NAD 83, CA SP ZONE III GRID COORDINATES. VERTICAL CONTROL: CITY OF STOCKTON, NGVD29 (COS 1996 ADJUSTMENT) PROJECT BENCHMARKS INCLUDE THE FOLLOWING BENCHMARKS:

BM NUMBER	NORTHING	EASTING	ELEVATION	DESCRIPTION
COS BM 216	2192047.120	6312949.79	-2.23	TOP 3/8" IRON PIN IN MONUMENT BOX, CENTERLINE OF CUMBERLAND PLACE & 5-MILE DRIVE, COS "7N-3"
1000	2192538.460	6310657.179	-1.713	DRILL HOLE IN NW VAULT CORNER AT PUMP STATION
1112	2192386.084	6310591.343	-1.050	SPIKE 1112 IN DRIVEWAY TO PUMP STATION
1113	2192369.693	6310728.335	-1.370	SCRIBED 'X' 1113 IN VAULT CONCRETE

- CONTRACTOR SHALL PROVIDE CONSTRUCTION STAKING NECESSARY FOR THE PROJECT. CONTRACTOR SHALL PRESERVE CONSTRUCTION STAKES, REFERENCE POINTS, AND OTHER SURVEY POINTS. SET BY THE OWNER. OWNER WILL BACK CHARGE THE CONTRACTOR COSTS FOR RESTAKING.
- SEE SPECIFICATIONS FOR CONSTRUCTION SEQUENCING REQUIREMENTS.
- CONTRACTOR SHALL SELECT CONSTRUCTION EQUIPMENT TO MINIMIZE DAMAGE TO EXISTING PAVEMENT AT PROJECT SITE AND AT ALL ROADS USED TO MOVE MATERIAL AND EQUIPMENT TO AND FROM PROJECT. REPLACE DAMAGED ASPHALT CONCRETE PAVEMENT IN ACCORDANCE WITH CONTRACT DOCUMENTS. ALL PAVEMENT, INCLUDING ASPHALT CONCRETE (AC) AND PORTLAND CEMENT CONCRETE (PCC) PAVING, SHALL BE SAW CUT PRIOR TO INSTALLATION OF PAVEMENT PATCH.
- ANY PAVEMENT DISTURBED MUST BE REMOVED, ALL SUBGRADE AND ANY UNDERLYING MATERIAL DISTURBED SHALL BE RECOMPACTED, AND ORIGINAL VERTICAL ALIGNMENT RESTORED.
- CONTRACTOR SHALL PROVIDE PIPE BENDS OR FITTINGS AT HORIZONTAL ANGLE POINTS.
- CONTRACTOR SHALL REMOVE AND LEGALLY DISPOSE OF ALL MATERIALS THAT ARE TO BE REMOVED FROM THE SITE INCLUDING, SURPLUS EXCAVATION MATERIALS AND DEBRIS. CONTRACTOR SHALL MAINTAIN THE SITE IN A NEAT AND ORDERLY CONDITION. THE CONTRACTOR SHALL DELIVER MATERIALS OR EQUIPMENT TO BE SALVAGED AND RETURNED TO THE OWNER AT THE LOCATION TO BE DETERMINED BY THE ENGINEER.
- ALL PRESSURE PIPE ON THE PUMP STATION SITE SHALL HAVE RESTRAINED JOINTS.
- NOTIFY UNDERGROUND SERVICES ALERT (USA) AT (800) 642-2444 AT LEAST 48 HOURS PRIOR TO ALL EXCAVATION.
- MAINTAIN ACCESS ROADS TO ALL PROPERTIES ADJACENT TO WORK THROUGHOUT PERIOD OF CONSTRUCTION IN ACCORDANCE WITH THE SPECIFICATIONS.
- TEMPORARY ACCESS ROADS CONSTRUCTED BY THE CONTRACTOR TO FACILITATE THE WORK AND NOT INDICATED AS PERMANENT ACCESS ROADS ON THE PLANS SHALL BE REMOVED AT THE COMPLETION OF THE WORK. ALL GRAVEL AND ROCK USED FOR TEMPORARY ACCESS ROADS SHALL BE REMOVED.
- CONTRACTOR SHALL MAINTAIN ADEQUATE DUST CONTROL PER SECTION 10, CALTRANS STANDARD SPECIFICATIONS.
- THE CONTRACTOR MAY USE GROUNDWATER FROM DEWATERING FOR DUST CONTROL.
- ENGINEER ANTICIPATES THAT DEWATERING WATER AND OTHER WATER GENERATED BY THE CONSTRUCTION WILL BE IMPOUNDED ON SITE IN ONE OR MORE OF THE EXISTING BASINS. CONTRACTOR SHALL PREPARE AND SUBMIT TO THE ENGINEER A STORM WATER POLLUTION PREVENTION PLAN (SWPPP) AND OBTAIN APPROPRIATE FORMS FROM SAN JOAQUIN COUNTY CITY OF STOCKTON. CONTRACTOR SHALL ABIDE BY ALL REQUIREMENTS AND BMP'S IN THE APPROVED SWPPP.

- THE TYPE, LOCATION, SIZE AND DEPTH OF EXISTING UNDERGROUND UTILITIES SHOWN ON THESE IMPROVEMENT PLANS WERE OBTAINED FROM SOURCES OF VARYING RELIABILITY. EFFORTS HAVE BEEN MADE TO LOCATE AND DELINEATE ALL KNOWN UNDERGROUND FACILITIES. HOWEVER, THE ENGINEER CANNOT DOES NOT ASSUME RESPONSIBILITY FOR THE COMPLETENESS AND/OR ACCURACY OF THE DELINEATION OF SUCH UNDERGROUND FACILITIES. NOR FOR EXISTENCE OF OTHER BURIED OBJECTS AND/OR FACILITIES WHICH MAY BE ENCOUNTERED BUT ARE NOT SHOWN ON THESE DRAWINGS. THE CONTRACTOR SHALL EXPOSE ALL UNDERGROUND FACILITIES THAT ARE TO BE CONNECTED TO, OR THAT ARE IN THE PATH OF, THE PROPOSED IMPROVEMENTS FOR VERIFICATION OF LOCATION AND ELEVATION PRIOR TO COMMENCING CONSTRUCTION. THE CONTRACTOR SHALL BE RESPONSIBLE FOR CONSTRUCTING THE WORK OF THE PROJECT PER THE IMPROVEMENT PLANS DESPITE BURIED OBJECTS OR FACILITIES WHICH WERE NOT EXPECTED TO BE ENCOUNTERED.
- A WRITTEN REQUEST TO REMOVE AND/OR TRIM ANY TREES NOT INDICATED FOR REMOVAL SHALL BE SUBMITTED IN WRITING TO THE ENGINEER. NO REMOVAL AND/OR TRIMMING SHALL TAKE PLACE WITHOUT WRITTEN RESPONSE BY THE ENGINEER. REMOVE AND DISPOSE OF TREES AS REQUIRED BY THE LEEVE IMPROVEMENTS SHOWN HEREIN. APPROXIMATELY 60 TREES, 24" TO 36" DBH, ARE EXPECTED TO BE REMOVED. FOR ALL OTHER TREES NOT INDICATED FOR REMOVAL, A WRITTEN REQUEST TO REMOVE AND/OR TRIM SHALL BE SUBMITTED IN WRITING TO THE ENGINEER. NO REMOVAL AND/OR TRIMMING SHALL TAKE PLACE WITHOUT WRITTEN RESPONSE FROM THE ENGINEER.
- ALL EXISTING DRAINAGE DITCHES SHALL BE GRADED TO DRAIN IN ORIGINAL DIRECTION AND PROTECTED FROM EROSION.
- UNLESS OTHERWISE INDICATED, DRIVEWAYS AND CULVERTS ARE TO BE REPLACED IN KIND IF DAMAGED AT THE CONTRACTOR'S EXPENSE.
- ANY AND ALL PIPELINES DAMAGED DURING CONSTRUCTION MUST BE SATISFACTORILY REPLACED AND/OR REPAIRED, AND INSPECTED BY THE ENGINEER.
- CONTRACTOR IS RESPONSIBLE FOR THE PROTECTION OF ALL EXISTING MONUMENTS AND OTHER SURVEY MARKERS. MONUMENTS AND SURVEY MARKERS DESTROYED DURING CONSTRUCTION SHALL BE REPLACED OR REESTABLISHED AT THE CONTRACTOR'S EXPENSE.
- UNLESS INDICATED OTHERWISE PROVIDE 12" MIN. VERTICAL CLEARANCE BETWEEN WATERLINE & SEWAGE FACILITIES.
- 36" OF COVER IS A MINIMUM REQUIREMENT FOR PIPELINE INSTALLATION. THE CONTRACTOR SHALL BE RESPONSIBLE FOR DETERMINING THE AMOUNT OF COVER NECESSARY FOR THE PROPER INSTALLATION OF APPURTENANCES.
- TIE-IN DETAILS SHOWN ON THE PLANS ARE SCHEMATIC AND ARE INTENDED TO SHOW THE ESSENTIAL ELEMENTS REQUIRED OF THE CONNECTION, ACTUAL FIELD PIPING ANGLES MAY BE DIFFERENT. THE CONTRACTOR SHALL SUPPLY ALL LABOR, ANGLED FITTINGS AND APPURTENANCES REQUIRED FOR THE TIE-IN INSTALLATION WITH NO ADDITIONAL REIMBURSEMENT.
- NO CONSTRUCTION SHALL BE DONE BETWEEN OCTOBER 15 AND MAY 1 WITHOUT A COUNTY CITY OF STOCKTON APPROVED SEDIMENT AND EROSION CONTROL PLAN TO PREVENT SOIL EROSION. ALL EROSION AND SEDIMENTATION CONTROL MEASURES SHALL BE IN ACCORDANCE WITH THE SPECIFICATIONS AND RECOMMENDATIONS CONTAINED IN THE "EROSION AND SEDIMENT CONTROL GUIDELINES FOR DEVELOPING AREAS OF THE SIERRAS, OCTOBER 1991" "CALIFORNIA STORM WATER BEST MANAGEMENT PRACTICES HANDBOOK (CSW-BMP)".
- INSTALLATION AND MAINTENANCE OF EROSION CONTROL MEASURES ARE THE RESPONSIBILITY OF THE CONTRACTOR. THE CONTRACTOR SHALL BE RESPONSIBLE FOR THE PREVENTION OF SIGNIFICANT EROSION AND SILTATION ENTERING THE STORM DRAIN SYSTEM, NATURAL DRAINAGE COURSES AND/OR INTRUDING UPON ADJACENT ROADWAYS AND PROPERTIES. WINTERIZATION AND EROSION CONTROL SHOWN ON THESE PLANS IN THE CSW-BMP HANDBOOK IS INTENDED AS A GUIDE. ADDITIONAL EROSION CONTROL MEASURES MAY BE REQUIRED AS DETERMINED IN THE FIELD AND APPROVED BY THE ENGINEER. THIS RESPONSIBILITY SHALL APPLY THROUGHOUT THE COURSE OF CONSTRUCTION AND UNTIL ALL DISTURBED AREAS HAVE BECOME STABILIZED AND SHALL NOT BE LIMITED TO WET WEATHER PERIODS.
- AFTER STRIPPING THE DEBRIS, ANY EXISTING LOOSE FILL, UNSUITABLE SOIL, SILTY SAND DEPOSITS, OR DISTURBED NATURAL SOILS ANY UNSUITABLE SOIL SHALL BE EXCAVATED AND PROPERLY DISPOSED OF TO THE SATISFACTION OF THE ENGINEER.
- THE OWNER OR THE ENGINEER MAY REQUIRE THE CONTRACTOR AT THE CONTRACTOR'S EXPENSE TO UNCOVER ANY IMPROVEMENTS THAT HAVE BEEN COMPLETED WITHOUT PROPER INSPECTION AND/OR APPROVAL. IF THE INSTALLATION IS FOUND NOT TO MEET CONTRACT REQUIREMENTS OR PREVIOUSLY APPROVED ALTERNATIVES SHOWN ON THE PLANS, THE CONTRACTOR MAY BE REQUIRED TO REMOVE AND REPLACE SUCH IMPROVEMENTS AT HIS EXPENSE.
- AREAS DISTURBED BY THE WORK AND NOT RECEIVING SURFACING SHALL BE HYDROSEEDDED.
- THE CONTRACTOR SHALL COOPERATE WITH THE ENGINEER IN IMPLEMENTING THE MITIGATION MEASURES IN ACCORDANCE WITH THE INITIAL STUDY/MITIGATED NEGATIVE DECLARATION ENVIRONMENTAL DOCUMENT PREPARED FOR THIS PROJECT. SEE SPECIFICATIONS.
- CONTRACTOR SHALL VERIFY ALL DIMENSIONS BEFORE STARTING WORK AND SHALL IMMEDIATELY NOTIFY THE ENGINEER OF ANY DISCREPANCIES.
- CONTRACTOR TO FIELD CHECK ALL EX-VERIFY ALL EXISTING STRUCTURES FOR VERIFICATION OF DIMENSIONS WHERE EQUIPMENT IS TO BE INSTALLED.
- CONTRACTOR SHALL REFER TO ALL RELATED DRAWINGS AND TO MANUFACTURER'S DRAWINGS FOR COMPLETE DETAILS OF A GIVEN FACILITY.

- THE EXISTING WESTSIDE INTERCEPTOR IS NOT VALVED. CONTRACTOR SHALL PREPARE PLAN TO SAFELY MAKE THE MODIFICATIONS TO THE FORCEMAIN REQUIRED BY THE WORK. CONTRACTOR SHALL PREPARE BYPASS PLANS, STOPPAGE PLANS AND CONTROLS OF WASTE WATER FLOW FOR ENGINEERS REVIEW AND APPROVAL.
- ENGINEERED FILLS AND SUBGRADES SHALL BE MOISTURE CONDITIONED AND COMPACTED. COMPACTED SOILS SHALL BE BETWEEN 3% AND 6% ABOVE OPTIMUM MOISTURE CONTENT.
- REMOVE APPROX. 2,200 FEET OF FENCING ALONG THE EXISTING LEEVE. CONSTRUCT NEW FENCING 10 FEET AWAY FROM TOE OF NEW SLOPE OR AS DIRECTED IN THE FIELD BY THE ENGINEER. REPLACEMENT FENCING SHALL BE PER SHEET C202; WITH THE EXCEPTION THAT RAZOR WIRE IS NOT REQUIRED. EXISTING FENCING MAY BE REUSED AT THE DISCRETION OF THE ENGINEER.
- EXTEND SIPHON PIPING THROUGH LEEVE IMPROVEMENTS. SEE KEYNOTE 4 ON SHEET C2 AND SKETCH A3-1 AND A3-2 FOR SIPHON PIPE PLAN AND DETAILS.
- PROVIDE TIE-OFF BOLTS ON THE PUMP STATION TOP SLAB TO BE USED IN REMOVING PUMPS WITH THE BRIDGE CRANE. SEE SKETCH A3-3 AND A3-4 FOR PUMP TIE-OFF PLAN AND DETAILS.

N:\Clients\293_Sponsor\00-05-01_14-MSPS_Upgrade\CAD\Design\Submittals\293-0501003.dwg 11-12-08 01:59:25 PM oreimer

Underground Service Alert

TWO DAYS BEFORE YOU DIG

Call TOLL FREE: 1-800-642-2444

REFER TO BID SET FOR SIGNATURE

NO. 57272

REV. No.	DISCRPTION	DATE	BY	Apr'd By
1	ADDENDUM No. 3	5/25/06	TTT	PDF
2				
3				
4				
5				
6				
7				

WEST YOST ASSOCIATES

Consulting Engineers

1260 Lake Boulevard
Suite 240
Davis, California 95616
(530) 756-5905
FAX (530) 756-5991

RECORD DRAWINGS

14-Mile Slough Pump Station Upgrades

HYDRAULIC PROFILE, GENERAL NOTES

DEPARTMENT OF MUNICIPAL UTILITIES
CITY OF STOCKTON, CALIFORNIA

SCALE: NONE	APPROVED BY: DATE:	SHEET No.
DESIGNED BY: PDF		G3
DRAWN BY: DTD		3 of 89 SHEETS
CHECKED BY: GDH	ASSISTANT DIRECTOR, DEPT. OF MUNICIPAL UTILITIES	PROJECT No. 293-00-05-01
RECORD DWG:		



KEYNOTES:

- ① INSTALL TEMPORARY PLUG IN OUTLET(S) OF POND TO PREVENT DEWATERING WATER FROM EXITING POND TO DRAINAGE DITCHES
- ② DEWATERING WATER MAY BE STORED IN THE DESIGNATED PONDS. IF DISCHARGE IS REQUIRED, DEWATERING WATER SHALL BE PUMPED TO 14 MILE SLOUGH AT A RATE NOT TO EXCEED 170 GPM
- ③ CONTRACTOR SHALL PROTECT, TO THE SATISFACTION OF RD2119, THE SLOUGH LEVEE FROM EROSION DUE TO DISCHARGE OF DEWATERING WATER
- ④ RESTORE THIS AREA TO PRE-CONSTRUCTION CONDITION AT CONCLUSION OF THE WORK OF THIS CONTRACT

N:\Client\293\Spanos\00-05-01 14-MSPS Upgrades\CAD\Design\Asbuils\293-050\G04.dwg 11-13-08 09:15:28 AM cgreiner

RECORD DRAWINGS		
14-Mile Slough Pump Station Upgrades		
SITE PLAN DRAWING REFERENCE SHEET		
DEPARTMENT OF MUNICIPAL UTILITIES CITY OF STOCKTON, CALIFORNIA		
SCALE: 1"=150'	APPROVED BY: DATE: _____	SHEET No.
DESIGNED BY: DTD		G4
DRAWN BY: DTD		4 of 89 SHEETS
CHECKED BY: TTT	ASSISTANT DIRECTOR, DEPT. OF MUNICIPAL UTILITIES	PROJECT No.
RECORD Dwg.:		293-00-05-01

Underground Service Alert

TWO DAYS BEFORE YOU DIG

Call TOLL FREE: 1-800-642-2444

REFER TO BID SET FOR SIGNATURE

REV. No.	DISCRIPTION	DATE	BY	Aprv'd By
1	RECORD DRAWINGS	6/08	CLB	PDF
2				
3				
4				
5				
6				
7				

WEST YOST ASSOCIATES
Consulting Engineers

1260 Lake Boulevard
Suite 240
Davis, California 95616
(530) 756-5905
FAX (530) 756-5991


FROM STATION	TO STATION	LEFT EDGE	RIGHT EDGE
10+00	17+90.52	HEADER BOARD	HEADER BOARD
17+90.52	19+30.76	HEADER BOARD	CURB & GUTTER
19+30.76	25+63	CURB	CURB & GUTTER
25+63	26+17	CURB	NONE
26+17	27+25	HEADER BOARD	NONE
27+25	27+70	CURB	NONE
27+70	29+12	CURB	CURB & GUTTER
29+12	29+80	CURB & GUTTER	CURB
30+00	32+28	CURB	CURB & GUTTER
32+28	33+27	CURB & GUTTER	HEADER BOARD
33+27	33+42	CURB & GUTTER	CURB & GUTTER
33+42	33+69	CURB	CURB
33+69	34+35.05	CURB	CURB & GUTTER

NOTE: THIS TABLE APPLIES TO ACCESS ROAD SHOWN ON C1 & C2. AT STATION 10+00, LEFT IS ON THE WEST AND RIGHT IS ON THE EAST.

BUILDING	NORTHING	EASTING
A1	2,192,414.43	6,310,508.36
A2	2,192,414.43	6,310,559.02
B1	2,192,536.35	6,310,517.41
B2	2,192,536.35	6,310,537.41
D1	2,192,512.35	6,310,540.91
D2	2,192,512.35	6,310,600.91
E1	2,192,469.79	6,310,528.69
E2	2,192,469.79	6,310,538.69

No.	CURVE DATA			STATION		BEGIN CURVE		END CURVE	
	LENGTH	RADIUS	DELTA	BEGIN	END	NORTHING	EASTING	NORTHING	EASTING
C1	58.97	55.00	61°25'35"	11+41.03	12+00.00	2,191,733.57	6,310,792.59	2,191,782.37	6,310,764.75
C2	140.23	133.00	60°24'43"	17+90.52	19+30.76	2,192,073.95	6,310,251.23	2,192,189.61	6,310,183.90
C3	222.27	141.50	90°00'00"	21+64.02	23+86.29	2,192,422.87	6,310,183.90	2,192,564.37	6,310,325.40
C4	92.55	46.00	115°16'37"	26+56.67	27+49.22	2,192,564.37	6,310,595.78	2,192,498.73	6,310,637.38
C5	38.41	34.00	64°43'23"	28+27.53	28+65.94	2,192,408.43	6,310,573.19	2,192,427.91	6,310,603.94
C6	120.95	77.00	90°00'01"	30+00.00	31+20.95	2,192,269.08	6,310,183.90	2,192,346.08	6,310,260.90
C7	66.04	67.65	55°56'02"	32+44.34	33+10.38	2,192,346.08	6,310,384.29	2,192,377.60	6,310,439.36

NOTE: THIS SITE IS AVAILABLE FOR CONTRACTORS USE. NO SEPARATE STAGING AREA HAS BEEN DESIGNATED

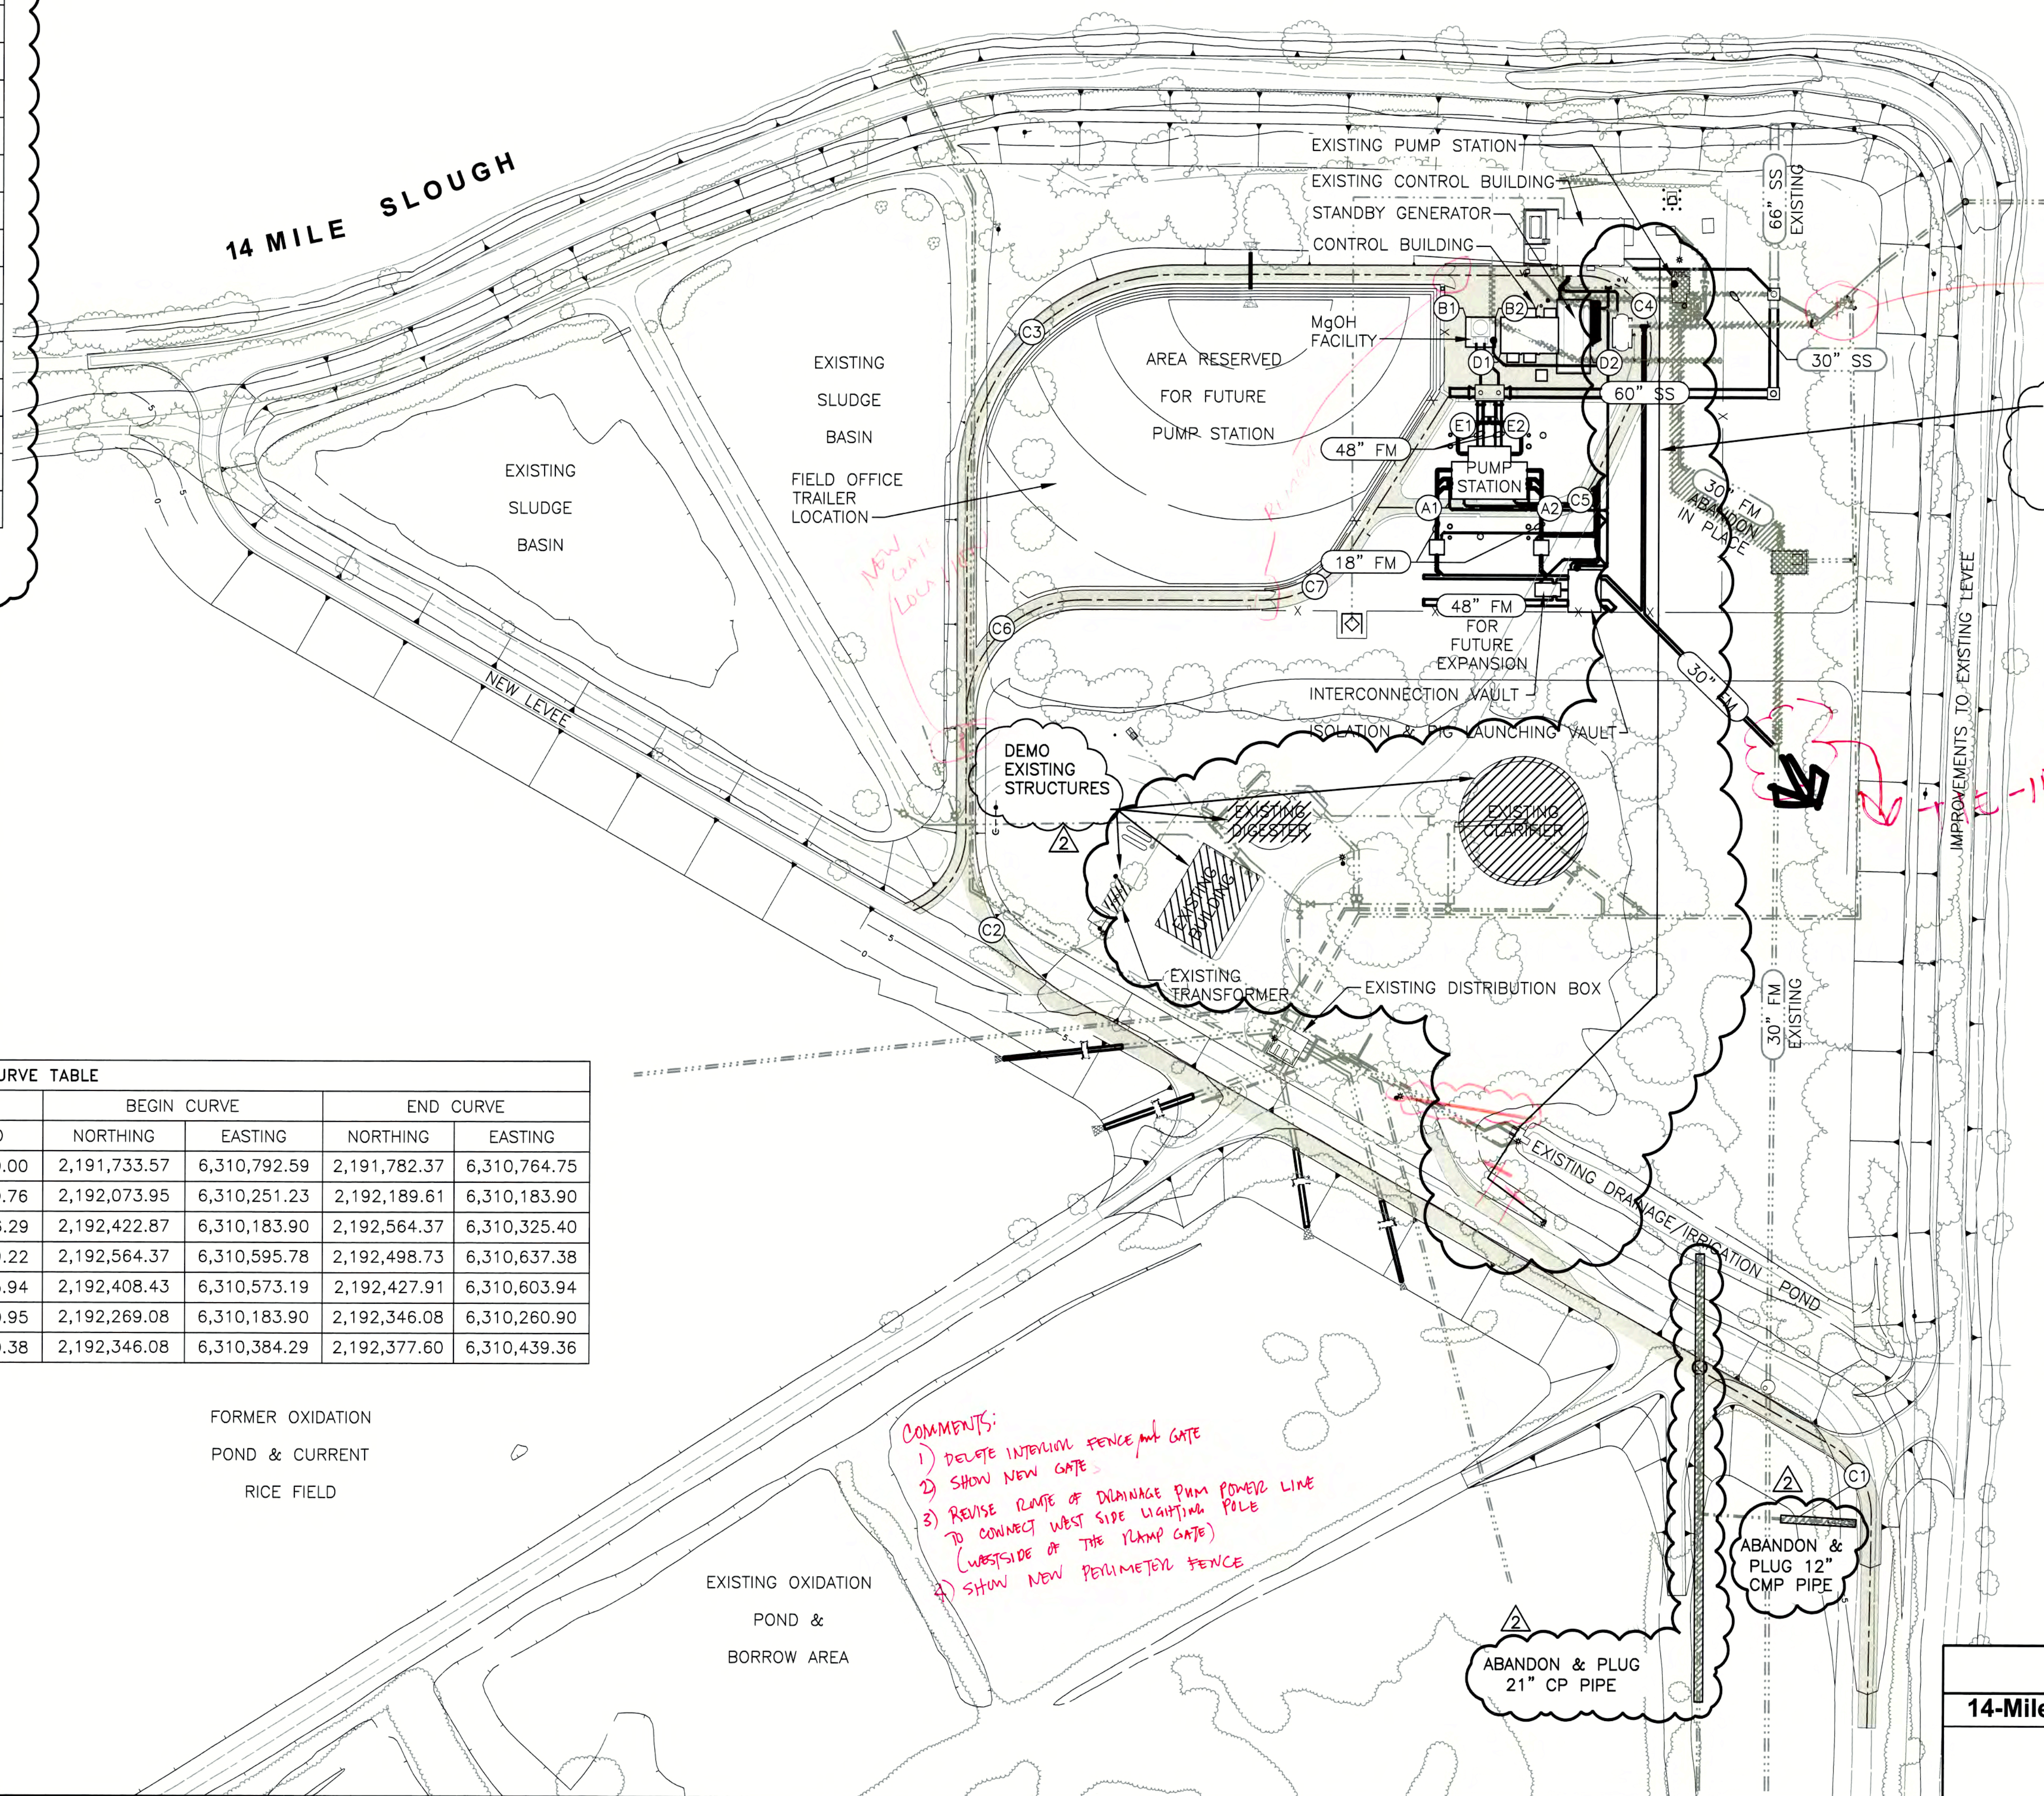

- COMMENTS:
- 1) DELETE INTERIOR FENCE AND GATE
 - 2) SHOW NEW GATE
 - 3) REVISE RANGE OF DRAINAGE PUMP POWER LINE TO CONNECT WEST SIDE LIGHTING POLE (WESTSIDE OF THE RAMP GATE)
 - 4) SHOW NEW PERIMETER FENCE

RECORD DRAWINGS		
14-Mile Slough Pump Station Upgrades		
SITE PLAN LAYOUT CONTROL		
DEPARTMENT OF MUNICIPAL UTILITIES CITY OF STOCKTON, CALIFORNIA		
SCALE: 1"=60'	APPROVED BY: DATE: _____	SHEET No.
DESIGNED BY: PDF	ASSISTANT DIRECTOR, DEPT. OF MUNICIPAL UTILITIES	G5
DRAWN BY: DTD		5 of 89 SHEETS
CHECKED BY: GDH		PROJECT No. 293-00-05-01
RECORD Dwg.:		

Underground Service Alert

TWO DAYS BEFORE YOU DIG

Call TOLL FREE: 1-800-642-2444

REFER TO BID SET FOR SIGNATURE


REV. No.	DISCRPTION	DATE	BY	Appr'd By
1	ADDENDUM No. 3	5/25/06	TTT	PDF
2	RECORD DRAWINGS	6/08	CLB	PDF
3				
4				
5				
6				
7				

WEST YOST ASSOCIATES
Consulting Engineers

1260 Lake Boulevard
Suite 240
Davis, California 95616
(530) 756-5905
FAX (530) 756-5991



N:\clients\293\spans\00-05-01 14-MSFS Upgrades\CAD\Design\Asbuille\293-0501005.dwg 11-13-08 08:10:13 AM oreimer

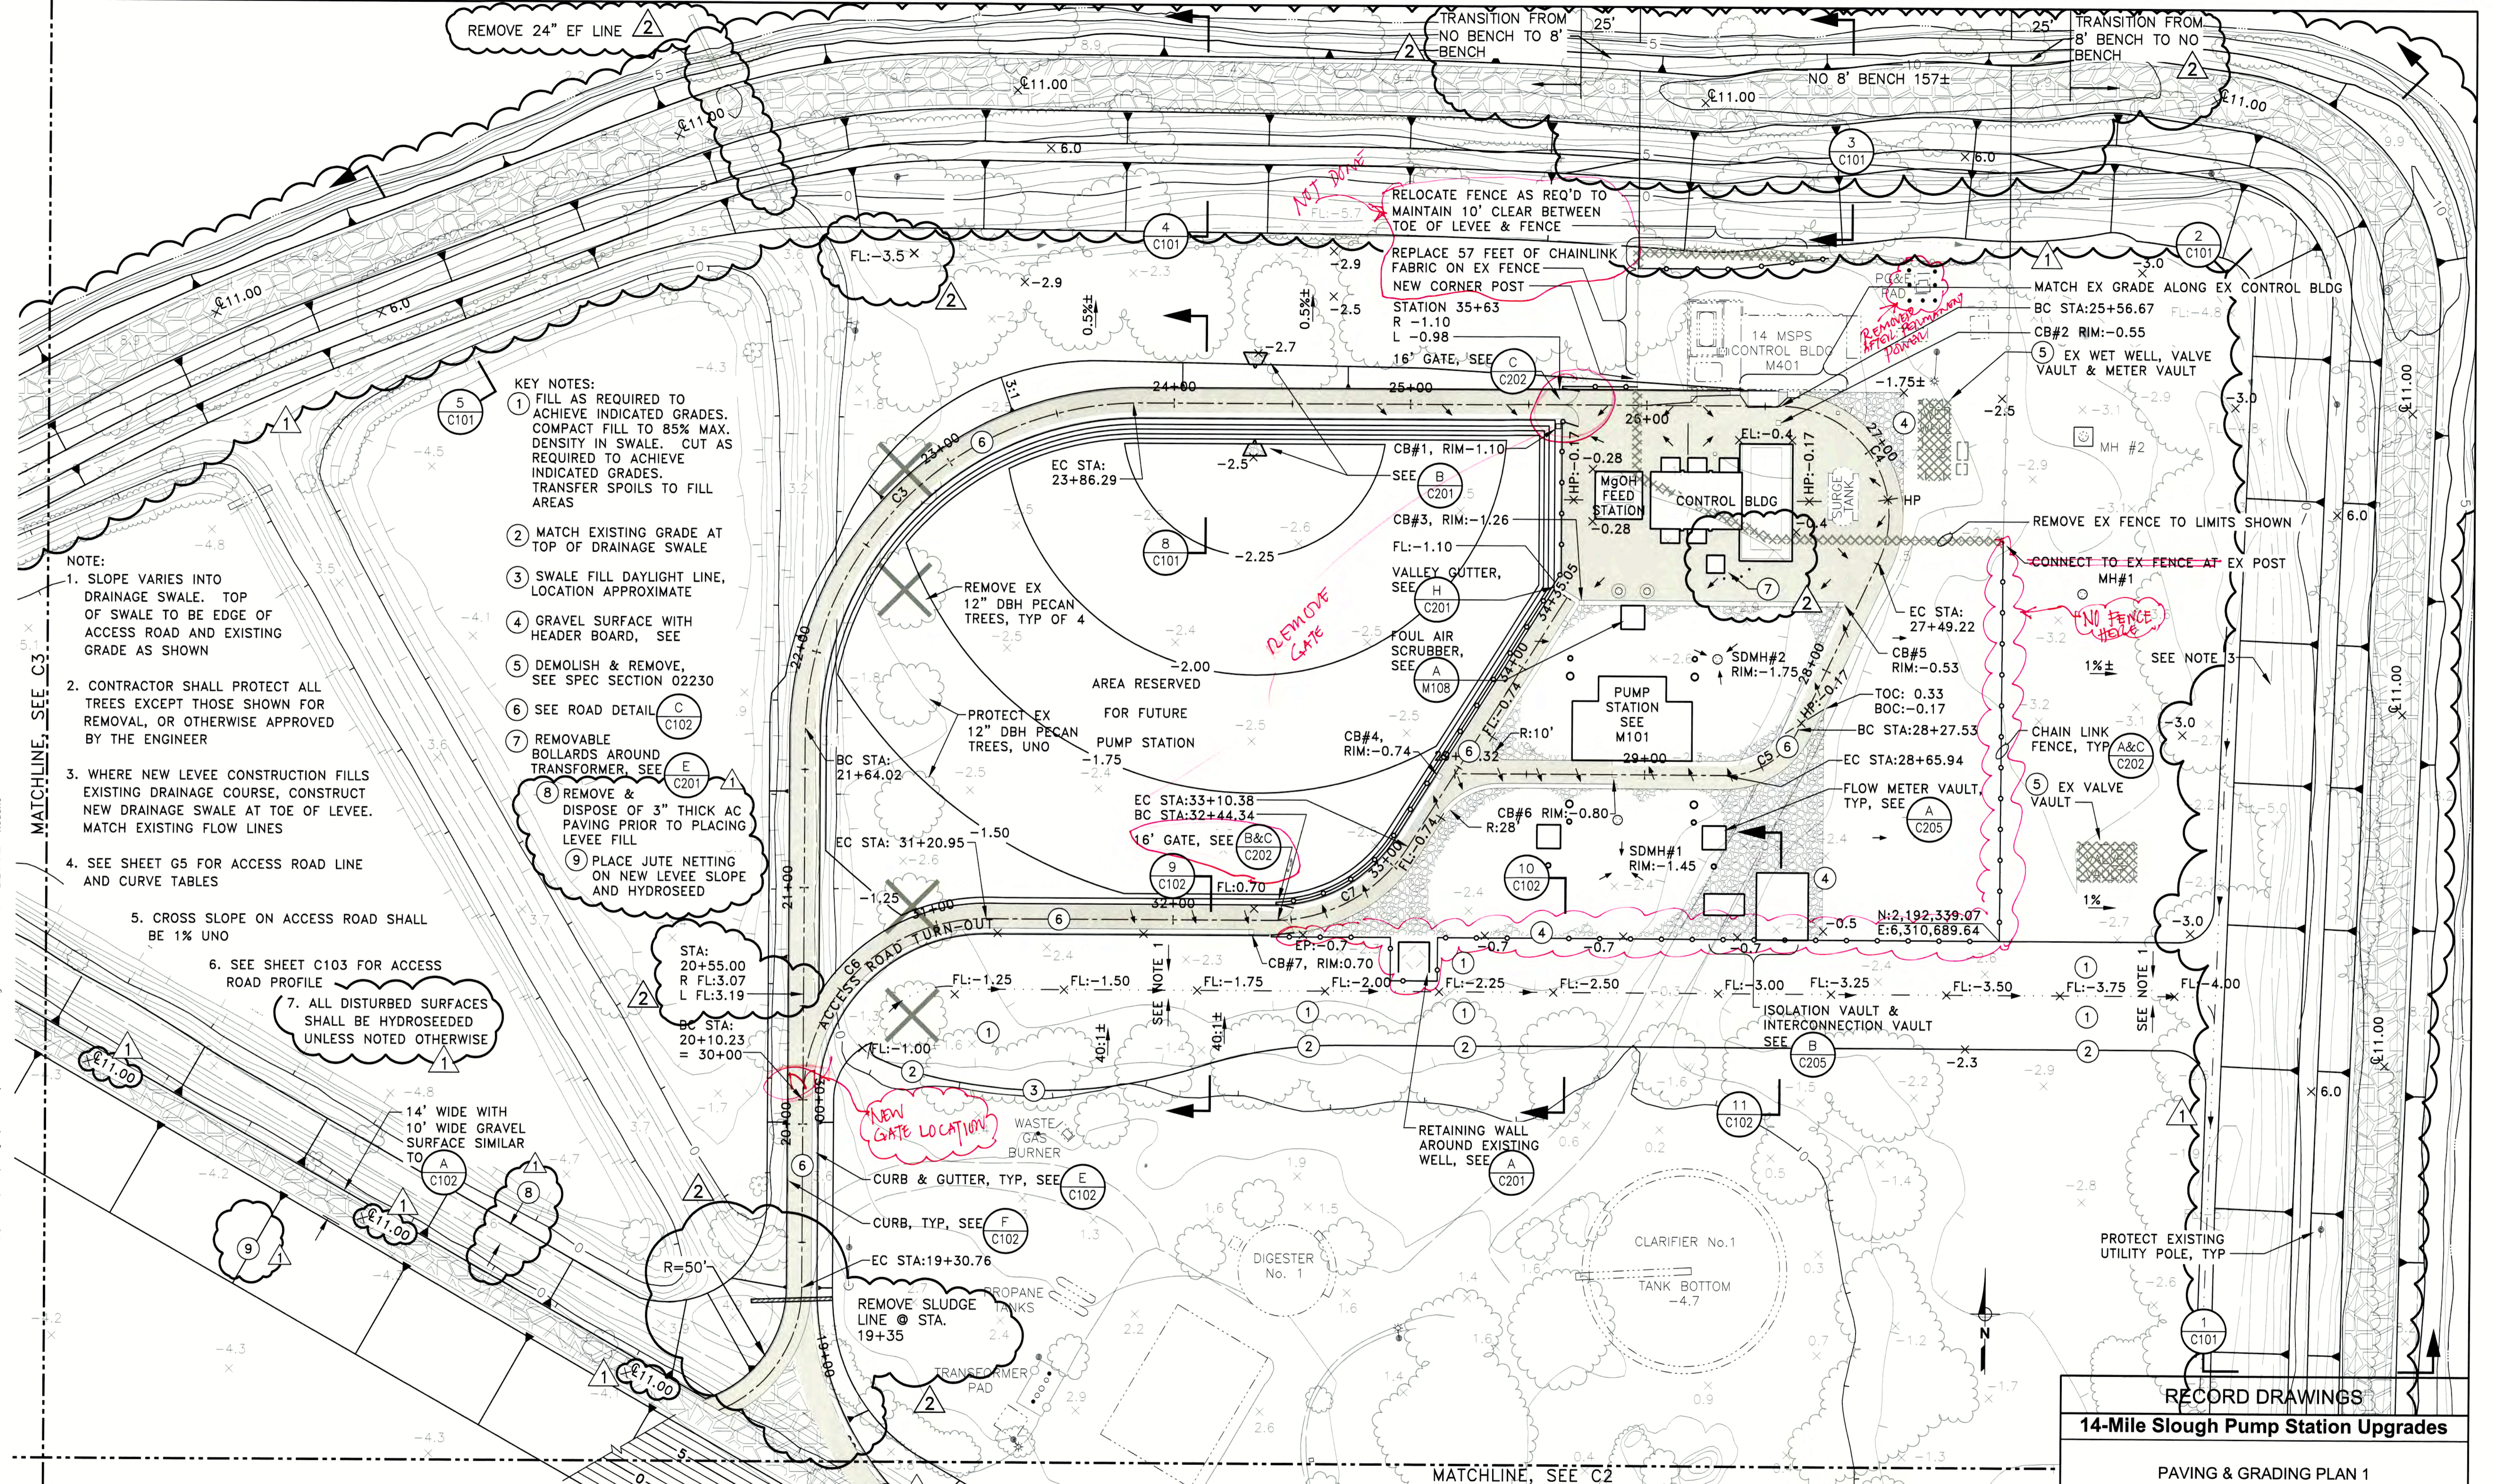

- KEY NOTES:**
- 1 FILL AS REQUIRED TO ACHIEVE INDICATED GRADES. COMPACT FILL TO 85% MAX. DENSITY IN SWALE. CUT AS REQUIRED TO ACHIEVE INDICATED GRADES. TRANSFER SPOILS TO FILL AREAS
 - 2 MATCH EXISTING GRADE AT TOP OF DRAINAGE SWALE
 - 3 SWALE FILL DAYLIGHT LINE, LOCATION APPROXIMATE
 - 4 GRAVEL SURFACE WITH HEADER BOARD, SEE
 - 5 DEMOLISH & REMOVE, SEE SPEC SECTION 02230
 - 6 SEE ROAD DETAIL (C) C102
 - 7 REMOVABLE BOLLARDS AROUND TRANSFORMER, SEE (E) C201
 - 8 REMOVE & DISPOSE OF 3" THICK AC PAVING PRIOR TO PLACING LEVEE FILL
 - 9 PLACE JUTE NETTING ON NEW LEVEE SLOPE AND HYDROSEED
- NOTE:**
1. SLOPE VARIES INTO DRAINAGE SWALE. TOP OF SWALE TO BE EDGE OF ACCESS ROAD AND EXISTING GRADE AS SHOWN
 2. CONTRACTOR SHALL PROTECT ALL TREES EXCEPT THOSE SHOWN FOR REMOVAL, OR OTHERWISE APPROVED BY THE ENGINEER
 3. WHERE NEW LEVEE CONSTRUCTION FILLS EXISTING DRAINAGE COURSE, CONSTRUCT NEW DRAINAGE SWALE AT TOE OF LEVEE. MATCH EXISTING FLOW LINES
 4. SEE SHEET G5 FOR ACCESS ROAD LINE AND CURVE TABLES
 5. CROSS SLOPE ON ACCESS ROAD SHALL BE 1% UNO
 6. SEE SHEET C103 FOR ACCESS ROAD PROFILE
 7. ALL DISTURBED SURFACES SHALL BE HYDROSEED UNLESS NOTED OTHERWISE

Underground Service Alert

TWO DAYS BEFORE YOU DIG

Call TOLL FREE: 1-800-642-2444

REFER TO BID SET FOR SIGNATURE

No. 57272

REV. No.	DESCRIPTION	DATE	BY	APPR'D By
1	ADDENDUM No. 3	5/25/06	TTT	PDF
2	RECORD DRAWINGS	6/08	CLB	PDF

WEST YOST ASSOCIATES

Consulting Engineers

1260 Lake Boulevard
Suite 240
Davis, California 95616
(530) 756-5905
FAX (530) 756-5991

RECORD DRAWINGS

14-Mile Slough Pump Station Upgrades

PAVING & GRADING PLAN 1

DEPARTMENT OF MUNICIPAL UTILITIES
CITY OF STOCKTON, CALIFORNIA

SCALE: 1"=30'

DESIGNED BY: PDF/TTT

DRAWN BY: DTD

CHECKED BY: GDH

RECORD Dwg.:

APPROVED BY: DATE:

ASSISTANT DIRECTOR,
DEPT. OF MUNICIPAL UTILITIES

SHEET No.
C1
6 of 89 SHEETS

PROJECT No.
293-00-05-01

MATCHLINE, SEE C1

KEY NOTES:

- 1) 25' TRANSITION TO CROWNED ROAD
- 2) SEE NOTE 3 ON SHEET C1. GRADE NEW DRAINAGE SWALE INTO EXISTING POND, AS REQUIRED
- 3) PROTECT EXISTING UTILITY POLE, TYP
- 4) EXTEND EXISTING STEEL SIPHON PIPE INTO POND. CUT EXISTING AND WELD NEW PIPE ONTO END
- 5) LEVEE SHALL MAINTAIN A CENTERLINE ELEVATION NOT LESS THAN 11.00 AT ALL LOCATIONS. ADJUST SLOPE OF CROWN TO DRAIN AT 1%, UNO, SEE B C102
- 6) SEE B C207
- 7) ADJUST EXISTING ARVR STATION, SEE F C201
- 8) CONSTRUCT NEW ACCESS ROAD, SLOPE 7%
- 9) MATCH EXISTING GRADE
- 10) HEADER BOARD. SEE D C201
- 11) CONSTRUCT 16' WIDE GATE AT BASE OF RAMP
- 12) REMOVE AND DISPOSE OF 3" THICK AC PAVING PRIOR TO PLACING LEVEE FILL
- 13) PLACE JUTE NETTING ON NEW LEVEE SLOPES AND HYDROSEED


NOTES:
1. ALL DISTURBED SURFACES SHALL BE HYDROSEED UNLESS NOTED OTHERWISE

CONSTRUCT 10' WIDE RAMP TO BASIN, MAX SLOPE: 10%

REMOVE EX. STANDPIPE SKIMMER

BORROW AREA, SEE SHEET C4 THRU C6
DEWATERING POND

BORROW AREA

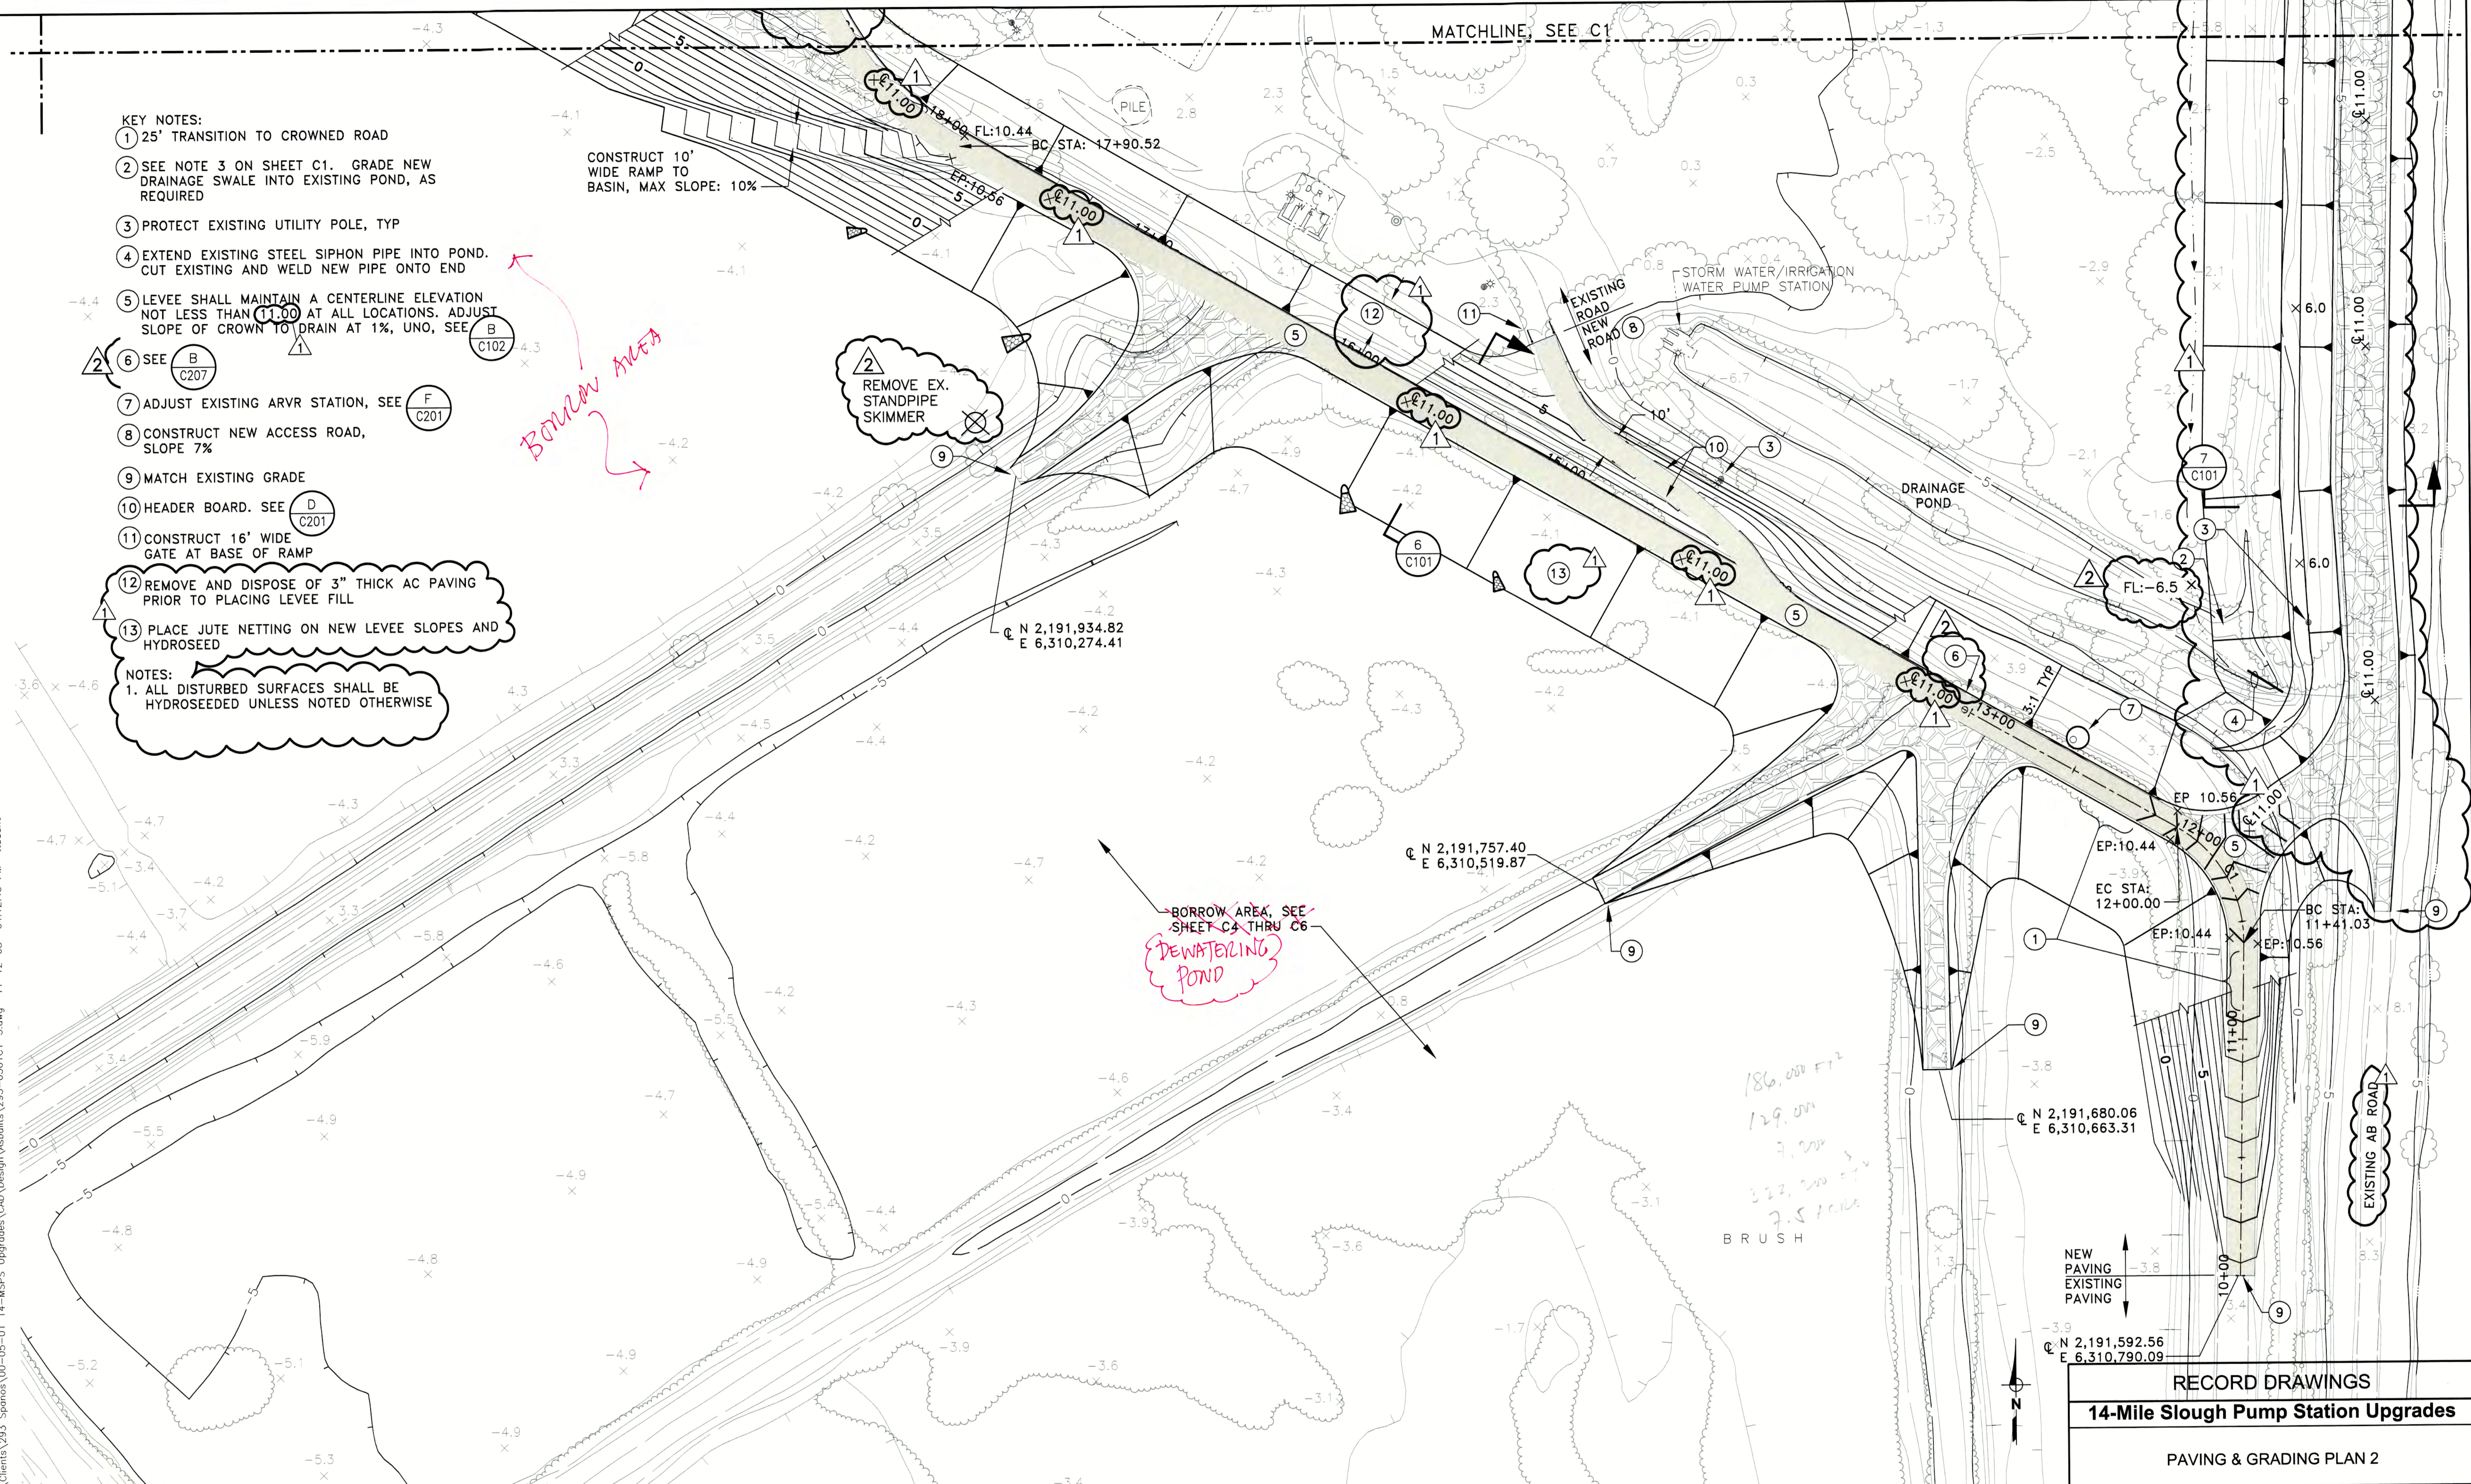

N:\Clients\293 - Spornos\00-05-01 14-Mile Slough Pump Station Upgrades\CAD\Design\Asbuilt\293-0501C1-3.dwg 11-12-08 04:12:45 PM Ricardo

Underground Service Alert

TWO DAYS BEFORE YOU DIG

Call TOLL FREE: 1-800-642-2444

REFER TO BID SET FOR SIGNATURE

PROJECT MANAGER
No. 57272

REV. No.	DISCRPTION	DATE	BY	Appr'd By
1	ADDENDUM No. 3	5/25/06	TTT	PDF
2	RECORD DRAWINGS	6/08	CLB	PDF
3				
4				
5				
6				
7				

WEST YOST ASSOCIATES
Consulting Engineers

1260 Lake Boulevard
Suite 240
Davis, California 95616
(530) 756-5905
FAX (530) 756-5991

RECORD DRAWINGS

14-Mile Slough Pump Station Upgrades

PAVING & GRADING PLAN 2

DEPARTMENT OF MUNICIPAL UTILITIES
CITY OF STOCKTON, CALIFORNIA

SCALE: 1"=30'

DESIGNED BY: PDF/TTT

DRAWN BY: DTD

CHECKED BY: GDH

RECORD Dwg.:

APPROVED BY: DATE:

ASSISTANT DIRECTOR,
DEPT. OF MUNICIPAL UTILITIES


SHEET No. **C2**

7 of 89 SHEETS

PROJECT No. 293-00-05-01

KEY NOTES:
 ① REMOVE AND DISPOSE OF 3" THICK AC PAVING PRIOR TO PLACING LEVEE FILL
 ② PLACE JUTE NETTING ON NEW LEVEE SLOPE AND HYDROSEED

NOTES:
 1. ALL DISTURBED SURFACES SHALL BE HYDROSEEDED UNLESS NOTED OTHERWISE

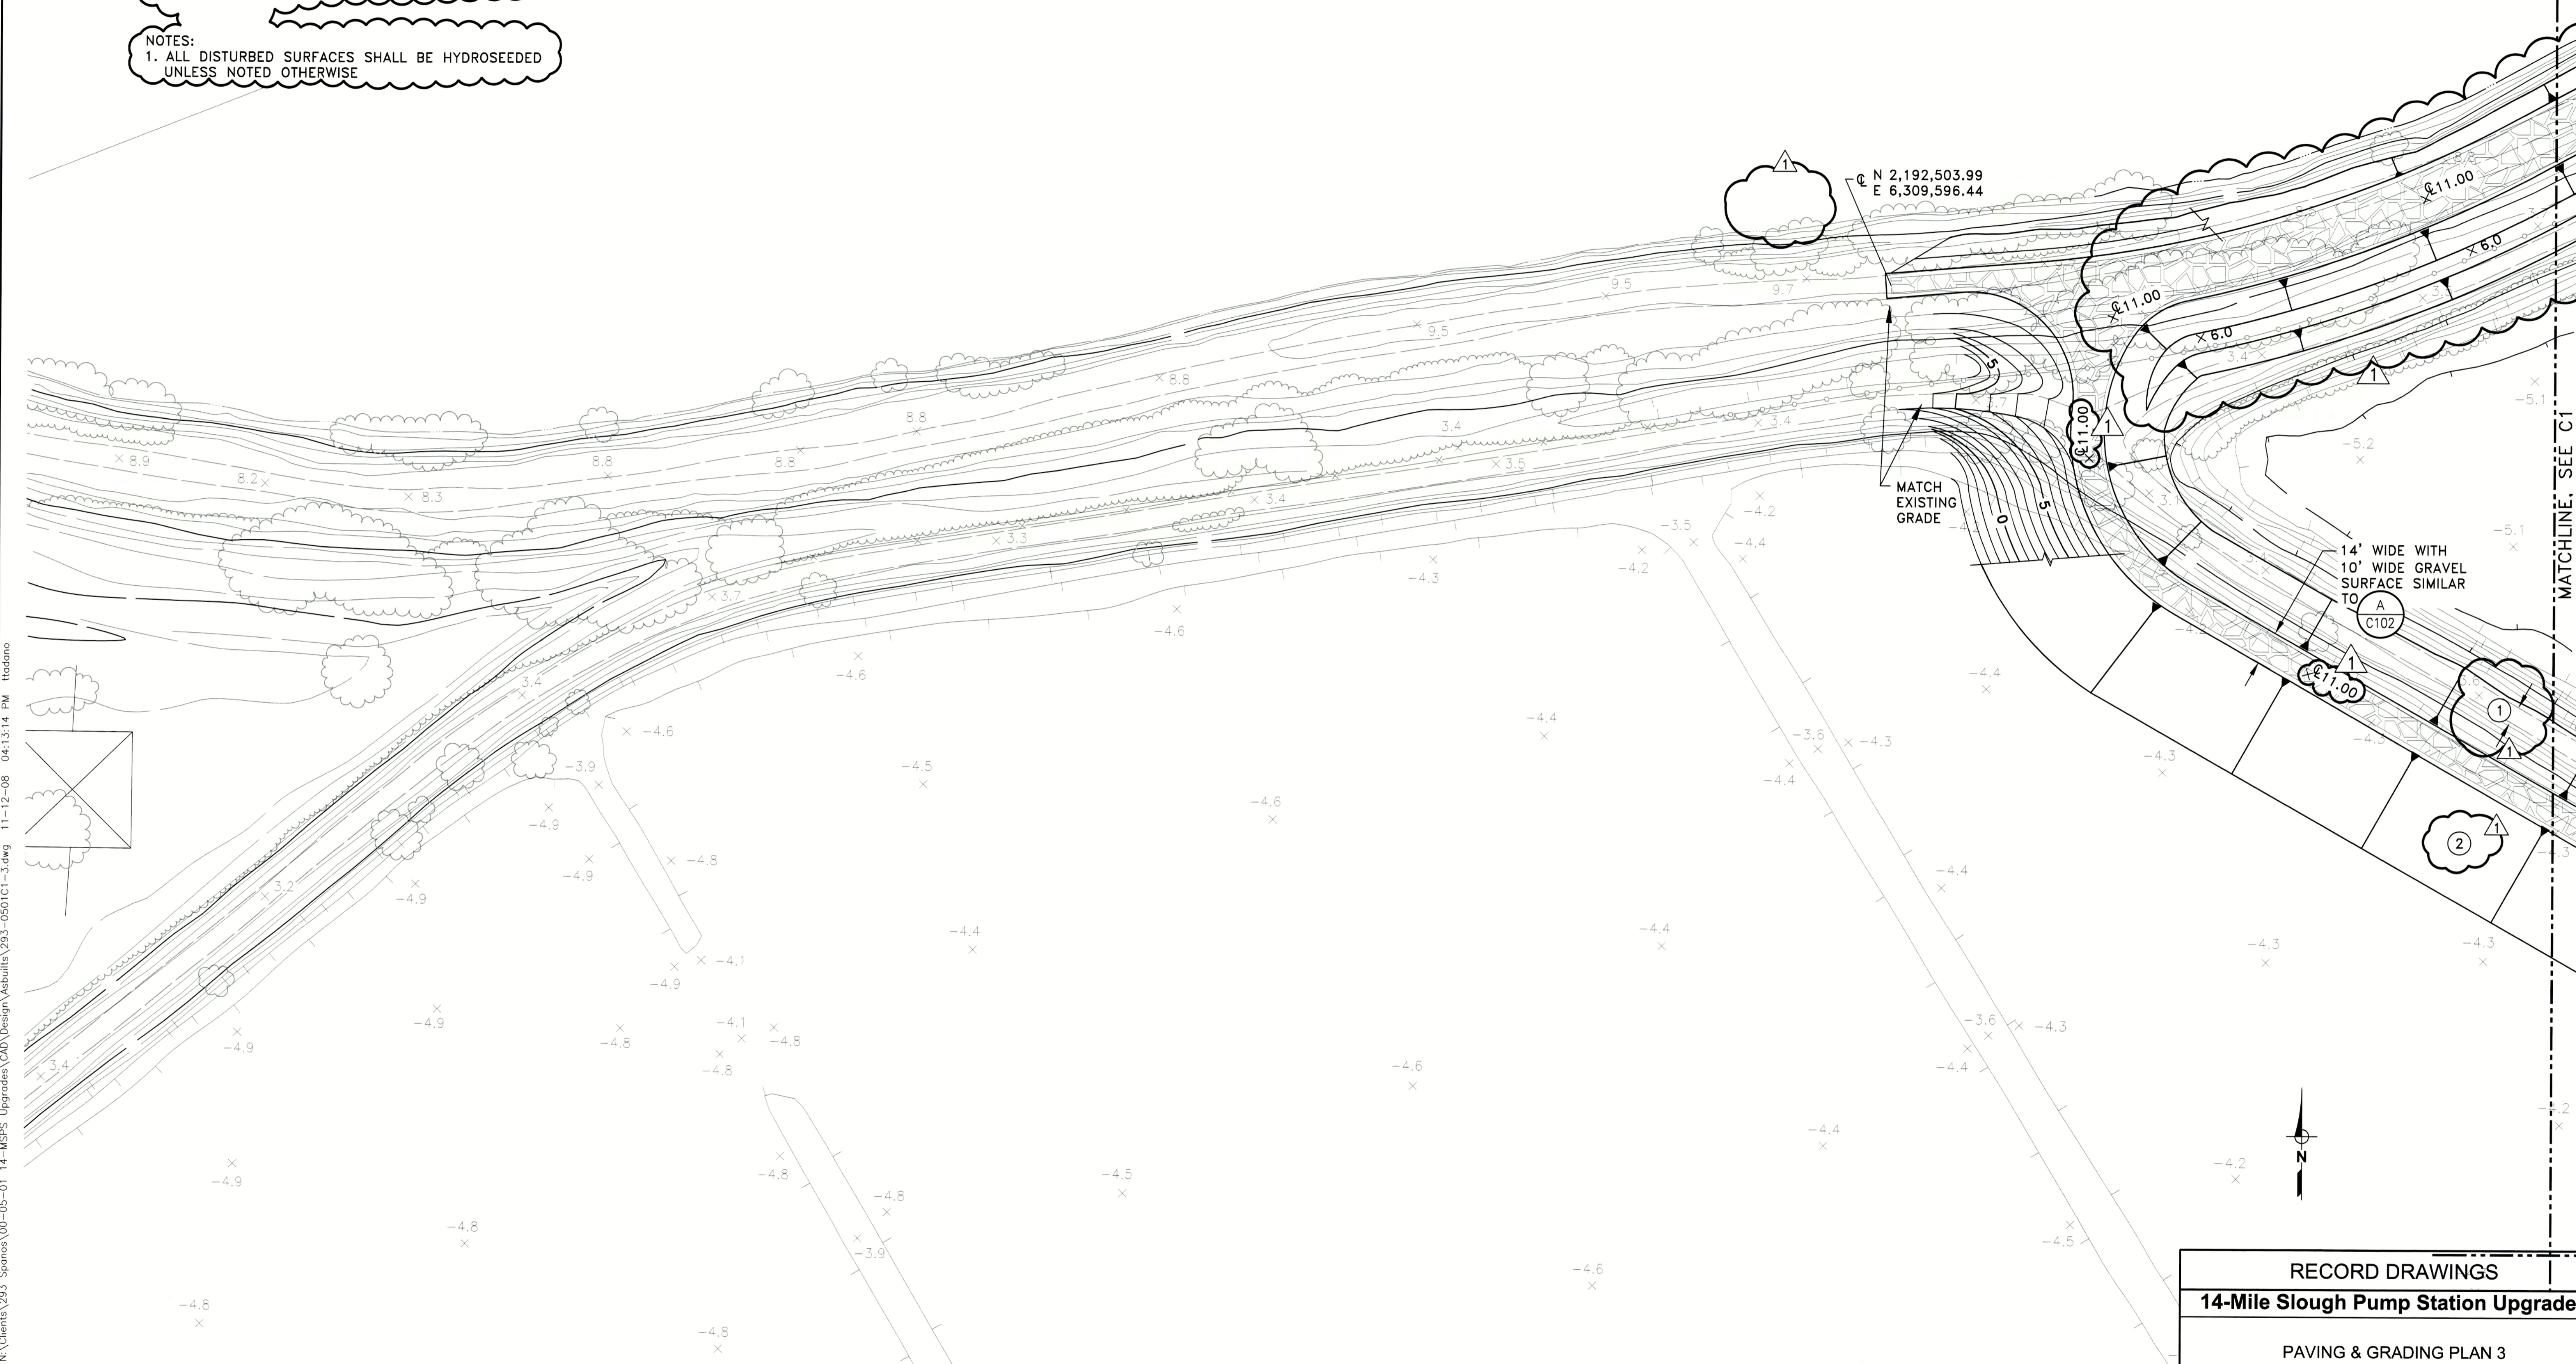

N:\Client\293\ Spones\00-05-01 14-MSFS Upgrades\CAD\Design\Submittals\293-0501C1-3.dwg 11-12-08 04:13:14 PM Itadano

Underground Service Alert

TWO DAYS BEFORE YOU DIG

Call TOLL FREE: 1-800-642-2444

REFER TO BID SET FOR SIGNATURE

REGISTRATION NUMBER: No. 57272

REV. No.	DISCRPTION	DATE	BY	Apr'd By
1	ADDENDUM No. 3	5/25/06	TTT	PDF
2	RECORD DRAWINGS	6/08	CLB	
3				
4				
5				
6				
7				

WEST YOST ASSOCIATES
 Consulting Engineers

1260 Lake Boulevard
 Suite 240
 Davis, California 95616
 (530) 756-5905
 FAX (530) 756-5991

RECORD DRAWINGS

14-Mile Slough Pump Station Upgrades

PAVING & GRADING PLAN 3

DEPARTMENT OF MUNICIPAL UTILITIES
 CITY OF STOCKTON, CALIFORNIA

SCALE: 1"=30'

DESIGNED BY: PDF/TTT

DRAWN BY: DTD

CHECKED BY: GDH


RECORD DWG.:

APPROVED BY: DATE: _____

ASSISTANT DIRECTOR,
 DEPT. OF MUNICIPAL UTILITIES


SHEET No.
C3
 8 of 89 SHEETS

PROJECT No.
 293-00-05-01

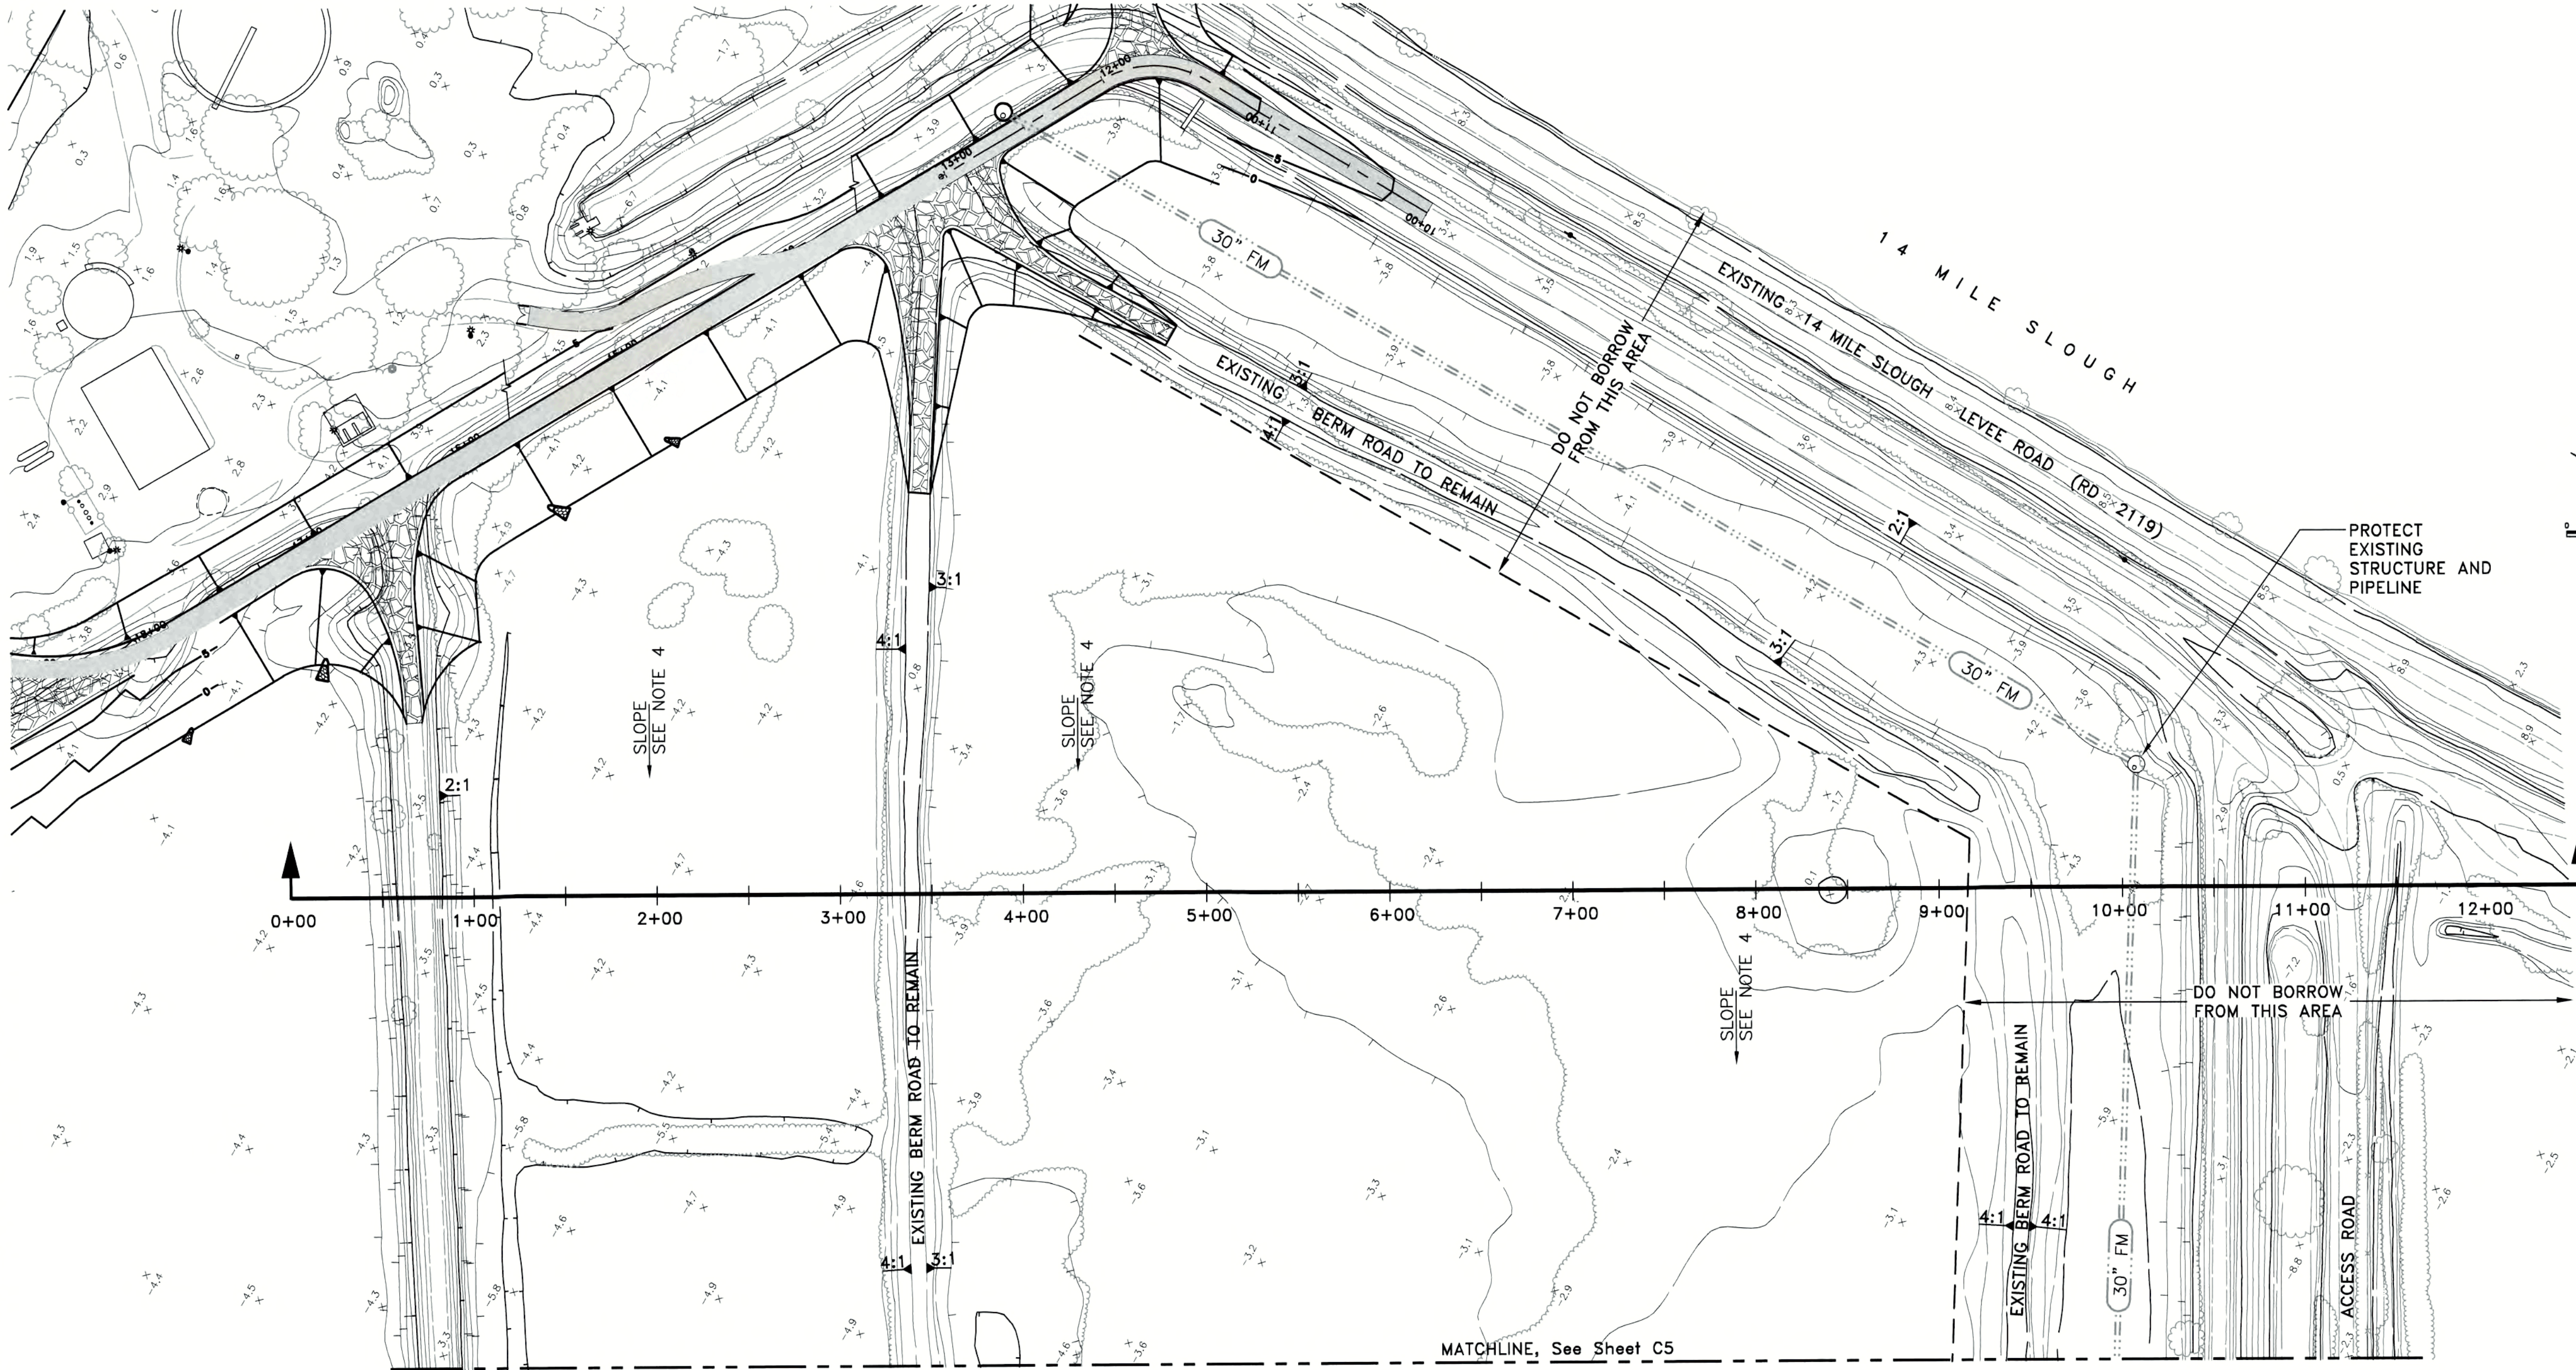

- NOTES:**
- THE EXISTING BERMS WITHIN THE BORROW AREA SHALL NOT BE DISTURBED
 - EXCAVATIONS SHALL BE NO CLOSER THAN 3 FEET FROM THE TOE OF EXISTING AND NEW BERMS. EXCAVATIONS SHALL BE SLOPED AWAY FROM THE BERM AT THE SAME SLOPE AS THE EXISTING SIDE SLOPE, AS INDICATED
 - CONTRACTOR SHALL EXCAVATE NO MORE THAN 2 FEET BELOW ADJACENT GRADE AT A TIME
 - FOLLOWING EXCAVATION THE FINISHED GRADE SHALL BE SLOPED AT NO MORE THAN 2% (WITH THE EXCEPTION OF MATCHING THE EXISTING BERM SIDE SLOPES)
 - OWNER DOES NOT GUARANTEE DEPTH OF SUITABLE MATERIAL. CONTRACTOR SHALL CONDUCT INVESTIGATIONS AS NEEDED TO DETERMINE DEPTH OF SUITABLE MATERIAL. HANDLING OF UNSUITABLE MATERIAL AS REQUIRED SHALL BE INCLUDED IN THE BID PRICE
 - CONTRACTOR SHALL CONSTRUCT ACCESS AS REQUIRED INTO THE BORROW AREA
 - NO EXCAVATION IS ALLOWED WITHIN 25 FEET OF EXISTING 30" FM
 - FINISH GRADING SHALL MAINTAIN EXISTING DRAINAGE WITHIN THE BORROW AREA
 - THE EXISTING PONDS ARE LINED WITH RIP-RAP. CONTRACTOR SHALL REMOVE EXISTING RIP-RAP AND STOCKPILE IN A LOCATION ON THE 14 MILE SLOUGH PUMP STATION SITE AS DIRECTED IN THE FIELD BY THE ENGINEER.

PLAN
SCALE: 1"=50'

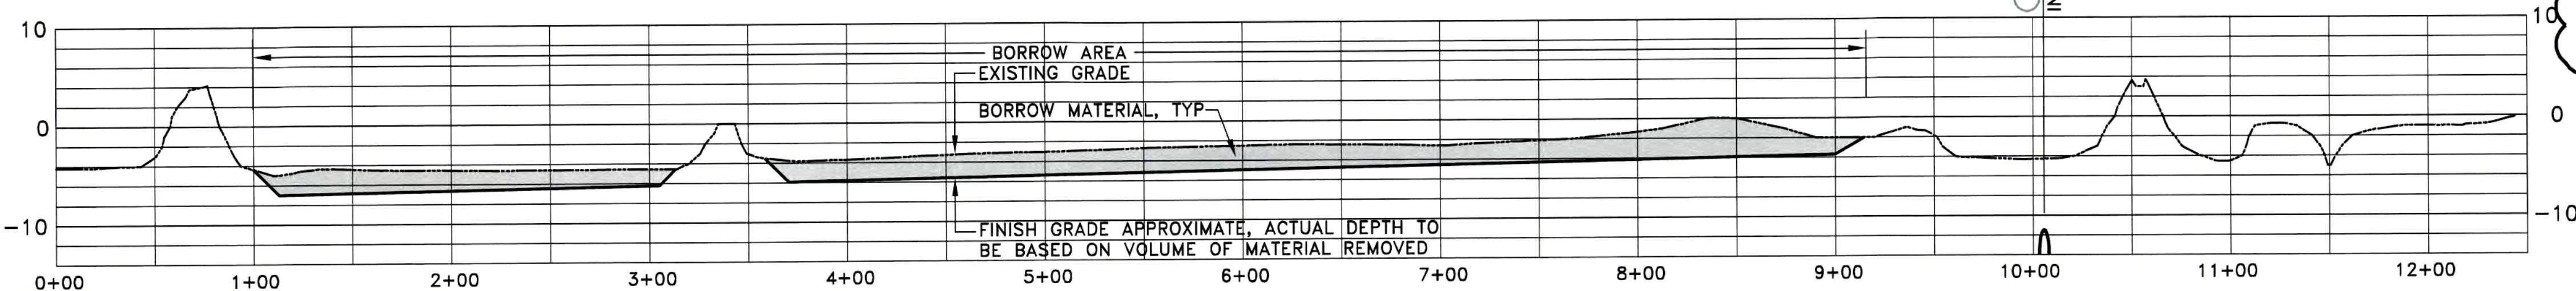

SECTION
SCALE HORIZONTAL: 1"=50'
VERTICAL: 1"=10'

RECORD DRAWINGS		
14-Mile Slough Pump Station Upgrades		
BORROW AREA PLAN & SECTION 1		
DEPARTMENT OF MUNICIPAL UTILITIES CITY OF STOCKTON, CALIFORNIA		
SCALE: AS SHOWN	APPROVED BY: DATE:	SHEET No.
DESIGNED BY: PDF		C4
DRAWN BY: DTD		9 of 89 SHEETS
CHECKED BY: GDH	ASSISTANT DIRECTOR, DEPT. OF MUNICIPAL UTILITIES	PROJECT No. 293-00-05-01
RECORD Dwg.:		

Underground Service Alert

TWO DAYS BEFORE YOU DIG

Call TOLL FREE: 1-800-642-2444

REFER TO BID SET FOR SIGNATURE

REGISTRATION No. 57272

PAUL D. SASS

REV. No.	DISCRPTION	DATE	BY	Appr'd By
1	ADDENDUM No. 3	8/25/08	TTT	PDF
2				
3				
4				
5				
6				
7				



WEST YOST ASSOCIATES

Consulting Engineers


1260 Lake Boulevard
Suite 240
Davis, California 95616
(530) 756-5905
FAX (530) 756-5991

M:\Clients\293 - Spomos\00-05-01 14-Mile Slough Pump Station Upgrades\CAD\Design\Asubuilt\293-050104-6.dwg 11-12-08 02:20:09 PM crenner

N:\Clients\293_Spanosa\00-05-01_14-MSFIS_Upgrade\CAO\Design\Asbuilts\293-0501C4-6.dwg 11-12-08 02:20:21 PM areimer

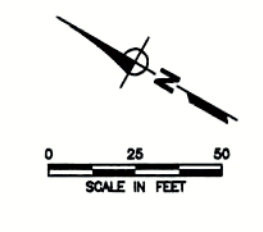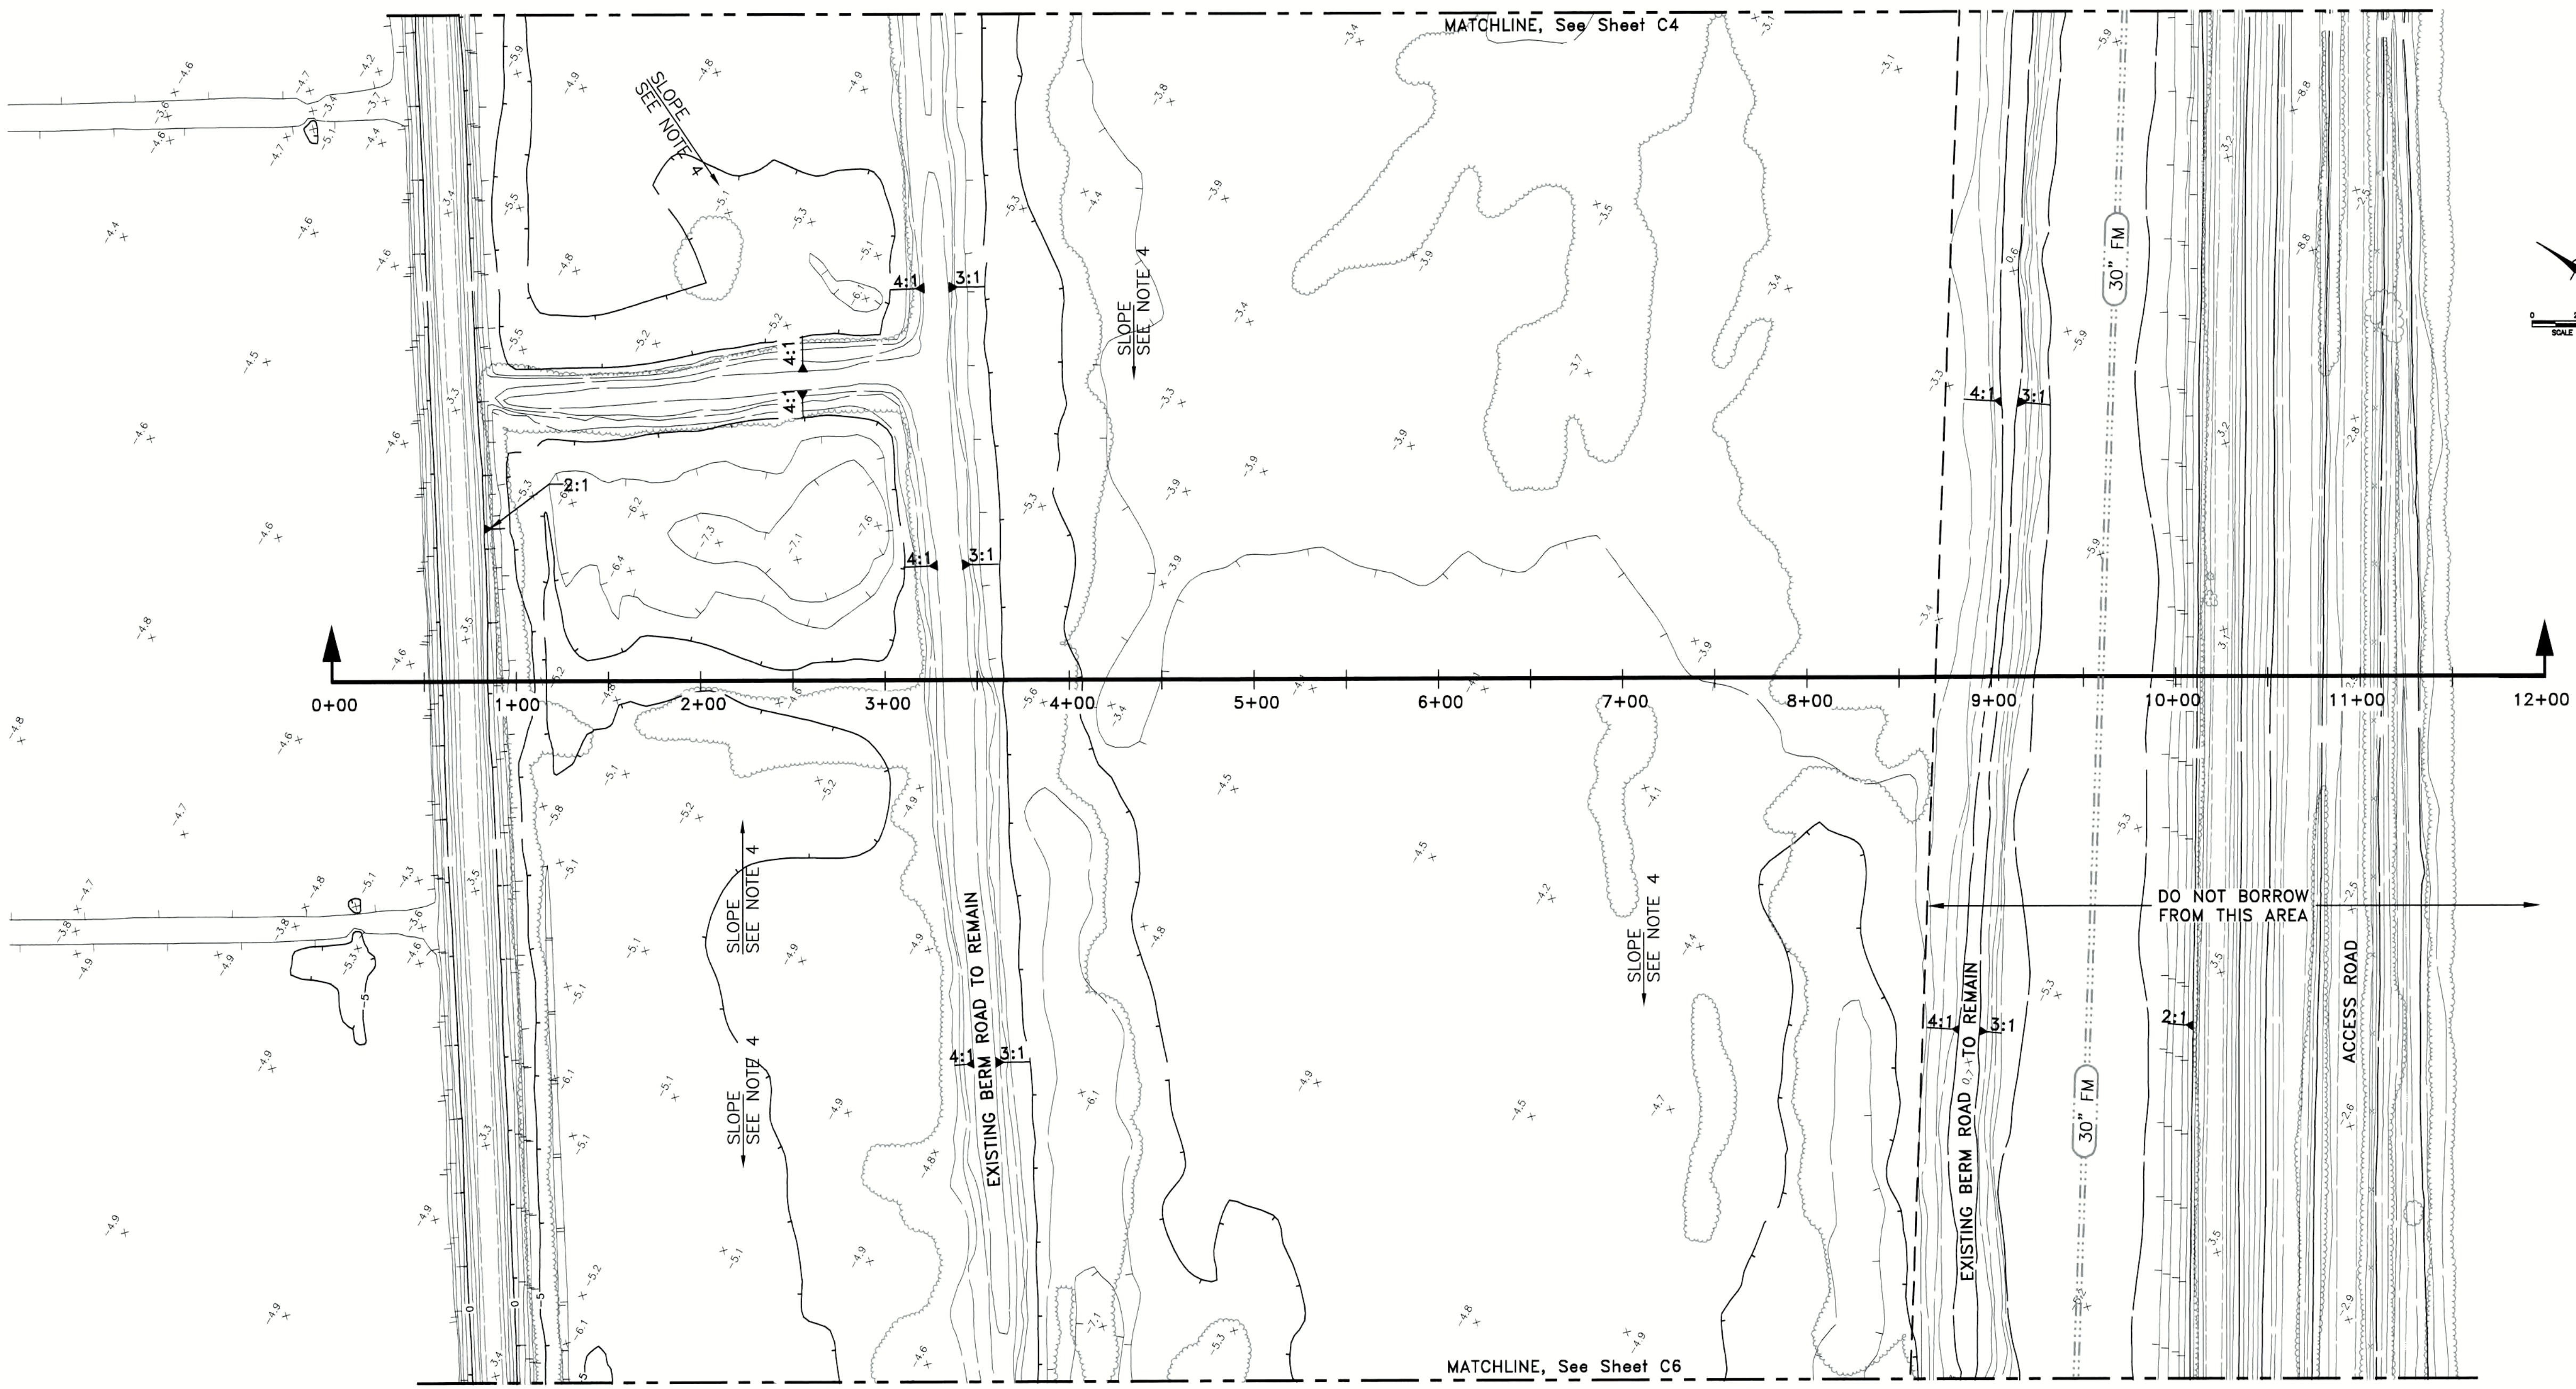

PLAN
SCALE: 1"=50'

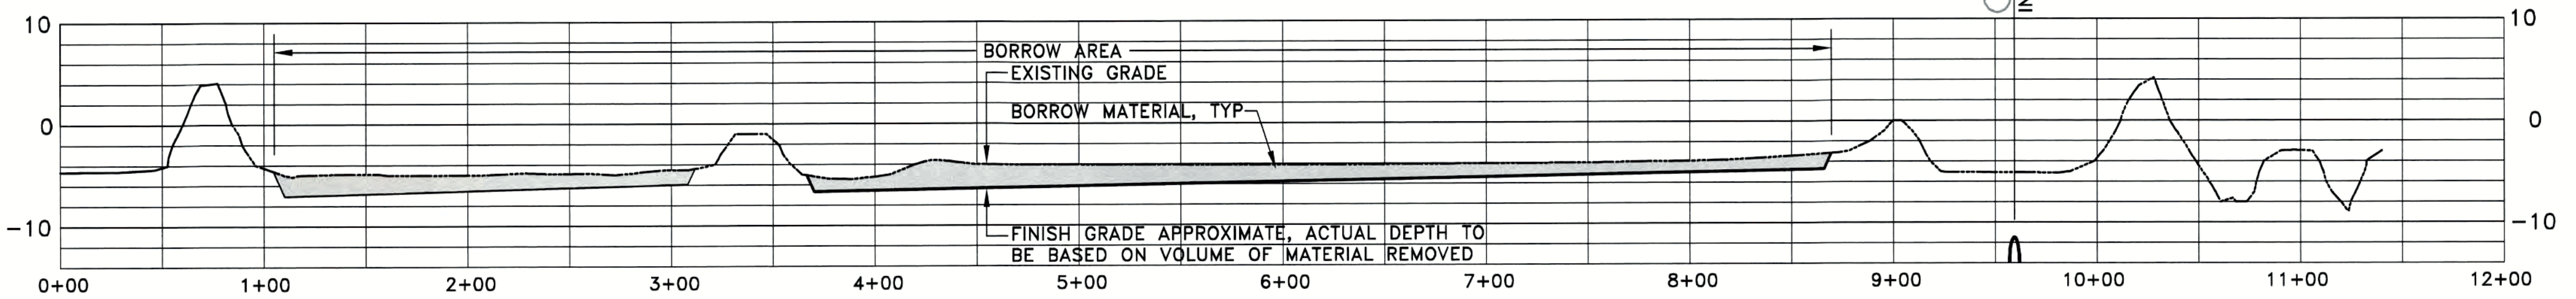

SECTION
SCALE HORIZONTAL: 1"=50'
SCALE VERTICAL: 1"=10'

- NOTES:**
1. THE EXISTING BERMS WITHIN THE BORROW AREA SHALL NOT BE DISTURBED
 2. EXCAVATIONS SHALL BE NO CLOSER THAN 3 FEET FROM THE TOE OF EXISTING AND NEW BERMS. EXCAVATIONS SHALL BE SLOPED AWAY FROM THE BERM AT THE SAME SLOPE AS THE EXISTING SIDE SLOPE, AS INDICATED
 3. CONTRACTOR SHALL EXCAVATE NO MORE THAN 2 FEET BELOW ADJACENT GRADE AT A TIME
 4. FOLLOWING EXCAVATION THE FINISHED GRADE SHALL BE SLOPED AT NO MORE THAN 2% (WITH THE EXCEPTION OF MATCHING THE EXISTING BERM SIDE SLOPES)
 5. OWNER DOES NOT GUARANTEE DEPTH OF SUITABLE MATERIAL. CONTRACTOR SHALL CONDUCT INVESTIGATIONS AS NEEDED TO DETERMINE DEPTH OF SUITABLE MATERIAL. HANDLING OF UNSUITABLE MATERIAL AS REQUIRED SHALL BE INCLUDED IN THE BID PRICE
 6. CONTRACTOR SHALL CONSTRUCT ACCESS AS REQUIRED INTO THE BORROW AREA
 7. NO EXCAVATION IS ALLOWED WITHIN 25 FEET OF EXISTING 30" FM
 8. FINISH GRADING SHALL MAINTAIN EXISTING DRAINAGE WITHIN THE BORROW AREA
 9. THE EXISTING PONDS ARE LINED WITH RIP-RAP. CONTRACTOR SHALL REMOVE EXISTING RIP-RAP AND STOCKPILE IN A LOCATION ON THE 14 MILE SLOUGH PUMP STATION SITE AS DIRECTED IN THE FIELD BY THE ENGINEER.

RECORD DRAWINGS		
14-Mile Slough Pump Station Upgrades		
BORROW AREA PLAN & SECTION 2		
DEPARTMENT OF MUNICIPAL UTILITIES CITY OF STOCKTON, CALIFORNIA		
SCALE: AS SHOWN	APPROVED BY: DATE: _____	SHEET No.
DESIGNED BY: PDF		C5
DRAWN BY: DTD		10 of 89 SHEETS
CHECKED BY: GDH	ASSISTANT DIRECTOR, DEPT. OF MUNICIPAL UTILITIES	PROJECT No. 293-00-05-01
RECORD Dwg.:		

Underground Service Alert

TWO DAYS BEFORE YOU DIG

Call TOLL FREE: 1-800-642-2444

REFER TO BID SET FOR SIGNATURE

REGISTRATION NO. 57272



ENGINEER

REV. No.	DISCRPTION	DATE	BY	Aprv'd By
1	ADDENDUM No. 3	9/25/06	TTT	PDF
2				
3				
4				
5				
6				
7				

WEST YOST ASSOCIATES
Consulting Engineers


1260 Lake Boulevard
Suite 240
Davis, California 95616
(530) 756-5905
FAX (530) 756-5991

N:\Clients\293_Spanos\00-05-01 14-MSPS Upgrades\CAD\Design\Submittals\293-050TCA-6.dwg 11-12-08 02:20:32 PM areimer

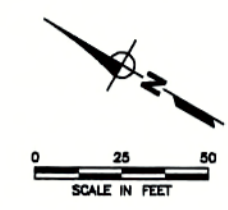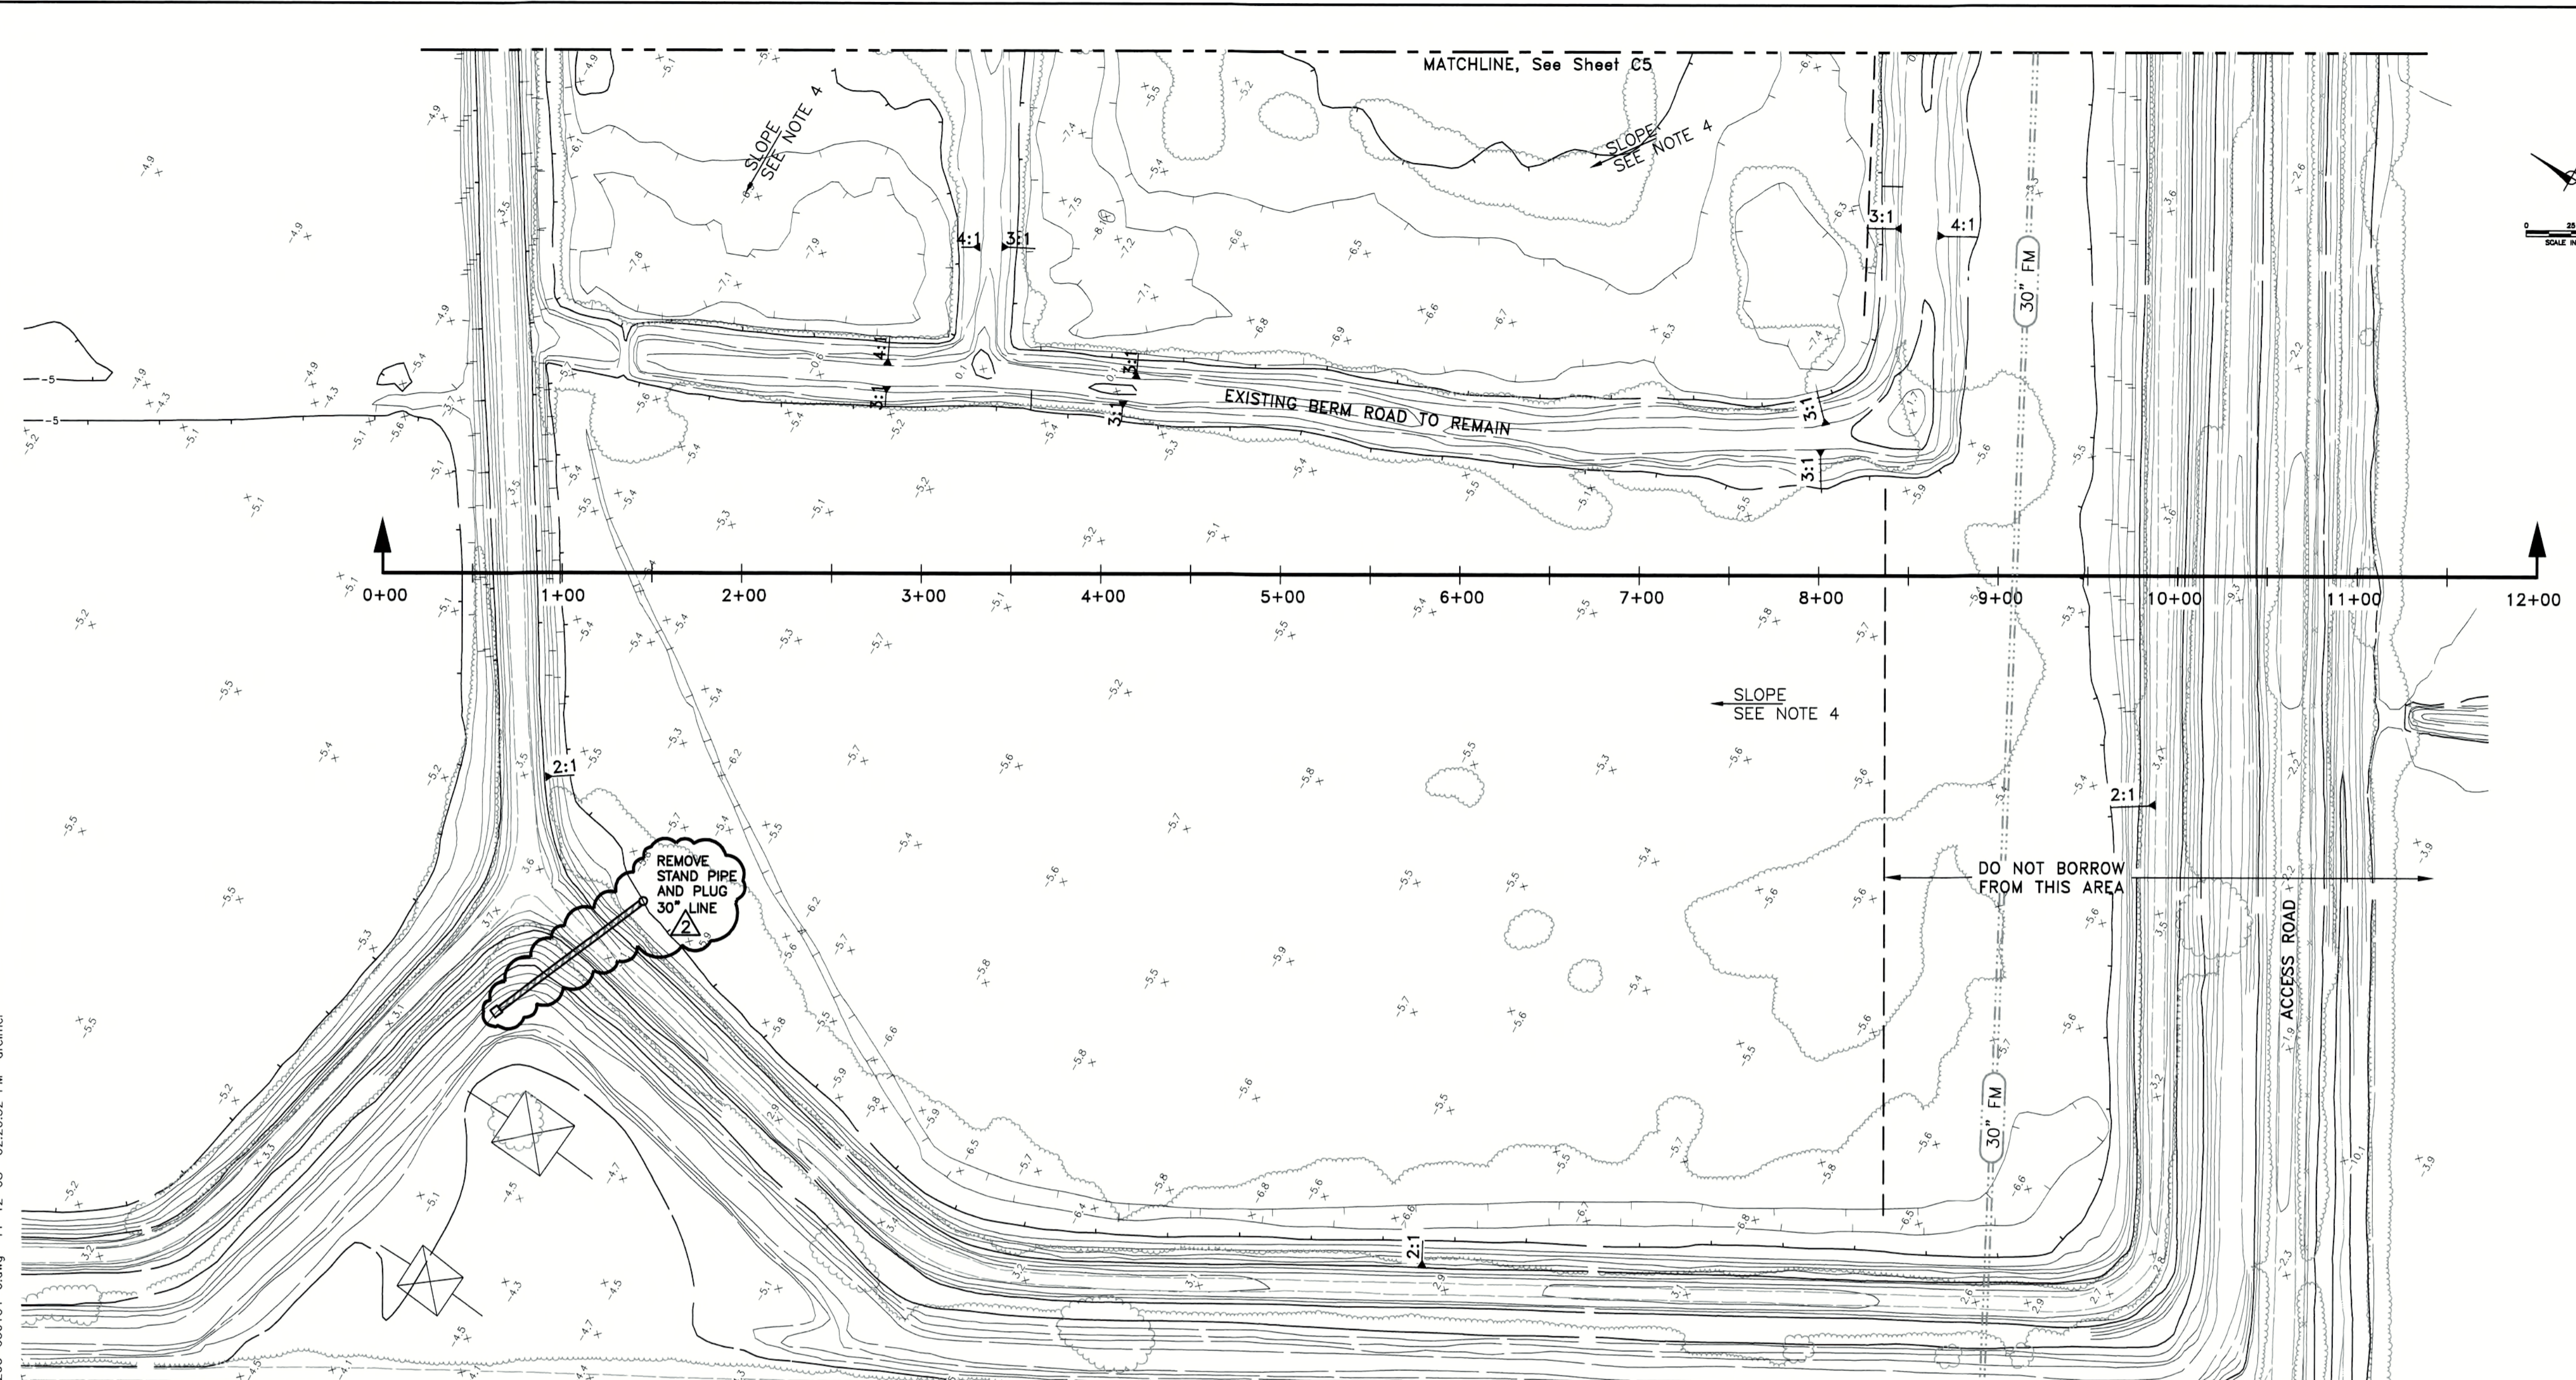

- NOTES:**
1. THE EXISTING BERMS WITHIN THE BORROW AREA SHALL NOT BE DISTURBED
 2. EXCAVATIONS SHALL BE NO CLOSER THAN 3 FEET FROM THE TOE OF EXISTING AND NEW BERMS. EXCAVATIONS SHALL BE SLOPED AWAY FROM THE BERM AT THE SAME SLOPE AS THE EXISTING SIDE SLOPE, AS INDICATED
 3. CONTRACTOR SHALL EXCAVATE NO MORE THAN 2 FEET BELOW ADJACENT GRADE AT A TIME
 4. FOLLOWING EXCAVATION THE FINISHED GRADE SHALL BE SLOPED AT NO MORE THAN 2% (WITH THE EXCEPTION OF MATCHING THE EXISTING BERM SIDE SLOPES)
 5. OWNER DOES NOT GUARANTEE DEPTH OF SUITABLE MATERIAL. CONTRACTOR SHALL CONDUCT INVESTIGATIONS AS NEEDED TO DETERMINE DEPTH OF SUITABLE MATERIAL. HANDLING OF UNSUITABLE MATERIAL AS REQUIRED SHALL BE INCLUDED IN THE BID PRICE
 6. CONTRACTOR SHALL CONSTRUCT ACCESS AS REQUIRED INTO THE BORROW AREA
 7. NO EXCAVATION IS ALLOWED WITHIN 25 FEET OF EXISTING 30" FM
 8. FINISH GRADING SHALL MAINTAIN EXISTING DRAINAGE WITHIN THE BORROW AREA
 9. THE EXISTING PONDS ARE LINED WITH RIP-RAP. CONTRACTOR SHALL REMOVE EXISTING RIP-RAP AND STOCKPILE IN A LOCATION ON THE 14 MILE SLOUGH PUMP STATION SITE AS DIRECTED IN THE FIELD BY THE ENGINEER.

PLAN
SCALE: 1"=50'

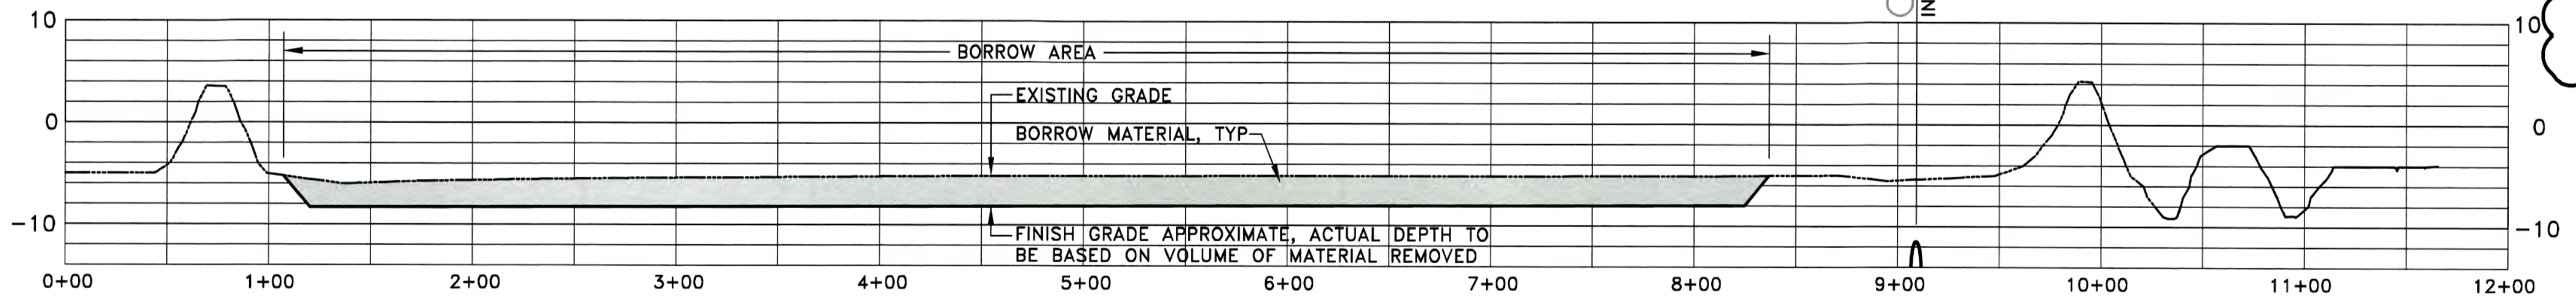

SECTION
SCALE HORIZONTAL: 1"=50'
VERTICAL: 1"=10'

RECORD DRAWINGS
14-Mile Slough Pump Station Upgrades

BORROW AREA
PLAN & SECTION 3

DEPARTMENT OF MUNICIPAL UTILITIES
CITY OF STOCKTON, CALIFORNIA

SCALE: AS SHOWN	APPROVED BY: DATE: _____	SHEET No.
DESIGNED BY: PDF	 ASSISTANT DIRECTOR, DEPT. OF MUNICIPAL UTILITIES	C6
DRAWN BY: DTD		11 of 89 SHEETS
CHECKED BY: GDH		PROJECT No. 293-00-05-01
RECORD Dwg.:		

Underground Service Alert

TWO DAYS BEFORE YOU DIG

Call TOLL FREE: 1-800-642-2444


REFER TO BID SET FOR SIGNATURE

No. 57272

REV. No.	DISCRPTION	DATE	BY	Appr'd By
1	ADDENDUM No. 3	5/28/06	TTT	PDF
2	RECORD DRAWINGS	6/08/06	CLB	PDF
3				
4				
5				
6				
7				

WEST YOST ASSOCIATES
Consulting Engineers

1260 Lake Boulevard
Suite 240
Davis, California 95616
(530) 756-5905
FAX (530) 756-5991

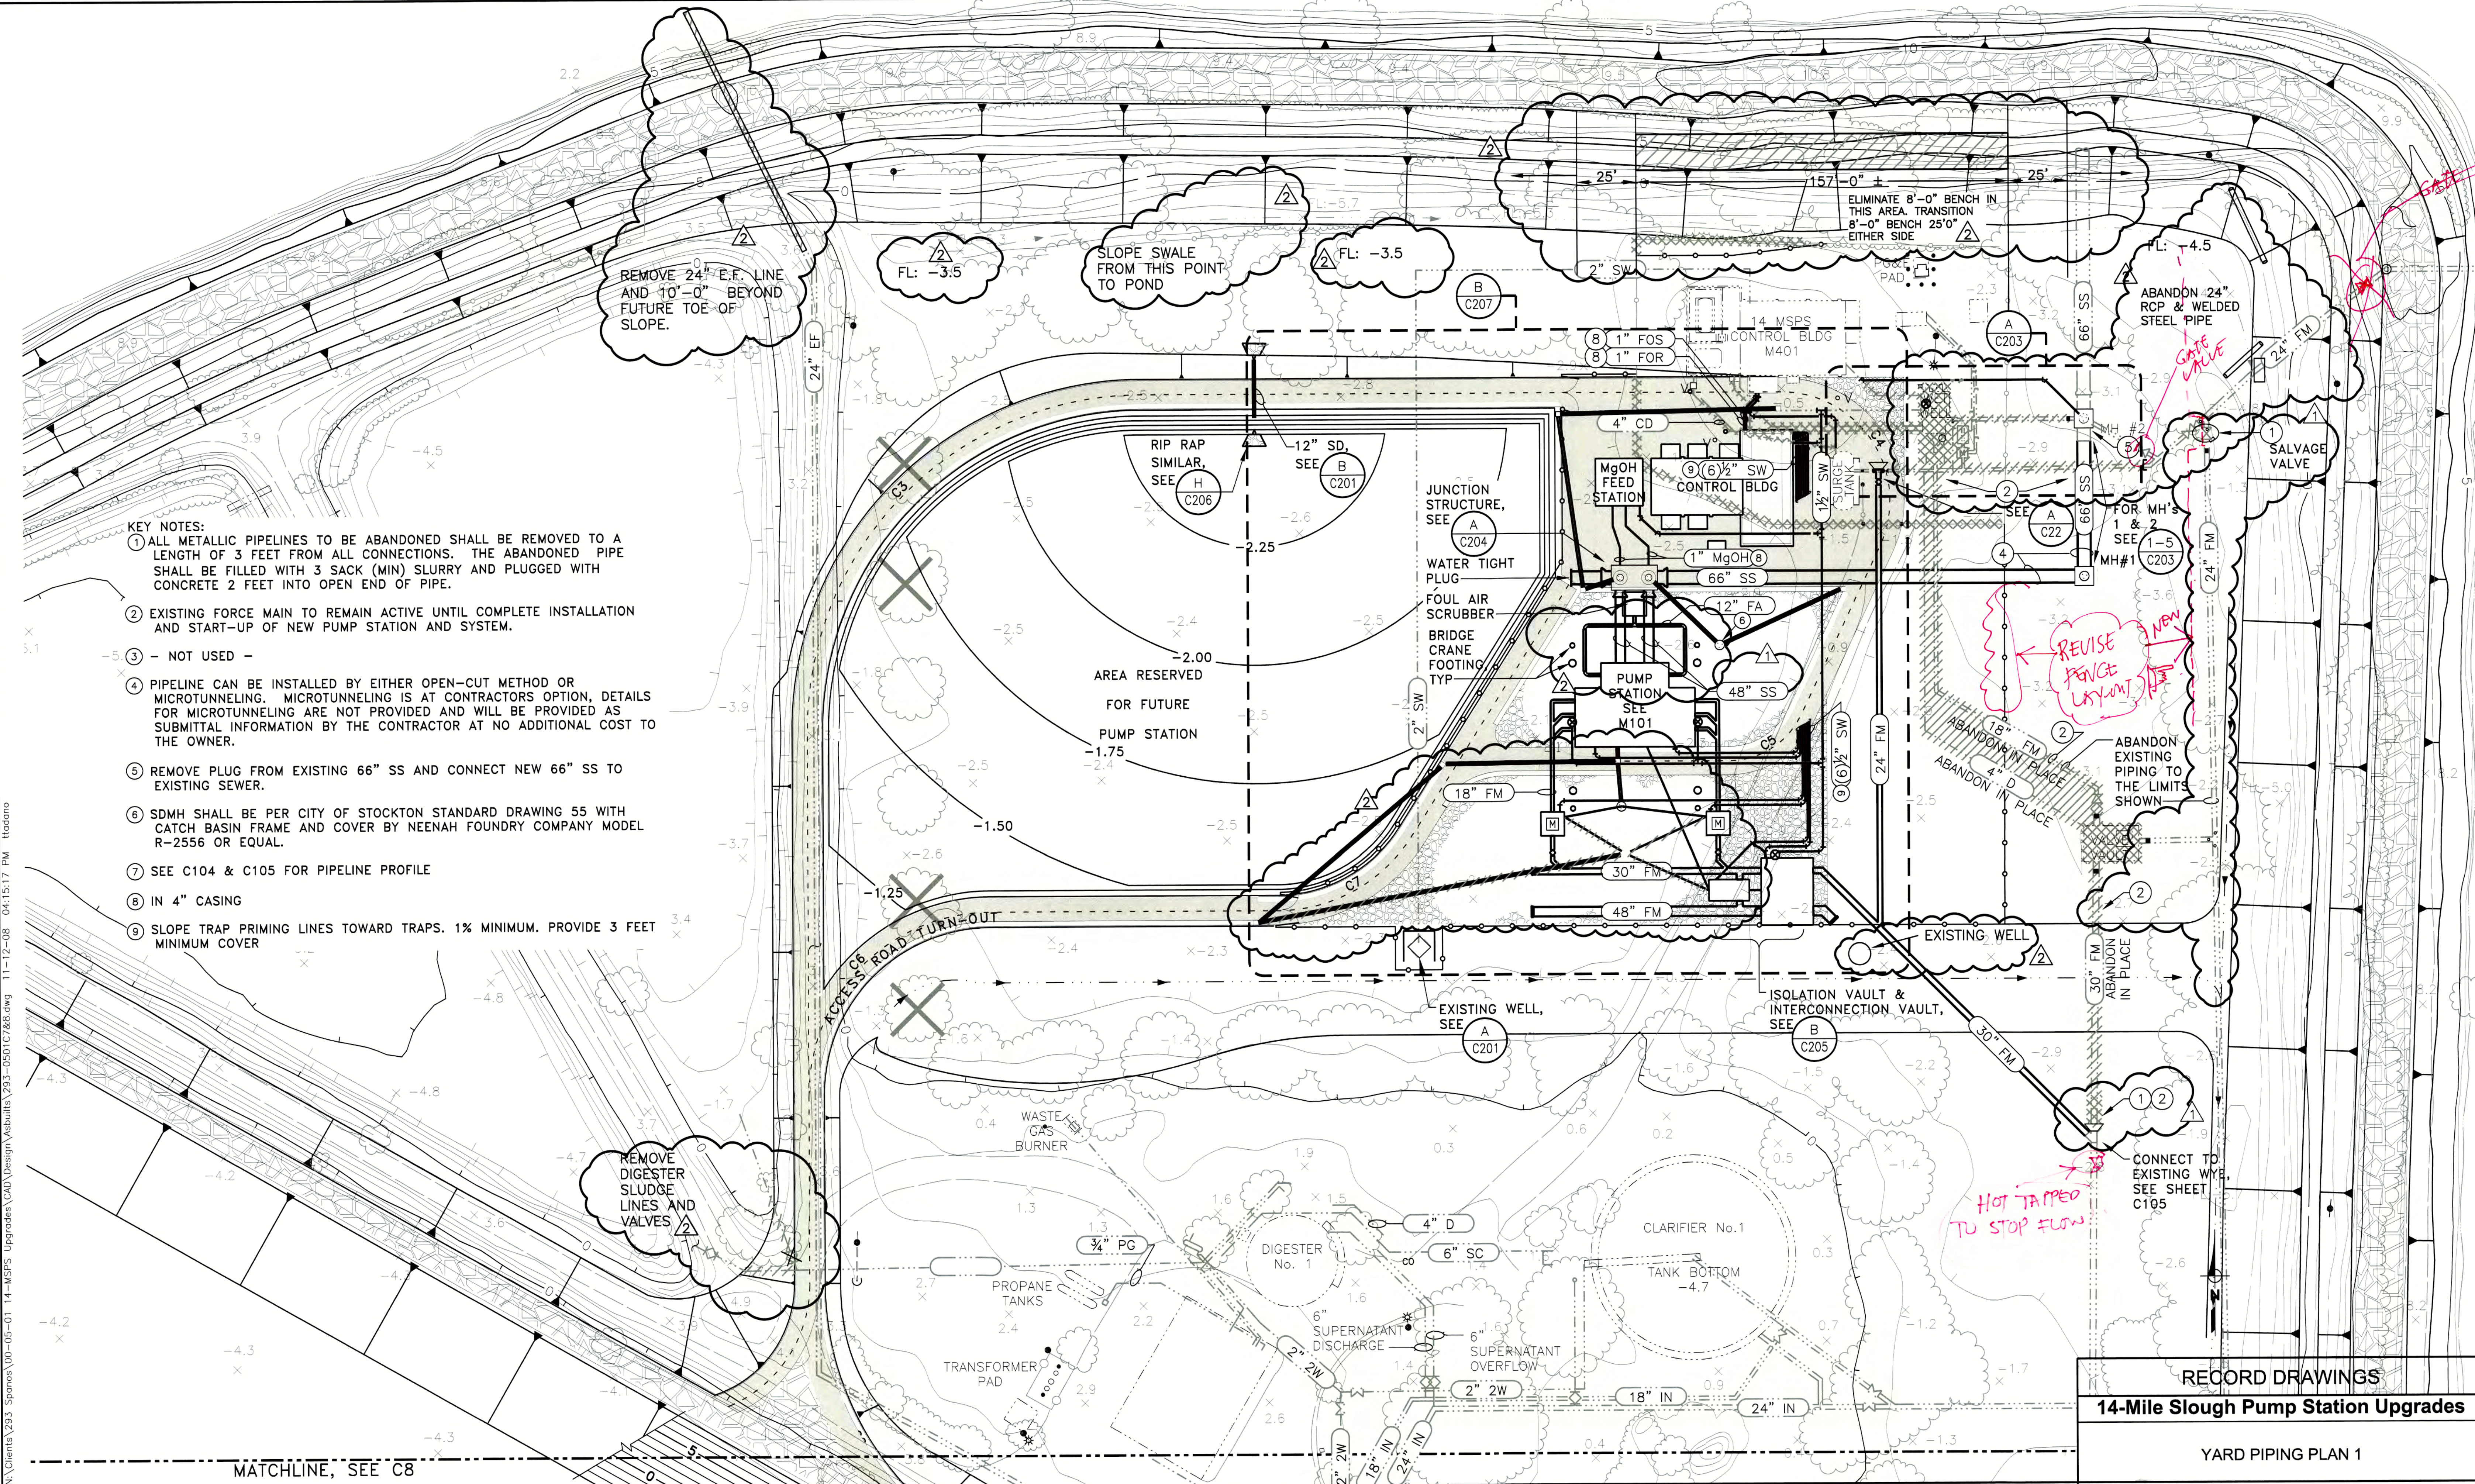

- KEY NOTES:**
- ① ALL METALLIC PIPELINES TO BE ABANDONED SHALL BE REMOVED TO A LENGTH OF 3 FEET FROM ALL CONNECTIONS. THE ABANDONED PIPE SHALL BE FILLED WITH 3 SACK (MIN) SLURRY AND PLUGGED WITH CONCRETE 2 FEET INTO OPEN END OF PIPE.
 - ② EXISTING FORCE MAIN TO REMAIN ACTIVE UNTIL COMPLETE INSTALLATION AND START-UP OF NEW PUMP STATION AND SYSTEM.
 - ③ - NOT USED -
 - ④ PIPELINE CAN BE INSTALLED BY EITHER OPEN-CUT METHOD OR MICROTUNNELING. MICROTUNNELING IS AT CONTRACTORS OPTION, DETAILS FOR MICROTUNNELING ARE NOT PROVIDED AND WILL BE PROVIDED AS SUBMITTAL INFORMATION BY THE CONTRACTOR AT NO ADDITIONAL COST TO THE OWNER.
 - ⑤ REMOVE PLUG FROM EXISTING 66" SS AND CONNECT NEW 66" SS TO EXISTING SEWER.
 - ⑥ SDMH SHALL BE PER CITY OF STOCKTON STANDARD DRAWING 55 WITH CATCH BASIN FRAME AND COVER BY NEENAH FOUNDRY COMPANY MODEL R-2556 OR EQUAL.
 - ⑦ SEE C104 & C105 FOR PIPELINE PROFILE
 - ⑧ IN 4" CASING
 - ⑨ SLOPE TRAP PRIMING LINES TOWARD TRAPS. 1% MINIMUM. PROVIDE 3 FEET MINIMUM COVER

REMOVE 24" E.F. LINE AND 10'-0" BEYOND FUTURE TOE OF SLOPE.

SLOPE SWALE FROM THIS POINT TO POND

ELIMINATE 8'-0" BENCH IN THIS AREA. TRANSITION 8'-0" BENCH 25'0" EITHER SIDE

ABANDON 24" RCP & WELDED STEEL PIPE

REVISE FENCE LAYOUT

HOT TAPPED TO STOP FLOW

CONNECT TO EXISTING WYE, SEE SHEET C105

MATCHLINE, SEE C8

RECORD DRAWINGS

14-Mile Slough Pump Station Upgrades

YARD PIPING PLAN 1

DEPARTMENT OF MUNICIPAL UTILITIES
CITY OF STOCKTON, CALIFORNIA

SCALE: 1"=30'	APPROVED BY: DATE: _____	SHEET No. C7
DESIGNED BY: PFD/TTT		12 of 89 SHEETS
DRAWN BY: DTD		PROJECT No. 293-00-05-01
CHECKED BY: GDH	ASSISTANT DIRECTOR, DEPT. OF MUNICIPAL UTILITIES	
RECORD Dwg.:		

Underground Service Alert

TWO DAYS BEFORE YOU DIG

Call TOLL FREE: 1-800-642-2444

REFER TO BID SET FOR SIGNATURE

REGISTRATION NO. 57272

REV. No.	DISCRPTION	DATE	BY	Appr'd By
1	ADDENDUM No.3	5/25/08	TTT	PDF
2	RECORD DRAWINGS	6/08	CLB	PDF
3				
4				
5				
6				
7				



WEST YOST ASSOCIATES

Consulting Engineers

1260 Lake Boulevard
Suite 240
Davis, California 95616
(530) 756-5905
FAX (530) 756-5991

N:\Client\293 Sponosa\00-05-01 14-MSPS Upgrades\CAD Design\Submittals\293-0501C7&8.dwg 11-12-08 04:15:17 PM tcdono

- KEY NOTES:
- ① PLUG EXISTING 30" & 21" CONNECTIONS IN DISTRIBUTION BOX WITH STEEL PLATES, SEE **A**
 - ② INSTALL NEW MANHOLE, SEE **B** **C207** **DELETE FROM CONTRACT**
 - ③ TRENCH DAM, SEE **J** **C206**
 - ④ FIELD CLOSURE PIPE CONNECTION, SEE **G** **C206**
 - ⑤ INSTALL TIDEFLEX CHECK VALVE ON ENDS OF PIPE & INSTALL RIP RAP AROUND PIPE OUTLET, TYP, SEE **H** **C206**
 - ⑥ INSTALL FLARED END SECTION PER **B** **C201** & RIP RAP PER **H** **C206**

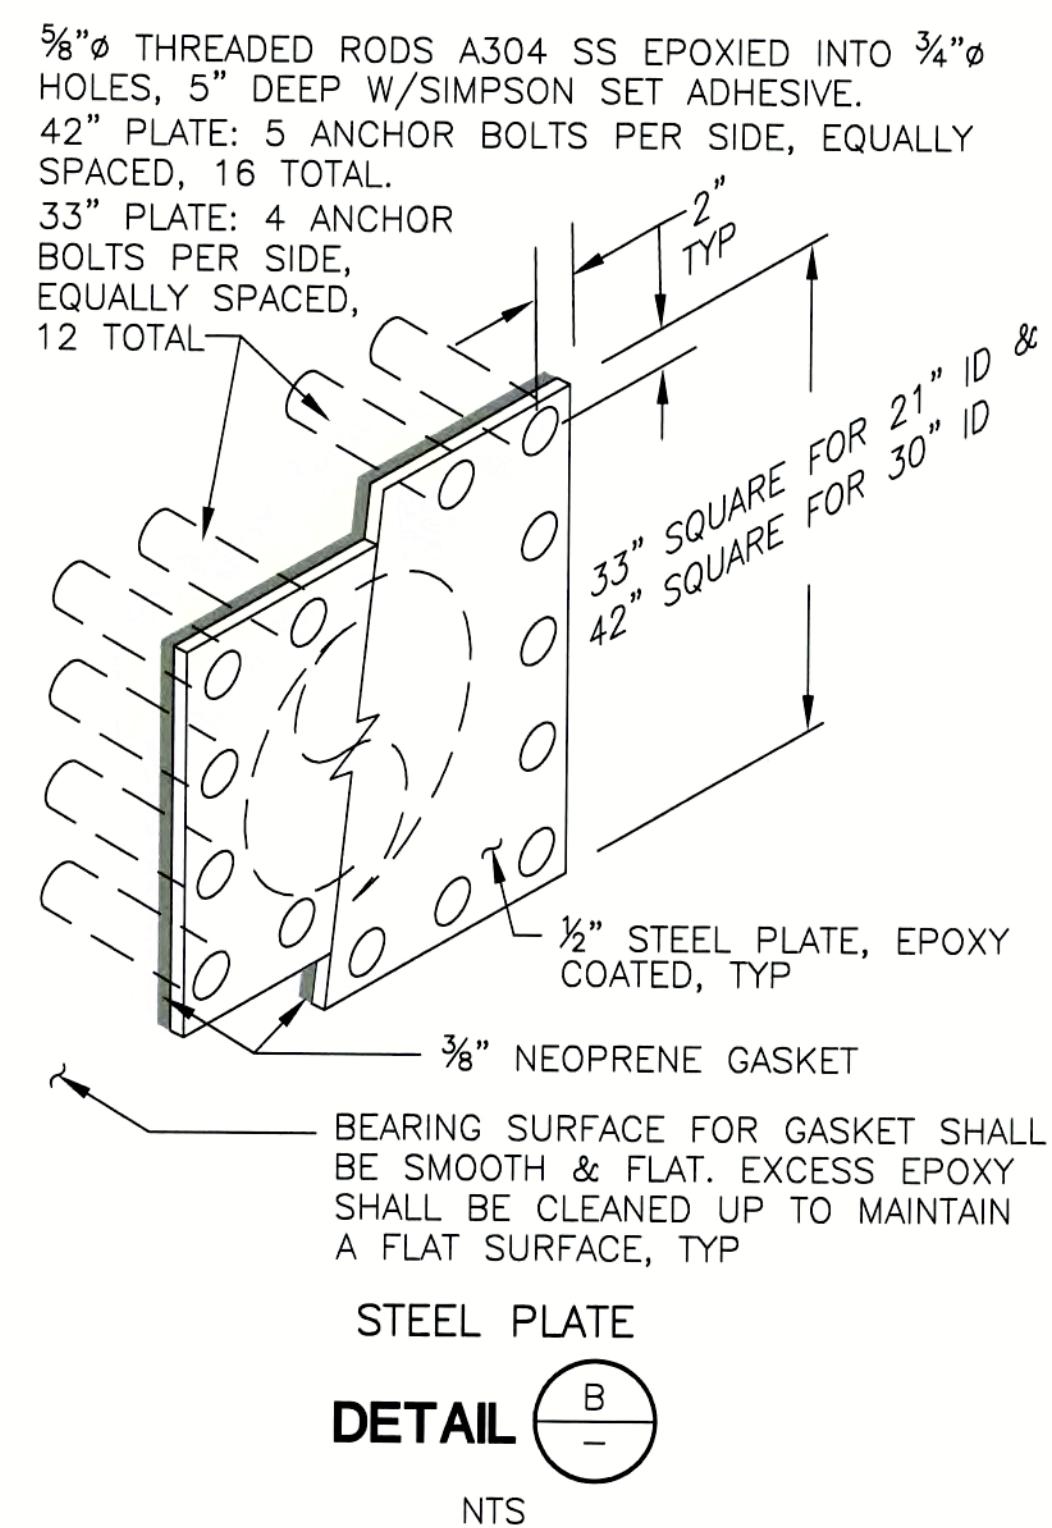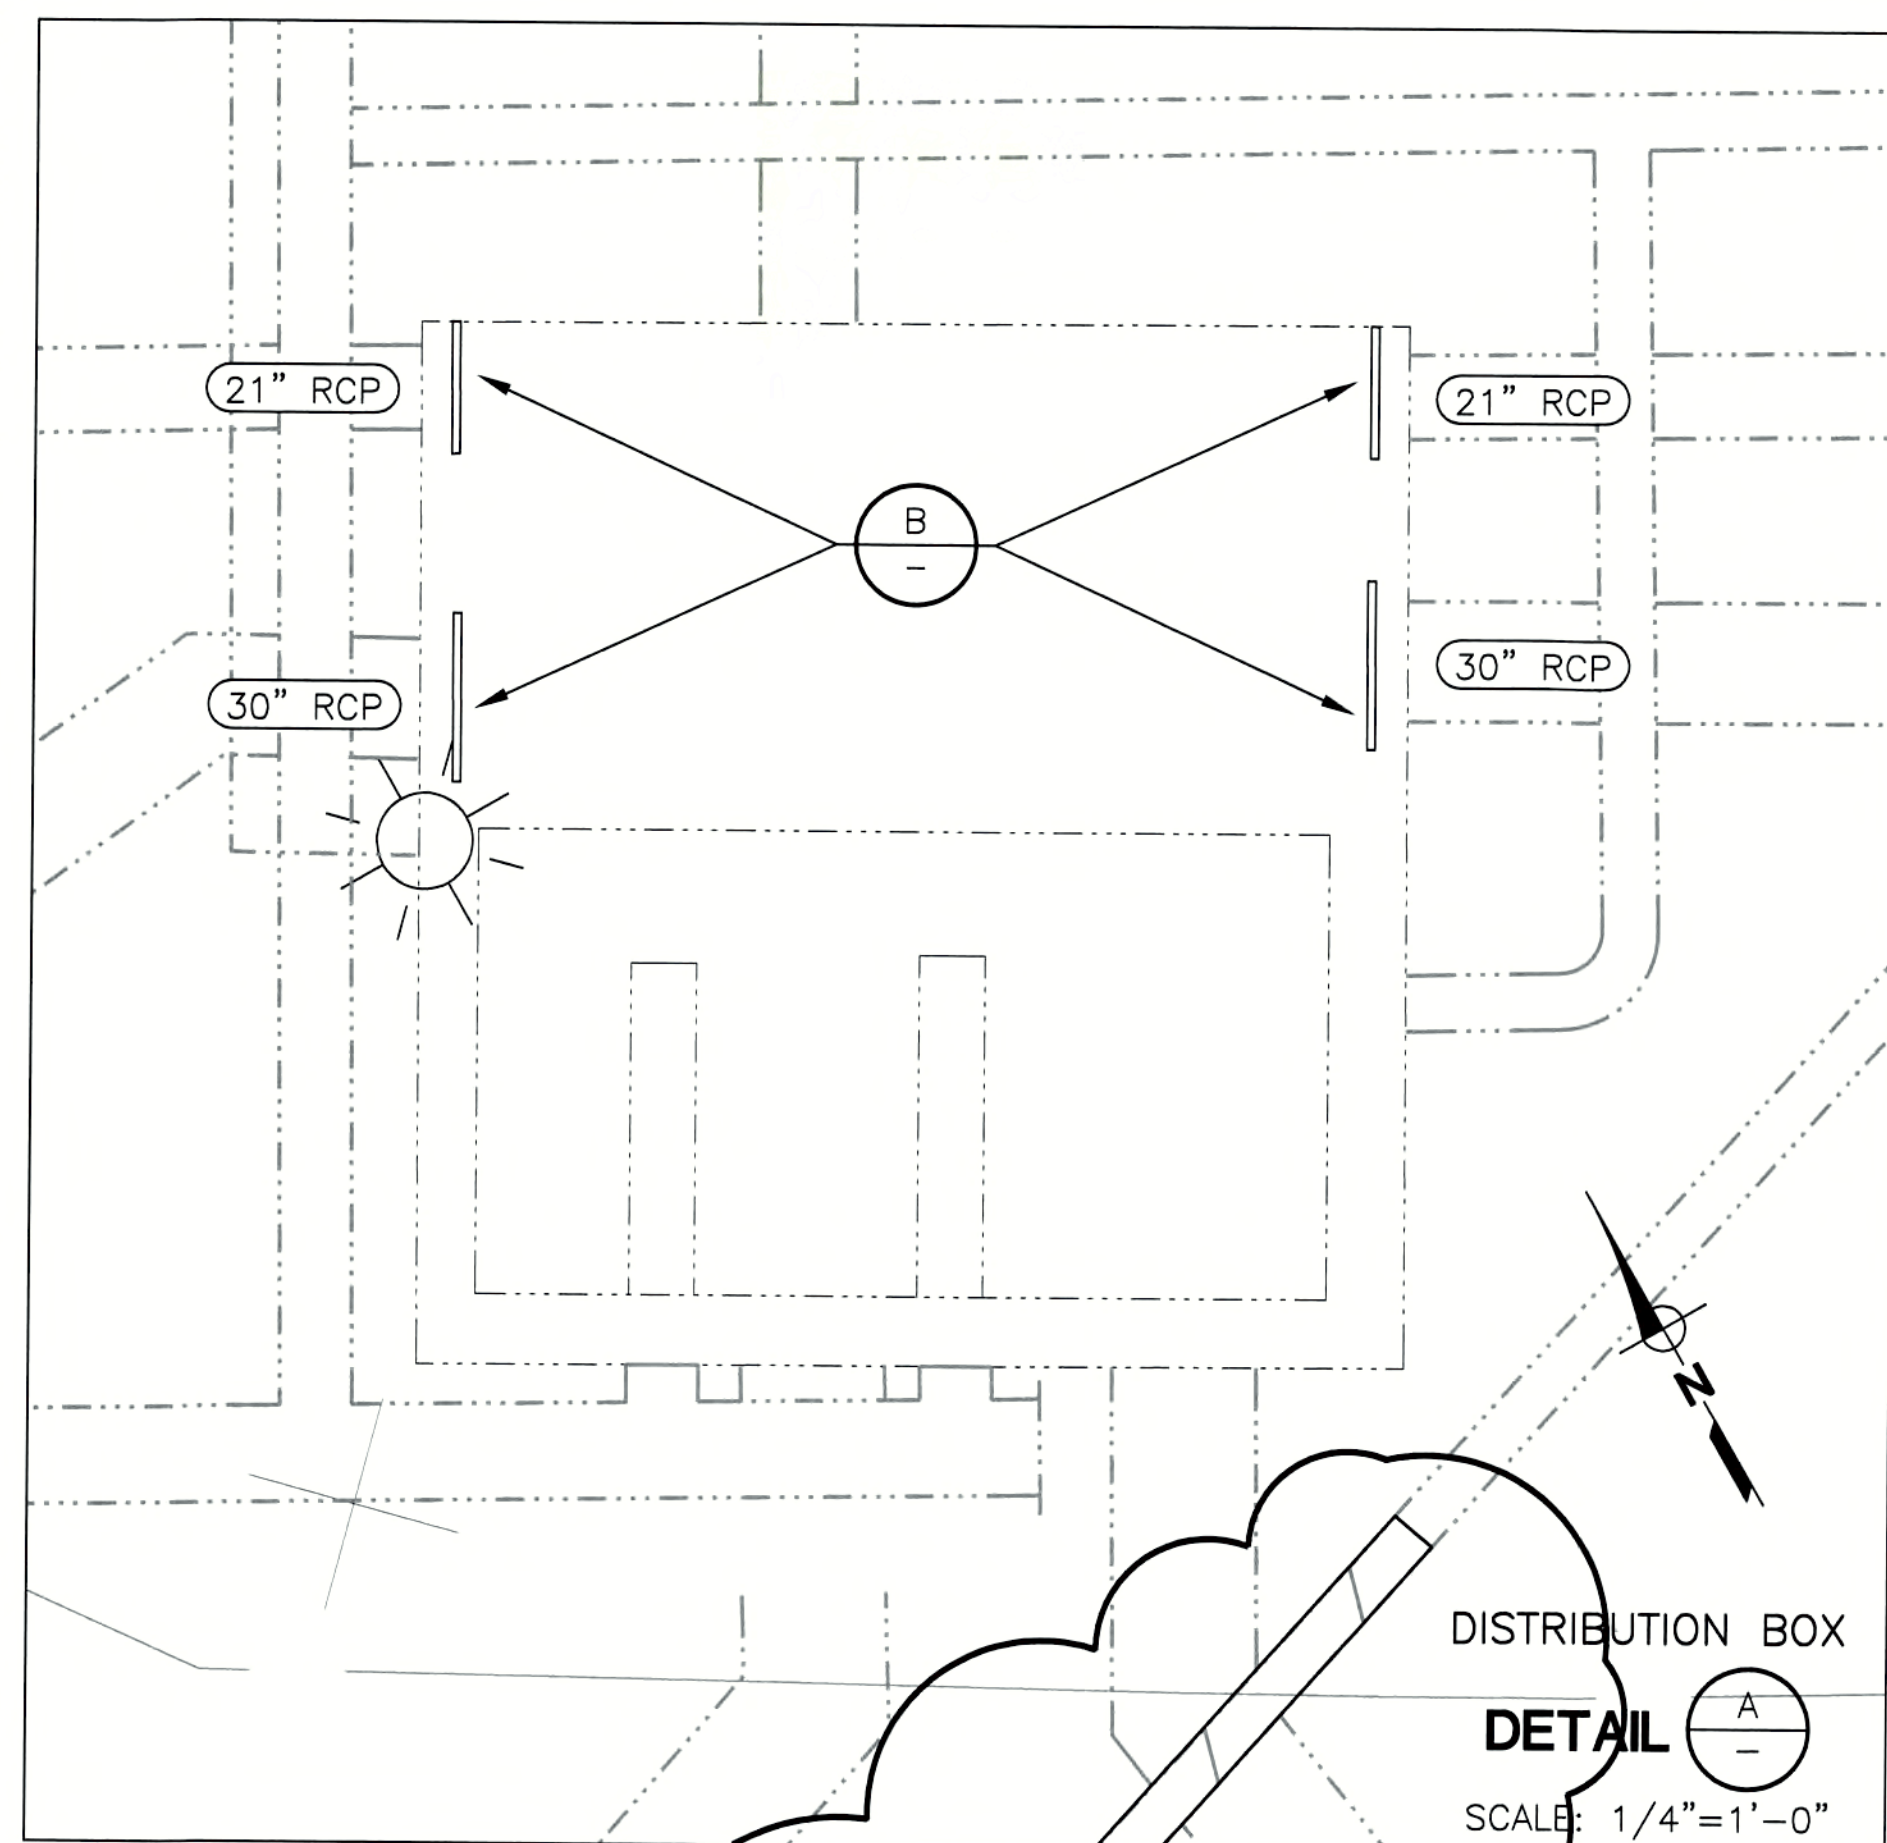

REFER TO SET FOR SIGNATURE


REV. No.	DESCRIPTION	DATE	BY	APR'D BY
1	RECORD DRAWINGS	6/08	CLB	PDF
2				
3				
4				
5				
6				
7				




1260 Lake Boulevard
Suite 240
Davis, California 95616
(530) 756-5905
FAX (530) 756-5991

RECORD DRAWINGS
14-Mile Slough Pump Station Upgrades
YARD PIPING PLAN 2


DEPARTMENT OF MUNICIPAL UTILITIES CITY OF STOCKTON, CALIFORNIA		SHEET No. C8
SCALE: 1"=30'	APPROVED BY: _____ DATE: _____	13 of 89 SHEETS
DESIGNED BY: PDF	ASSISTANT DIRECTOR, DEPT. OF MUNICIPAL UTILITIES	PROJECT No. 293-00-05-01
DRAWN BY: DTD		
CHECKED BY: GDH		
RECORD DWG.:		

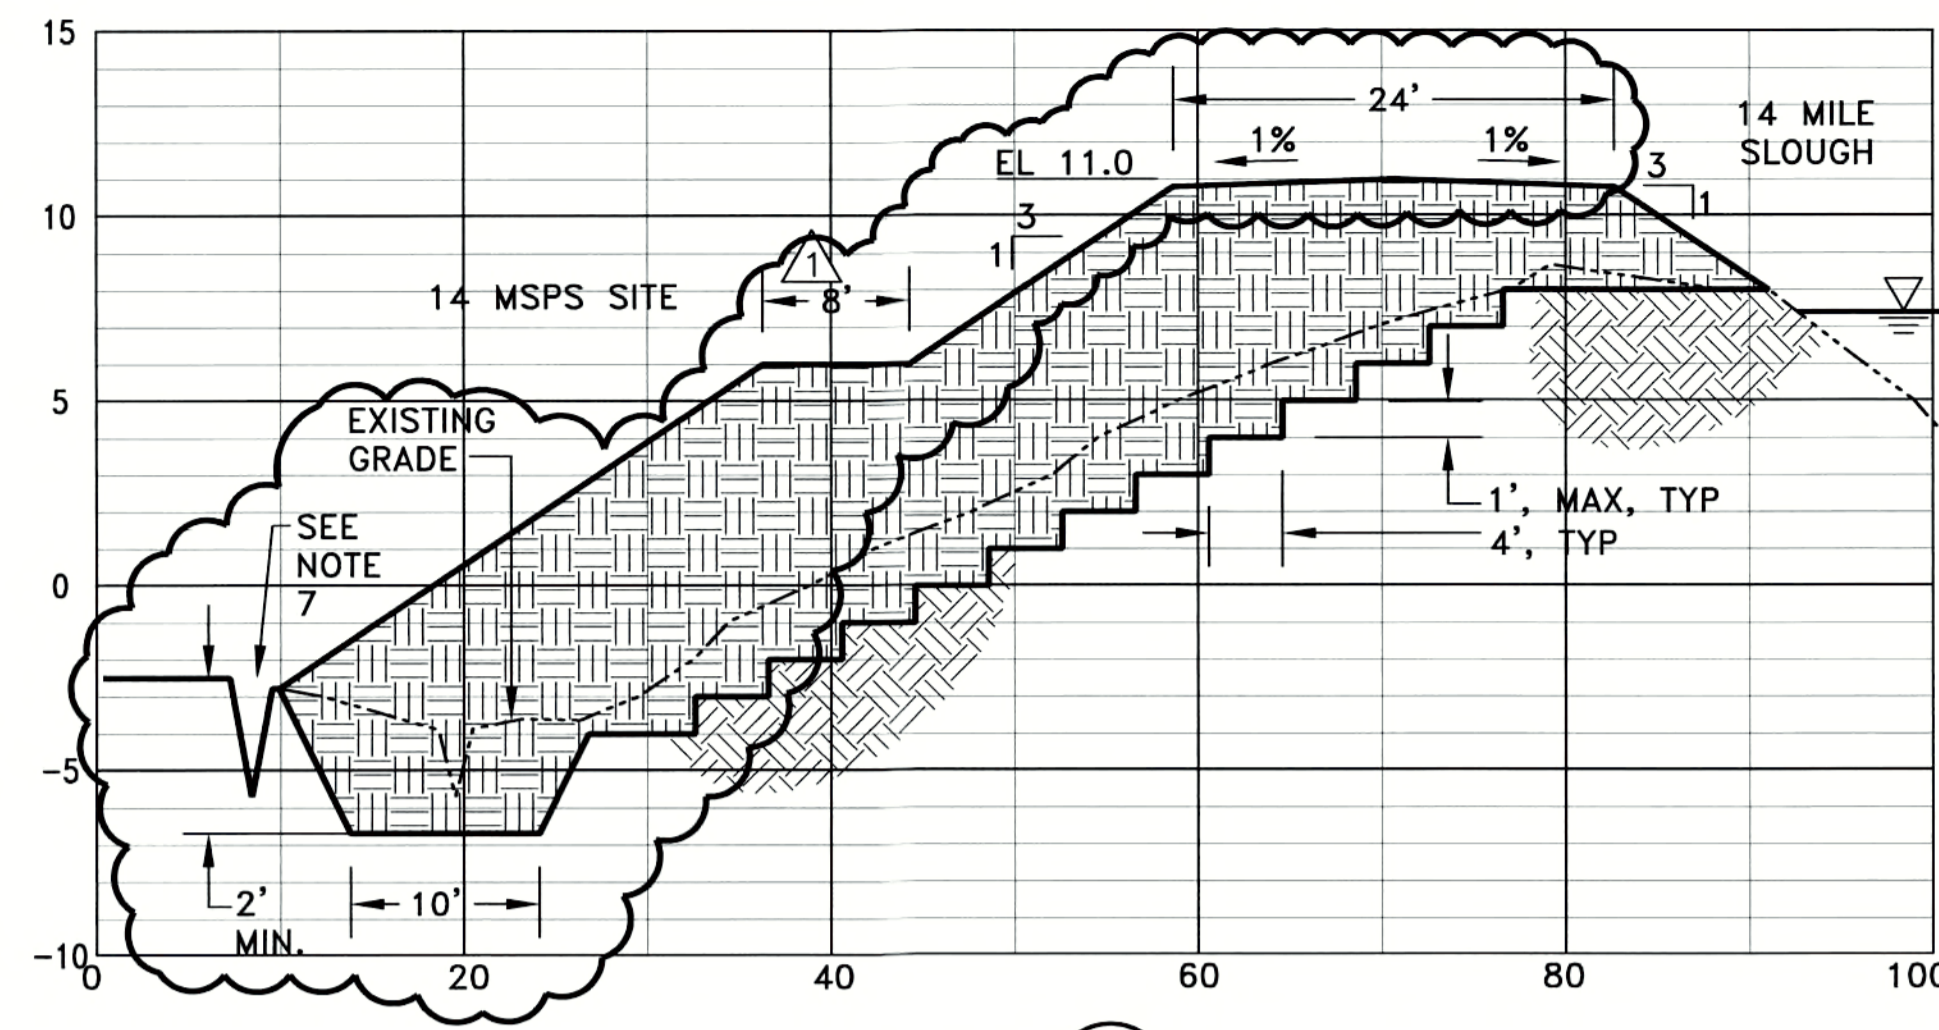


SECTION 1
C1
SCALE HORIZONTAL: 1"=10'
VERTICAL: 1"=5'

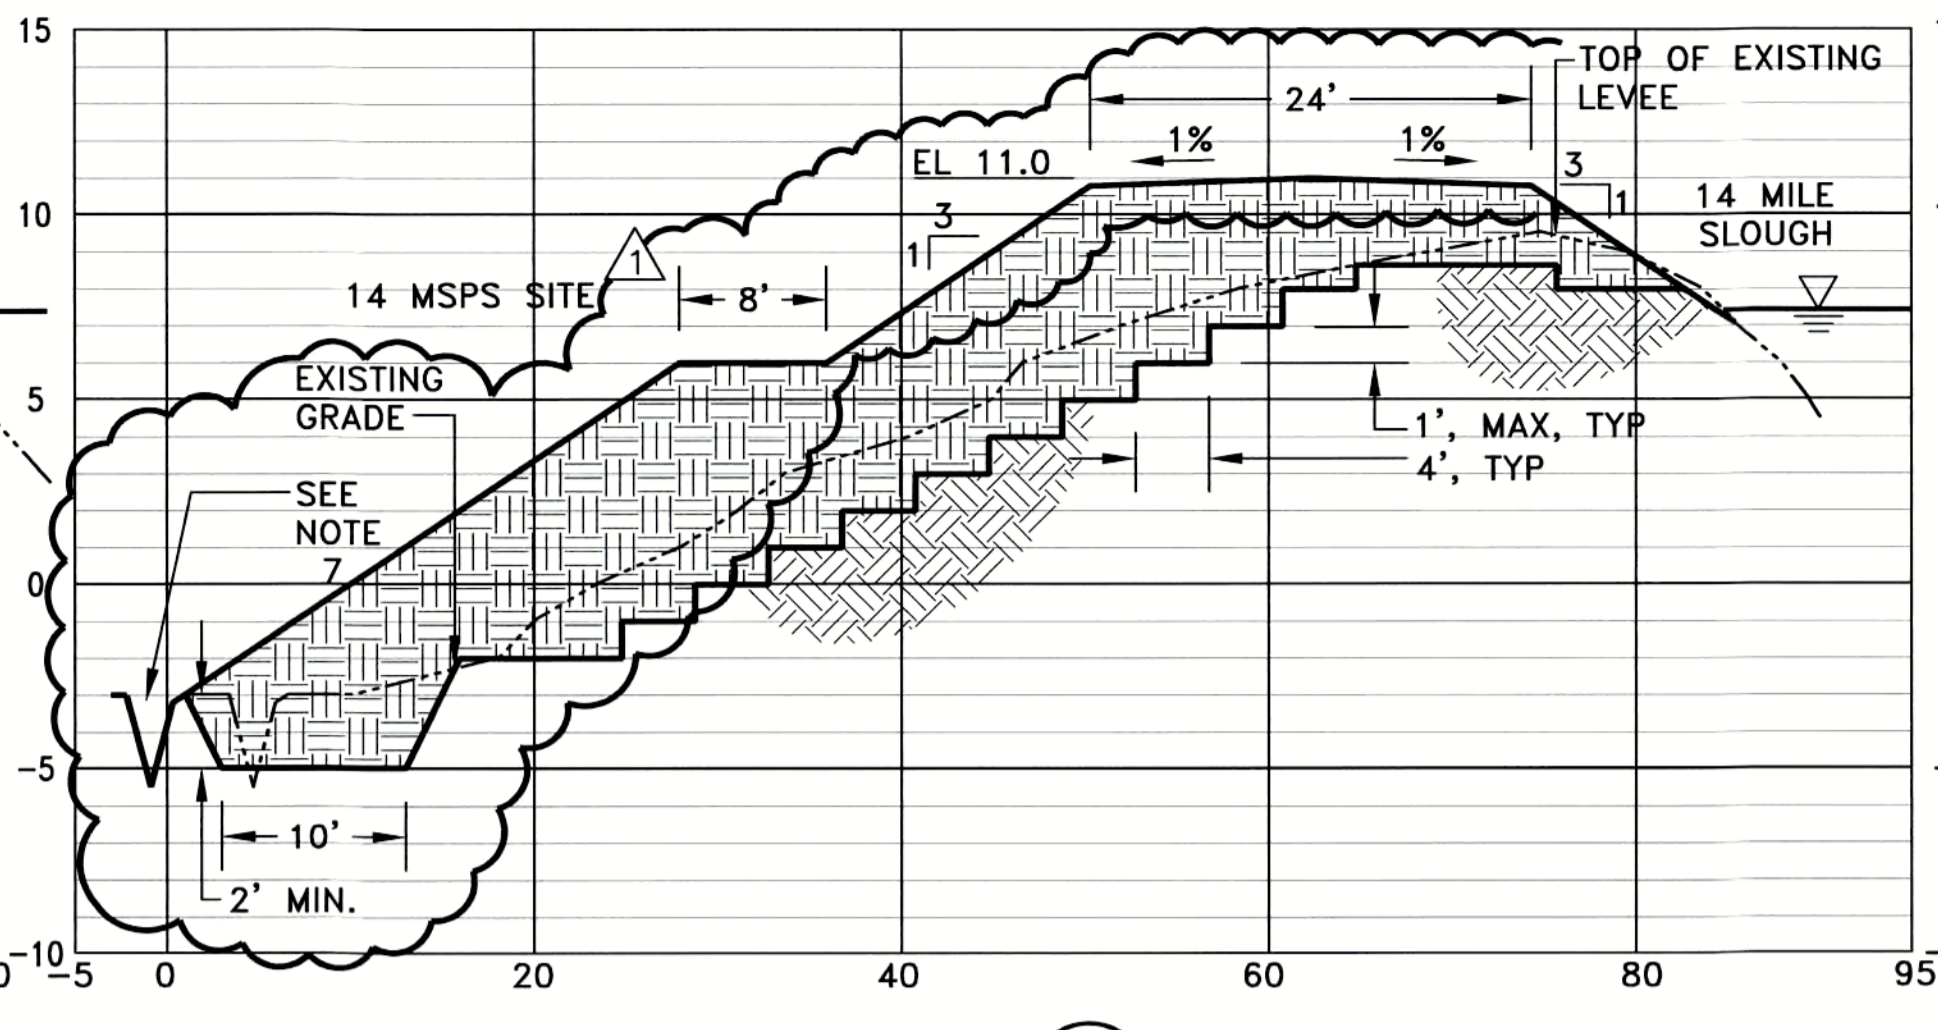


SECTION 4
C1
SCALE HORIZONTAL: 1"=10'
VERTICAL: 1"=5'

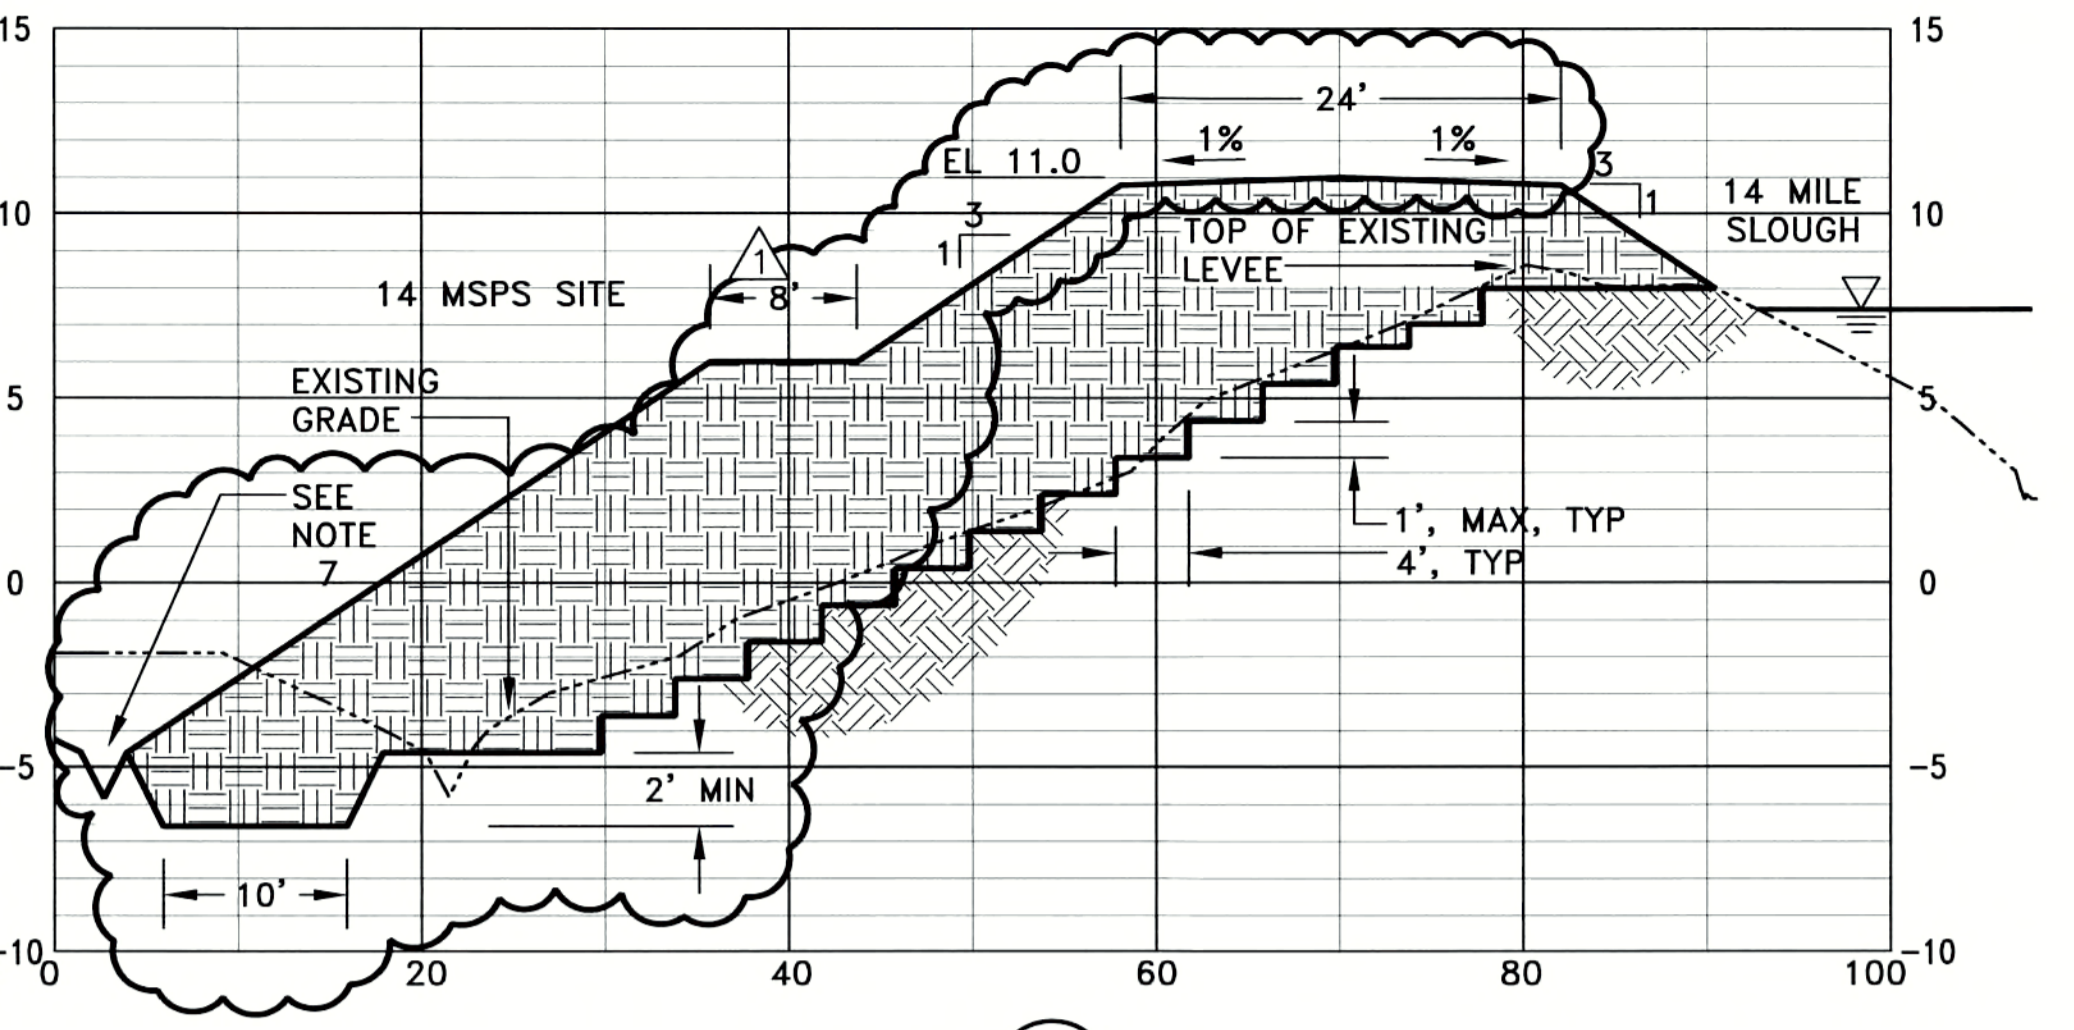


SECTION 7
C2
SCALE HORIZONTAL: 1"=10'
VERTICAL: 1"=5'

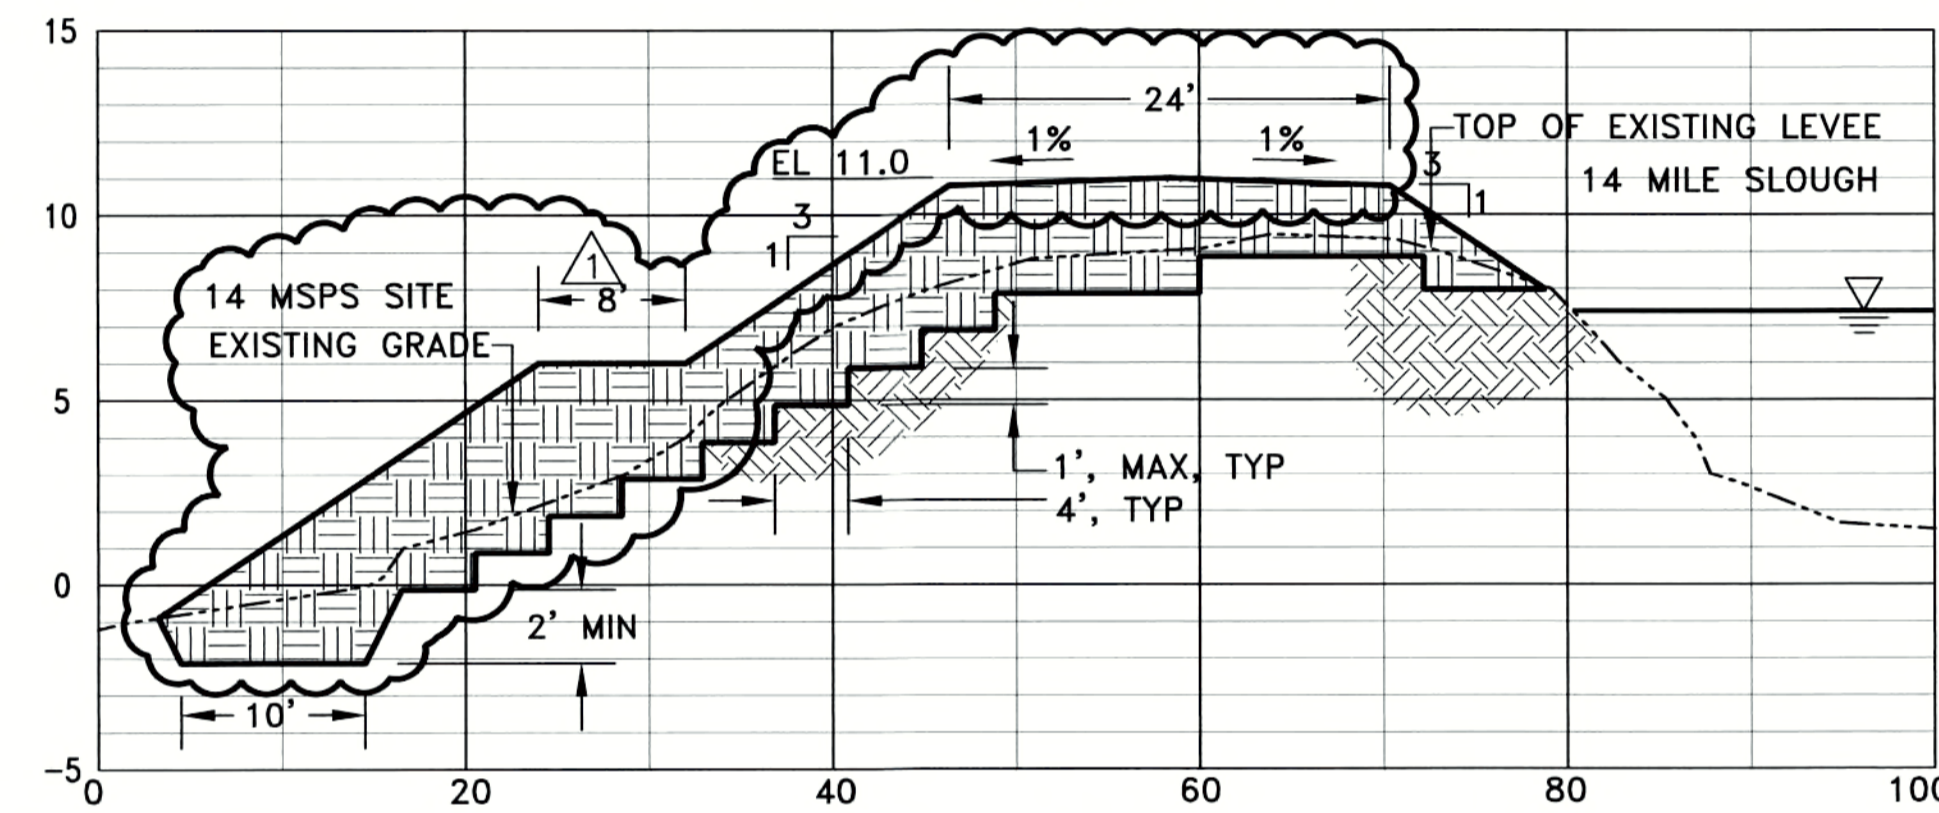


SECTION 2
C1
SCALE HORIZONTAL: 1"=10'
VERTICAL: 1"=5'

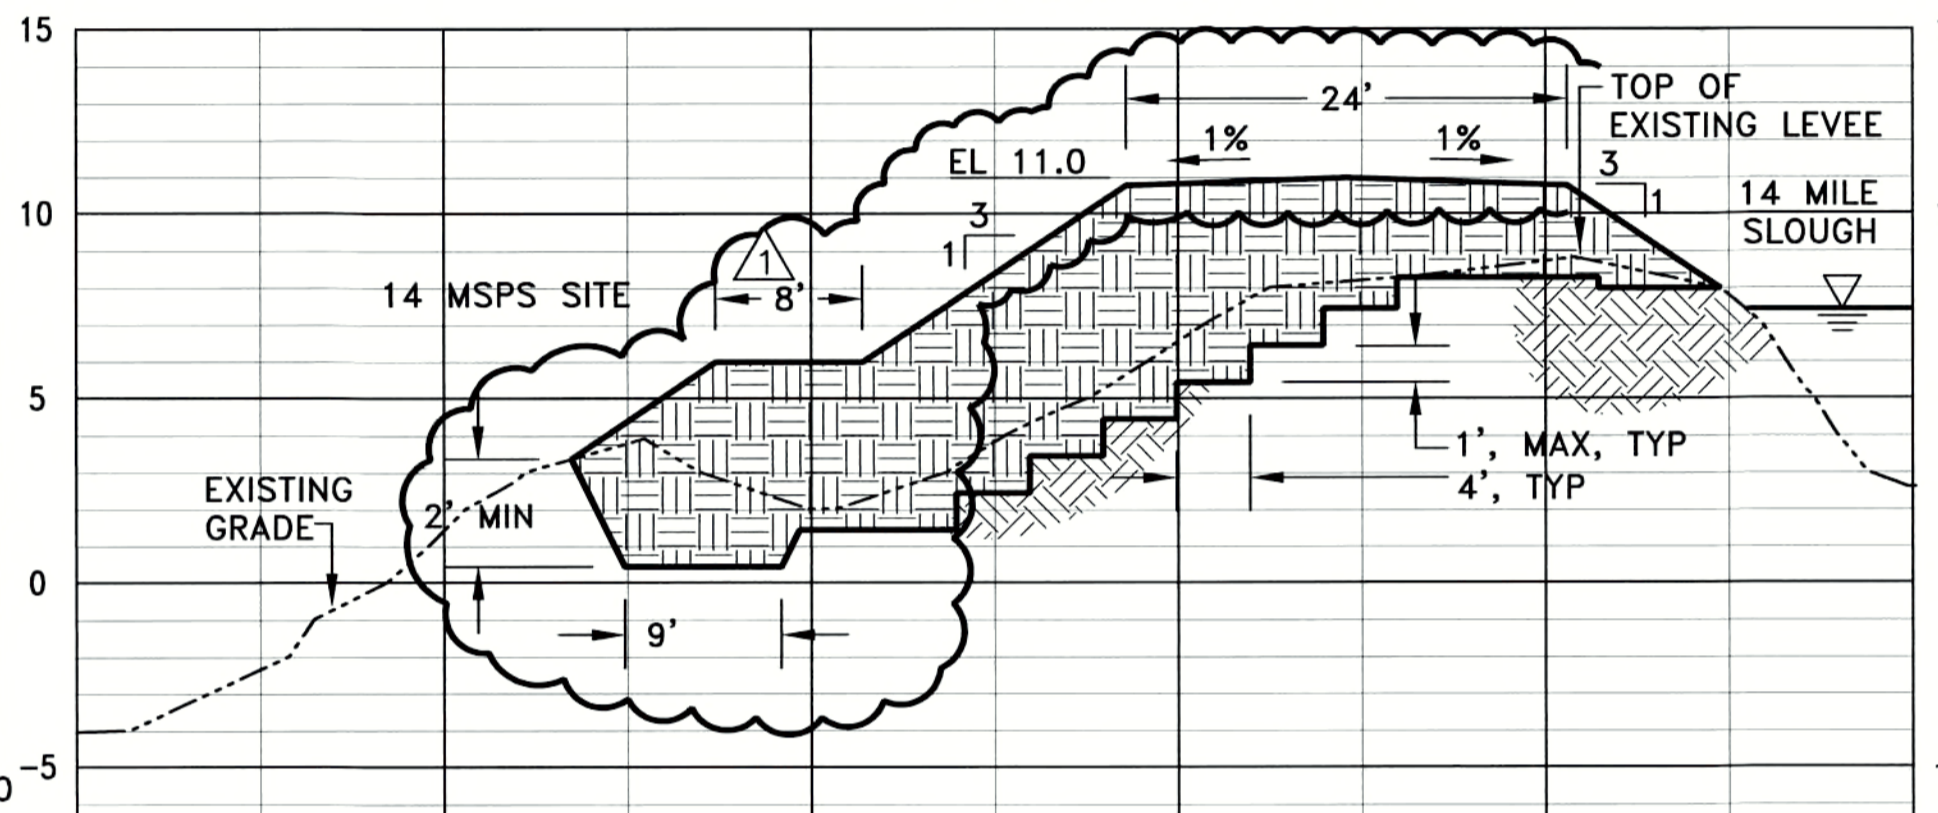


SECTION 5
C1
SCALE HORIZONTAL: 1"=10'
VERTICAL: 1"=5'

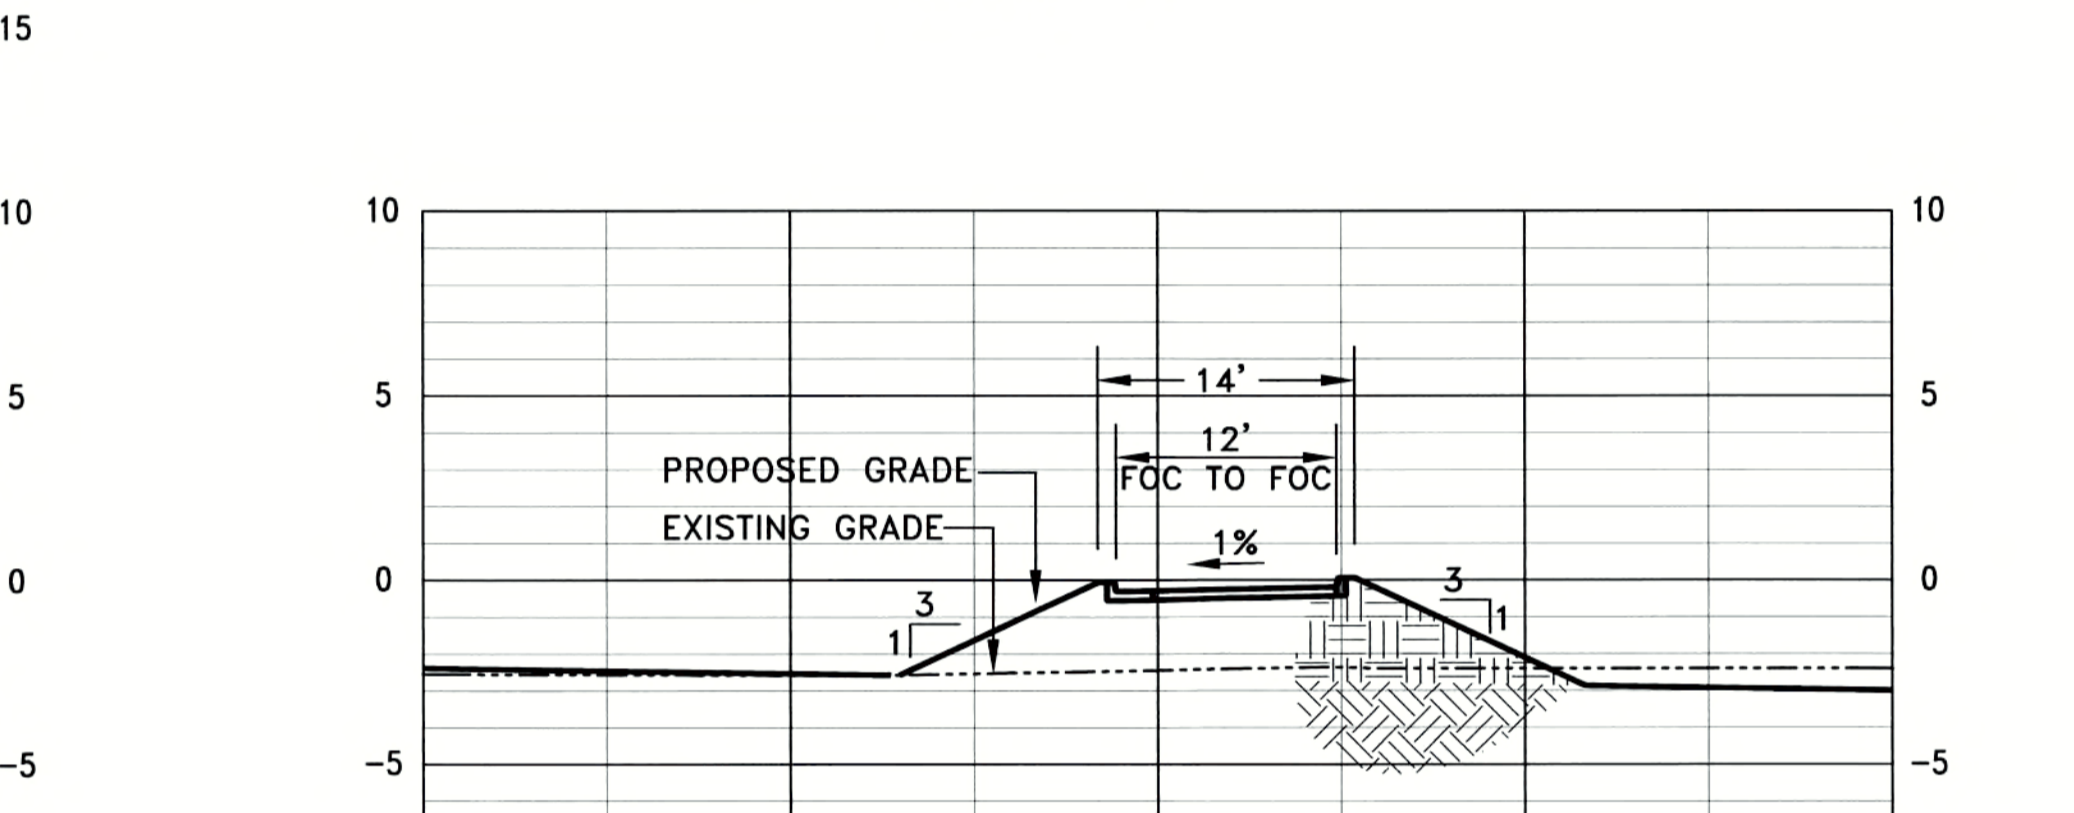

SECTION 8
C1
SCALE HORIZONTAL: 1"=10'
VERTICAL: 1"=5'

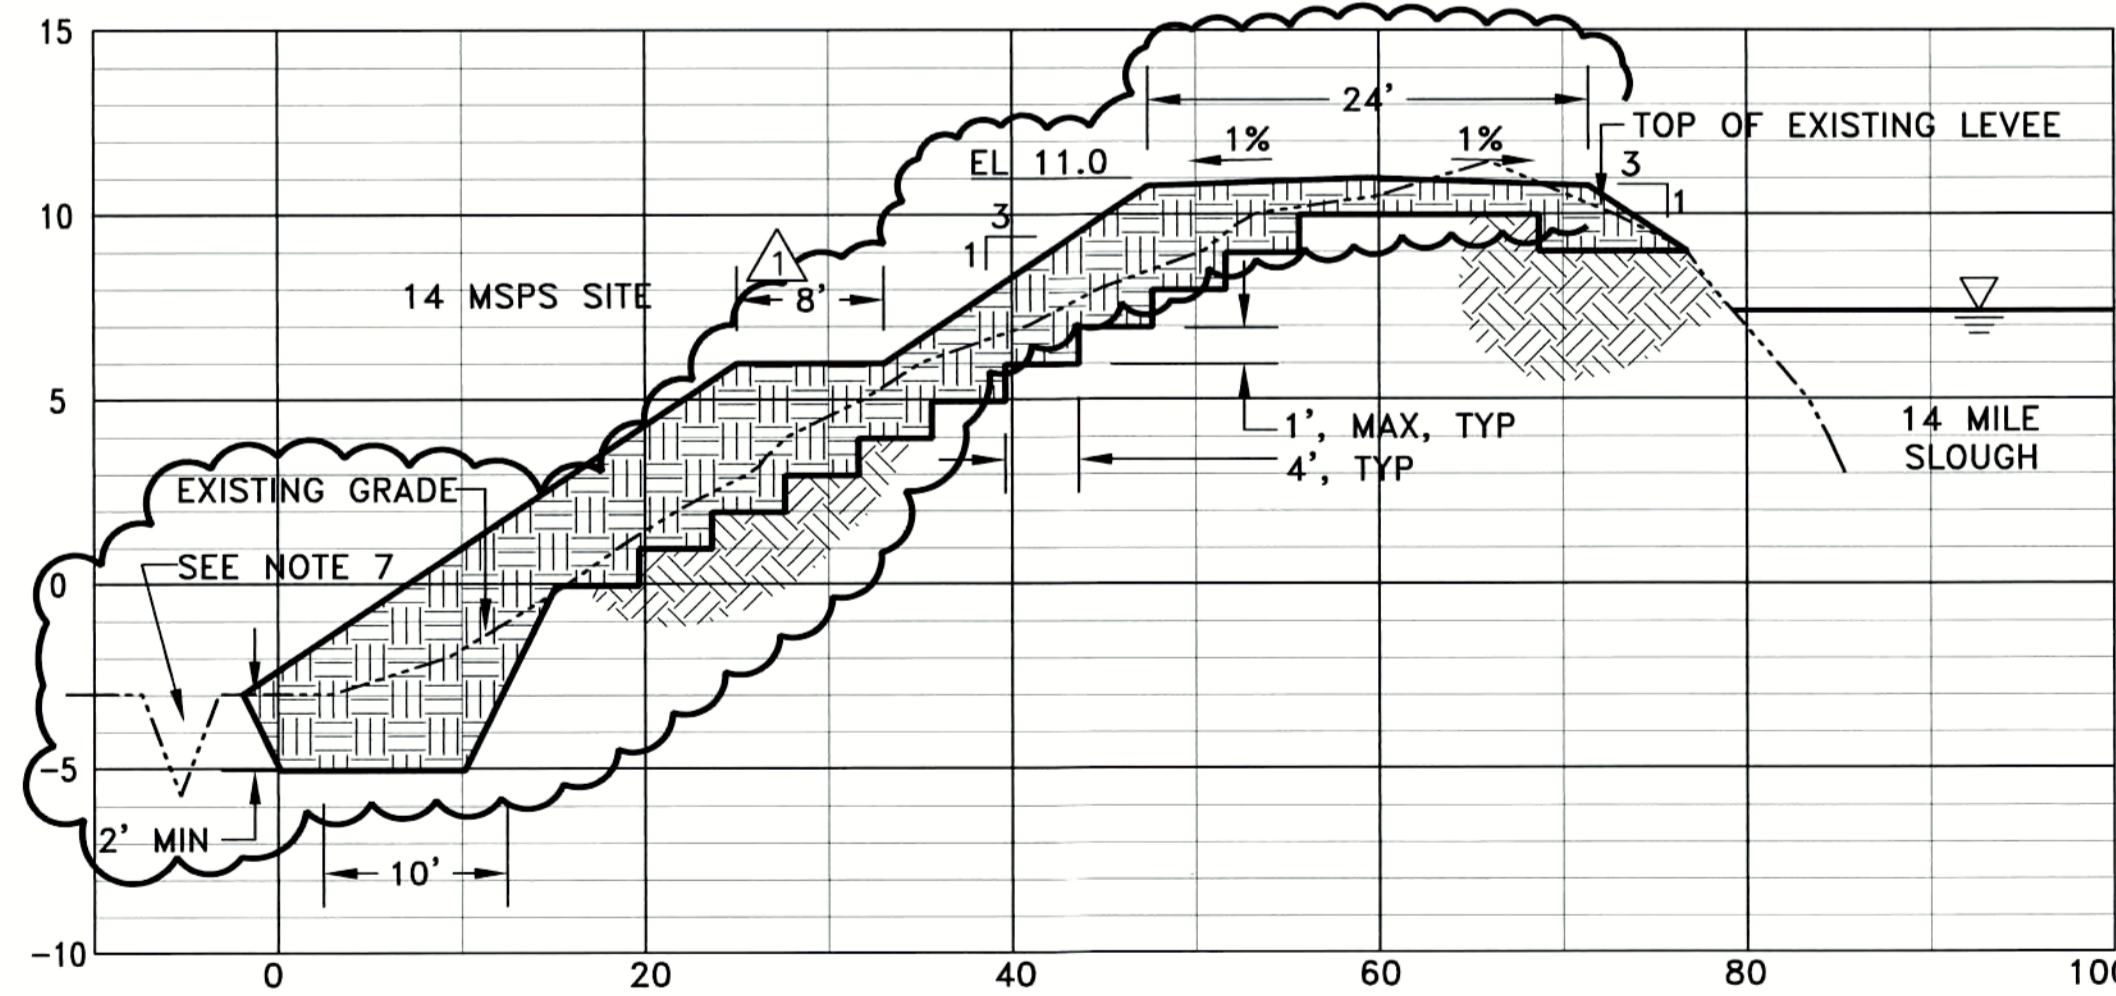

SECTION 3
C1
SCALE HORIZONTAL: 1"=10'
VERTICAL: 1"=5'

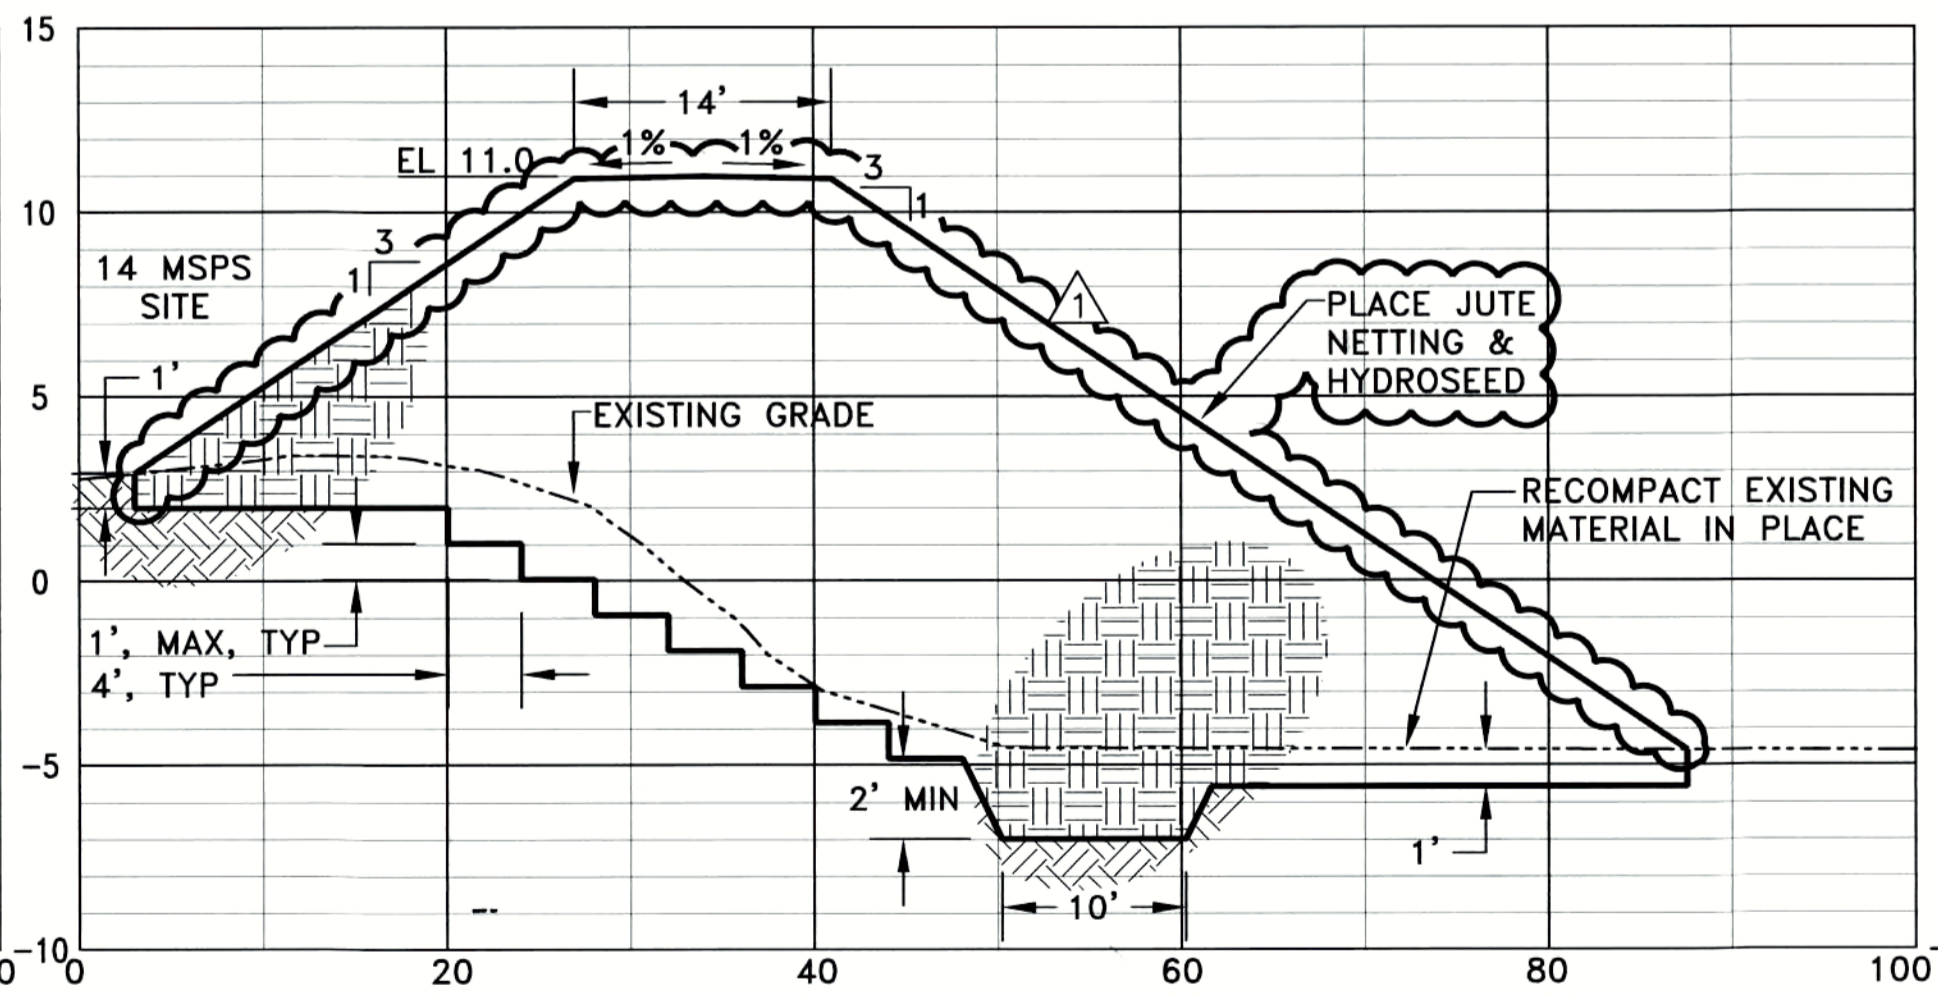

SECTION 6
C2
SCALE HORIZONTAL: 1"=10'
VERTICAL: 1"=5'

- NOTES:
- CONSTRUCTION ON SIDE SLOPE OF LEVEE SHALL CONSIST OF MINIMUM 4 FOOT HORIZONTAL AND MAXIMUM 1 FOOT DEEP BENCHES. BENCHING LIMITS MAY BE ALTERED IN THE FIELD WITH ENGINEER APPROVAL
 - LEVEE CONSTRUCTION SHALL CONFORM TO SPECIAL PROVISIONS AND/OR SPECIFICATIONS
 - NOT USED -
 - SEE A/C102 FOR TOP OF LEVEE DETAILS FOR SECTION 1-5&7
 - SEE B/C102 FOR TOP OF LEVEE DETAILS FOR SECTION 6
 - SEE C/C102 FOR TOP OF LEVEE DETAILS FOR SECTION 8
 - CUT AS NECESSARY TO MAINTAIN EXISTING DRAINAGE SWALE
 - EXISTING LEVEE HAS 6" GRAVEL ROAD. REMOVE GRAVEL PRIOR TO ADDING FILL. EXISTING GRAVEL MAY BE REUSED
 - NO WORK IS PERMITTED ON EXISTING LEVEE BETWEEN NOVEMBER 15 & APRIL 1

LEGEND:
100 YEAR HIGH WATER ELEVATION= 7.4 PER RD2119

RECORD DRAWINGS
14-Mile Slough Pump Station Upgrades
CIVIL SECTIONS 1

DEPARTMENT OF MUNICIPAL UTILITIES CITY OF STOCKTON, CALIFORNIA		SCALE: AS SHOWN	APPROVED BY: DATE:	SHEET No.
DESIGNED BY: PDF/TTT	DRAWN BY: DTD	CHECKED BY: GDH	RECORD Dwg.:	C101
ASSISTANT DIRECTOR, DEPT. OF MUNICIPAL UTILITIES			14 of 89 SHEETS	
			PROJECT No. 293-00-05-01	


N:\Clients\293 - Spomas\00-05-01-14-MSPS Upgrades\CAD\Design\Submitt\293-0501C101&102.dwg 11-13-08 09:16:41 AM aremer

Underground Service Alert
TWO DAYS BEFORE YOU DIG
Call TOLL FREE: 1-800-642-2444


REFER TO BID SET FOR SIGNATURE

REV. No.	DISCUSSION	DATE	BY	Apr'd By
1	ADDENDUM No. 3	5/25/06	TTT	PDF
2				
3				
4				
5				
6				


WEST YOST ASSOCIATES
Consulting Engineers
1260 Lake Boulevard
Suite 240
Davis, California 95616
(530) 756-5905
FAX (530) 756-5991

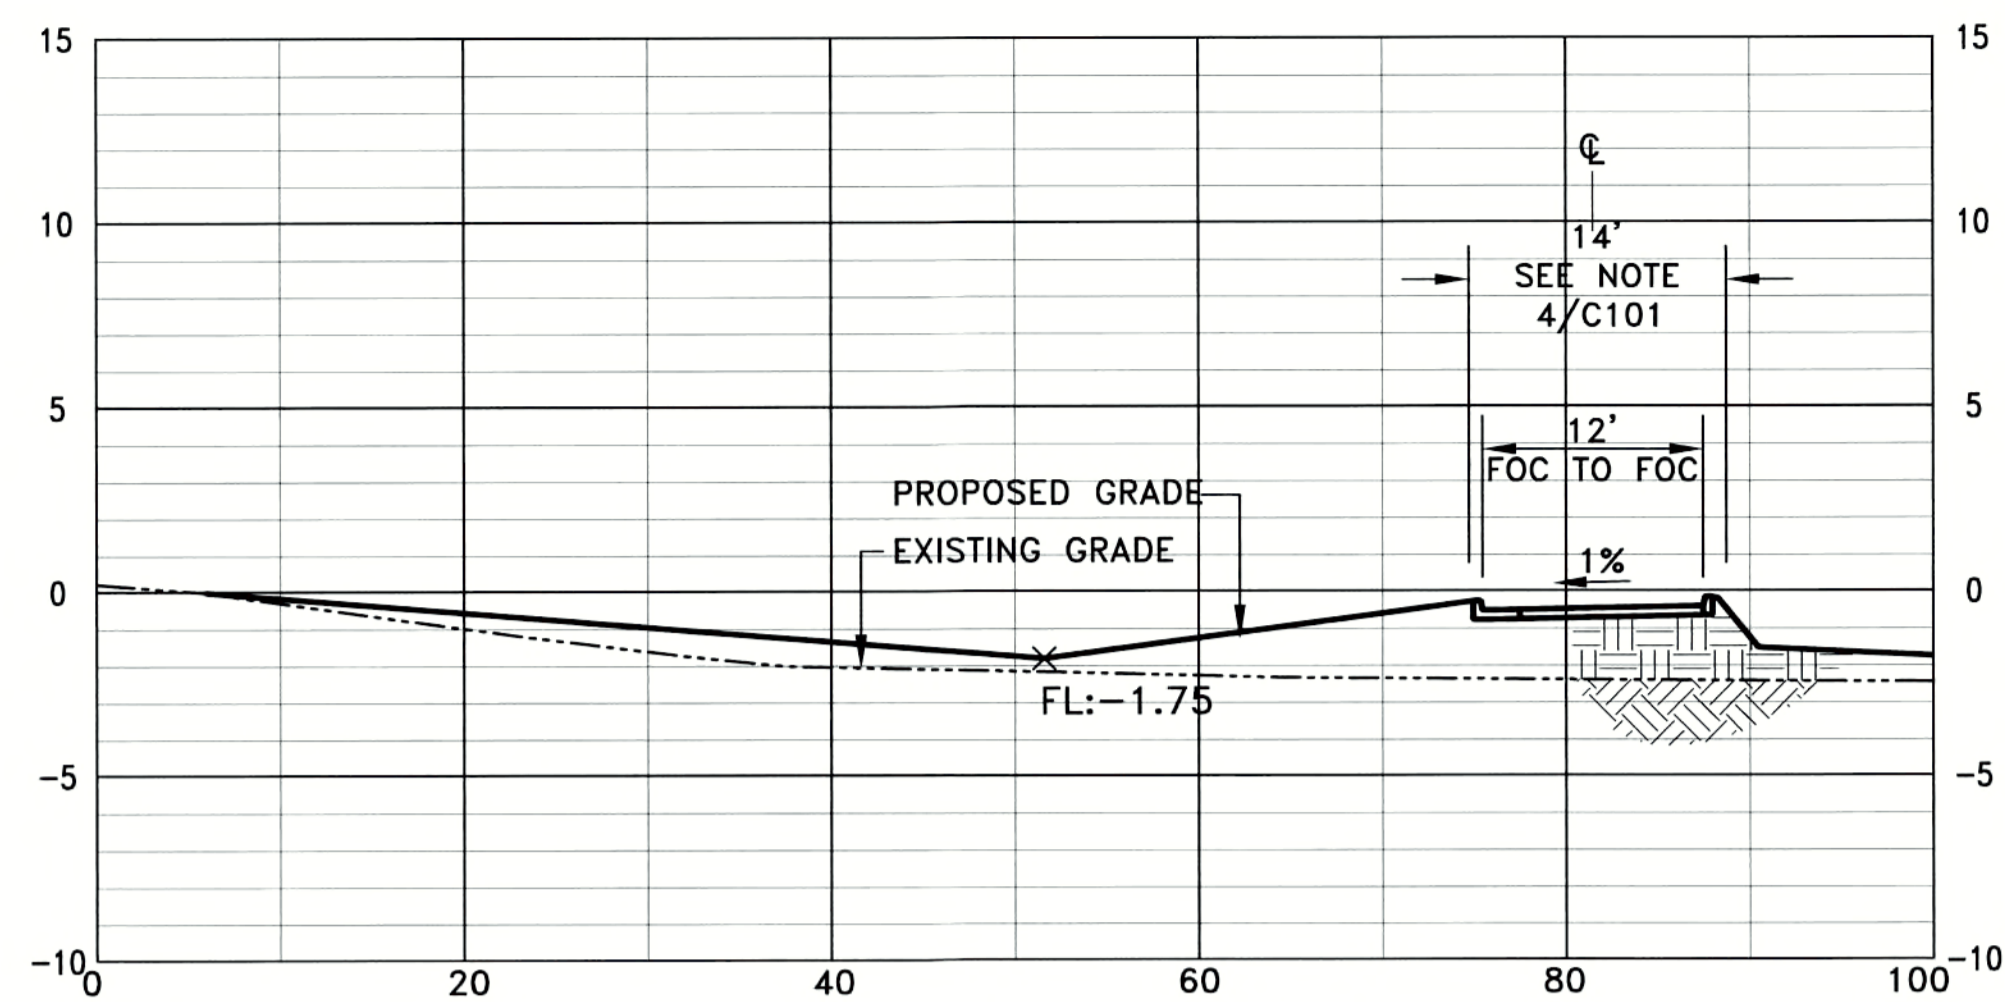

SECTION **9**
C1
SCALE HORIZONTAL: 1"=10'
VERTICAL: 1"=5'

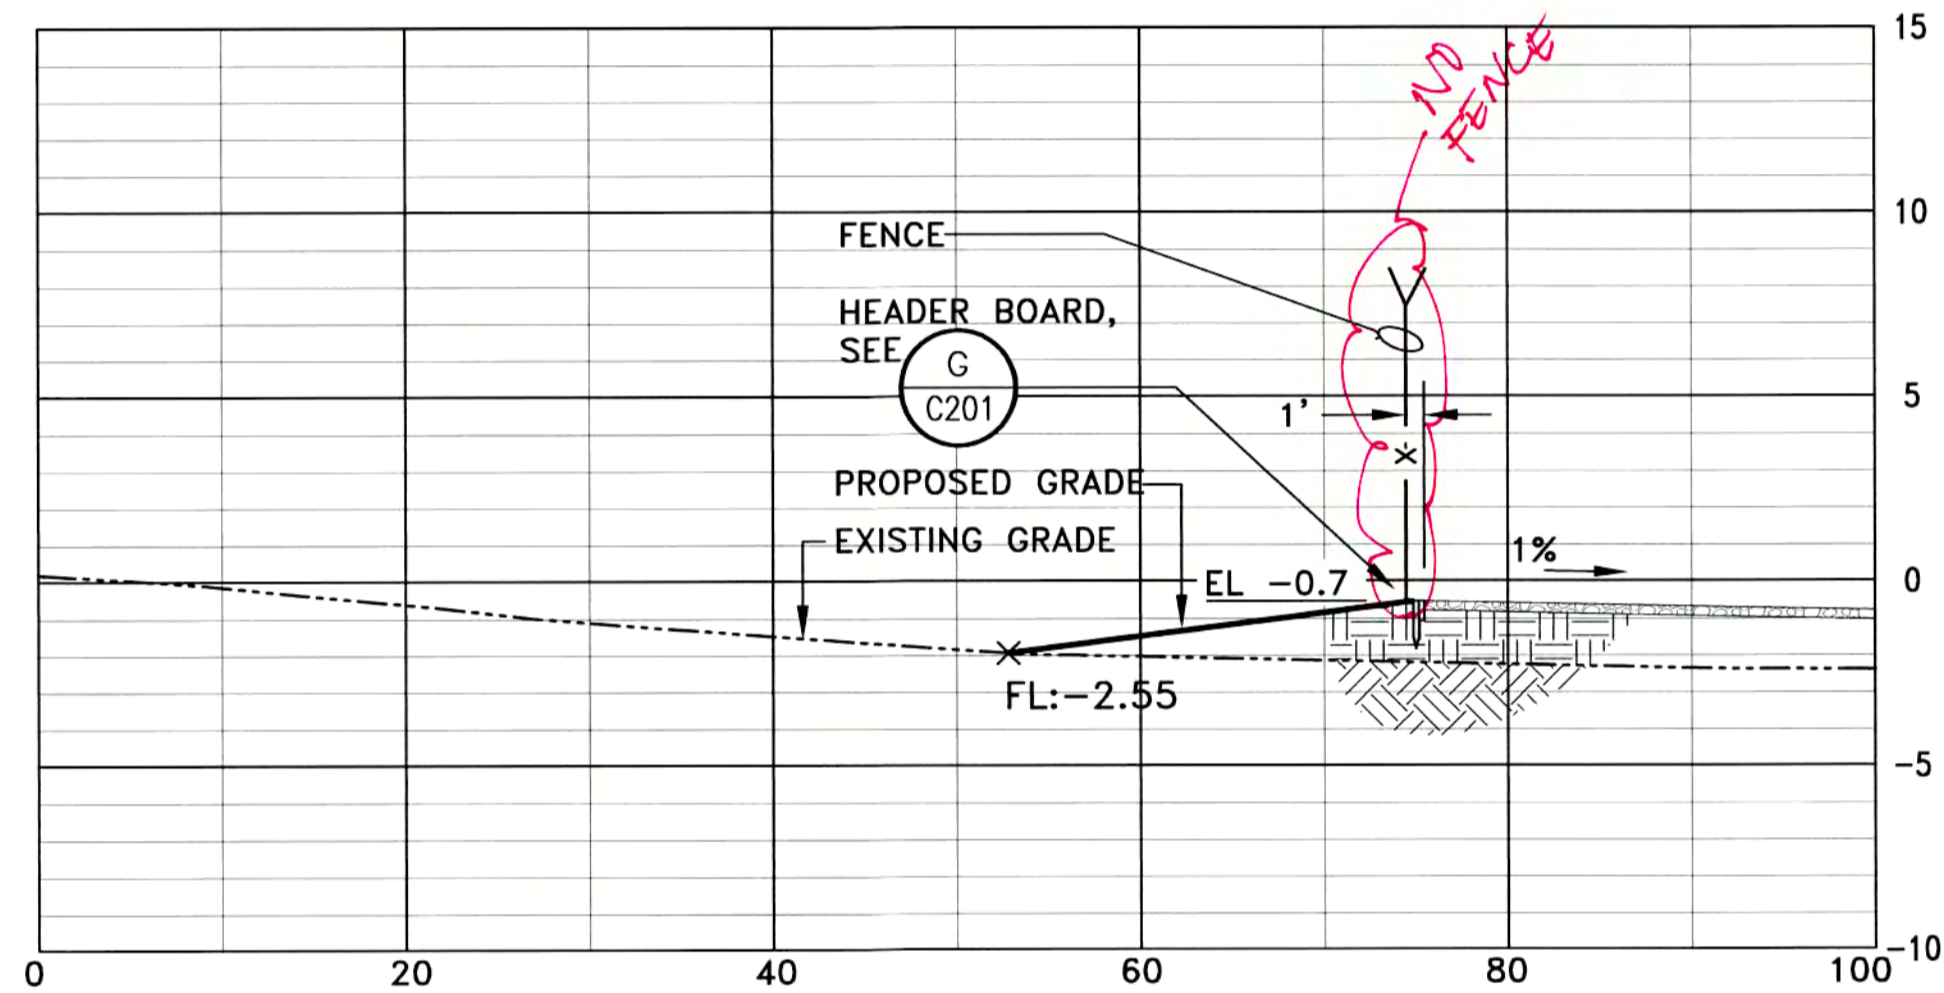


SECTION **10**
C1
SCALE HORIZONTAL: 1"=10'
VERTICAL: 1"=5'

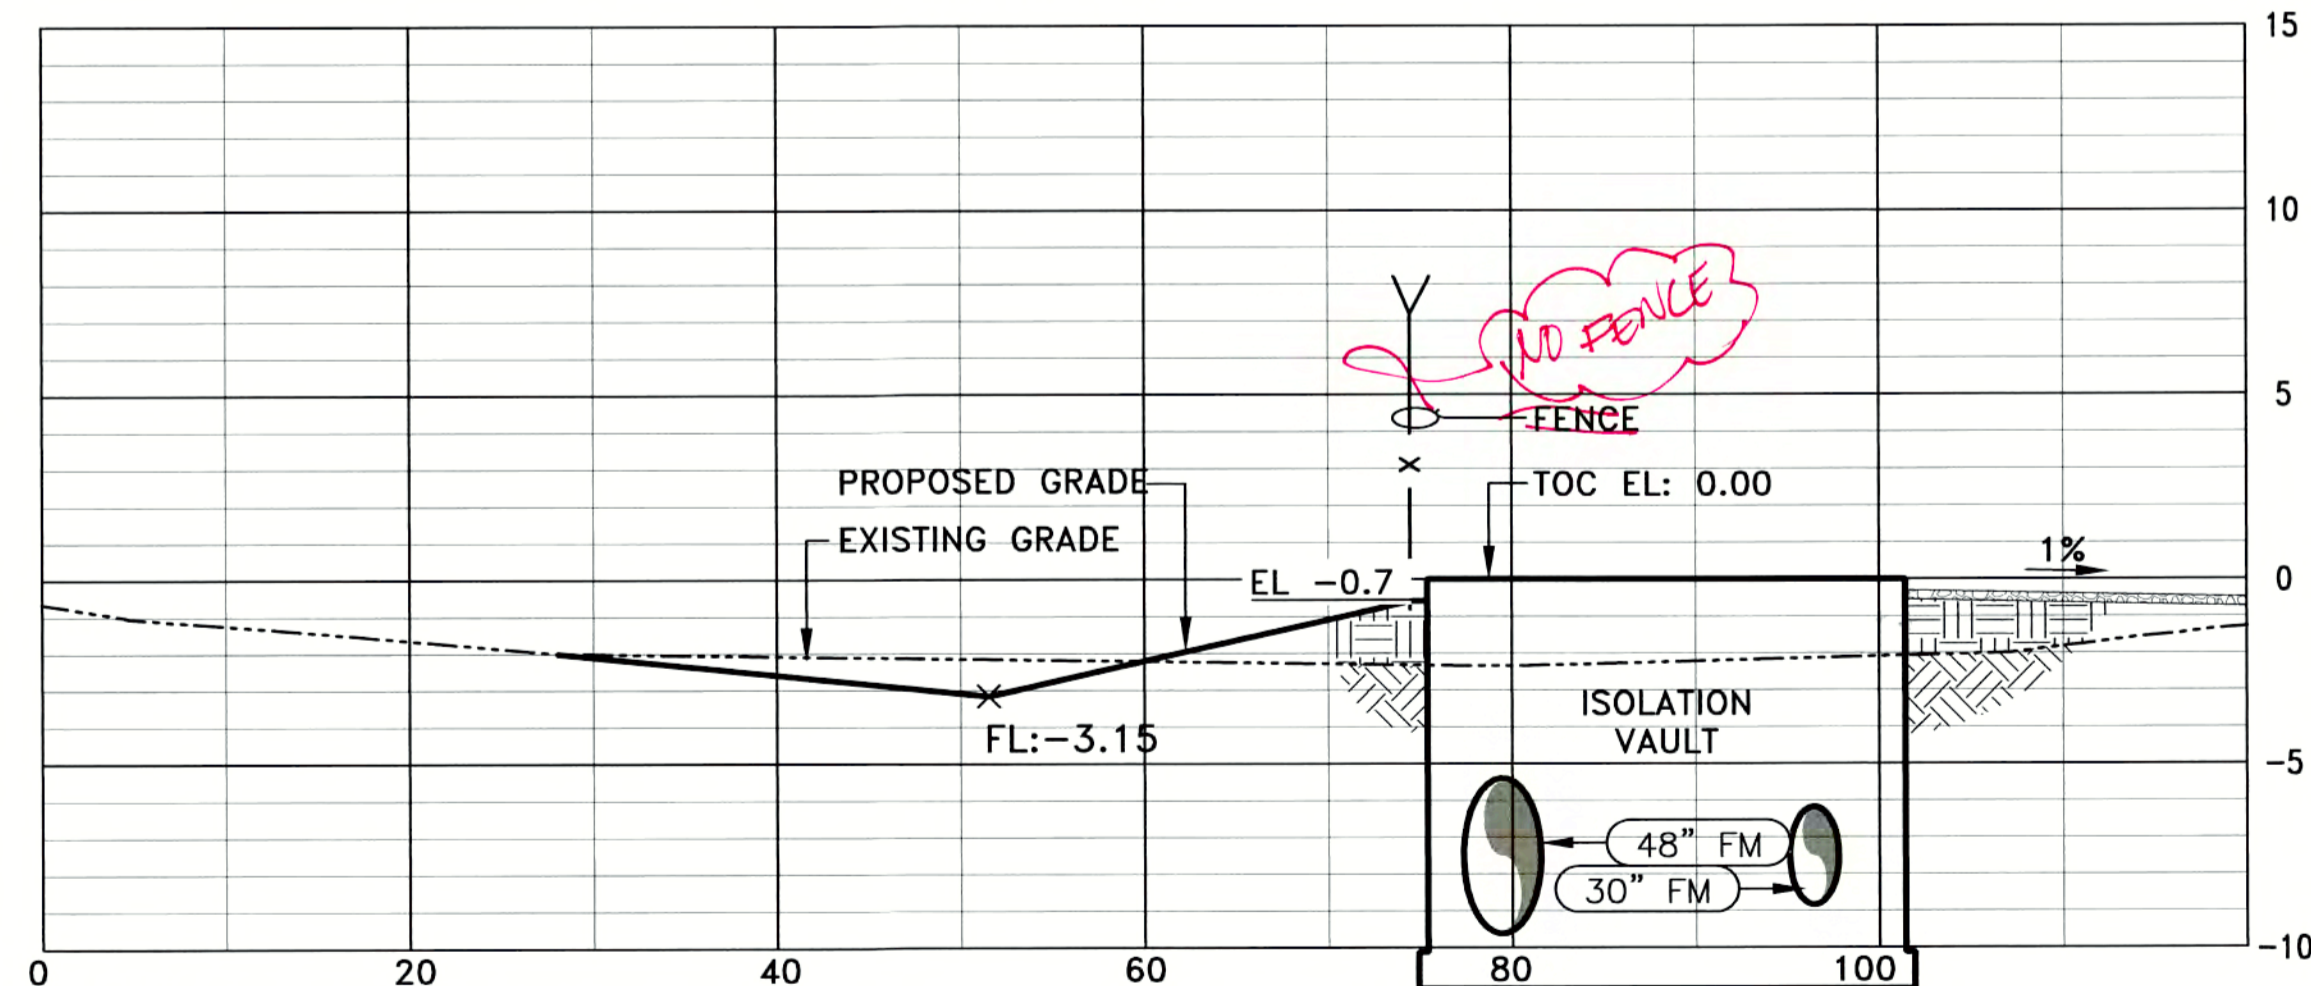


SECTION **11**
C1
SCALE HORIZONTAL: 1"=10'
VERTICAL: 1"=5'


- NOTES:
1. DETAIL A APPLIES TO SECTIONS 1-5, 7, SEE C101
2. DETAIL B APPLIES TO LEVEE ROAD STA 10+00 TO STA 17+90

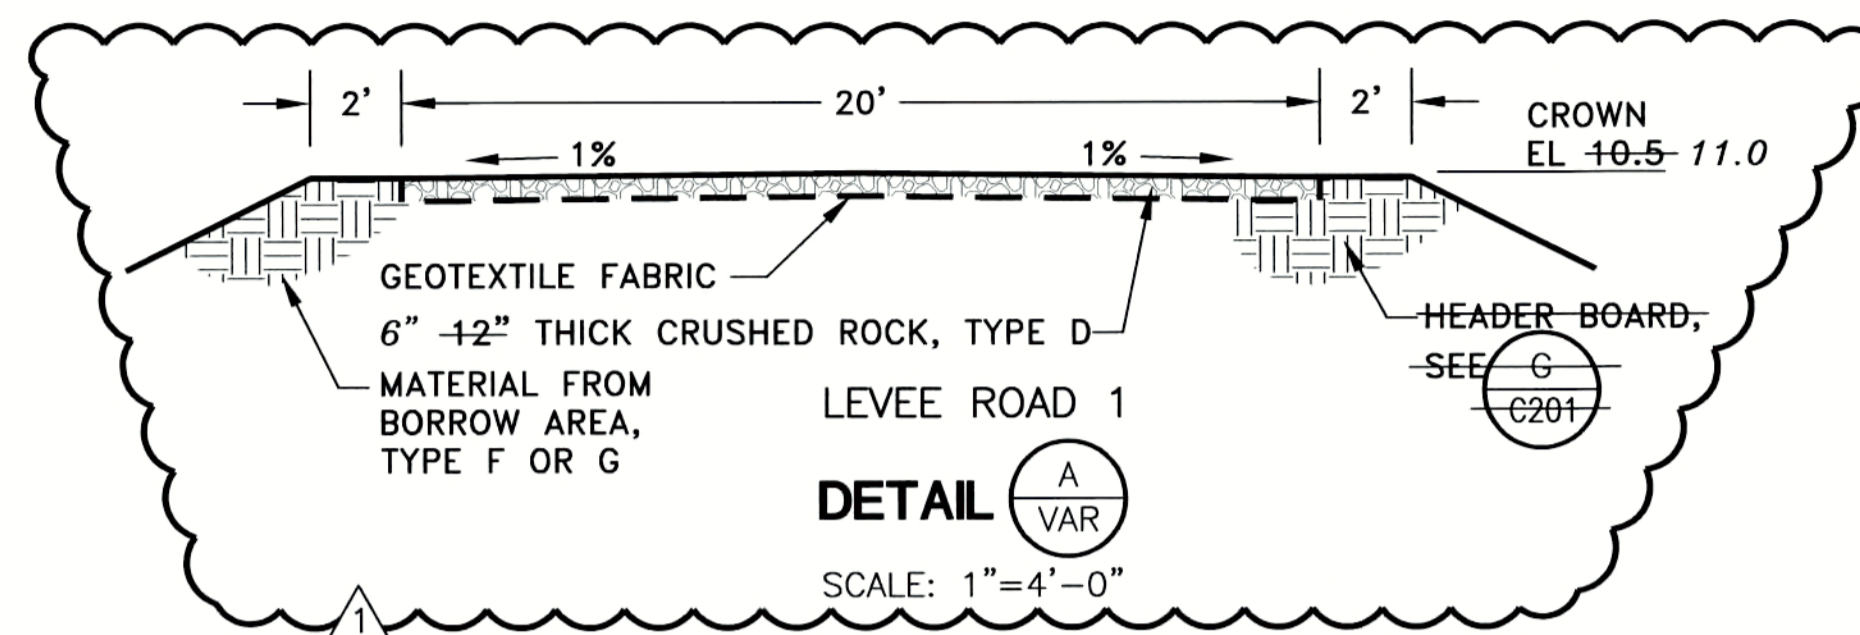


DETAIL **A**
VAR
SCALE: 1"=4'-0"

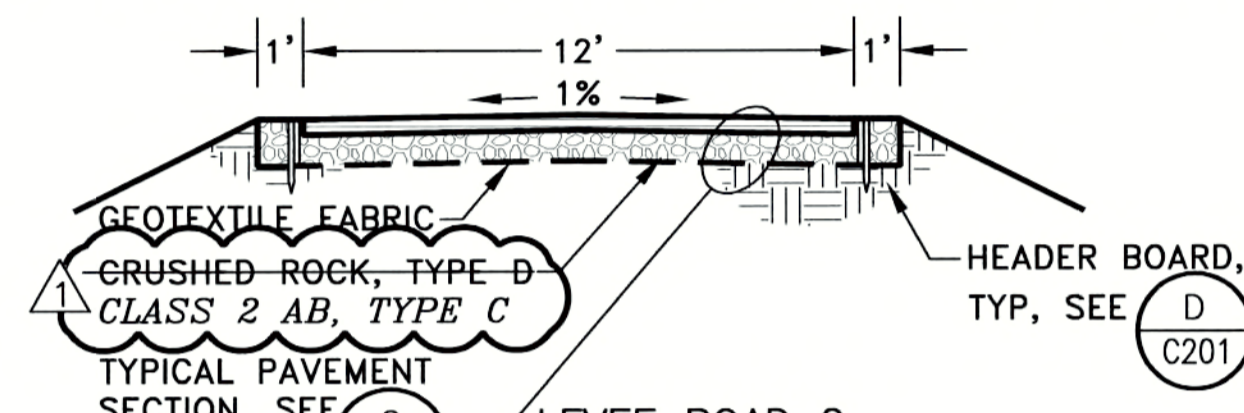


DETAIL **B**
VAR
SCALE: 1"=4'-0"

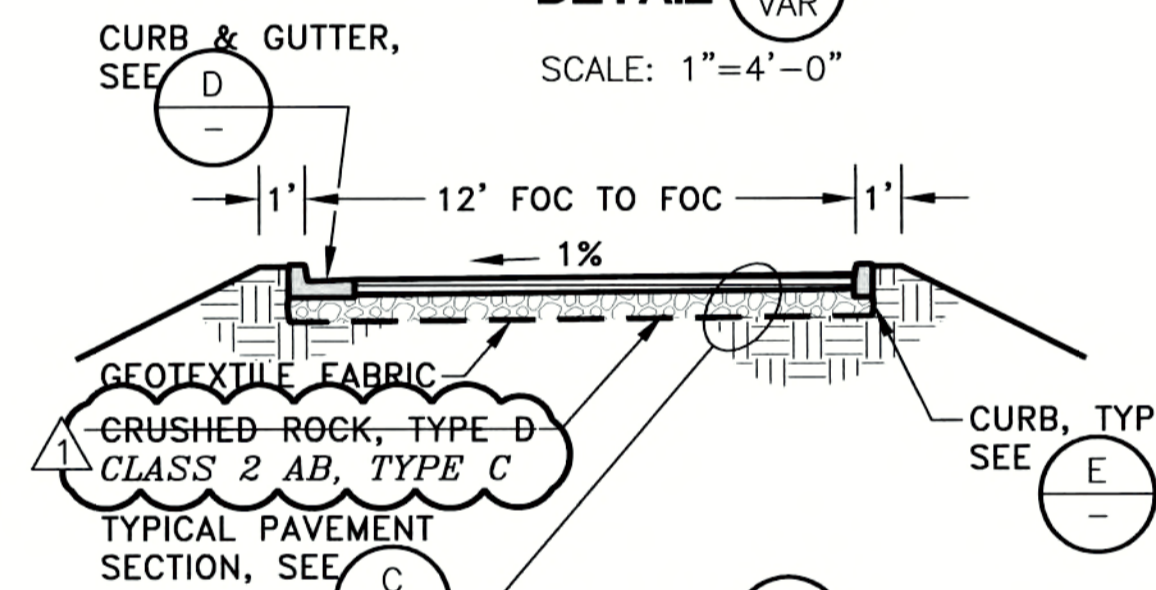

DETAIL **C**
C1
SCALE: 1"=4'-0"

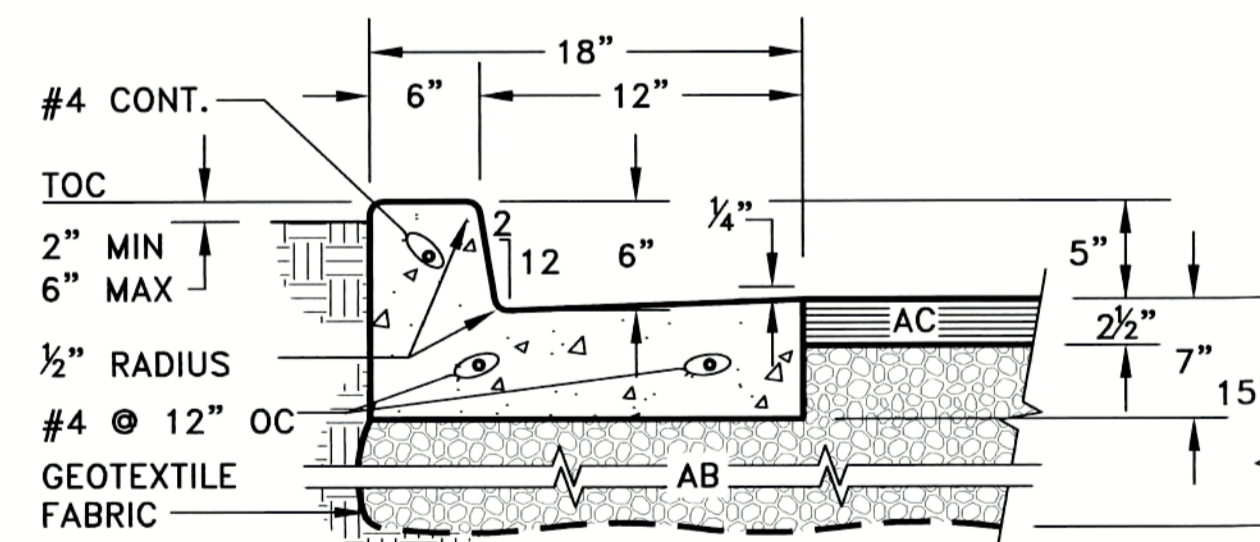

CURB & GUTTER
DETAIL **D**
VAR
NTS

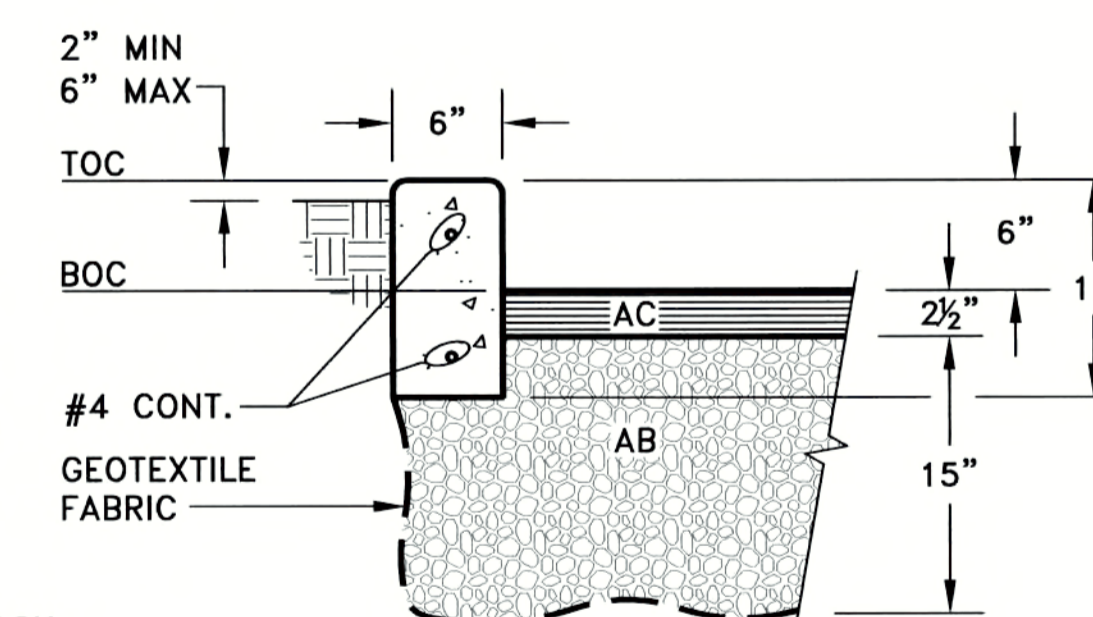

CURB
DETAIL **E**
VAR
NTS

- NOTES:
1. BOTTOM OF CURB TO BE SET ON COMPACTED AGGREGATE BASE ROCK
2. BROOM FINISH ALL EXPOSED CONCRETE SURFACES
3. PROVIDE 1/2" EXPANSION JOINTS @ 25'-0" OC MAX. AND AT CURVES, TANGENTS, AND CORNERS
4. CONTINUE RE-BAR THROUGH EXPANSION JOINTS
5. ROUND EXPOSED CORNERS WITH 1/2" RADIUS TOOL

RECORD DRAWINGS
14-Mile Slough Pump Station Upgrades
CIVIL SECTIONS 2

DEPARTMENT OF MUNICIPAL UTILITIES CITY OF STOCKTON, CALIFORNIA		SHEET No. C102 15 of 89 SHEETS
SCALE: AS SHOWN	APPROVED BY: DATE: _____	PROJECT No. 293-00-05-01
DESIGNED BY: PDF/TIT	ASSISTANT DIRECTOR, DEPT. OF MUNICIPAL UTILITIES	
DRAWN BY: DTD		
CHECKED BY: GDH		
RECORD DWG.: _____		



N:\Clients\283_Spones\00-05-01_14-MSPS Upgrades\CAD\Design\Submittals\293-00-05-01\102.dwg 11-13-08 09:06:52 AM oreimer

Underground Service Alert
TWO DAYS BEFORE YOU DIG
Call TOLL FREE: 1-800-642-2444


REFER TO BID SET FOR SIGNATURE
No. 57272

REV. No.	DISCRPTION	DATE	BY	Apr'd By
1	ADDENDUM No. 3	5/25/06	TTT	PDF
2				
3				
4				
5				
6				
7				

WEST YOST ASSOCIATES
Consulting Engineers
1260 Lake Boulevard
Suite 240
Davis, California 95616
(530) 756-5905
FAX (530) 756-5991

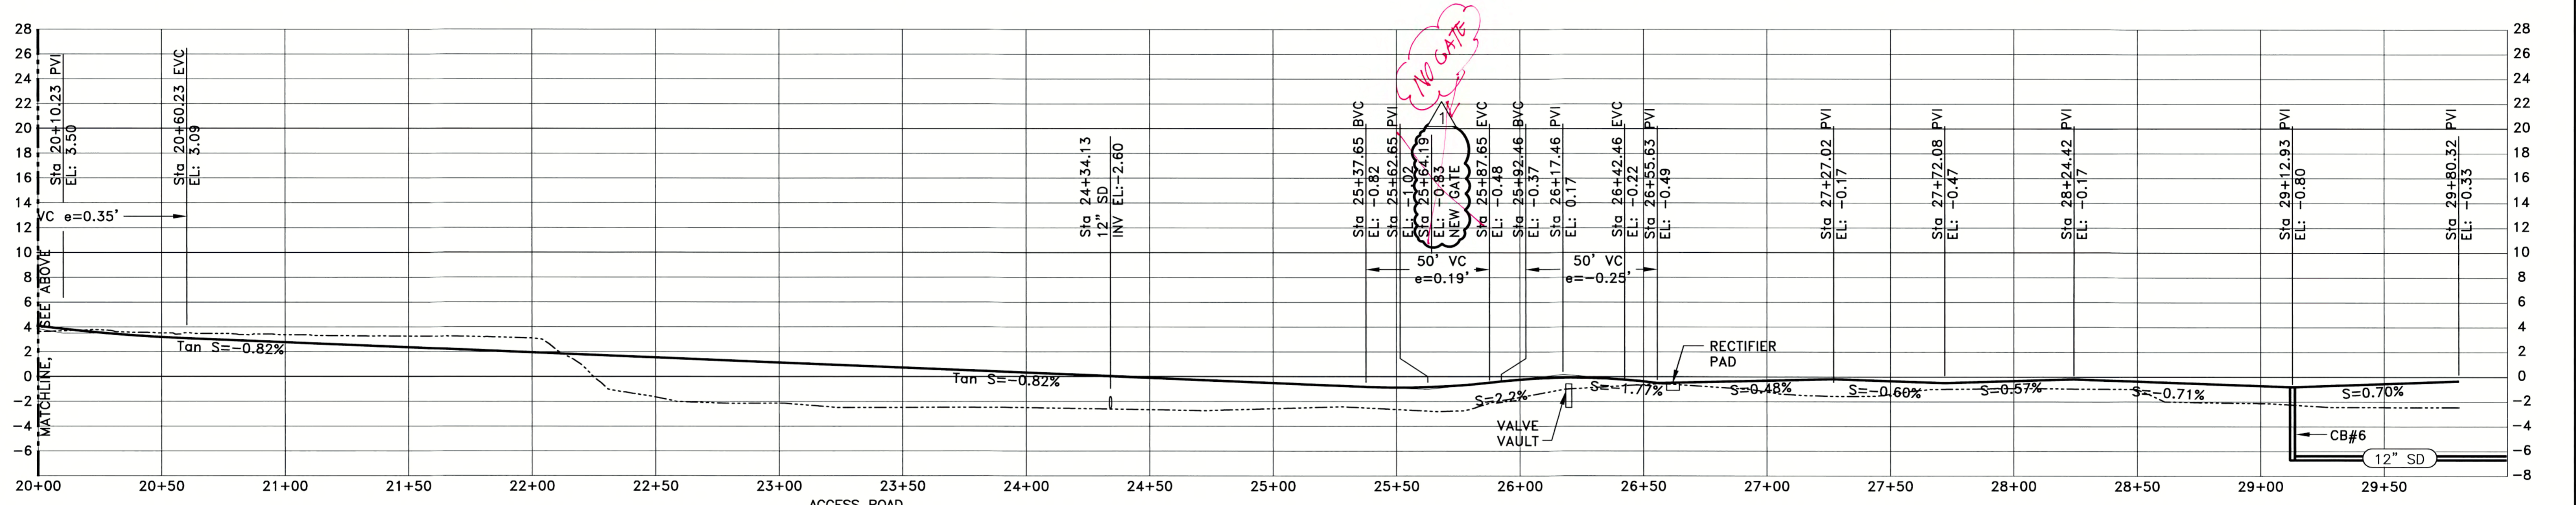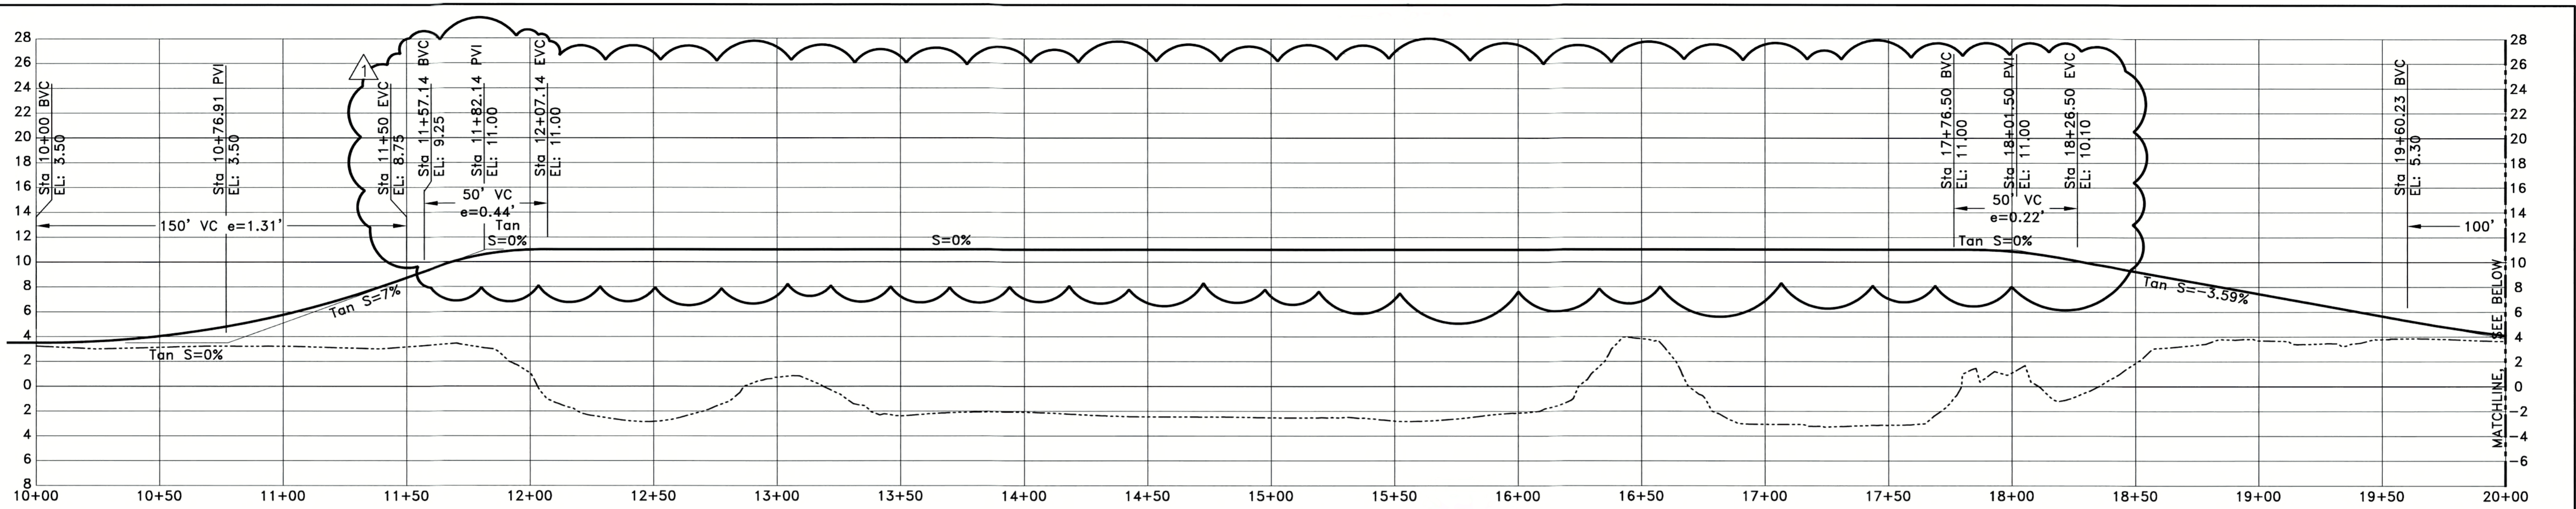

ACCESS ROAD
SECTION 1
SCALE HORIZONTAL: 1"=30'
SCALE VERTICAL: 1"=6'

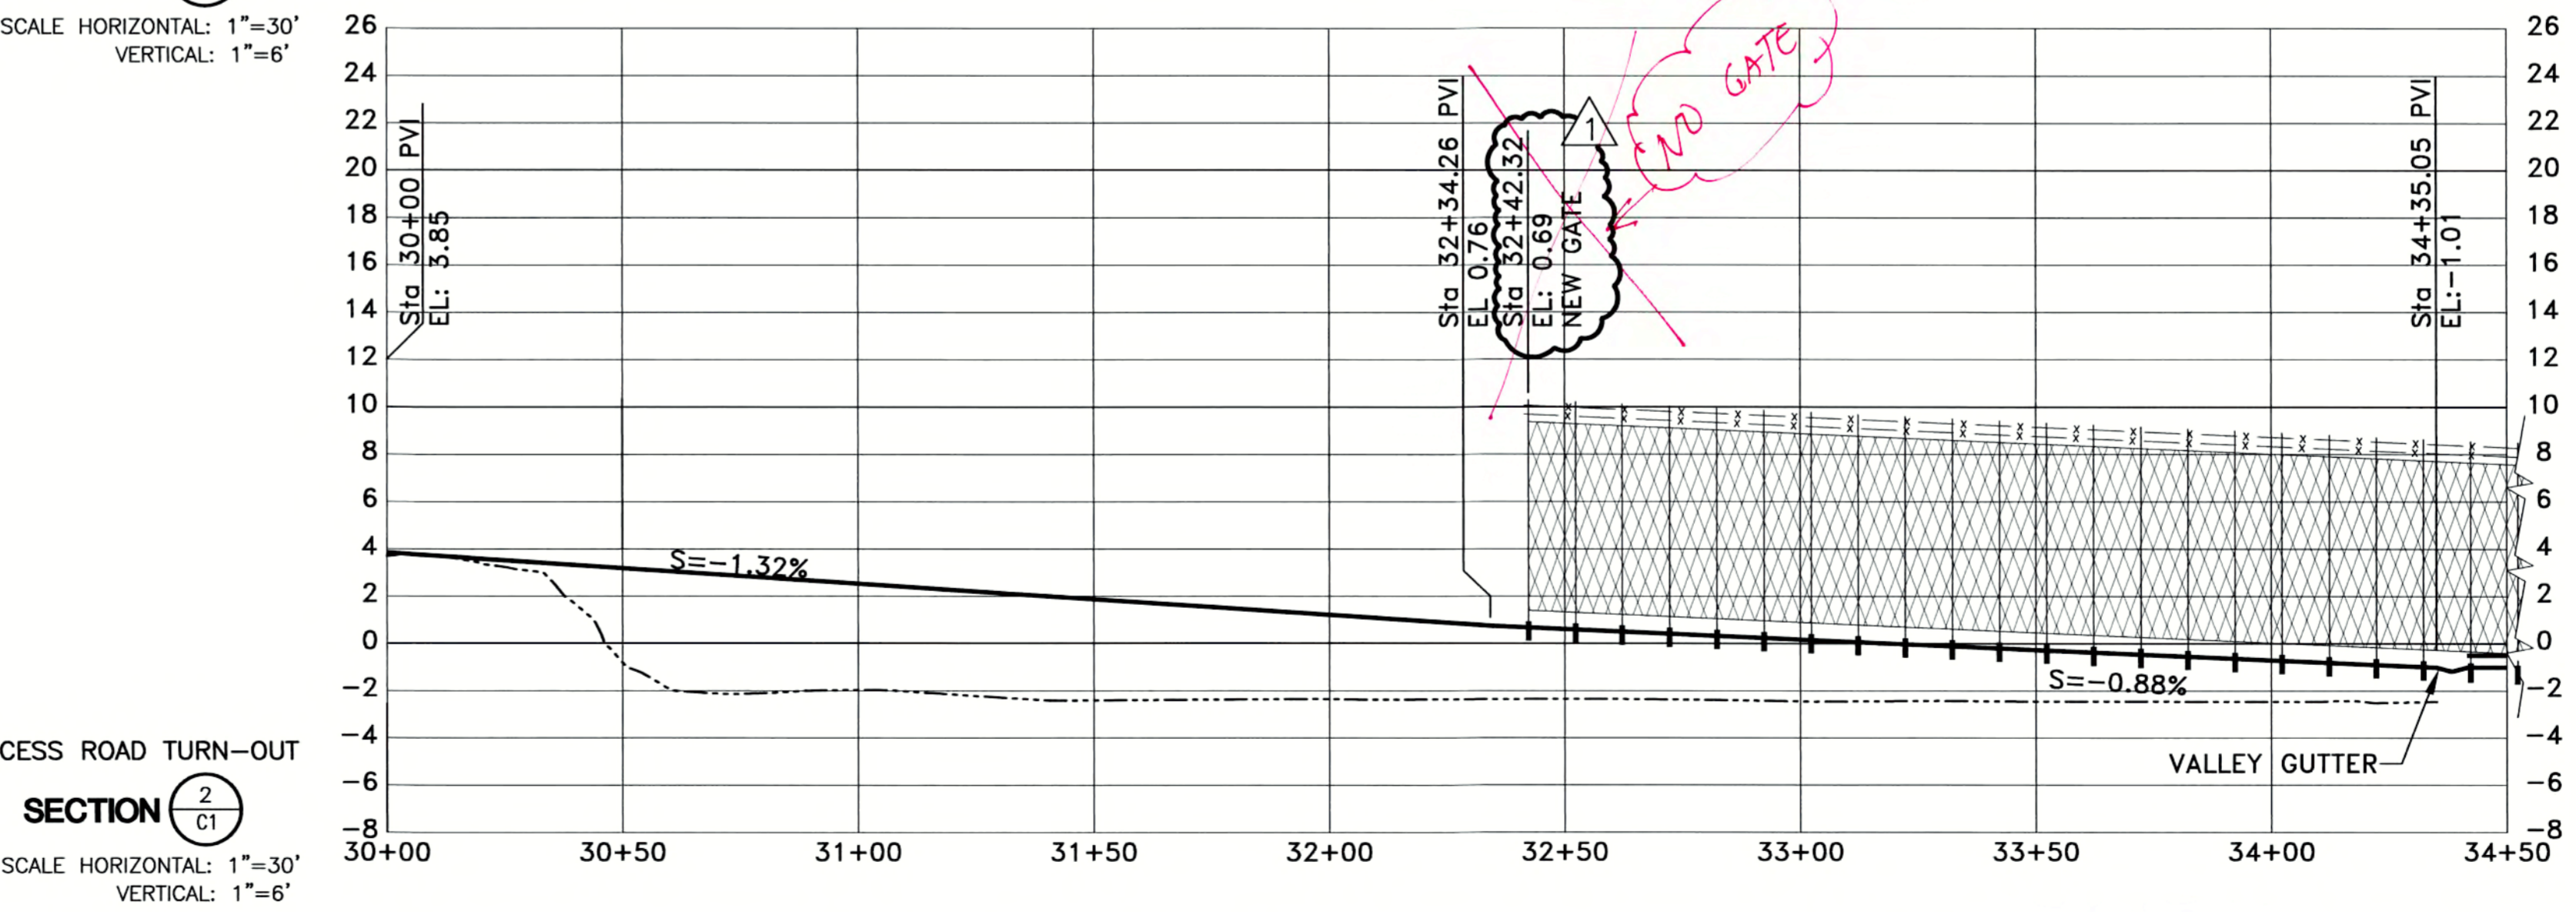

ACCESS ROAD TURN-OUT
SECTION 2
SCALE HORIZONTAL: 1"=30'
SCALE VERTICAL: 1"=6'

RECORD DRAWINGS
14-Mile Slough Pump Station Upgrades

ACCESS ROAD
PROFILE

DEPARTMENT OF MUNICIPAL UTILITIES CITY OF STOCKTON, CALIFORNIA		
SCALE: AS SHOWN	APPROVED BY: DATE: _____	SHEET No. C103.1
DESIGNED BY: TTT		16 of 89 SHEETS
DRAWN BY: DTD		PROJECT No. 293-00-05-01
CHECKED BY: GDH/PDF	ASSISTANT DIRECTOR, DEPT. OF MUNICIPAL UTILITIES	
RECORD Dwg.:		

N:\Clients\293 Sponos\00-05-01 14-Mile Slough Pump Station Upgrades\CAD\Design\Asbuilt\393-0507C103.1.dwg 11-13-08 09:09:30 AM areimer

Underground Service Alert

TWO DAYS BEFORE YOU DIG


Call TOLL FREE: 1-800-642-2444

REFER TO BID SET FOR SIGNATURE


REV. No.	DISCRPTION	DATE	BY	Apr'd By
1	RFI 020-ADJUST ROAD ELEVATION	10/06	TTT	PDF
2				
3				
4				
5				
6				
7				

WEST YOST ASSOCIATES
Consulting Engineers

1260 Lake Boulevard
Suite 240
Davis, California 95616
(530) 756-5905
FAX (530) 756-5991

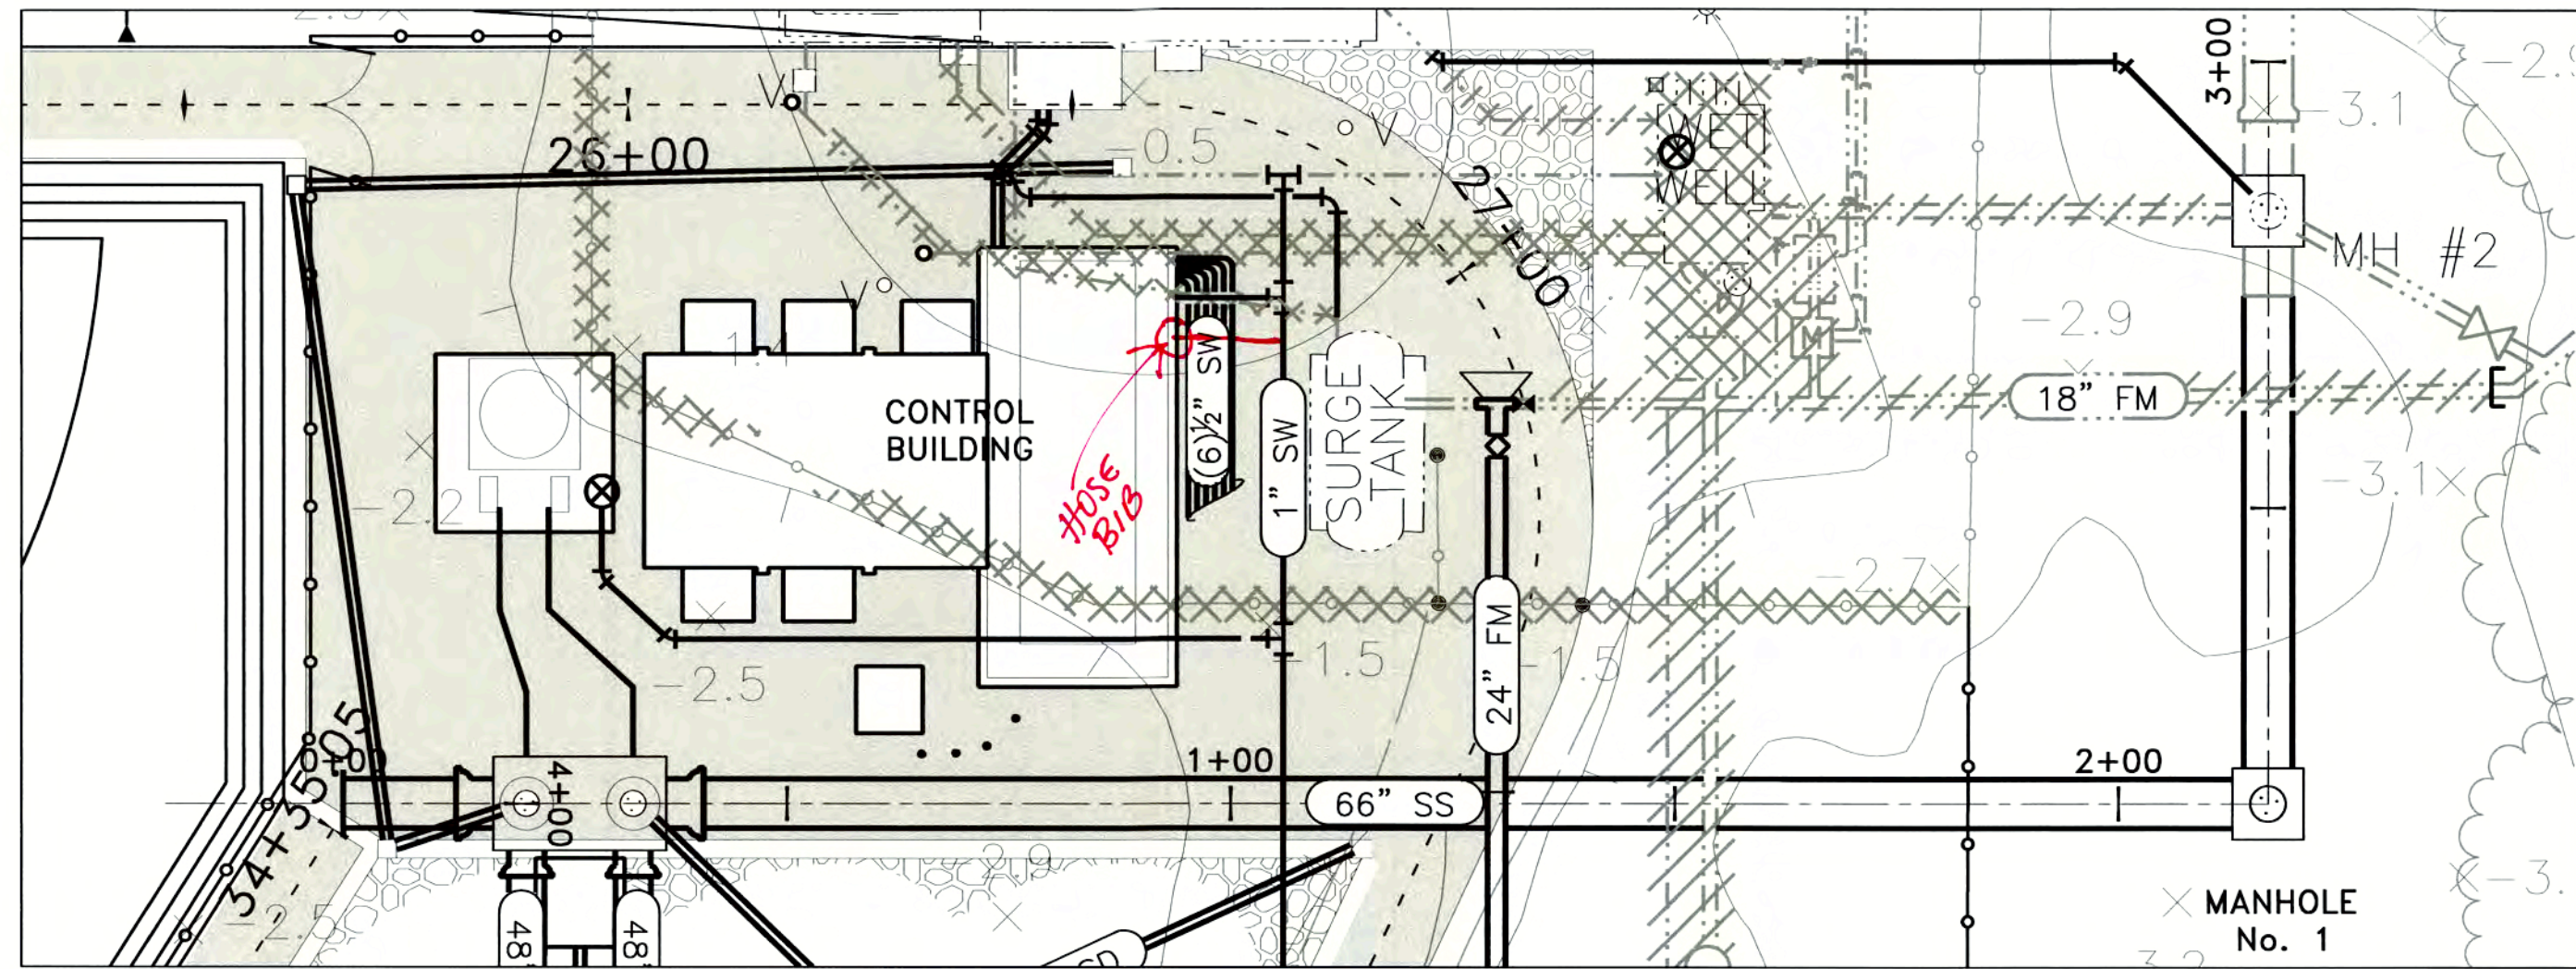


66" FM
PLAN
 SCALE HORIZONTAL: 1"=20'
 VERTICAL: 1"=4'

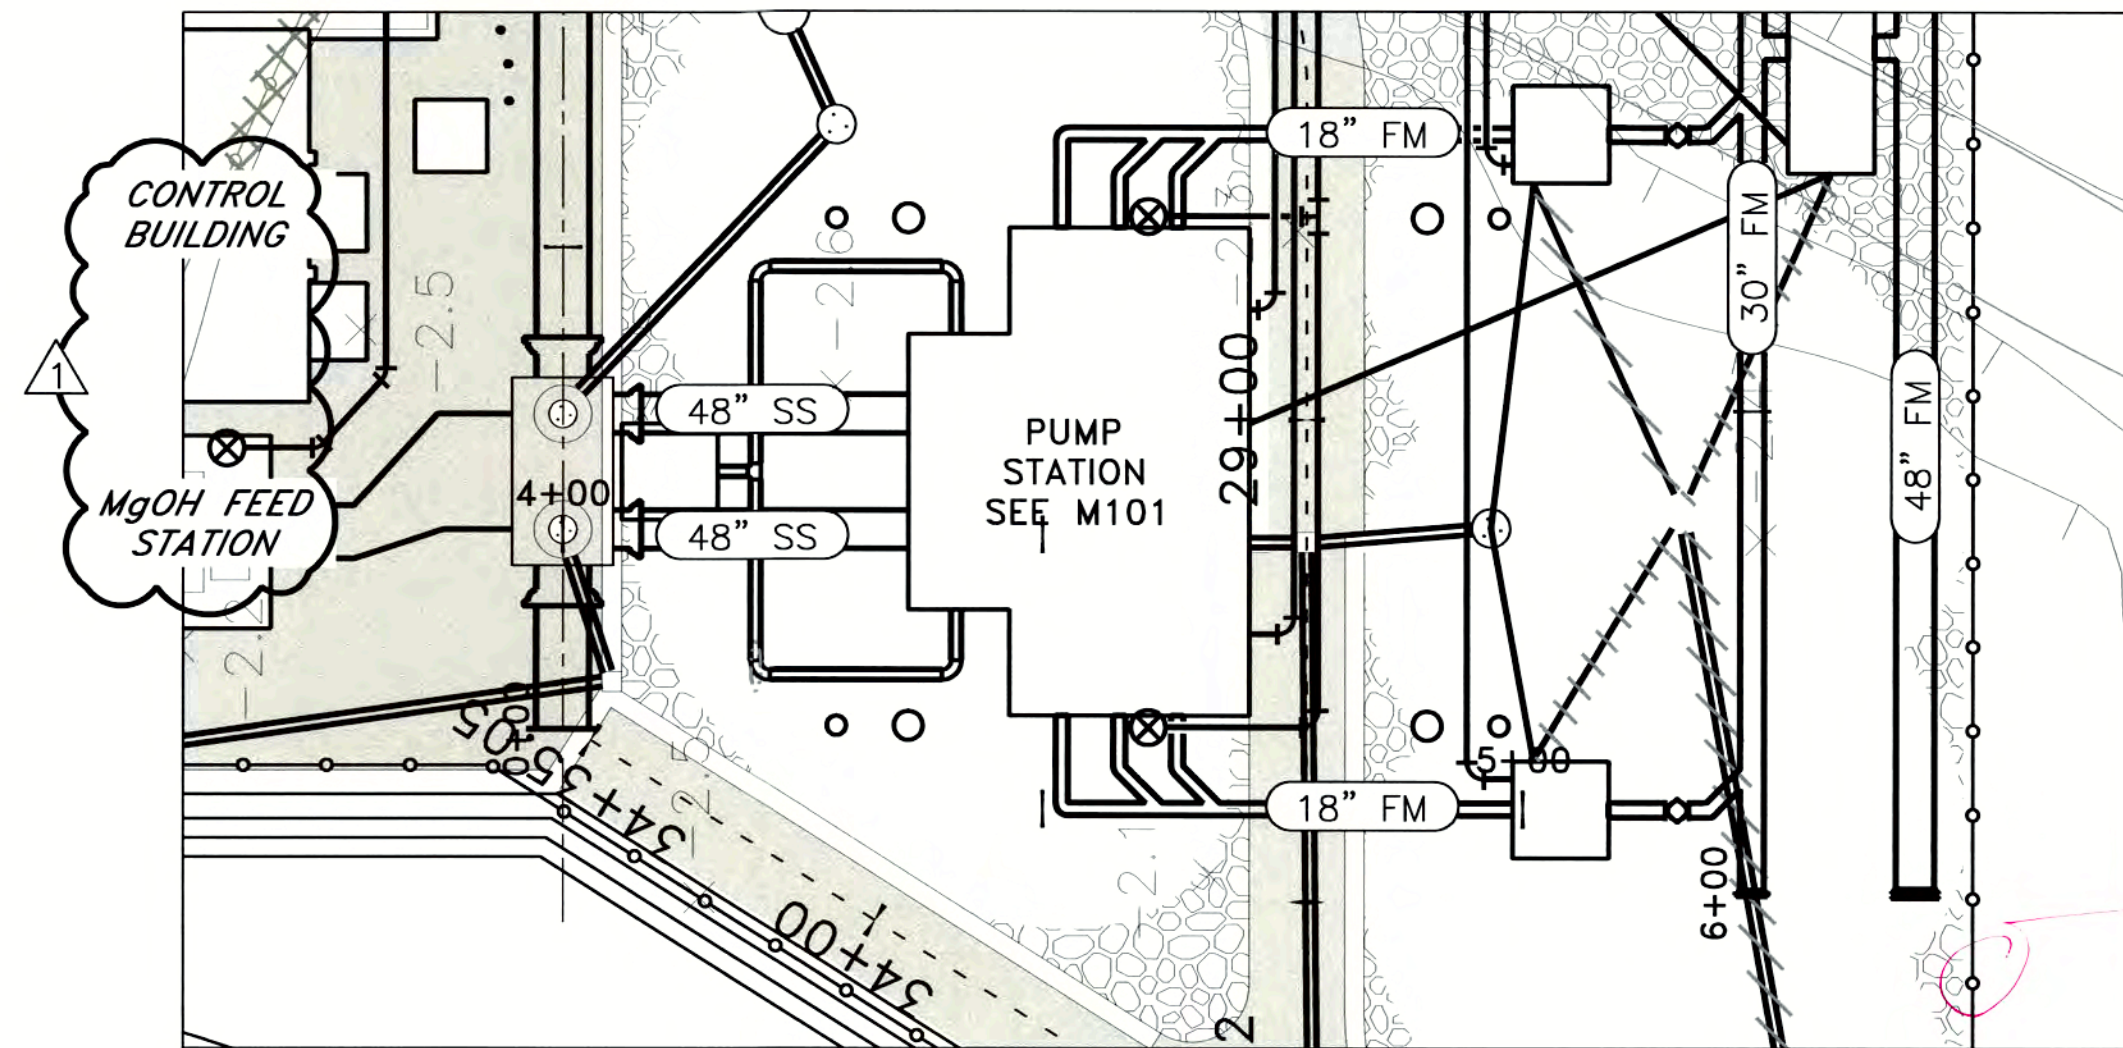


48" SS
PLAN
 SCALE HORIZONTAL: 1"=20'
 VERTICAL: 1"=4'

18" HEADER
PLAN
 SCALE HORIZONTAL: 1"=20'
 VERTICAL: 1"=4'

TAKE-OUT

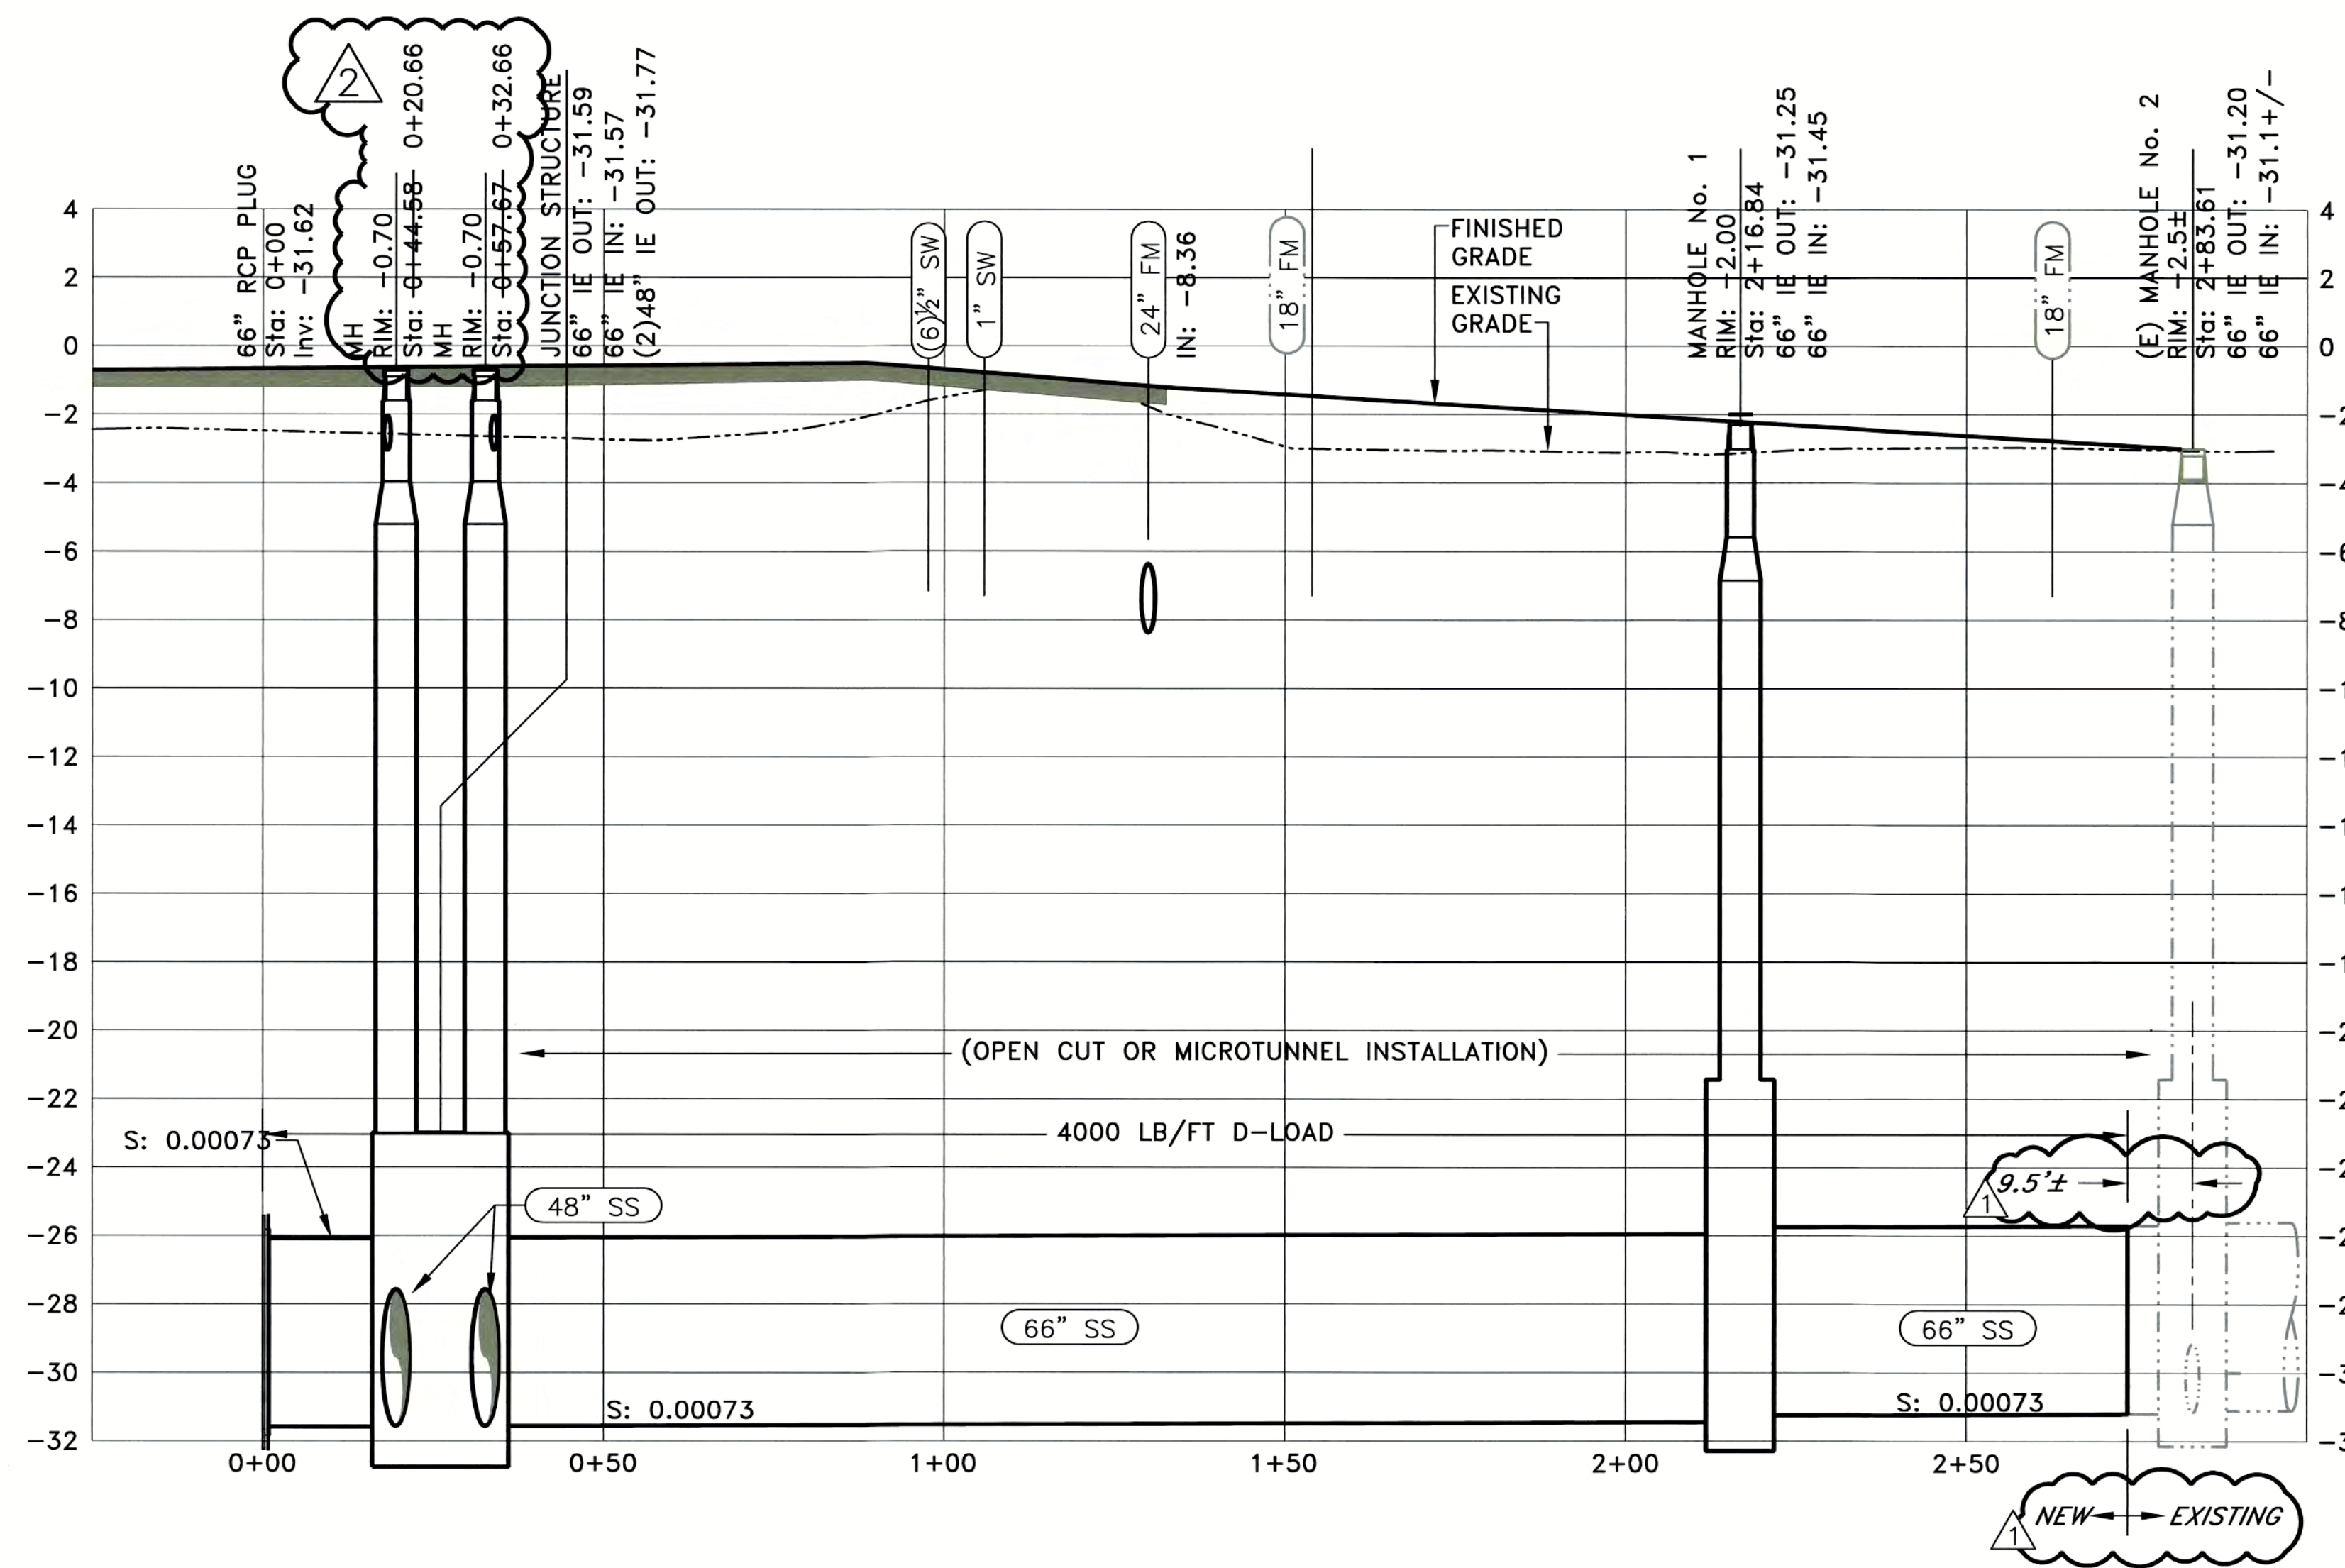

66" FM
PROFILE
 SCALE HORIZONTAL: 1"=20'
 VERTICAL: 1"=4'

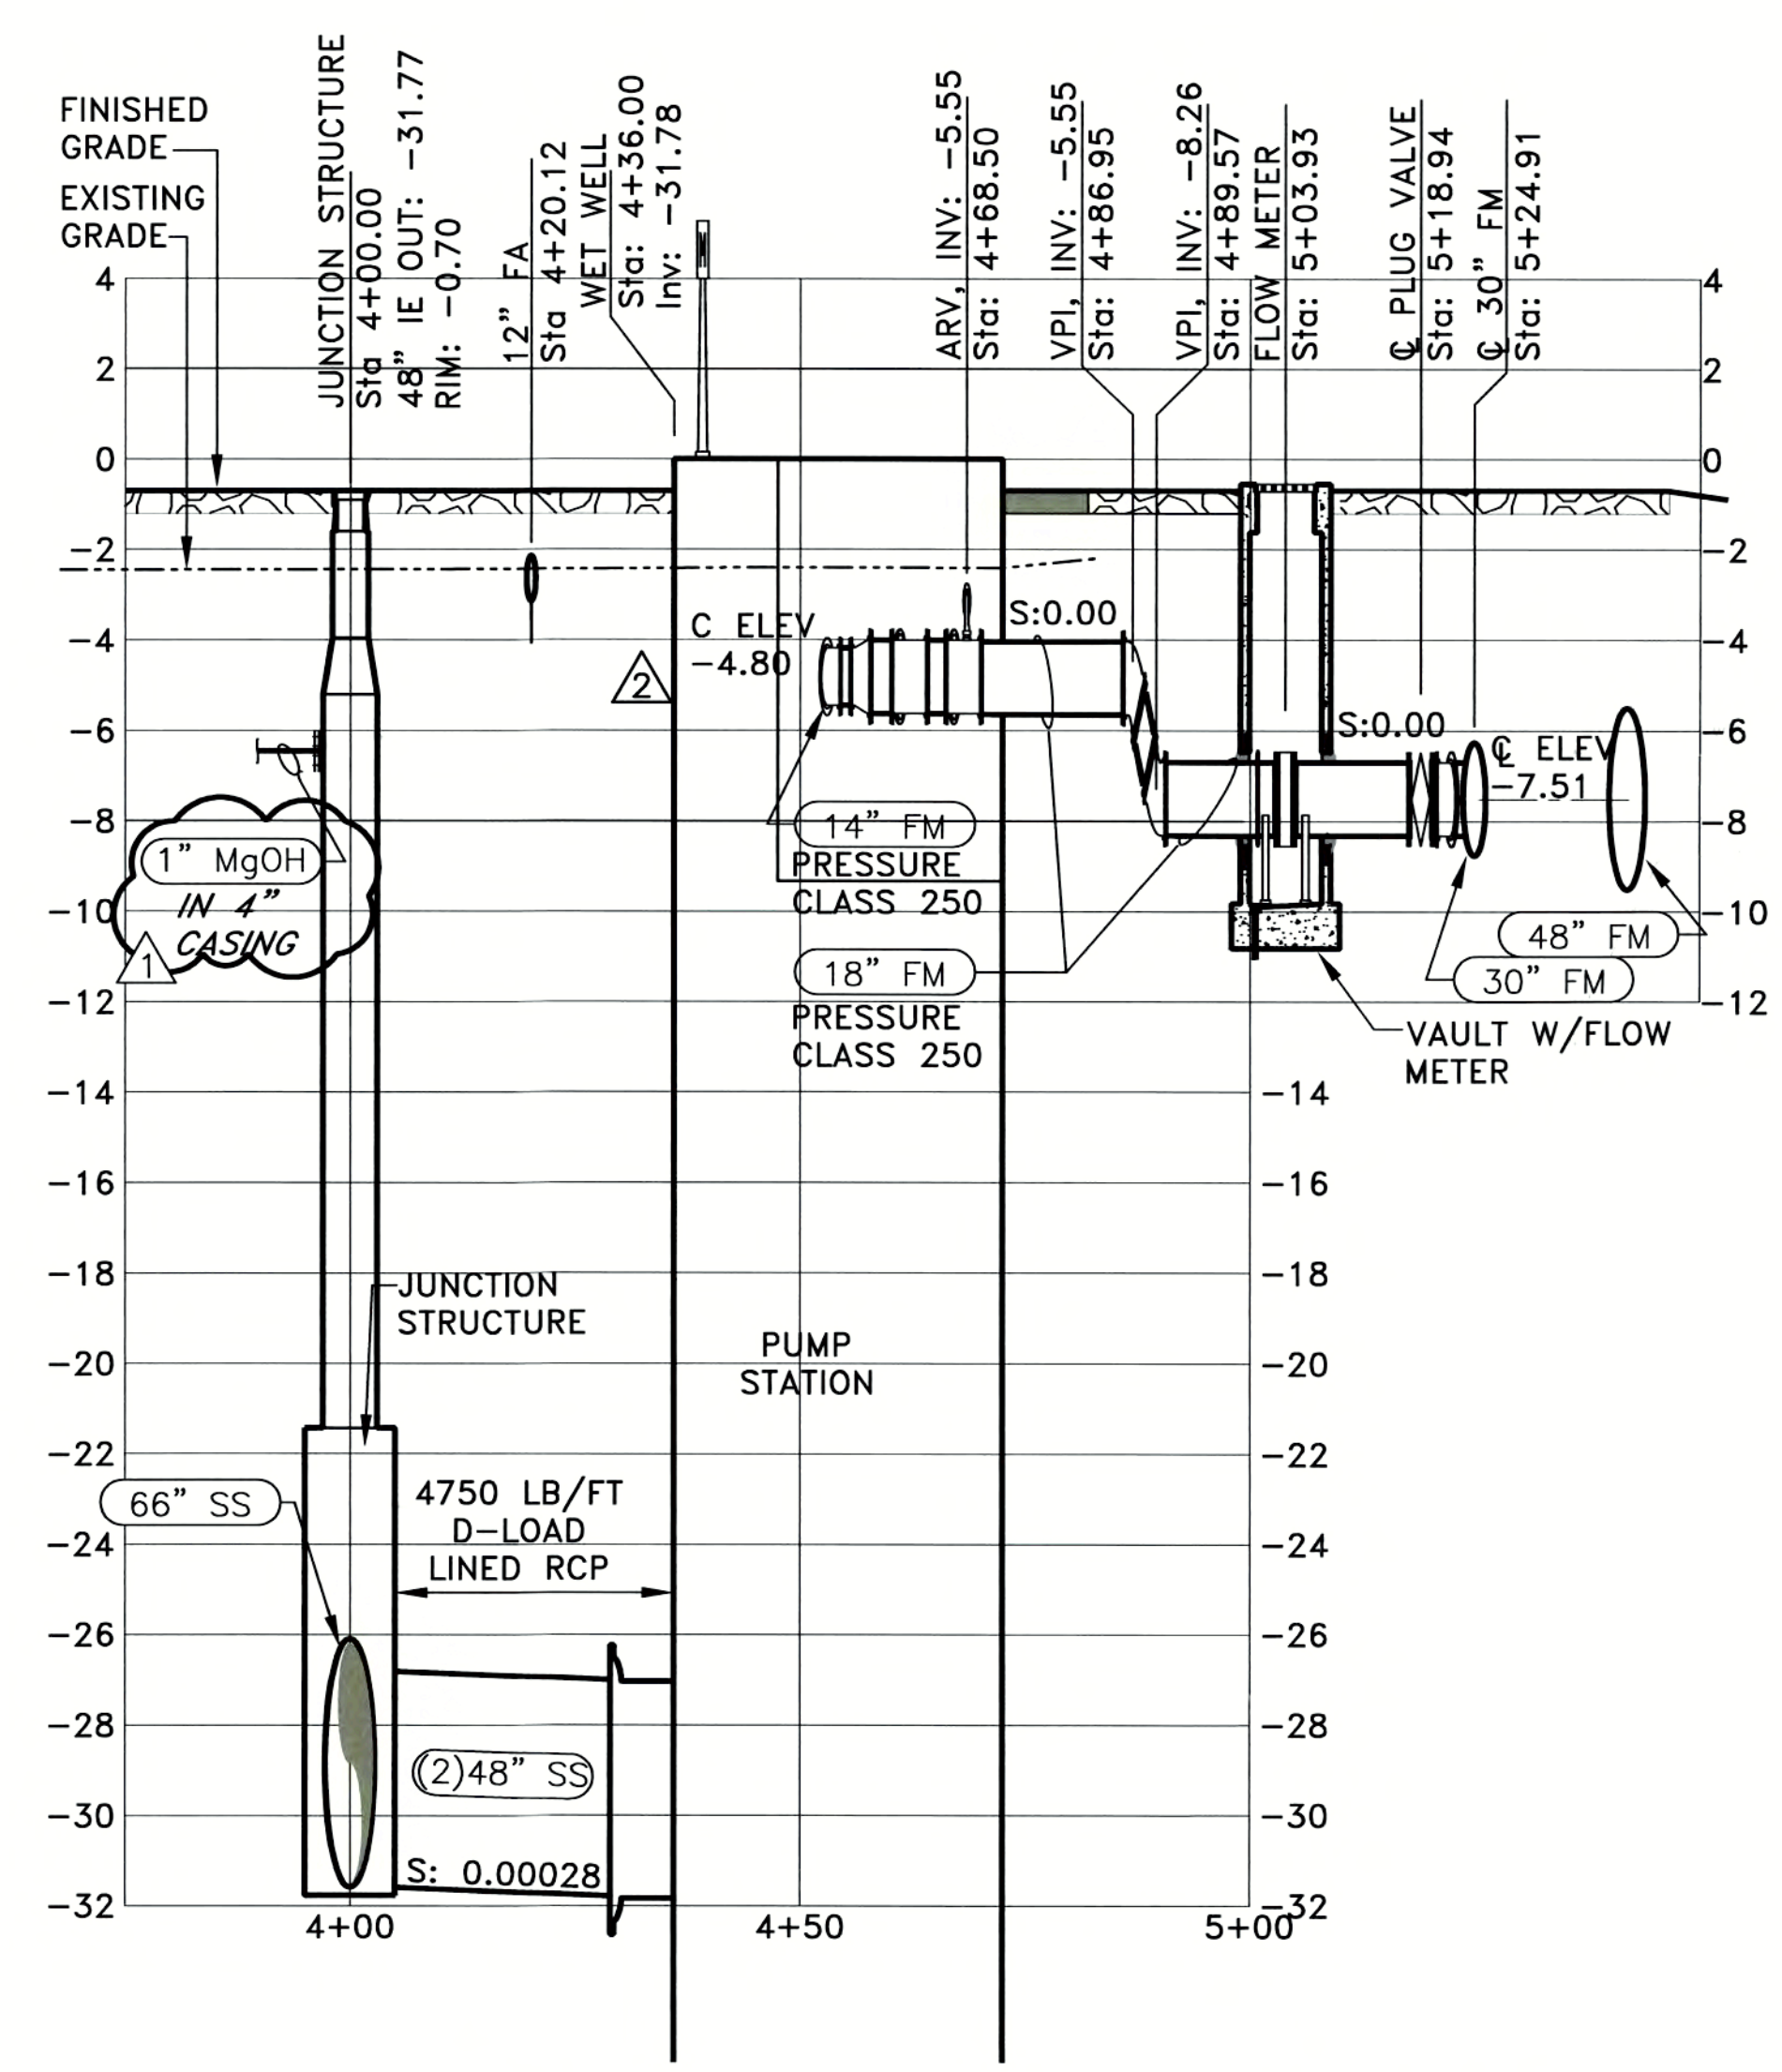

48" SS
PROFILE
 SCALE HORIZONTAL: 1"=20'
 VERTICAL: 1"=4'

18" FM HEADER
PROFILE
 SCALE HORIZONTAL: 1"=20'
 VERTICAL: 1"=4'

N:\Clients\2013\Spence\00-05-01 14-MSPS Upgrades\CAD\Design\Asbuilts\293-0501\0448105.dwg 11-13-08 09:25:59 AM creimer



REV. No.	DISCRPTION	DATE	BY	Apr'd By
1	ADDENDUM No. 3	5/25/08	TTT	PDF
2	RECORD DRAWINGS	6/08	CLB	PDF
3				
4				
5				
6				
7				


WEST YOST ASSOCIATES
 Consulting Engineers
 1260 Lake Boulevard
 Suite 240
 Davis, California 95616
 (530) 756-5905
 FAX (530) 756-5991

RECORD DRAWINGS
14-Mile Slough Pump Station Upgrades


CIVIL PLAN & PROFILES 1

DEPARTMENT OF MUNICIPAL UTILITIES
 CITY OF STOCKTON, CALIFORNIA


SCALE: AS SHOWN	APPROVED BY: DATE:	SHEET No.
DESIGNED BY: TTT		C104
DRAWN BY: DTD		of 89 SHEETS
CHECKED BY: GDH	ASSISTANT DIRECTOR, DEPT. OF MUNICIPAL UTILITIES	PROJECT No. 293-00-05-01
RECORD Dwg.:		

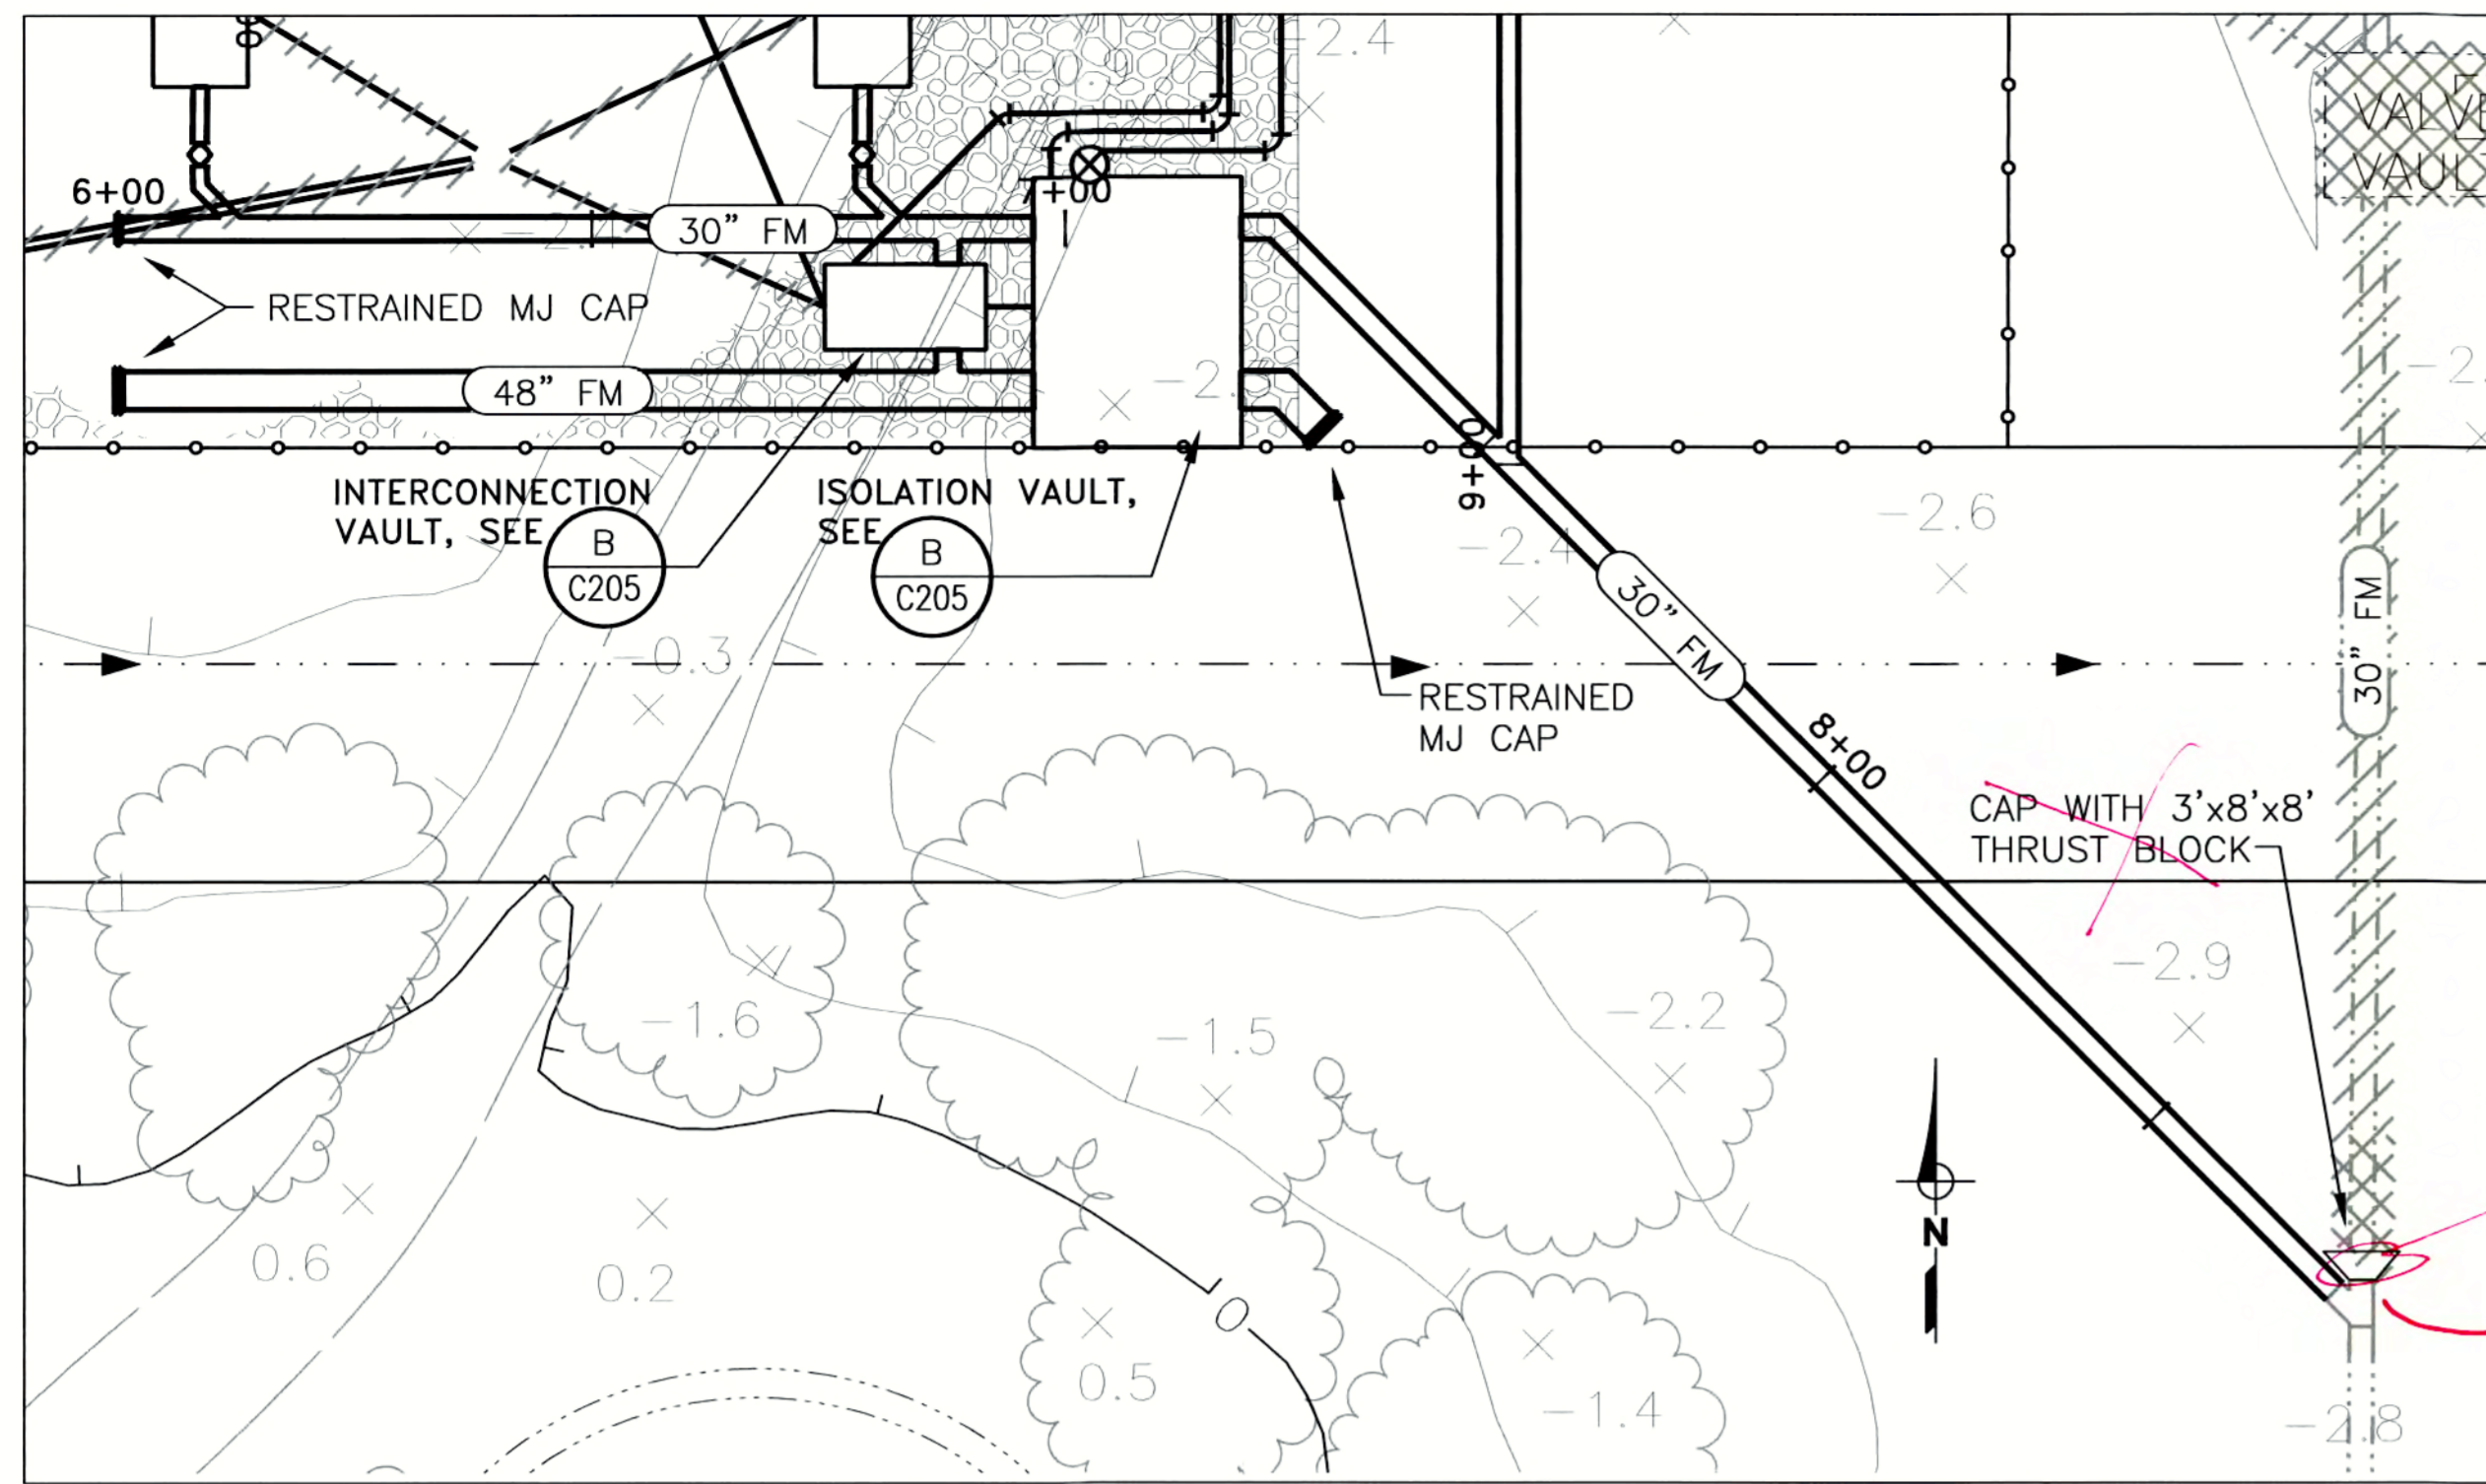


30" FM
PLAN
 SCALE HORIZONTAL: 1"=20'
 VERTICAL: 1"=4'

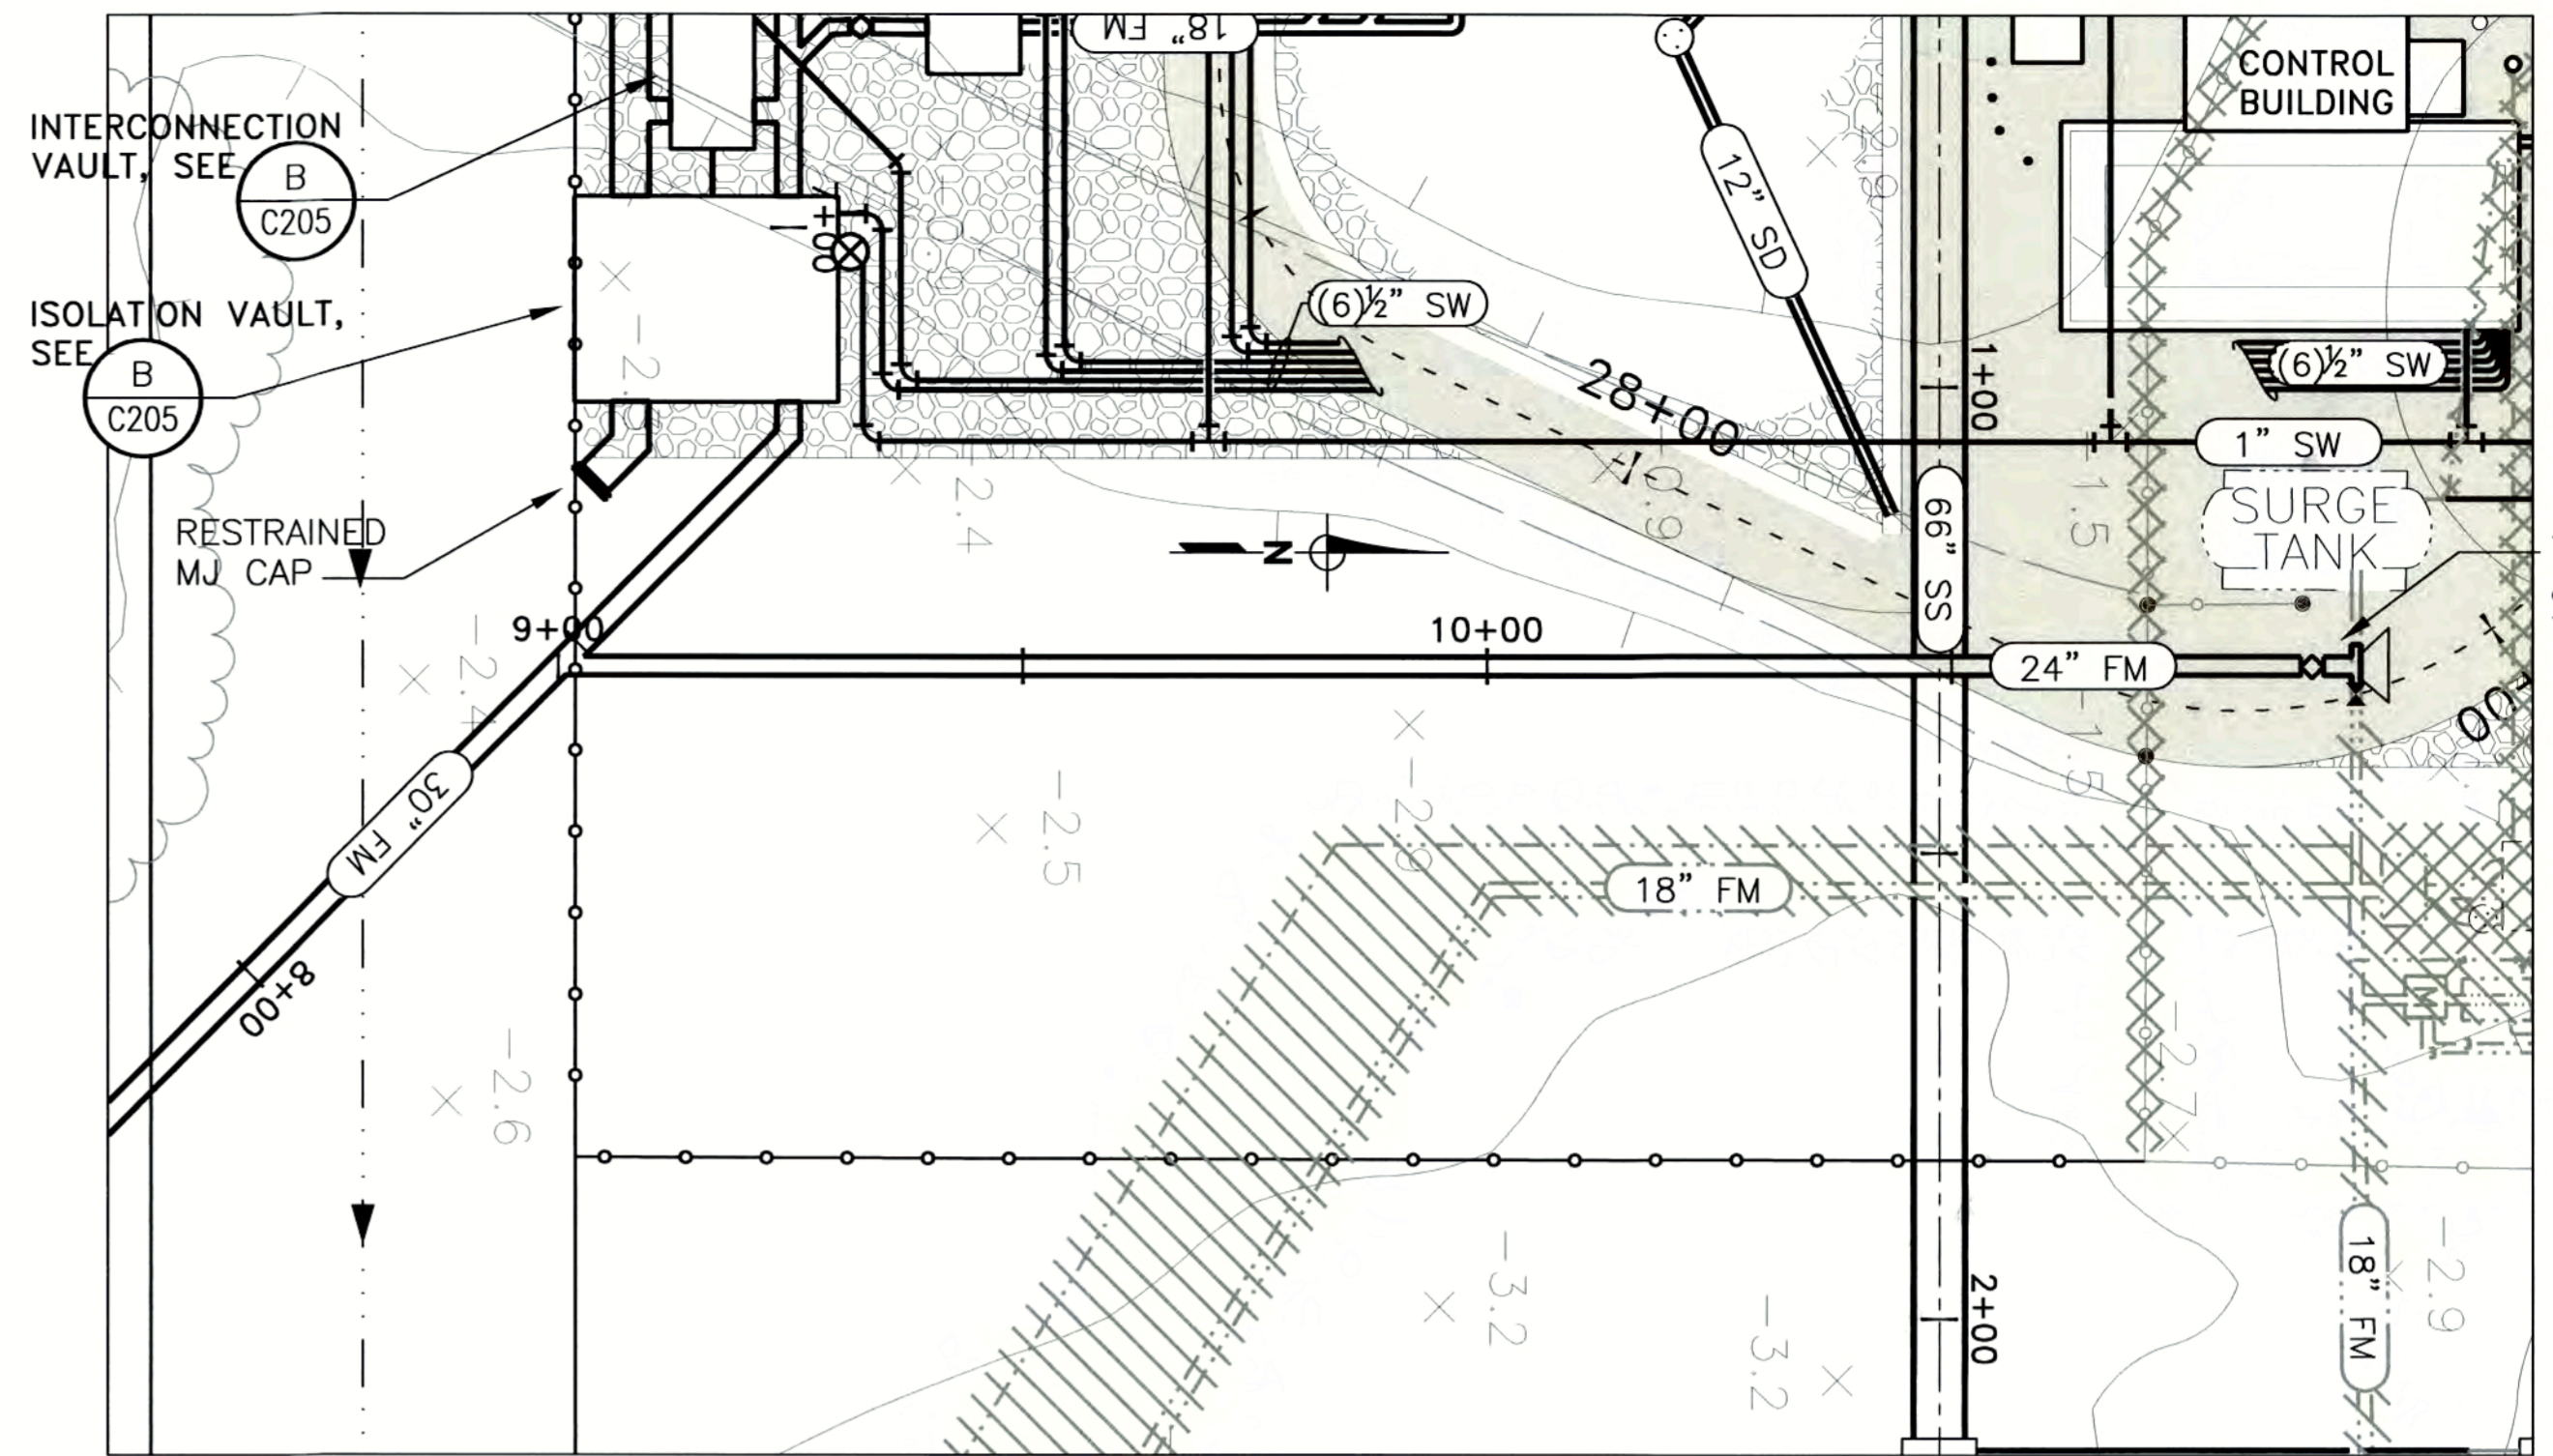

24" FM
PLAN
 SCALE HORIZONTAL: 1"=20'
 VERTICAL: 1"=4'

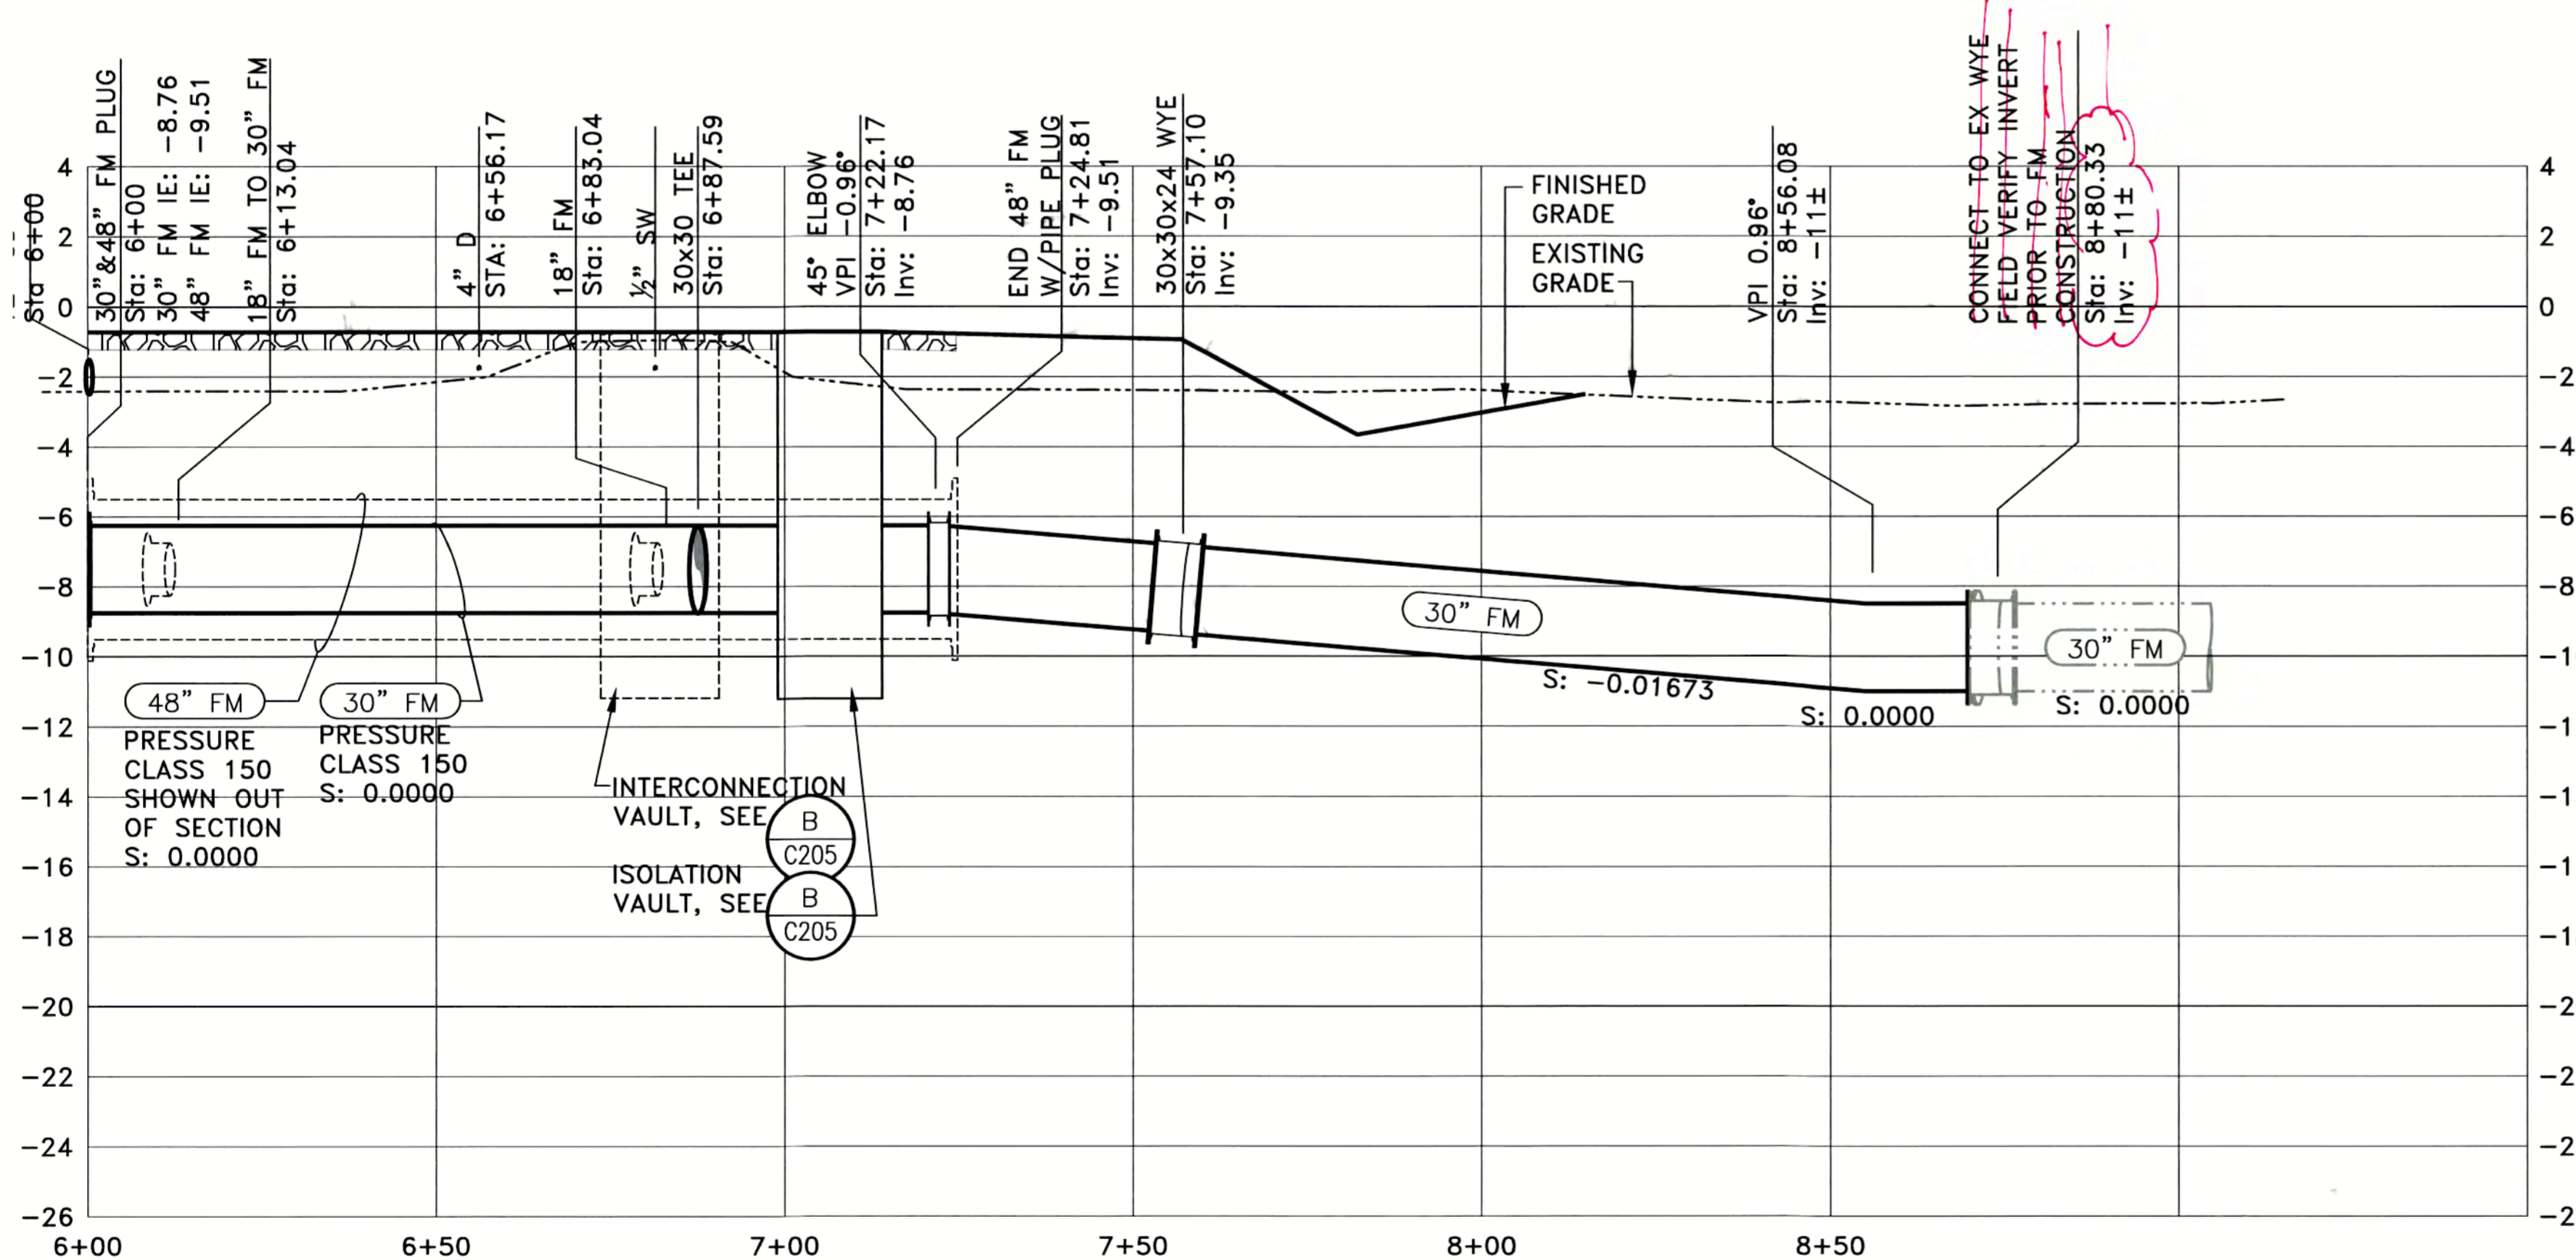

30" FM
PROFILE
 SCALE HORIZONTAL: 1"=20'
 VERTICAL: 1"=4'

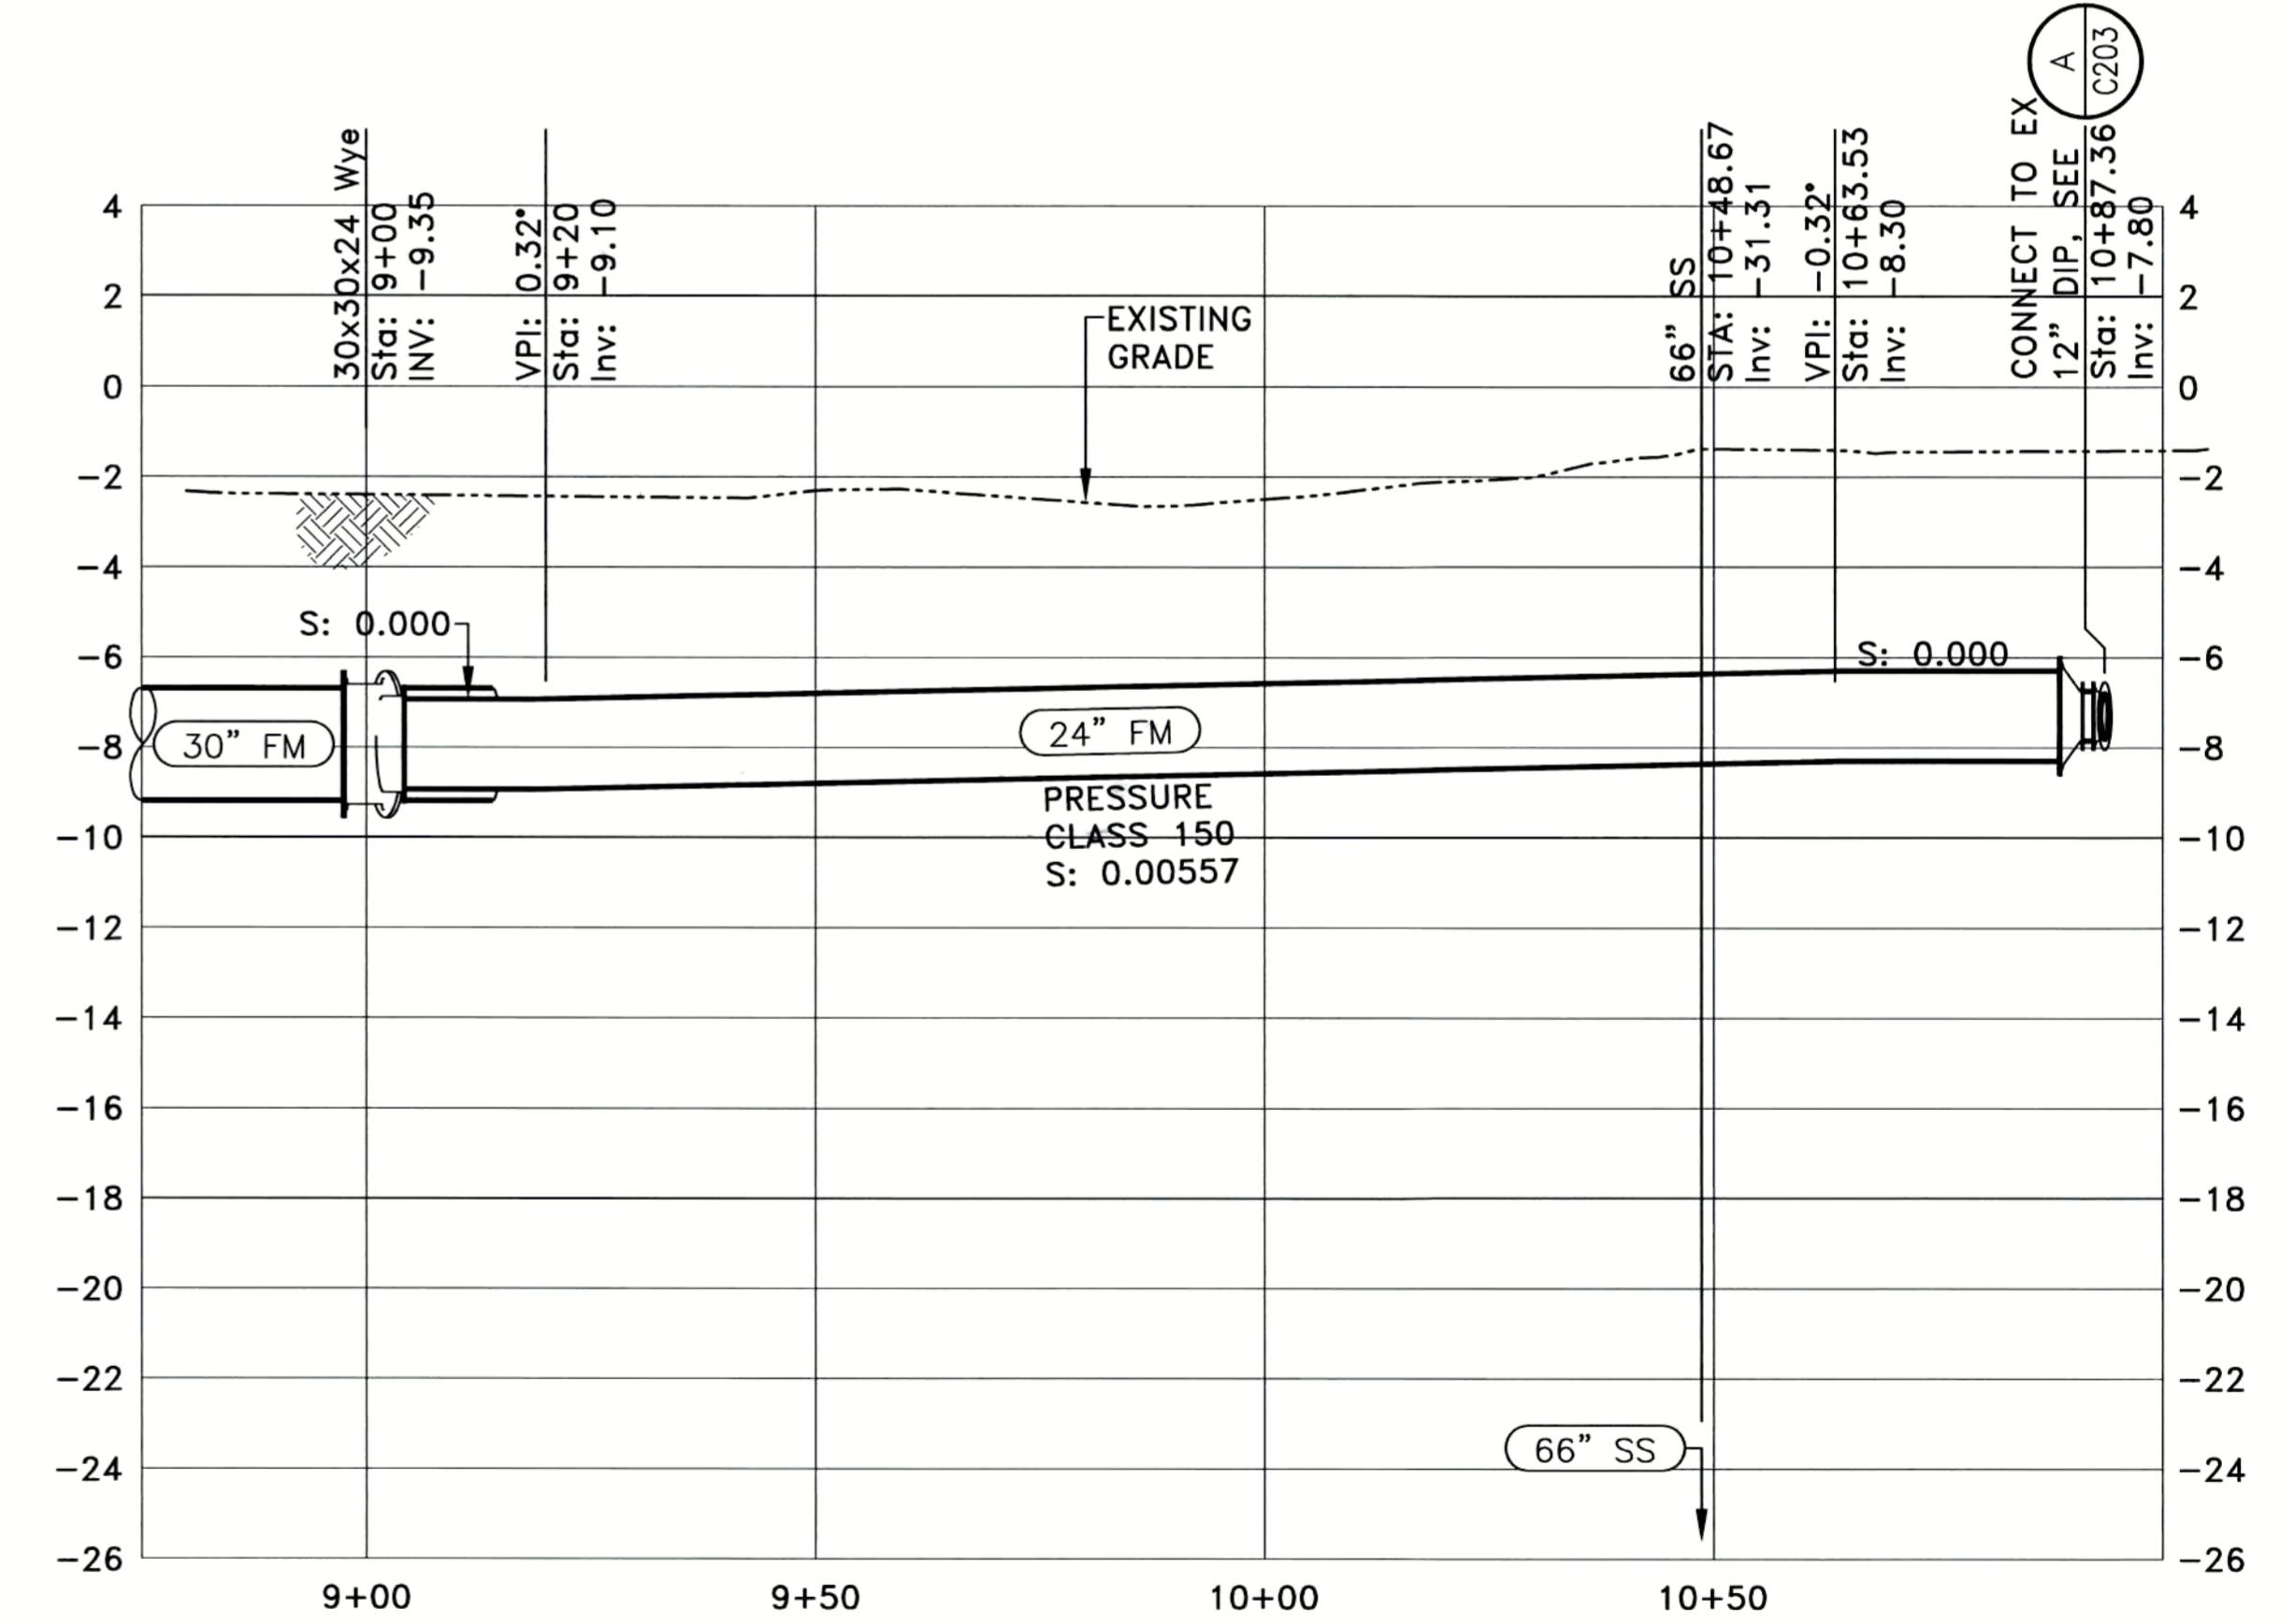

24" FM
PROFILE
 SCALE HORIZONTAL: 1"=20'
 VERTICAL: 1"=4'

RECORD DRAWINGS
14-Mile Slough Pump Station Upgrades
 CIVIL PLAN & PROFILES 2



N:\Clients\293 - Sports\00-05-01 14-MSFS Upgrades\Submittals\293-0501\04&105.dwg 11-13-08 09:26:16 AM dreimer










REV. No.	DISCRPTION	DATE	BY	Aprv'd By
1				
2				
3				
4				
5				
6				
7				

WEST YOST ASSOCIATES
 Consulting Engineers
 1260 Lake Boulevard
 Suite 240
 Davis, California 95616
 (530) 756-5905
 FAX (530) 756-5991

SCALE: AS SHOWN	APPROVED BY: DATE: _____	SHEET No. C105
DESIGNED BY: PDF		of 89 SHEETS
DRAWN BY: DTD		PROJECT No. 293-00-05-01
CHECKED BY: GDH	ASSISTANT DIRECTOR, DEPT. OF MUNICIPAL UTILITIES	
RECORD Dwg.:		

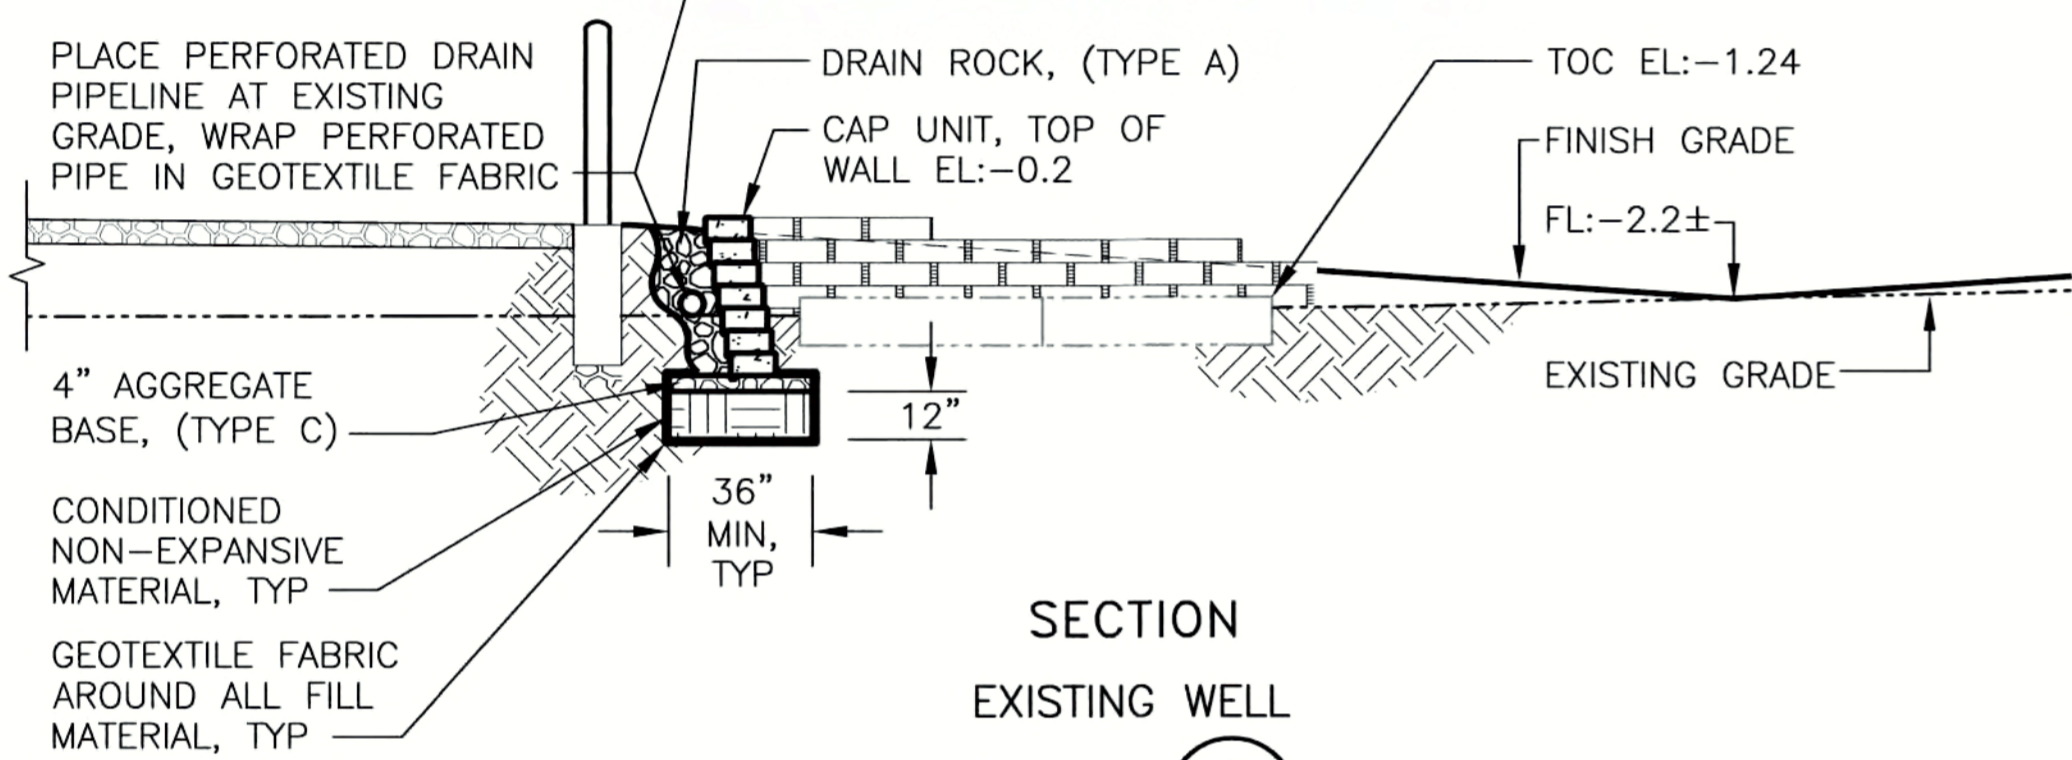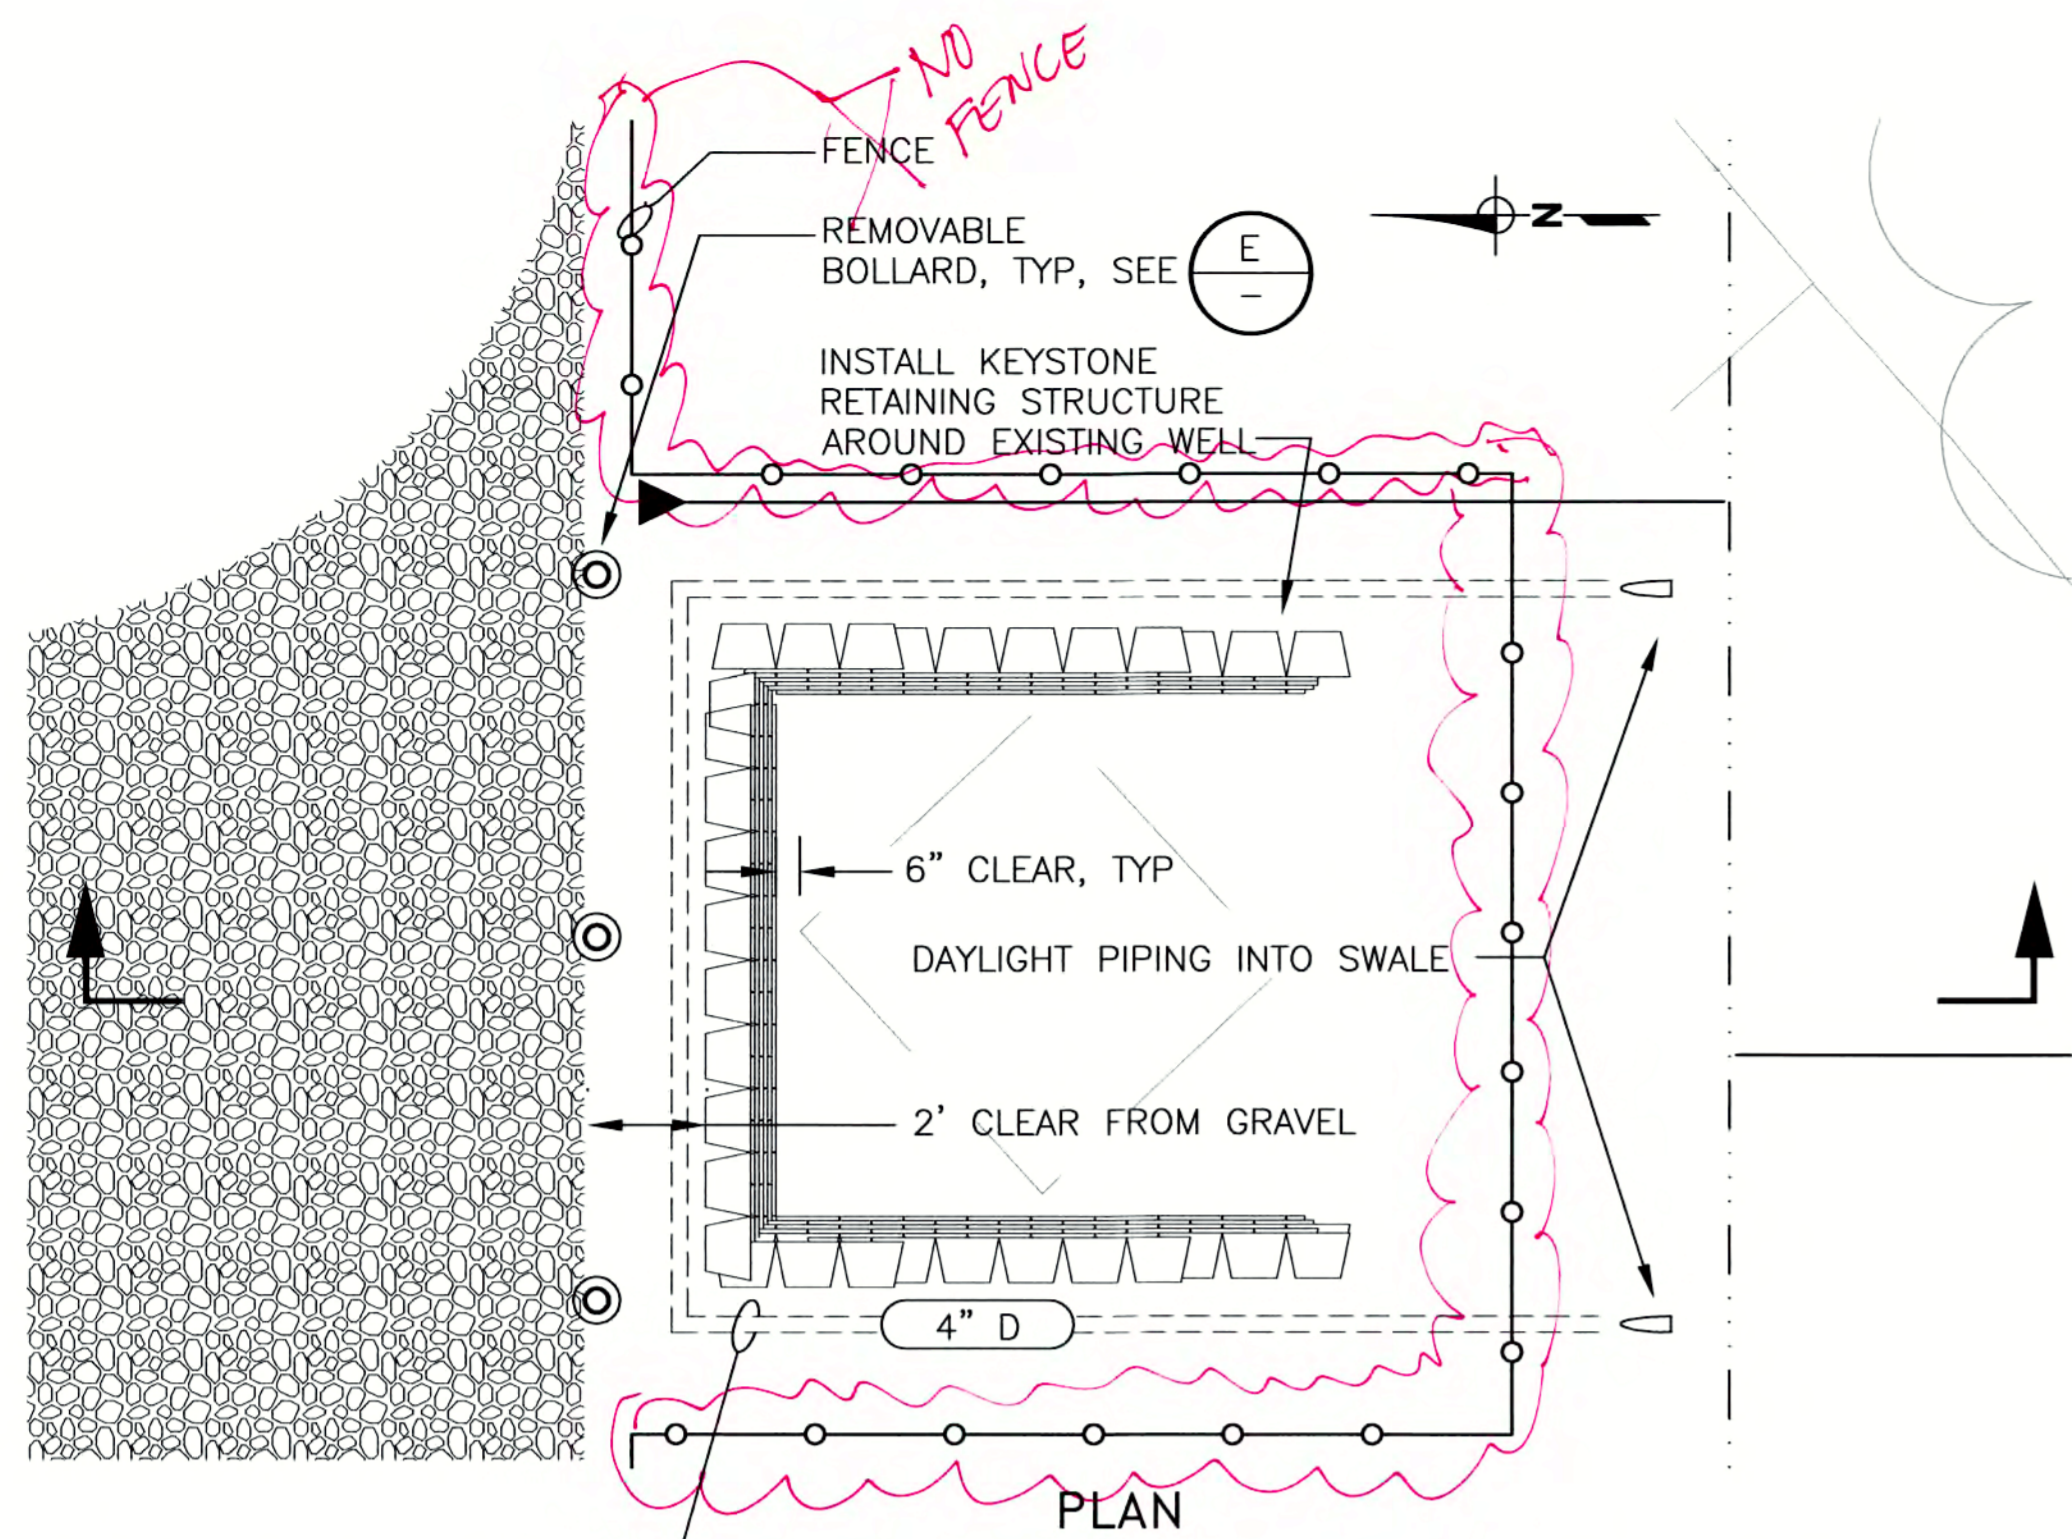

SECTION EXISTING WELL
DETAIL (A) C1 & C7
SCALE: 1/4"=1'-0"

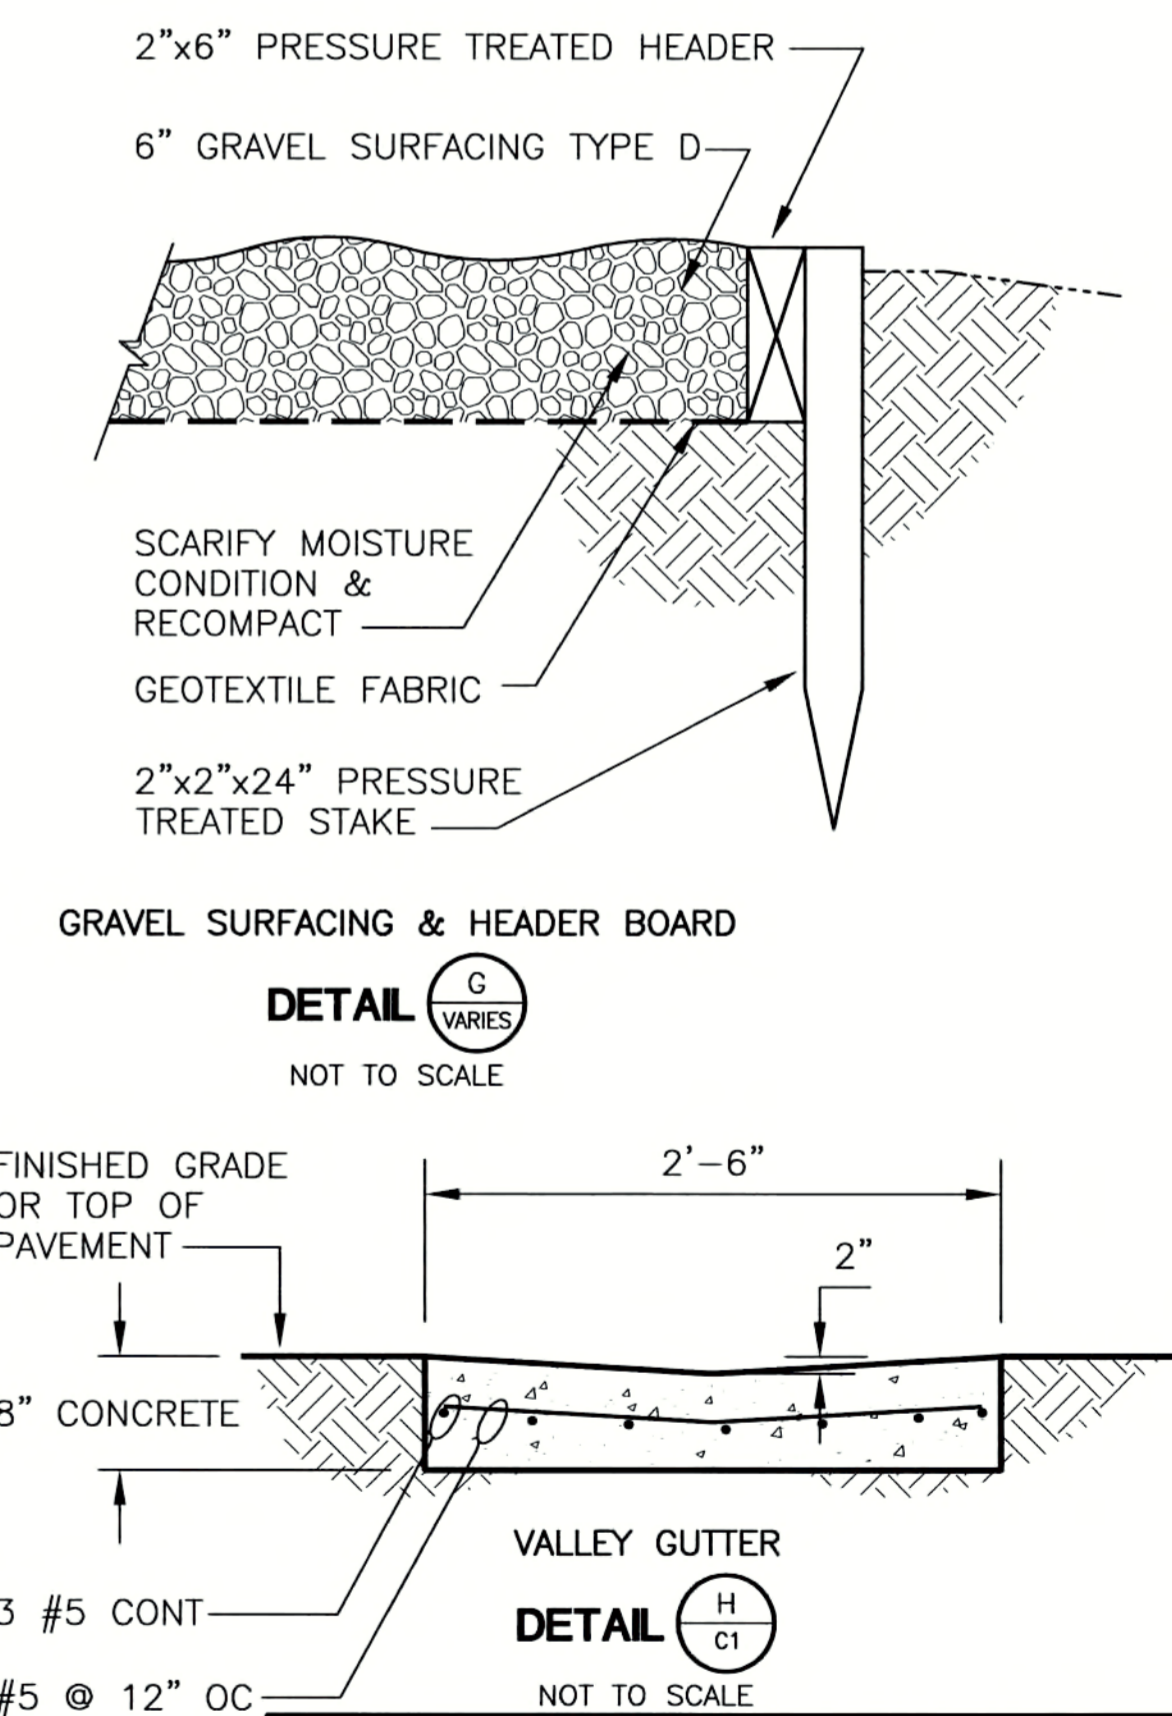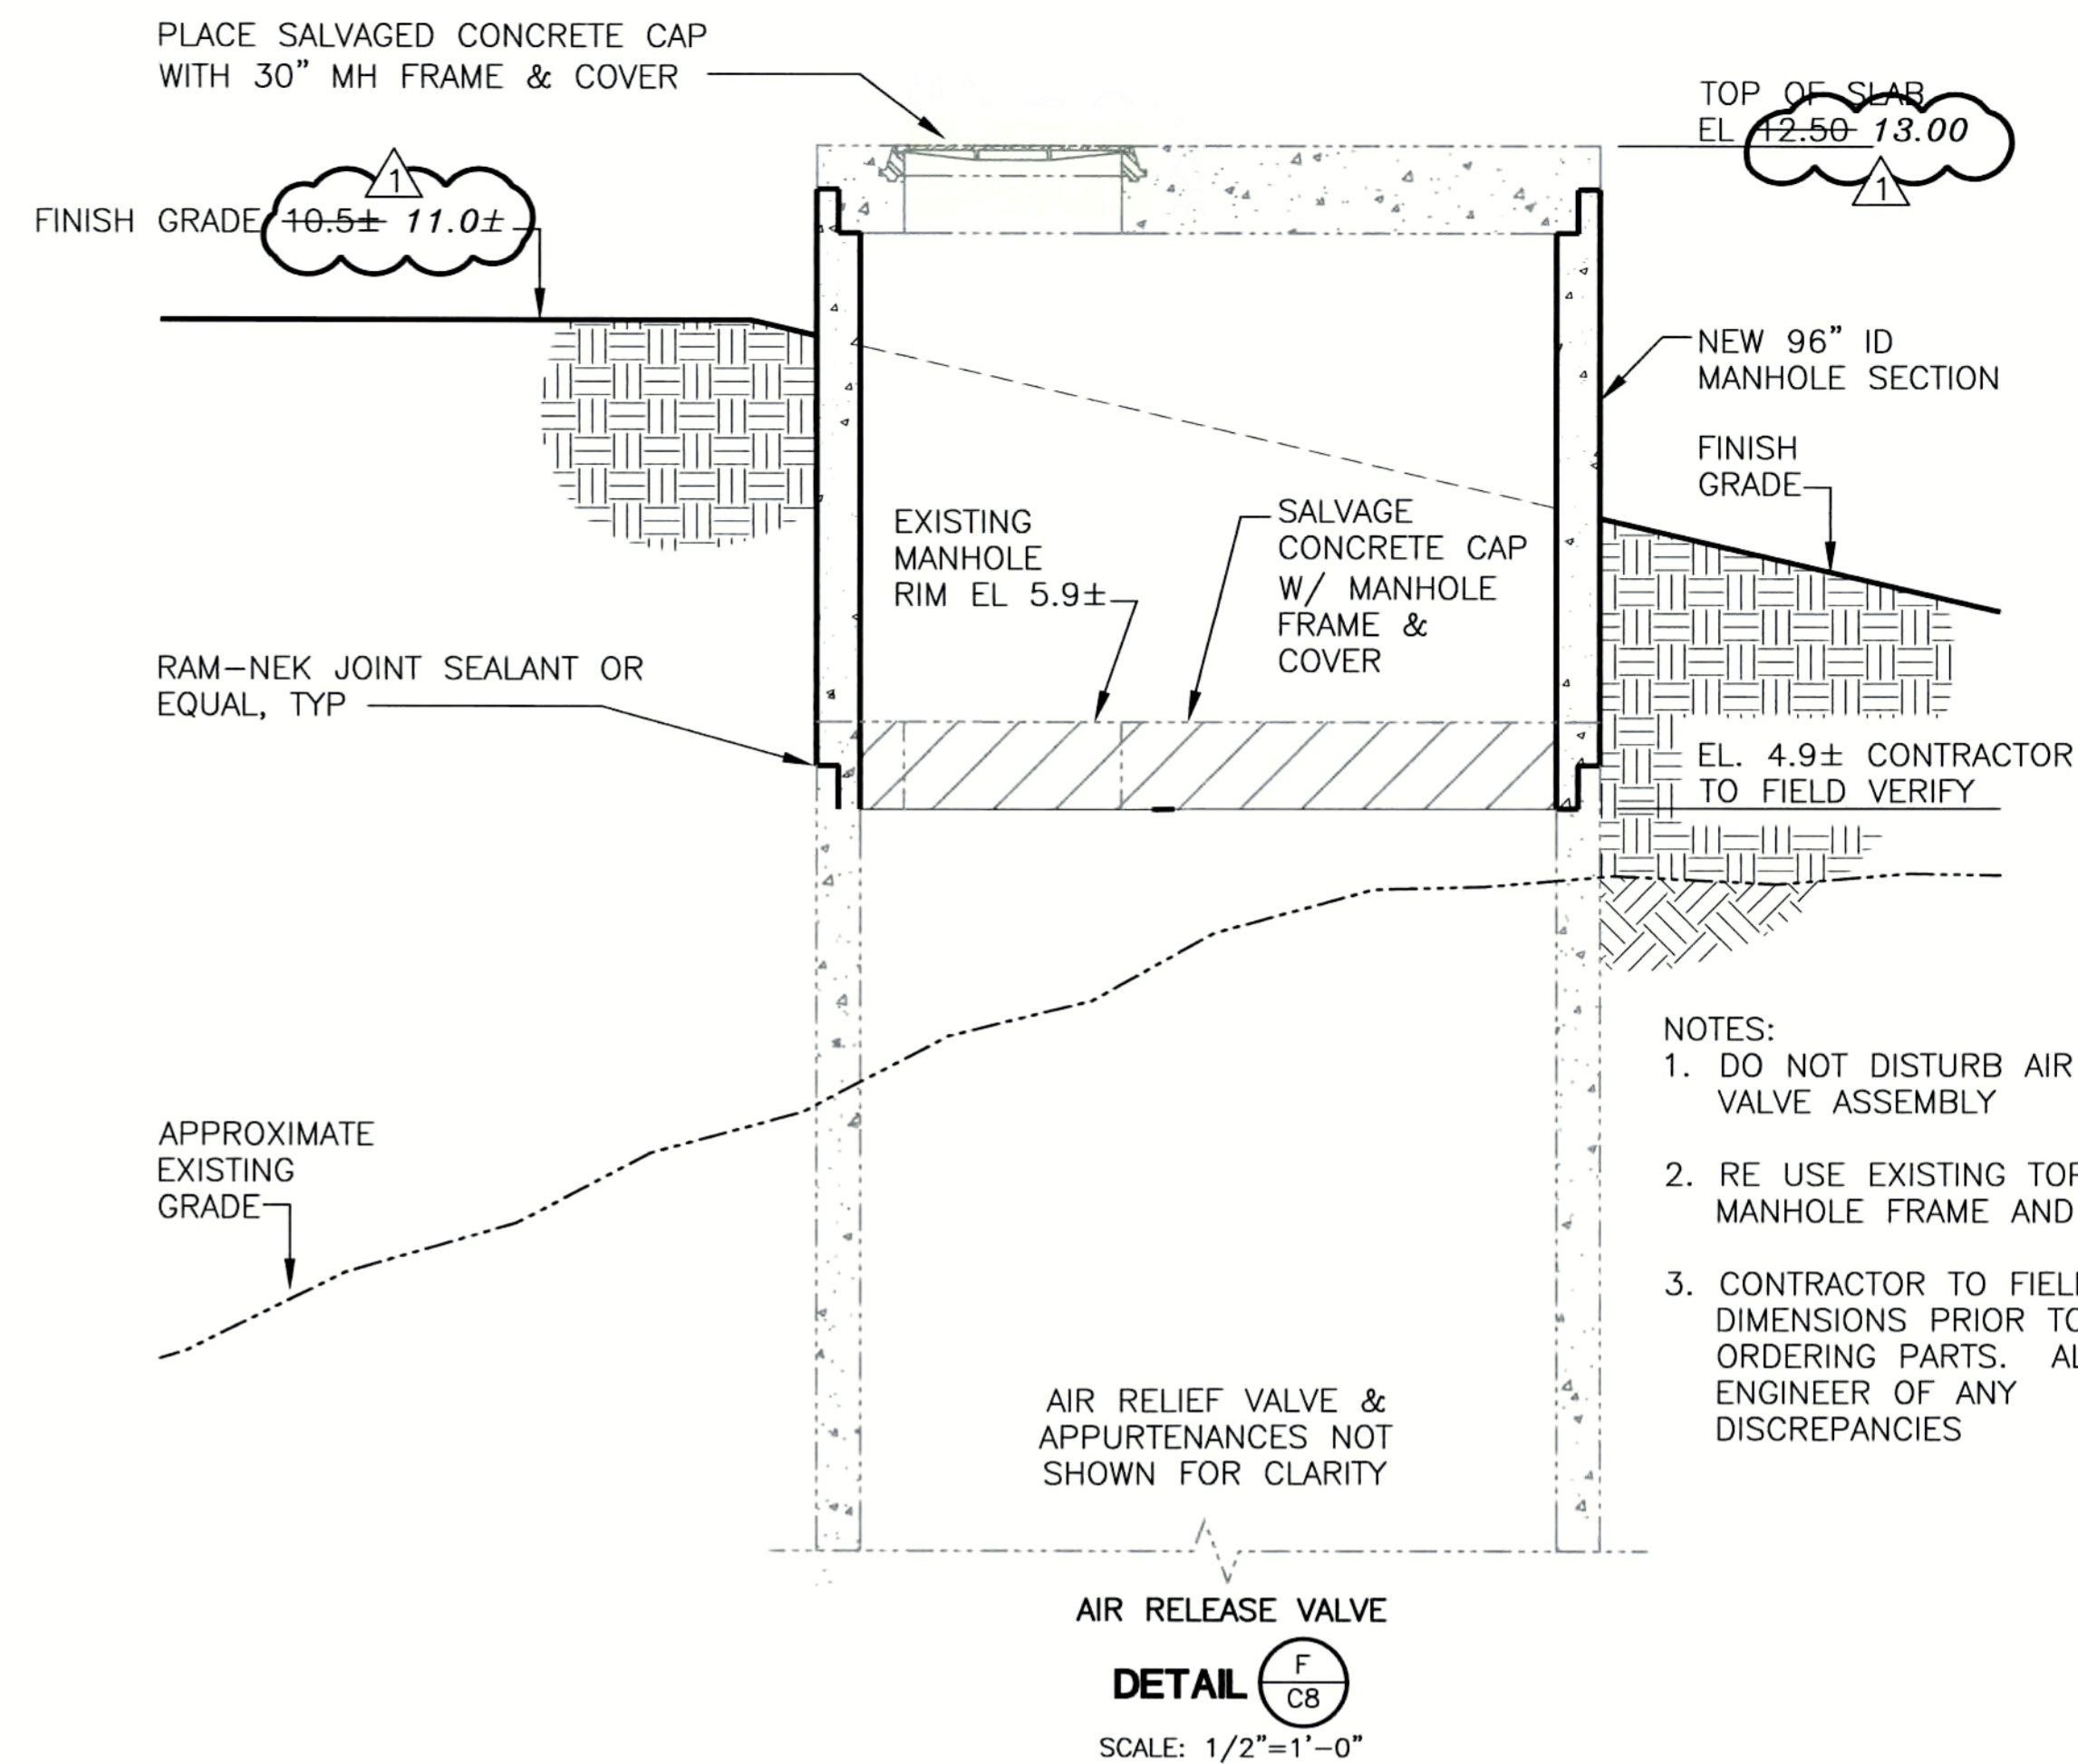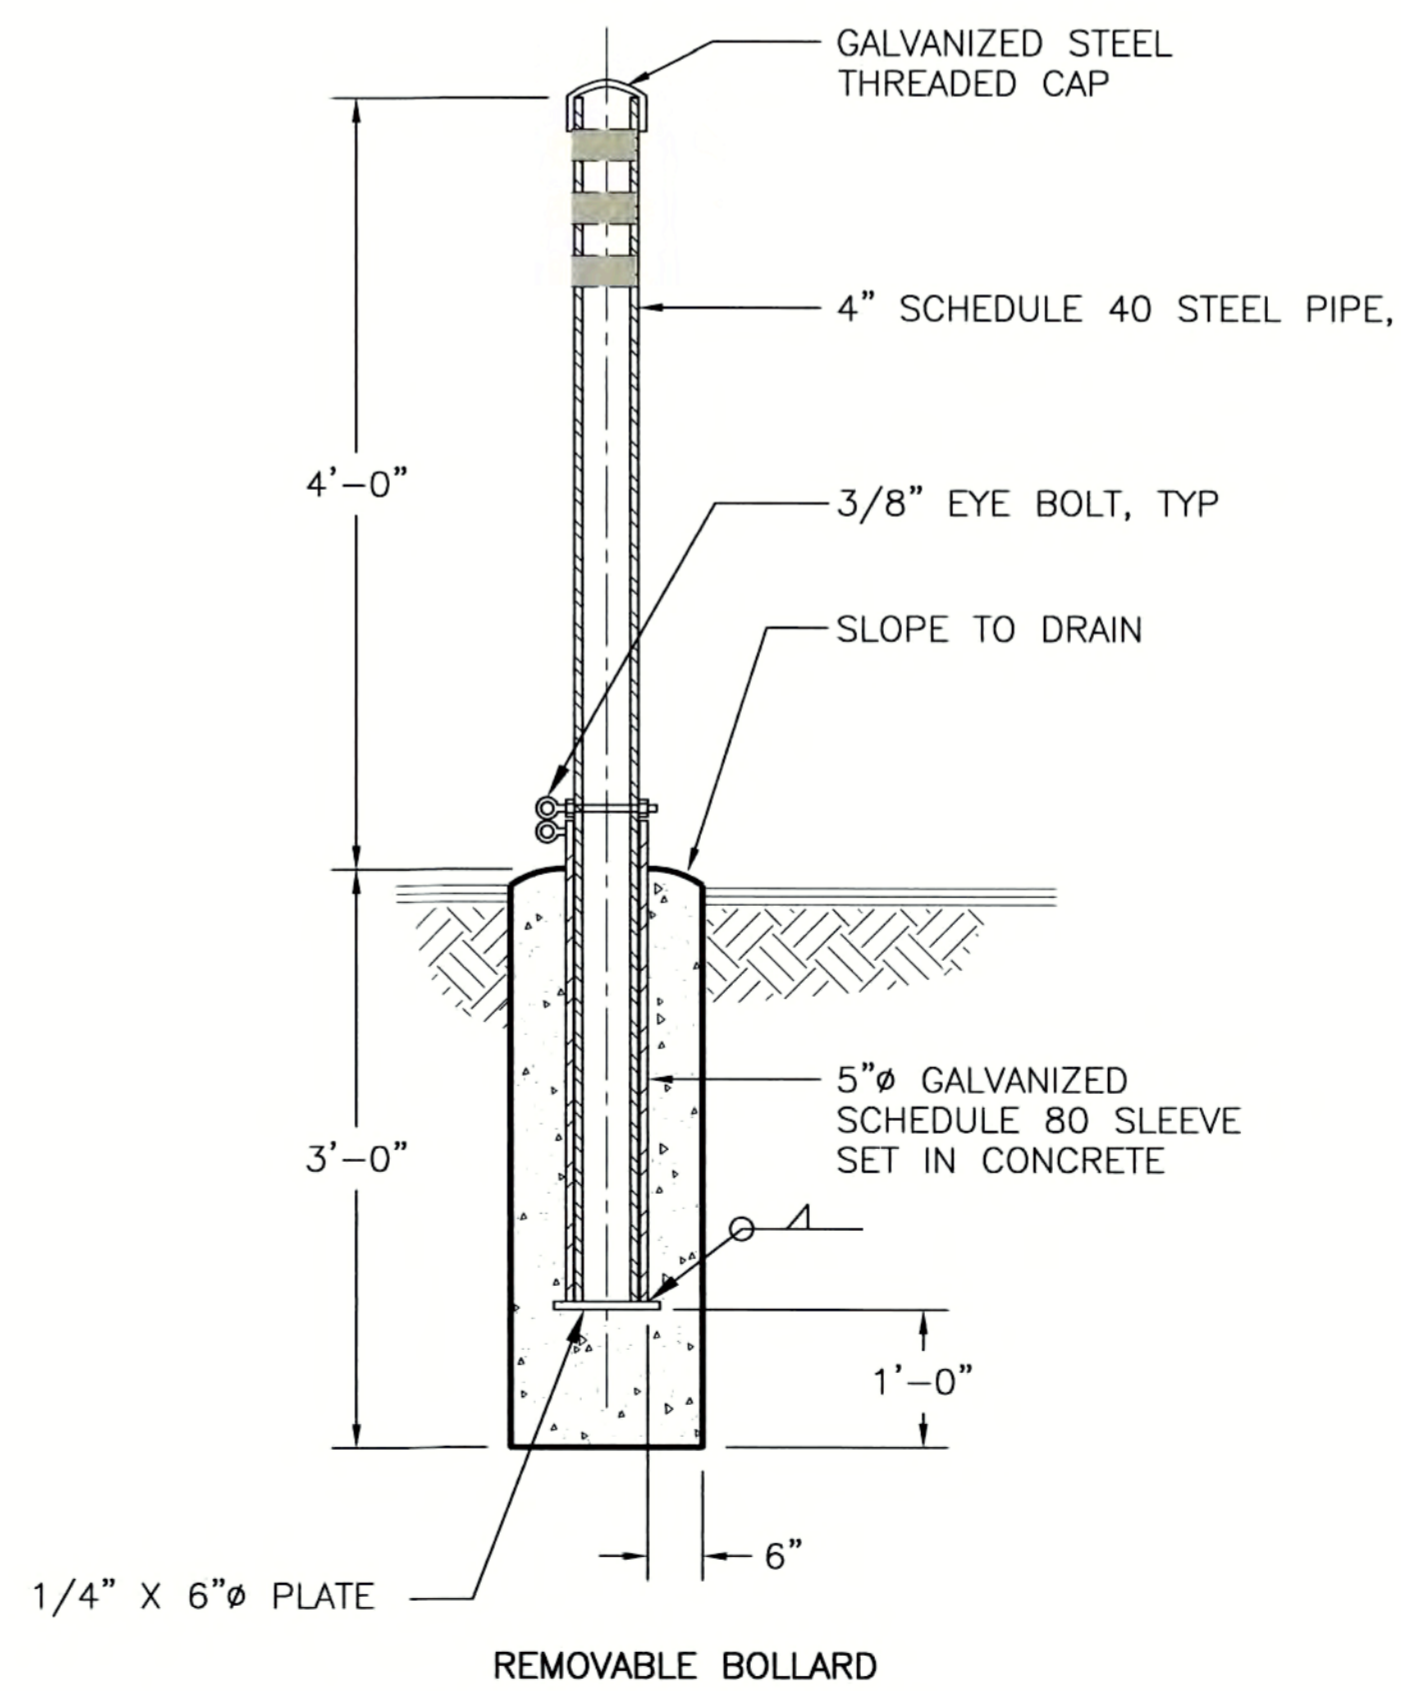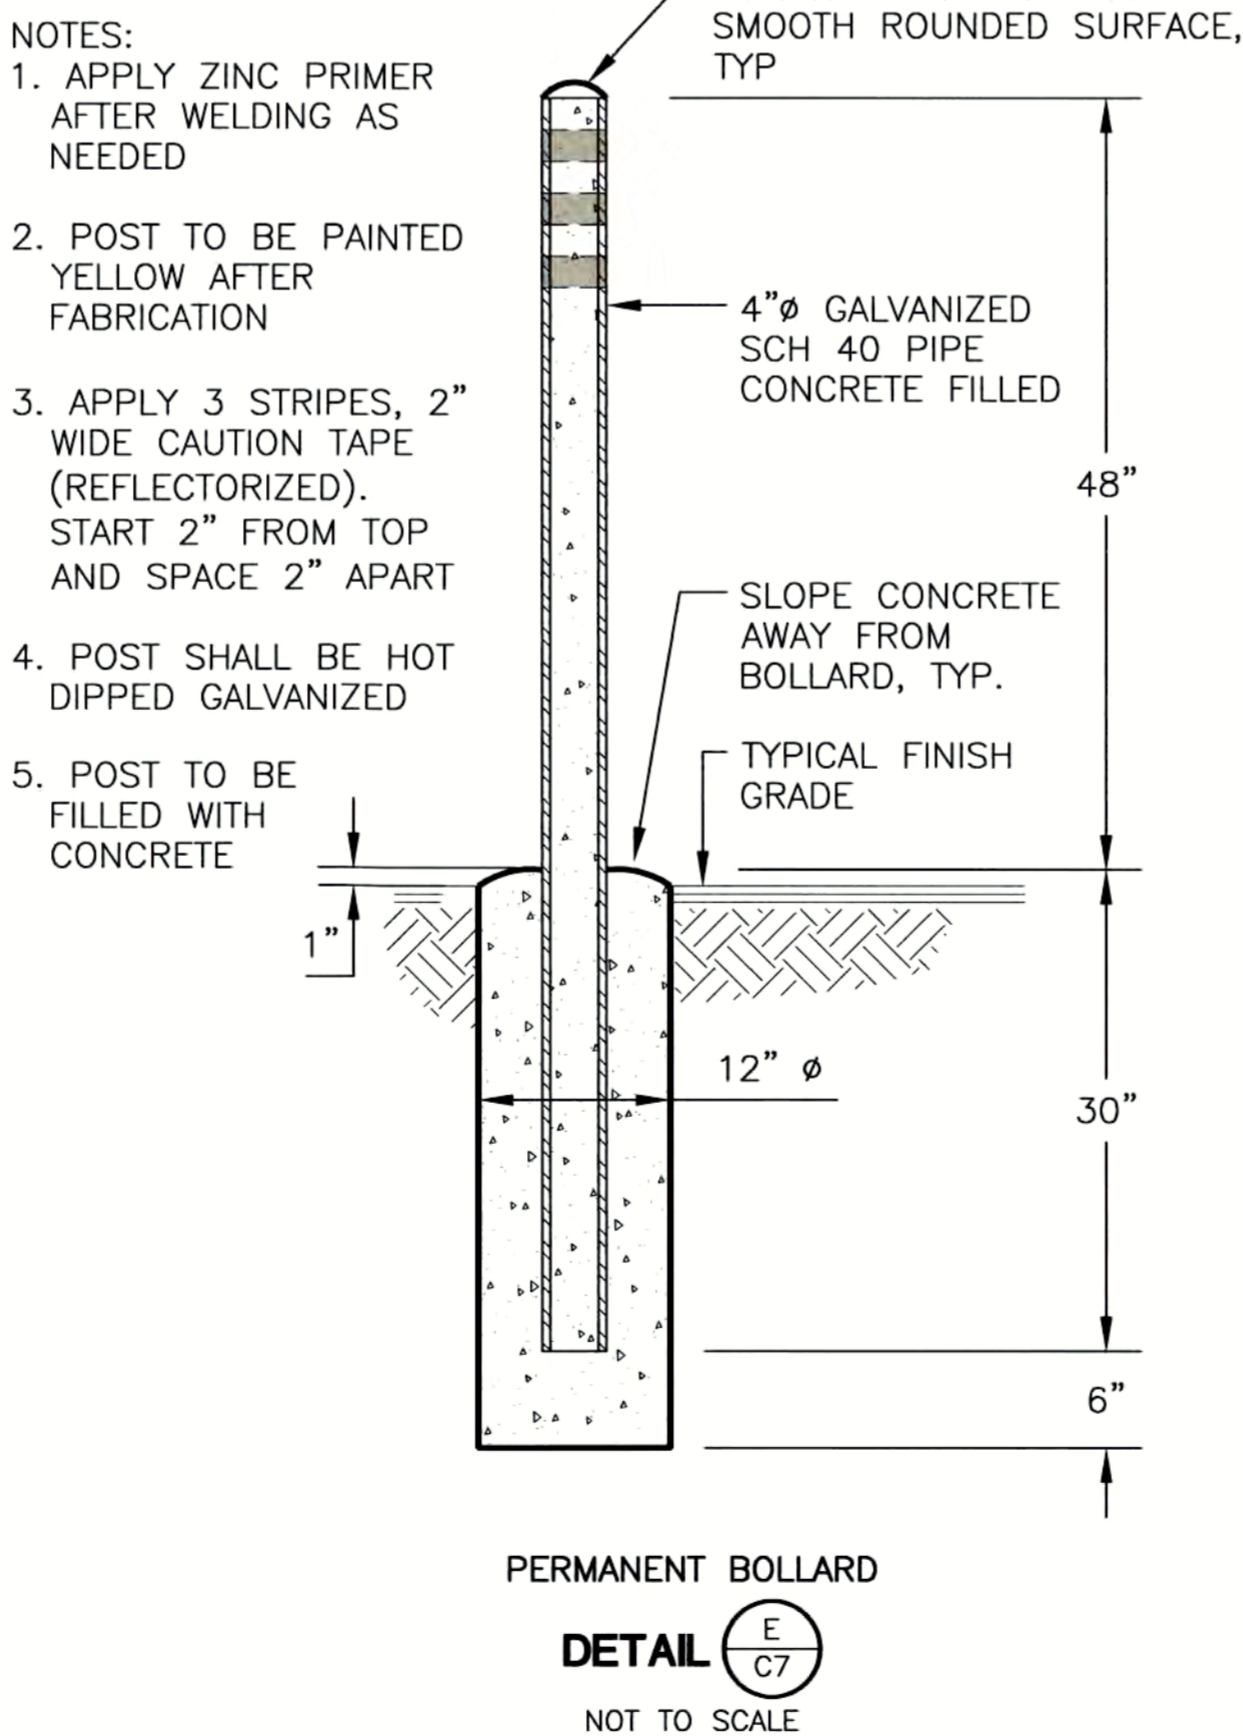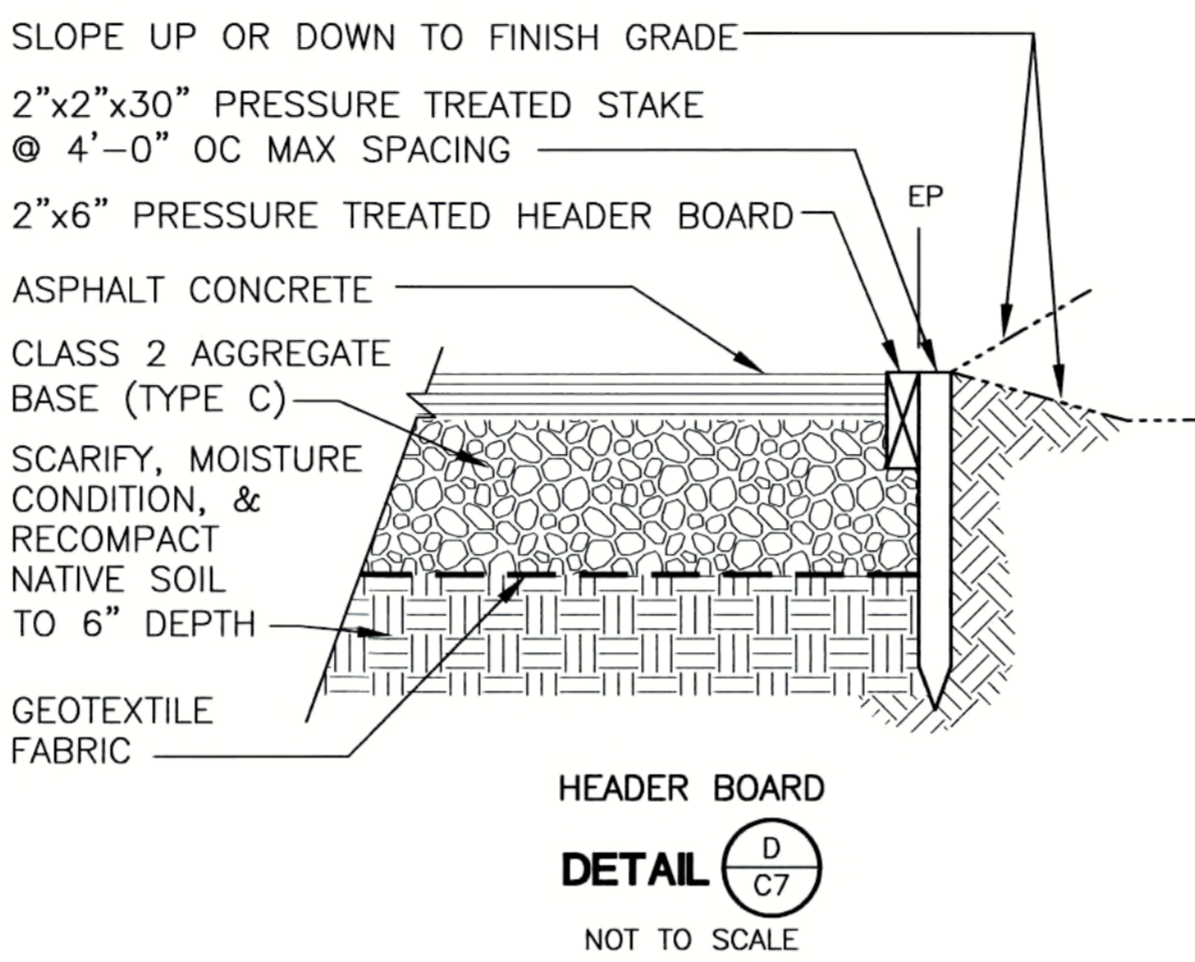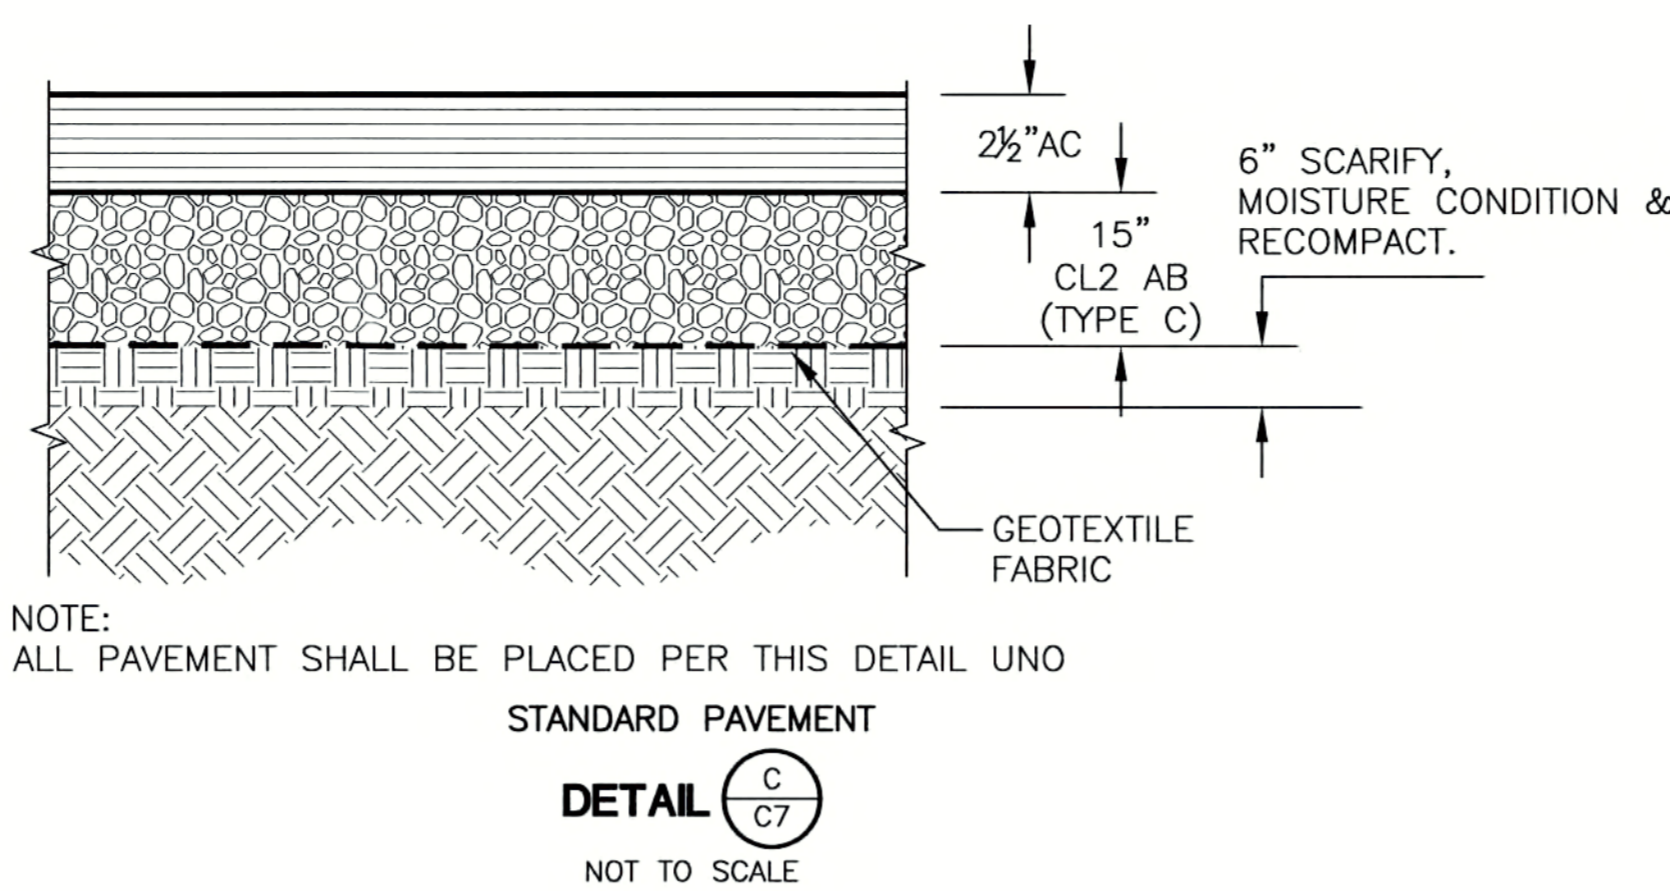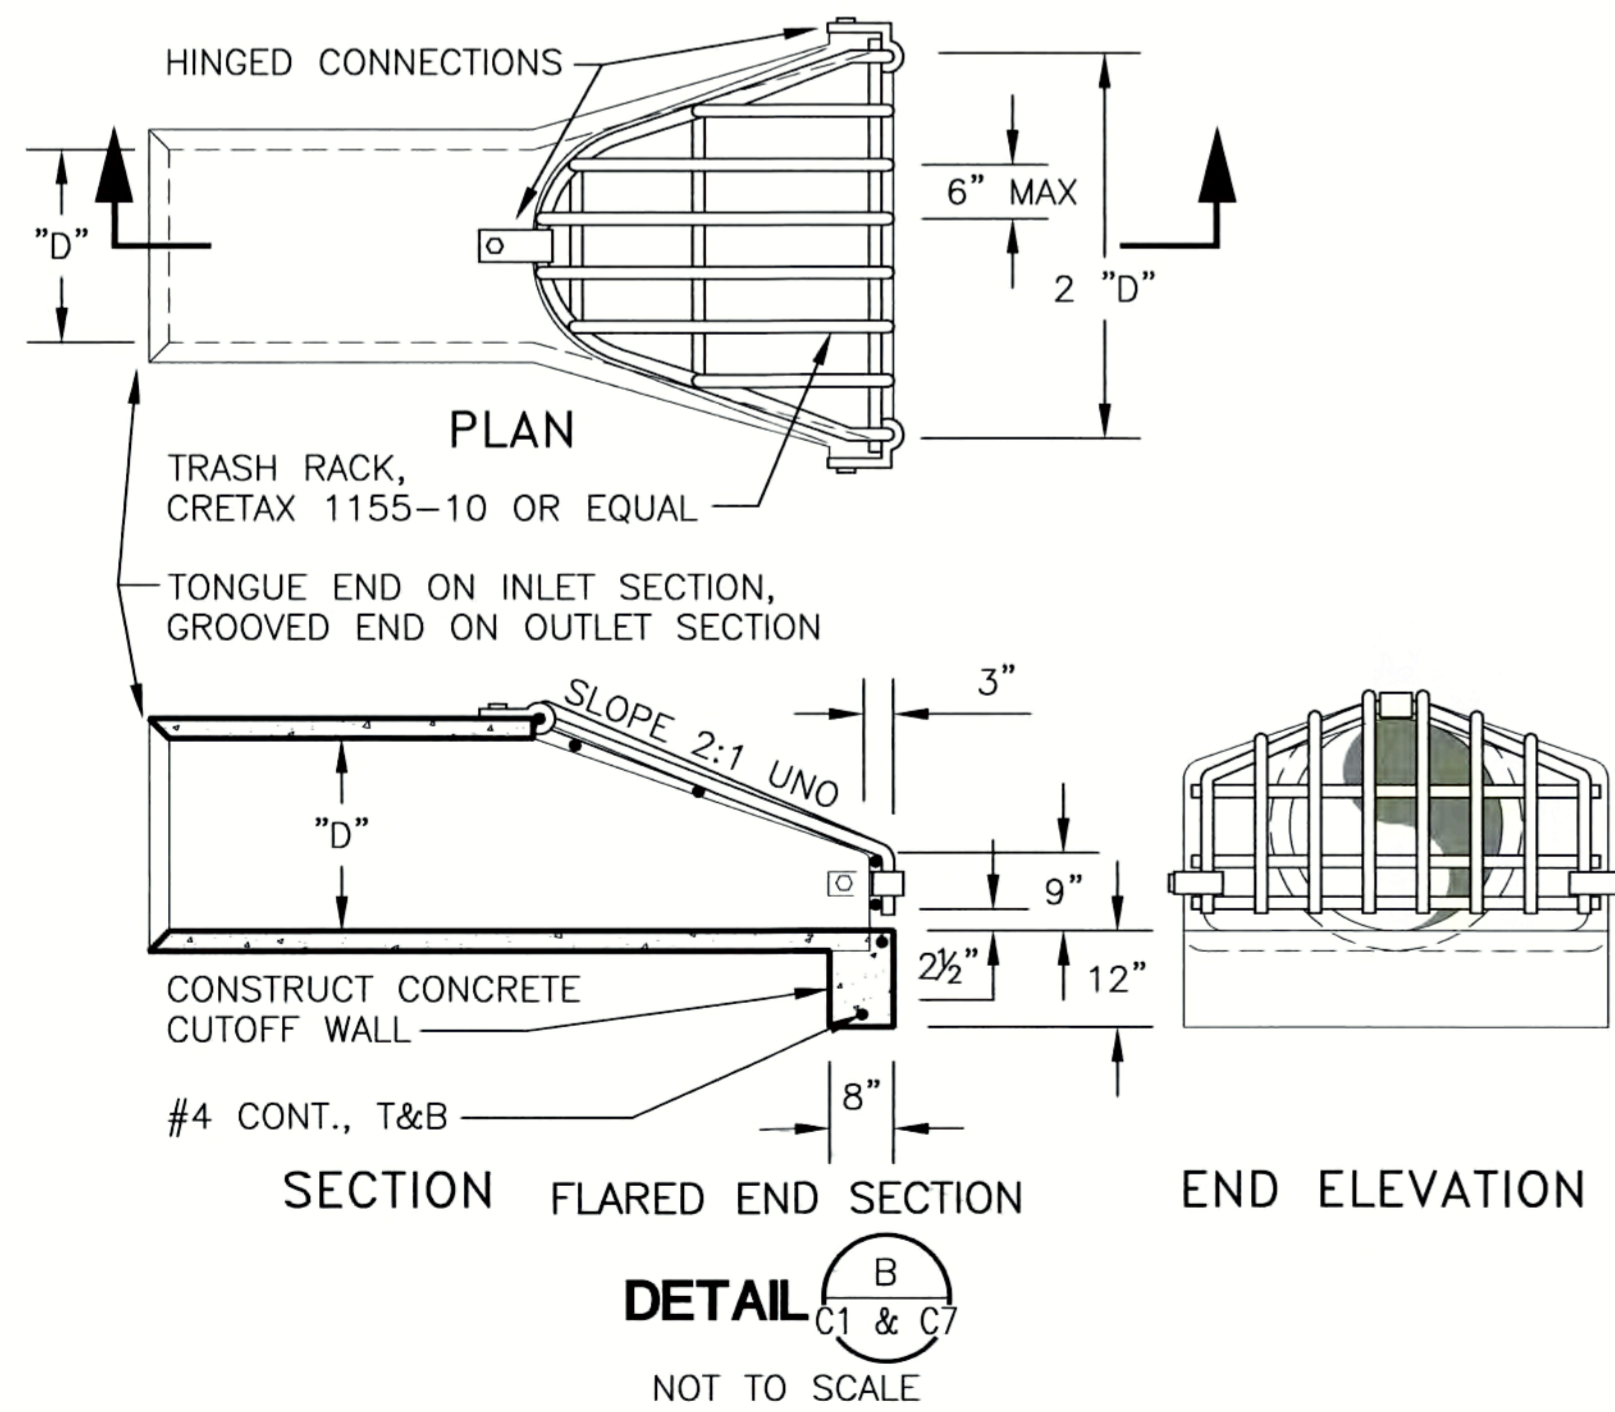

RECORD DRAWINGS
14-Mile Slough Pump Station Upgrades
CIVIL DETAILS 1




REV. No.	DISCRPTION	DATE	BY	Appr'd By
1	ADDENDUM No. 3	5/25/06	TTT	PDF
2				
3				
4				
5				
6				
7				

WEST YOST ASSOCIATES
Consulting Engineers
1260 Lake Boulevard
Suite 240
Davis, California 95616
(530) 756-5905
FAX (530) 756-5991


SCALE: AS SHOWN	APPROVED BY: DATE:	SHEET No. C201
DESIGNED BY: TTT		19 of 89 SHEETS
DRAWN BY: DTD		PROJECT No. 293-00-05-01
CHECKED BY: GDH	ASSISTANT DIRECTOR, DEPT. OF MUNICIPAL UTILITIES	
RECORD DWG.:		

N:\clients\293 - Spores\00-05-01 14-MSPS Upgrade\CAD\Design\Asbuilt\293-0501\2201.dwg 11-13-08 09:26:40 AM dreimer

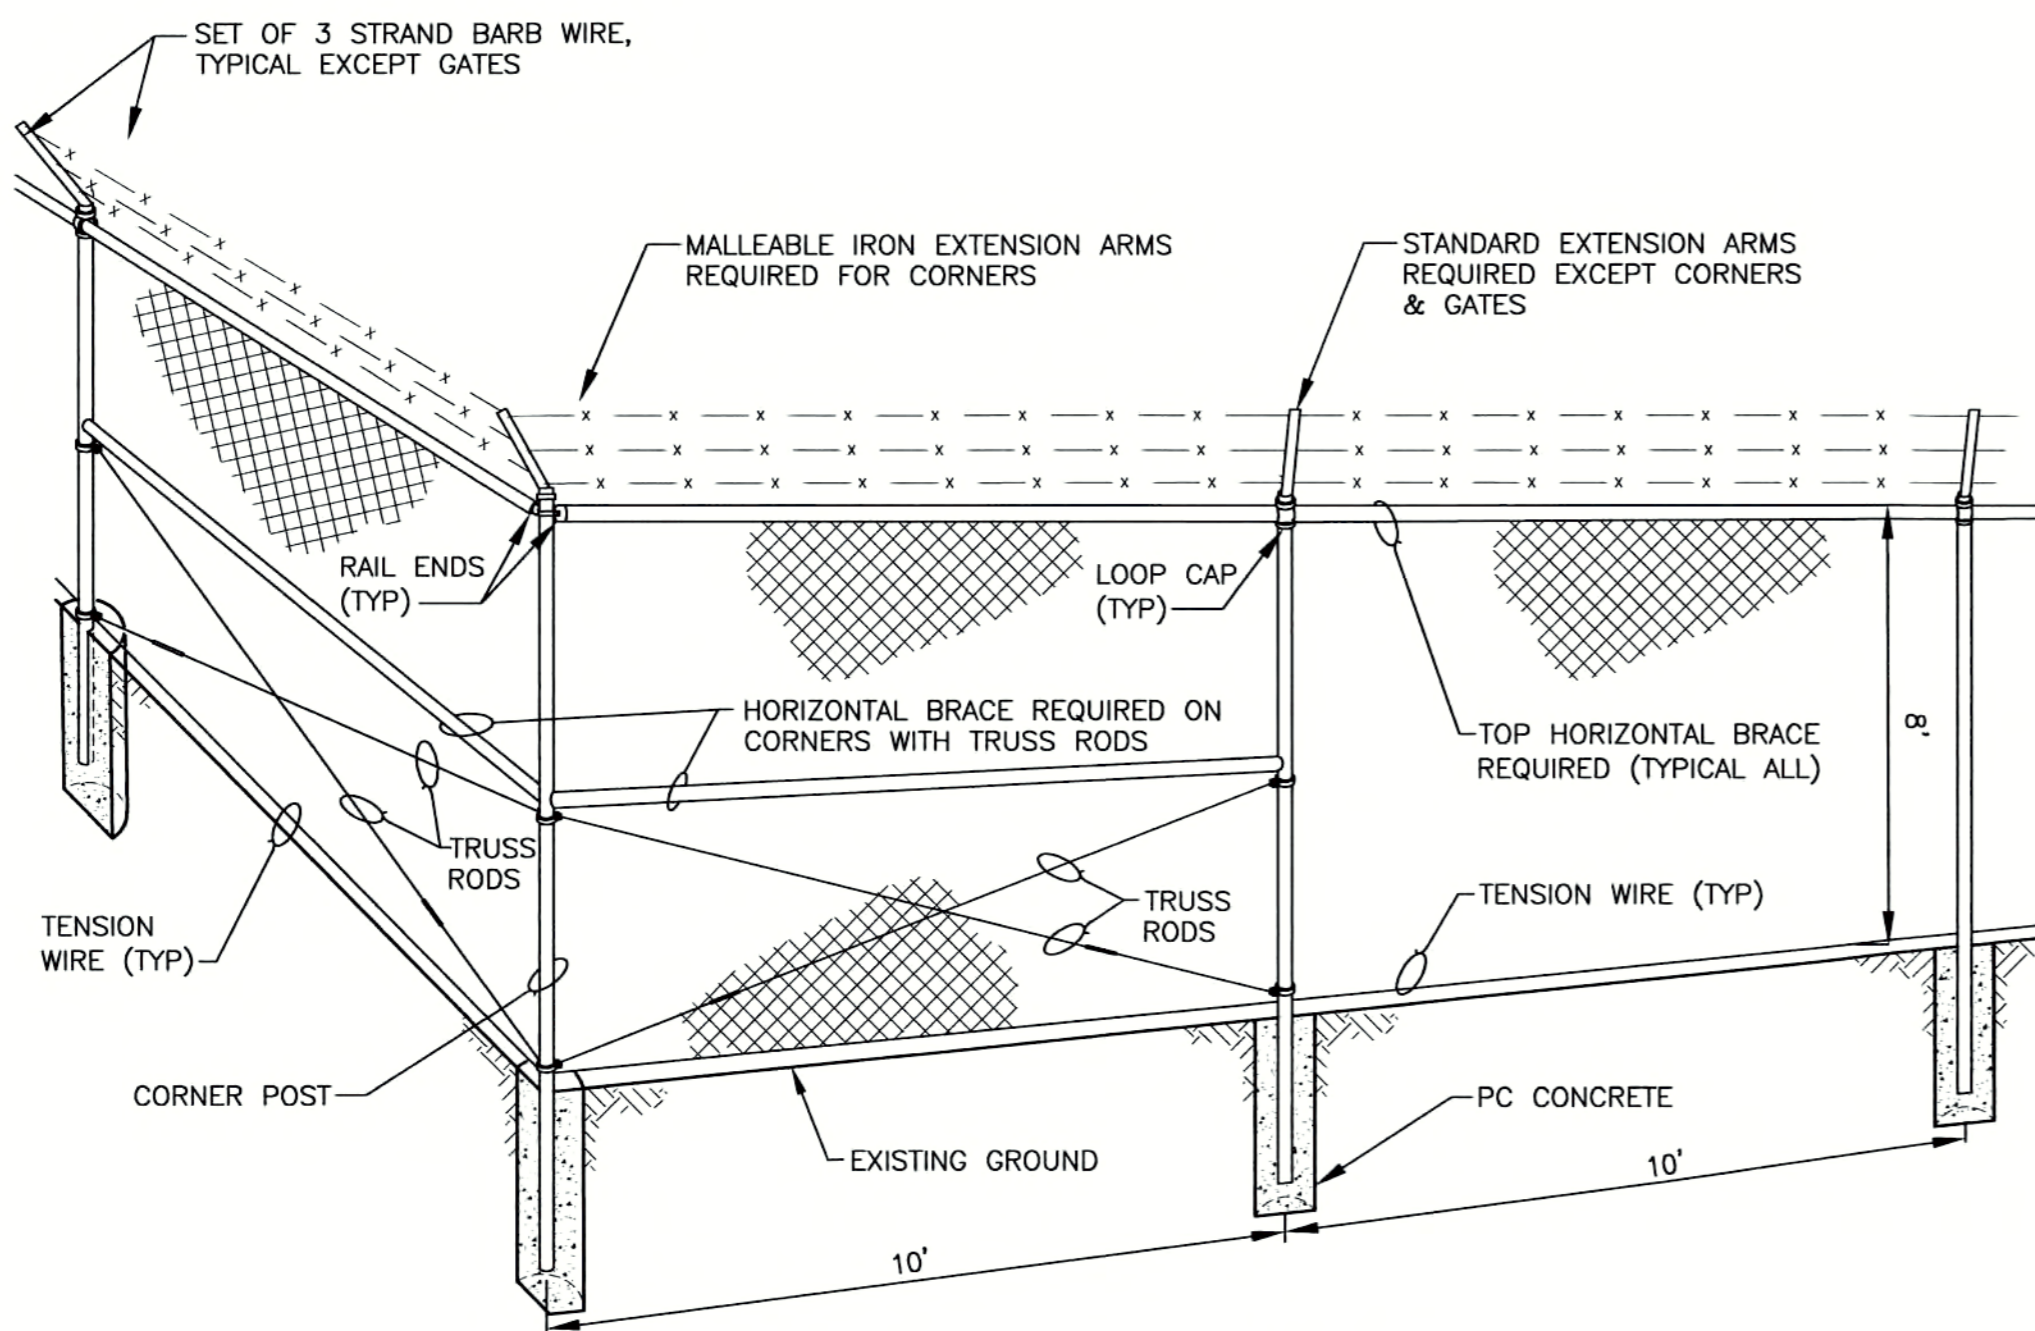


CORNER
DETAIL A/C1
NOT TO SCALE

- NOTES:
1. GATE POST SIZE SHALL BE 5"Ø
 2. LINE POST SIZE SHALL BE 2"Ø
 3. END, LATCH AND CORNER POST SIZE SHALL BE 2.5"Ø
 4. HORIZONTAL BRACE AND TOP RAIL SIZE SHALL BE 1 1/4"Ø
 5. GATE KEEPERS ARE REQUIRED SEE SPECIFICATIONS
 6. TOP RAIL SHALL BE 1 1/4"Ø

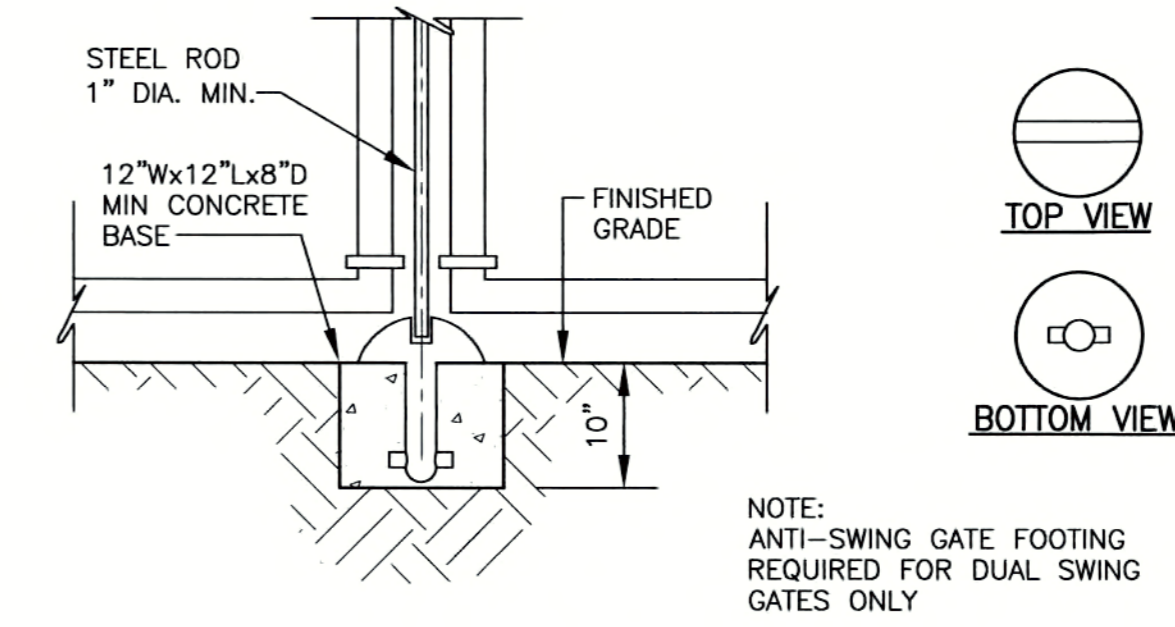


GATE ANTI-SWING FOOTING
DETAIL B
NOT TO SCALE


NOTE:
ANTI-SWING GATE FOOTING
REQUIRED FOR DUAL SWING
GATES ONLY

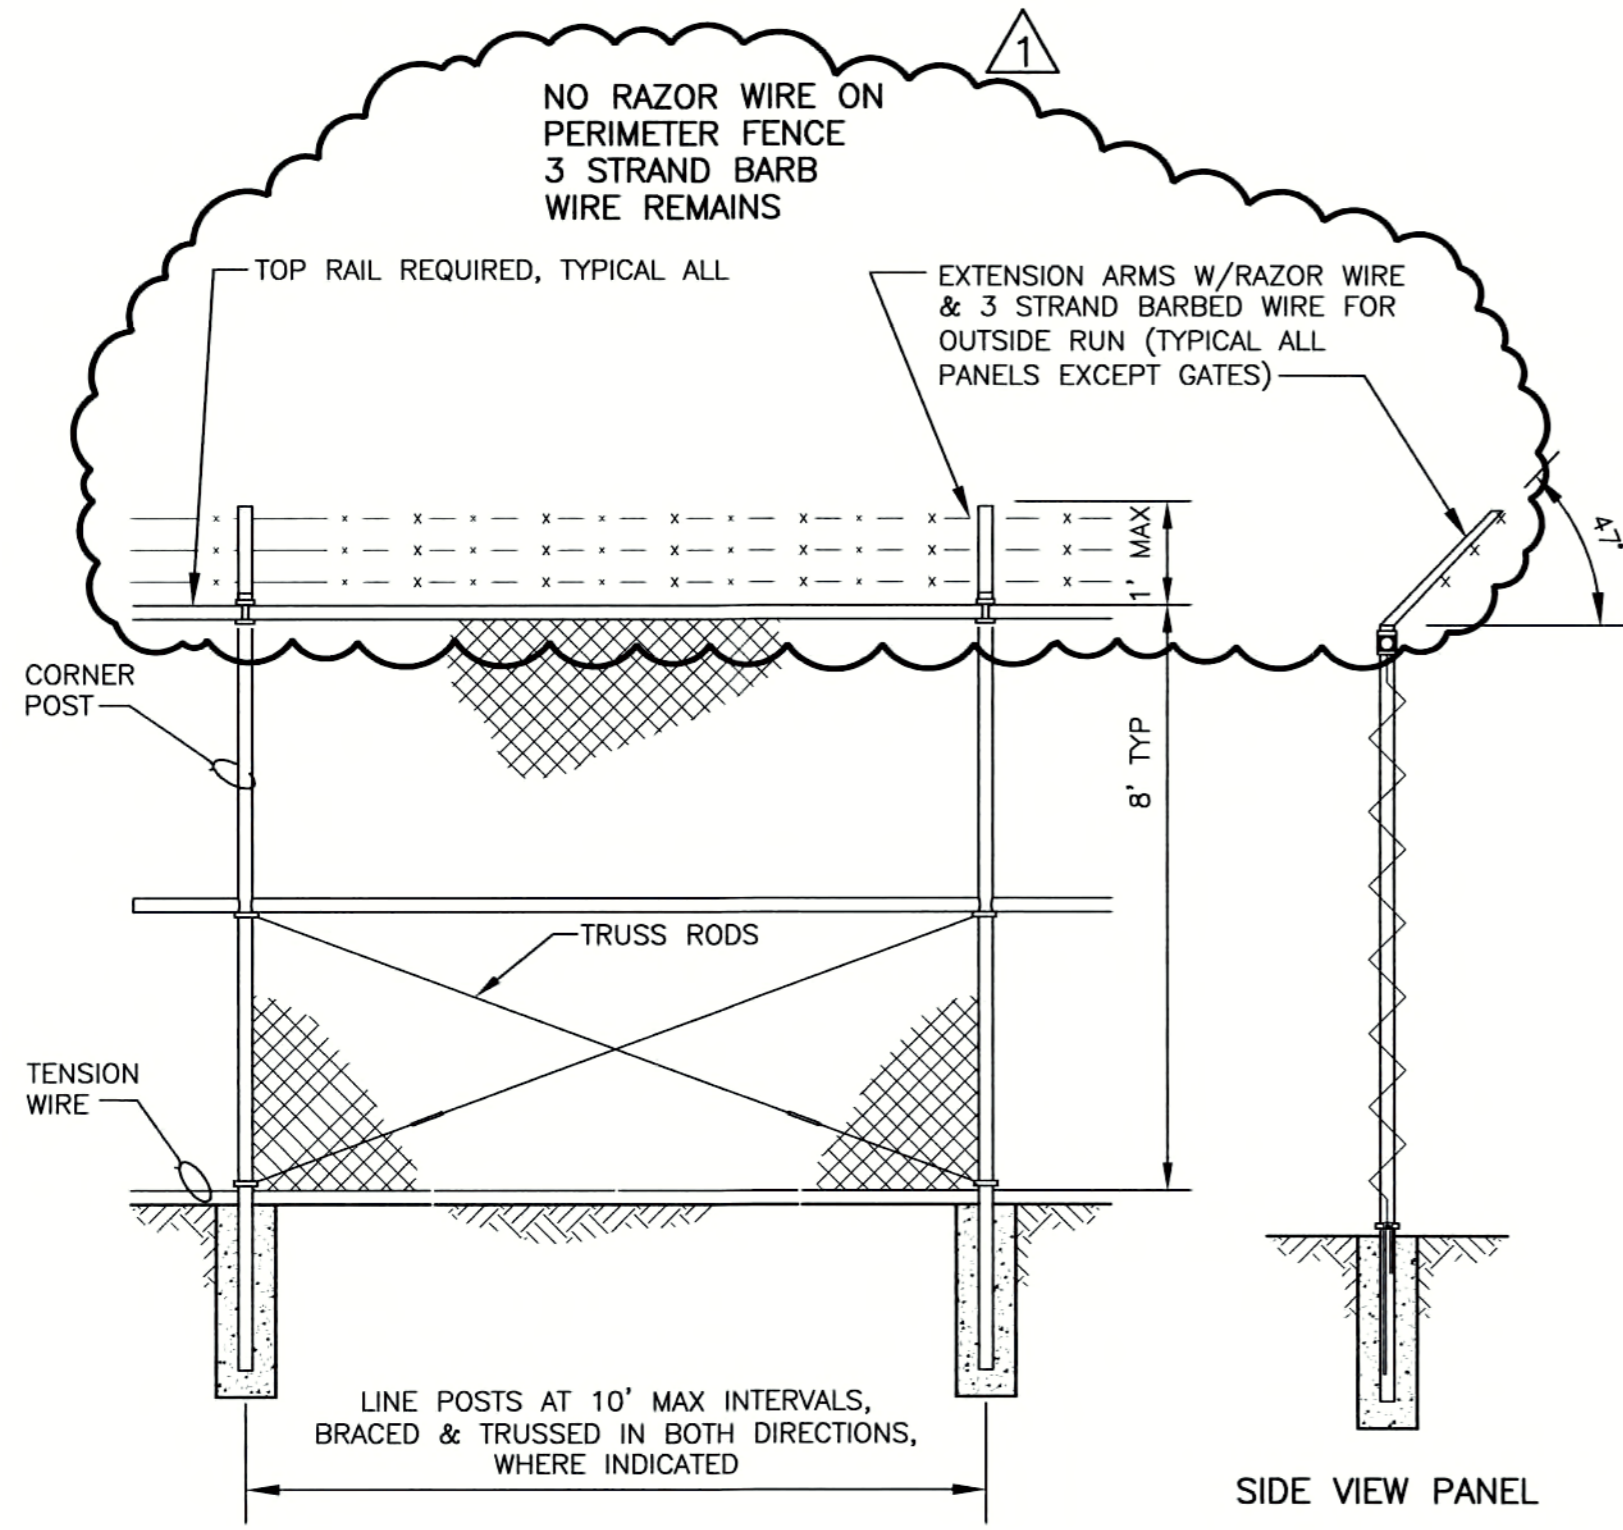


SIDE VIEW PANEL

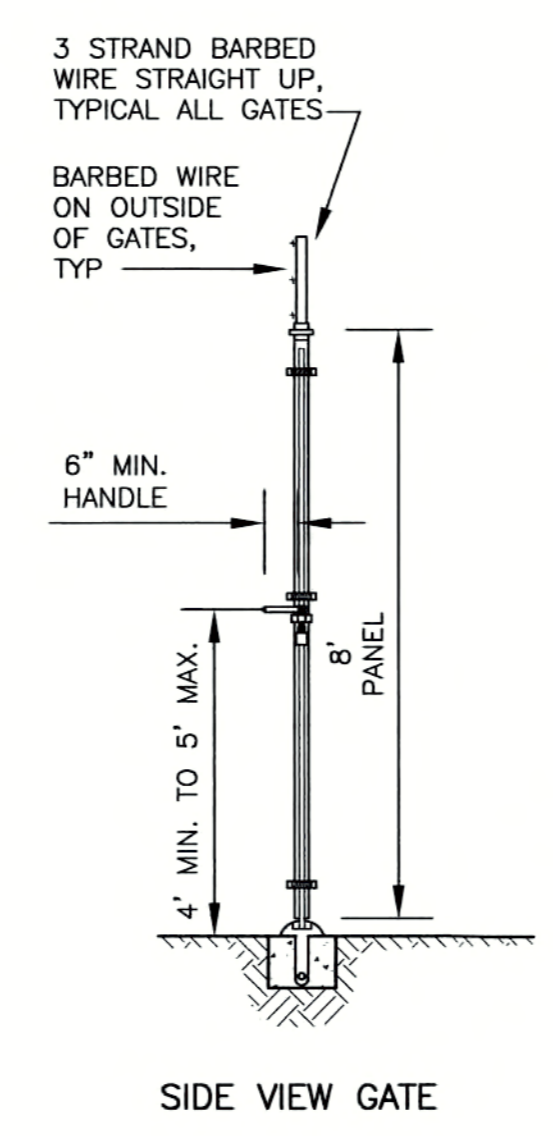


SIDE VIEW GATE

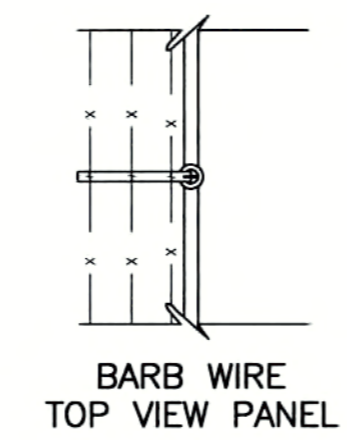

BARB WIRE
TOP VIEW PANEL

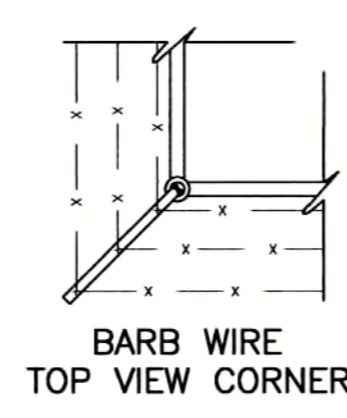

BARB WIRE
TOP VIEW CORNER

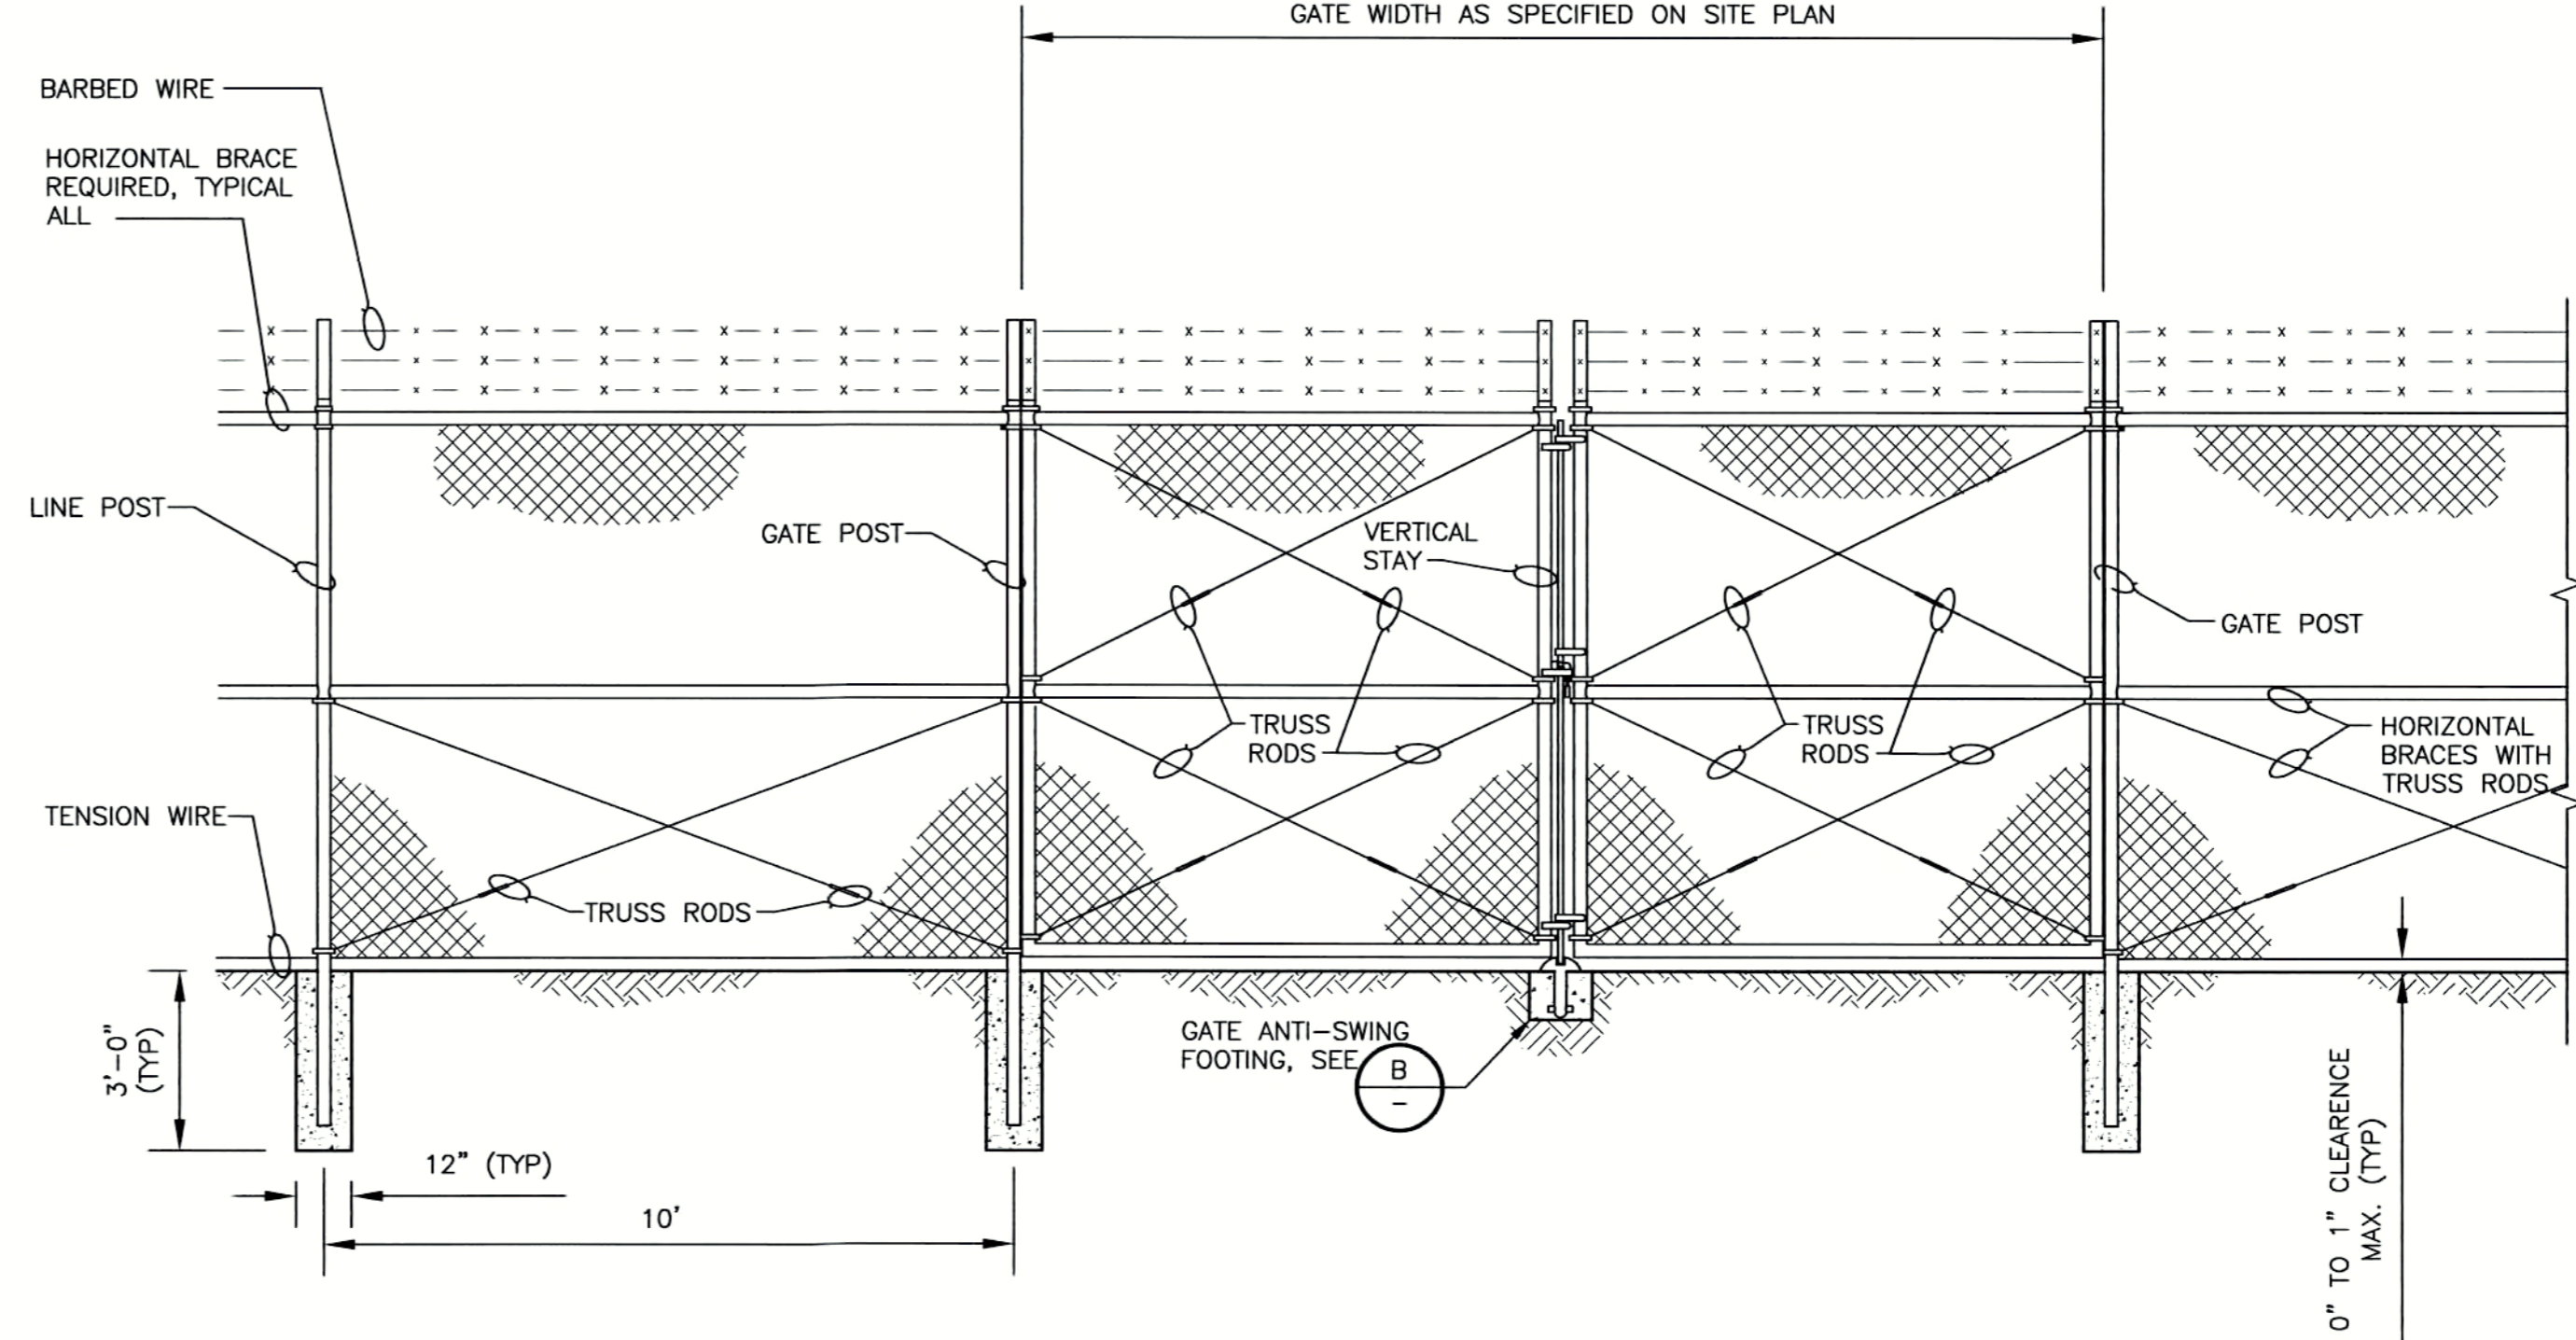

CHAINLINK FENCE
DETAIL C/C1
NOT TO SCALE

RECORD DRAWINGS
14-Mile Slough Pump Station Upgrades
CIVIL DETAILS 2

DEPARTMENT OF MUNICIPAL UTILITIES CITY OF STOCKTON, CALIFORNIA		SCALE: AS SHOWN	APPROVED BY: DATE: _____	SHEET No.
DESIGNED BY: TTT	DRAWN BY: DTD	CHECKED BY: GDH	RECORD Dwg.:	C202
ASSISTANT DIRECTOR, DEPT. OF MUNICIPAL UTILITIES			20 of 89 SHEETS	
			PROJECT No. 293-00-05-01	

N:\Clients\283 - Sponos\00-05-01 14-MSFS Upgrades\CAD\Design\Asbuilt\293-0501C202.dwg 11-13-08 09:37:03 AM dremmer




REFER TO
BID SET
FOR
SIGNATURE

REV. No.	DISCRPTION	DATE	BY	Apr'd By
1	RECORD DRAWINGS	6/08	CLB	PDF
2				
3				
4				
5				
6				
7				

WEST YOST
ASSOCIATES
Consulting Engineers
1260 Lake Boulevard
Suite 240
Davis, California 95616
(530) 756-5905
FAX (530) 756-5991

N:\Clients\293_Sponos\00-05-01_14-MSPS_Upgrade\CAD\Design\Asbults\931-0501C203.dwg 11-13-08 09:37:26 AM greimer

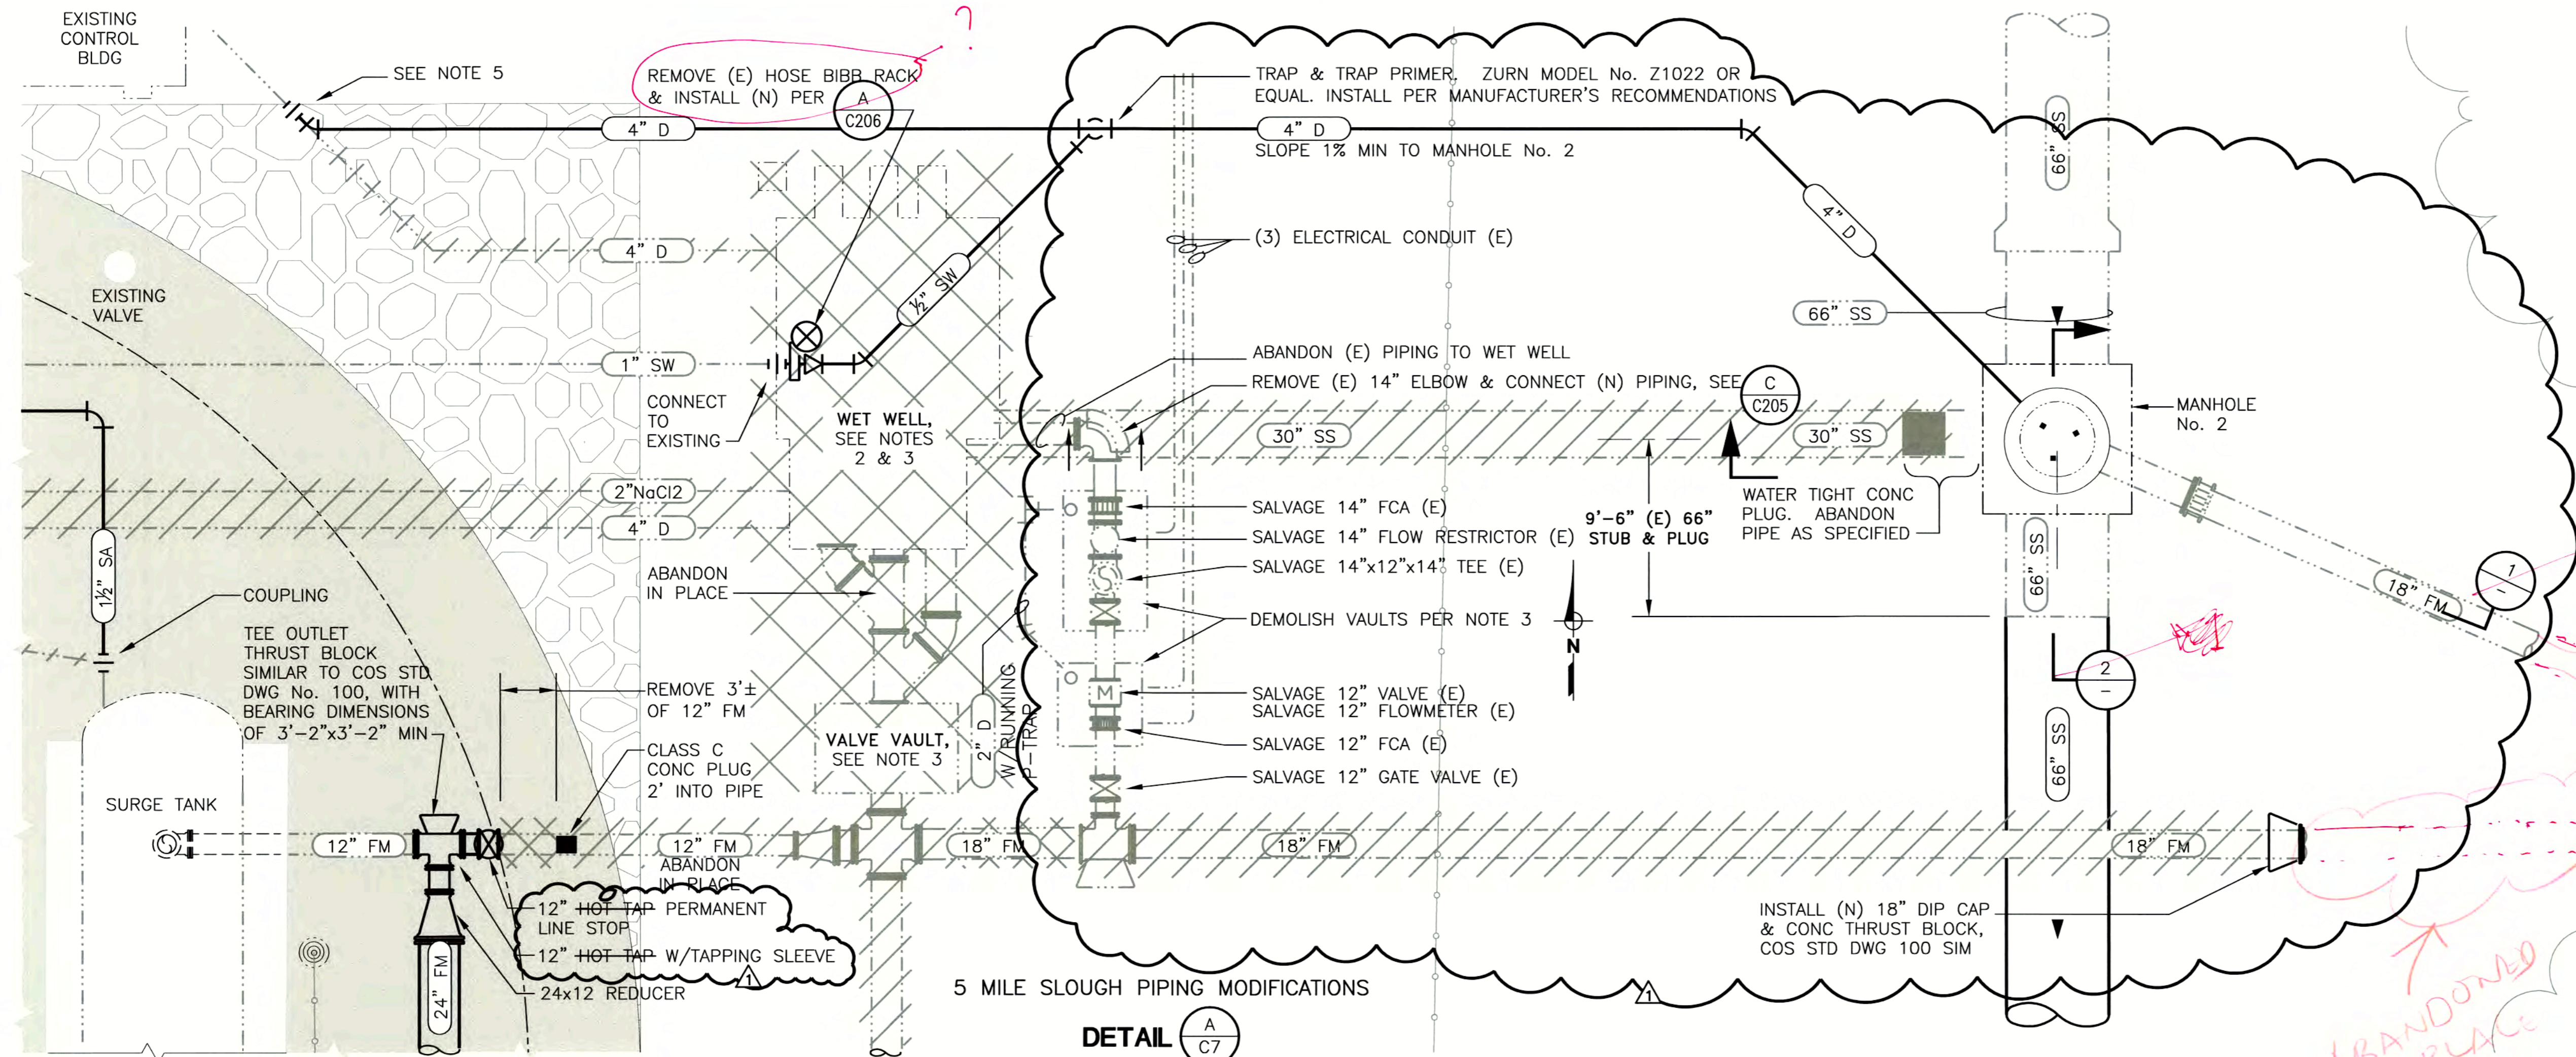


- NOTES:**
1. PRECAST MANHOLE SECTIONS SHALL CONFORM TO ASTM C478 AND SPECIFICATIONS, EXCEPT WHERE OTHERWISE NOTED. ALL PRECAST SECTIONS SHALL BE GASKETED AND GROUTED AS NOTED
 2. REMOVE AND SALVAGE EXISTING 50HP PUMPS
 3. DEMOLISH WET WELL & VALVE VAULT TO 3' BELOW FINISH GRADE. SALVAGE VALVES
 4. EXISTING MANHOLE IS COATED WITH URETHANE. COAT GROUT PACKING WITH 5 MILS TNEMEC SERIES 66 PRIMER, 5 MILS TNEMEC 1074 TOP COAT. CLEAN EXISTING COATING WITH M.E.K. AND WIRE BRUSH ROUGHEN PRIOR TO COATING REPAIR
 5. CONNECT TO EXISTING PIPE USING FERNCO COUPLING


NOT SHOWN

ABANDONED PLACE


DETAIL (A/C7)
SCALE: 1"=5'-0"

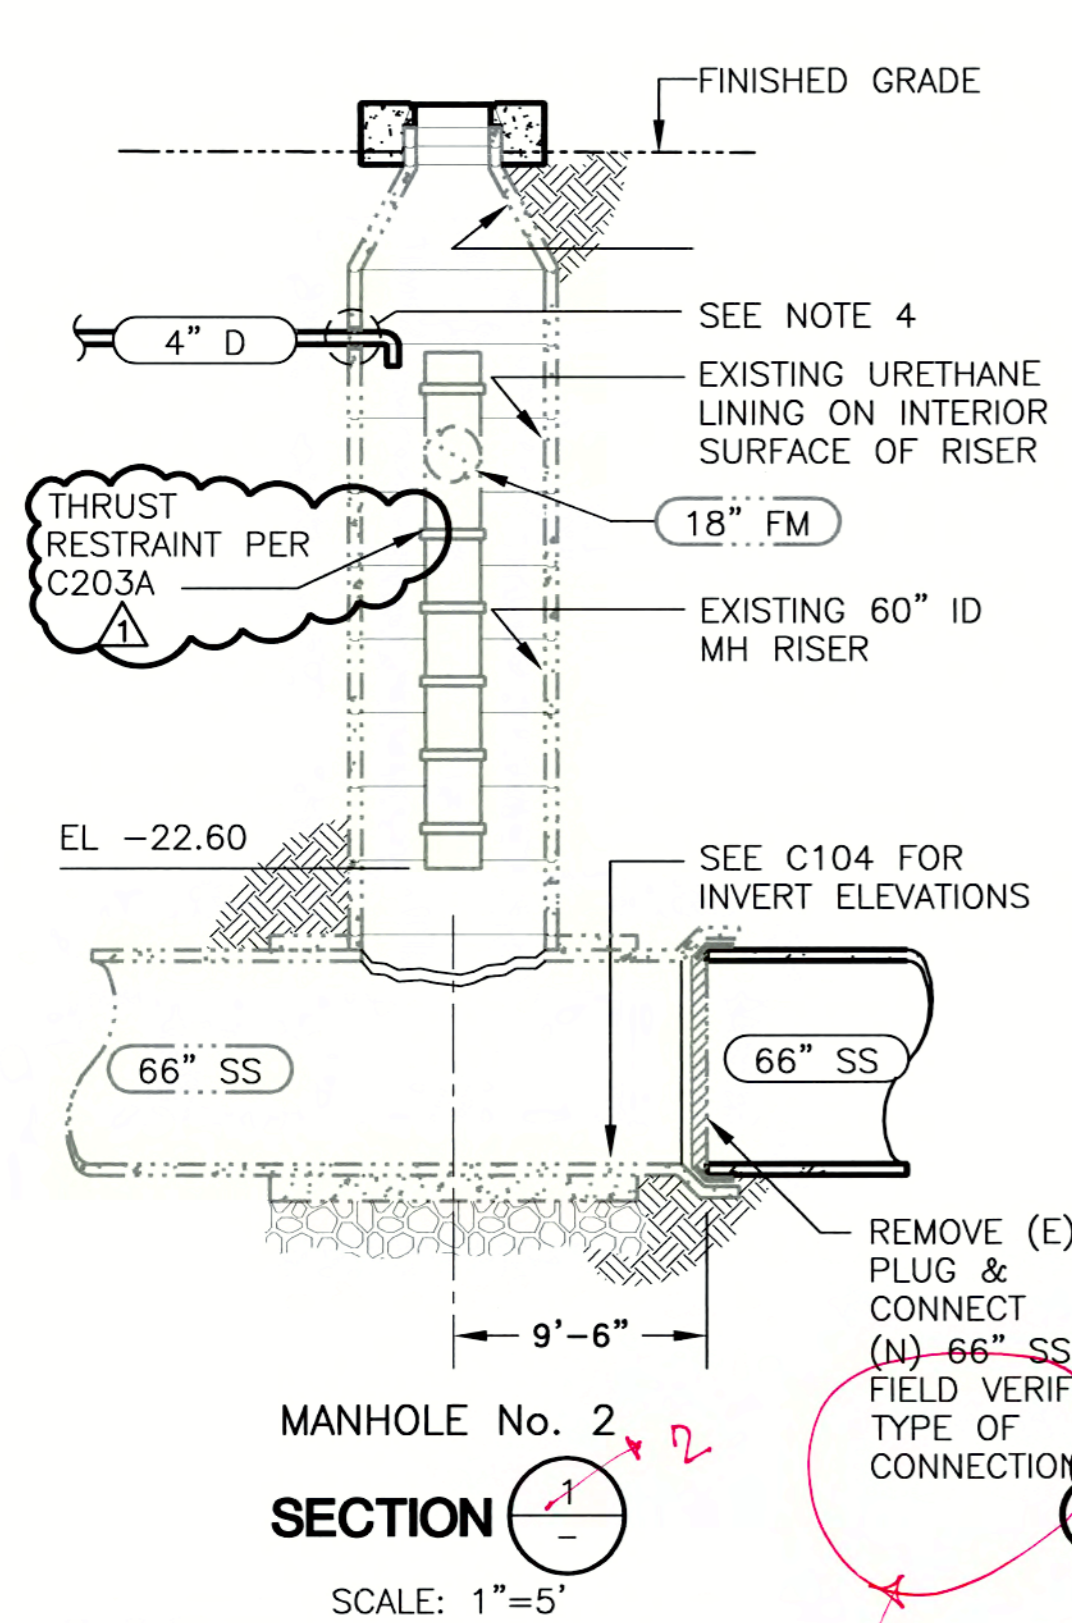


SECTION 1
SCALE: 1"=5'

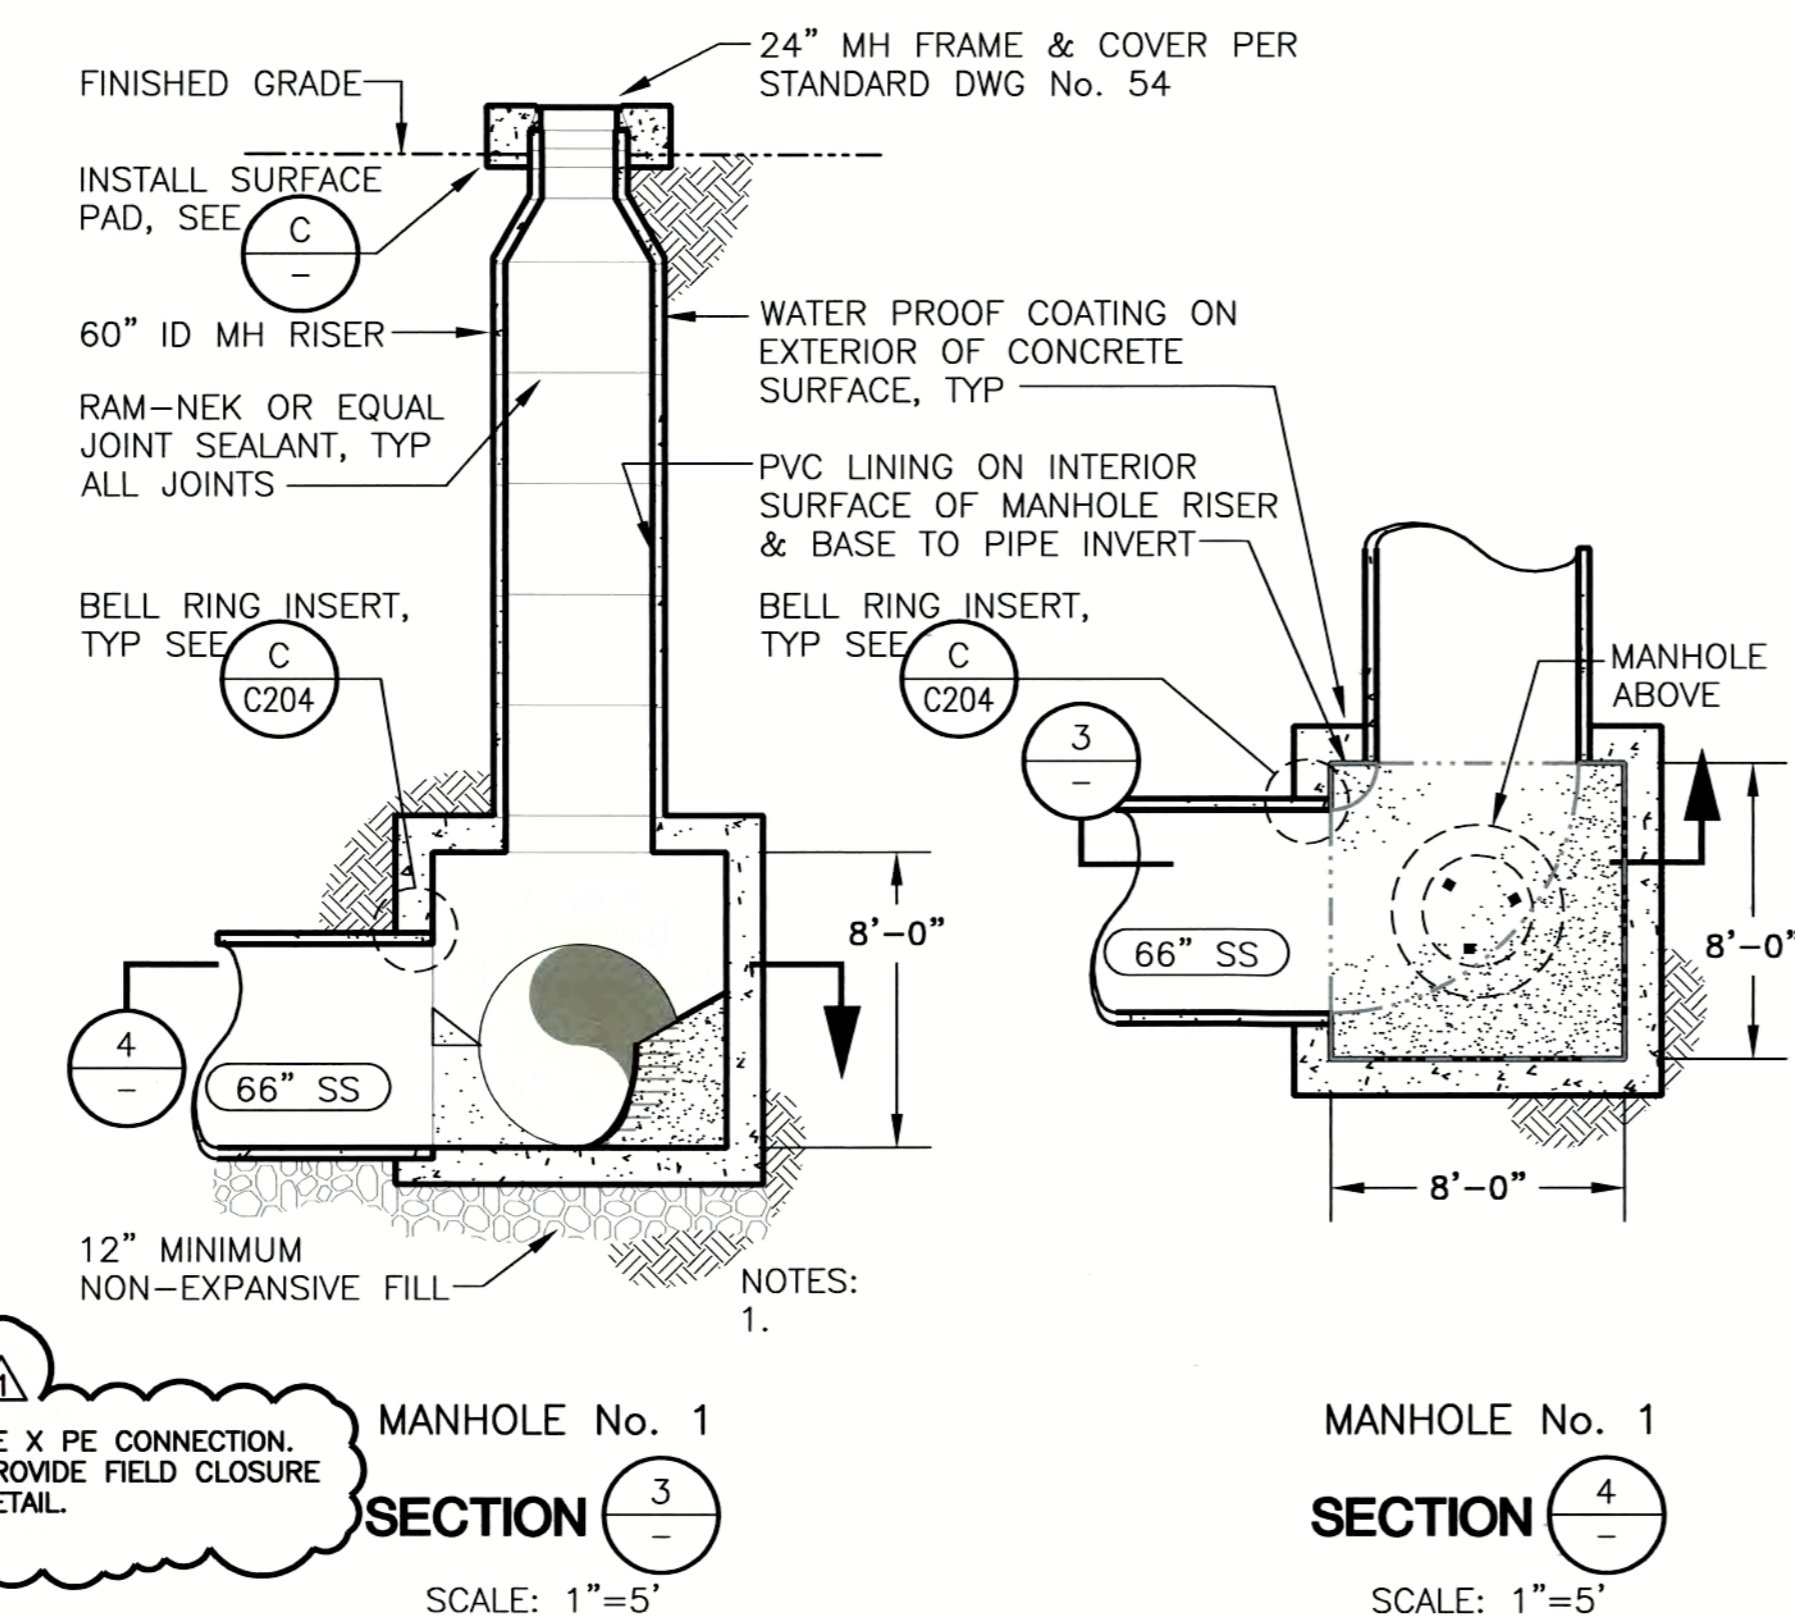

SECTION 3
SCALE: 1"=5'

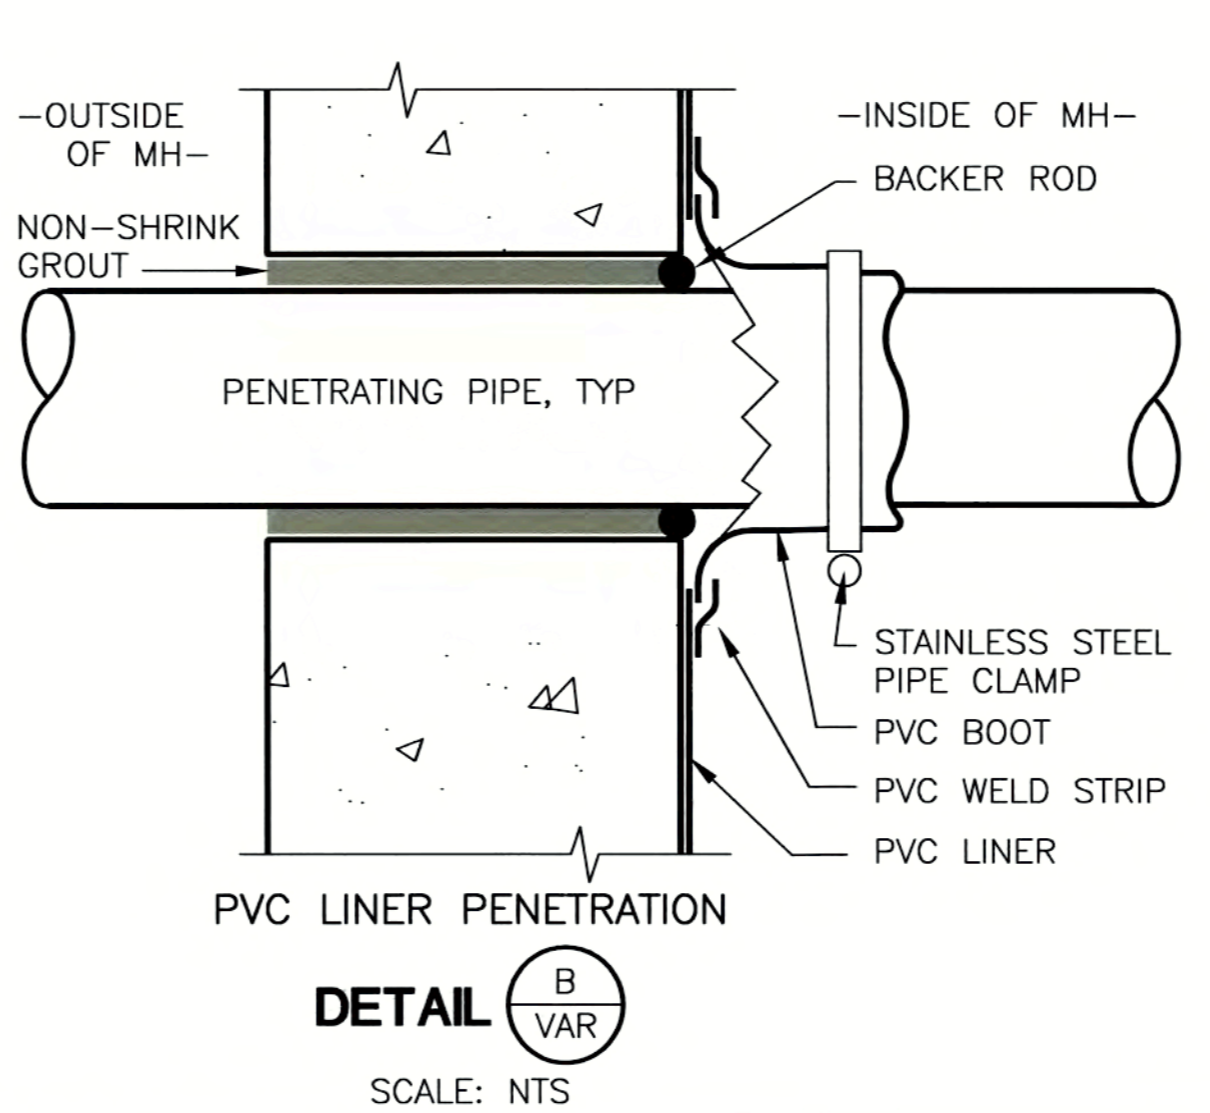

DETAIL (B/VAR)
SCALE: NTS

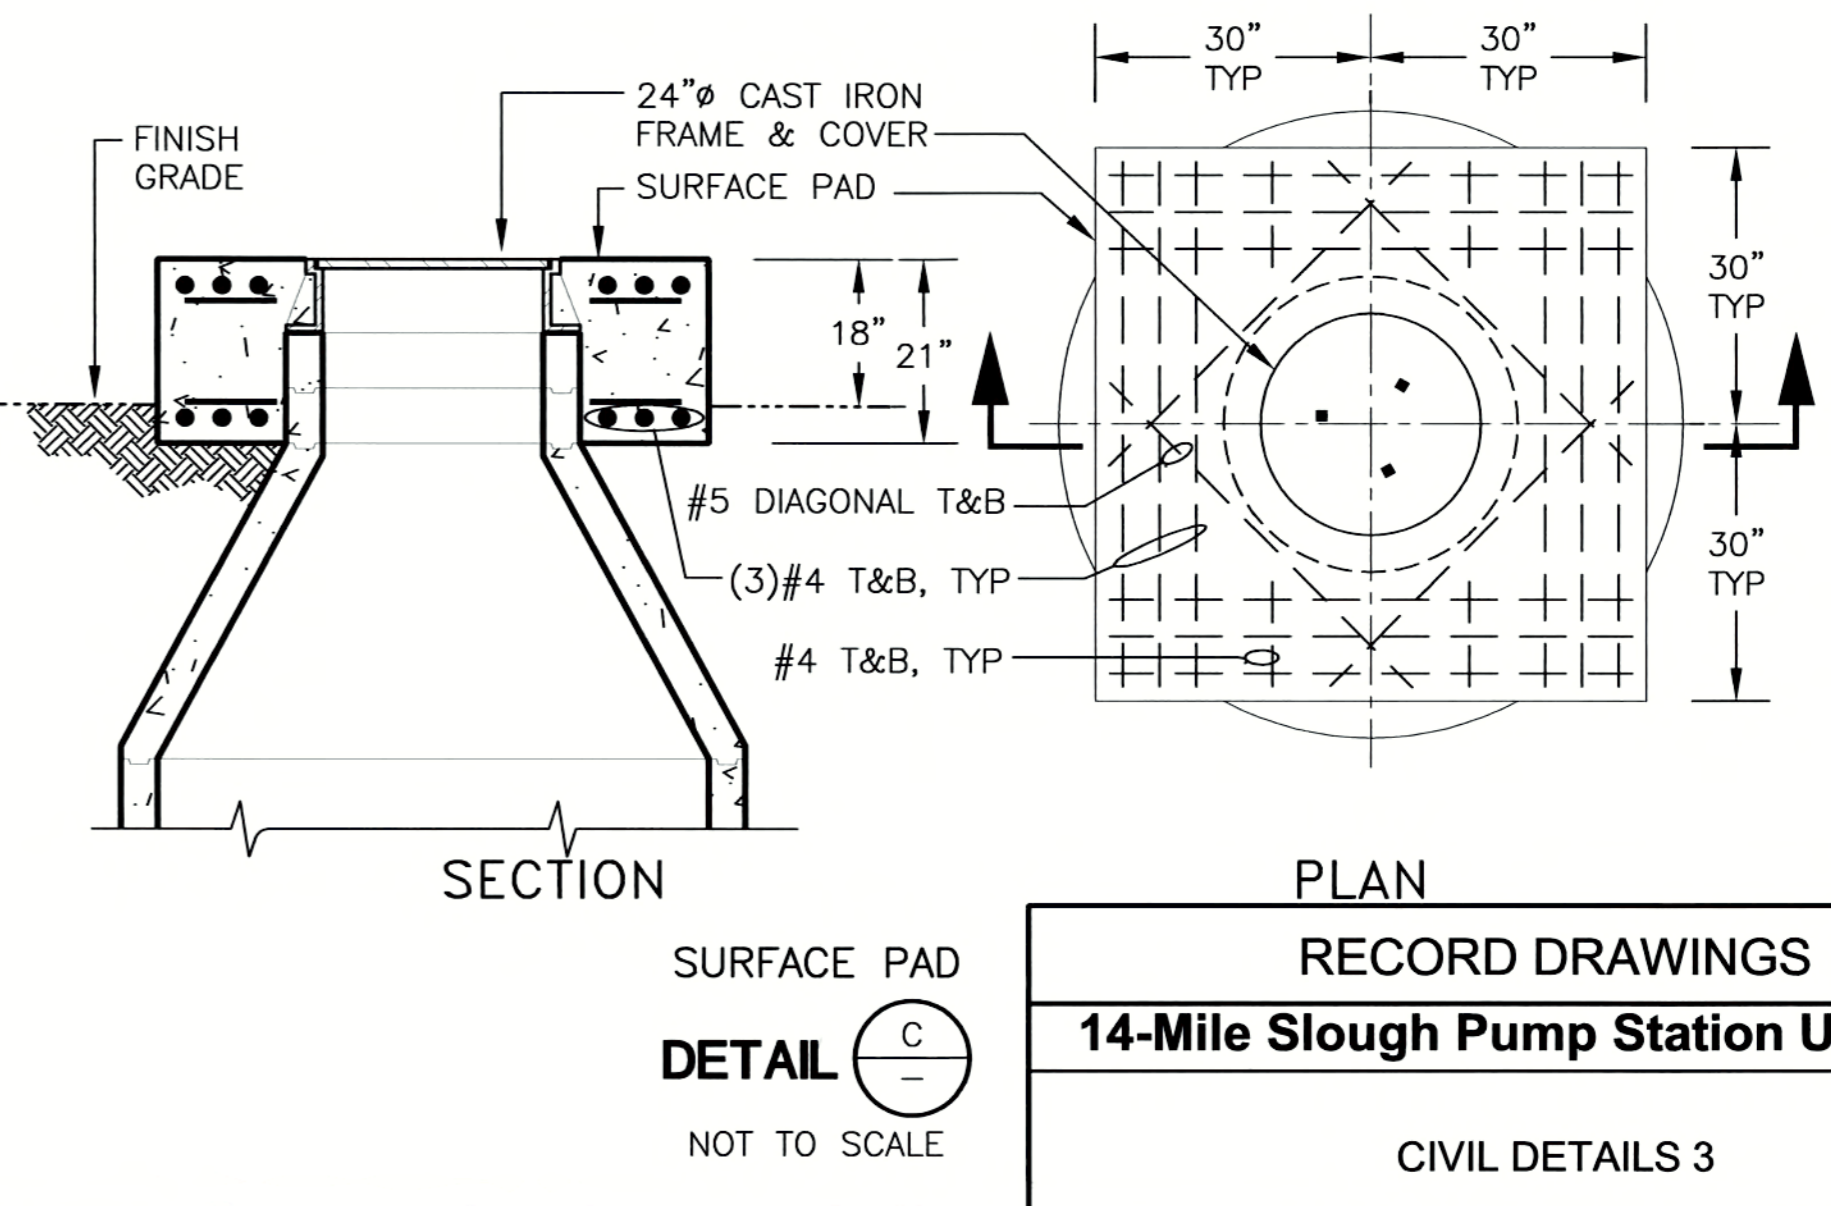

DETAIL (C)
NOT TO SCALE

PLAN

RECORD DRAWINGS

14-Mile Slough Pump Station Upgrades

CIVIL DETAILS 3

Underground Service Alert

TWO DAYS BEFORE YOU DIG

Call TOLL FREE: 1-800-642-2444

Built connection (volume)

REFER TO BID SET FOR SIGNATURE





REV. No.	DISCRPTION	DATE	By	Apr'd By
1	RECORD DRAWINGS	6/08	CLB	PDF
2				
3				
4				
5				
6				
7				

WEST YOST ASSOCIATES

1260 Lake Boulevard
Suite 240
Davis, California 95616
(530) 756-5905
FAX (530) 756-5991

DEPARTMENT OF MUNICIPAL UTILITIES CITY OF STOCKTON, CALIFORNIA		
SCALE: AS SHOWN	APPROVED BY: DATE:	SHEET No.
DESIGNED BY: TTT		C203
DRAWN BY: DTD		21 of 89 SHEETS
CHECKED BY: PDF	ASSISTANT DIRECTOR, DEPT. OF MUNICIPAL UTILITIES	PROJECT No. 293-00-05-01
RECORD Dwg.:		

N:\Clients\293 - Sponos\05-05-01 14-MSFS Upgrades\CAD\Design\Submittals\293-0501C203A.dwg 11-13-08 09:37:55 AM oreimer

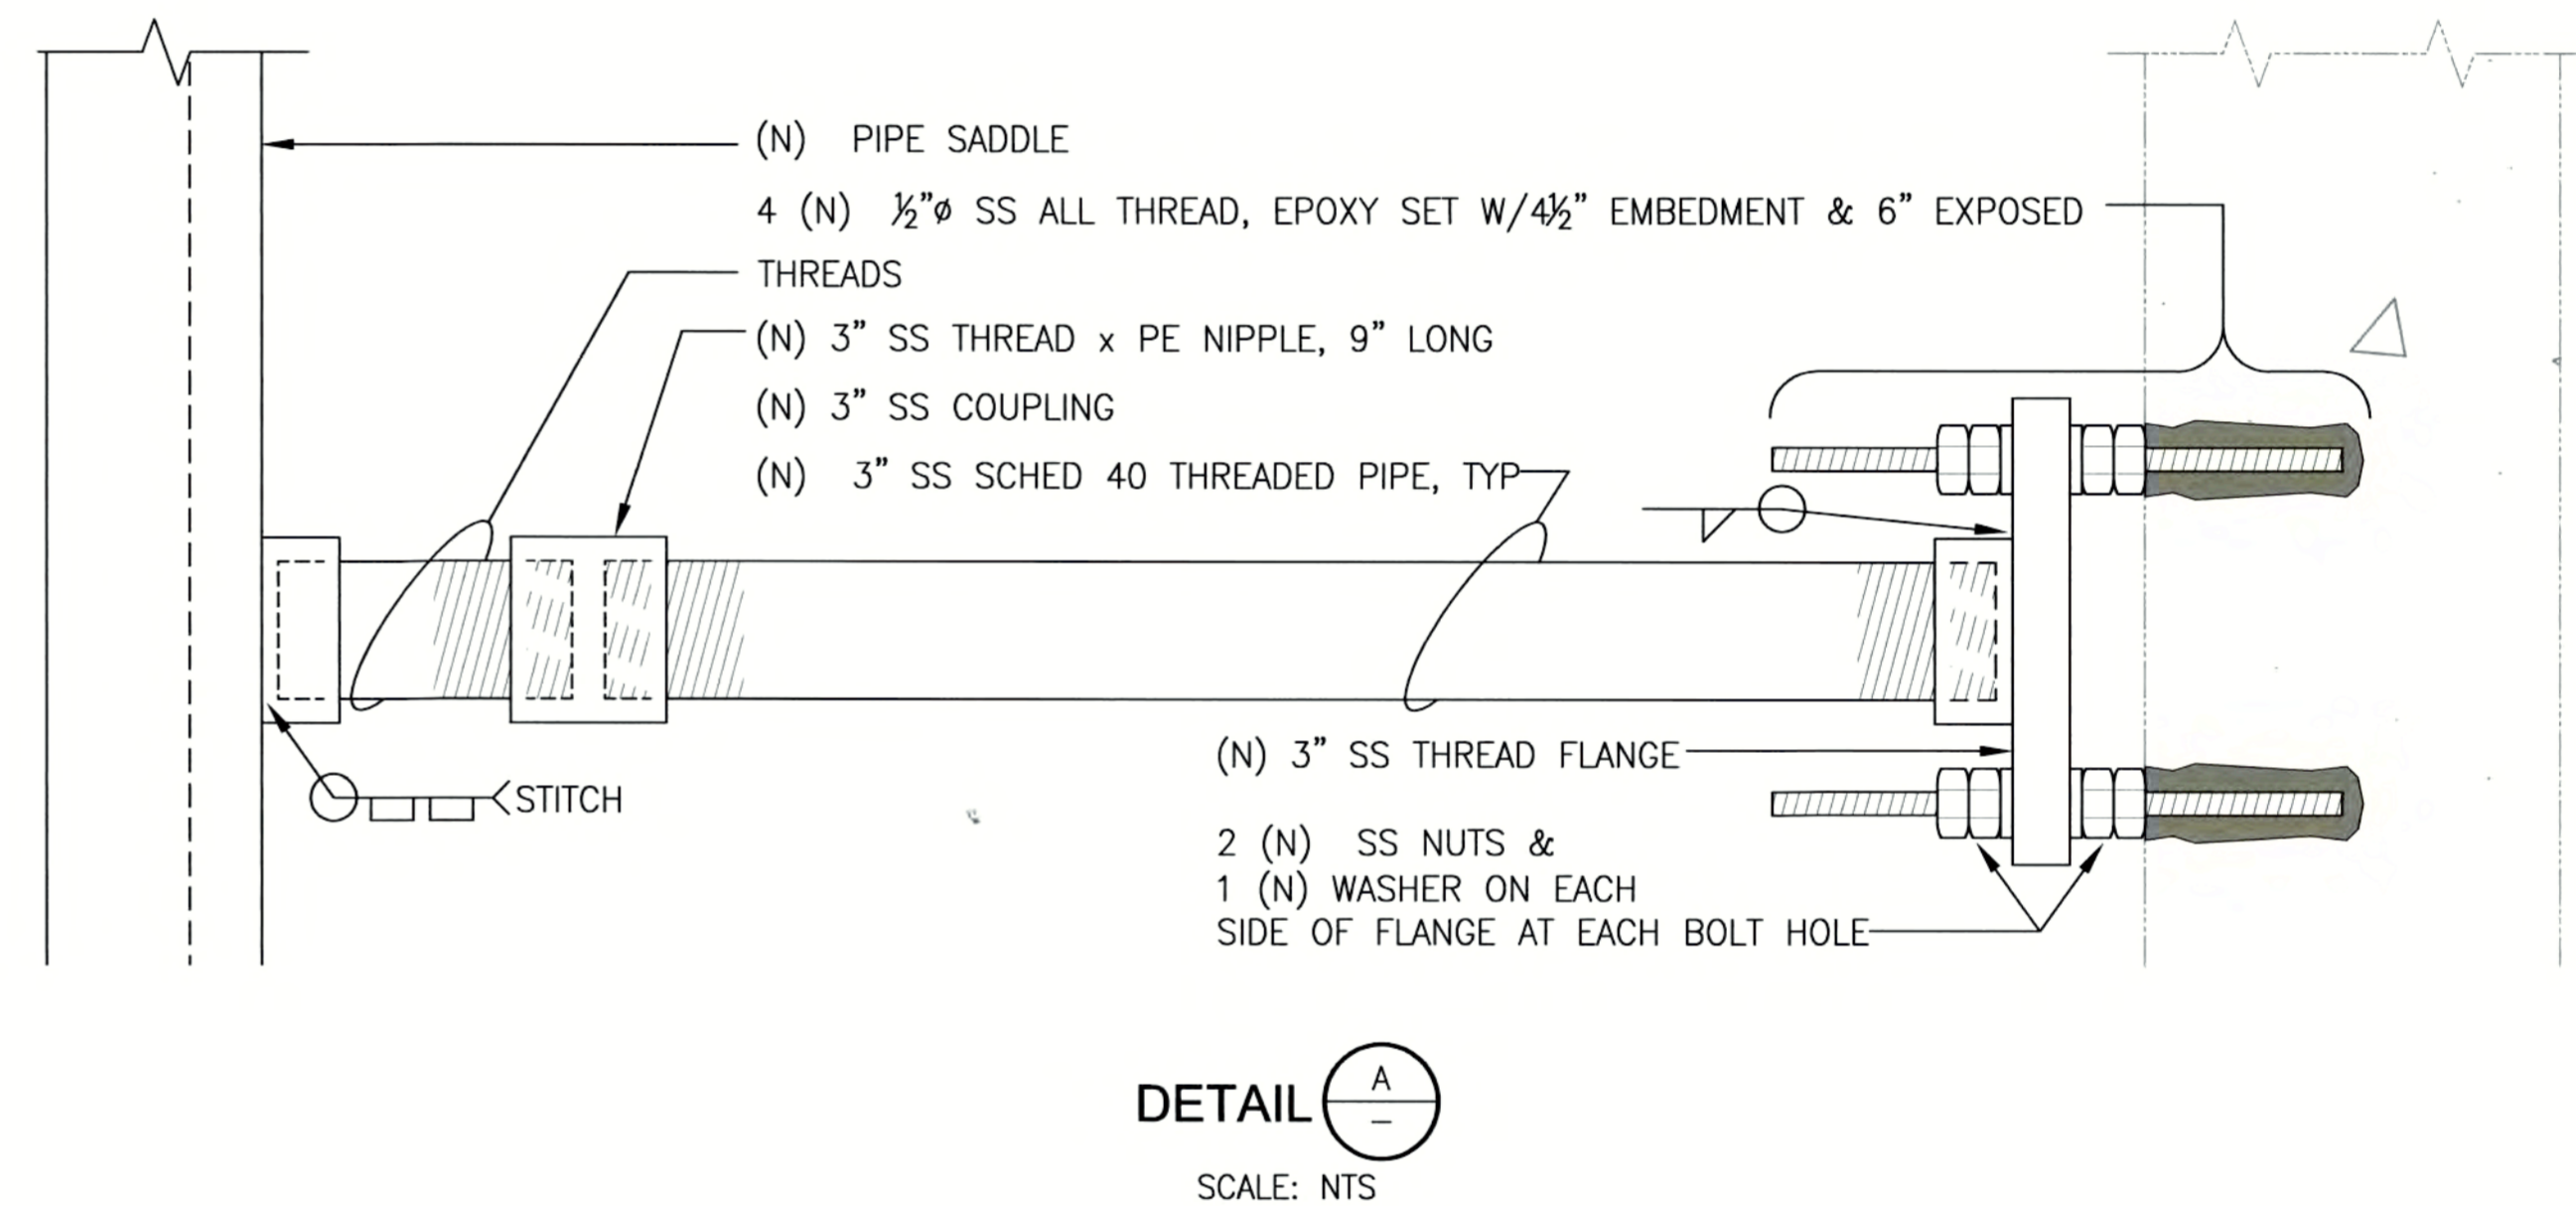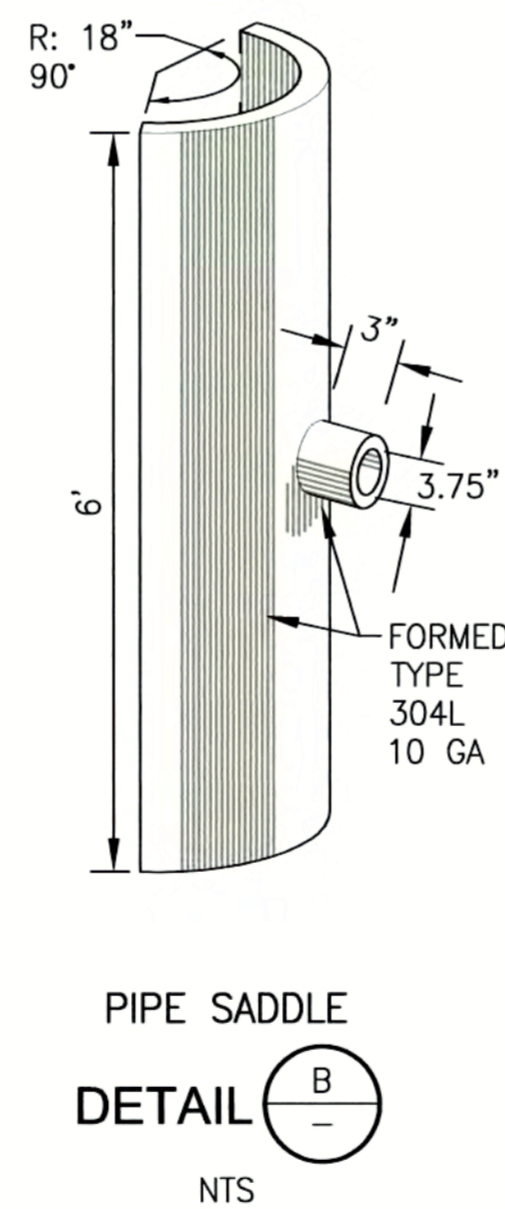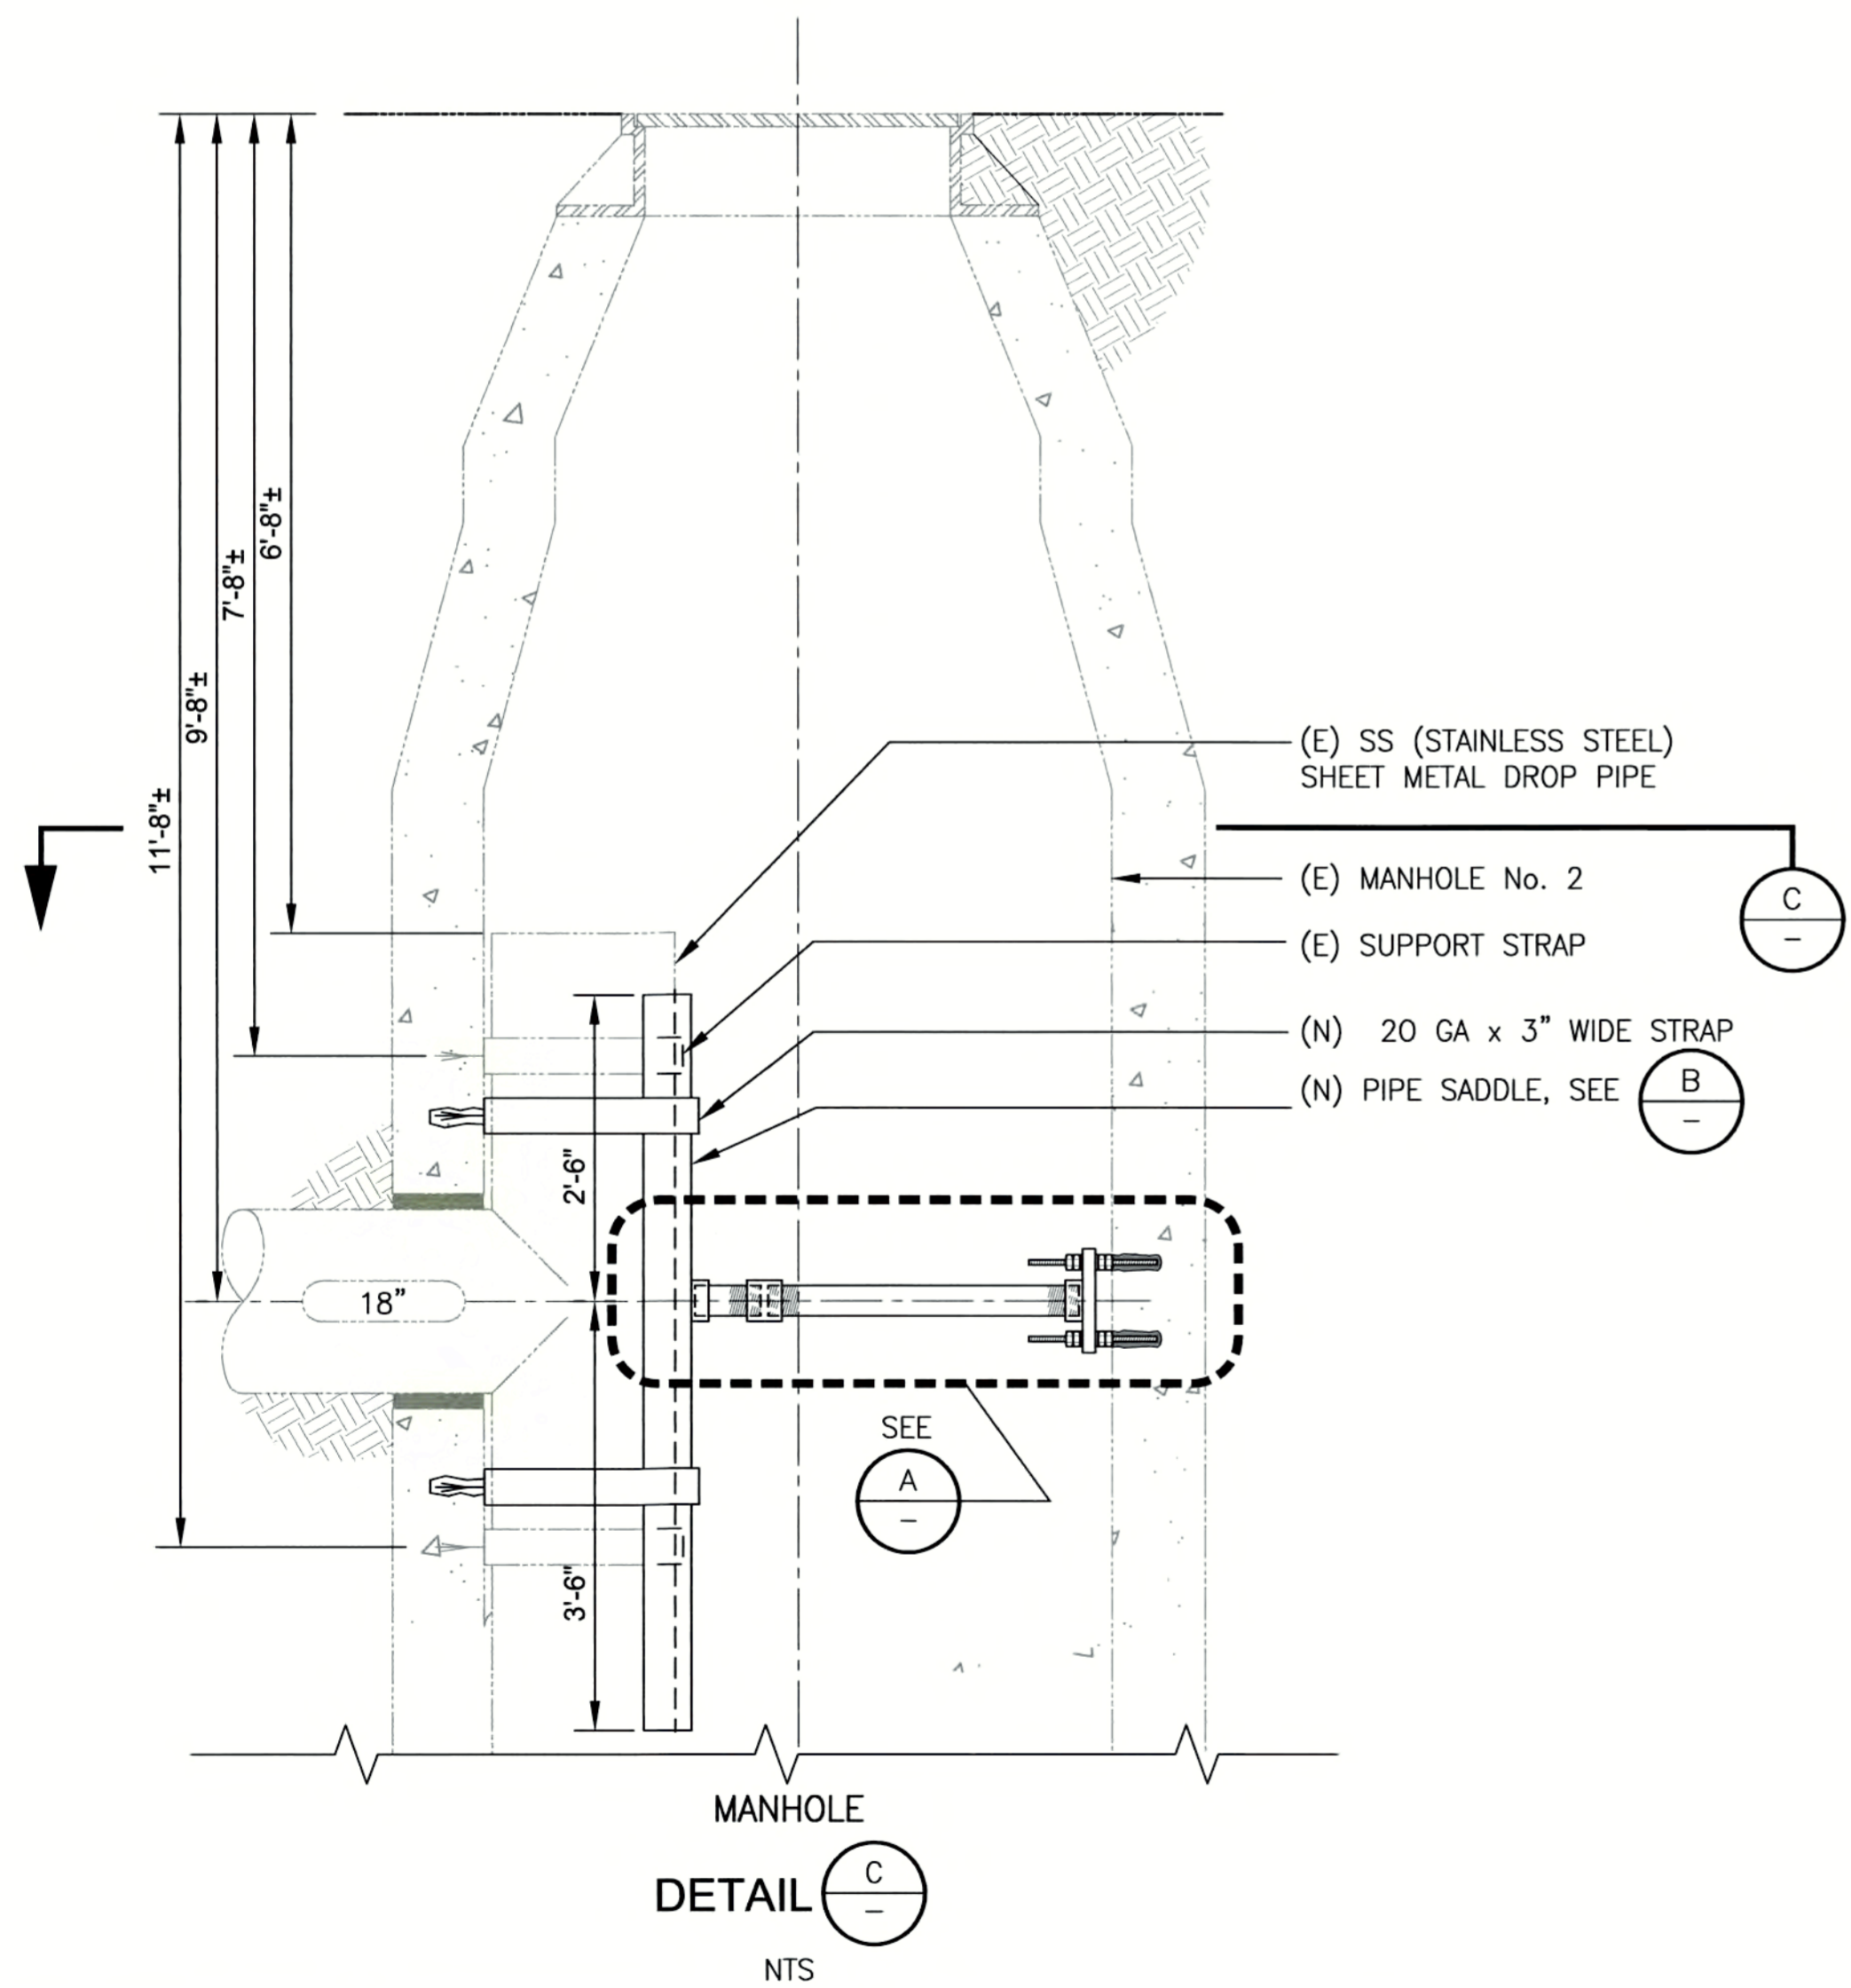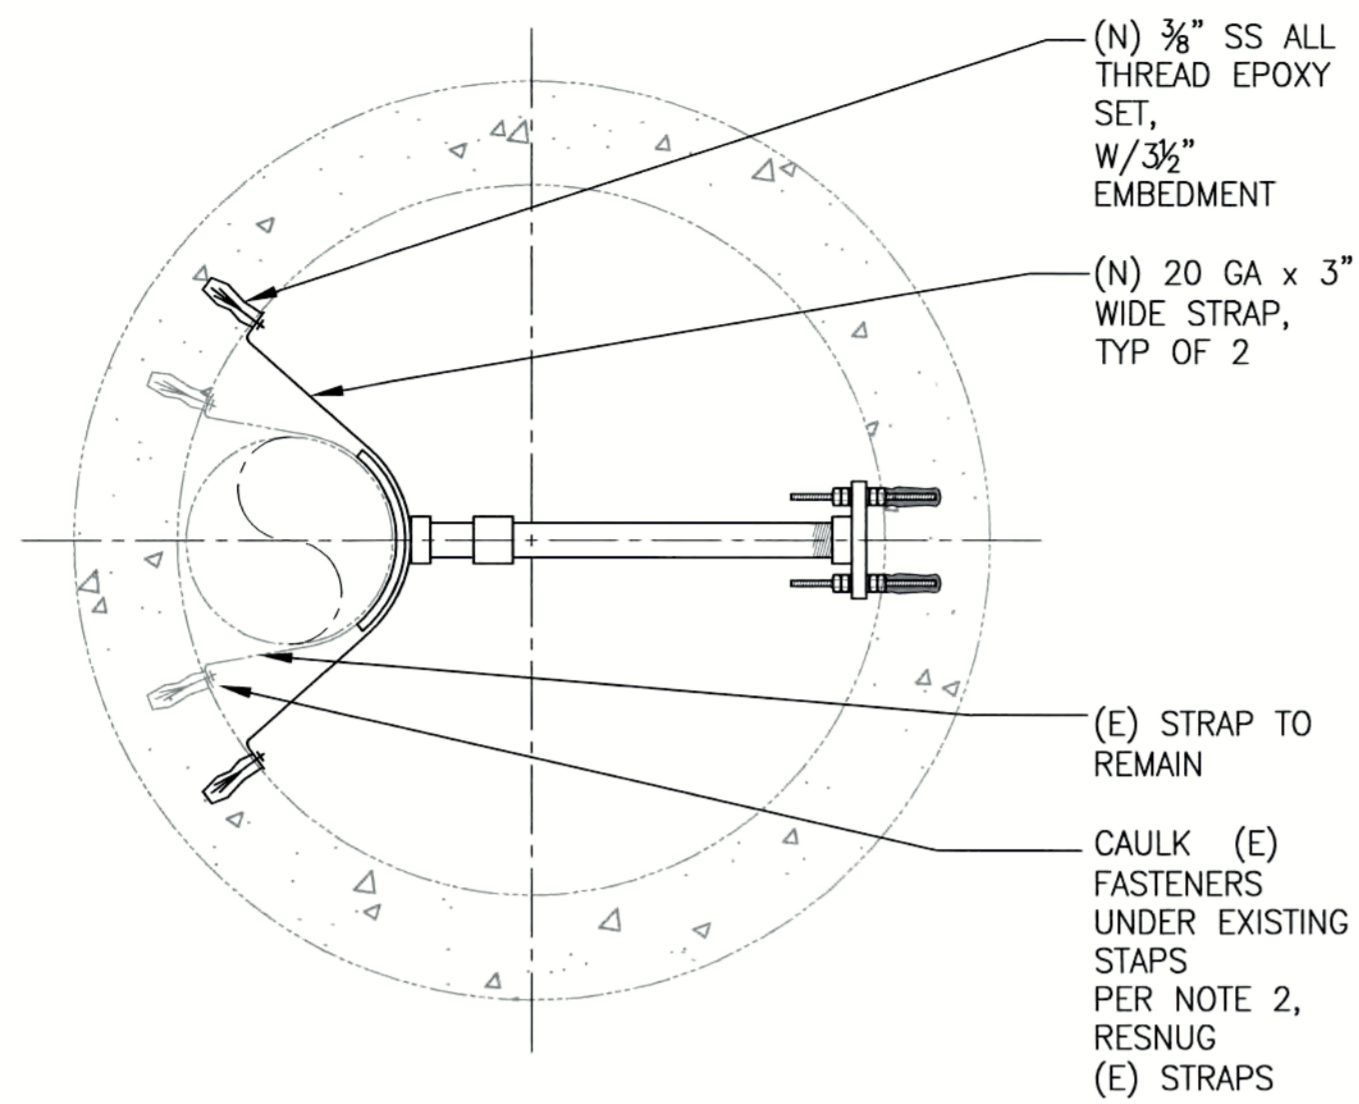

RECORD DRAWINGS
14-Mile Slough Pump Station Upgrades

MANHOLE No. 2
5 MSFM THRUST RESTRAINT

DEPARTMENT OF MUNICIPAL UTILITIES
CITY OF STOCKTON, CALIFORNIA

SCALE: AS SHOWN	APPROVED BY: DATE: _____	SHEET No.
DESIGNED BY: _____		C203A
DRAWN BY: DTD		of 89 SHEETS
CHECKED BY: PDF	ASSISTANT DIRECTOR, DEPT. OF MUNICIPAL UTILITIES	PROJECT No. 293-00-05-01
RECORD Dwg.:		

Underground Service Alert

TWO DAYS BEFORE YOU DIG

Call TOLL FREE: 1-800-642-2444

- NOTES:
1. SET THREADED ROD WITH EPICON A7 ACRYLIC ADHESIVE.
 2. SEAL EXPOSED EPOXY SURFACE WITH SIKAFLEX 1A SEALANT.
 3. SUGGESTED ASSEMBLY SEQUENCE:
A. SET PIPE BRACE ASSEMBLY SNUG TO EXISTING DROP PIPE WITH FLANGE AS CLOSE TO MANHOLE WALL AS POSSIBLE
B. EXTEND NIPPLE FROM COUPLING 1/4" TURN
C. EXTEND LOWER FLANGE NUTS 1/4" TURN
D. SET LOCKING NUTS SNUG TO FLANGE NUTS
 4. FIELD VERIFY ALL DIMENSIONS PRIOR TO FABRICATING PIPE BRACE ASSEMBLY.




REFER TO SET FOR SIGNATURE

REV. No.	DISCRIPTION	DATE	BY	Apr'd By
1				
2				
3				
4				
5				
6				
7				

WEST YOST ASSOCIATES
Consulting Engineers


1260 Lake Boulevard
Suite 240
Davis, California 95616
(530) 756-5905
FAX (530) 756-5991

- NOTES:
1. CONSTRUCT BOTTOM OF CHANNEL WITH SAME RADIUS AS OUTLET SEWER AND VERTICAL WALLS ABOVE CENTERLINE
 2. ALL RISER JOINTS SHALL HAVE WATERTIGHT RUBBER GASKET, RAM-NECK OR EQUAL
 3. PRECAST MANHOLE SECTIONS SHALL CONFORM TO ASTM C-478 AND THE SPECIFICATIONS, EXCEPT WHERE OTHERWISE NOTED
 4. ALL RISER JOINTS SHALL BE MORTER FILLED PRIOR TO INSTALLATION OF PVC LINER WELD STRIP
 5. PROVIDE BELL JOINT 2'-6" MAXIMUM FROM STRUCTURE

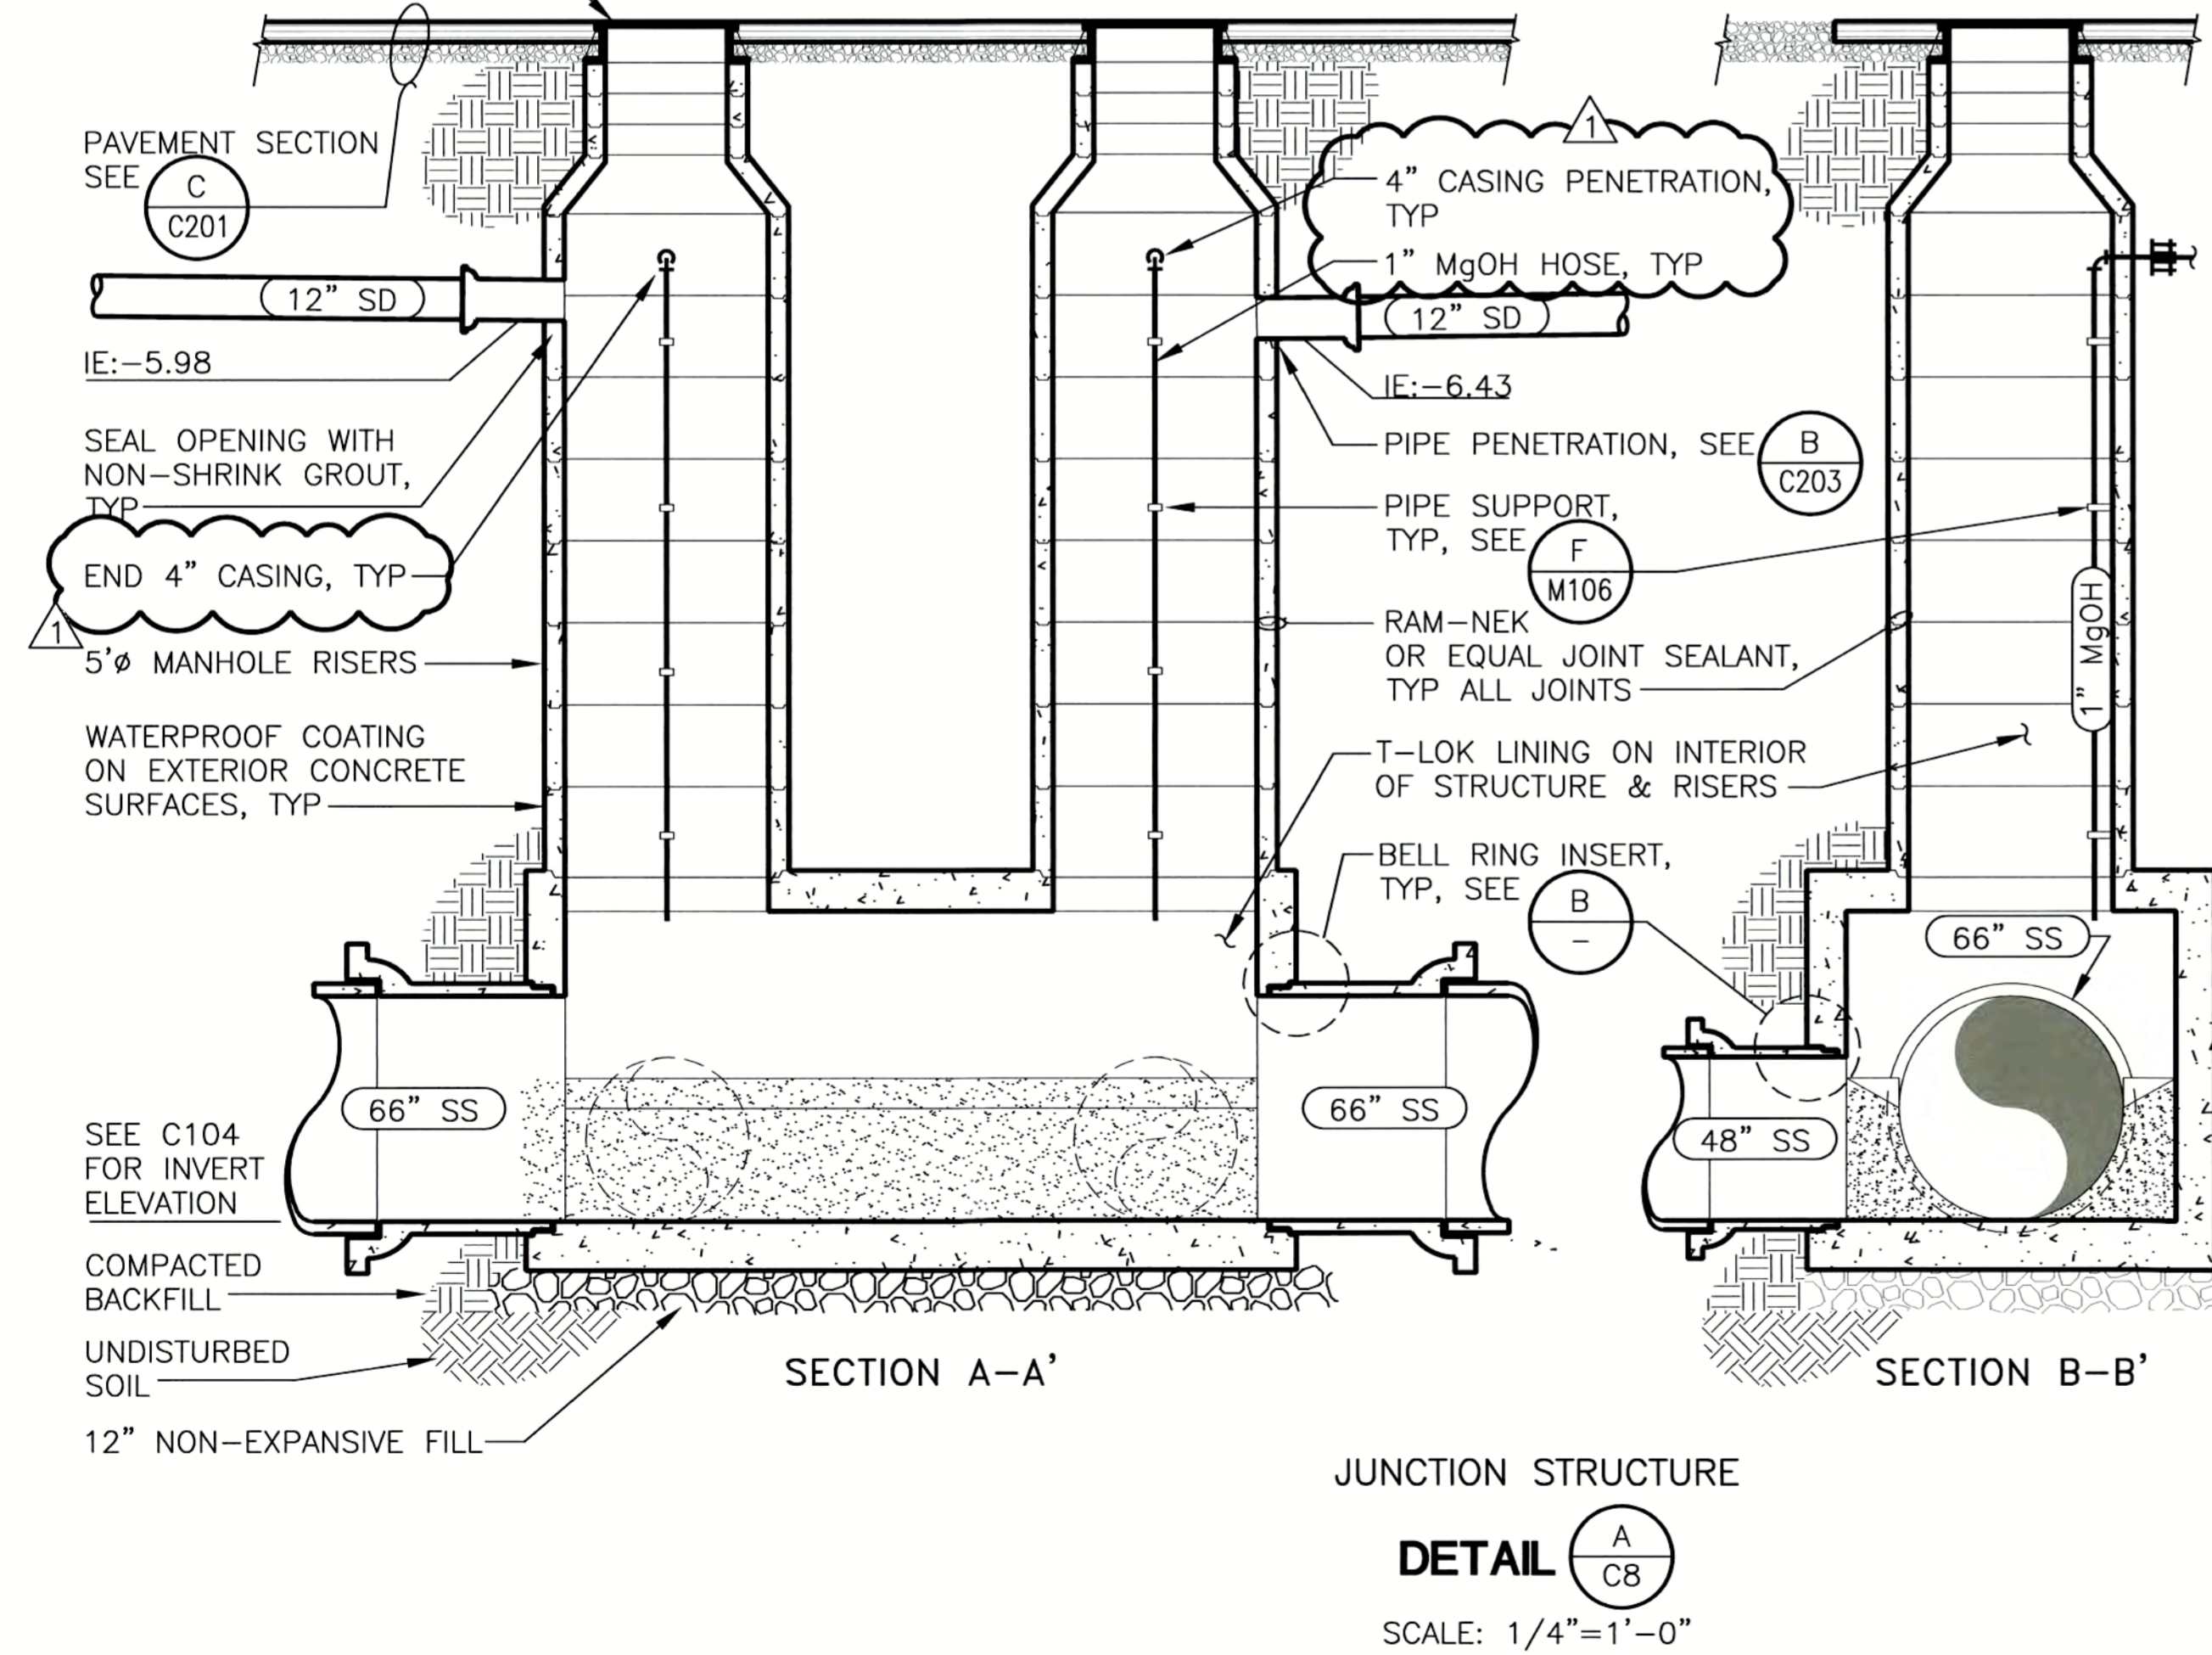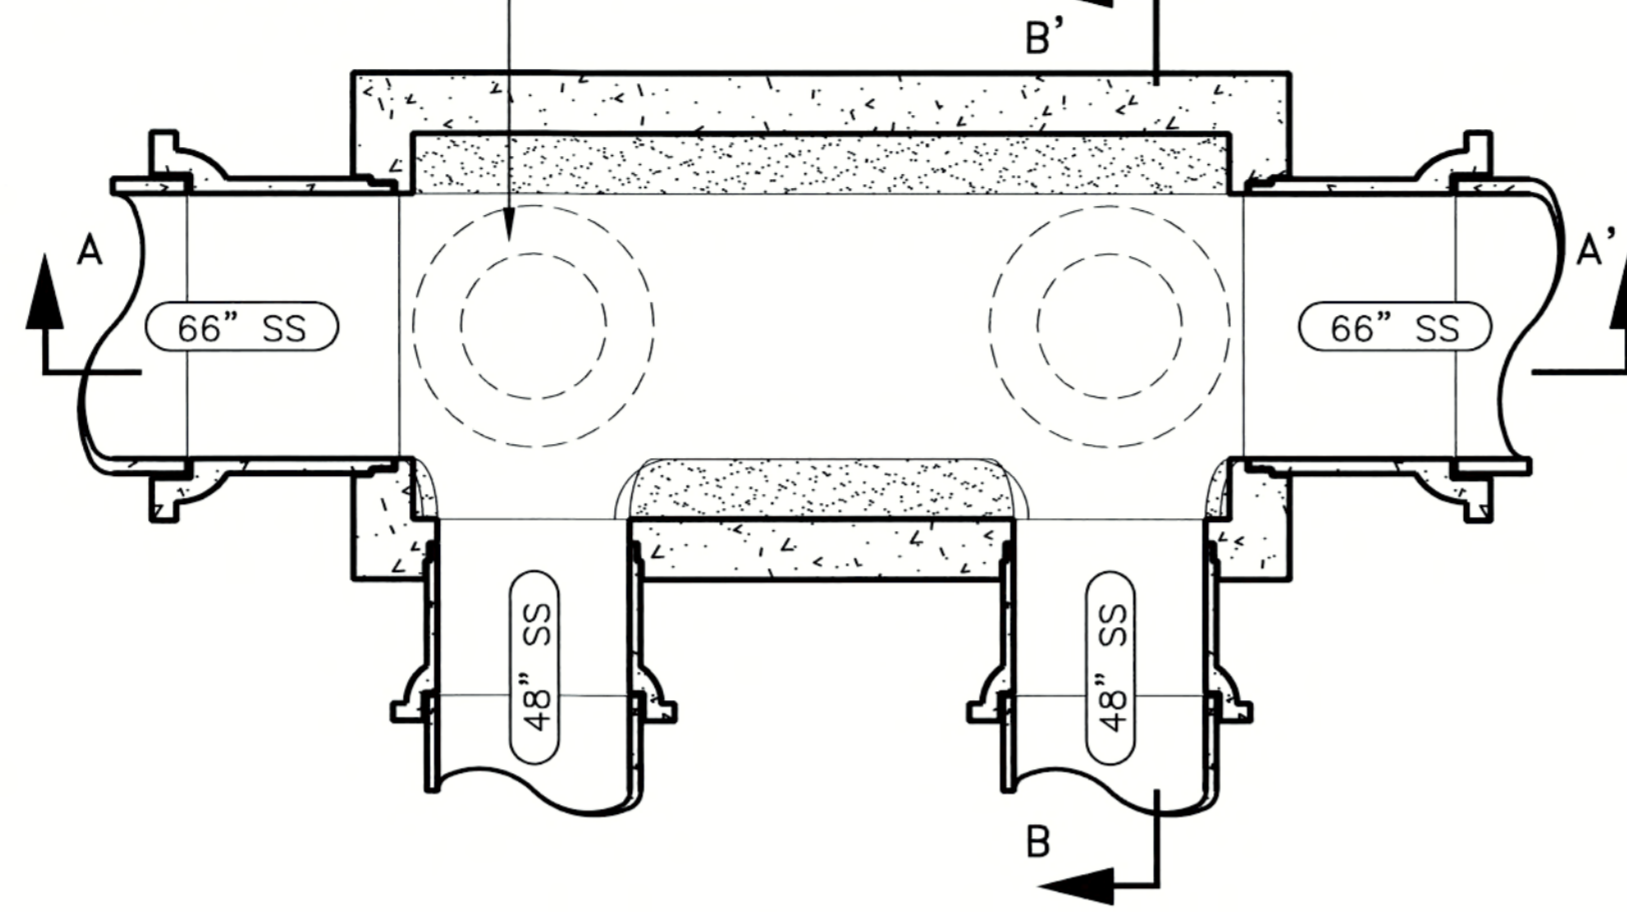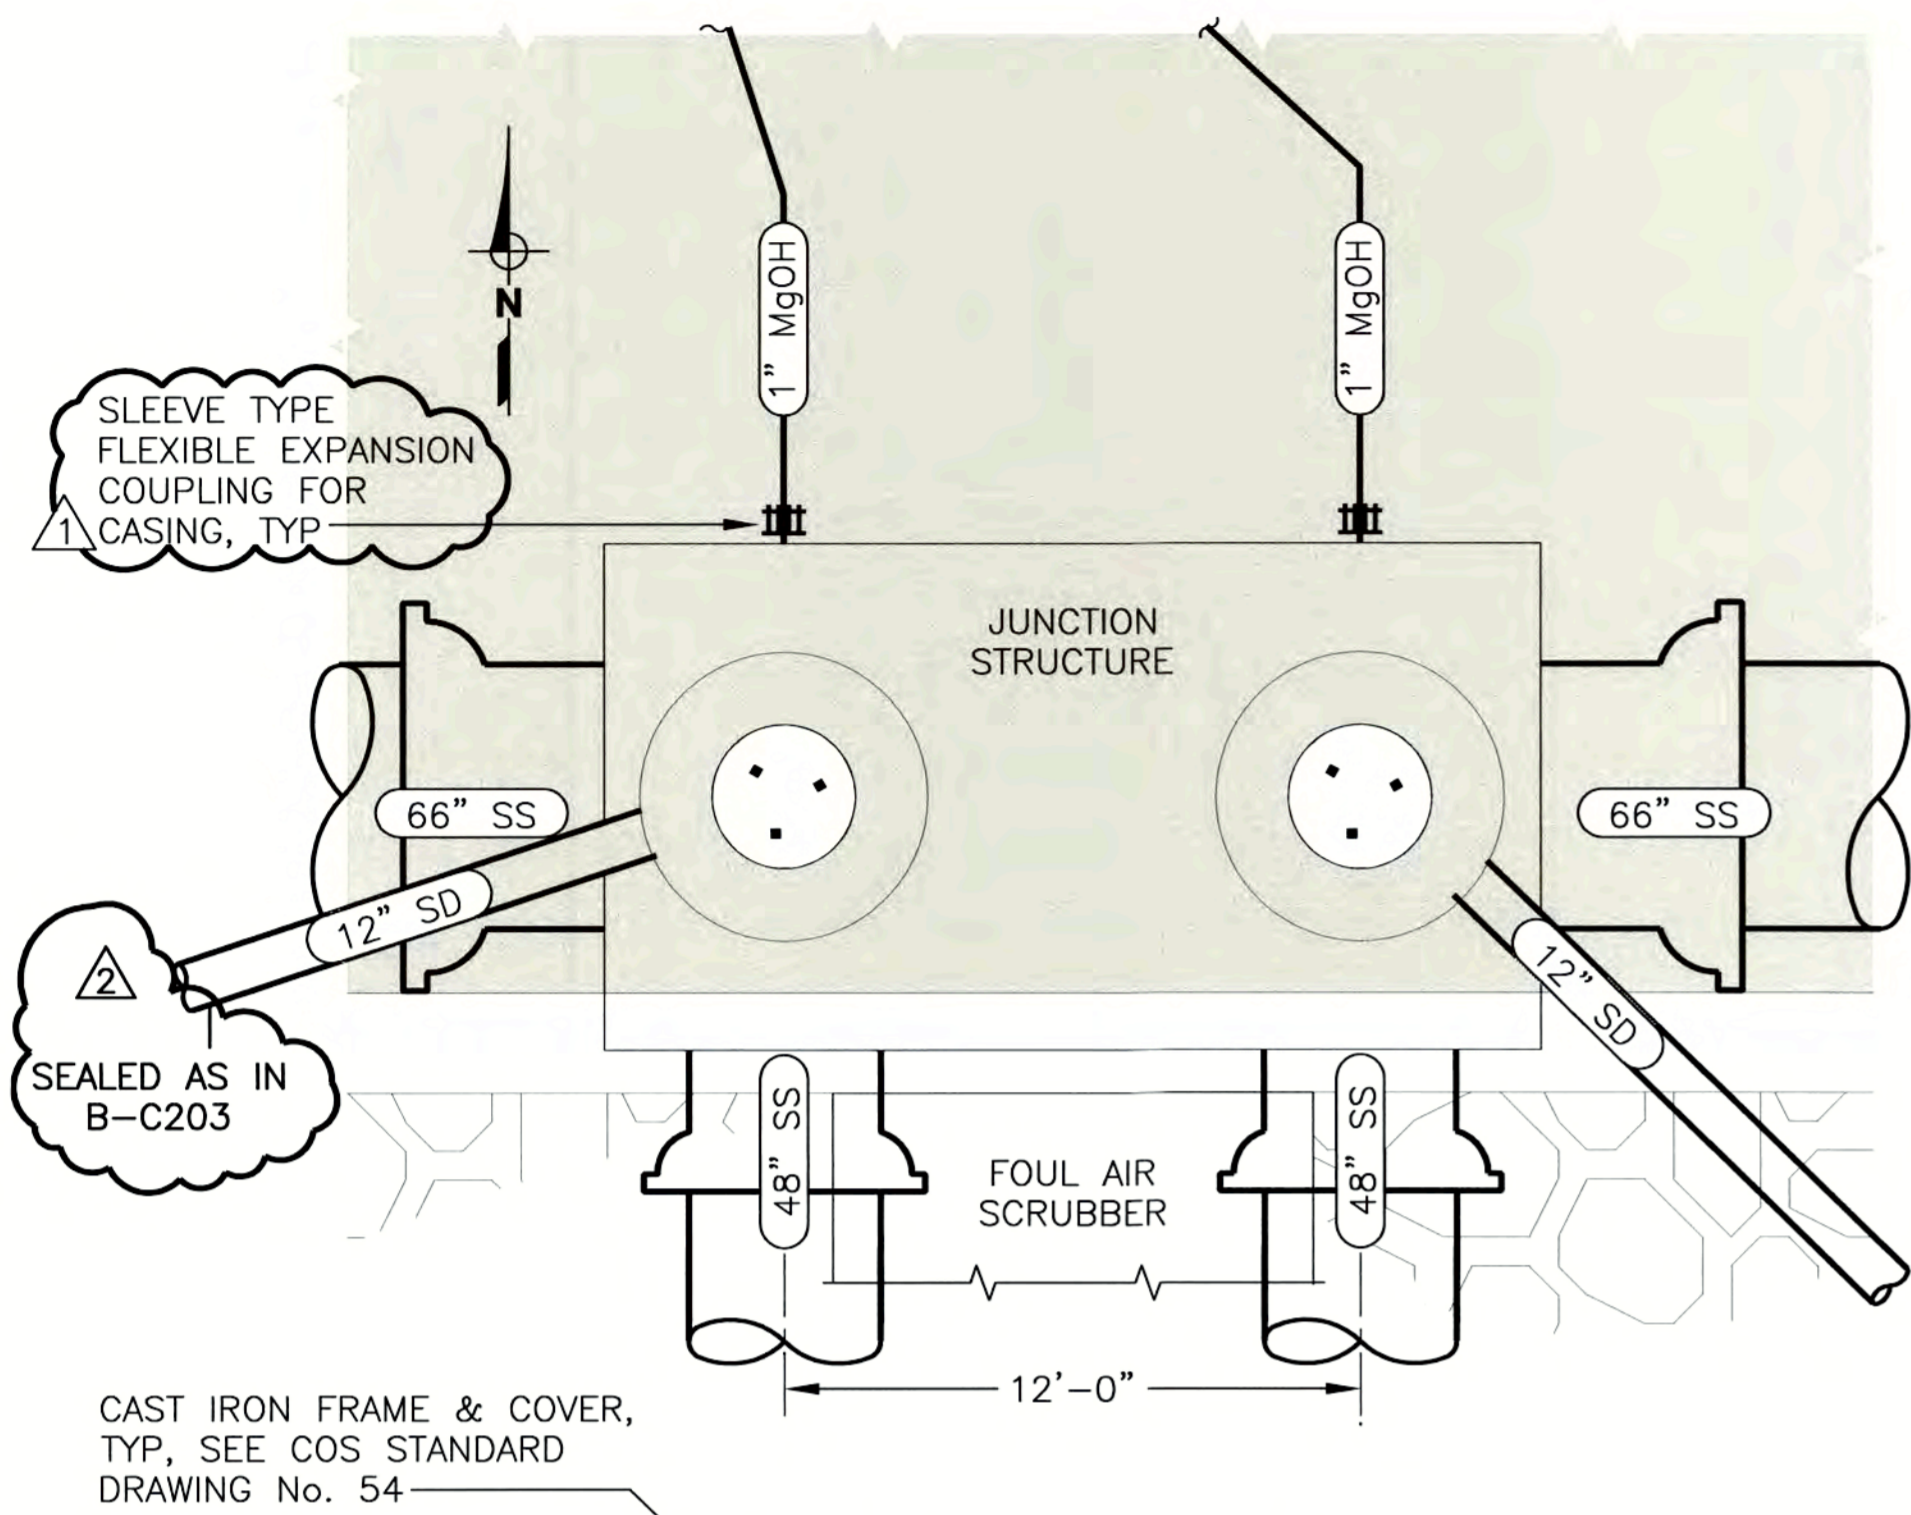

JUNCTION STRUCTURE
DETAIL A
 C8
 SCALE: 1/4"=1'-0"

- KEYNOTES:
- 1 WELD ALL CUT REINFORCING BARS TO ANNULAR RING FOR PIPES GREATER THAN 48"Ø. USE LOW HYDROGEN WELDING
 - 2 REINFORCING STEEL CLEAR COVER PLUS DIAMETER OF OUTSIDE BARS
 - 3 GRIND SMOOTH ALL METAL EDGES IN AREAS TO BE COATED & ALL SURFACES IN PIPE SEATING AREA
 - 4 RING SHALL HAVE SPIDER BRACING INSTALLED AT POINT OF MANUFACTURER
 - 5 RING SHALL BE EPOXY COATED AFTER FABRICATION
 - 6 SHAPE & SIZE OF PIPE SPIGOT SHALL BE VERIFIED BY CONTRACTOR PRIOR TO FABRICATION OF BELL RING

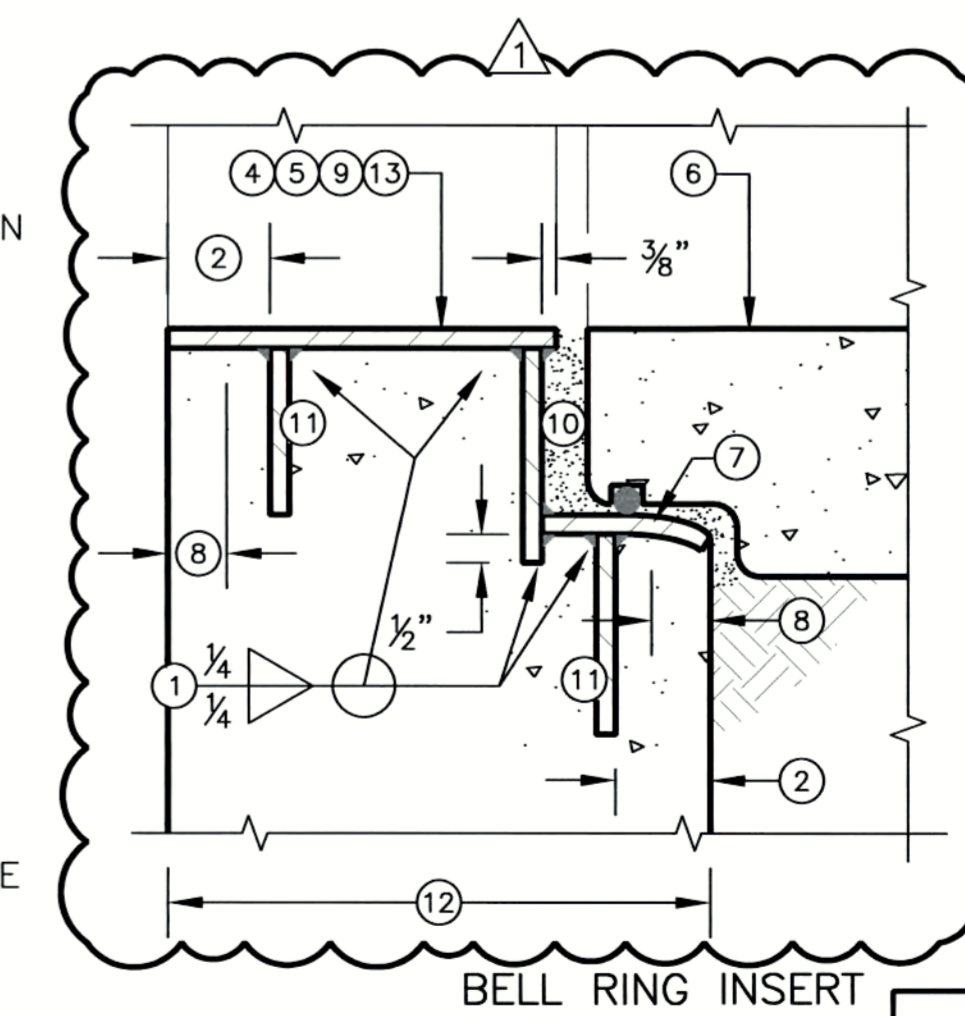

BELL RING INSERT
DETAIL B
 NTS

RECORD DRAWINGS
14-Mile Slough Pump Station Upgrades
 CIVIL DETAILS 4

DEPARTMENT OF MUNICIPAL UTILITIES CITY OF STOCKTON, CALIFORNIA		SHEET No.
SCALE: AS SHOWN	APPROVED BY: DATE:	C204
DESIGNED BY: TTT	DRAWN BY: DTD	22 of 89 SHEETS
CHECKED BY: GDH	RECORD DWG.:	PROJECT No. 293-00-05-01
ASSISTANT DIRECTOR, DEPT. OF MUNICIPAL UTILITIES		

N:\Clients\293 Spross\00-05-01 14-Mile Slough Pump Station Upgrades\CAD\Design\Asbuilt\293-0501C204.dwg 11-13-08 09:51:07 AM dreimer

Underground Service Alert

TWO DAYS BEFORE YOU DIG


Call TOLL FREE: 1-800-642-2444

REFER TO BID SET FOR SIGNATURE

REV. No.	DISCRPTION	DATE	BY	App'd By
1	ADDENDUM No. 3	5/25/06	TTT	PDF
2	RECORD DRAWINGS	6/08	CLB	PDF
3				
4				
5				
6				
7				


WEST YOST ASSOCIATES
 Consulting Engineers

1260 Lake Boulevard
 Suite 240
 Davis, California 95616
 (530) 756-5905
 FAX (530) 756-5991

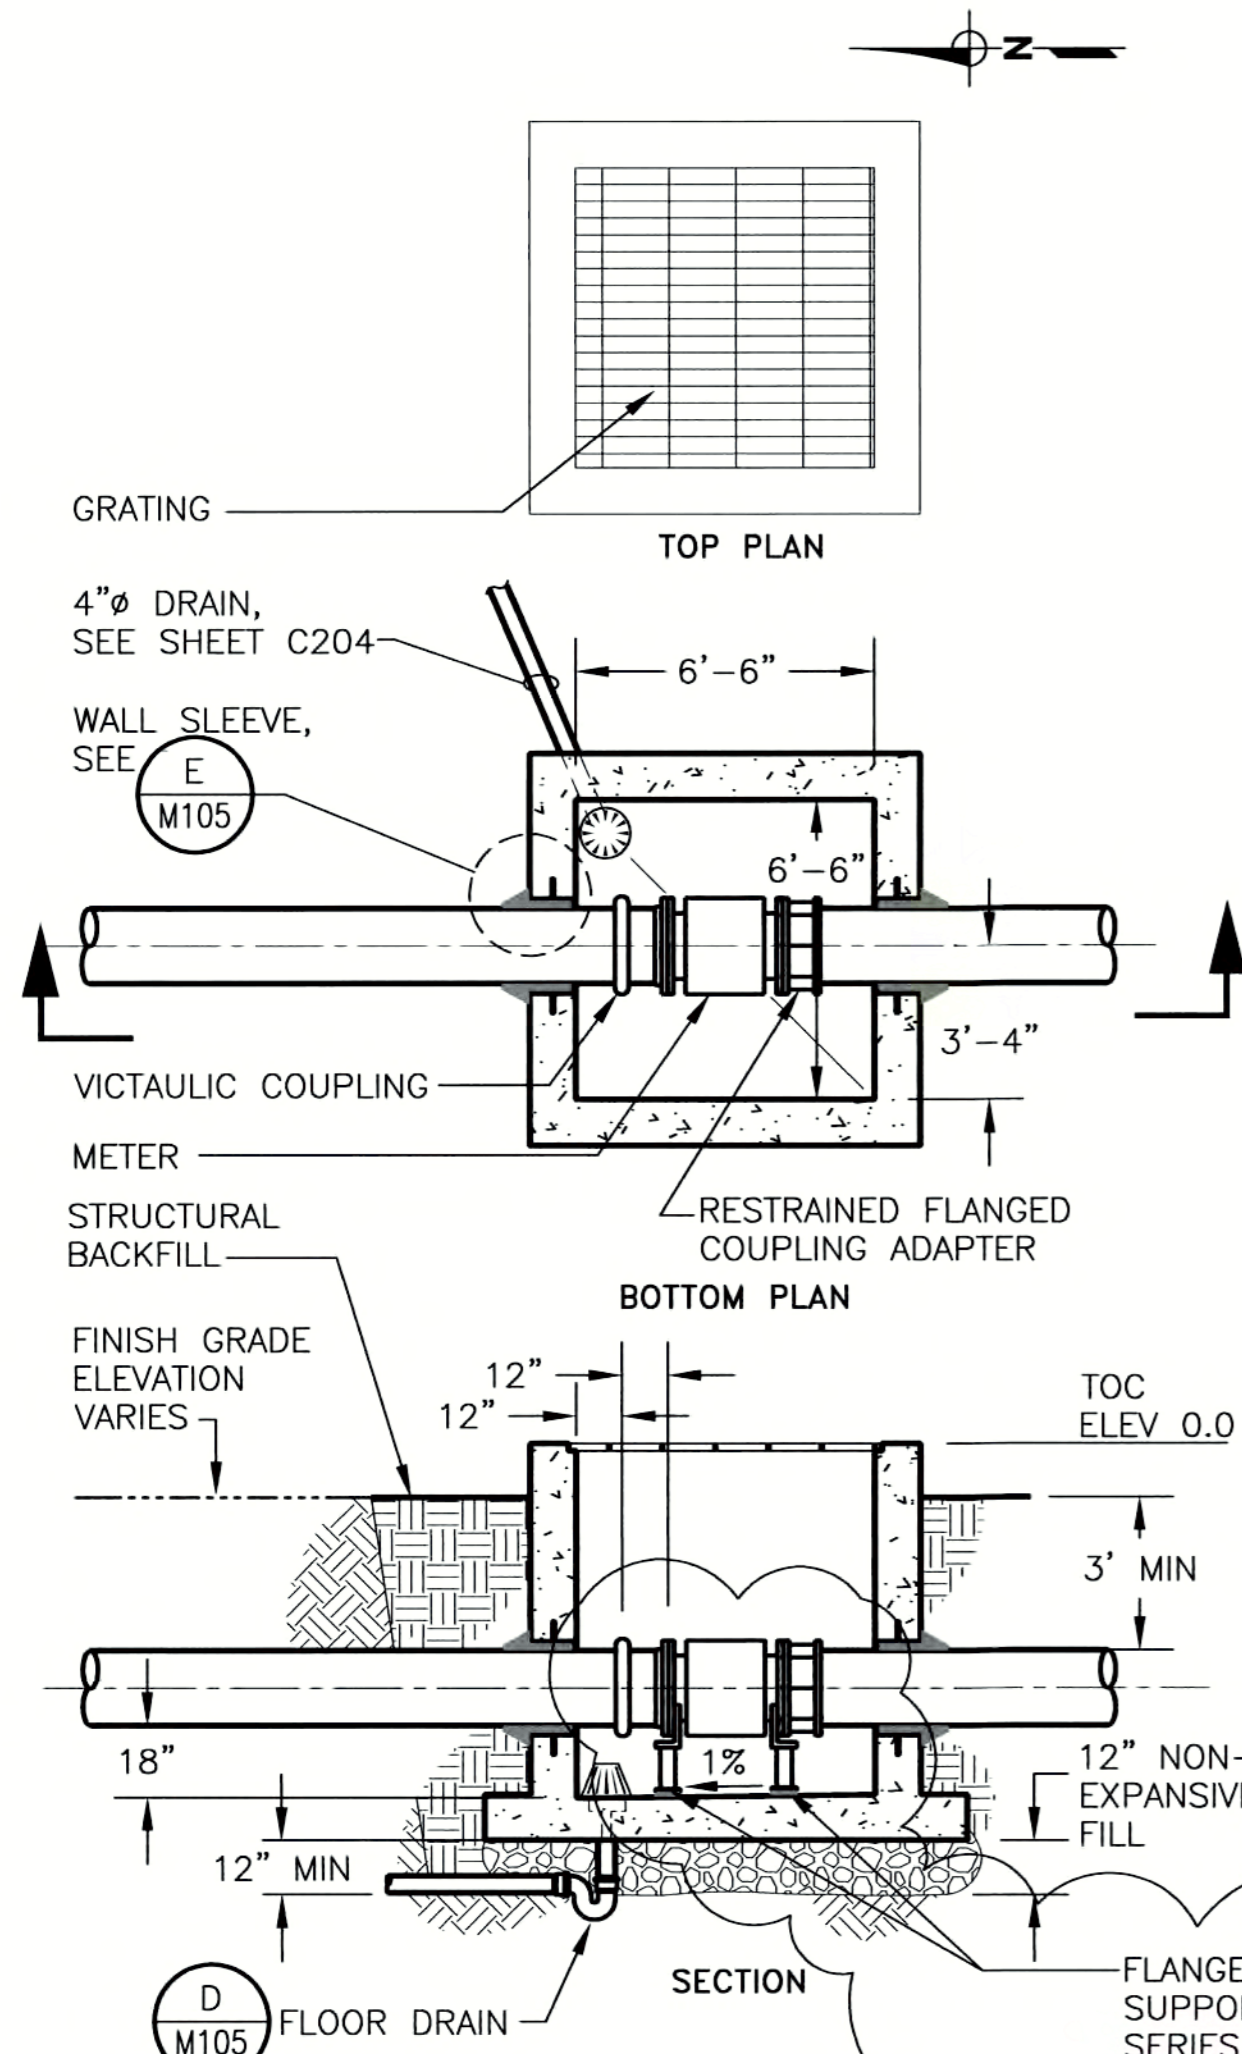


NOTES:
 1. METER DIMENSION PER METER MANUFACTURER.
 2. SEE PLAN & PROFILE SHEET C104 FOR PIPING CONTINUATIONS.
 3. PROVIDE 3/16" THICK NEOPRENE PAD BETWEEN FLOW METER PIPING AND SUPPORT.


METER VAULT
 DETAIL A/C7
 SCALE: 1/4"=1'-0"

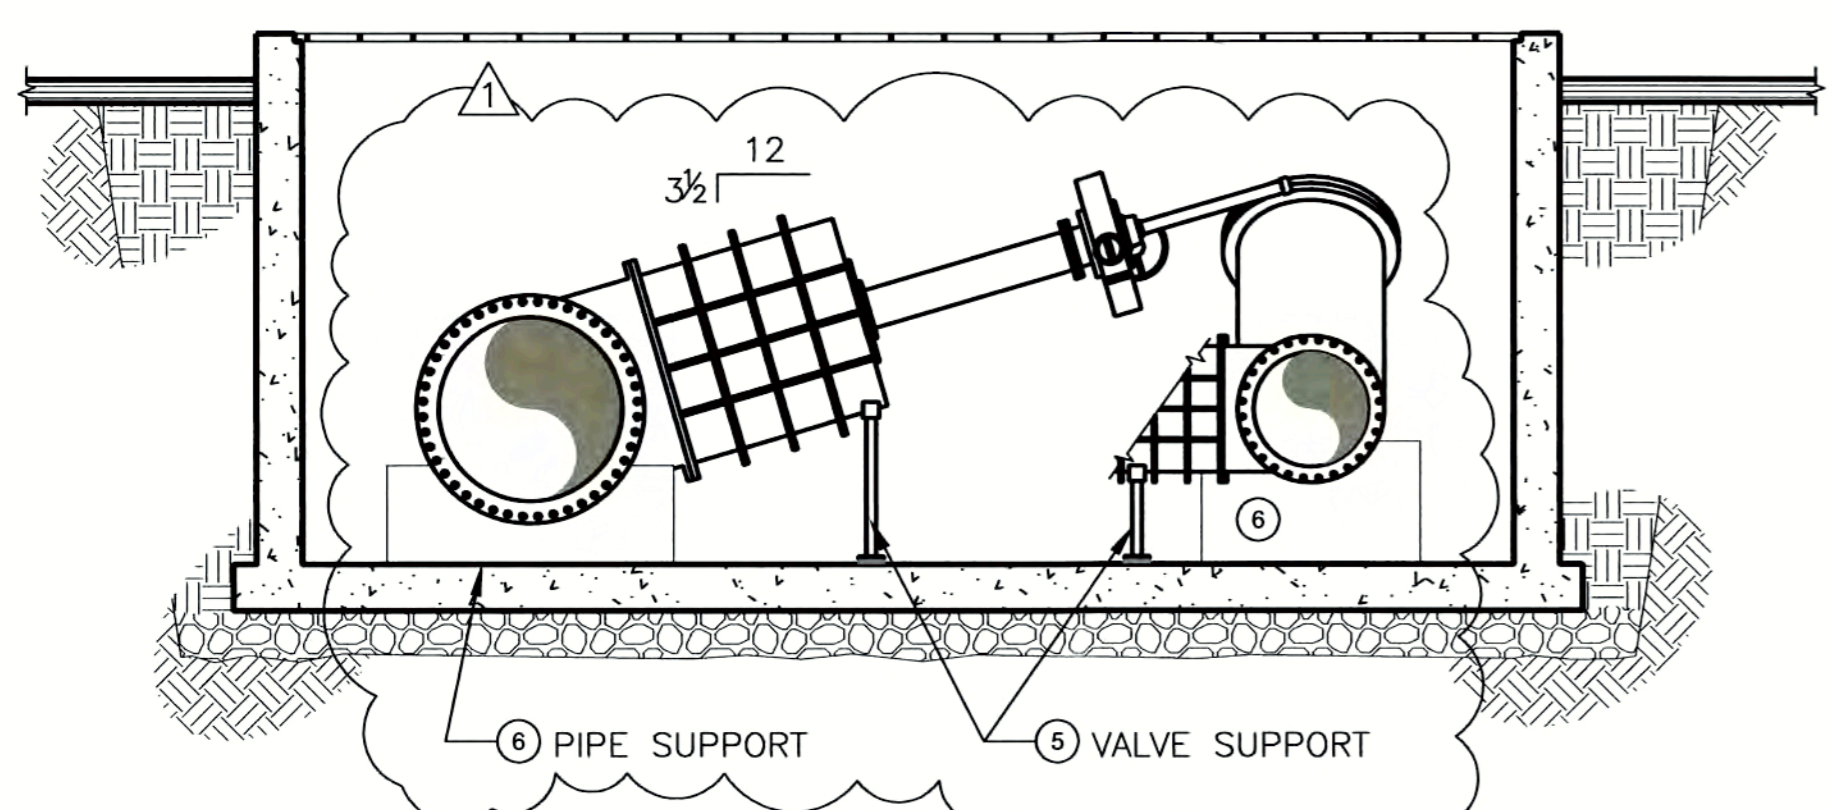


ISOLATION VAULT
 SECTION 1/1
 1/4"=1'-0"

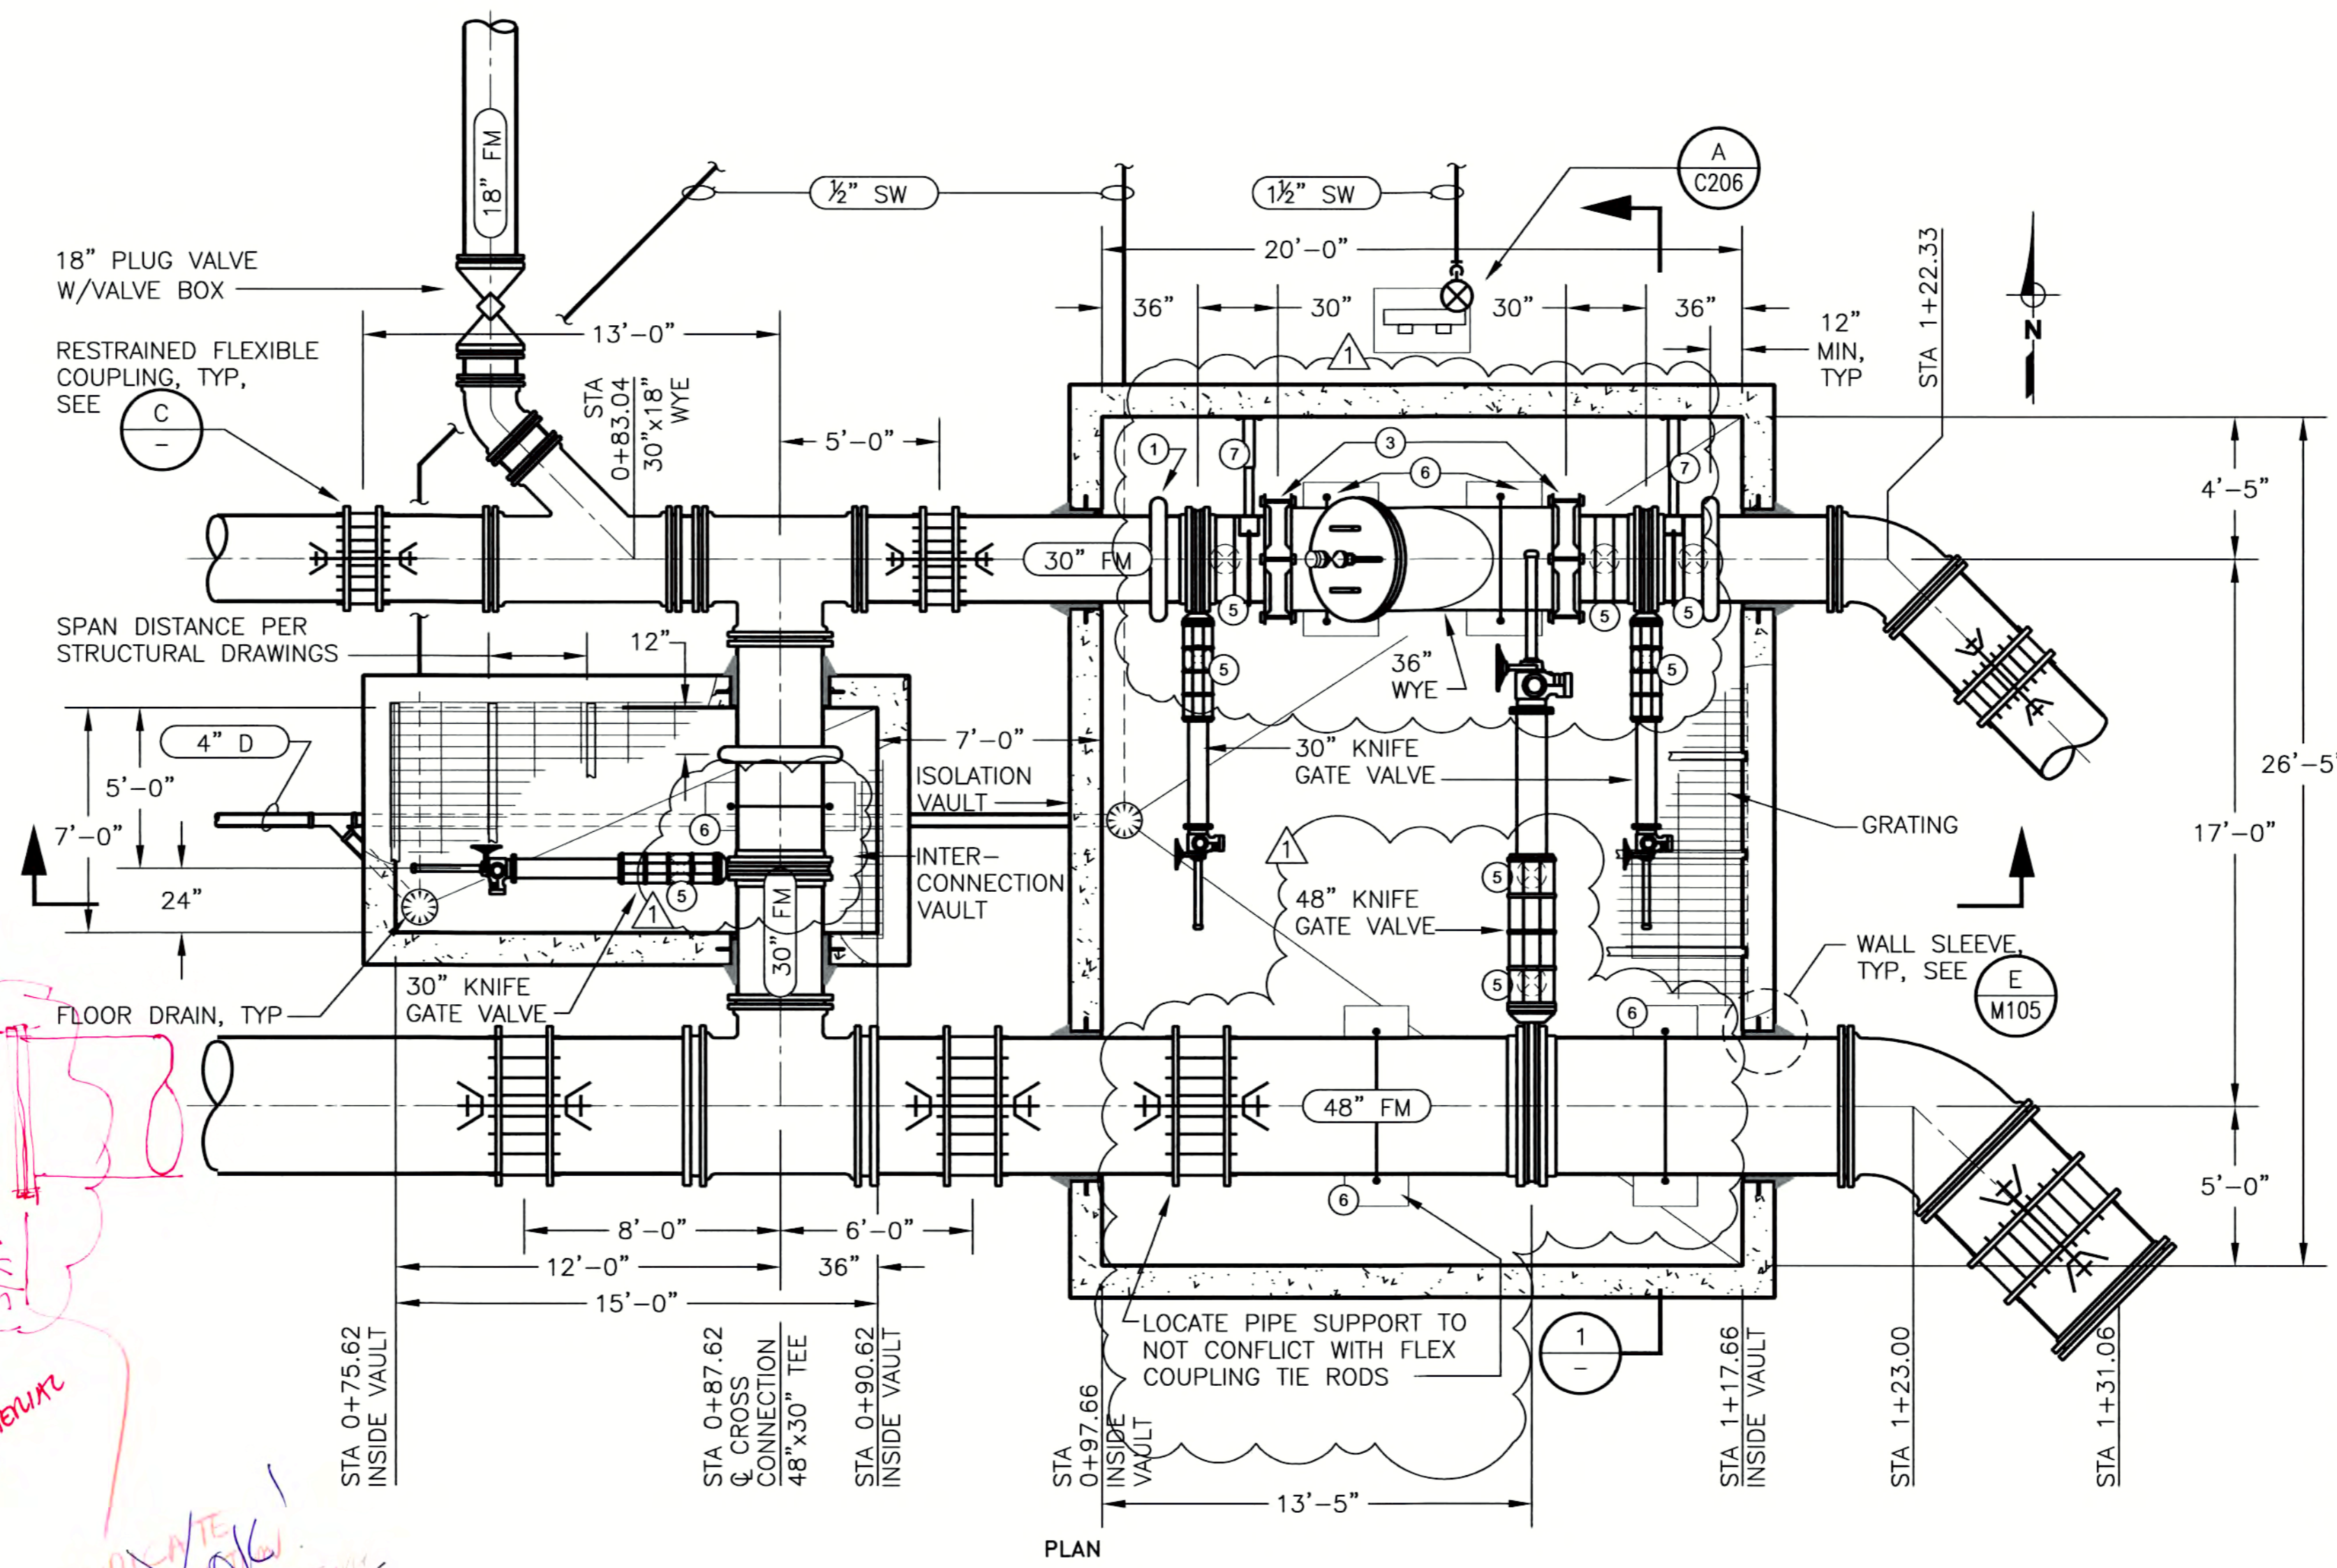

PLAN

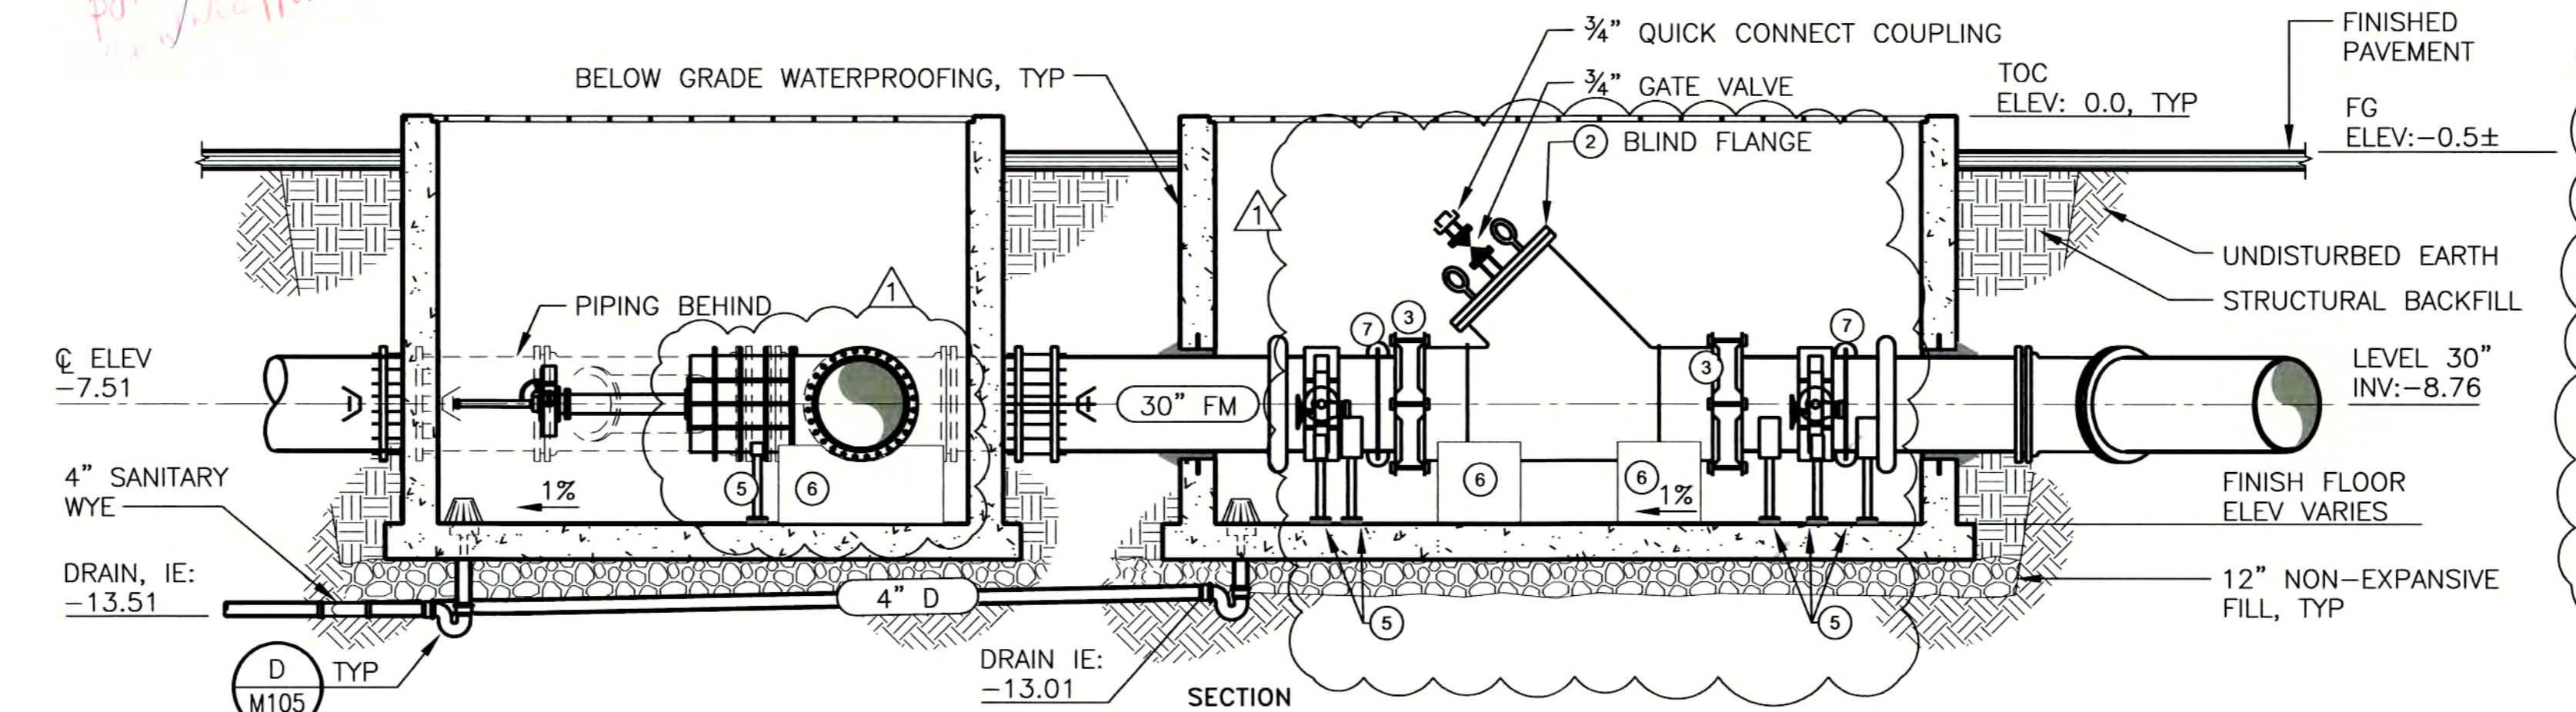

ISOLATION & INTERCONNECTION VAULT
 DETAIL B/C7
 SCALE: 1/4"=1'-0"

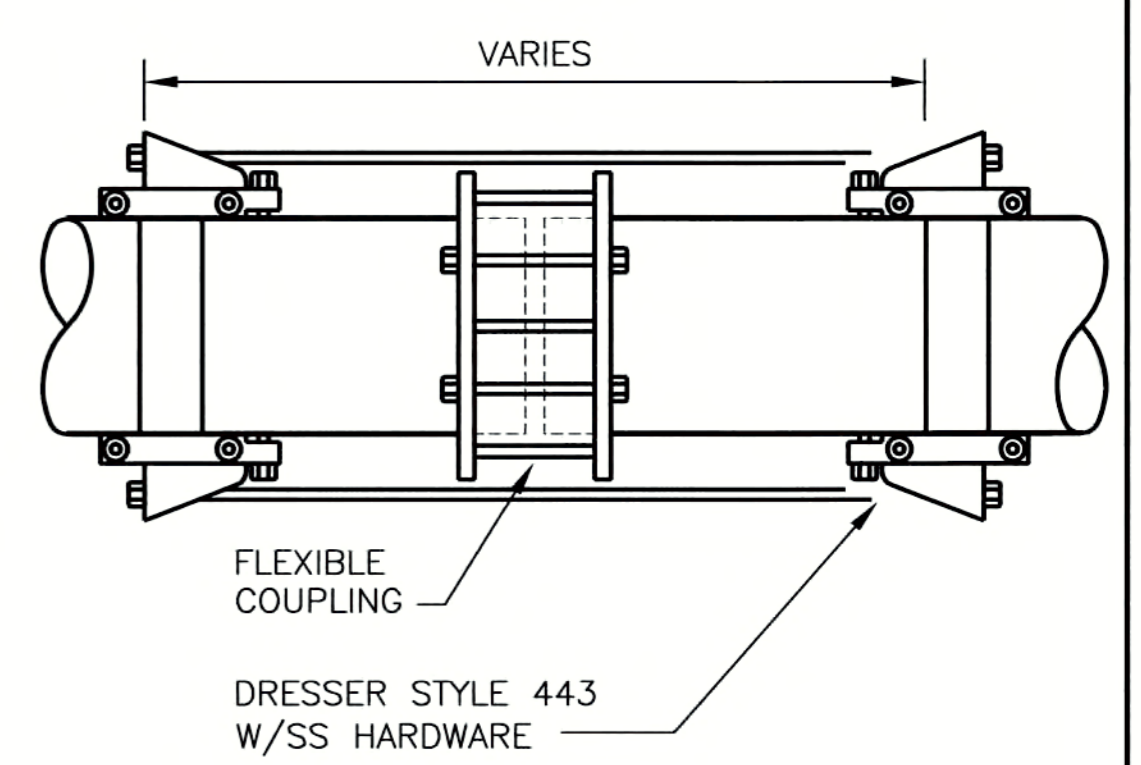

TYPICAL HARNESS FLEX COUPLING
 DETAIL C/VAR
 NOT TO SCALE

- NOTES:
- VICTAULIC TYPE COUPLING
 - DRILL AND TAP 3/4" NPT PIPE CONNECTION AND THREE 1" ID EYE BOLTS WITH NUTS. PIPE, GATE VALVE, AND ACCESSORIES SHALL BE STAINLESS STEEL. EYE BOLTS SHALL BE EQUALLY SPACED AND ORIENTED AS SHOWN IN PLAN
 - 36"x30" REDUCING COUPLING W/LOCK-PINS, TYP. COUPLING SHALL BE DRESSER STYLE 62, OR EQUAL, WITH EPOXY COATING AND LINING AND SEWAGE RATED GASKETS
 - SEE PLAN & PROFILE SHEET C105 FOR PIPING CONTINUATIONS
 - PIPE SUPPORT, SEE (A/M106) TYP. FOR SUPPORTS
 UNDER KNIFE GATE BONNET, USE PIPE SUPPORTS FOR 14" PIPES OR LARGER
 - PIPE SUPPORT, SEE (B/M106) TYP. W/ 1/2" THICK X 2" WIDE SS BAR, FORM TO MATCH PIPE, SECURE W/ 1/2" X 9" (6" MIN EMBED) SS EPOXY ANCHOR
 - PIPE SUPPORT, ANVIL FIG 265, OR EQUAL. MOUNT TO WALL W/ 1/2" SS EPOXY ANCHOR BOLTS, 6" MIN EMBED

INDICATE ACTUAL MATERIAL INSTALLED

INDICATE ACTUAL MATERIAL INSTALLED

INDICATE ACTUAL MATERIAL INSTALLED

INDICATE ACTUAL MATERIAL INSTALLED


RECORD DRAWINGS
 14-Mile Slough Pump Station Upgrades
 CIVIL DETAIL 5

DEPARTMENT OF MUNICIPAL UTILITIES CITY OF STOCKTON, CALIFORNIA		SCALE: AS SHOWN	APPROVED BY: DATE: _____	SHEET No. _____
DESIGNED BY: TTT	DRAWN BY: DTD	CHECKED BY: GDH	RECORD Dwg.:	C205.1
WEST YOST ASSOCIATES Consulting Engineers 1260 Lake Boulevard Suite 240 Davis, California 95616 (530) 756-5905 FAX (530) 756-5991			ASSISTANT DIRECTOR, DEPT. OF MUNICIPAL UTILITIES	23 of 89 SHEETS PROJECT No. 293-00-05-01




REV. No.	DISCRPTION	DATE	BY	Apr'd By
1	F.O. 19 - PIPE SUPPORTS	5/07	TTT	PDF
2				
3				
4				
5				
6				
7				


N:\Clients\293 - Sponos\00-05-01_14-MSFS Upgrades\CAD\Design\Asbults\293-0501C205.1.dwg 11-13-08 09:51:32 AM areimer

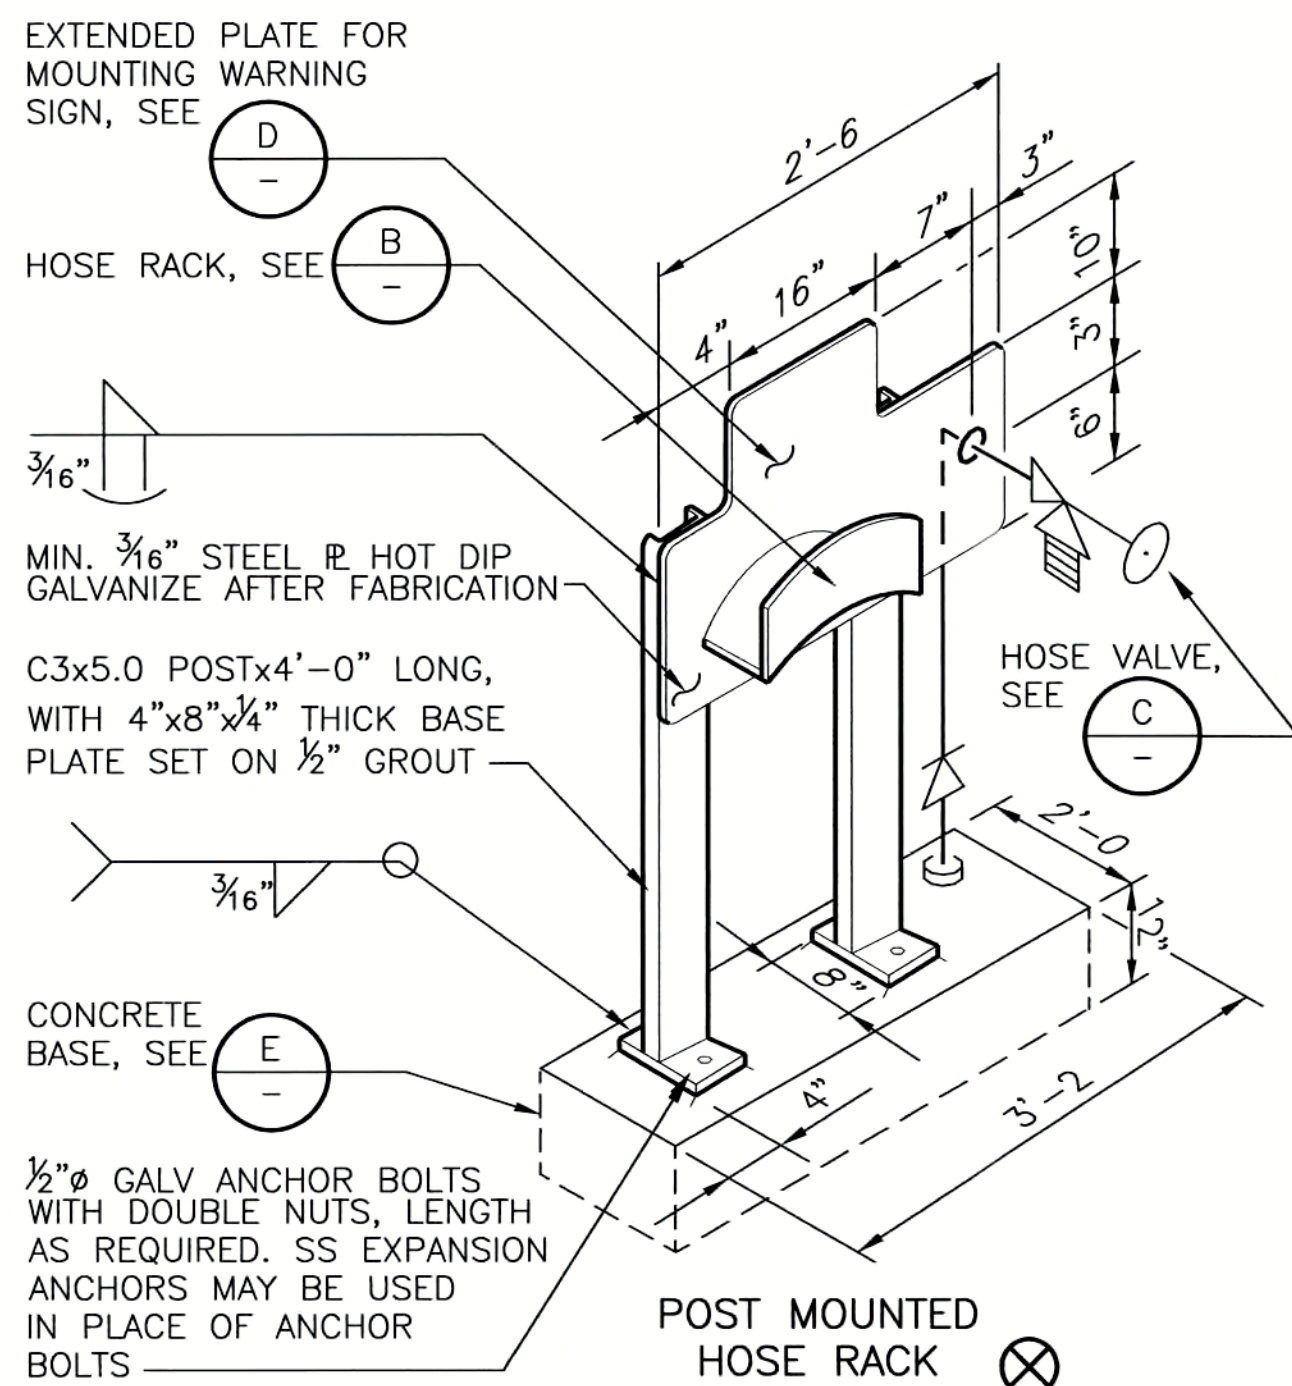


DETAIL A
SCALE: NONE

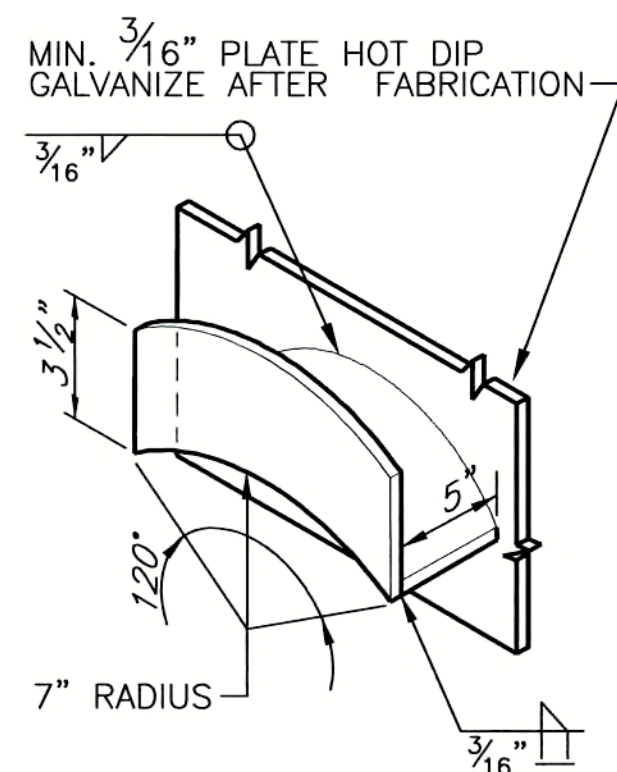


DETAIL B
SCALE: NONE

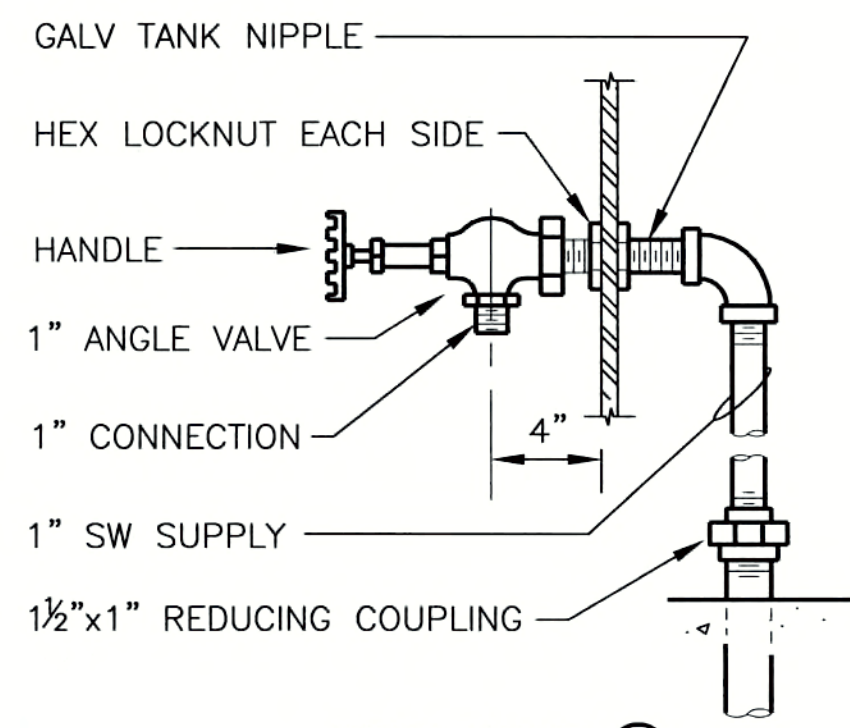


DETAIL C
SCALE: NONE

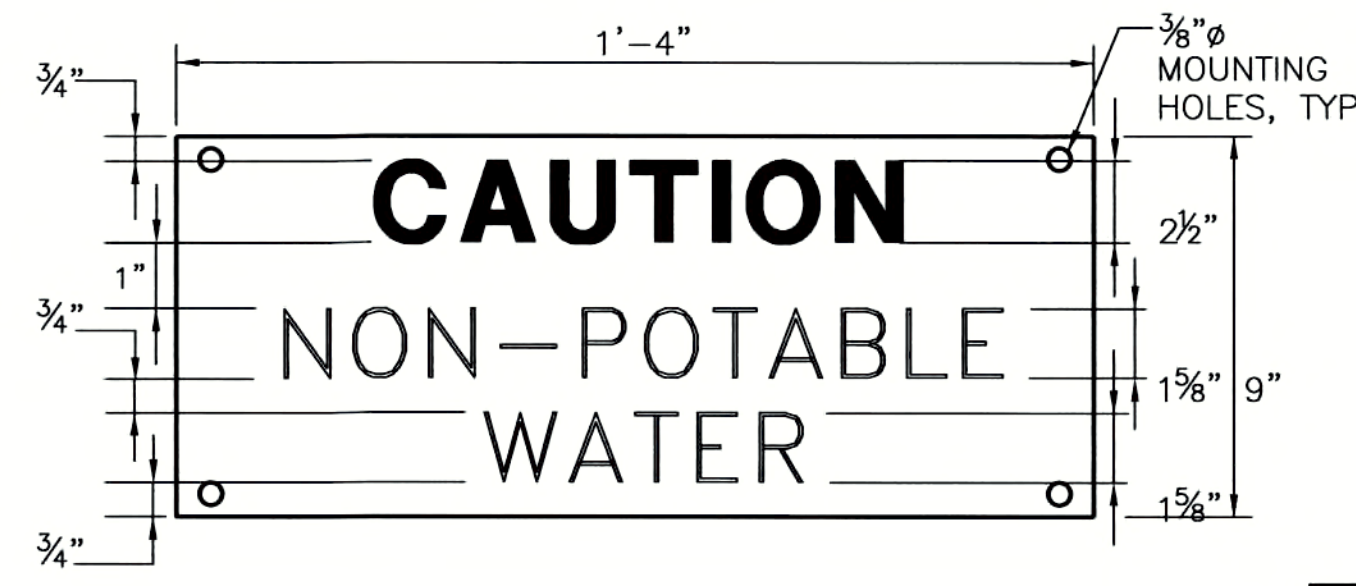


DETAIL D
SCALE: NONE

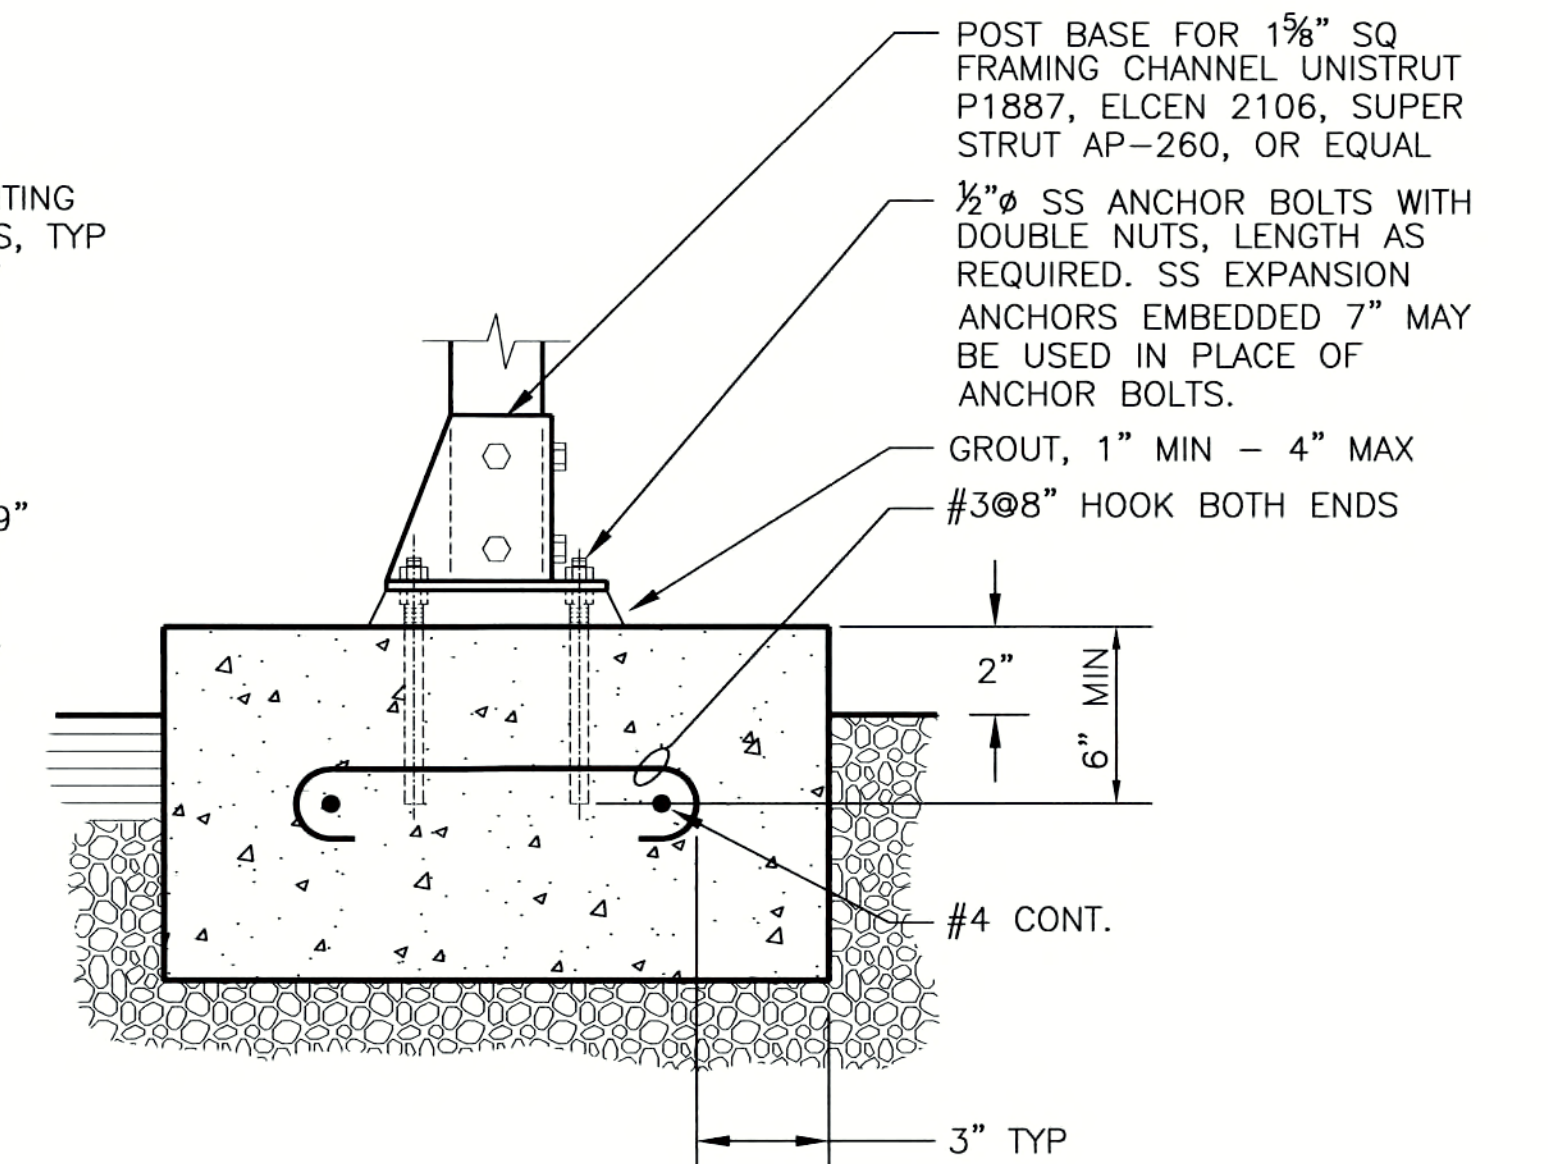

DETAIL E
SCALE: NONE

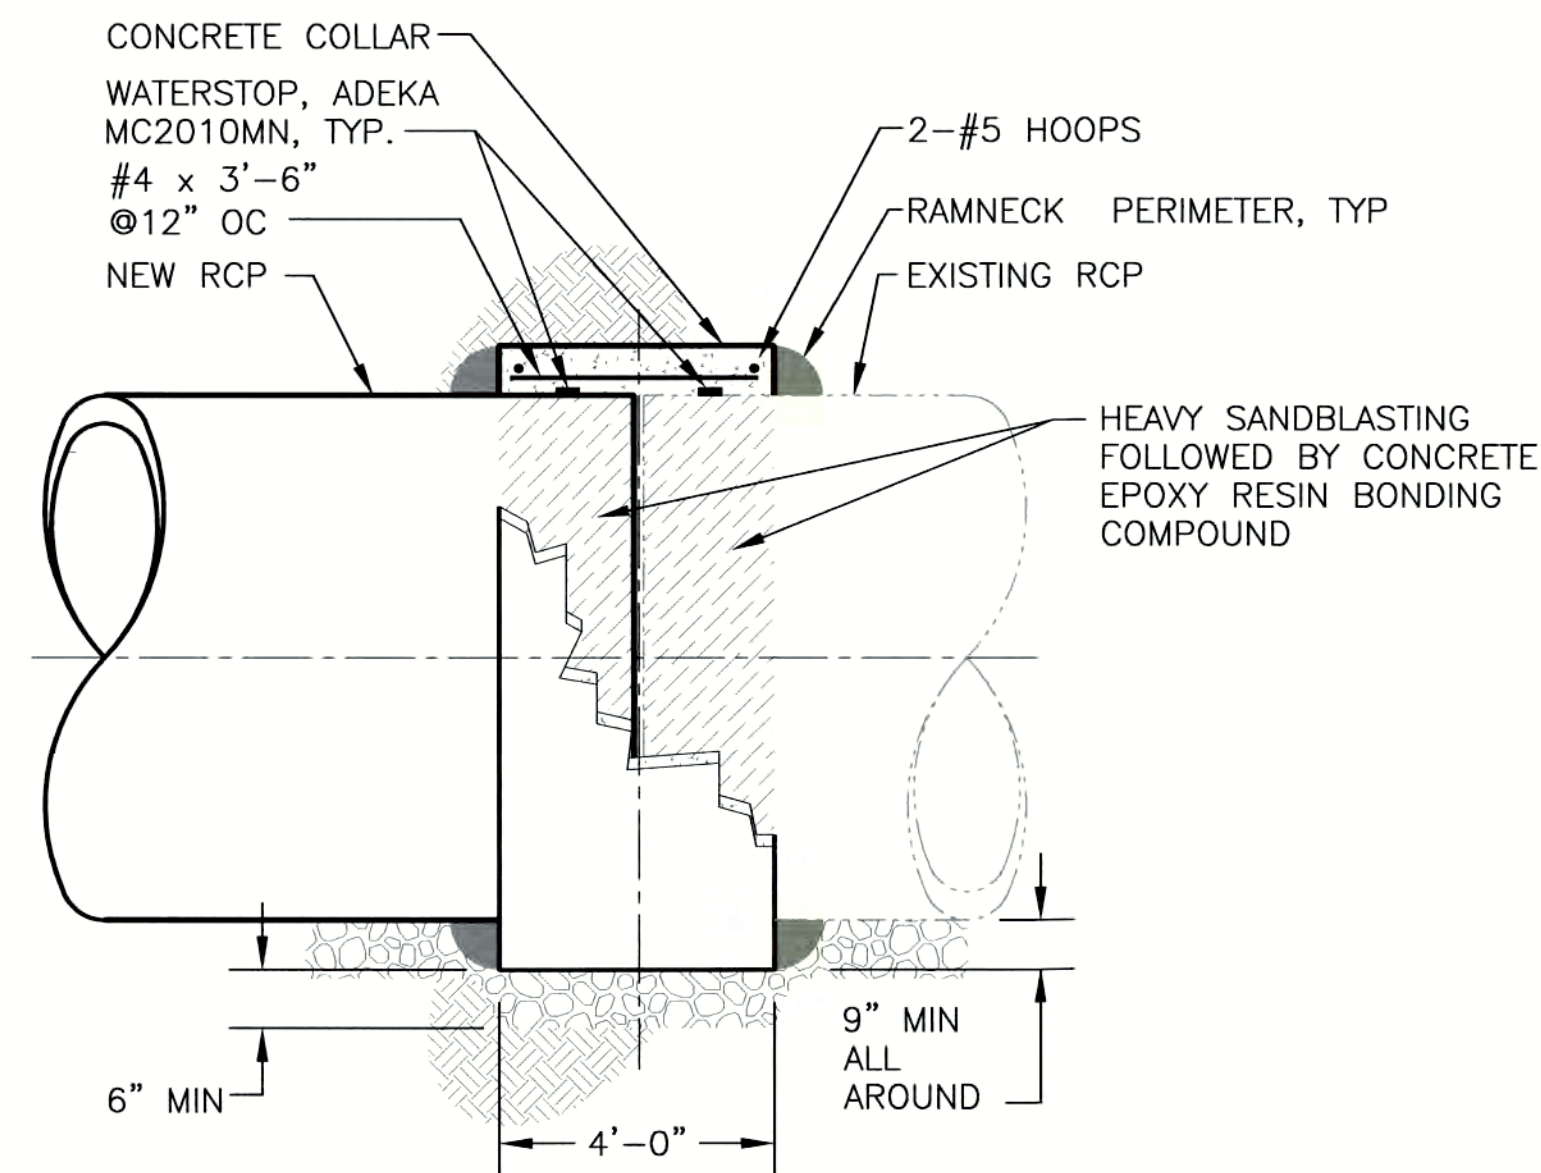


DETAIL G
SCALE: NONE

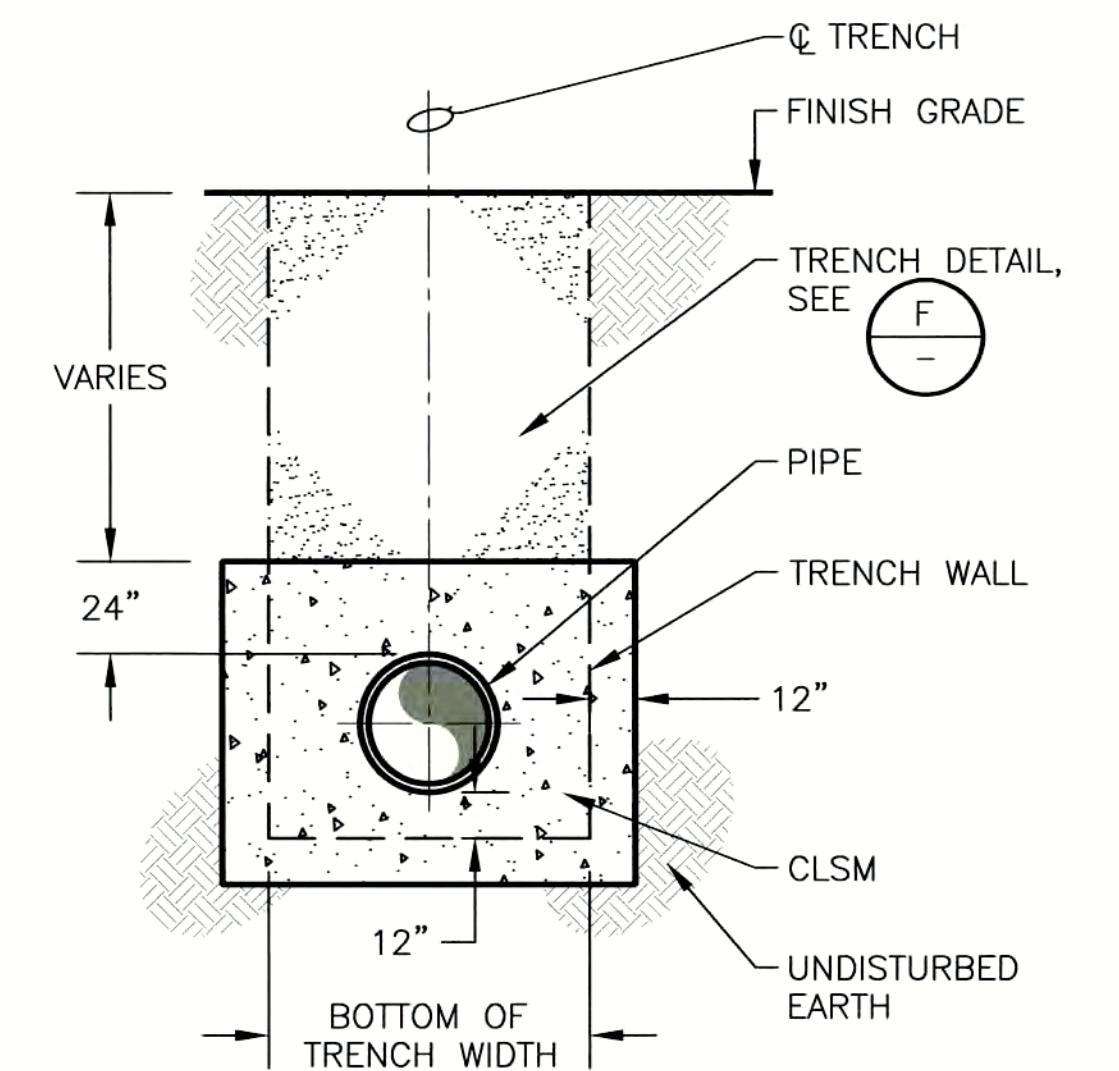


DETAIL J
SCALE: 1/4"=1'-0"

- NOTES:
- * SHALL BE TYPE H (1/2" CRUSHED ROCK)
 - CONTROLLED LOW STRENGTH BACKFILL MAY BE USED AS PIPE BACKFILL MATERIAL INSTEAD OF TYPE H MATERIAL. GEOTEXTILE FABRIC WILL NOT BE REQUIRED IF CONTROLLED LOW STRENGTH BACKFILL IS USED
 - PIPE BEDDING SHALL BE LAID ON STABLE, COMPACTED SOILS. IF UNSTABLE SOILS ARE ENCOUNTERED AT THE BOTTOM OF EXCAVATION, SCARIFY AND MOISTURE CONDITION 8 INCHES BELOW THE BEDDING OR THE DEPTH OF UNSTABLE SOILS, WHICH EVER IS GREATER. ALTERNATIVELY, UNSTABLE SOILS MAY BE REMOVED AND REPLACED WITH BEDDING MATERIAL. WORK PERFORMED TO RECTIFY UNSTABLE SOILS SHALL BE AT THE DIRECTION OF THE ENGINEER

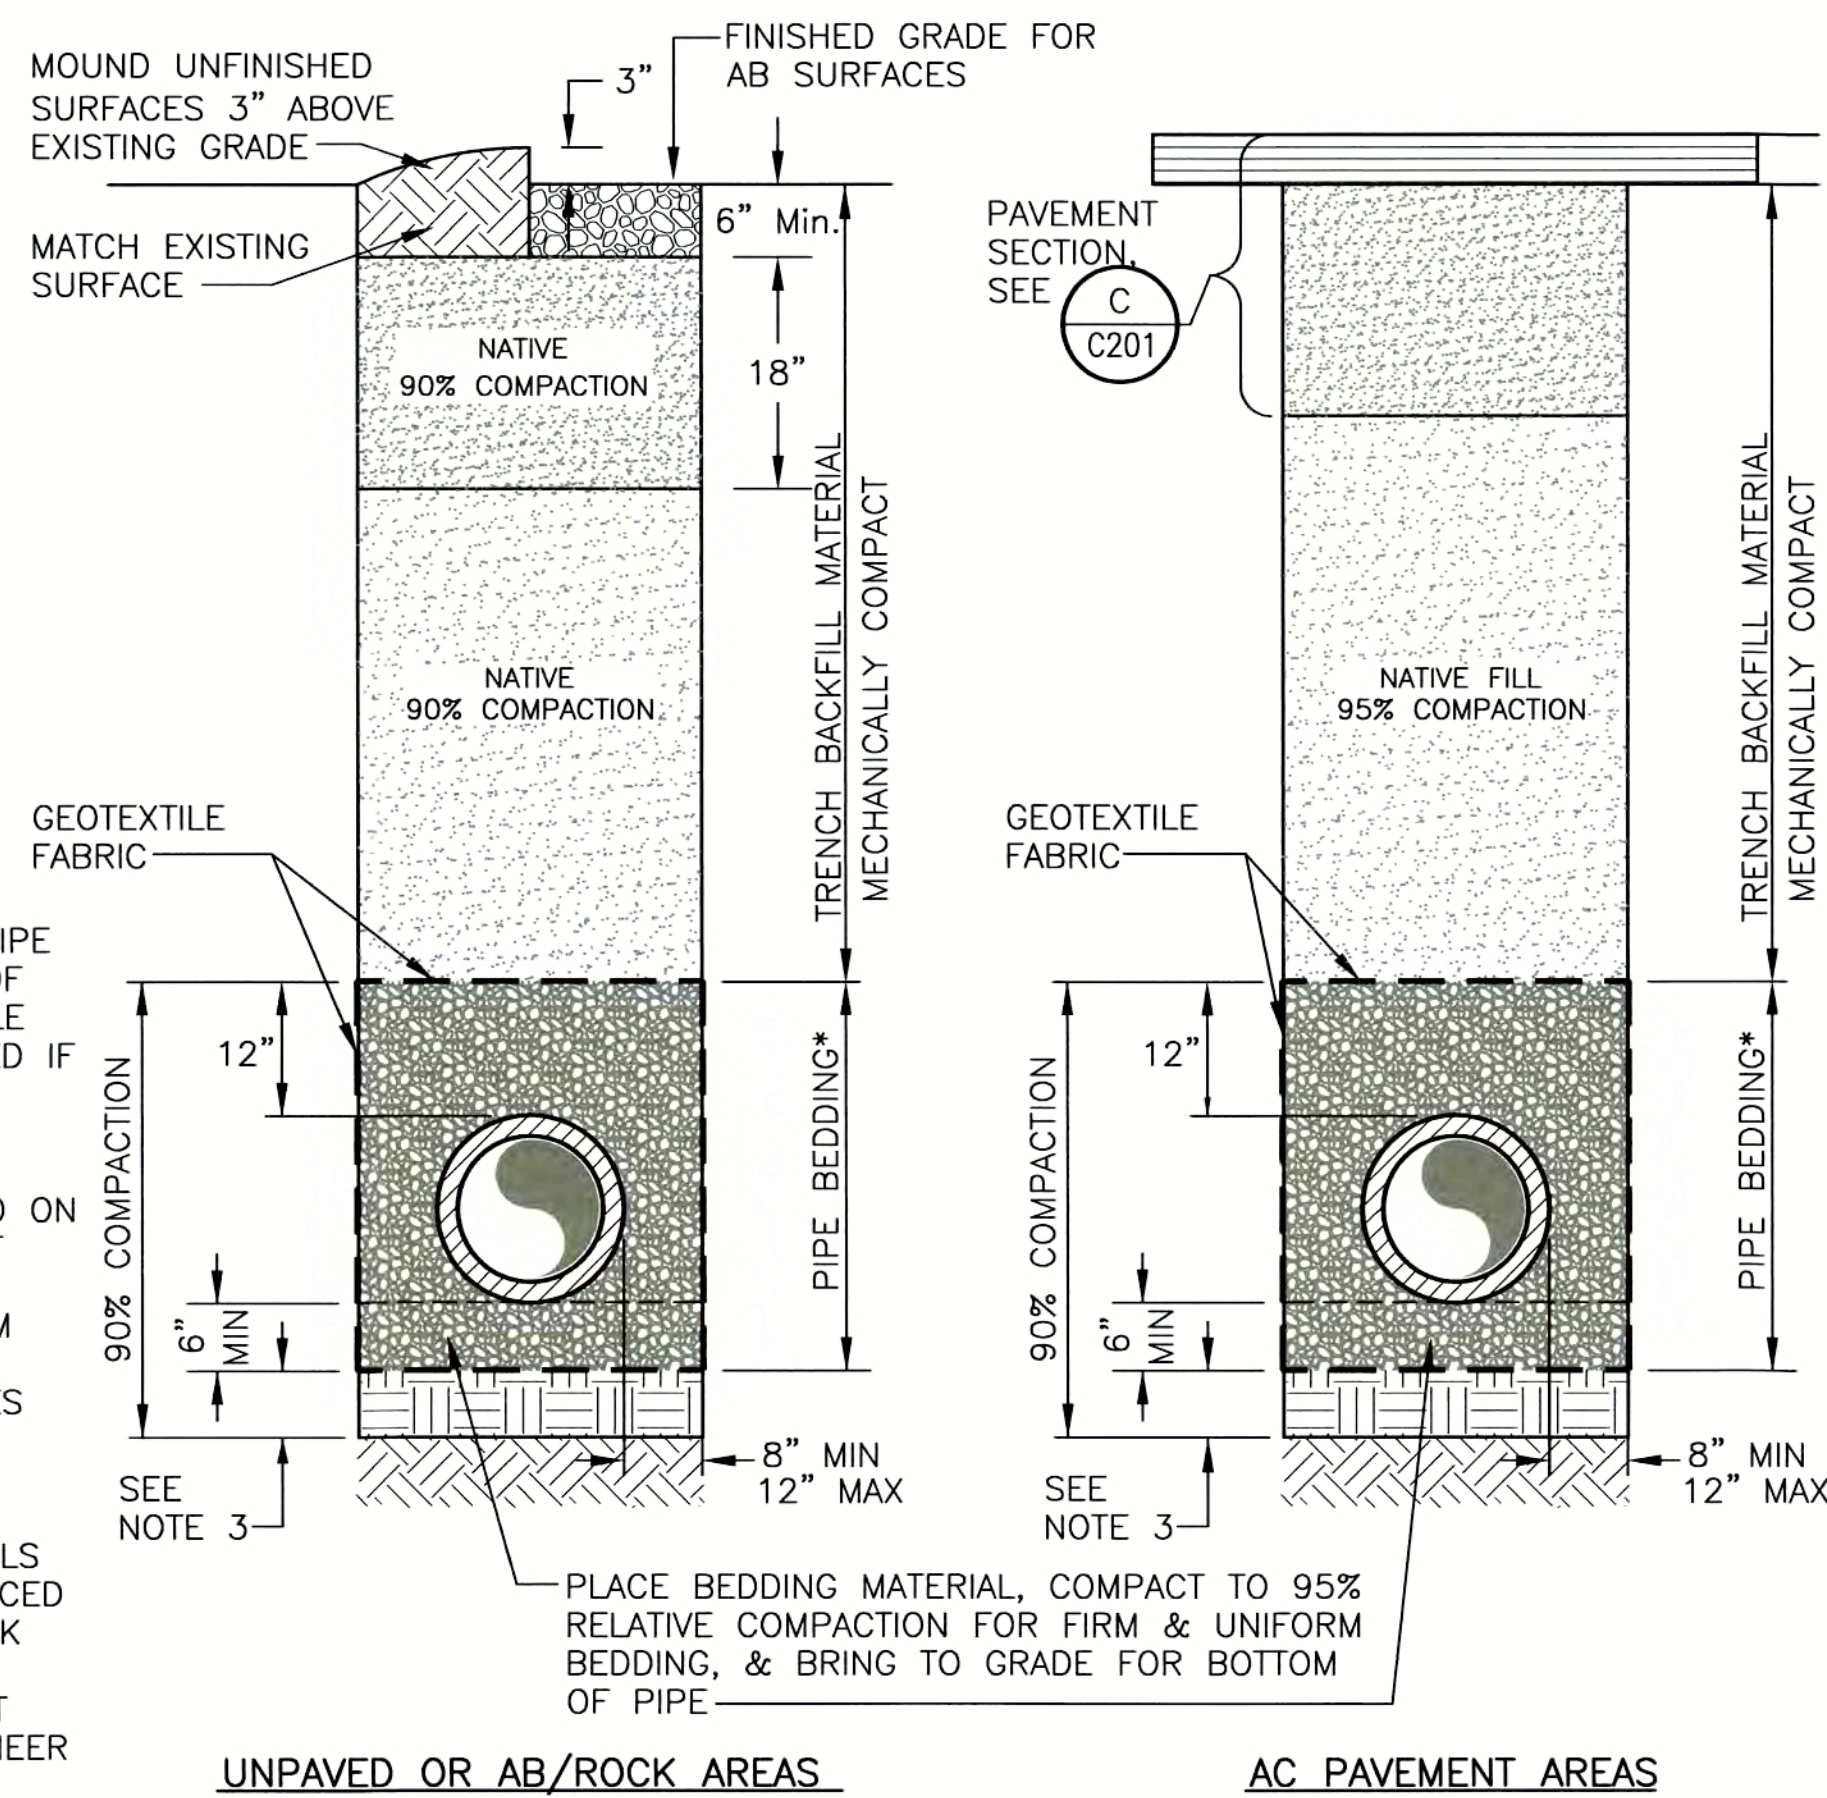

DETAIL F
SCALE: NONE

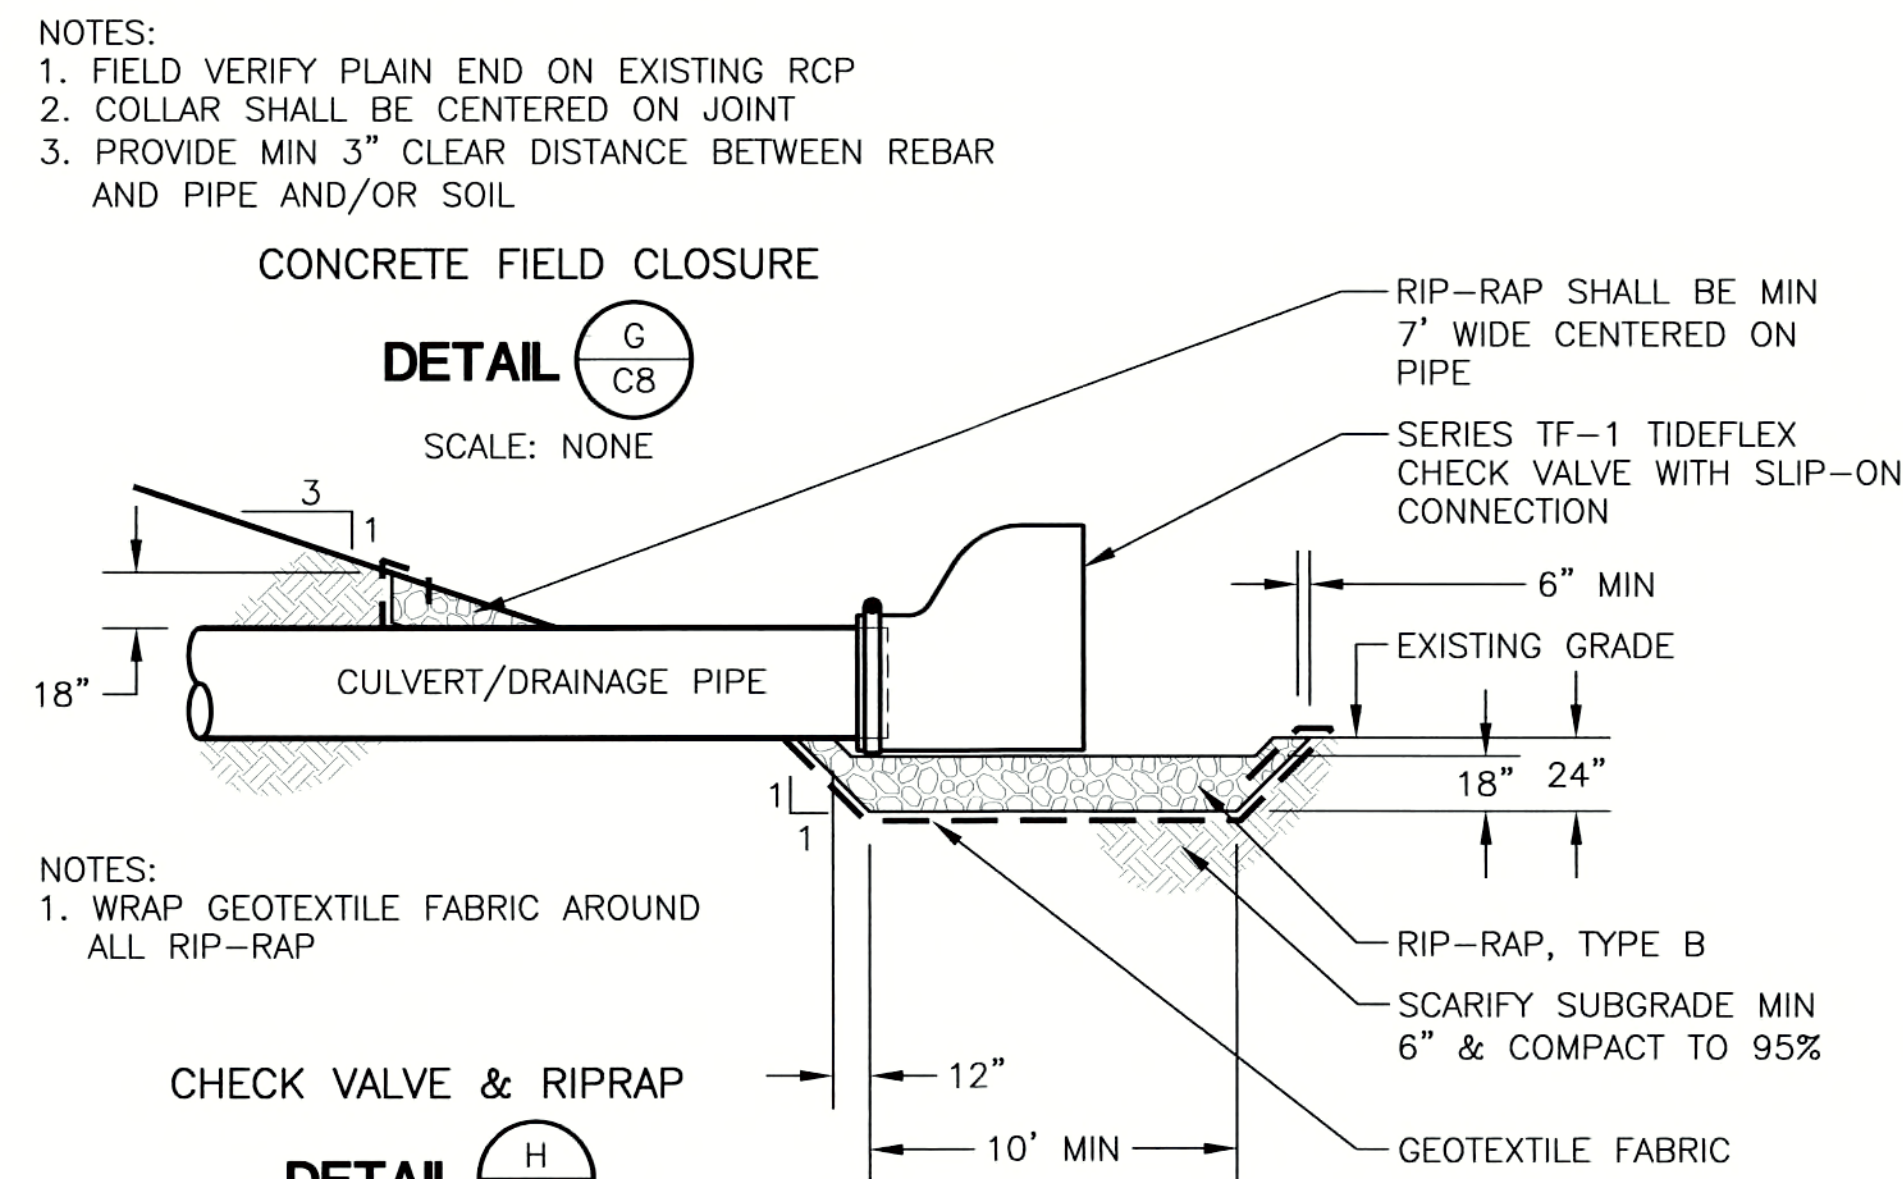

DETAIL H
SCALE: 1"=5'

N:\Clients\293 - Spontex\00-05-01 14-MSFS Upgrades\CAD\Design\Submittals\293-0501\2006.dwg 11-13-08 09:53:31 AM dremmer

Underground Service Alert

TWO DAYS BEFORE YOU DIG

Call TOLL FREE: 1-800-642-2444

REFER TO BID SET FOR SIGNATURE

No. C66147

REV. No.	DISCRPTION	DATE	BY	Aprv'd By
1				
2				
3				
4				
5				
6				
7				

WEST YOST ASSOCIATES
Consulting Engineers

1260 Lake Boulevard
Suite 240
Davis, California 95616
(530) 756-5905
FAX (530) 756-5991


RECORD DRAWINGS

14-Mile Slough Pump Station Upgrades

CIVIL DETAILS 6

DEPARTMENT OF MUNICIPAL UTILITIES
CITY OF STOCKTON, CALIFORNIA


SCALE: AS SHOWN	APPROVED BY: DATE:	SHEET No.
DESIGNED BY: TTT		C206
DRAWN BY: DTD		24 of 89 SHEETS
CHECKED BY: GDH	ASSISTANT DIRECTOR, DEPT. OF MUNICIPAL UTILITIES	PROJECT No. 293-00-05-01
RECORD Dwg.:		

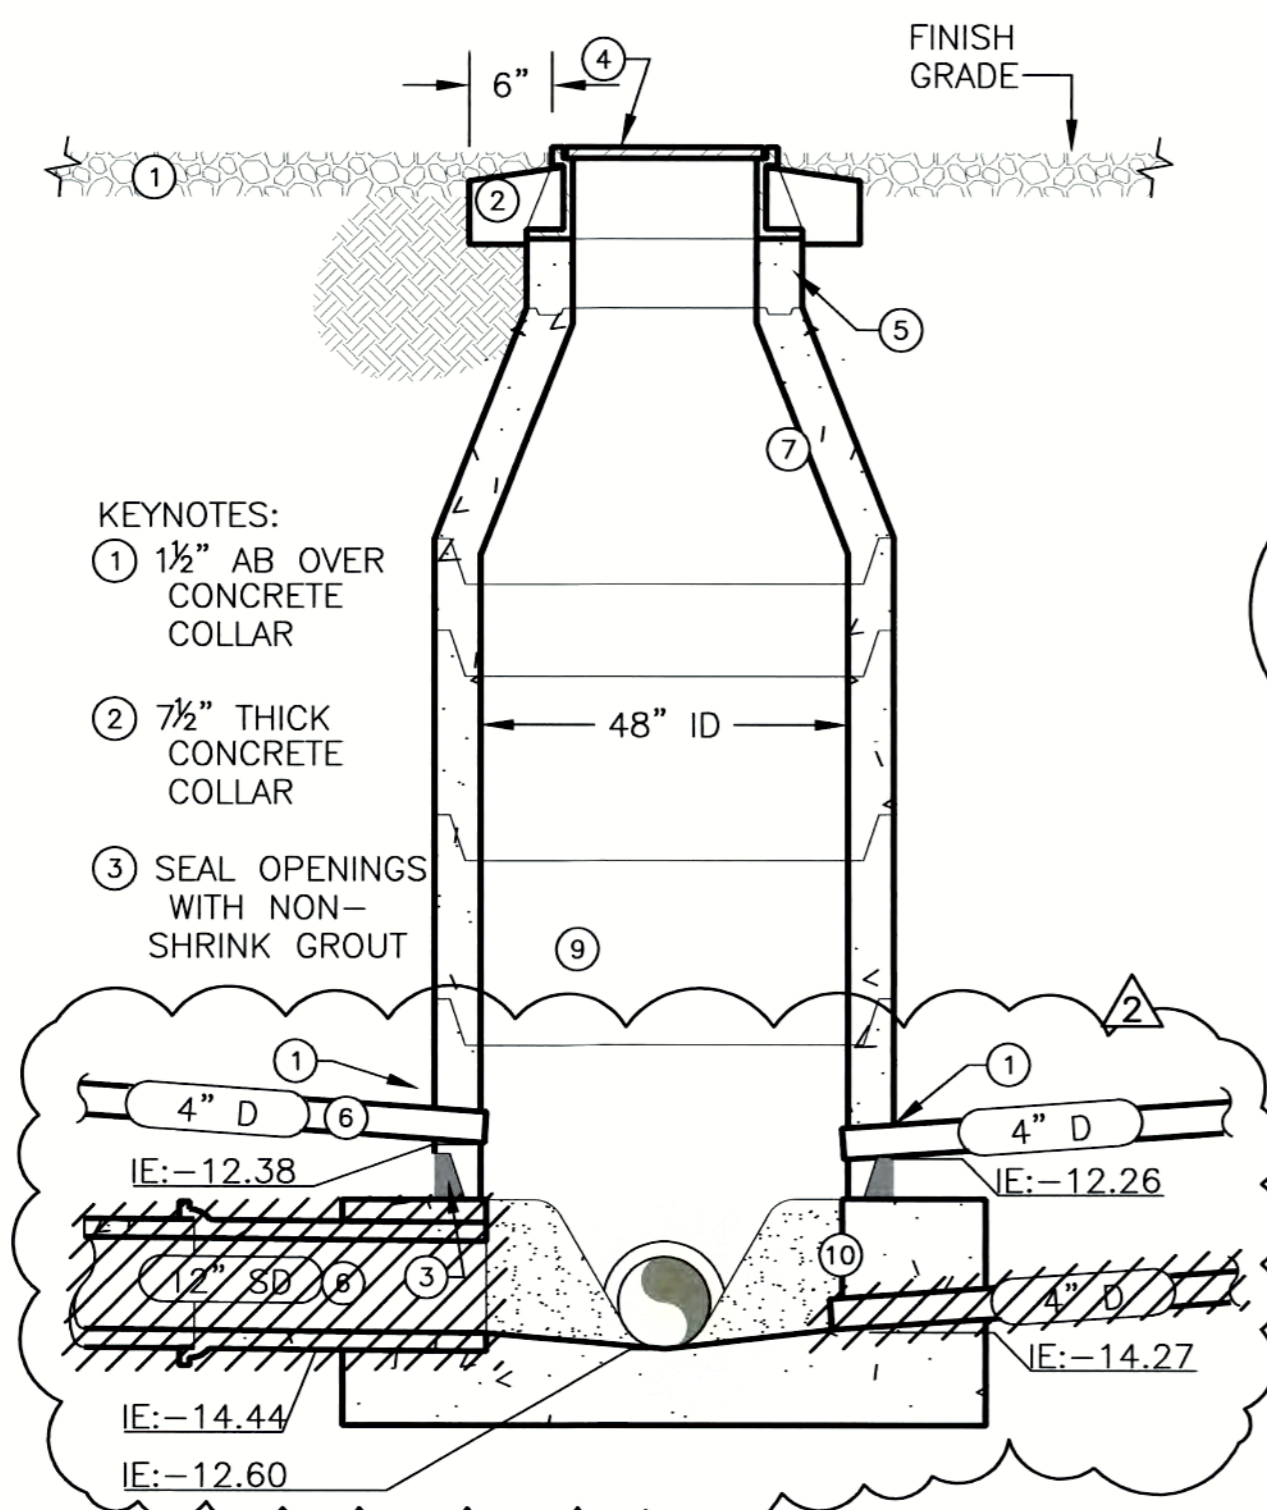


KEYNOTES:

- ① 1½" AB OVER CONCRETE COLLAR
- ② 7½" THICK CONCRETE COLLAR
- ③ SEAL OPENINGS WITH NON-SHRINK GROUT
- ④ CAST IRON FRAME & COVER, TYP. SEE COS STD DWG No. 54. RIM EL: -1.45. GROUT FRAME TO GRADE RING. SLOPE TO MATCH GRADE. COVER SHALL BE NEENAH FOUNDARY CO. MODEL R-2556 OR EQUAL
- ⑤ 3"-6" PRECAST REINFORCED CONCRETE GRADE RINGS AS REQ'D. SHALL CONFORM TO ASTM C-178. PRIOR APPROVAL FROM CITY ENGINEER MUST BE OBTAINED BEFORE INSTALLING MORE THAN 12" OF GRADE RINGS
- ⑥ CONSTRUCT PIPE STUB JOINT, 24" MIN TO 12"-0" MAX FOR PVC PIPE & 24" MAX FOR RIGID PIPE FROM BASE OF MH OR WET WELL
- ⑦ 30" TALL PRECAST REINFORCED CONCENTRIC MH CONE
- ⑧ FOR TYP PIPE INTERSECTION DETAIL SEE COS STD DWG No. 78
- ⑨ COAT INTERIOR OF MH AS PER COS SPEC SECTION 71-1.09
- ⑩ BASE SHALL CONFORM TO COS STD DWG No. 55

SDMH#1
DETAIL A
SCALE: 1/2"=1'-0"

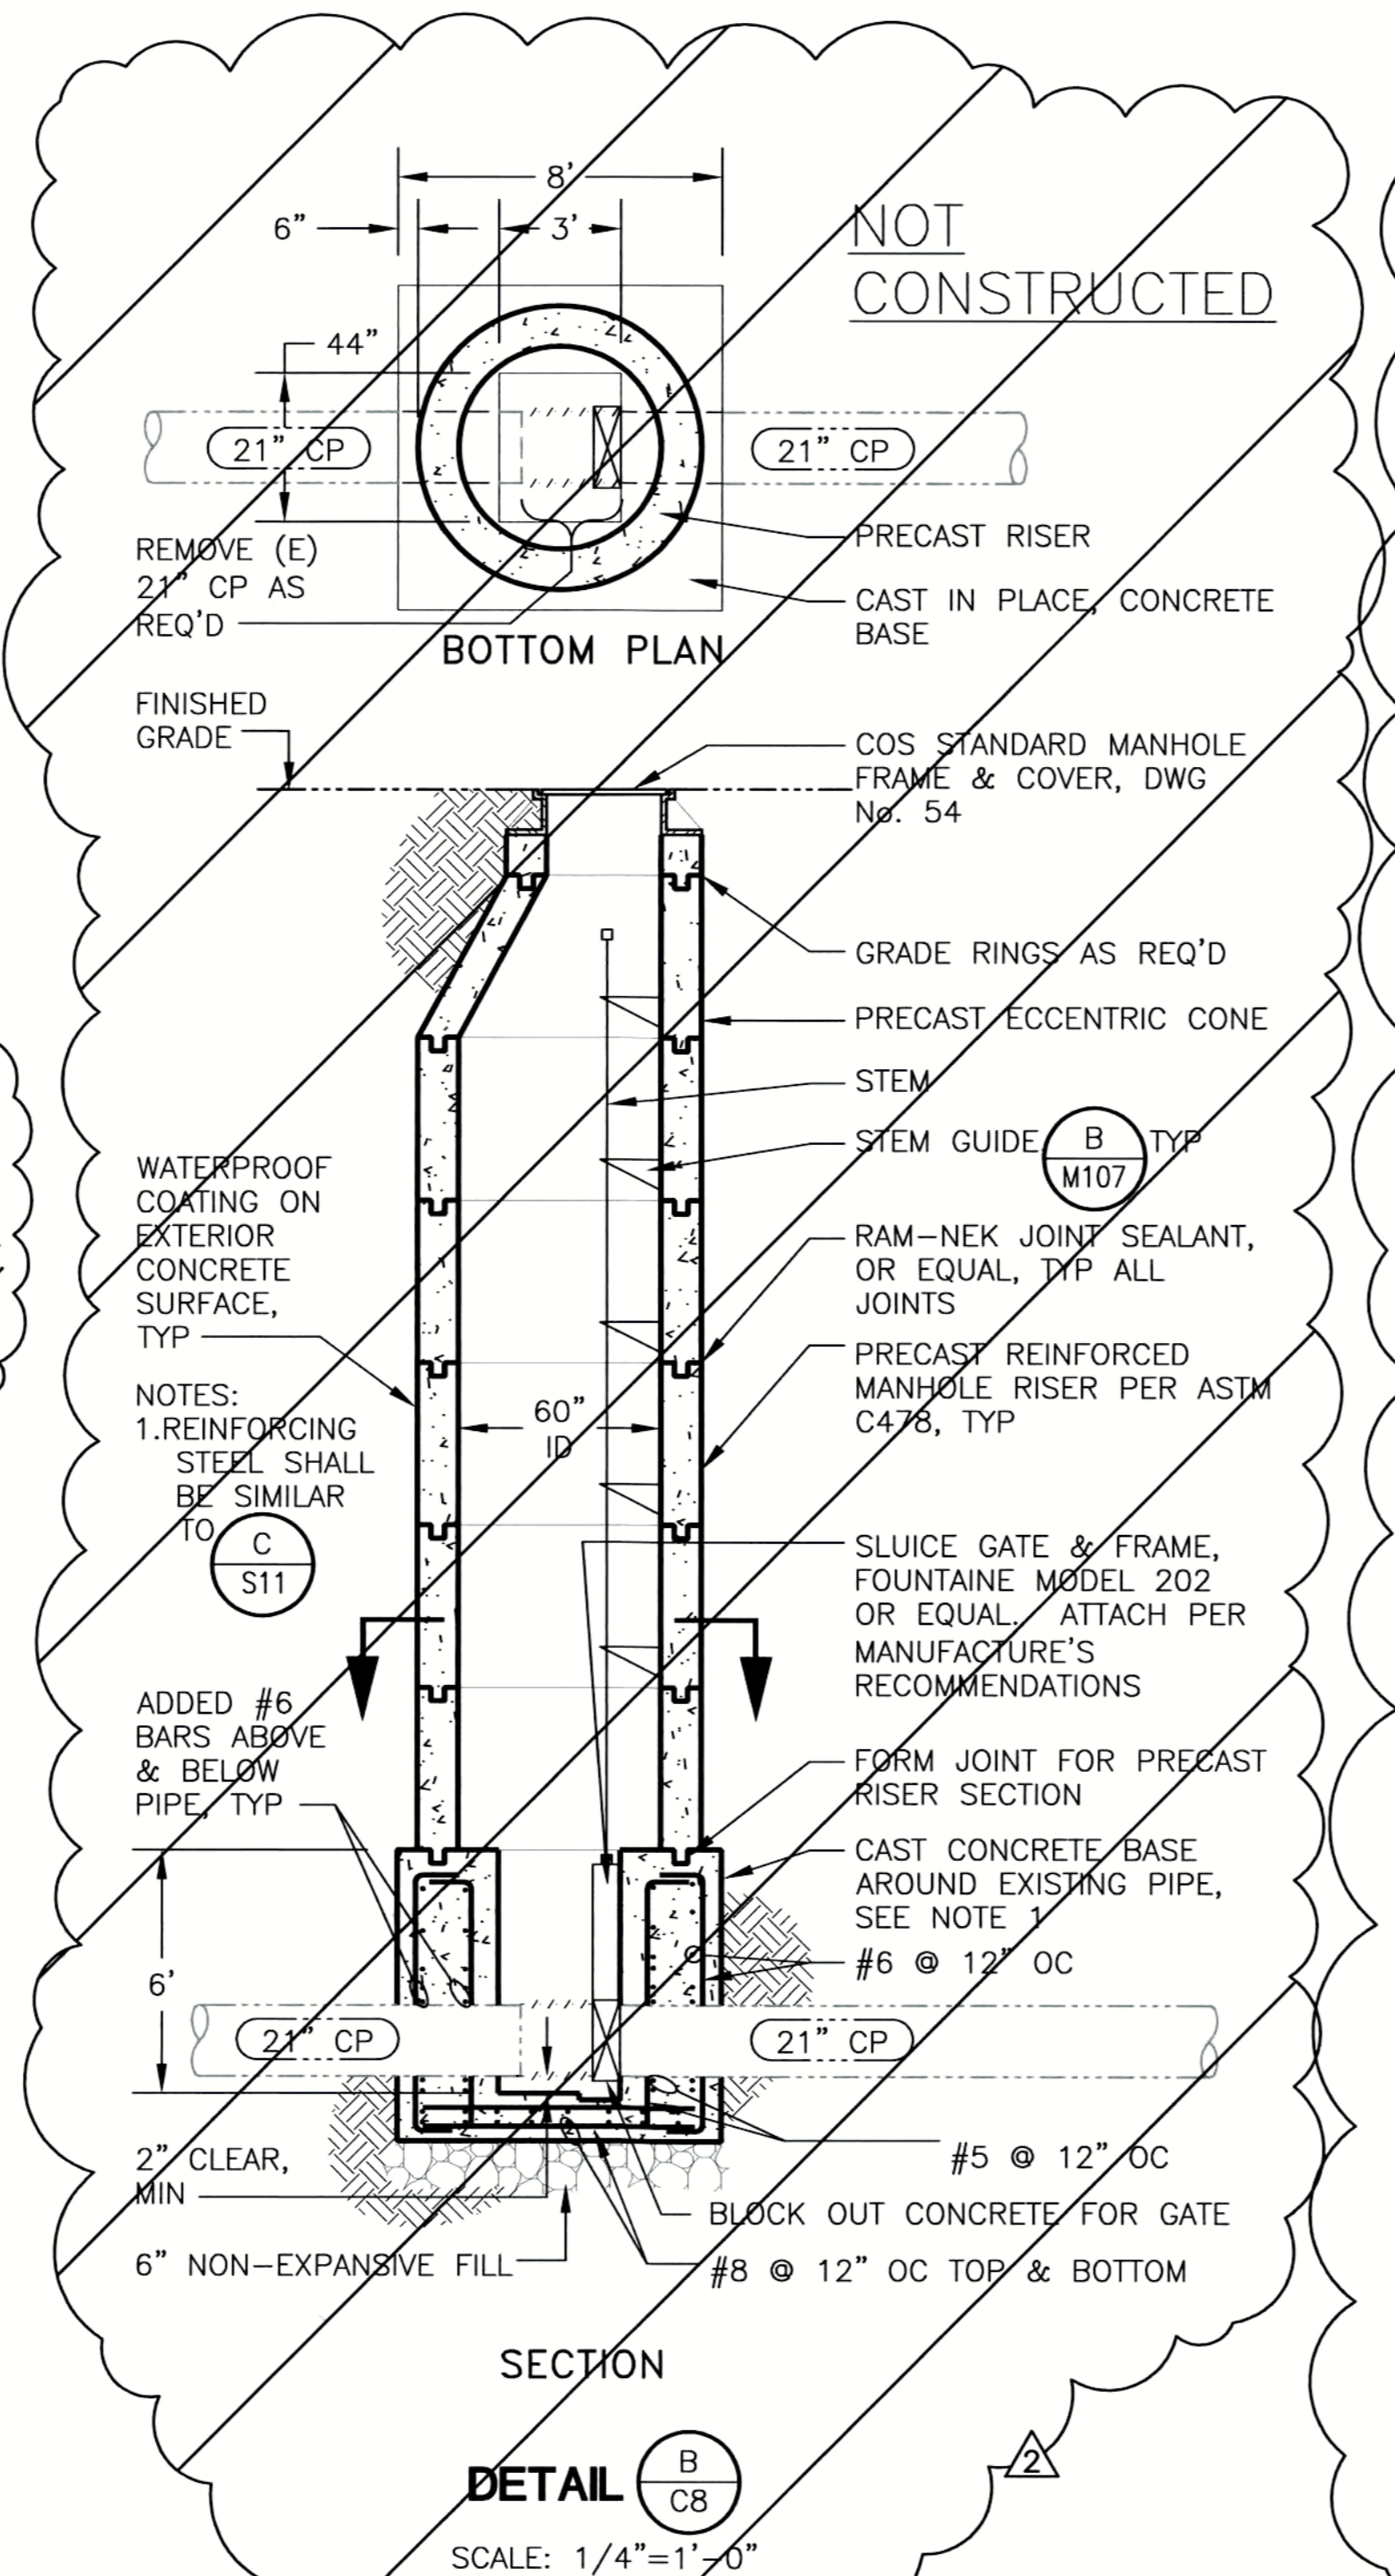

SECTION
DETAIL B
SCALE: 1/4"=1'-0"

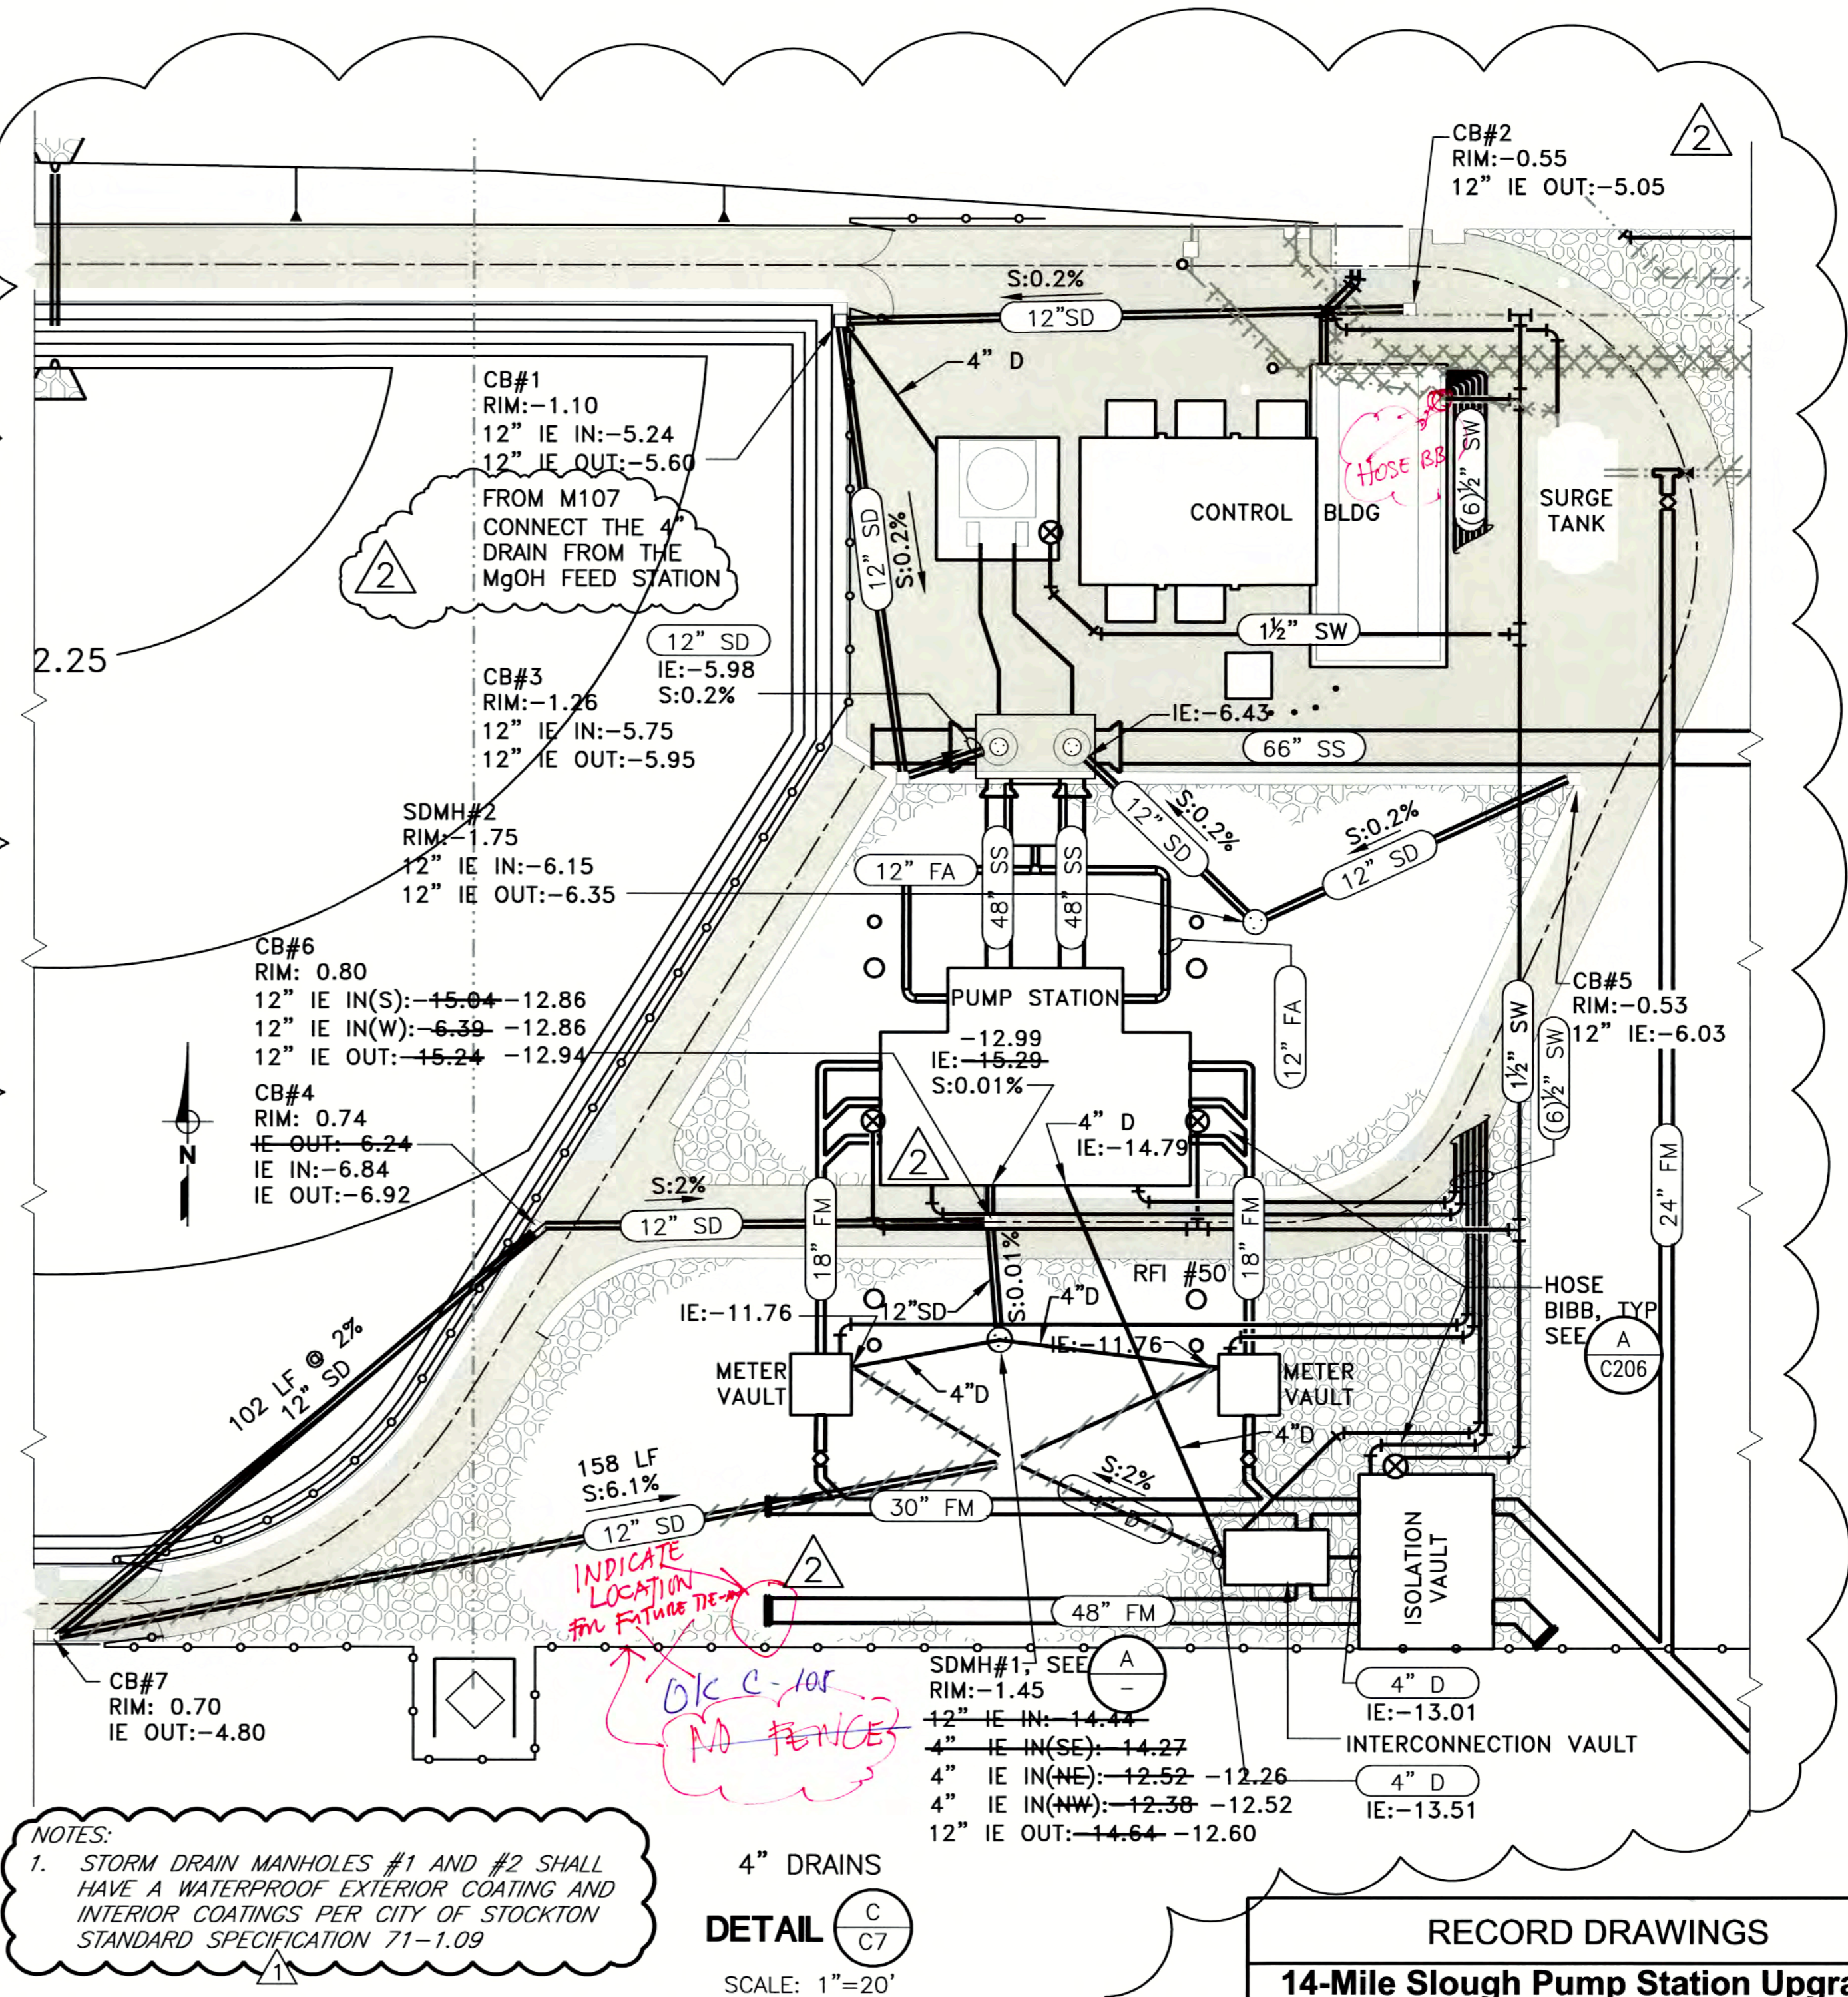

NOTES:
1. STORM DRAIN MANHOLES #1 AND #2 SHALL HAVE A WATERPROOF EXTERIOR COATING AND INTERIOR COATINGS PER CITY OF STOCKTON STANDARD SPECIFICATION 71-1.09

4" DRAINS
DETAIL C
SCALE: 1"=20'

M:\Clients\293\ Sponos\00-05-01 14-MSPS Upgrades\CAD Design\Utilities\293-0501\2007.dwg 11-13-08 09:54:01 AM ortimer

Underground Service Alert
TWO DAYS BEFORE YOU DIG
Call TOLL FREE: 1-800-642-2444

REFER TO BID SET FOR SIGNATURE

REV. No.	DISCRPTION	DATE	BY	Appr'd By
1	ADDENDUM No. 3	8/25/06	TTT	PDF
2	RECORD DRAWINGS	8/08	CLB	PDF
3				
4				
5				
6				
7				

WEST YOST ASSOCIATES
Consulting Engineers
1260 Lake Boulevard Suite 240 Davis, California 95616
(530) 756-5905 FAX (530) 756-5991

RECORD DRAWINGS
14-Mile Slough Pump Station Upgrades
CIVIL DETAILS 7


DEPARTMENT OF MUNICIPAL UTILITIES
CITY OF STOCKTON, CALIFORNIA

SCALE: AS SHOWN
DESIGNED BY: TTT
DRAWN BY: DTD
CHECKED BY: GDH
RECORD Dwg.:


APPROVED BY: DATE: _____
ASSISTANT DIRECTOR, DEPT. OF MUNICIPAL UTILITIES

SHEET No. **C207**
25 of 89 SHEETS
PROJECT No. 293-00-05-01

N:\Clients\293 - Sponosa\00-05-01 14-MSFS Upgrades\CAD\Design\Submittals\393-050\A3-1&2.dwg 11-13-08 09:58:24 AM gremmer

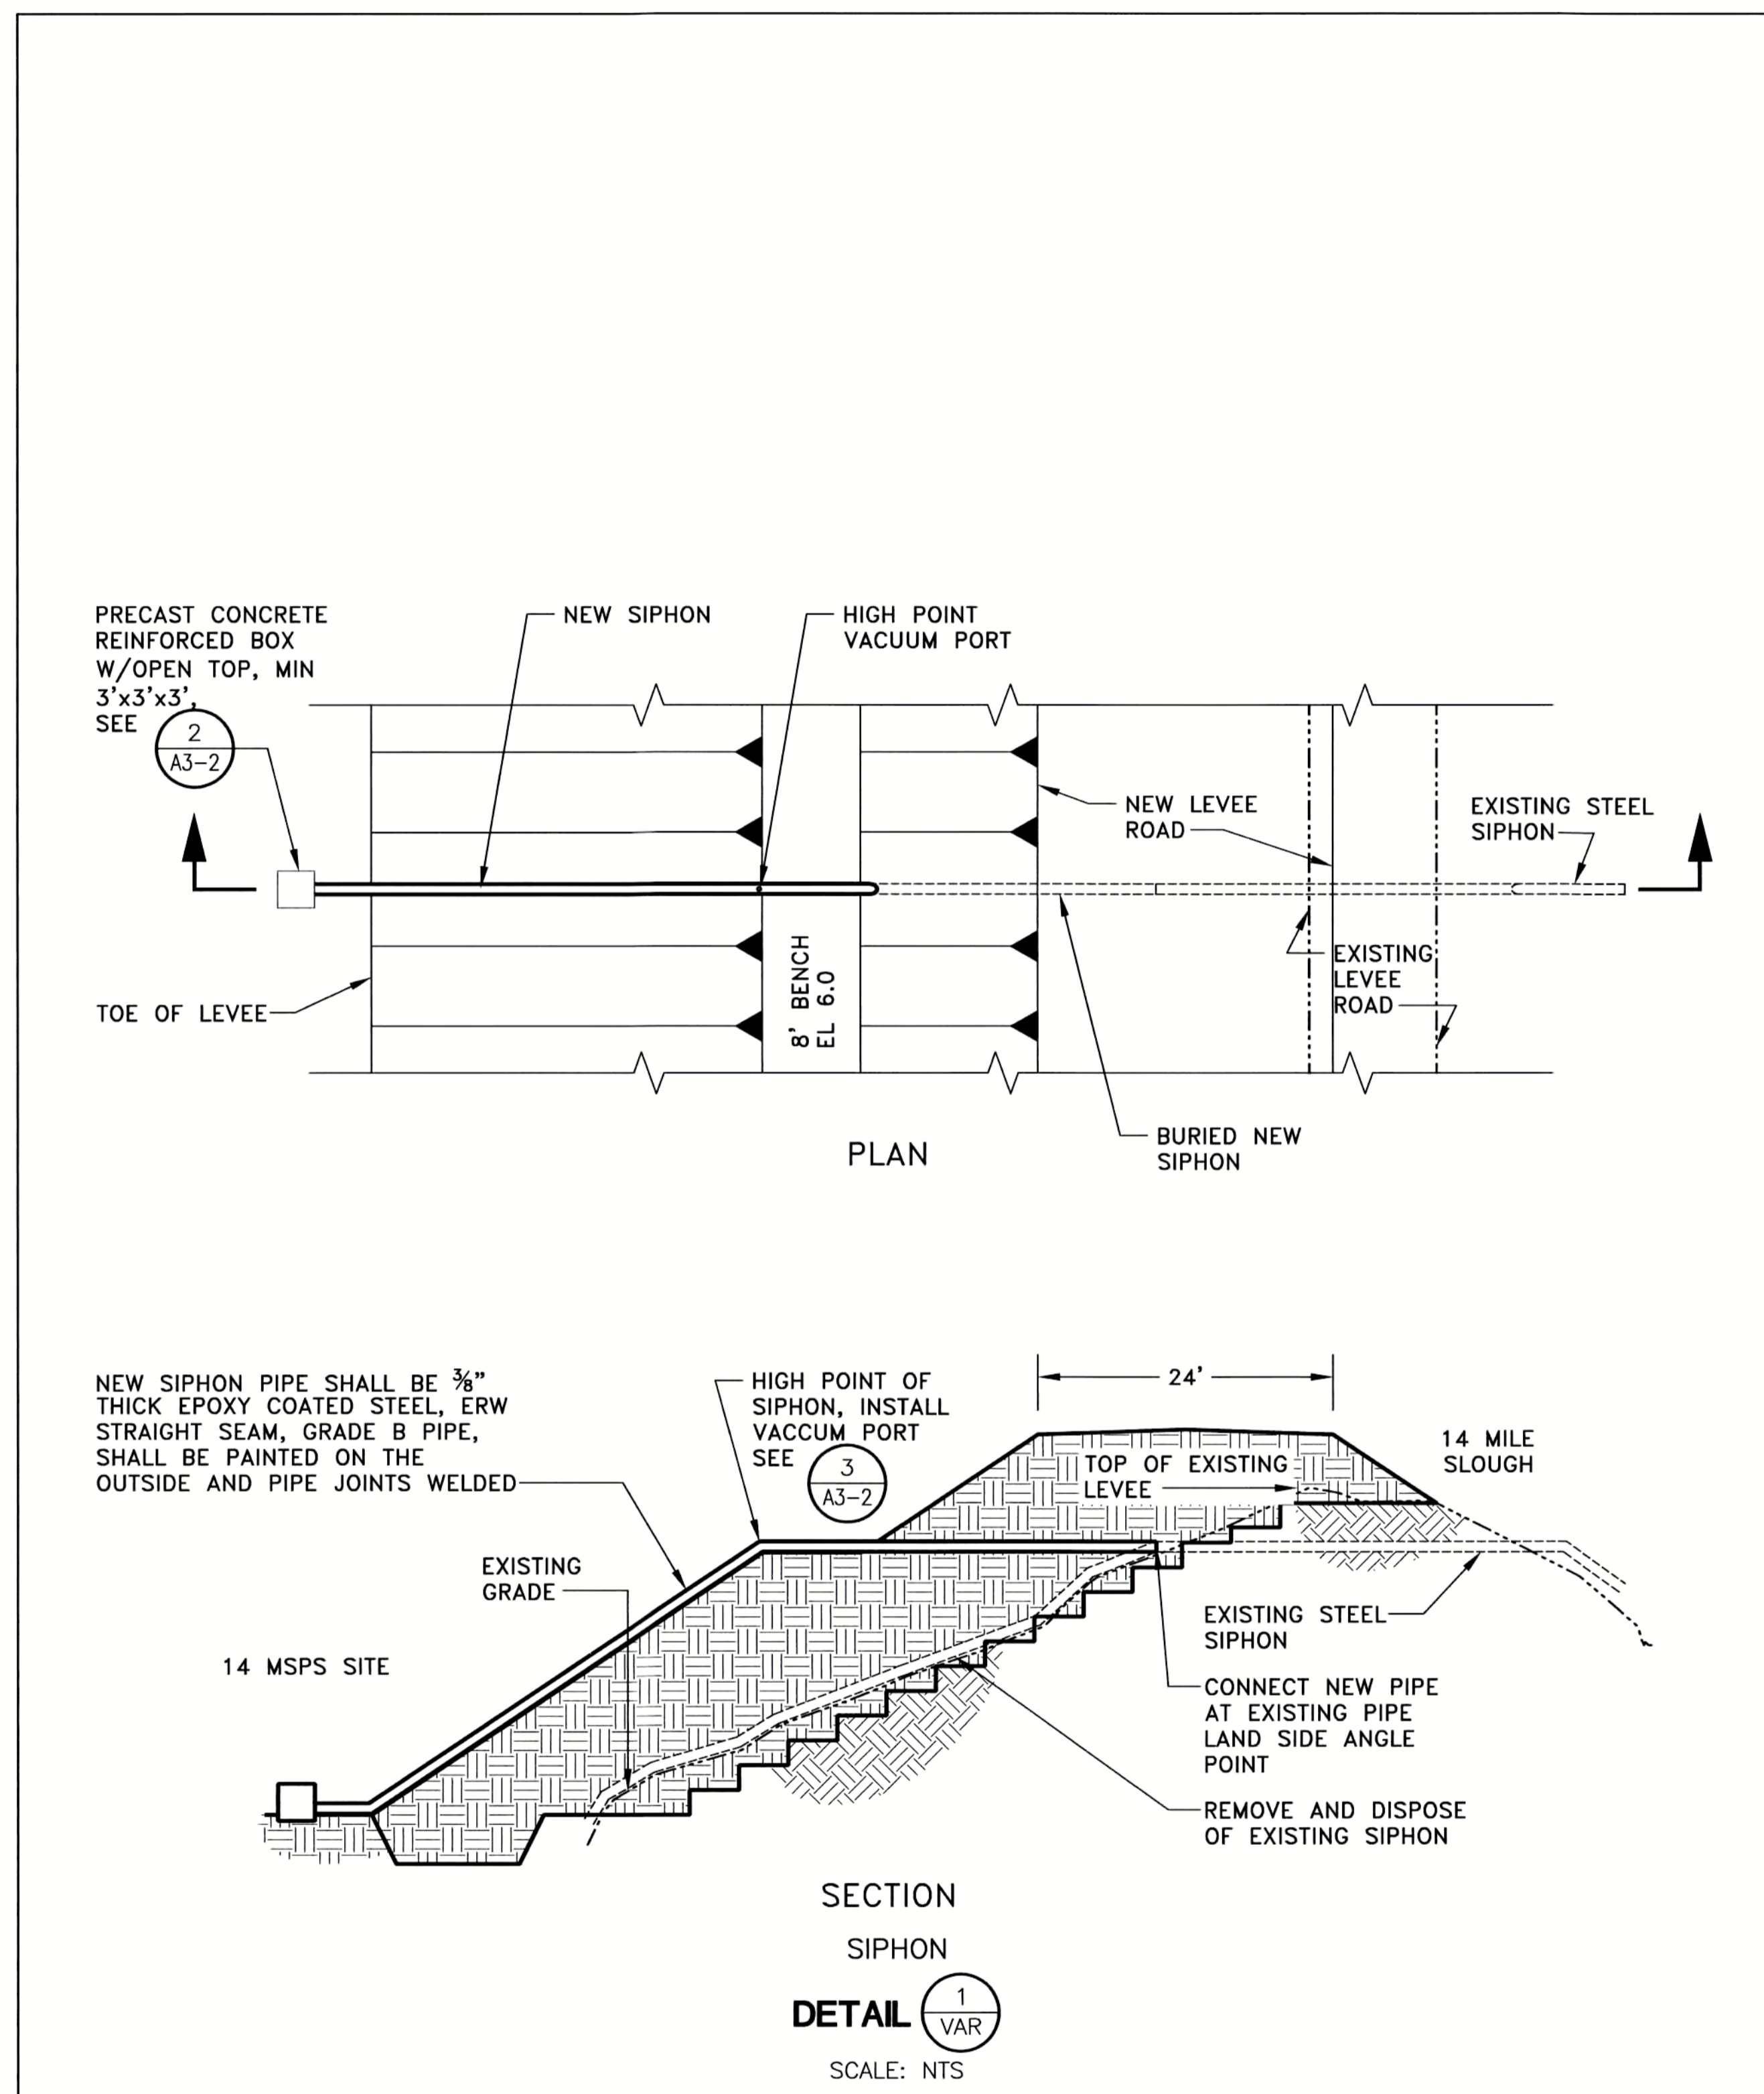


SKETCH A3-1

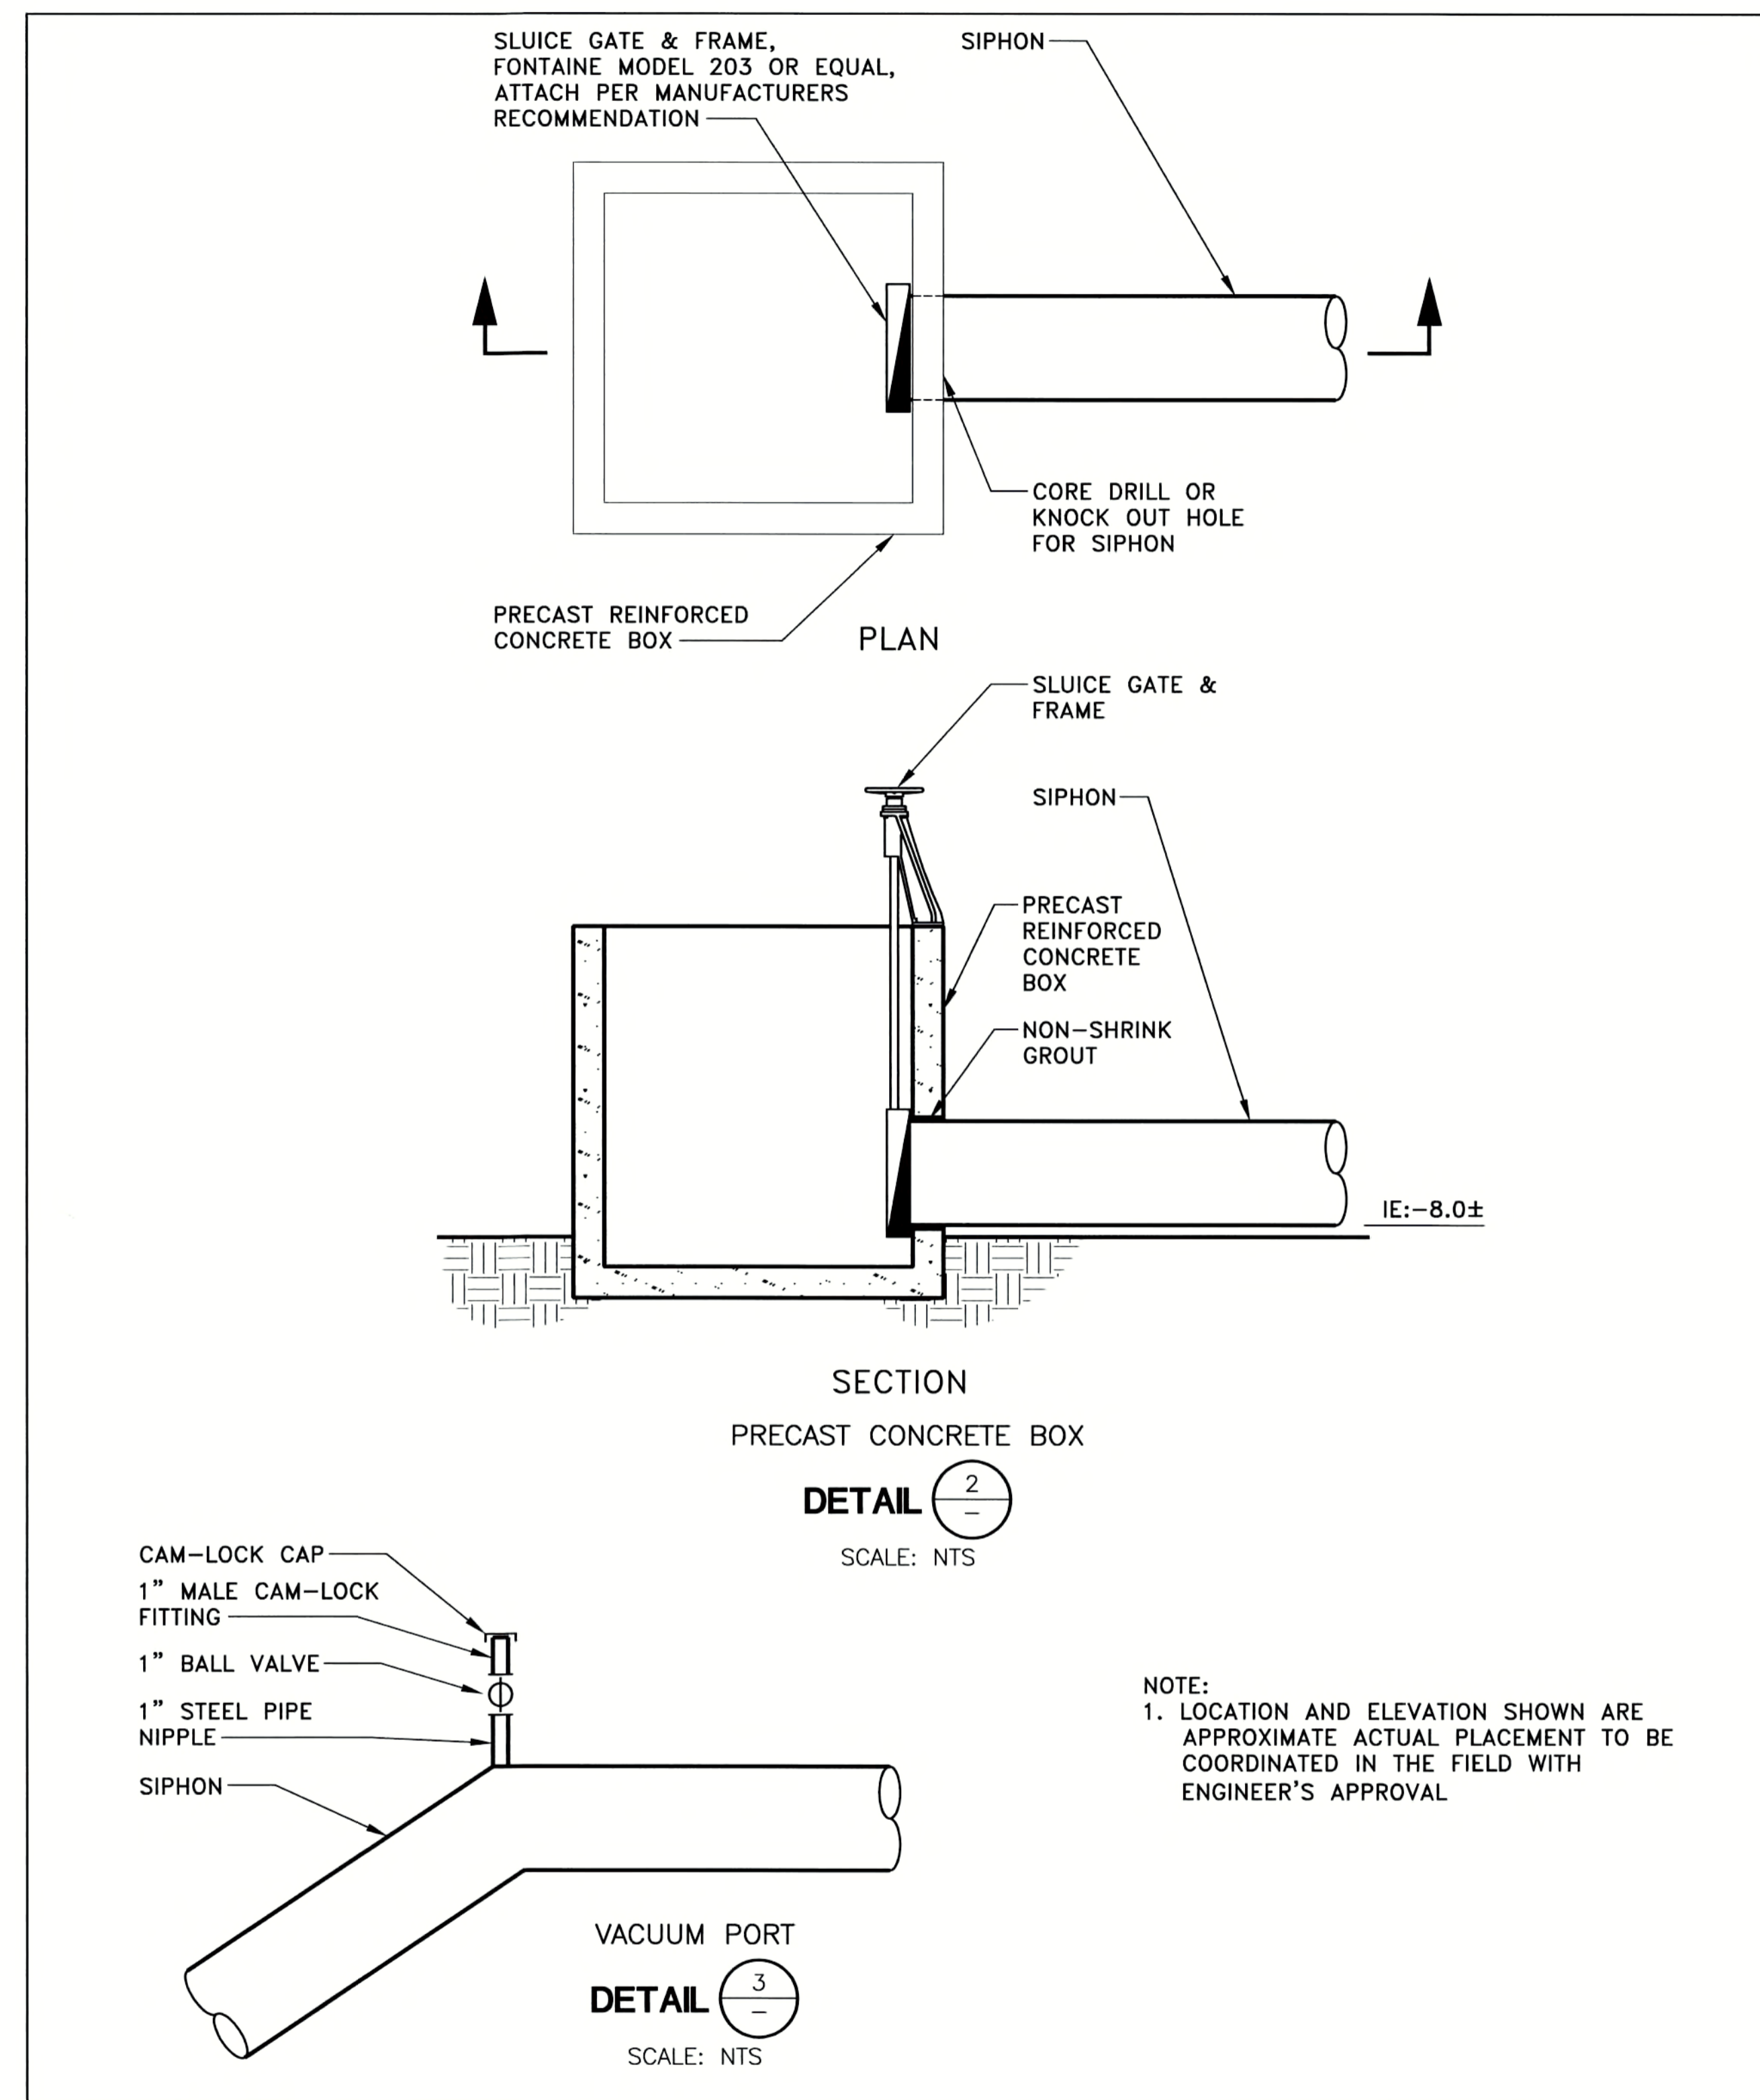

SKETCH A3-2


RECORD DRAWINGS		
14-Mile Slough Pump Station Upgrades		
ADDENDUM SKETCHES		
A3-1 & A3-2		
DEPARTMENT OF MUNICIPAL UTILITIES CITY OF STOCKTON, CALIFORNIA		
SCALE: AS SHOWN	APPROVED BY: DATE: _____	SHEET No. _____
DESIGNED BY: PDF/TTT		
DRAWN BY: RDB		26 of 89 SHEETS
CHECKED BY: GDH	ASSISTANT DIRECTOR, DEPT. OF MUNICIPAL UTILITIES	PROJECT No. 293-00-05-01
RECORD Dwg.:		

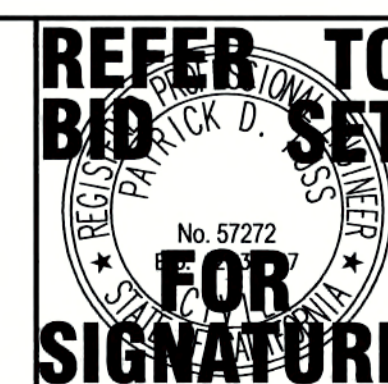

REV. No.	DISCRPTION	DATE	BY	Aprv'd By
1	ADDENDUM No. 3	5/25/08	TTT	PDF
2				
3				
4				
5				
6				
7				



1260 Lake Boulevard
Suite 240
Davis, California 95616
(530) 756-5905
FAX (530) 756-5991

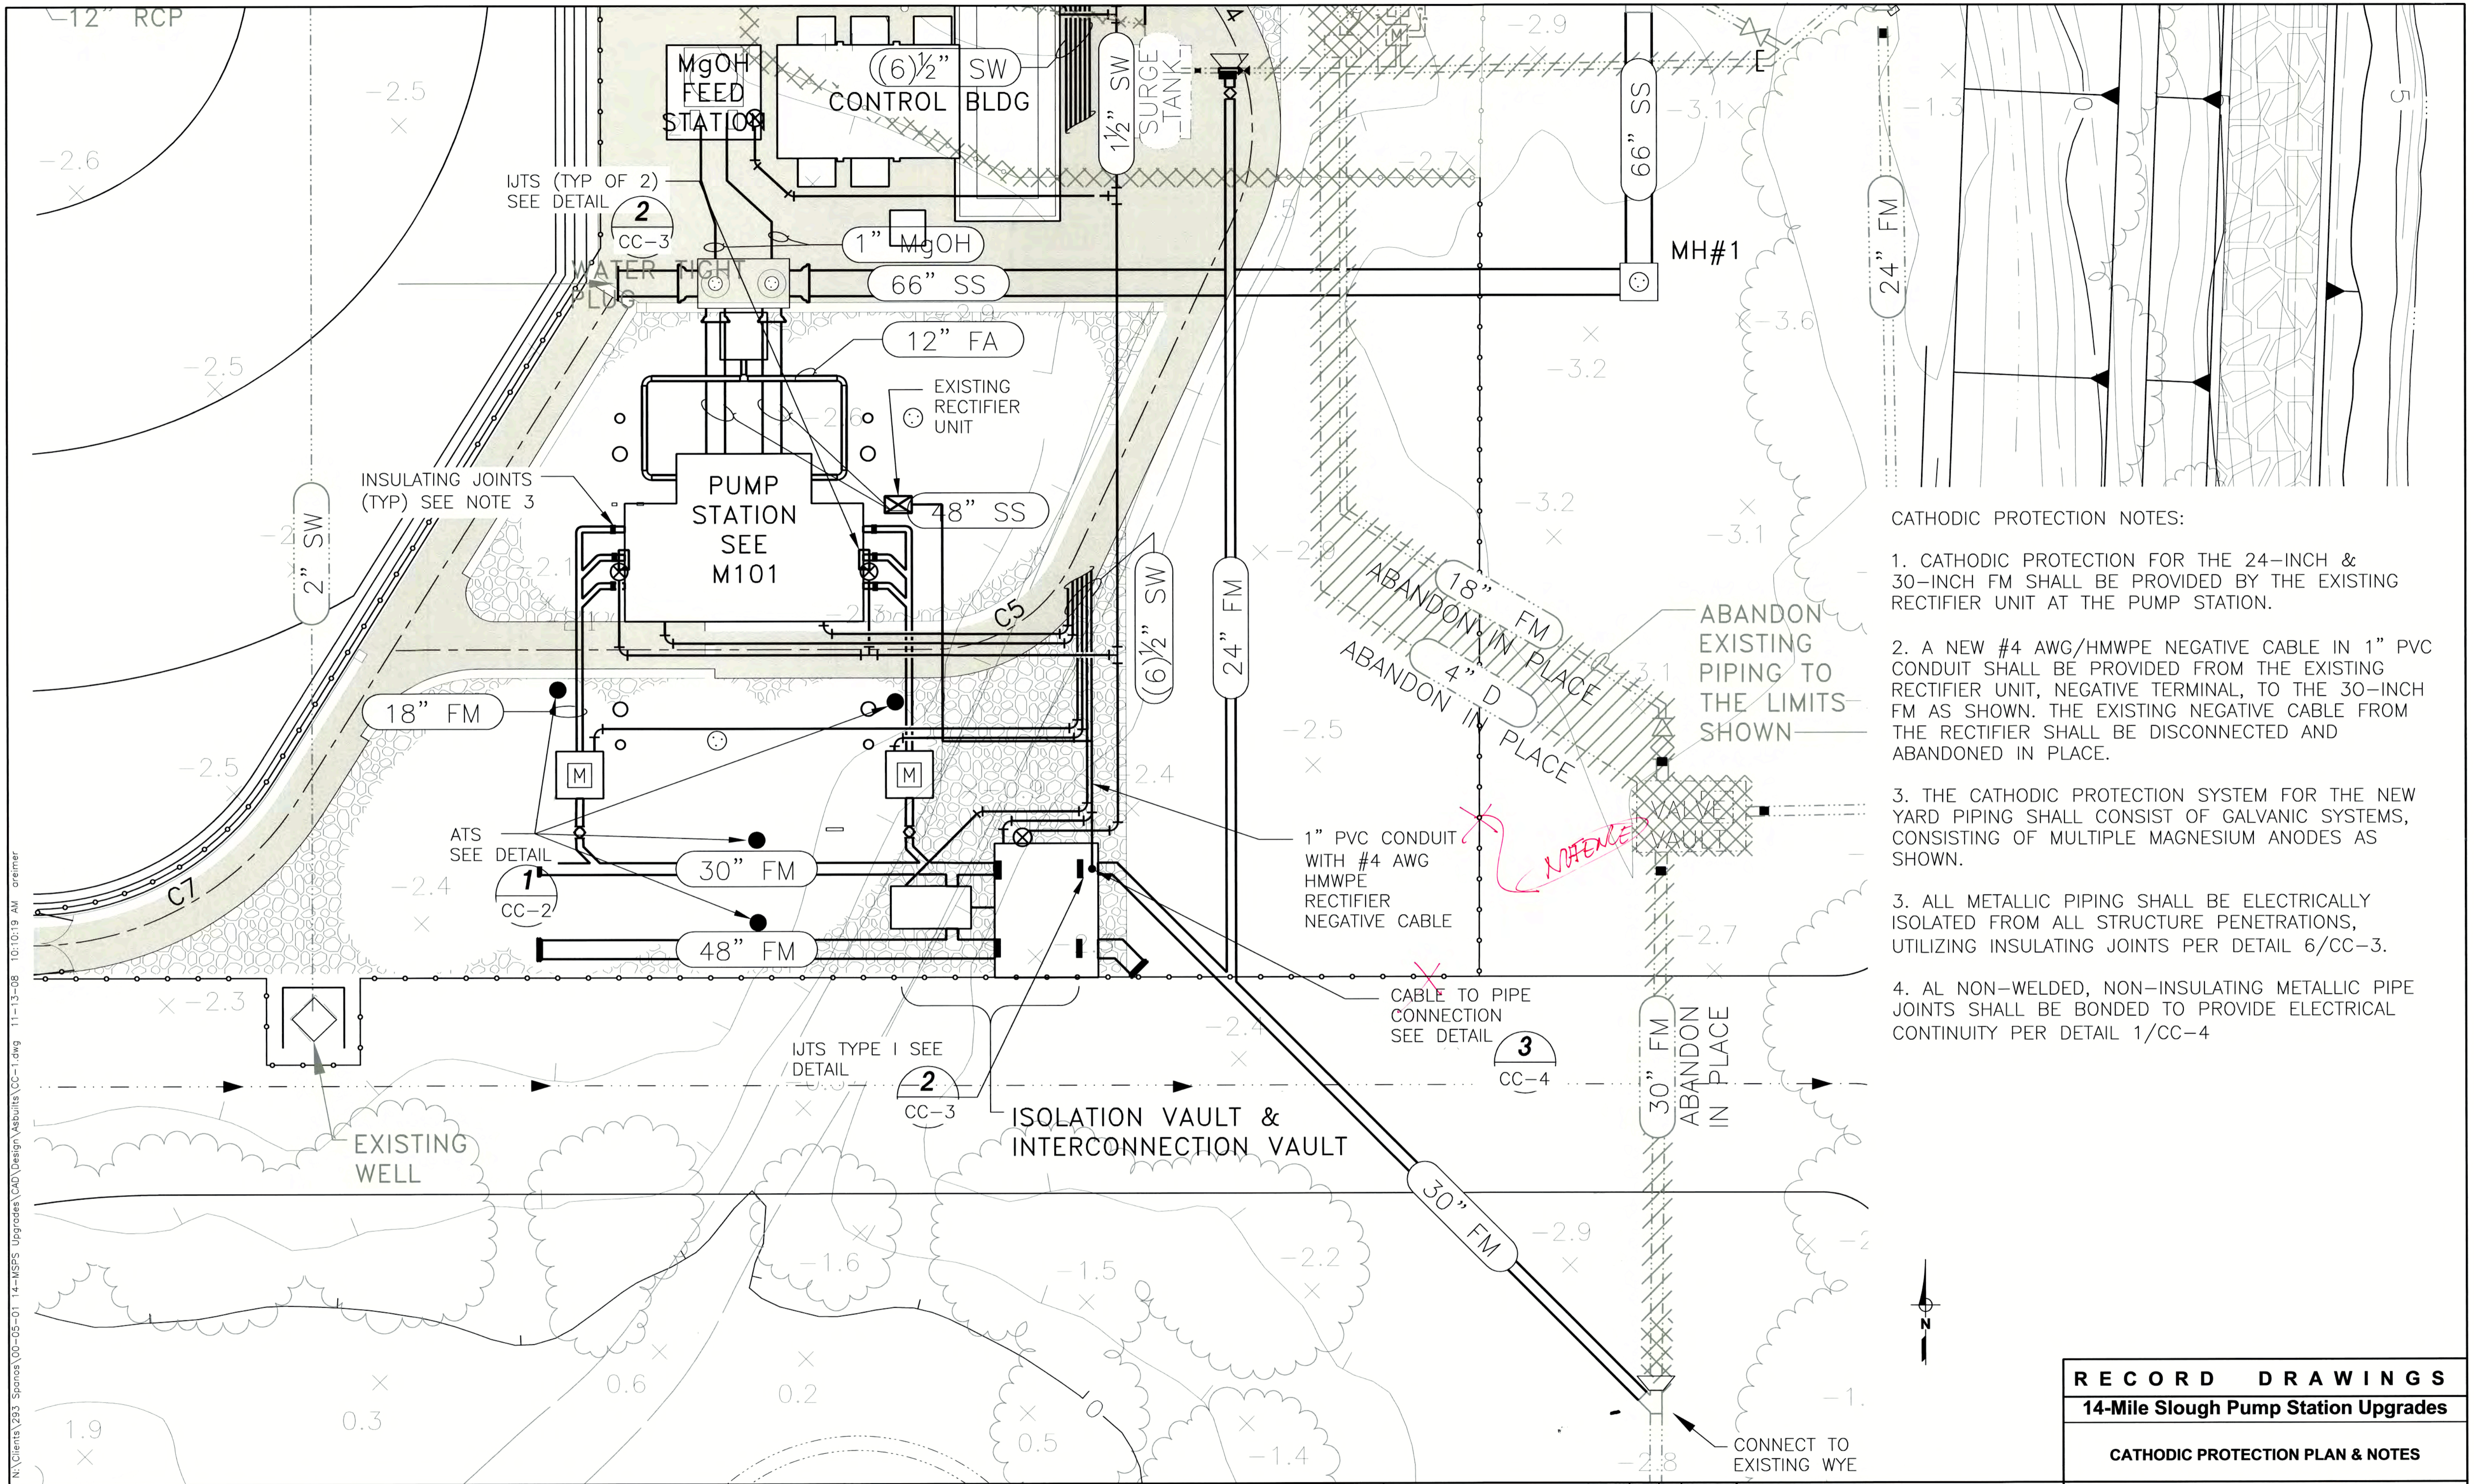

- CATHODIC PROTECTION NOTES:
1. CATHODIC PROTECTION FOR THE 24-INCH & 30-INCH FM SHALL BE PROVIDED BY THE EXISTING RECTIFIER UNIT AT THE PUMP STATION.
 2. A NEW #4 AWG/HMWPE NEGATIVE CABLE IN 1" PVC CONDUIT SHALL BE PROVIDED FROM THE EXISTING RECTIFIER UNIT, NEGATIVE TERMINAL, TO THE 30-INCH FM AS SHOWN. THE EXISTING NEGATIVE CABLE FROM THE RECTIFIER SHALL BE DISCONNECTED AND ABANDONED IN PLACE.
 3. THE CATHODIC PROTECTION SYSTEM FOR THE NEW YARD PIPING SHALL CONSIST OF GALVANIC SYSTEMS, CONSISTING OF MULTIPLE MAGNESIUM ANODES AS SHOWN.
 3. ALL METALLIC PIPING SHALL BE ELECTRICALLY ISOLATED FROM ALL STRUCTURE PENETRATIONS, UTILIZING INSULATING JOINTS PER DETAIL 6/CC-3.
 4. ALL NON-WELDED, NON-INSULATING METALLIC PIPE JOINTS SHALL BE BONDED TO PROVIDE ELECTRICAL CONTINUITY PER DETAIL 1/CC-4


N:\Clients\293_Sponos\00-05-01_14-Mile Slough Pump Station Upgrades\CAD\Design\Asbuilt\CC-1.dwg 11-13-08 10:10:19 AM oreimer

RECORD DRAWINGS
14-Mile Slough Pump Station Upgrades
CATHODIC PROTECTION PLAN & NOTES

DEPARTMENT OF MUNICIPAL UTILITIES CITY OF STOCKTON, CALIFORNIA		
SCALE: 1"=30'	APPROVED BY: DATE:	SHEET No. CC-1
DESIGNED BY:	DRAWN BY: DTD	27 of 89 SHEETS
CHECKED BY:	ASSISTANT DIRECTOR, DEPT. OF MUNICIPAL UTILITIES	PROJECT No. 293-00-05-01
RECORD DWG.:		

Underground Service Alert


 TWO DAYS BEFORE YOU DIG
 Call TOLL FREE: 1-800-642-2444


DH Corrosion Consultants
 Incorporated

REFER TO BID SET FOR SIGNATURE


REV. No.	DISCRPTION	DATE	BY	Apr'd By
1				
2				
3				
4				
5				
6				
7				


WEST YOST & ASSOCIATES
 Consulting Engineers
 1260 Lake Boulevard, Suite 240
 Davis, California 95616
 (530) 756-5905
 FAX (530) 756-5991

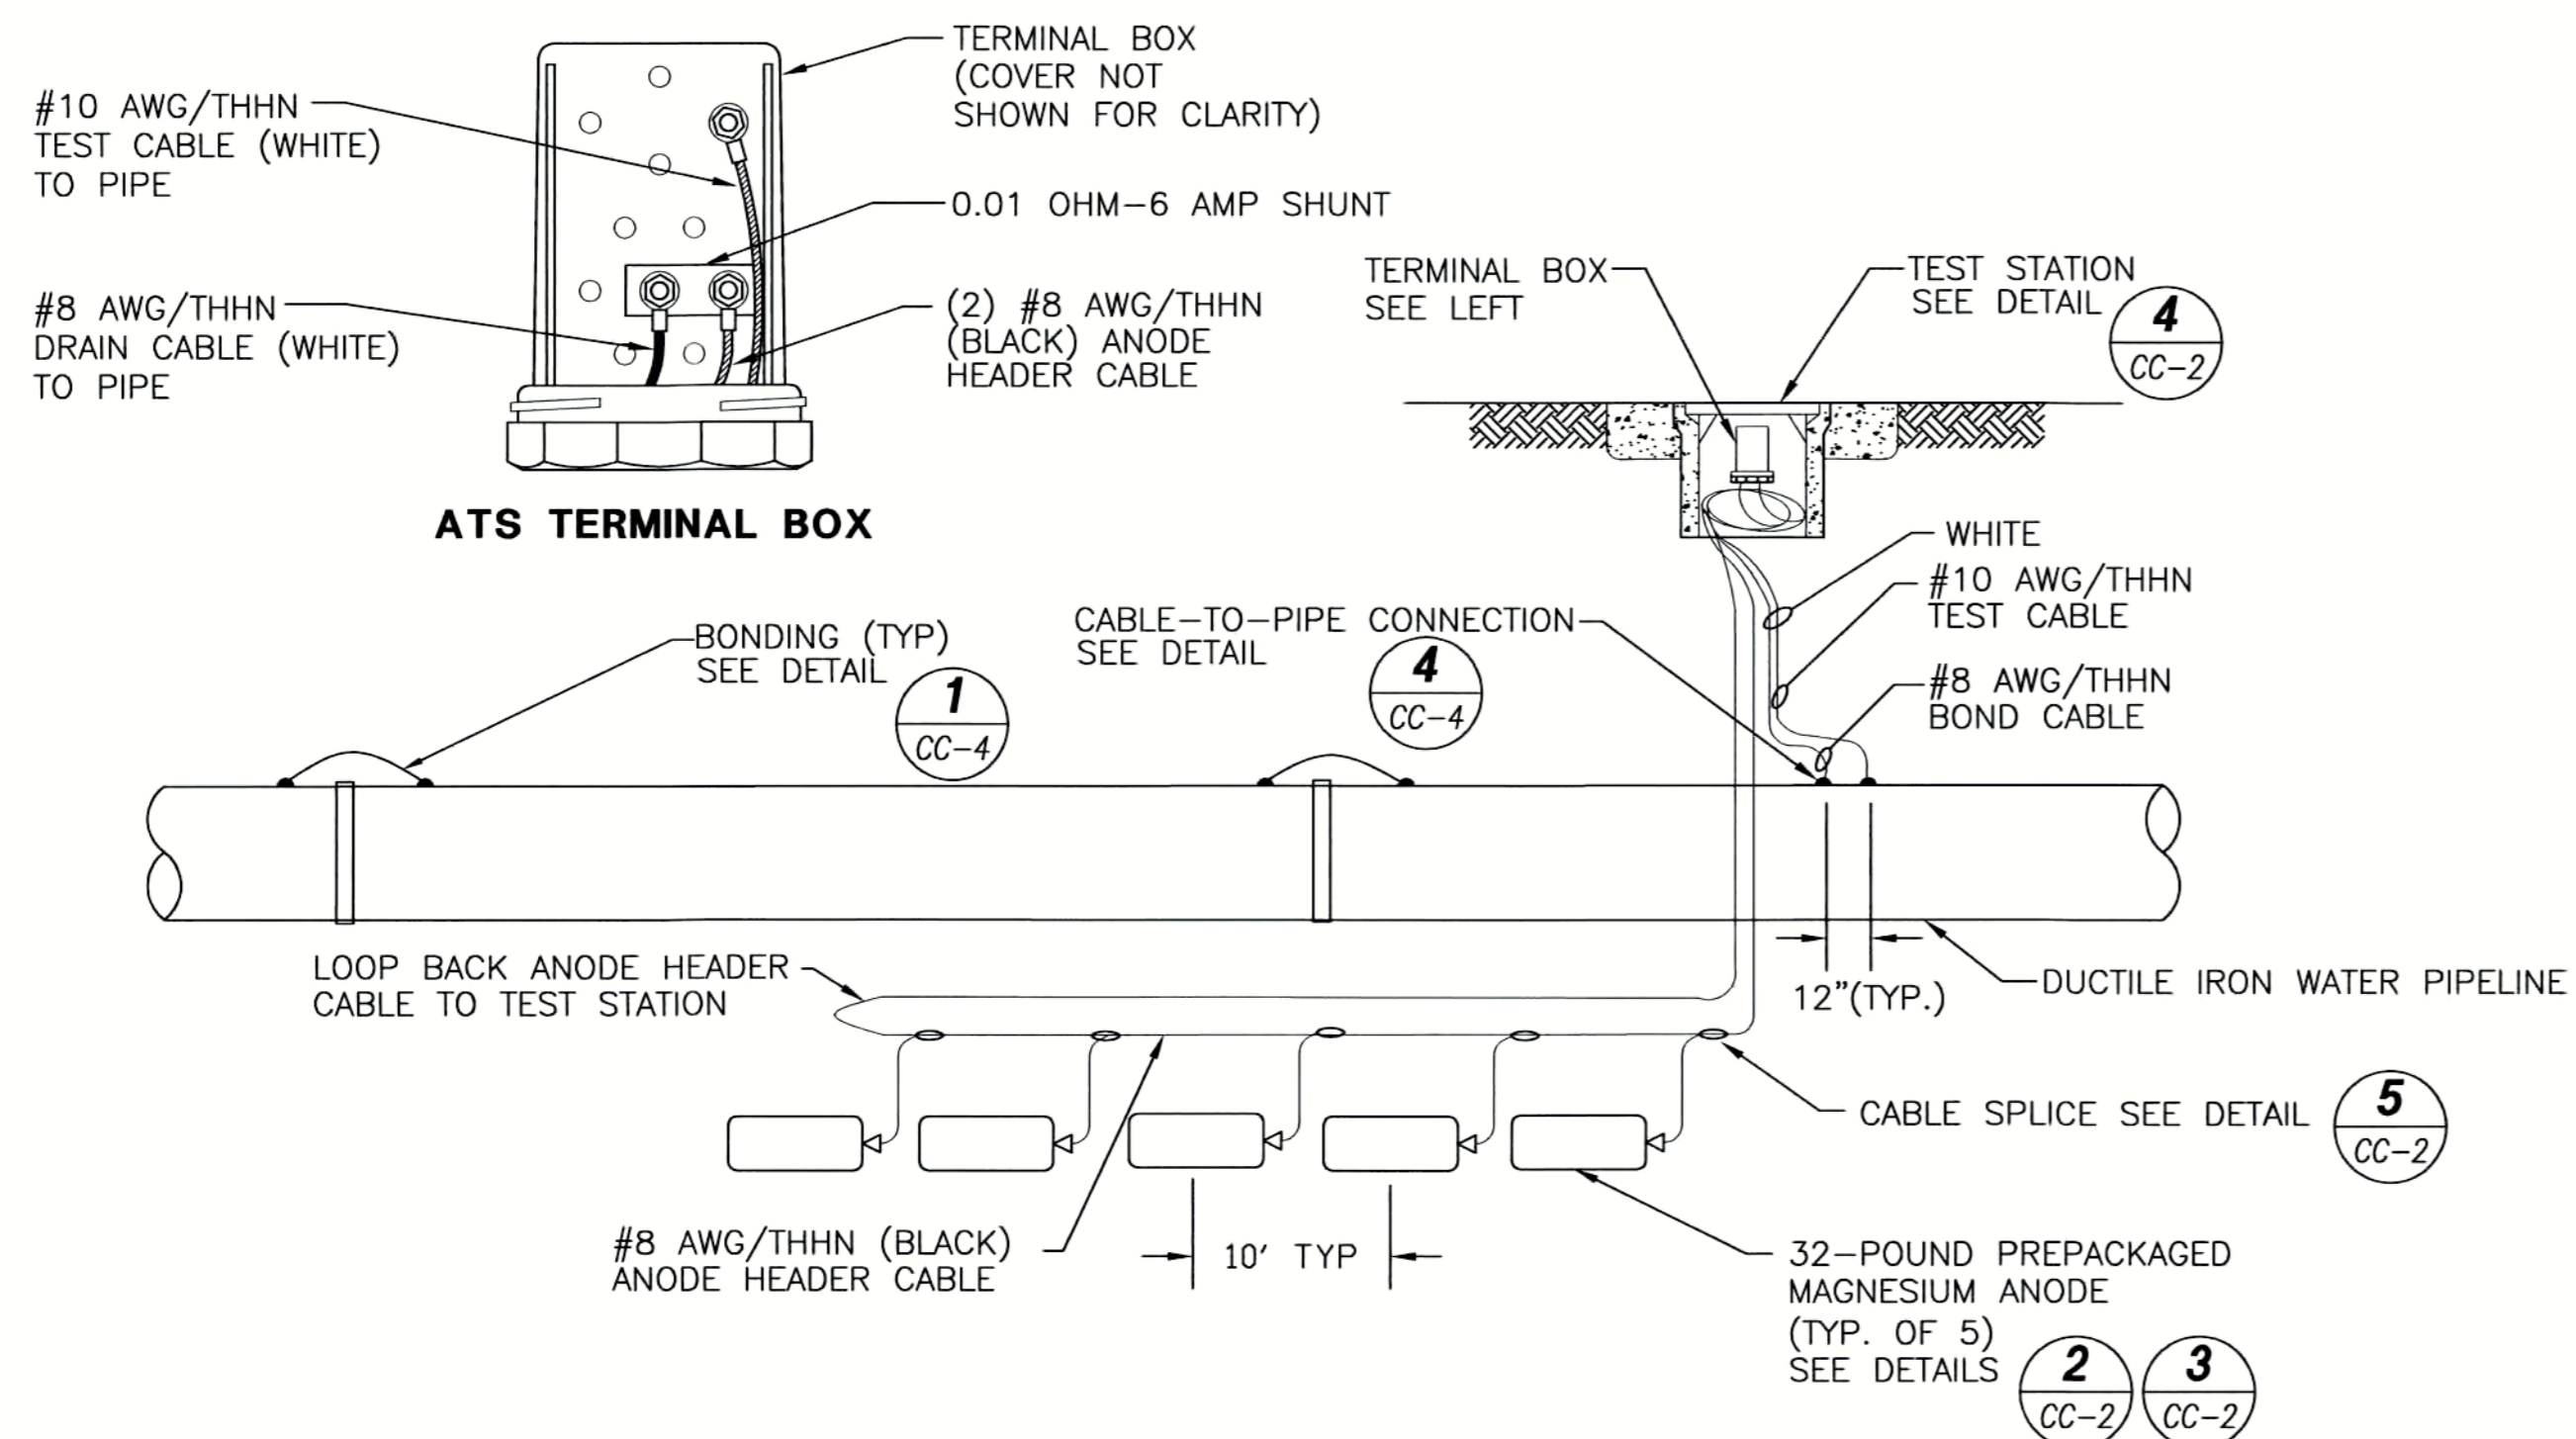

NOTES:

1. INSTALL 5, 32-POUND HIGH POTENTIAL MAGNESIUM ANODES AT EACH ANODE TEST STATION (ATS).
2. THE ANODES SHALL BE INSTALLED A MINIMUM OF 5 FT. OFF THE CENTERLINE OF THE WATER PIPELINE.
3. IDENTIFY ALL CABLES PER DETAIL 5, SHEET CC-4.


1 **ATS - ANODE TEST STATION ON DI PIPE**
CC-2 NOT TO SCALE

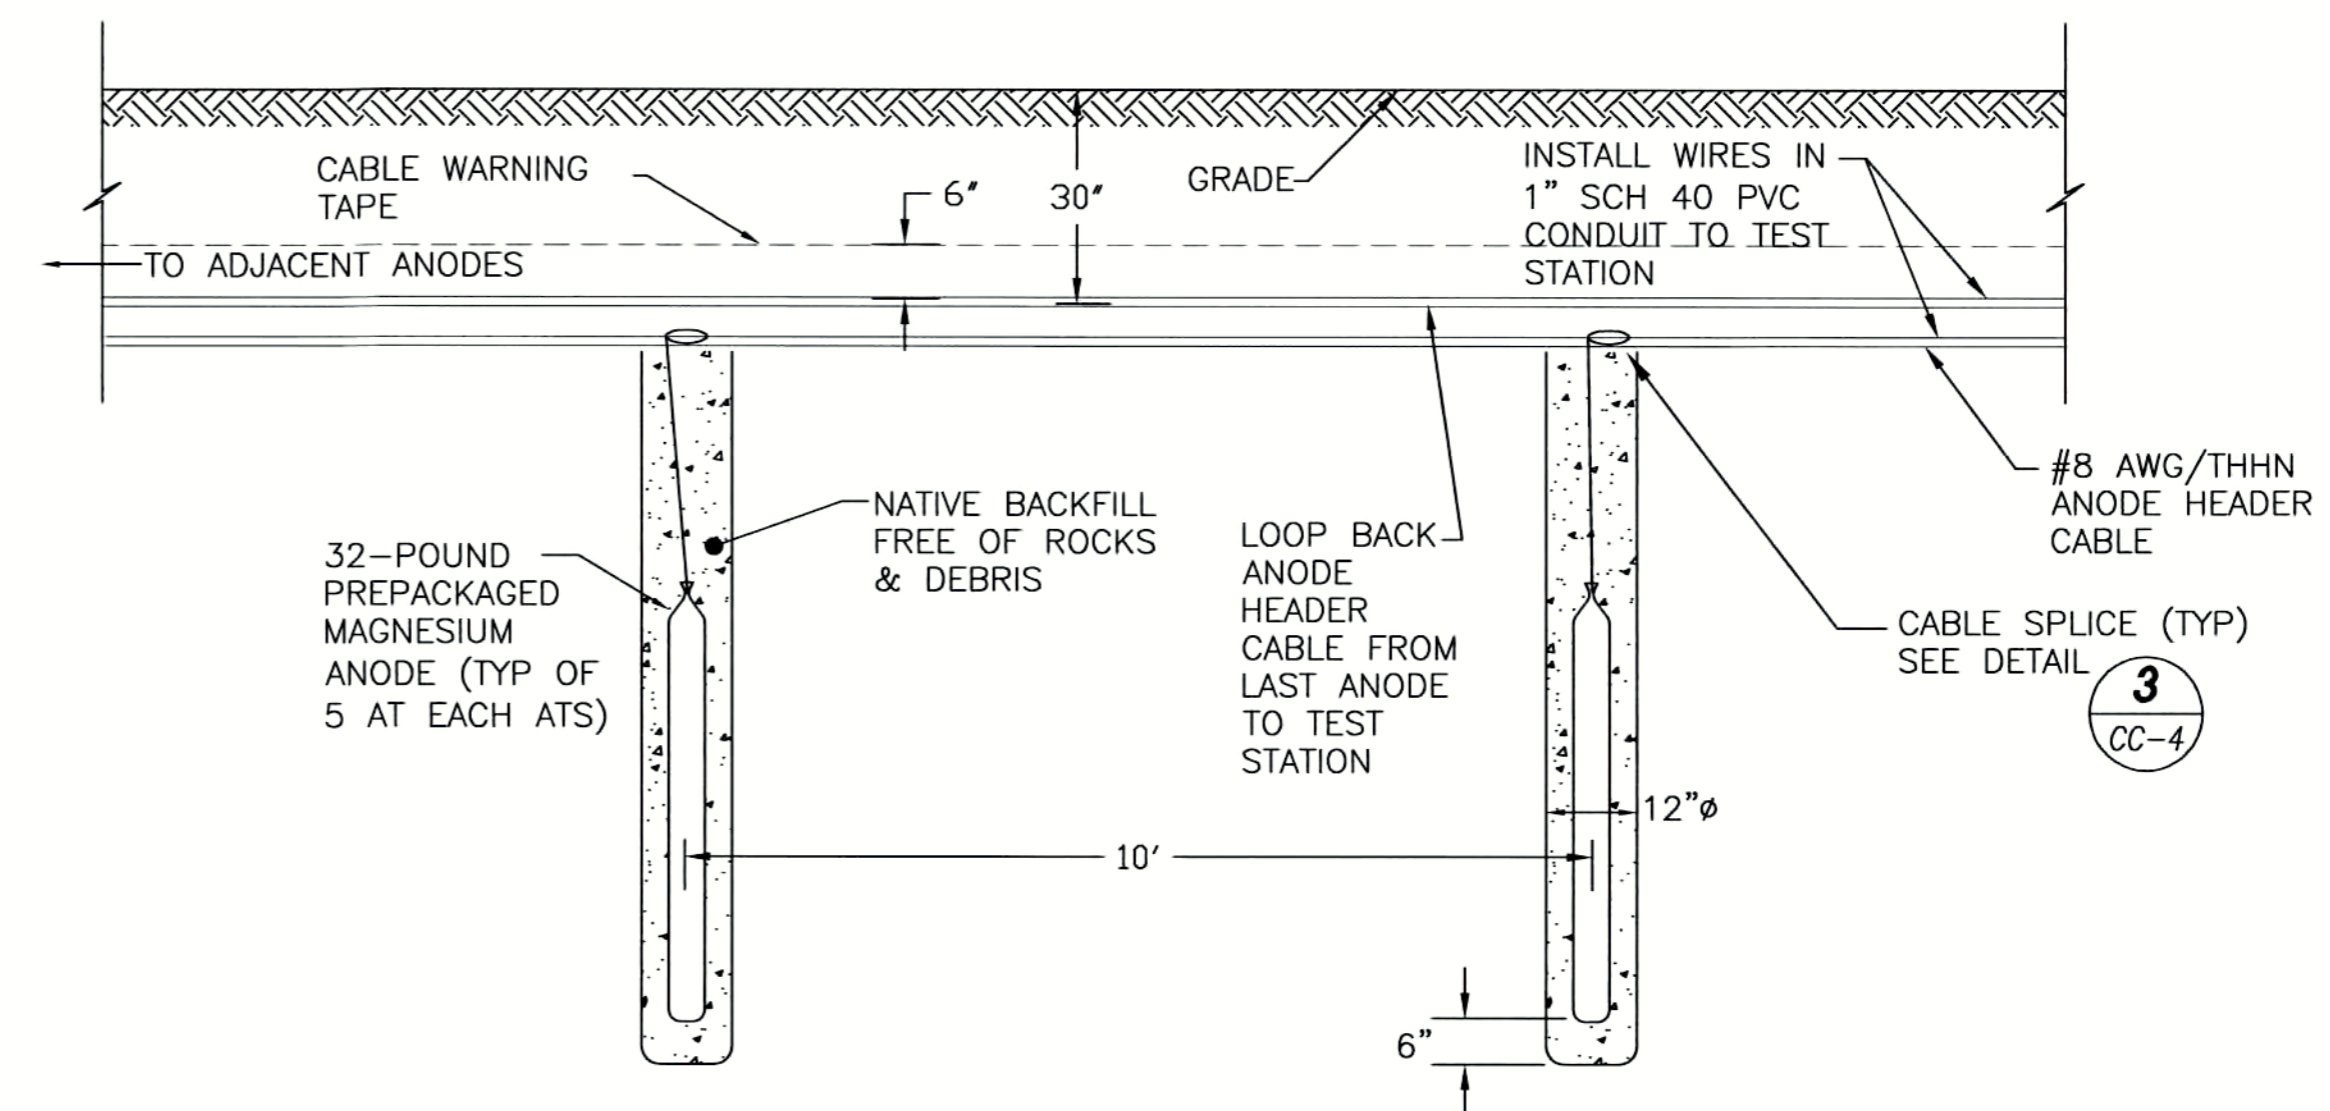

NOTES:

1. INSTALL ANODES PARALLEL TO THE PIPELINE AND 5 FT. OFF THE PIPE.
2. THE ANODES MAY BE INSTALLED HORIZONTALLY OR VERTICALLY UPON DISCRETION OF THE CONTRACTOR


2 **PROFILE - VERTICAL ANODE INSTALLATION**
CC-2 NOT TO SCALE

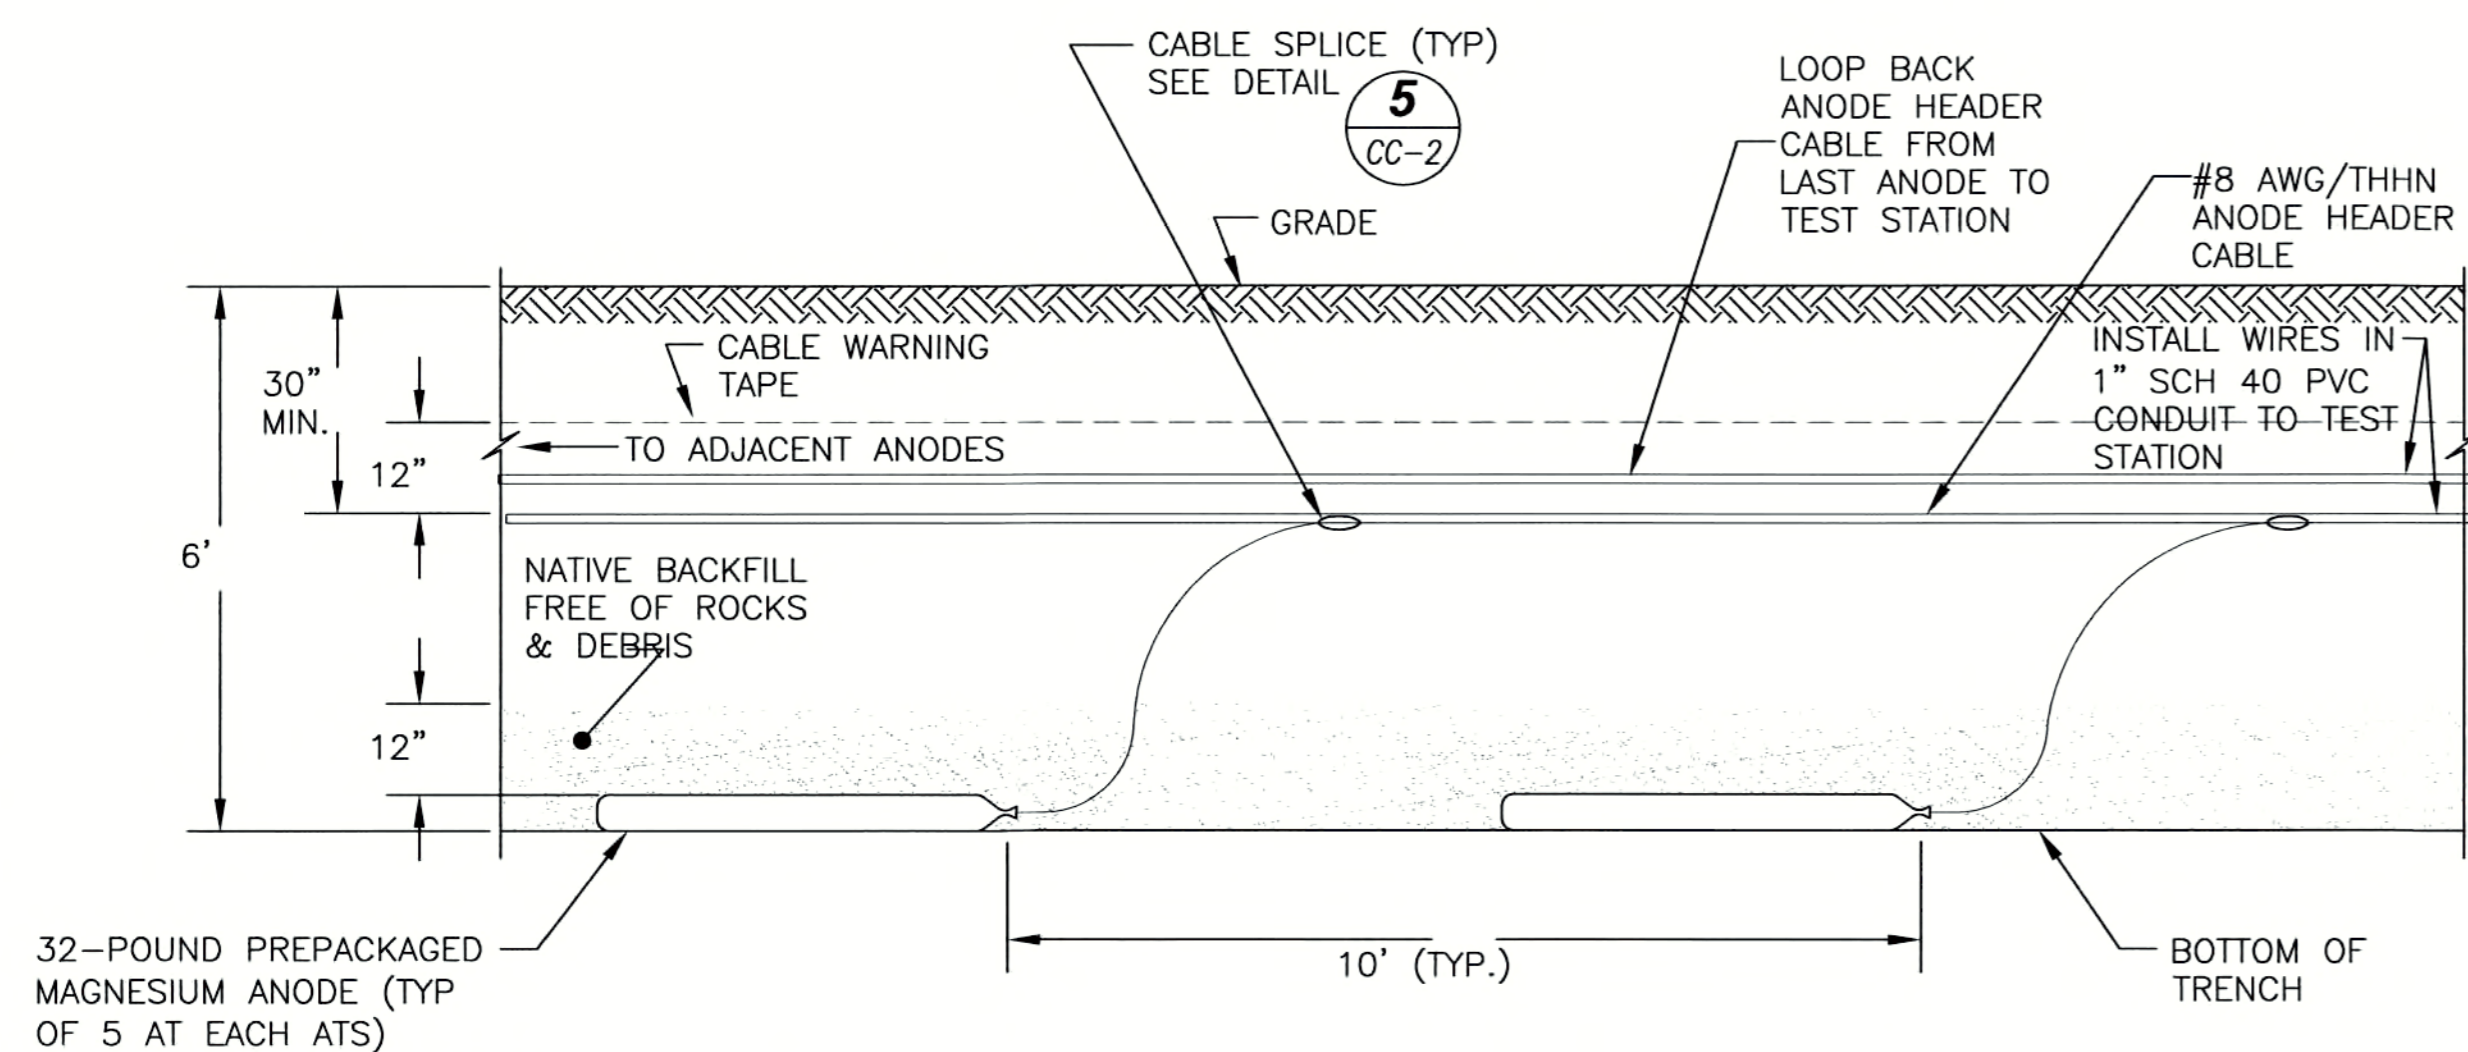

NOTES:

1. INSTALL ANODES PARALLEL TO THE PIPELINE AND 5 FT. OFF THE PIPE.
2. THE ANODES MAY BE INSTALLED HORIZONTALLY OR VERTICALLY UPON DISCRETION OF THE CONTRACTOR


3 **PROFILE - HORIZONTAL ANODE INSTALLATION**
CC-2 NOT TO SCALE

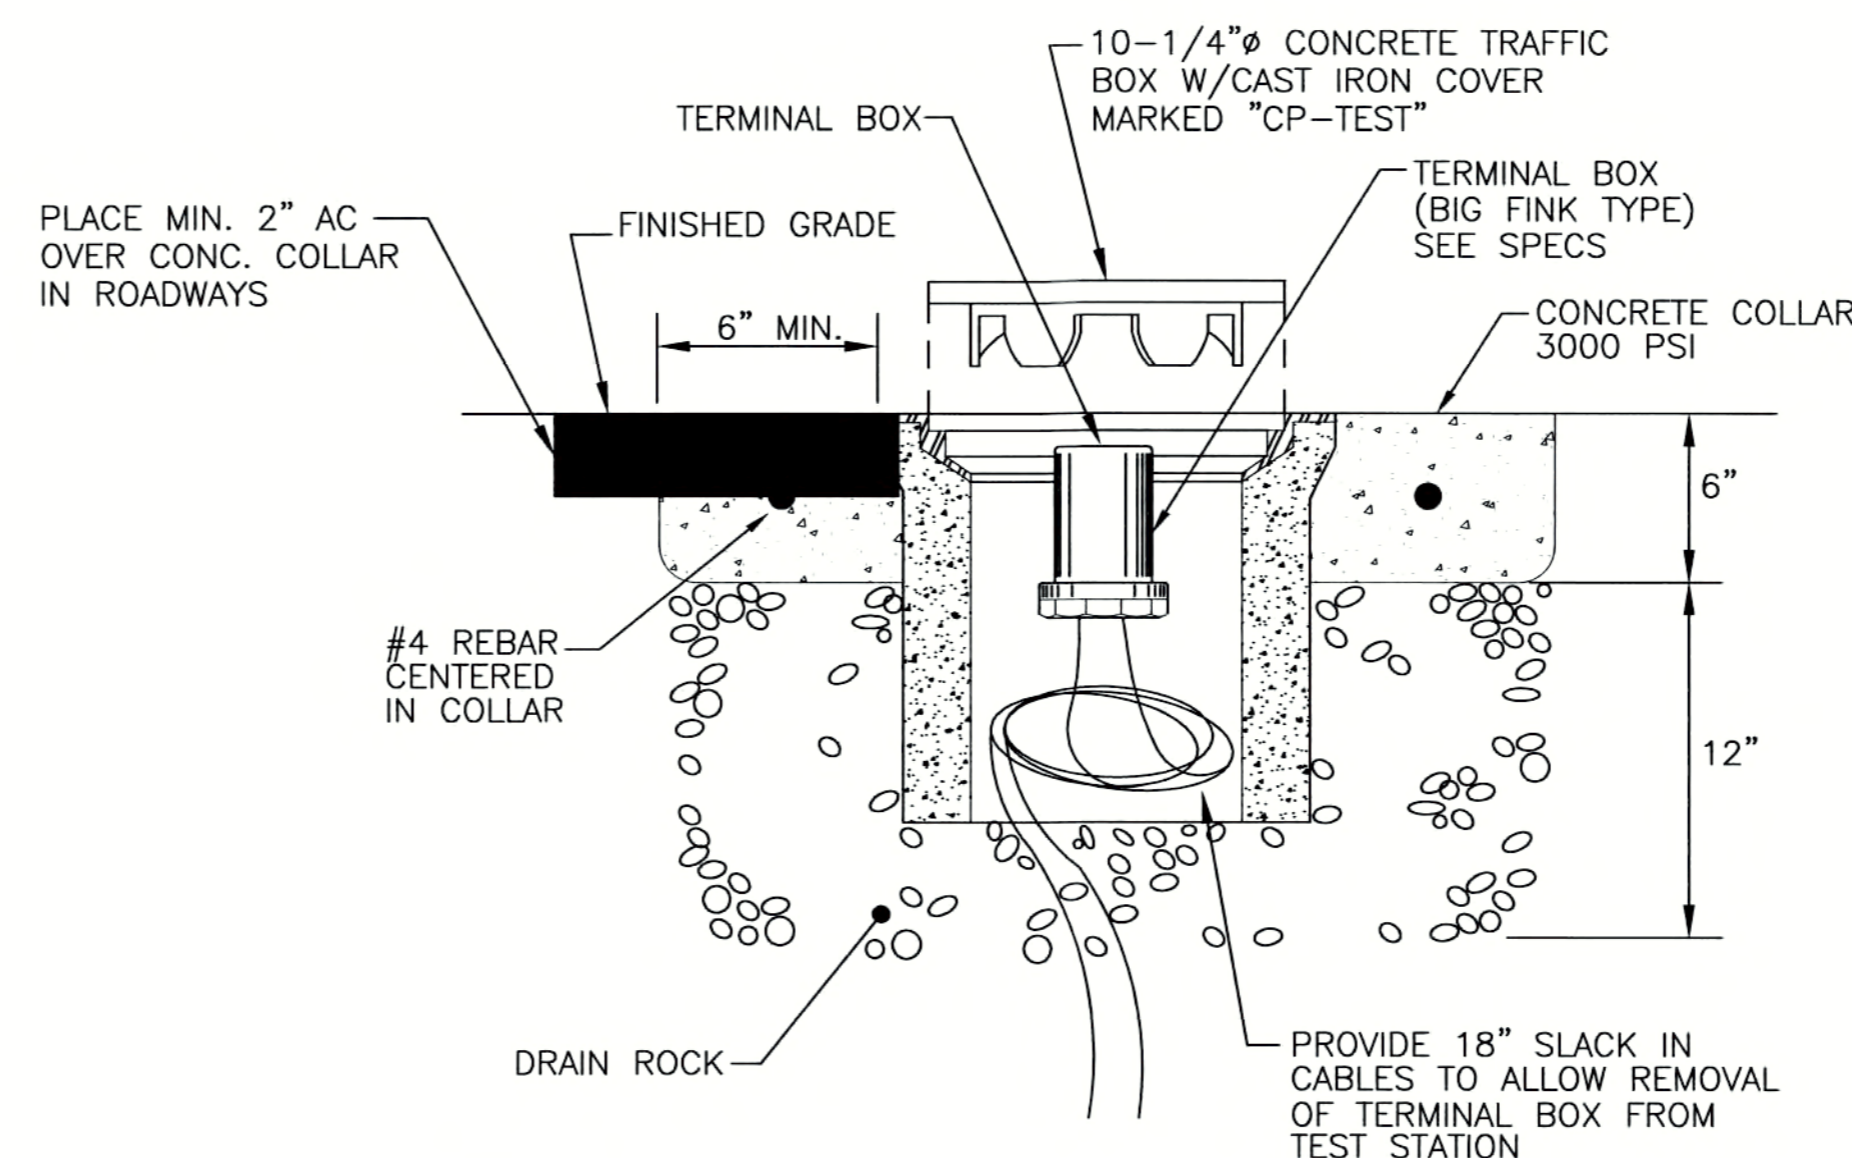

NOTE:

- SET LID 1/4" BELOW PAVEMENT OR SHOULDER IN ROADWAYS AND 2" ABOVE FINISHED GRADE ELSEWHERE

4 **FLUSH MOUNTED TEST STATION CONCRETE BOX**
CC-2 NOT TO SCALE FINISHED GRADE

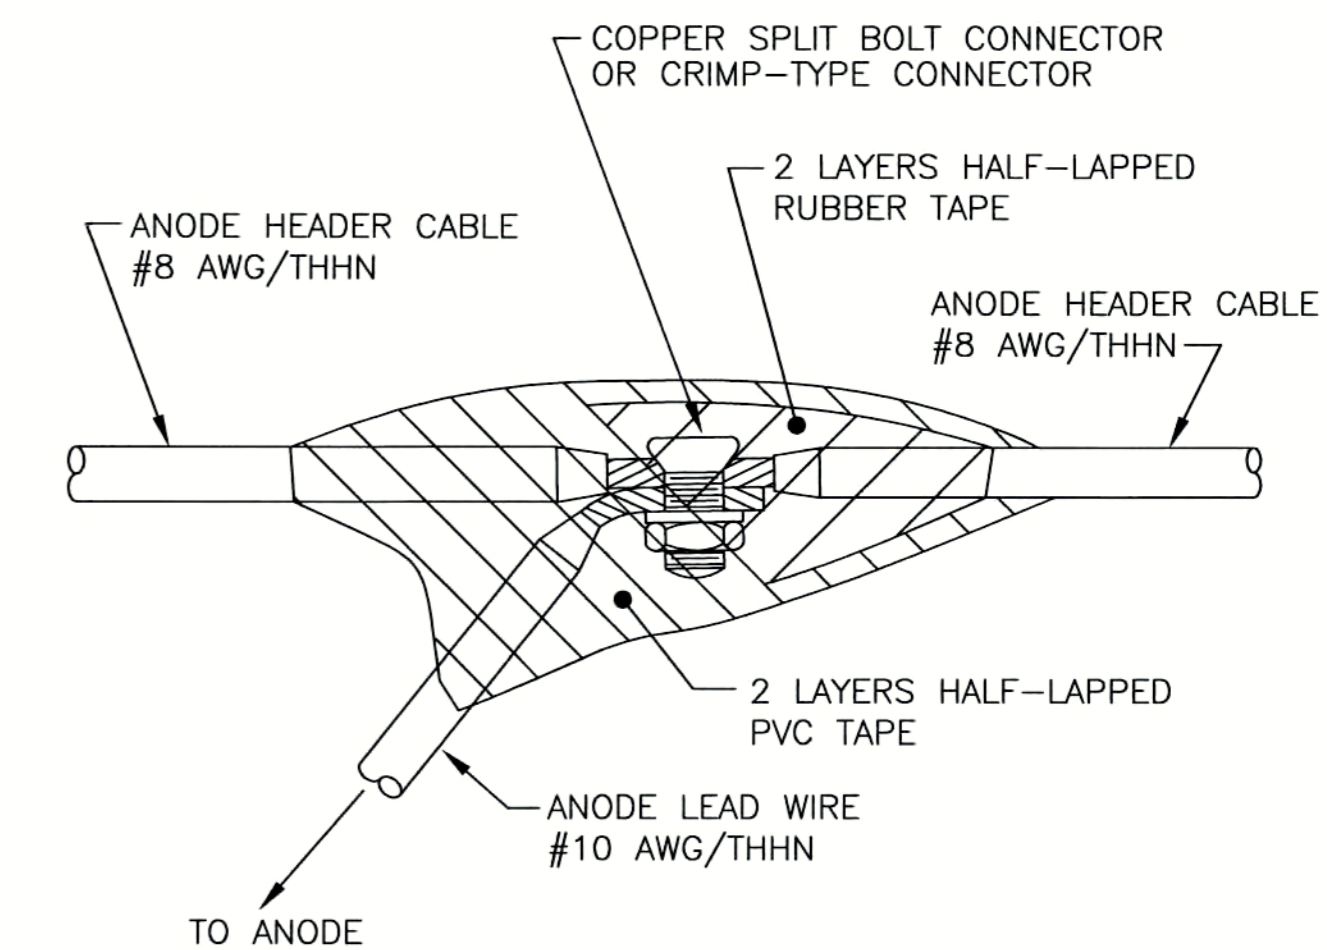

5 **SPLICE CONNECTION**
CC-2 NOT TO SCALE

N:\Clients\293_Spanos\00-05-01_14-MSPS_Upgrade\CAD\Design\Asbults\CC2-4.dwg 11-13-08 10:19:17 AM orimer




REFER TO BID SET FOR SIGNATURE


REV. No.	DISCRIPTION	DATE	BY	Apr'd By
1				
2				
3				
4				
5				
6				
7				

WEST YOST & ASSOCIATES
1260 Lake Boulevard Suite 240 Davis, California 95616 (530) 756-5905 FAX (530) 756-5991

RECORD DRAWINGS		
14-Mile Slough Pump Station Upgrades		
CATHODIC PROTECTION DETAILS - 2		
DEPARTMENT OF MUNICIPAL UTILITIES CITY OF STOCKTON, CALIFORNIA		
SCALE: NONE	APPROVED BY: DATE: _____	SHEET No. _____
DESIGNED BY: MA		CC-2
DRAWN BY: SC		28 of 89 SHEETS
CHECKED BY: JDH		PROJECT No. 293-00-05-01
RECORD Dwg.:	ASSISTANT DIRECTOR, DEPT. OF MUNICIPAL UTILITIES	

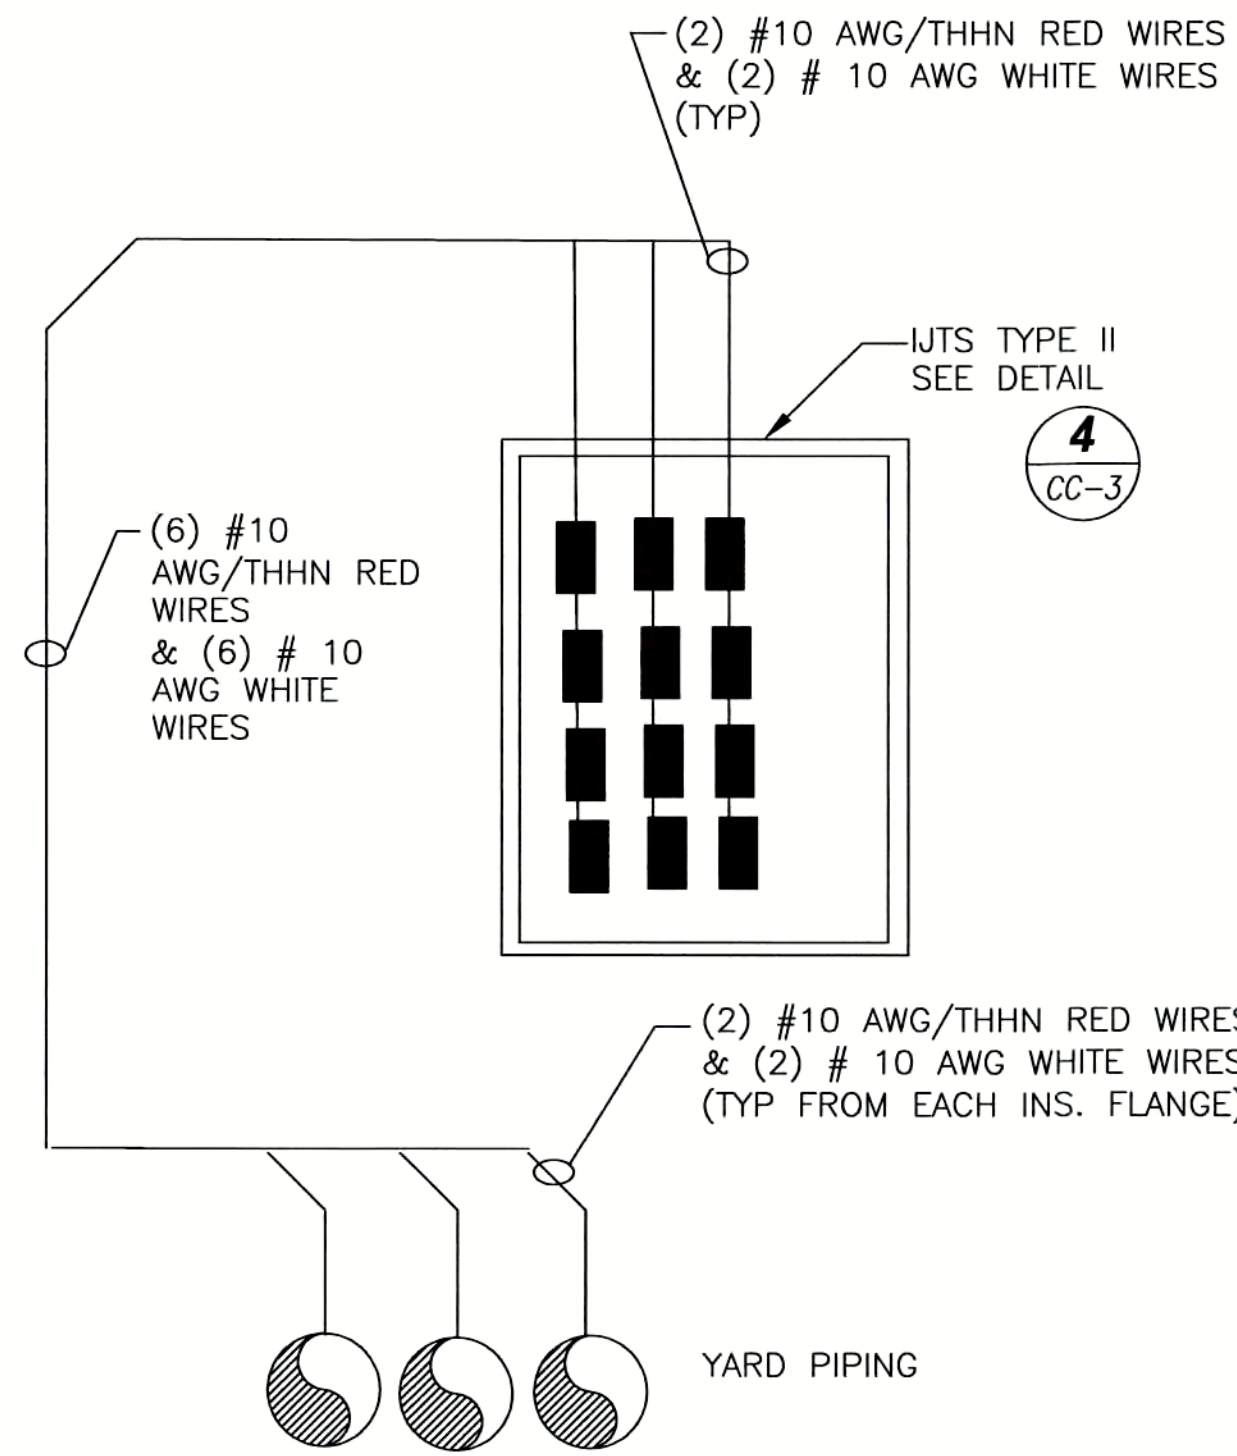


1 SCHEMATIC - IJTS
CC-3 NOT TO SCALE

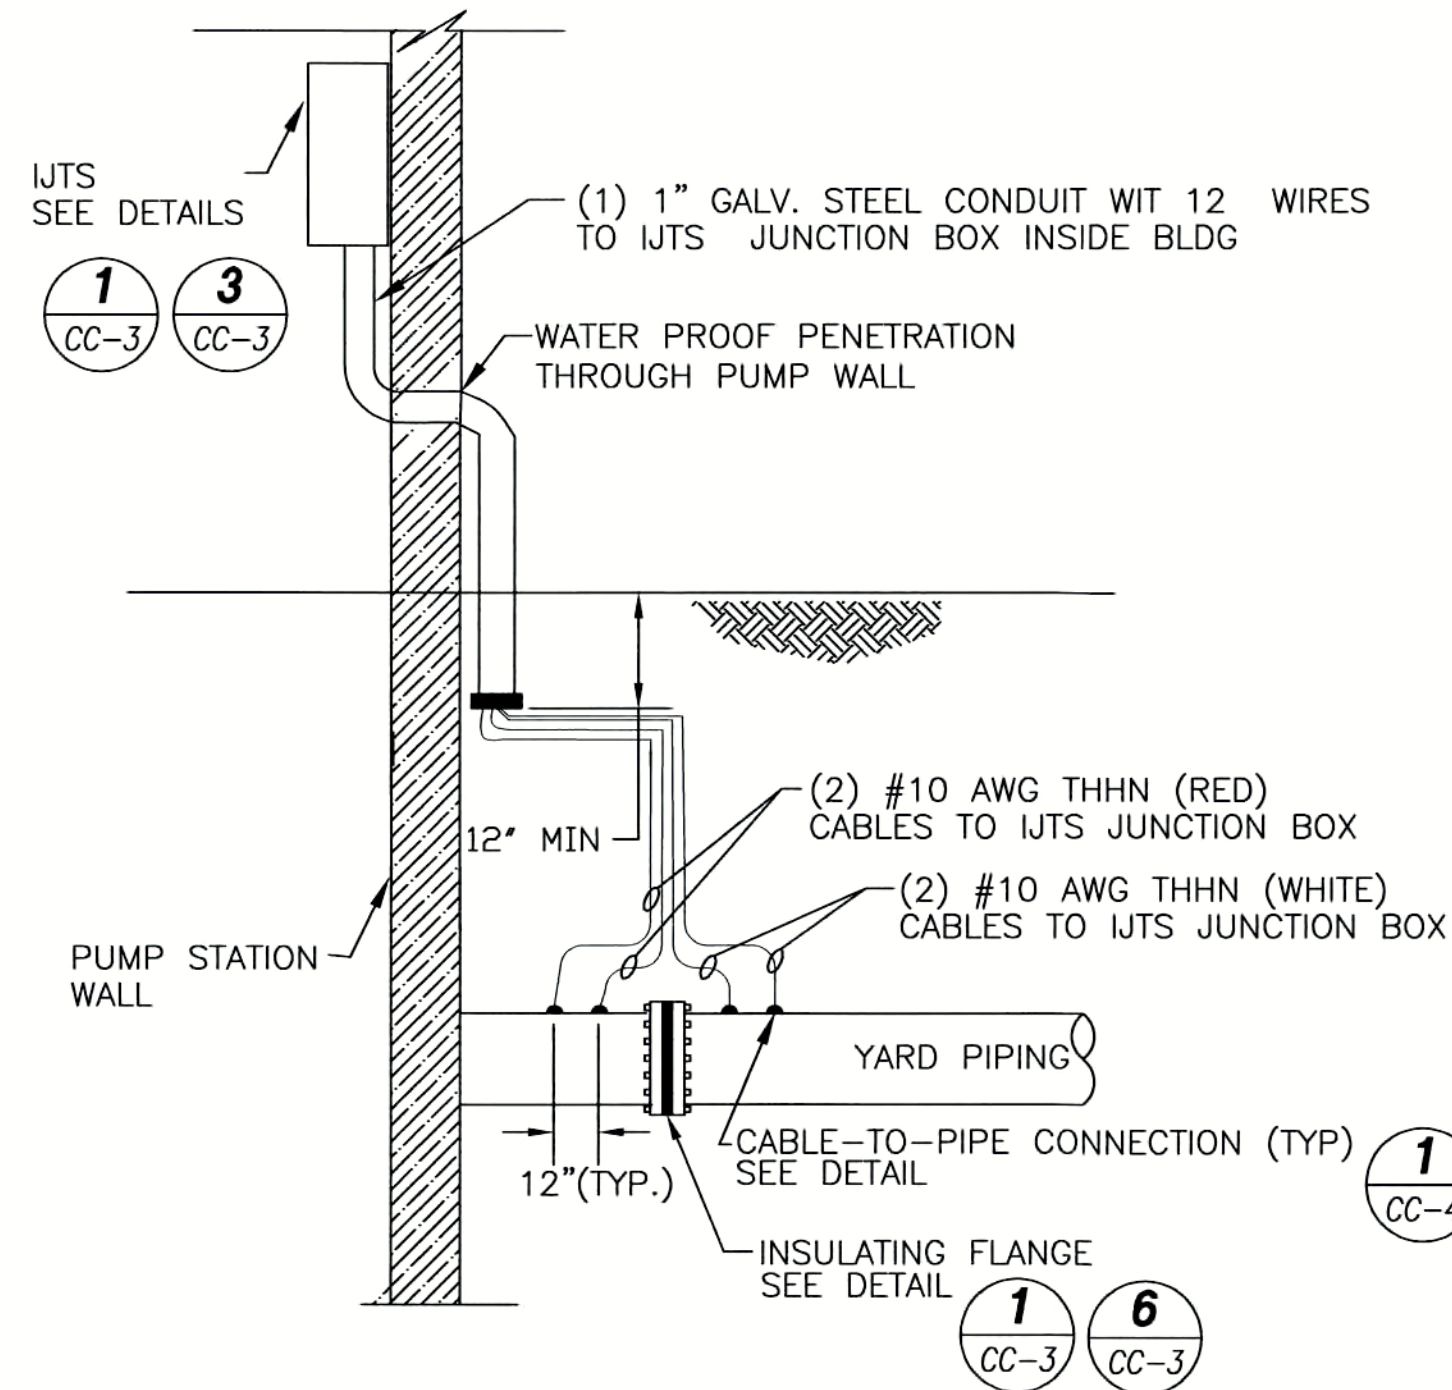


NOTES:
1. 3 YARD PIPE INSULATING FLANGES PENETRATING THE EAST WALL OF THE PUMP STATION SHALL BE CONNECTED TO THE IJTS-EAST.
2. 3 YARD PIPE INSULATING FLANGES PENETRATING THE WEST WALL OF THE PUMP STATION SHALL BE CONNECTED TO THE IJTS- WEST.
3. (2) #10 AWG/THHN RED WIRES AND (2) #10 AWG/THHN WHITE WIRES SHALL BE CONNECTED TO EACH INSULATING FLANGE AND THE WIRES TERMINATED IN THE RESPECTIVE IJTS JUNCTION BOXES.

2 IJTS - INSULATING JOINT TEST STATION
CC-3 NOT TO SCALE

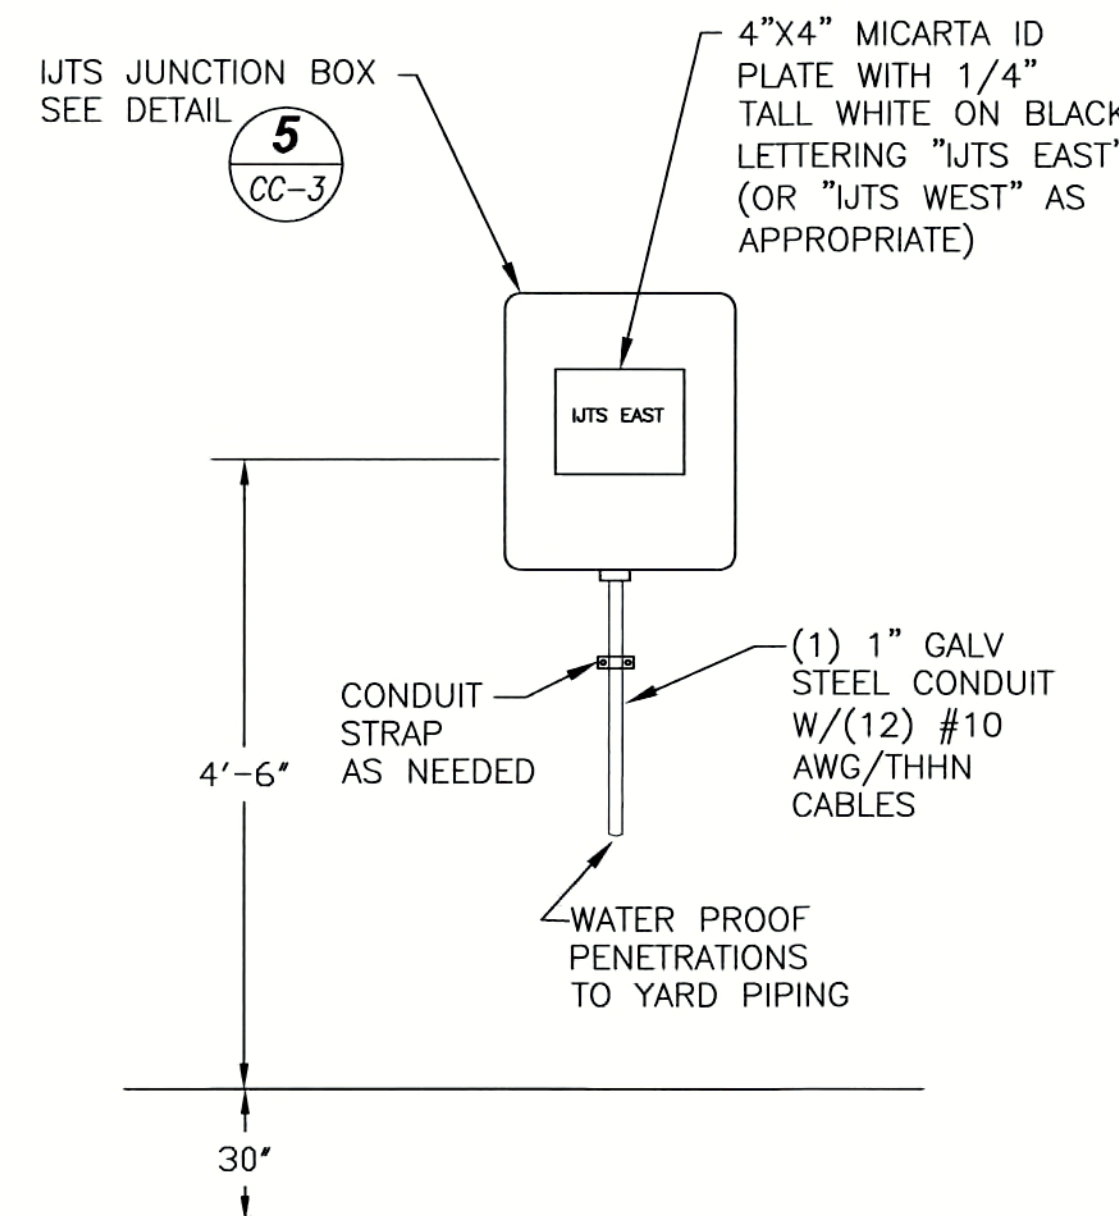


NOTE:
ALL UNDERGROUND CONDUIT SHALL BE PRIMED & TAPE WRAPPED WITH HALF-LAP 10-MIL POLYETHYLENE TAPE.

3 WALL MOUNTED IJTS TEST STATION
CC-3 NOT TO SCALE

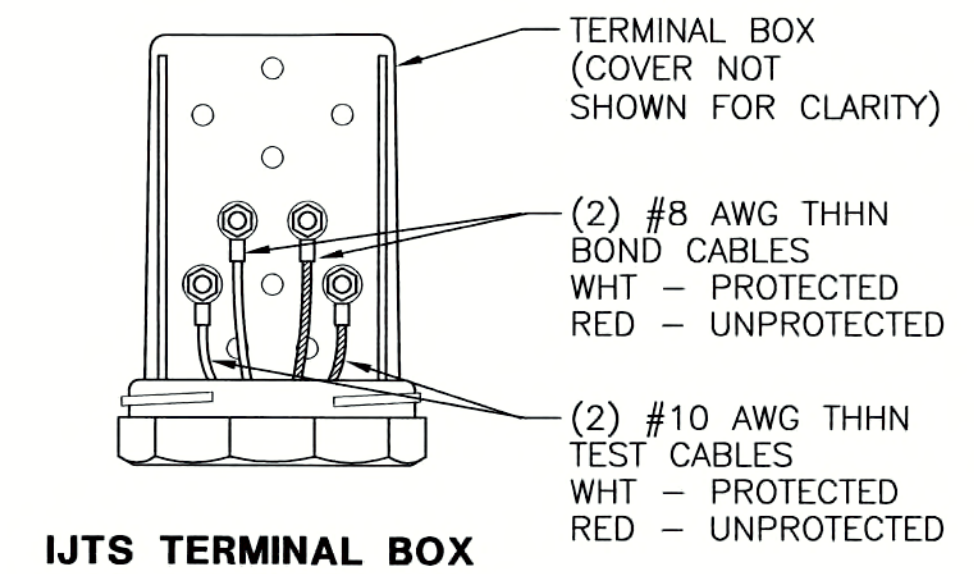


IJTS TERMINAL BOX

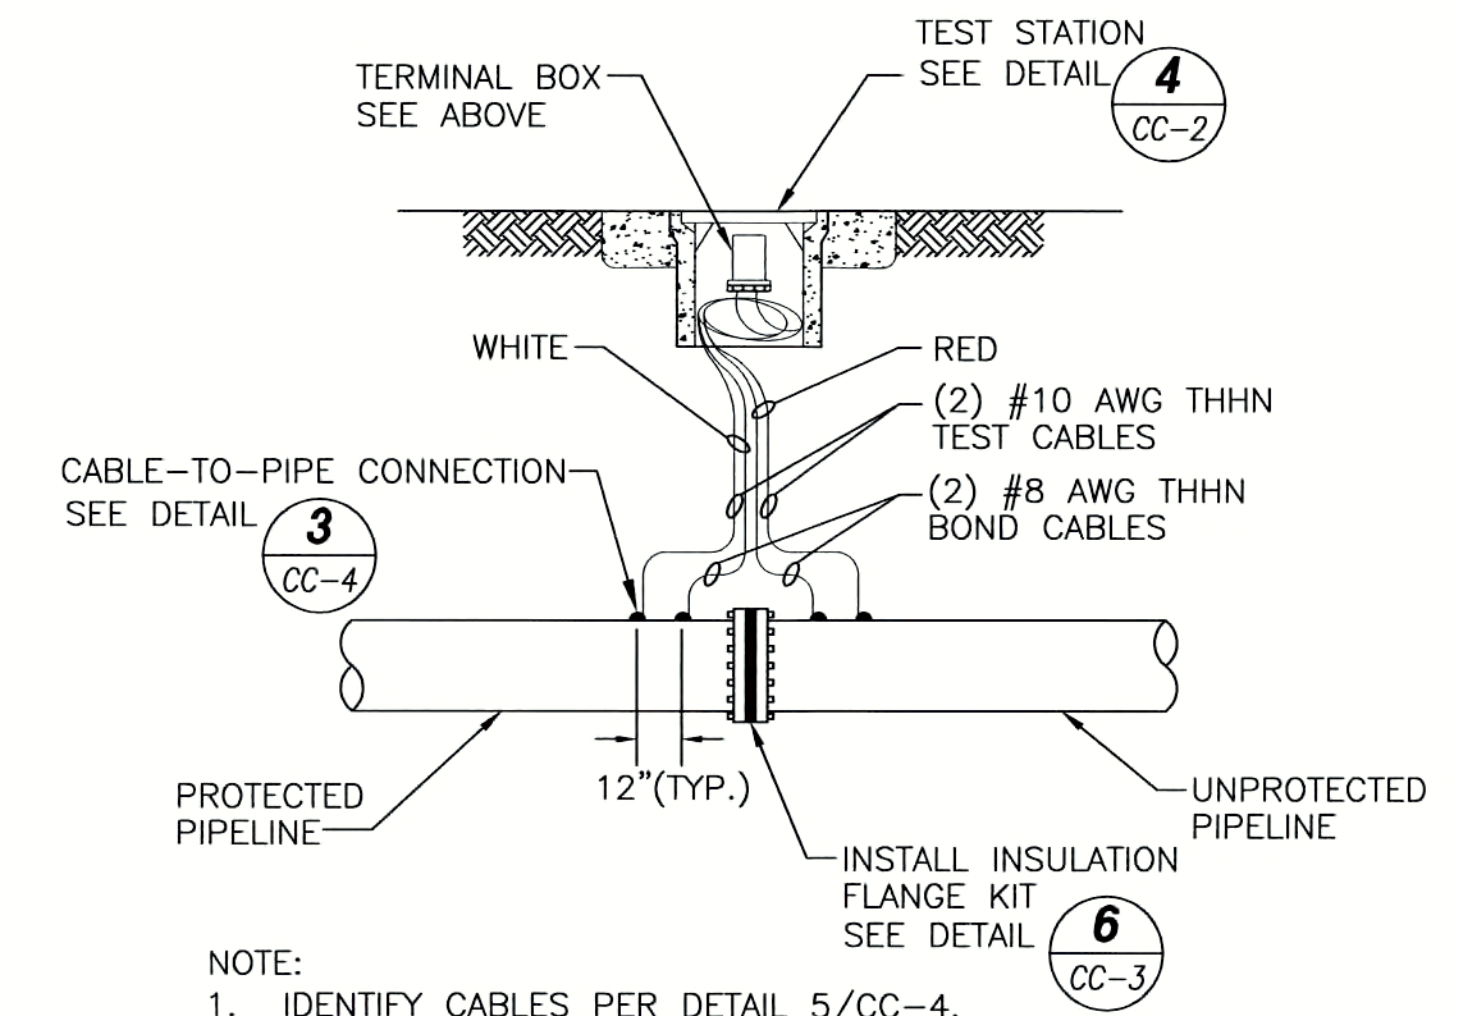


NOTE:
1. IDENTIFY CABLES PER DETAIL 5/CC-4.


4 IJTS TYPE I - INSULATING JOINT TEST STATION
CC-3 NOT TO SCALE

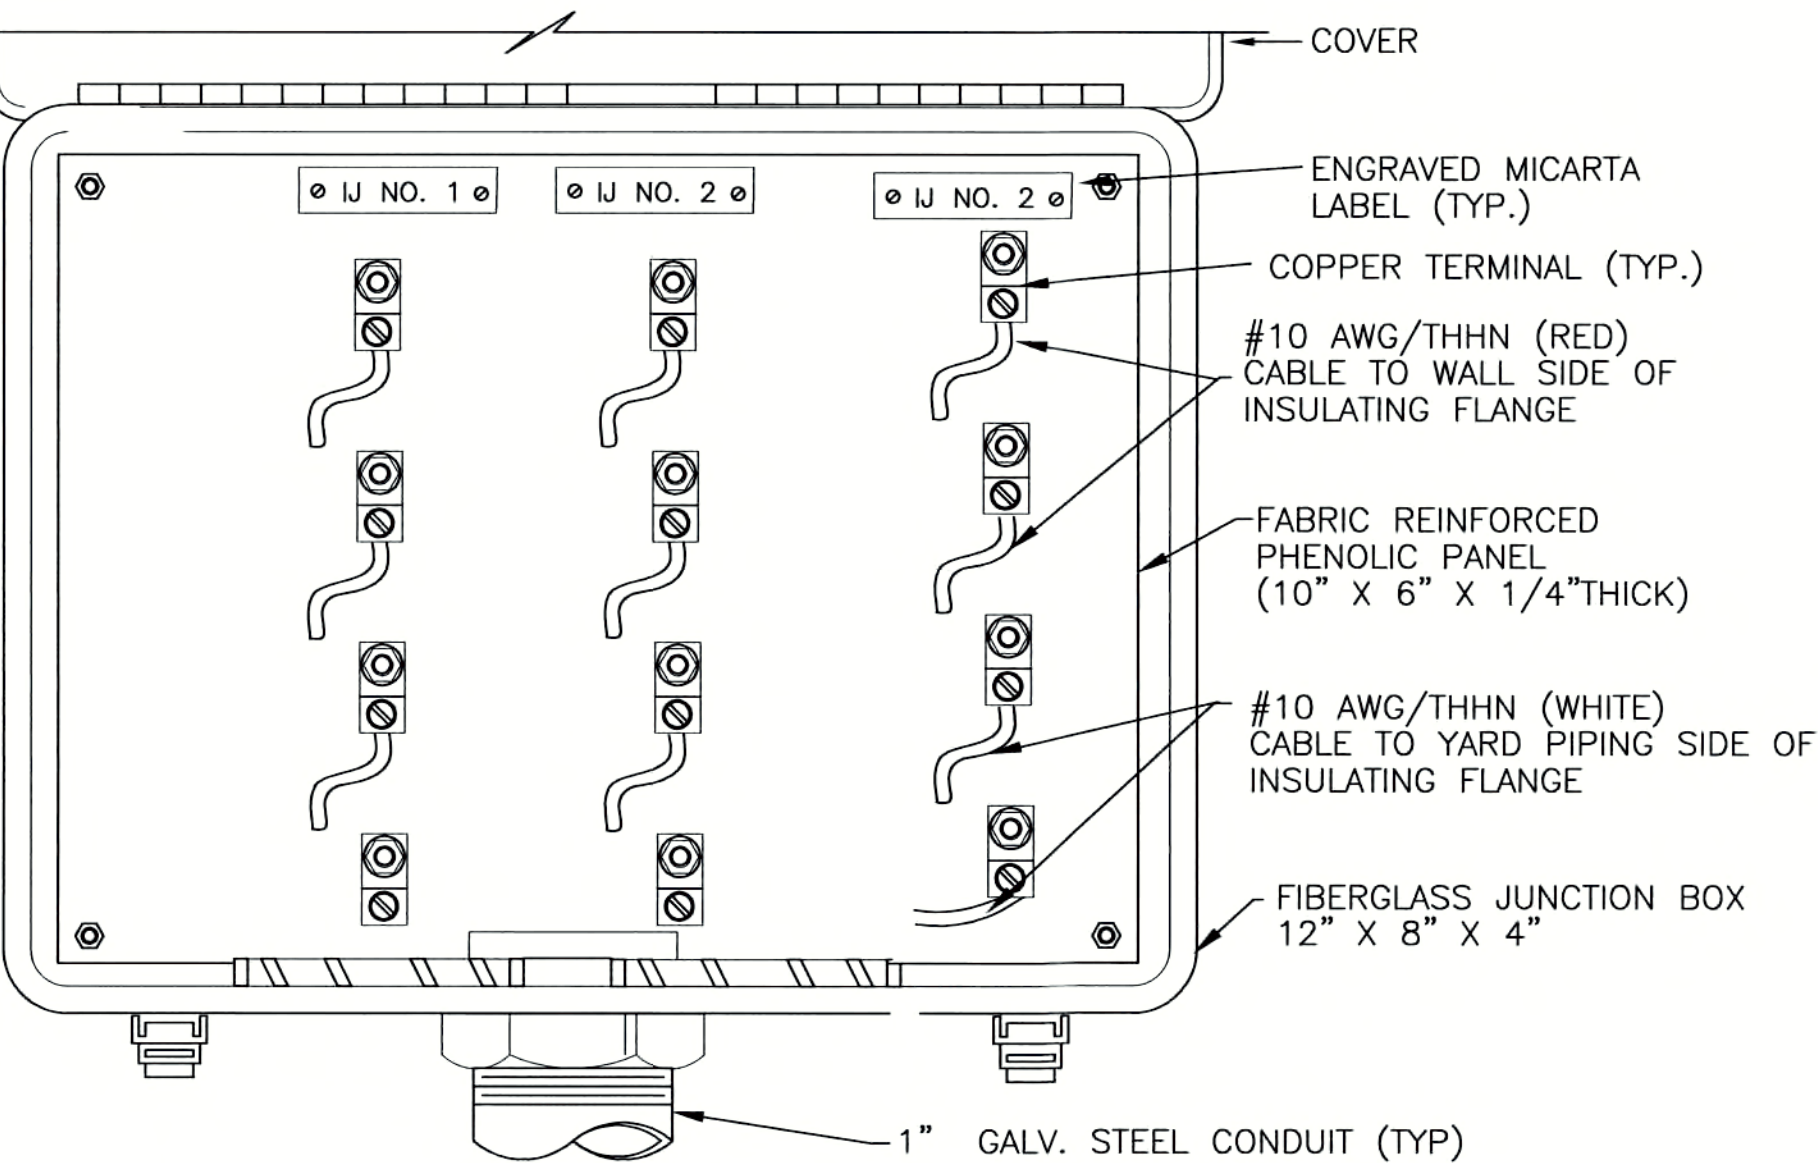


5 IJTS TYPE II JUNCTION BOX
CC-3 NOT TO SCALE

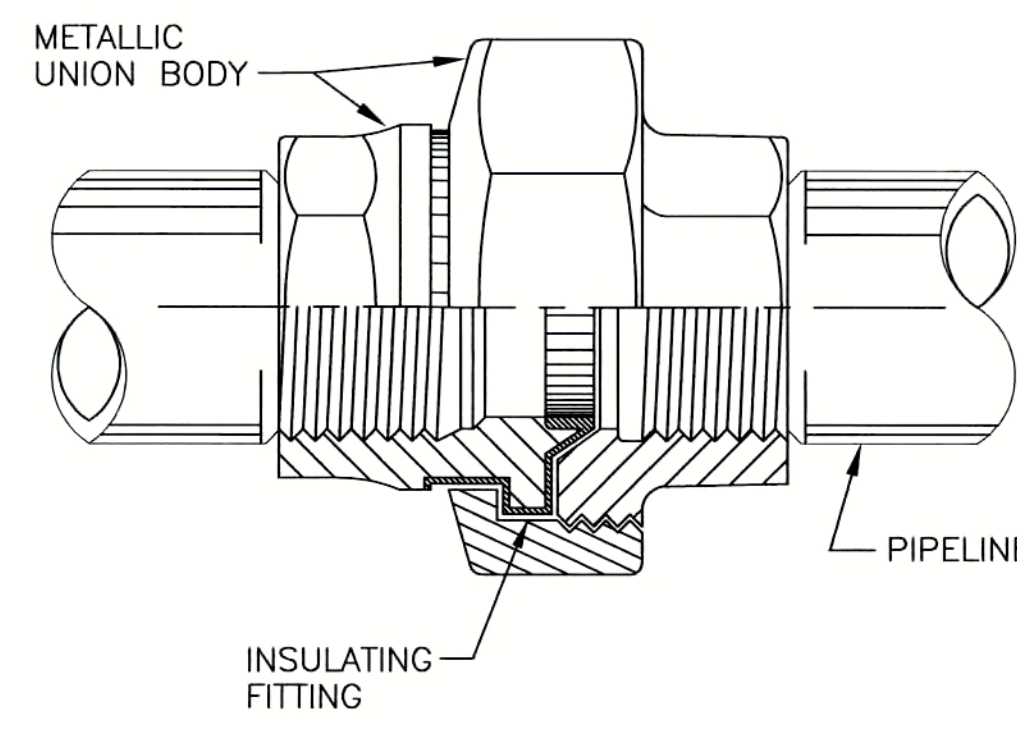

INSULATING UNION

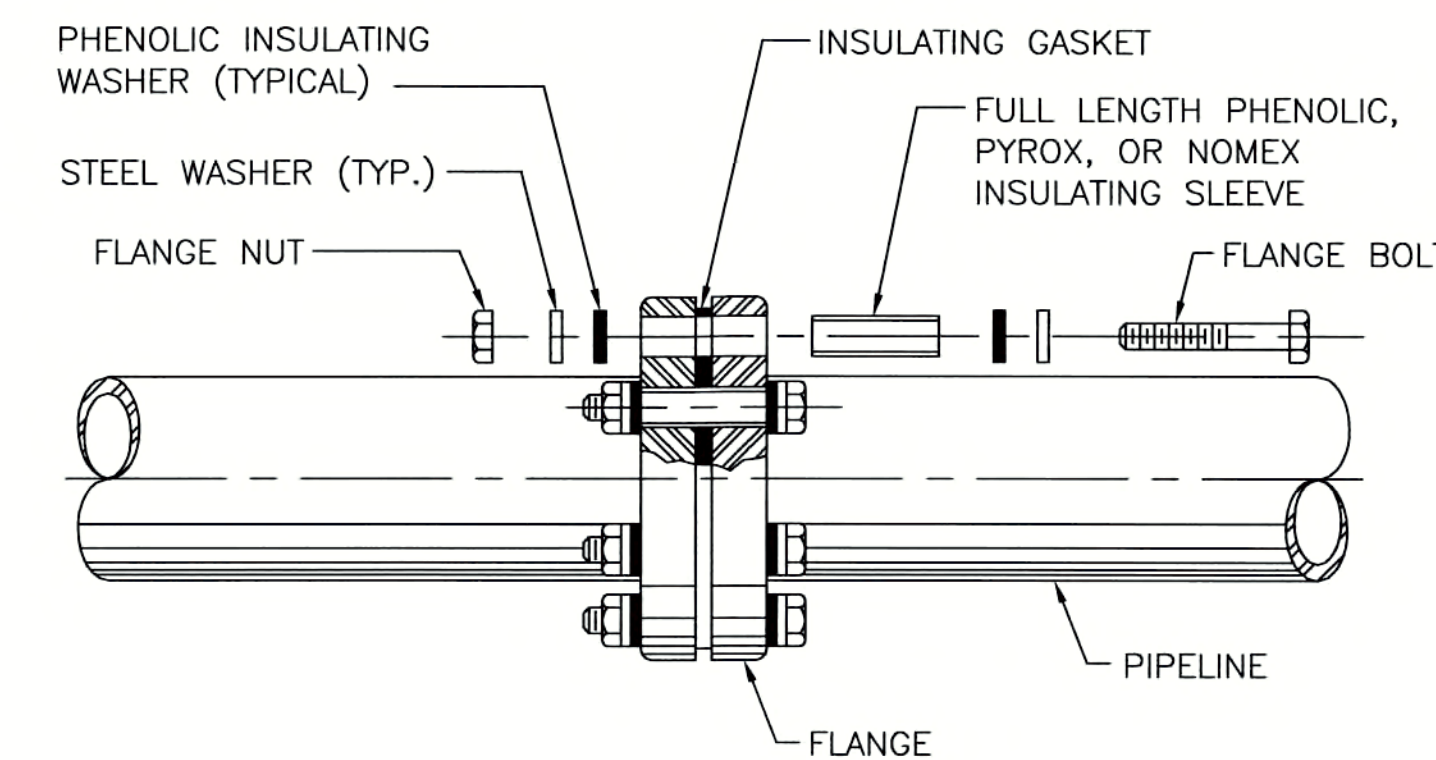

ABOVE GRADE INSULATING JOINT

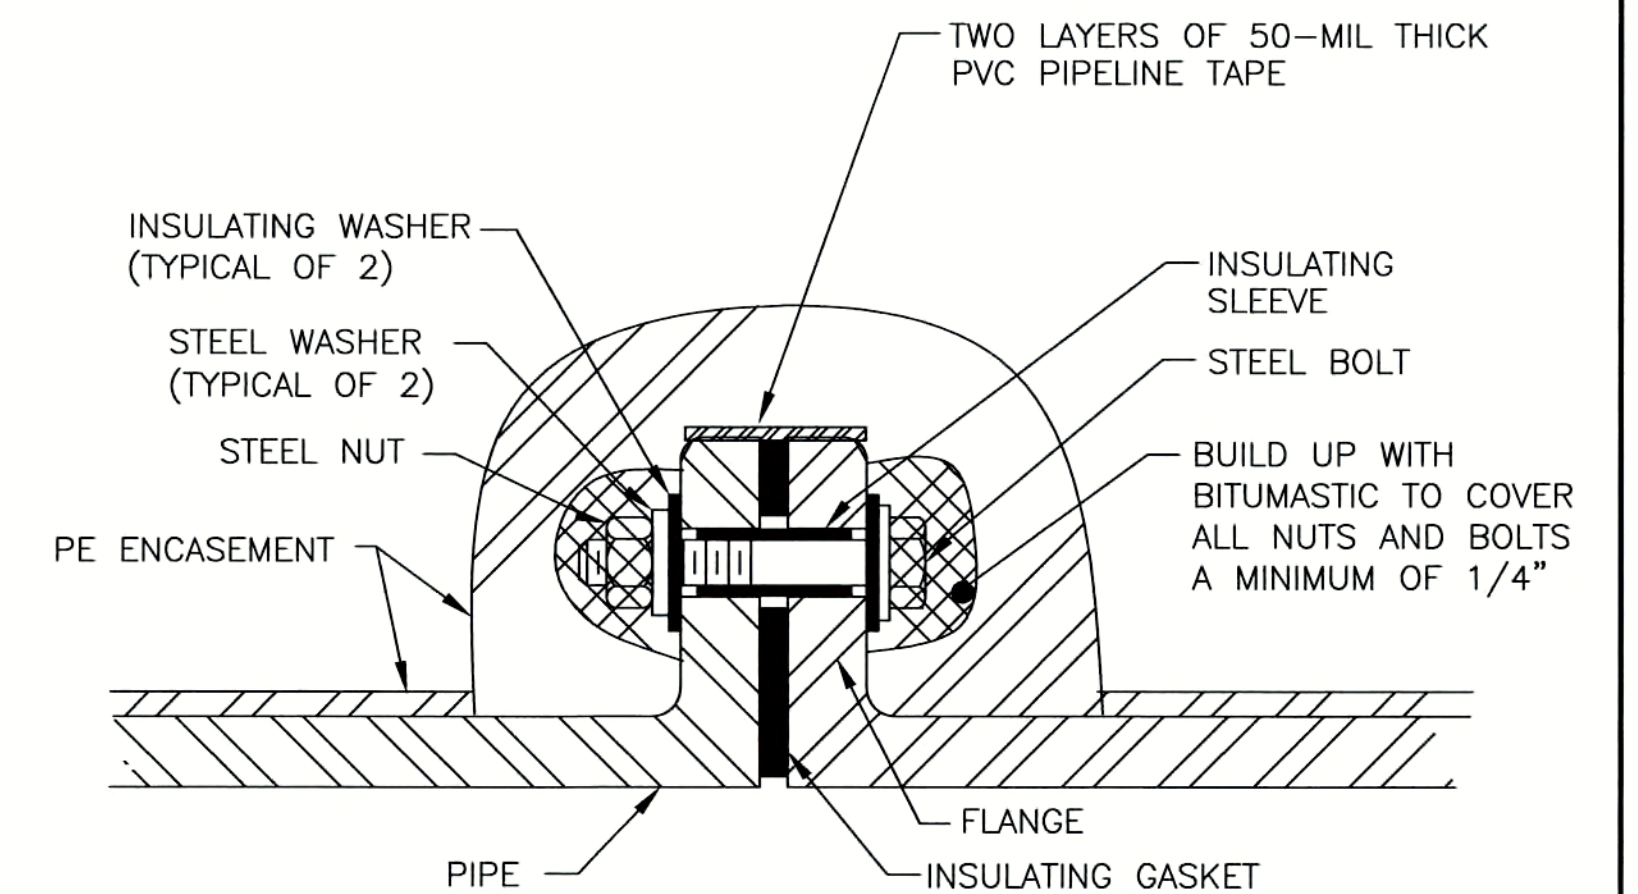

BELOW GRADE INSULATING JOINT COATING

NOTES:
1. GASKET SHALL BE FOR WATER SERVICE AND BE OF SAME PRESSURE RATING AS THE FLANGE.
2. DELETE COATING IF FLANGE IS LOCATED ABOVE GRADE OR IN VAULTS.
3. FOR BURIED IJS ON DI PIPE, COAT NUTS & BOLT WITH BITUMASTIC AND ENCASE IN POLYETHYLENE.

6 DIELECTRIC INSULATING JOINT (IJ)
CC-3 NOT TO SCALE








REFER TO SET
FOR SIGNATURE

REV. No.	DISCRPTION	DATE	BY	Aprv'd By
1				
2				
3				
4				
5				
6				
7				





RECORD DRAWINGS		
14-Mile Slough Pump Station Upgrades		
CATHODIC PROTECTION DETAILS - 2		
DEPARTMENT OF MUNICIPAL UTILITIES CITY OF STOCKTON, CALIFORNIA		
SCALE: NONE	APPROVED BY: DATE: _____	SHEET No.
DESIGNED BY: MA		CC-3
DRAWN BY: SC		29 of 89 SHEETS
CHECKED BY: JDH		PROJECT No. 293-00-05-01
RECORD DWG.:	ASSISTANT DIRECTOR, DEPT. OF MUNICIPAL UTILITIES	

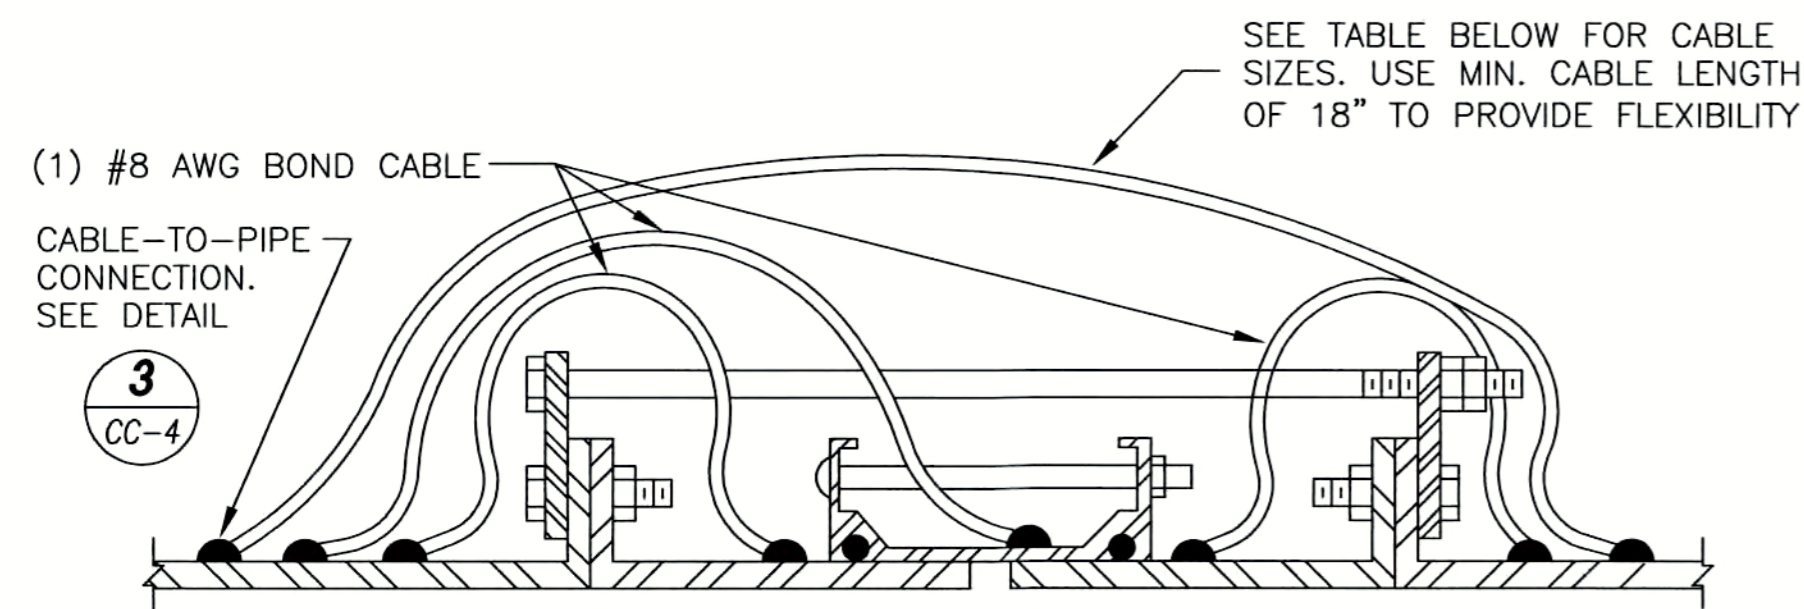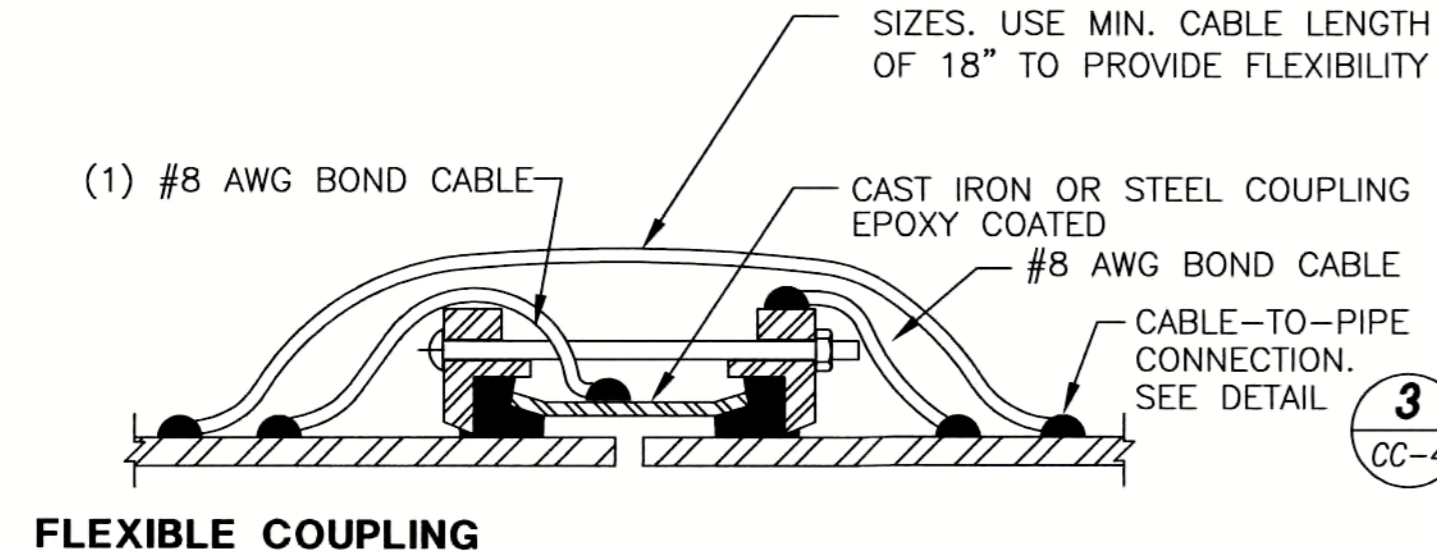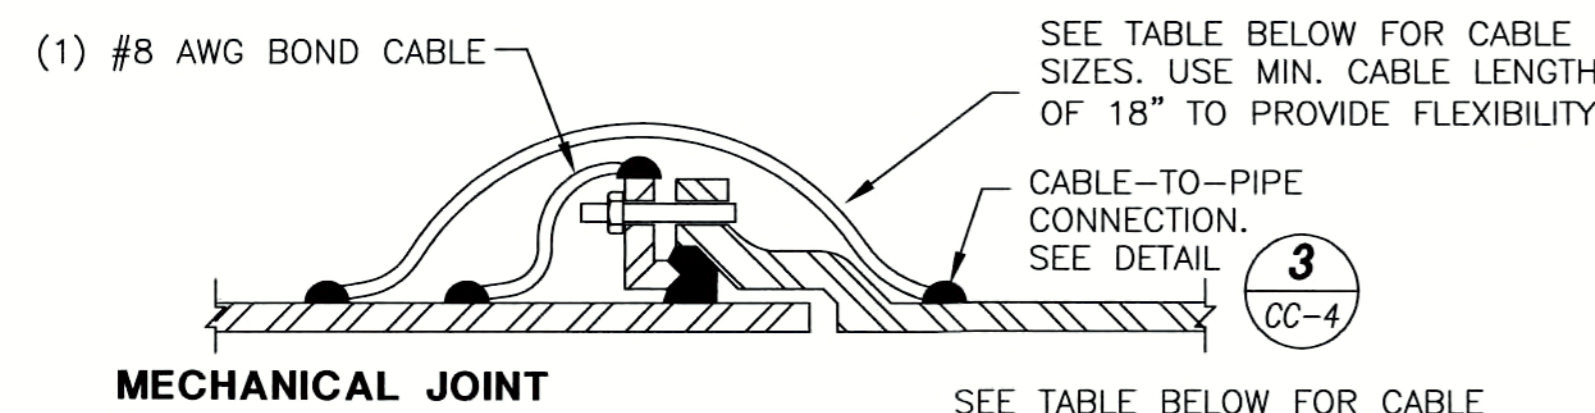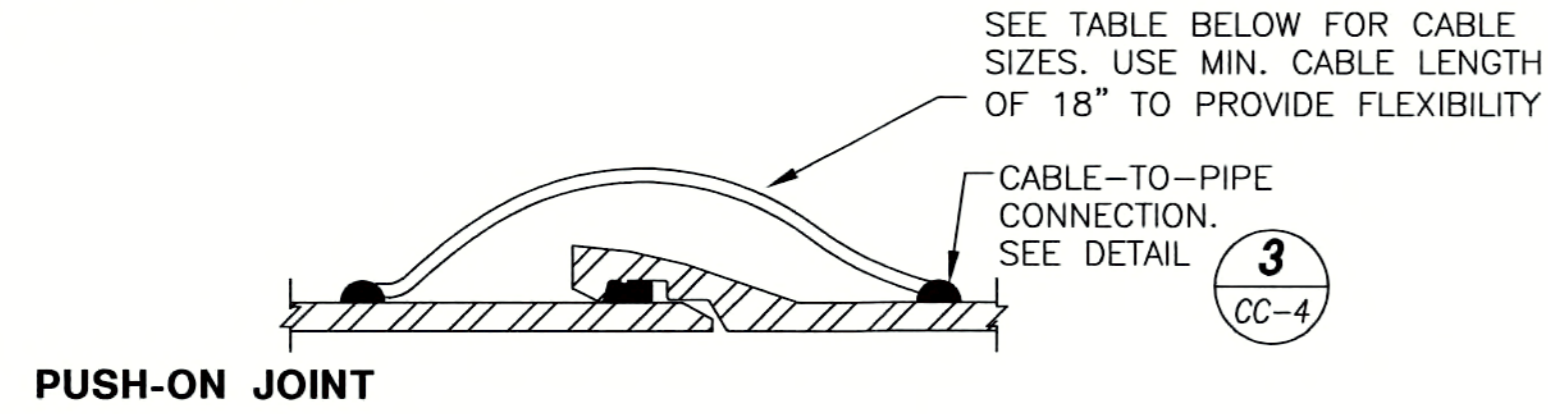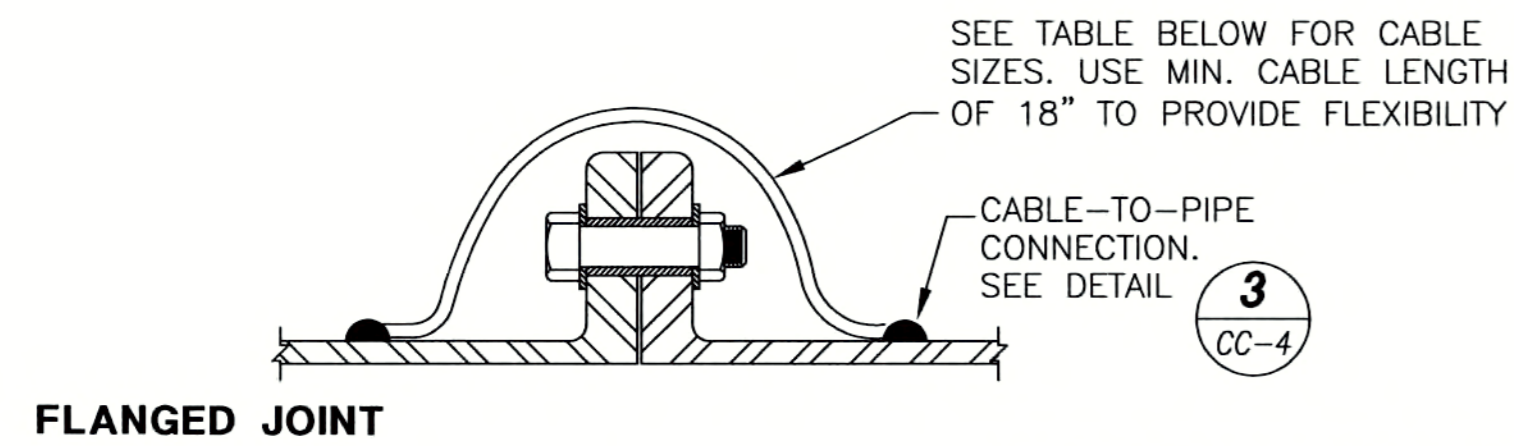

DUCTILE IRON PIPE FLEXIBLE COUPLING RESTRAINING RODS


BOND CABLE SIZES	
PIPE DIAMETER	BOND NO. & SIZE
48" - 30"	TWO #2 AWG
24" - 20"	TWO #4 AWG
18" - 8"	ONE # 4 AWG
8" OR LESS	ONE # 8 AWG

1 BOND CABLES - METALLIC PIPE JOINTS FOR DI WATER MAIN
CC-4 NOT TO SCALE

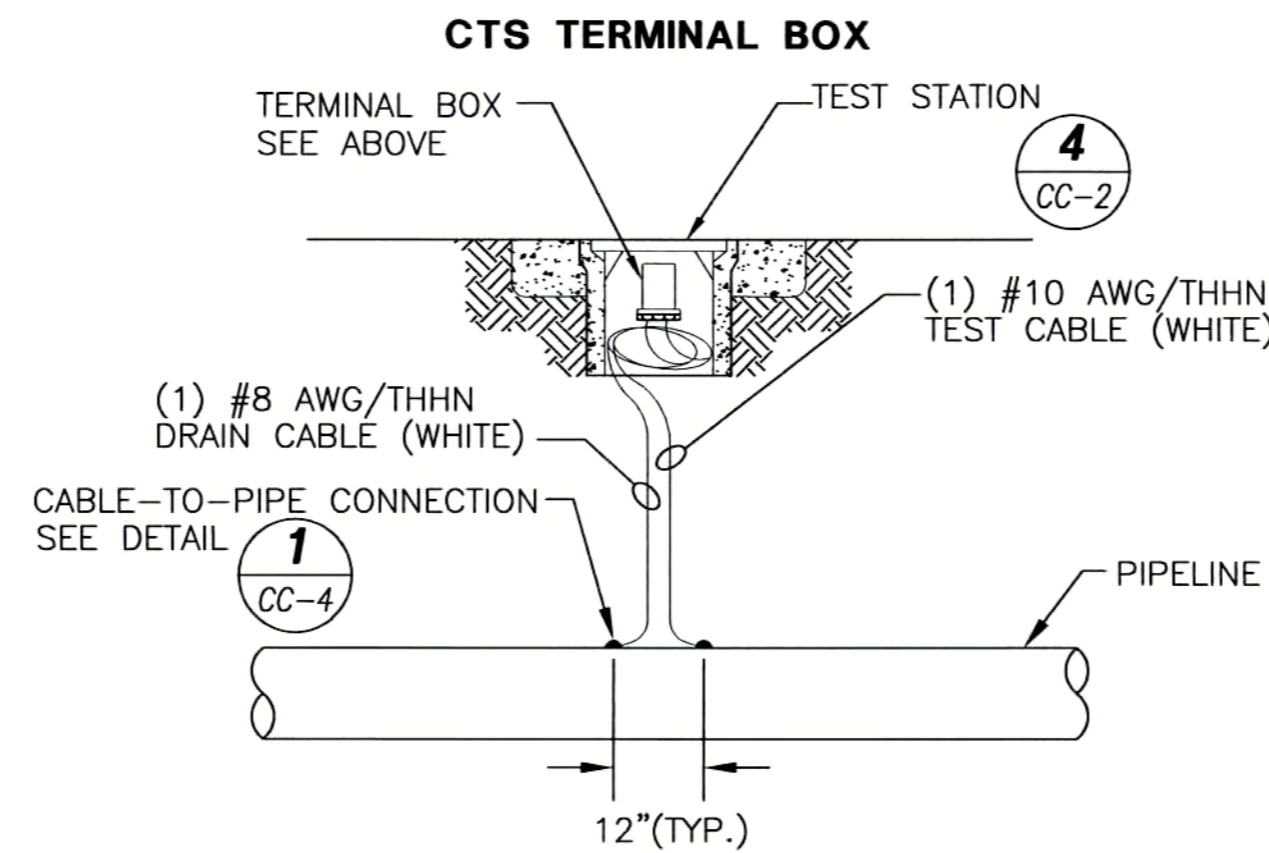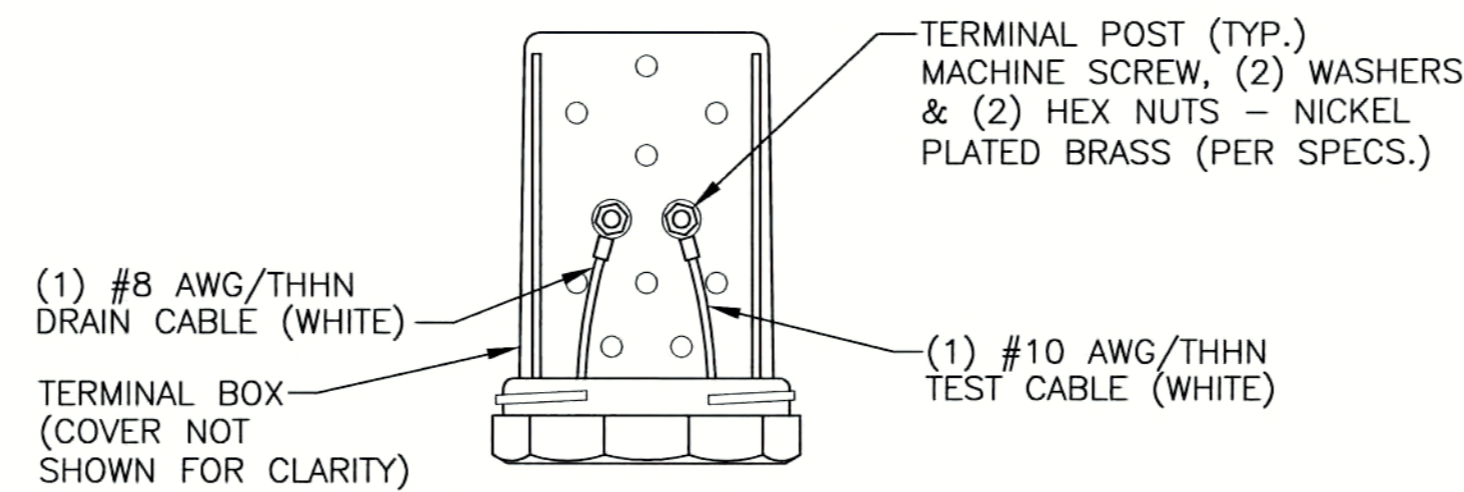

NOTE:
1. IDENTIFY CABLES PER DETAIL 5/CC-4.


2 CTS - CORROSION TEST STATION
CC-4 NOT TO SCALE

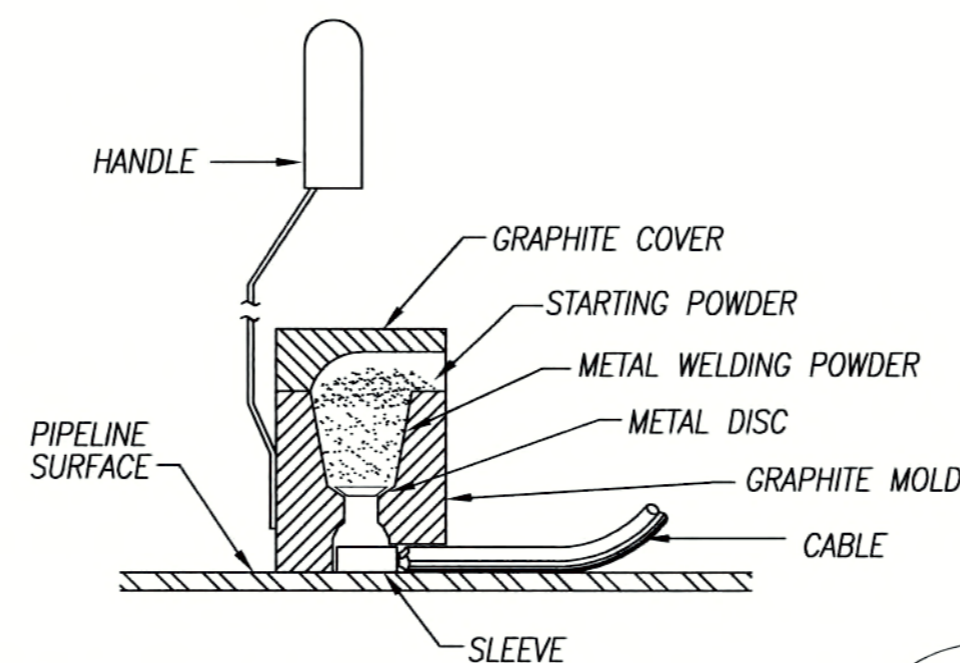

- STEP 1.** FILE STRUCTURE CONNECTION AREA TO BARE SHINY METAL AND CLEAN.
- STEP 2.** STRIP INSULATION FROM WIRE. ATTACH SLEEVE REQUIRED ON #6 AWG WIRE OR SMALLER
- STEP 3.** HOLD MOLD FIRMLY WITH OPENING AWAY FROM OPERATOR AND IGNITE WITH FLINT GUN.
- STEP 4.** REMOVE SLAG FROM CONNECTION AND PEEN WELD FOR SOUNDNESS.
- STEP 5.** COVER CONNECTION AND EXPOSED STRUCTURE SURFACE WITH EPOXY COATING COMPOUND PER DETAIL 3/CC-4


NOTE:
PROCEDURE SHOWN ABOVE IS TO BE USED AS A GENERAL GUIDE ONLY.
CONSULT MANUFACTURER'S LITERATURE FOR SPECIFIC INSTALLATION INSTRUCTIONS.

4 EXOTHERMIC WELD PROCEDURE
CC-4 NOT TO SCALE

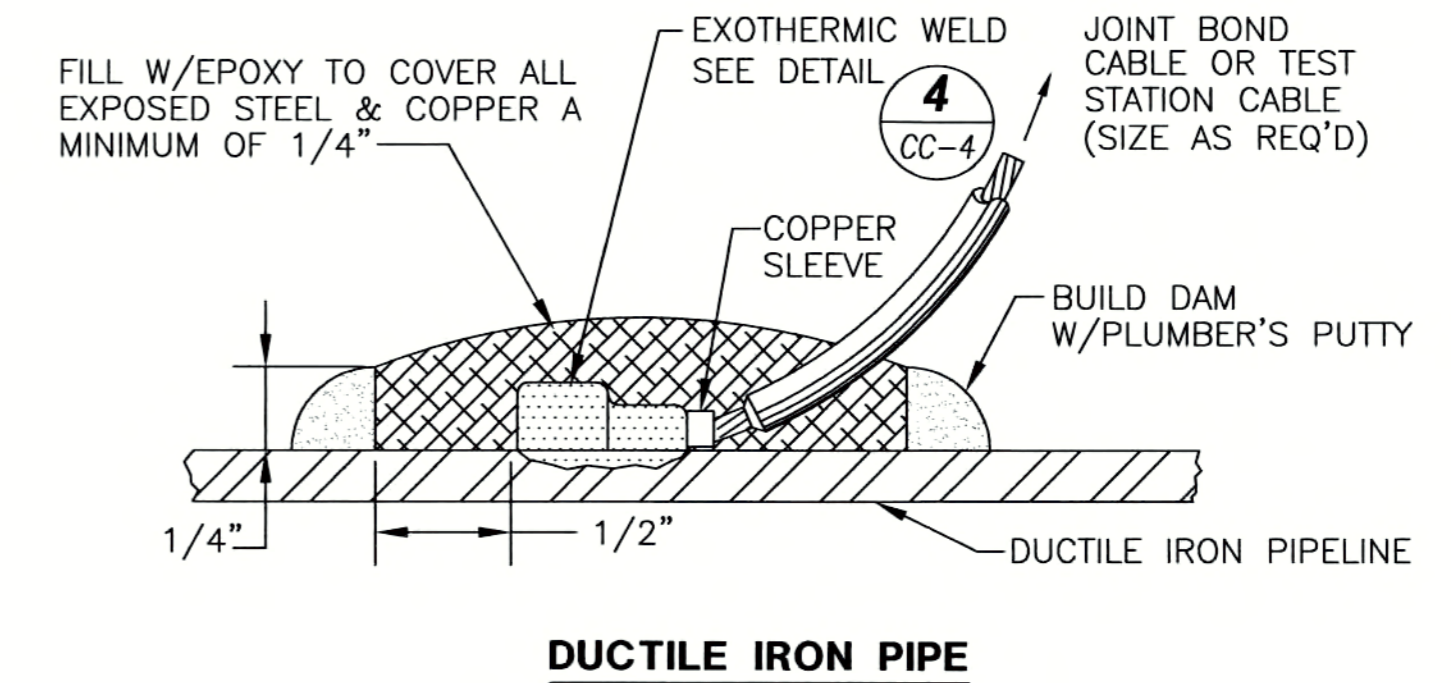

DUCTILE IRON PIPE

3 CABLE-TO PIPE CONNECTION
CC-4 NOT TO SCALE

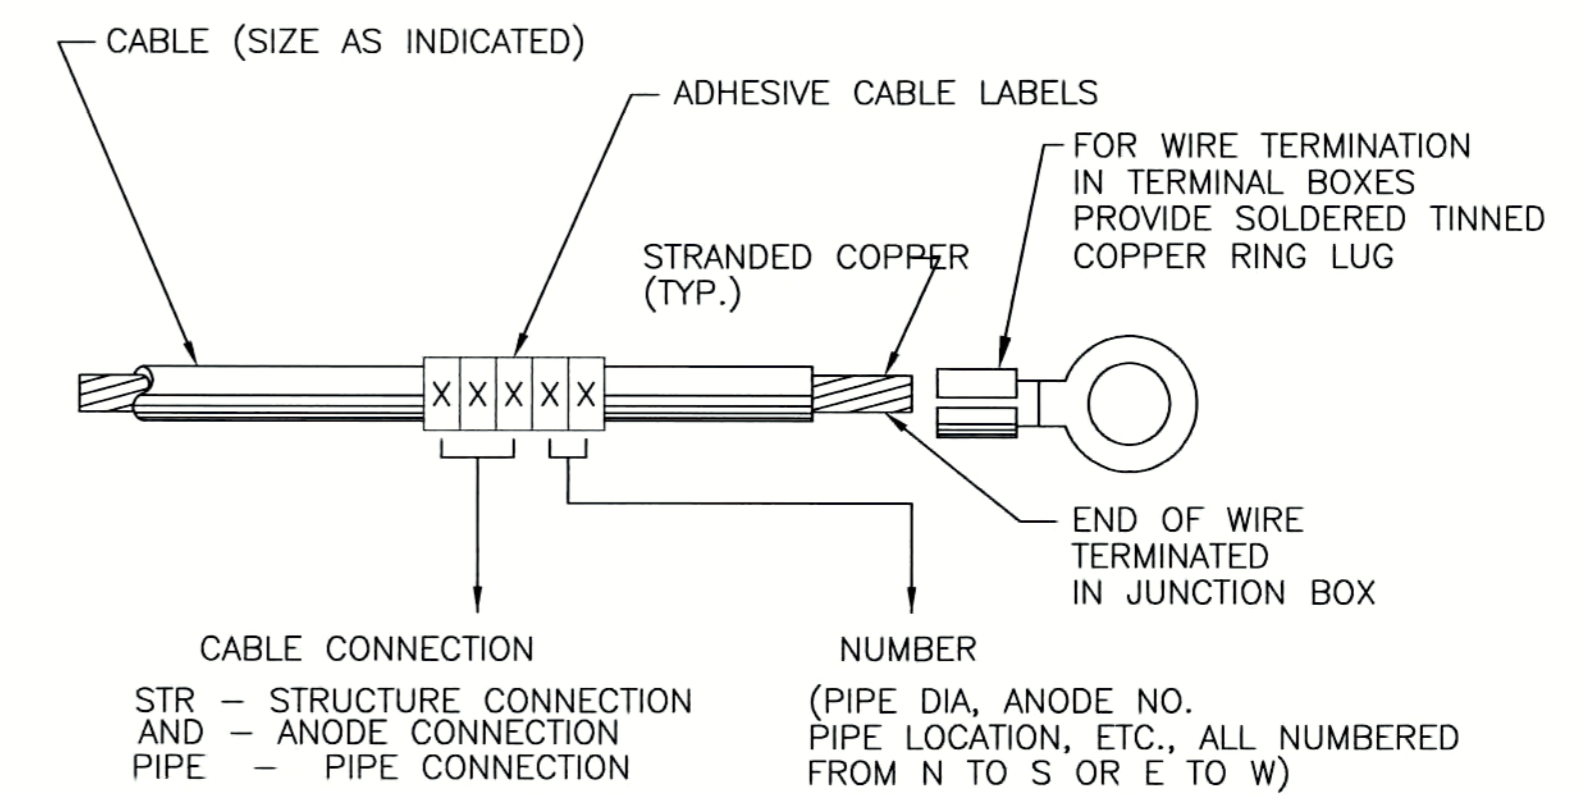

5 CABLE IDENTIFICATION
CC-4 NOT TO SCALE

N:\Clients\283 - Spruce\05-01 14-MSPS Upgrade\CAD\Design\Submittals\CC2-4.dwg 11-13-08 10:18:48 AM erimer



REFER TO SET FOR SIGNATURE

REV. No.	DISCRPTION	DATE	BY	Apr'd By
1				
2				
3				
4				
5				
6				
7				



RECORD DRAWINGS
14-Mile Slough Pump Station Upgrades
CATHODIC PROTECTION DETAILS - 2

DEPARTMENT OF MUNICIPAL UTILITIES CITY OF STOCKTON, CALIFORNIA		
SCALE: NONE	APPROVED BY: DATE: _____	SHEET No. CC-4
DESIGNED BY: MA		30 of 89 SHEETS
DRAWN BY: SC		PROJECT No. 293-00-05-01
CHECKED BY: JDH	ASSISTANT DIRECTOR, DEPT. OF MUNICIPAL UTILITIES	
RECORD Dwg.:		

GENERAL

1. BASIS OF DESIGN: 2001 CALIFORNIA BUILDING CODE.
2. THESE DRAWINGS SHALL BE USED IN CONJUNCTION WITH THE SEPARATELY BOUND PROJECT SPECIFICATIONS.
3. ALL MATERIALS, WORKMANSHIP, TESTING AND INSPECTION SHALL CONFORM TO THE CALIFORNIA BUILDING CODE, 2001 EDITION, AND LOCAL BUILDING CODES.
4. THE CONTRACTOR SHALL VERIFY ALL DIMENSIONS AND EXISTING CONDITIONS ON THE JOBSITE WITH A COMPLETE SET OF THE LATEST DRAWINGS. OMISSIONS OR DISCREPANCIES BETWEEN THE VARIOUS ELEMENTS OF THE CONTRACT DOCUMENTS SHALL BE BROUGHT TO THE ATTENTION OF THE ENGINEER BEFORE PROCEEDING WITH WORK.
5. DETAILS SHOWN ARE TYPICAL, AND APPLY TO SIMILAR CONDITIONS, UNLESS NOTED OTHERWISE.
6. REFER TO CIVIL DRAWINGS FOR FINISHED FLOOR ELEVATIONS, OPENINGS, SLOPES, DRAINS, CURBS, PADS, EMBEDDED ITEMS, ETC. REFER TO MECHANICAL AND ELECTRICAL DRAWINGS FOR SLEEVES, OPENINGS, AND HANGERS FOR PIPES, DUCTS AND EQUIPMENT.
7. THE CONTRACTOR SHALL BE RESPONSIBLE FOR JOBSITE SAFETY, INCLUDING SAFETY OF THE BUILDING. THE CONTRACTOR SHALL PROVIDE ADEQUATE SHORING, BRACING, AND GUYS IN ACCORDANCE WITH ALL NATIONAL, STATE AND LOCAL ORDINANCES.
8. DESIGN LOADS
 - BUILDING DESIGN VERTICAL LOADS
 - A. ROOF DEAD LOADS 15 PSF
 - B. ROOF LIVE LOADS 20 PSF (REDUCIBLE)
 - BUILDING DESIGN LATERAL LOADS
 - A. SEISMIC: PER 2001 CBC
 - Z = 0.3 FOR SEISMIC ZONE 3
 - R = 4.5 FOR MASONRY WALLS
 - I = 1.25 FOR ESSENTIAL FACILITY
 - SOIL PROFILE TYPE: S_D
 - B. WIND: PER 2001 CBC
 - 80 MPH WIND SPEED
 - EXPOSURE C
 - I = 1.15 FOR ESSENTIAL OCCUPANCY
- PUMP STATION/VAULT VERTICAL LOADS
 - A. TOP SLAB DEAD LOADS (SELF-WEIGHT)
 - B. TOP SLAB LIVE LOADS 100 PSF
9. DRAWINGS SHALL NOT BE SCALED OR MEASURED FOR DIMENSIONS.

FOUNDATION

1. FOUNDATION DESIGN IS BASED ON GEOTECHNICAL INVESTIGATION PREPARED BY KLEINFELDER, INC., DATED AUGUST 23, 2005, KLEINFELDER JOB NO. 47465.001.
2. OWNER SHALL RETAIN THE GEOTECHNICAL ENGINEER TO OBSERVE CONSTRUCTION, INCLUDING SITE GRADING, ENGINEERED FILL, COMPACTION OF FILL, ALL FOUNDATION EXCAVATION, AND TO PERFORM APPROPRIATE LABORATORY TESTING.
3. THE GEOTECHNICAL ENGINEER SHALL PROVIDE TO THE OWNER AND THE CITY OF STOCKTON A LETTER OF ACCEPTANCE FOR ALL FOUNDATION PREPARATION, BACKFILL, COMPACTION, ETC., PRIOR TO THE PLACEMENT OF ANY FOUNDATION CONCRETE. THE GEOTECHNICAL ENGINEER SHALL ALSO PREPARE A FINAL COMPREHENSIVE REPORT THAT STATES THAT ALL WORK WAS DONE IN COMPLIANCE WITH THE RECOMMENDATIONS MADE IN THE GEOTECHNICAL REPORT. THAT ITEMS THAT ITEMS ALL CHANGES MADE DURING FOUNDATION CONSTRUCTION THAT WERE DIFFERENT FROM THE REVIEWED GEOTECHNICAL REPORT.
4. BUILDING FOOTING DESIGN CAPACITIES:
 - DEAD + LIVE LOAD BEARING PRESSURE: 1,000 PSF
 - DEAD + WIND / SEISMIC BEARING PRESSURE: 1,333 PSF
- MANHOLE/VAULT DESIGN CAPACITY:
 - DEAD + LIVE LOAD BEARING PRESSURE: 1,500 PSF
- PUMP STATION DESIGN CAPACITY:
 - DEAD + LIVE LOAD BEARING PRESSURE: 3,000 PSF
5. SIDES OF FOOTINGS SHOWN STRAIGHT ARE FORMED. IF SITE CONDITION ALLOWS AND GEOTECHNICAL ENGINEER CONCURS, SIDES OF FOOTINGS MAY BE FORMED OR NOT FORMED AT CONTRACTOR'S OPTION. FOOTINGS CAST DIRECTLY AGAINST EARTH REQUIRE THE FOLLOWING PRECAUTIONS: A) SLOPE SIDES OF EXCAVATIONS AS APPROVED BY THE GEOTECHNICAL ENGINEER; B) CLEAN UP OF SLOUGHING BEFORE, DURING AND AFTER PLACING CONCRETE; C) ADEQUATE COVER MUST BE PROVIDED FOR ALL REBAR. ADD 1" TO ALL SIDES OF FOOTING DIMENSIONS WHICH ARE CAST AGAINST EARTH.

CONCRETE

1. ALL CONCRETE SHALL BE MIXED AND PLACED IN ACCORDANCE WITH ACI 318. USE MIXES WITH MAXIMUM AGGREGATE SIZE APPROPRIATE FOR FORM REBAR CLEARANCES TO BE ENCOUNTERED (SEE A.C.I.).
2. THE PROPOSED MATERIALS AND MIX DESIGN SHALL BE FULLY DOCUMENTED AND REVIEWED BY THE OWNER'S TESTING LABORATORY. IT IS THE CONTRACTOR'S RESPONSIBILITY TO OBTAIN THE REQUIRED DESIGN STRENGTH, SUBMITTAL DATA FROM 30 PREVIOUS COMPRESSION TESTS ON EACH PROPOSED MIX WILL BE REQUIRED FOR REVIEW BEFORE MIX CAN BE APPROVED.
3. ALL CONCRETE SHALL HAVE THE FOLLOWING MINIMUM 28-DAY STRENGTHS, U.N.O.
 - FOOTINGS AND BUILDING SLABS, TOP SLABS 4,000 PSI
 - MISCELLANEOUS SITE CONCRETE 2,500 PSI
4. SCHEDULING OF WORK MAY REQUIRE DESIGN STRENGTH TO BE ACHIEVED IN LESS THAN 28 DAYS. CONTRACTOR SHALL COORDINATE MIX DESIGN AND CONCRETE CYCLING BREAKS WITH THE OWNER'S TESTING LABORATORY.
5. CONSTRUCTION JOINTS SHALL BE INTENTIONALLY ROUGHENED BY SAND BLASTING OR MECHANICAL MEANS AND CLEANED BEFORE NEW POUR. LOCATION TO BE APPROVED BY THE STRUCTURAL ENGINEER.
6. BACKFILLING OF PUMP STATION, VAULTS, MANHOLE, OR JUNCTION STRUCTURE WALLS AND TOP SLABS SHALL NOT OCCUR UNTIL CONCRETE HAS ATTAINED DESIGN STRENGTH.

NOTES:

1. D = 6d FOR #3 THRU #8
D = 8d FOR #9 THRU #11
D = 10d FOR #14 THRU #18
 2. ALL BENDS SHALL BE MADE COLD.
 3. #14 AND #18 BARS SHALL BE BEND-TESTED AND APPROVED PRIOR TO BENDING.
-
- 135° HOOK TIE OR STIRRUP
90° HOOK TIE OR STIRRUP
MAX. OFFSET REINFORCING
TIE & STIRRUP REINFORCING
PRINCIPLE REINFORCING

DETAIL 1
NTS

CONCRETE UNIT MASONRY

1. ALL CONCRETE UNIT MASONRY SHALL BE GROUTED SOLID.
2. MASONRY UNIT DESIGN STRENGTH f_m = 1,500 PSI.
3. THE PROPOSED MATERIALS GROUT AND MORTAR MIX DESIGNS SHALL BE FULLY DOCUMENTED AND REVIEWED BY THE OWNER'S TESTING LABORATORY. IT IS THE CONTRACTOR'S RESPONSIBILITY TO OBTAIN THE REQUIRED STRENGTH.

REINFORCING STEEL

1. REINFORCING STEEL SHALL BE ASTM A615, GRADE 60 DEFORMED BARS, U.N.O. REINFORCING STEEL TO BE WELDED SHALL BE ASTM A706.
2. ALL REINFORCING STEEL AND EMBEDMENTS TO BE HELD SECURELY IN PLACE PRIOR TO PLACING CONCRETE. PROVIDE SUFFICIENT SUPPORTS TO ALLOW WALKING ON REINFORCEMENT.
3. WELDING OF REINFORCING IS PROHIBITED UNLESS EXPLICITLY SHOWN ON THE DRAWINGS OR APPROVED IN WRITING BY THE STRUCTURAL ENGINEER.
4. PROVIDE CONTINUOUS REINFORCEMENT WHEREVER POSSIBLE, PLACE ONLY AS SHOWN OR APPROVED, STAGGER SPLICES WHERE POSSIBLE.

STRUCTURAL STEEL

1. MATERIAL SPECIFICATIONS:
 - WIDE FLANGE BEAMS: ASTM A992, F_y = 50 KSI
 - ALL OTHER ROLLED SHAPES AND PLATES: ASTM A36, F_y = 36 KSI
 - ALL BASE PLATES, ANGLES AND MISCELLANEOUS STEEL: ASTM A36, F_y = 36 KSI U.N.O.
 - MACHINE BOLTS: ASTM A307, U.N.O.
 - HIGH STRENGTH BOLTS: ASTM A325SC, U.N.O.
 - HEADED ANCHOR STUDS: ASTM A108
2. ALL STRUCTURAL STEEL TO BE DETAILED, FABRICATED AND ERRECTED IN ACCORDANCE WITH AISC SPECIFICATIONS
3. ALL WELDING TO CONFORM TO AWS D1.1 AND TO BE PERFORMED BY CERTIFIED WELDERS.
4. ALL GROOVE AND BUTT WELDS TO BE COMPLETE PENETRATION U.N.O.
5. BOLT HOLES SHALL BE NO MORE THAN 1/16" OVERSIZE, U.N.O.
6. CONTRACTOR SHALL SUBMIT DETAILED SHOP DRAWINGS PER SPECIFICATIONS TO THE ENGINEER FOR REVIEW PRIOR TO FABRICATION.

METAL DECKING

1. METAL DECKING SHALL BE 1 1/2" DEEP x 18 GA. HSB-36 AS MANUFACTURED BY VERCO MANUFACTURING CO., PHOENIX, ARIZONA. DECK PANELS ARE TO BE THREE-SPAN CONTINUOUS WHEREVER POSSIBLE, ONE-SPAN ONLY WHERE UNAVOIDABLE. DECKING AND ALL ACCESSORIES SHALL BE FORMED FROM STEEL SHEETS HAVING A MINIMUM YIELD STRENGTH OF 38,000 PSI AND CONFORMING TO ASTM A446, GRADE A. THE STEEL SHALL HAVE A METAL PROTECTIVE COATING OF ZINC CONFORMING TO LIGHT COMMERCIAL DECKING.
2. WELD METAL DECK TO SUPPORTS AT ROOF AS FOLLOWS:
 - A. WHERE SUPPORTS ARE PERPENDICULAR TO FLUTES:
 - PLUG WELDS WITH AN EFFECTIVE FUSION DIAMETER OF 1/2" AT EACH FLUTE AT EACH INTERMEDIATE SUPPORT AND EACH SHEET END (MIN. OF 4-SPOT WELDS PER 3'-0" SHEET).
 - B. WHERE SUPPORTS ARE PARALLEL TO FLUTES:
 - PLUG WELDS WITH AN EFFECTIVE FUSION DIAMETER OF 1/2" AT EACH FLUTE AT 12" O.C. WHERE FLUTES DO NOT LAND ON SIDE SUPPORTS, CUT SHEET AND PROVIDE CLOSURE PLATES.
 - C. ALL SIDE SEAMS SHALL BE BUTT-PUNCHED AT 24" O.C., MAX.
3. MINIMUM BEARING OF DECKING SHALL BE 2".

GRATING

GRATING SHALL BE EITHER ALUMINUM OR GALVANIZED STEEL AS NOTED IN THESE DRAWINGS. SEE DRAWINGS & PROJECT SPECS. FOR GRATING SIZES & OTHER REQUIREMENTS. GRATING IS TO SAFELY SUSTAIN A UNIFORMLY DISTRIBUTED LOAD OF 100 POUNDS PER SQUARE FOOT AND DEFLECT LESS THAN 0.25 INCHES. GRATING SHALL HAVE BANDING AT ALL EDGES AND SHALL BE MADE UP OF MULTIPLE GRATING PANELS. EACH PANEL SHALL BE FASTENED WITH A MINIMUM OF 4 CLIPS.

DEFERRED SUBMITTALS/SHOP DRAWINGS

THE FOLLOWING ITEMS SHALL BE SUBMITTED TO THE ENGINEER FOR REVIEW:

1. CONCRETE MIX DESIGNS.
2. UNIT MASONRY SHOP DRAWINGS, GROUT MIX DESIGNS AND CERTIFICATIONS OF COMPLIANCE.
3. BAR REINFORCING STEEL SHOP DRAWINGS.
4. STRUCTURAL STEEL & ALUMINUM SHOP DRAWINGS.
5. WELDING PROCEDURE SPECIFICATIONS, WELDING ELECTRODE DATA, & WELDER QUALIFICATIONS.
6. METAL DECKING SHOP DRAWINGS.

SPECIAL INSPECTIONS

SPECIAL INSPECTIONS
THE OWNER SHALL EMPLOY A SPECIAL INSPECTOR DURING CONSTRUCTION ON THE FOLLOWING PHASES OF WORK:

EXPANSION BOLTS (WHERE NOTED ON THE PLANS)
- DURING INSTALLATION OF EXPANSION BOLTS, INCLUDING DIAMETER OF HOLE, DEPTH OF EMBEDMENT AND TORQUING OF BOLT.

CONCRETE
- DURING THE TAKING OF TEST SPECIMENS AND PLACING OF ALL REINFORCED CONCRETE.

EXCEPTIONS:
1. SITE WORK CONCRETE FULLY SUPPORTED ON EARTH WHERE NO SPECIAL HAZARD EXISTS.

BOLTS INSTALLED IN CONCRETE
- DURING INSTALLATION OF ANCHOR BOLTS AND EMBEDDED PLATES PLACING OF CONCRETE AROUND SUCH BOLTS AND EMBEDDED PLATES.

REINFORCING STEEL
- PERIODICALLY, DURING THE PLACING OF REINFORCING STEEL FOR ALL CONCRETE REQUIRED TO HAVE SPECIAL INSPECTION.

HIGH STRENGTH BOLTING
- DURING ALL BOLT INSTALLATIONS AND TIGHTENING OPERATIONS.

EXCEPTIONS:
1. THE SPECIAL INSPECTOR NEED NOT BE PRESENT DURING THE ENTIRE INSTALLATION AND TIGHTENING OPERATION, PROVIDED HE HAS:

- i) INSPECTED THE SURFACES AND BOLT TYPE FOR CONFORMANCE TO PLANS AND SPECIFICATIONS PRIOR TO START OF BOLTING.
- ii) AND WILL, UPON COMPLETION OF ALL BOLTING, VERIFY THE MINIMUM SPECIFIED BOLT TENSILE STRENGTH FOR EACH CONNECTION WITH A MINIMUM OF TWO BOLTS PER CONNECTION.

WELDING
- ALL STRUCTURAL WELDING, INCLUDING WELDING OF REINFORCING STEEL.

- NOTES:**
1. THE SPECIAL INSPECTOR NEED NOT BE CONTINUOUSLY PRESENT DURING WELDING OF THE FOLLOWING ITEMS, PROVIDED THE MATERIALS, QUALIFICATIONS OF WELDING PROCEDURES AND WELDERS ARE VERIFIED PRIOR TO THE START OF WORK; PERIODIC INSPECTIONS ARE MADE OF WORK IN PROGRESS; AND A VISUAL INSPECTION OF ALL WELDS IS MADE PRIOR TO THE COMPLETION OR PRIOR TO THE SHIPMENT OF SHOP WELDINGS:
 - SINGLE PASS FILLET WELDS NOT EXCEEDING 5/16 INCH (7.9mm) IN SIZE.
 - FLOOR AND ROOF DECK WELDING
 - WELDED STUD WHEN USED FOR STRUCTURAL DIAPHRAGM OR COMPOSITE SYSTEMS.
 - WELDED SHEET STEEL FOR COLD-FORMED STEEL FRAMING MEMBERS SUCH AS STUDS AND JOISTS.
 - WELDING OF STAIR AND RAILING SYSTEMS.

EPOXY ANCHORS AND DOWELS
- DURING ALL ANCHOR AND DOWEL INSTALLATIONS, U.N.O. ON THE DRAWINGS. SPECIAL INSPECTOR SHALL VERIFY THE FOLLOWING:

- HOLE DIAMETER AND DEPTH;
- CLEANLINESS OF HOLE AND ANCHOR;
- ADHESIVE TYPE AND APPLICATION;
- ANCHOR DIAMETER, EMBEDMENT AND GRADE OF STEEL;
- OTHER REQUIREMENTS SPECIFIED IN THE APPROPRIATE I.C.B.O. REPORT, IN THE MANUFACTURER'S LITERATURE AND ON THE DRAWINGS.

STRUCTURAL MASONRY
1. FOR MASONRY OTHER THAN FULLY GROUTED OPEN-END HOLLOW-UNIT MASONRY, DURING PREPARATION AND TAKING OF ANY REQUIRED PRISMS OR TEST SPECIMENS, PRIOR TO THE PLACEMENT OF ALL MASONRY UNITS, DURING THE PLACEMENT OF REINFORCING STEEL, IMMEDIATELY PRIOR TO CLOSING OF CLEANOUTS, PRIOR TO EACH GROUTING OPERATION, AND DURING ALL GROUTING OPERATIONS.

EXCEPTION: FOR HOLLOW-UNIT MASONRY WHERE THE f_m IS NO MORE THAN 1,500 PSI, SPECIAL INSPECTION MAY BE PERFORMED AS REQUIRED FOR FULLY GROUTED OPEN-END HOLLOW-UNIT MASONRY SPECIFIED IN ITEM 2 BELOW.

2. FOR FULLY GROUTED OPEN-END HOLLOW-UNIT MASONRY, DURING PREPARATION AND TAKING OF ANY REQUIRED PRISMS OR TEST SPECIMENS, AT THE START OF LAYING UNITS, AFTER THE PLACEMENT OF REINFORCING STEEL, PRIOR TO EACH GROUTING OPERATION, AND DURING ALL GROUTING OPERATIONS.

3. DESIGN IS BASED ON f_m = 1500 psi, FULL ALLOWABLE STRESSES.

4. VERIFICATION OF f_m SHALL BE BY MEANS OF THE UNIT STRENGTH METHOD AS OUTLINED IN CBC SECTION 2105.3.4.


5. THE SPECIAL INSPECTOR SHALL VERIFY THE FOLLOWING:
- STORAGE OF MATERIALS
 - CERTIFICATES FOR MASONRY UNITS AND GROUT
 - TYPE OF MORTAR
 - BLOCK LAYOUT (DIMENSIONS)
 - REINFORCING GRADE, SIZE, AND PLACEMENT
 - ANCHOR AND REINFORCING DOWEL LOCATIONS AND EMBEDMENTS
 - PREPARATION OF CONTROL JOINTS AND CONSTRUCTION JOINTS
 - MORTAR JOINT TOOLING
 - CLEANLINESS OF CELLS
 - VIBRATION EQUIPMENT AND OPERATIONS
 - GROUTING LIMITATIONS IN ACCORDANCE WITH UBC TABLE 21-C

SPECIAL INSPECTOR
- THE SPECIAL INSPECTOR SHALL BE A QUALIFIED PERSON WHO SHALL DEMONSTRATE HIS COMPETENCE, TO THE SATISFACTION OF THE BUILDING OFFICIAL, FOR INSPECTION OF A PARTICULAR TYPE OF CONSTRUCTION OR OPERATION REQUIRING SPECIAL INSPECTION.

DUTIES AND RESPONSIBILITIES OF THE SPECIAL INSPECTOR
- THE SPECIAL INSPECTOR SHALL OBSERVE THE WORK ASSIGNED FOR CONFORMANCE WITH THE APPROVED DESIGN DRAWINGS AND SPECIFICATIONS.

- THE SPECIAL INSPECTOR SHALL FURNISH INSPECTION REPORTS TO THE BUILDING OFFICIAL, THE ENGINEER OR ARCHITECT OF RECORD, AND OTHER DESIGNATED PERSONS. ALL DISCREPANCIES SHALL BE BROUGHT TO THE IMMEDIATE ATTENTION OF THE CONTRACTOR FOR CORRECTION, THEN, IF UNCORRECTED, TO THE PROPER DESIGN AUTHORITY AND TO THE BUILDING OFFICIAL.


- THE SPECIAL INSPECTOR SHALL SUBMIT A FINAL SIGNED REPORT STATING WHETHER THE WORK REQUIRING SPECIAL INSPECTION WAS, TO THE BEST OF THE INSPECTOR'S KNOWLEDGE, IN CONFORMANCE WITH THE APPROVED PLANS AND SPECIFICATIONS AND THE APPLICABLE WORKMANSHIP PROVISIONS OF THE CODE.

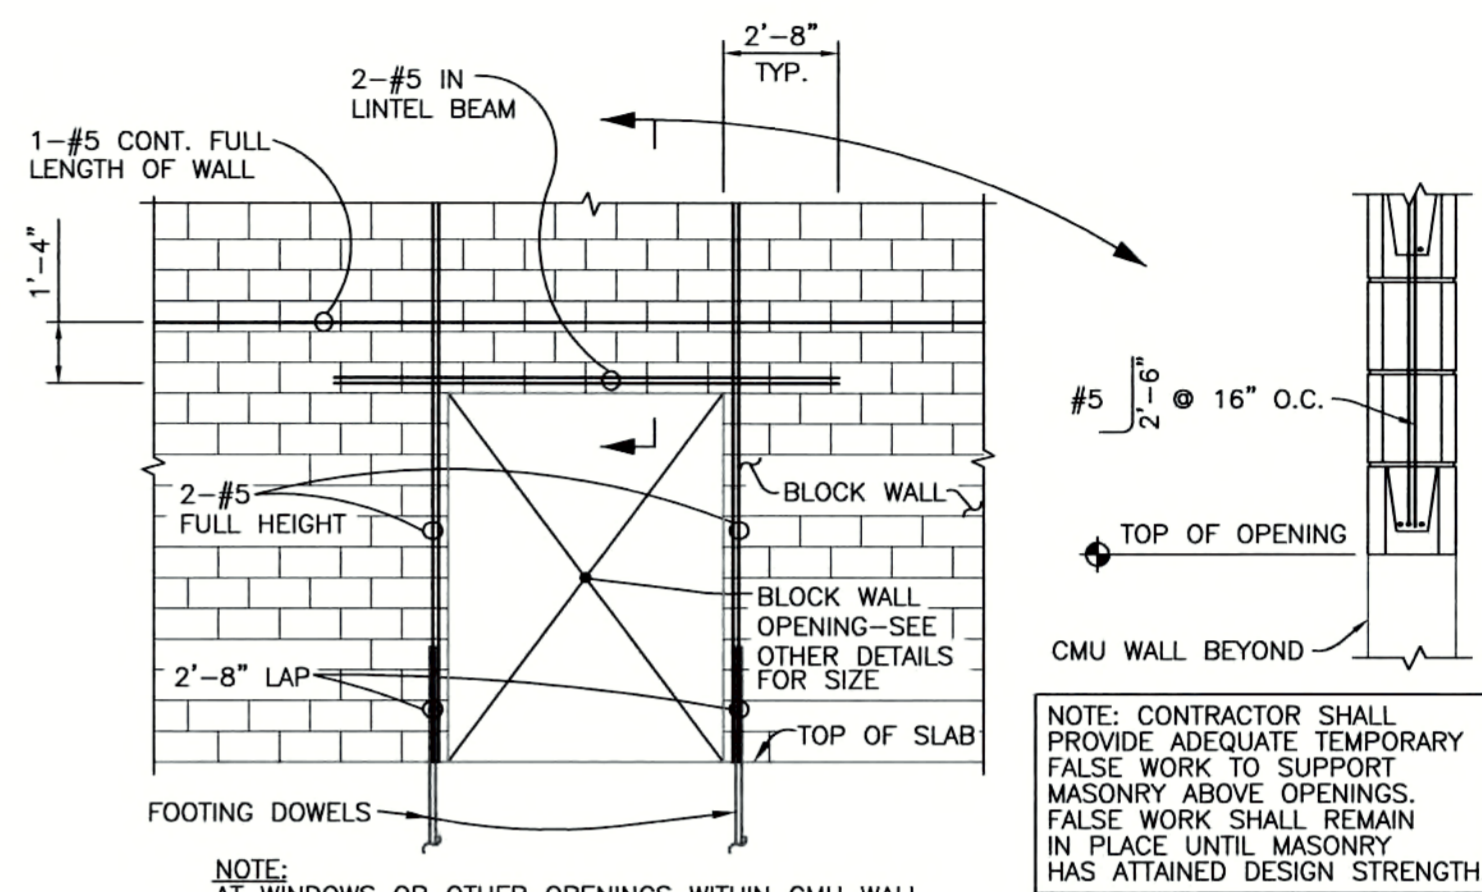

NOTE: AT WINDOWS OR OTHER OPENINGS WITHIN CMU WALL, PROVIDE 2-#5 BARS IN SILL BOND BEAM SIMILAR TO THOSE SHOWN IN LINTEL BEAM.

TYPICAL REINF. AROUND OPENING IN CMU WALL OVER 16" SQUARE

DETAIL 4
NTS

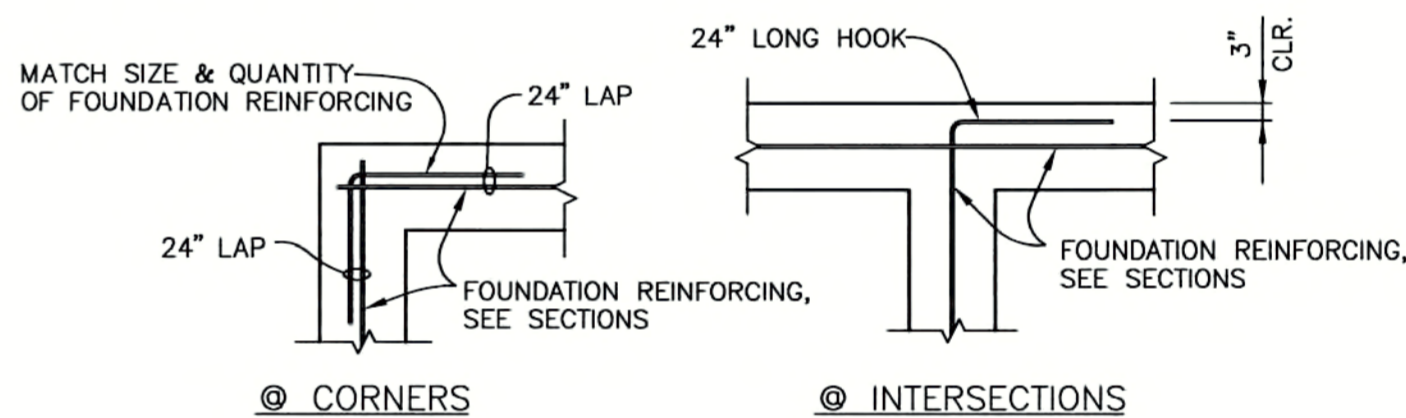


DETAIL 5
NTS

REINFORCING LAP SPLICES		
CONCRETE STRENGTH	f _c = 4000 PSI	
BAR SIZE	TOP BARS	OTHER BARS
#3	1'-4"	1'-4"
#4	1'-8"	1'-4"
#5	2'-1"	1'-7"
#6	2'-5"	1'-11"
#7	3'-7"	2'-9"
#8	4'-1"	3'-1"
#9	4'-7"	3'-6"
#10	5'-2"	3'-11"
#11	5'-8"	4'-5"

- NOTES:**
1. LAP SPLICE LENGTHS SHALL BE INCREASED BY 50% WHERE BAR CLEAR COVER IS LESS THAN 2 BAR DIAMETERS OR WHERE SPACING BETWEEN BARS BEING SPLICED IS LESS THAN 5 BAR DIAMETERS.
 2. TOP BARS ARE HORIZONTAL BARS WITH MORE THAN 12 INCHES OF CONCRETE CAST BELOW THE BARS.

DETAIL 6
NTS

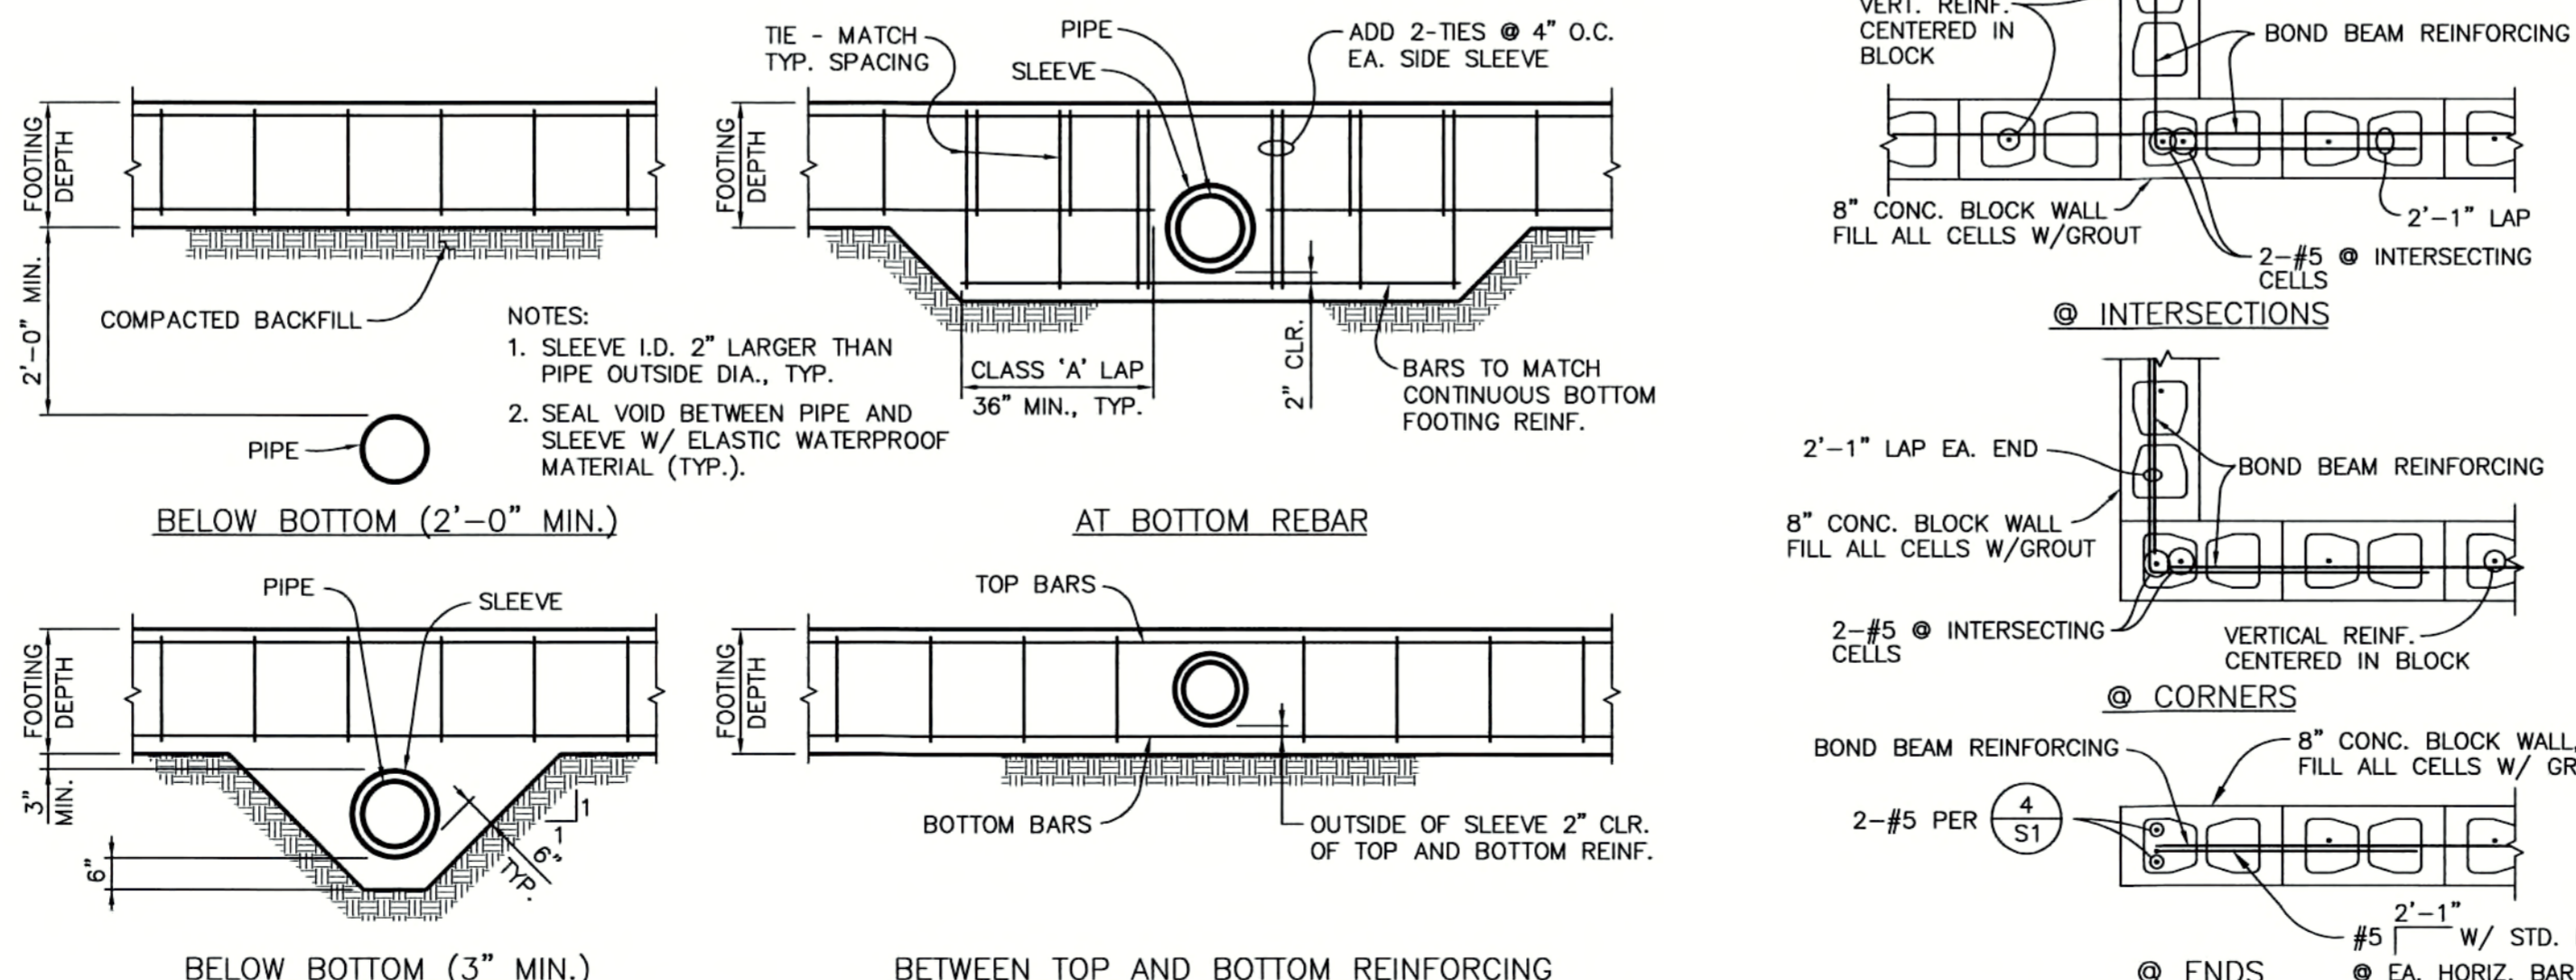

DETAIL 1
NTS

DETAIL 2
NTS

DETAIL 3
3/4" = 1'-0"

RECORD DRAWINGS
14-Mile Slough Pump Station Upgrades
GENERAL NOTES, SPECIFICATIONS & TYPICAL DETAILS



REFER TO BID SET FOR SIGNATURE


REV. No.	DISCRPTION	DATE	By	Apr'd By



1260 Lake Boulevard
Suite 240
Davis, California 95616
(530) 756-5905
FAX (530) 756-5991


DEPARTMENT OF MUNICIPAL UTILITIES CITY OF STOCKTON, CALIFORNIA	
SCALE: AS SHOWN	APPROVED BY: DATE: _____
DESIGNED BY: JAF	SHEET No. S1
DRAWN BY: REM	
CHECKED BY: JAF	PROJECT No. 293-00-05-01
RECORD Dwg.:	
ASSISTANT DIRECTOR, DEPT. OF MUNICIPAL UTILITIES	

N:\Clients\293\Sponos\00-05-01 14-MSPS Upgrades\CAD\Design\Asbuilt\05-147521.dwg 11-13-08 10:37:57 AM areimer

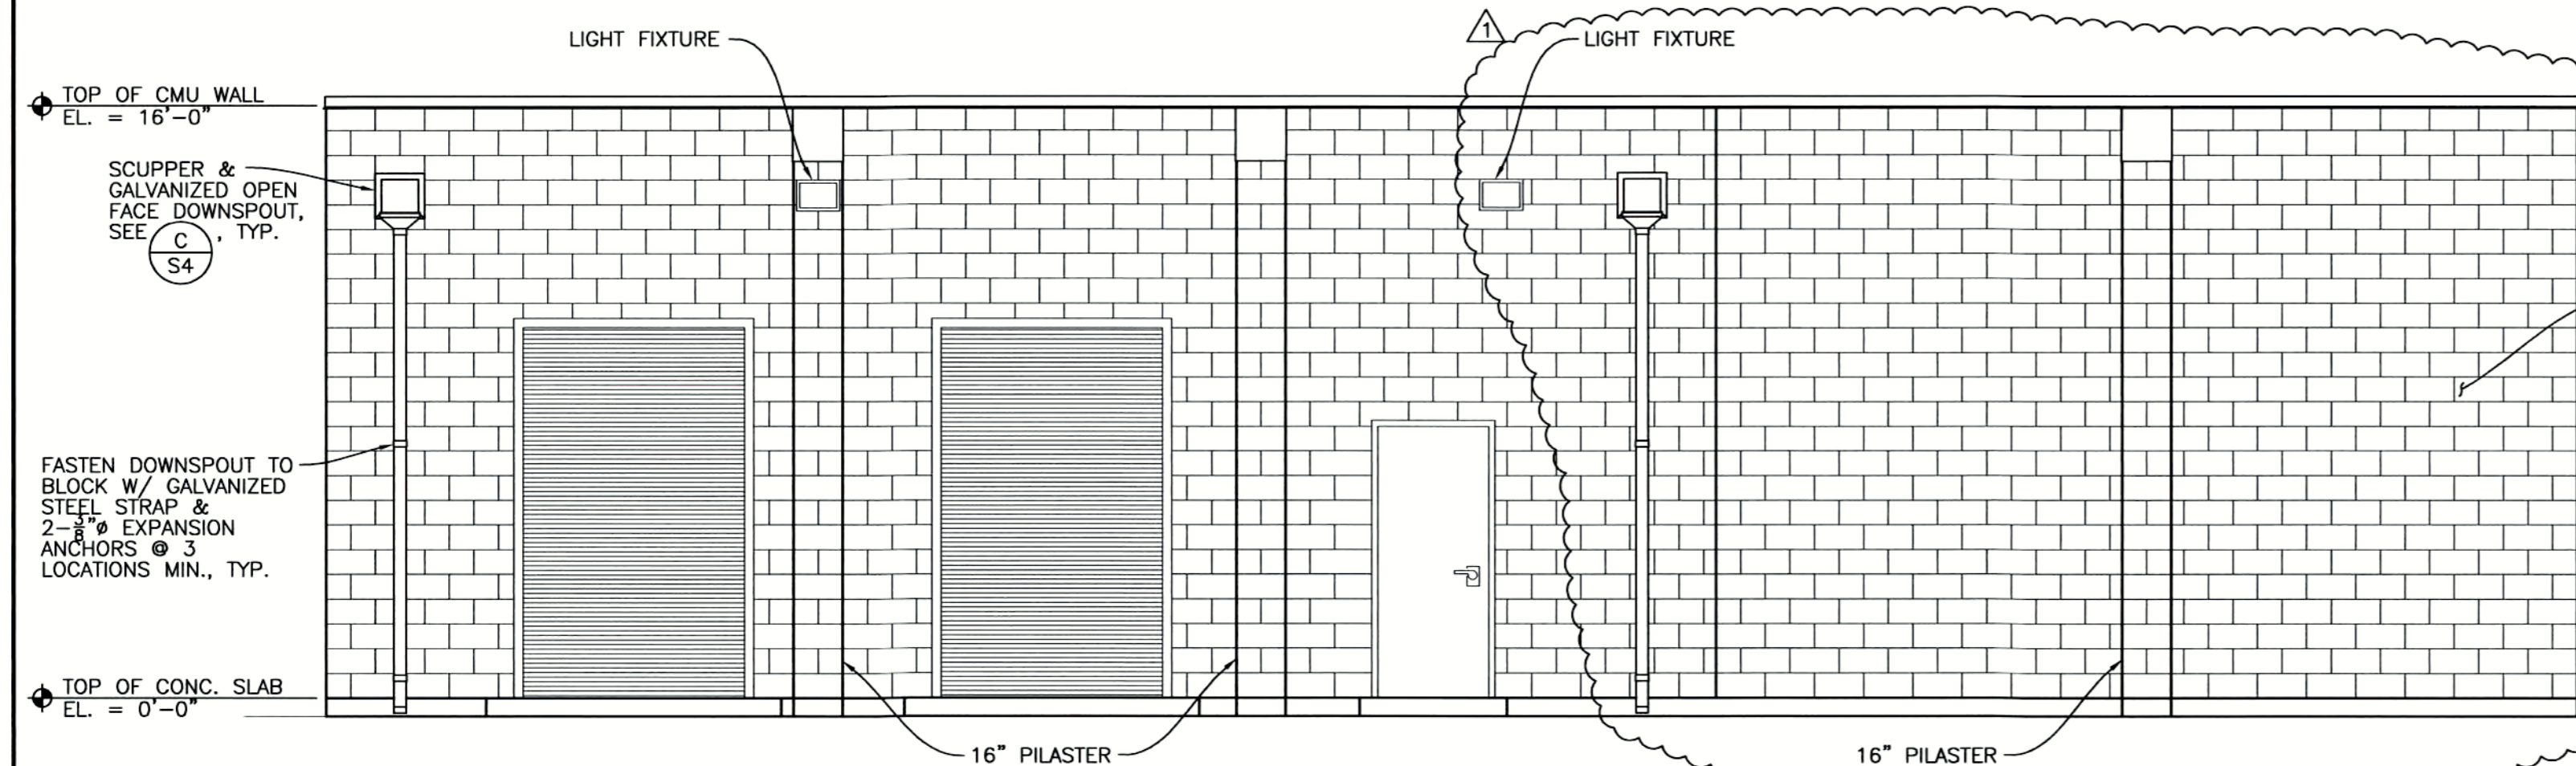


SOUTH ELEVATION

1/4" = 1'-0"

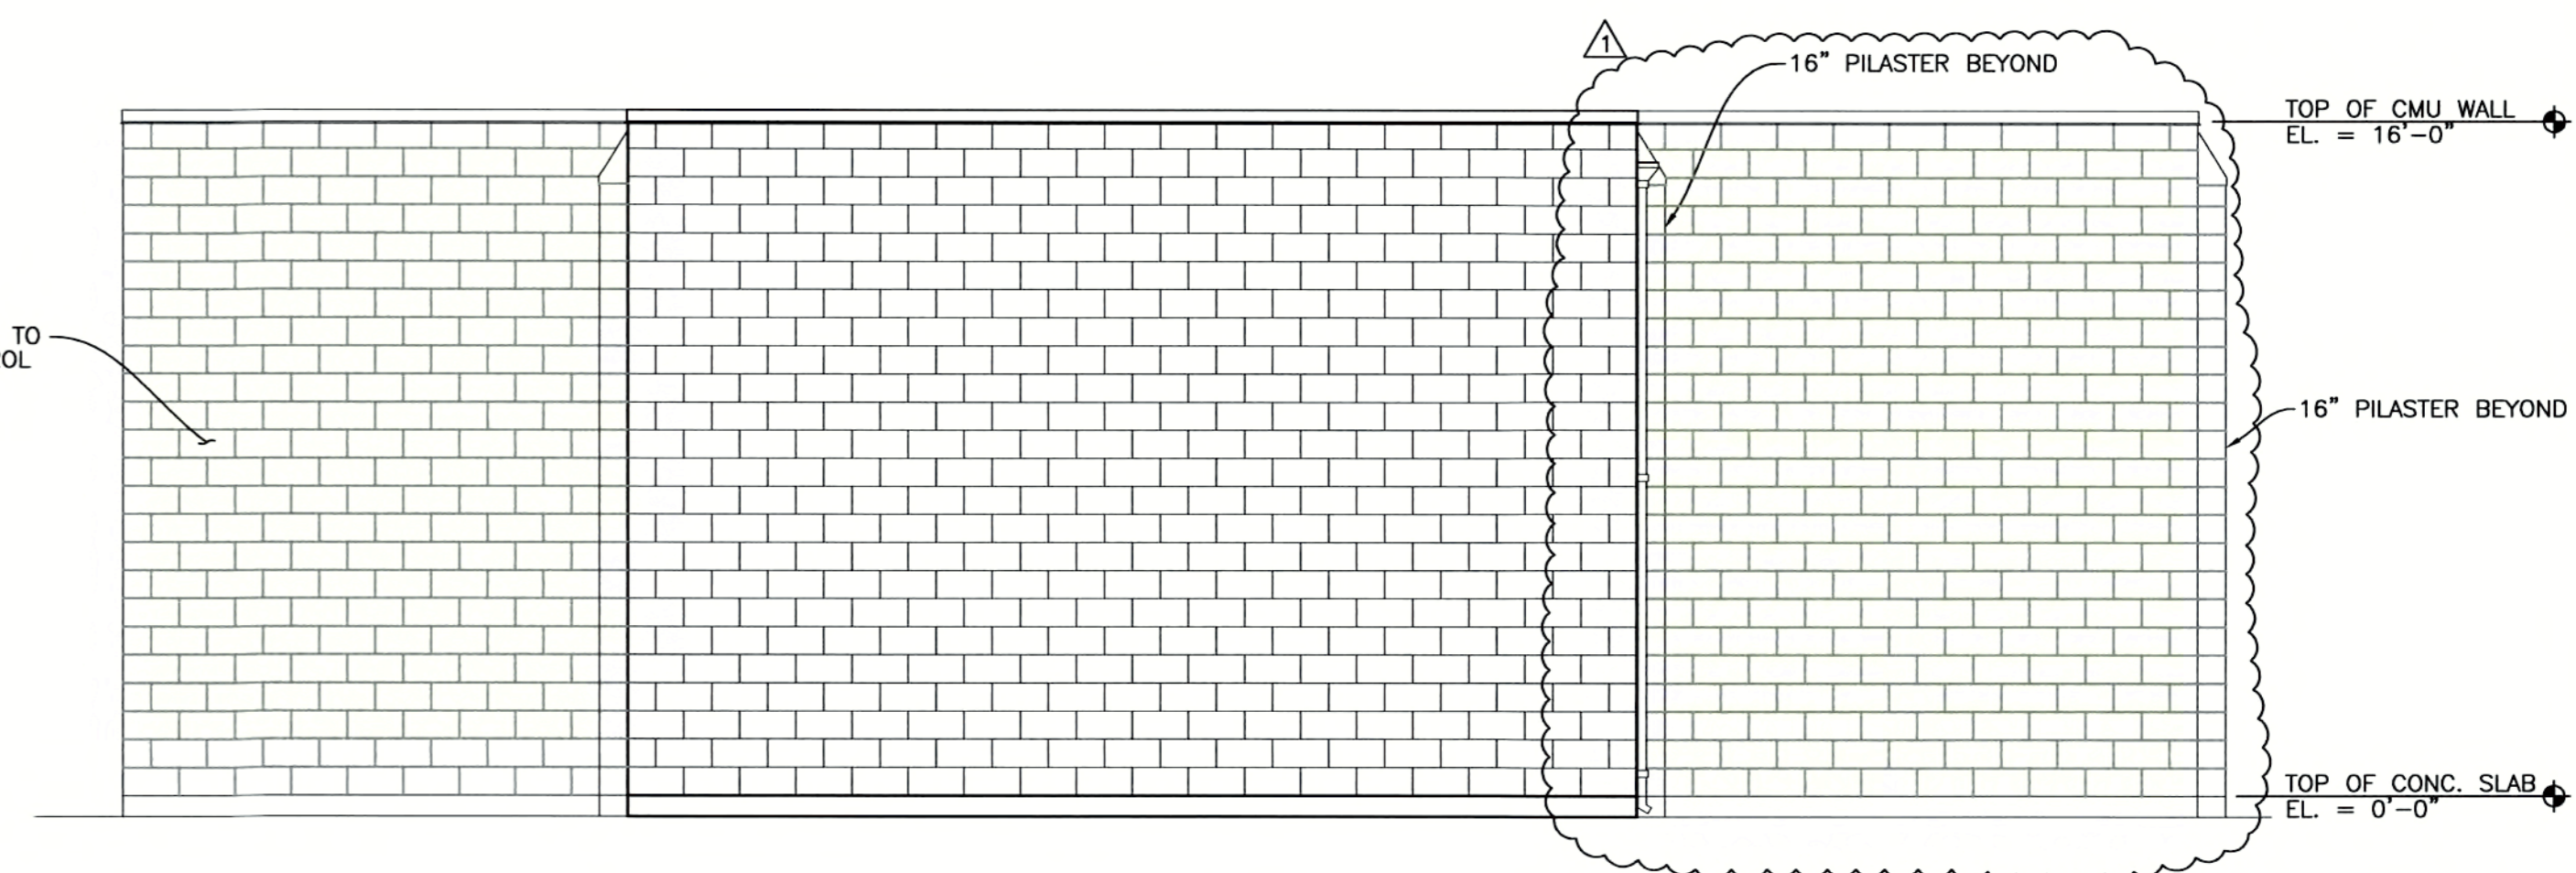


WEST ELEVATION

1/4" = 1'-0"

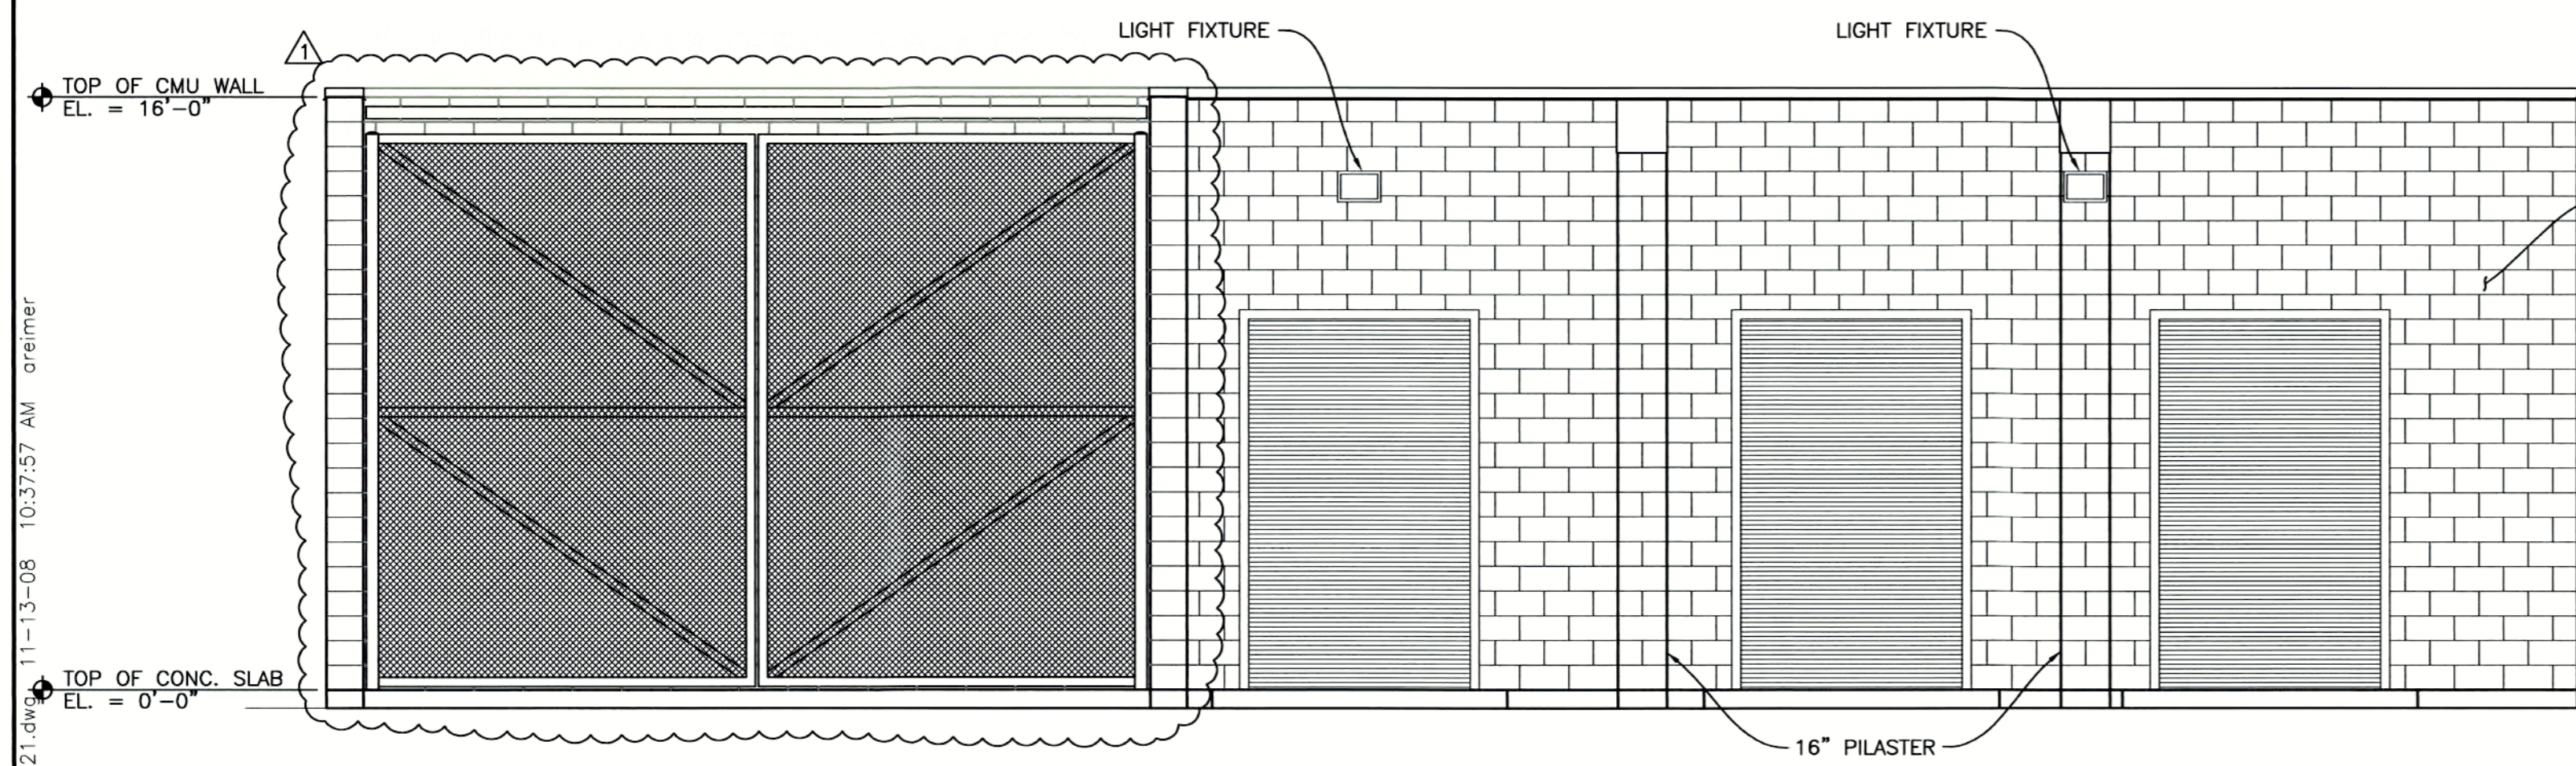

NORTH ELEVATION

1/4" = 1'-0"

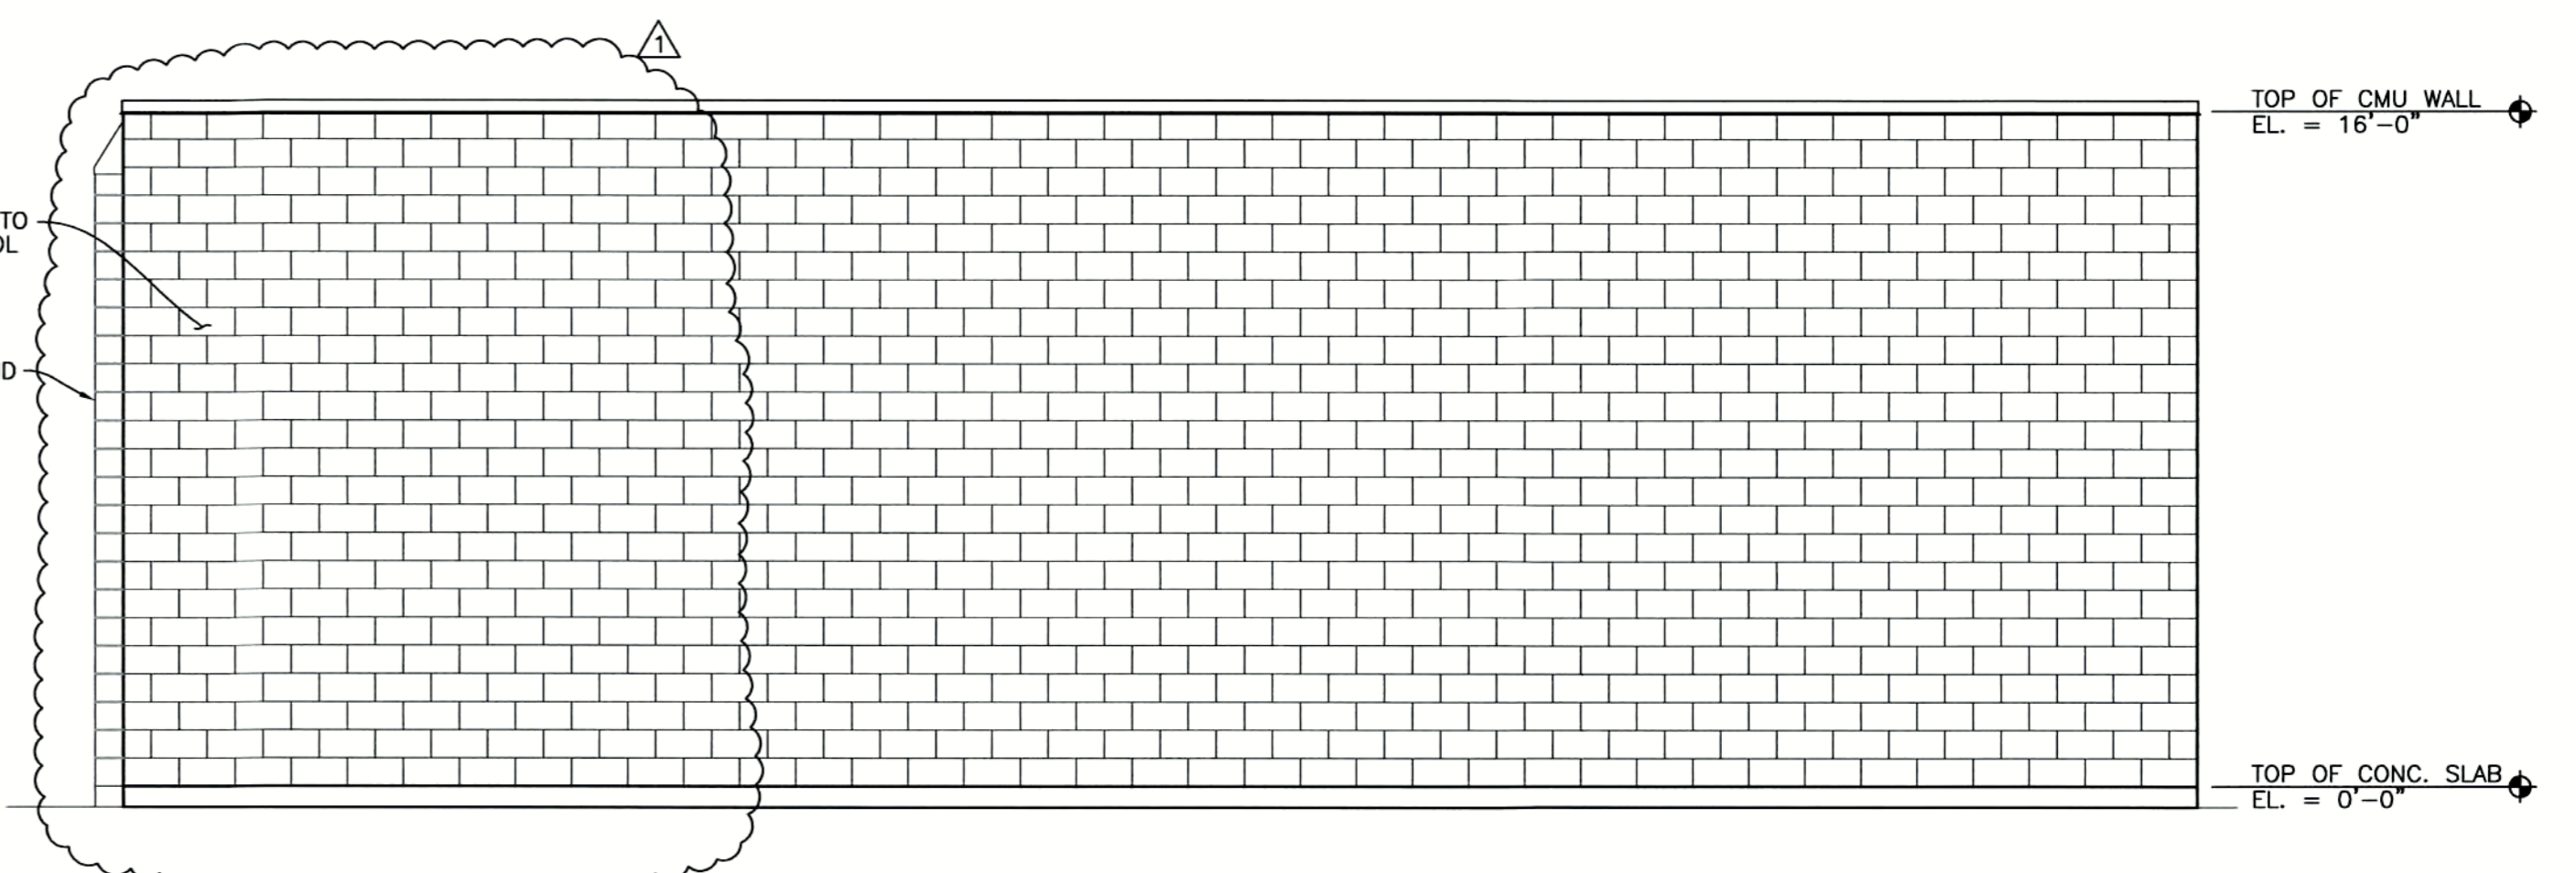

EAST ELEVATION

1/4" = 1'-0"

Underground Service Alert

TWO DAYS BEFORE YOU DIG

Call TOLL FREE: 1-800-642-2444

REFER TO BID SET FOR SIGNATURE

REV. No.	DISCRIPTION	DATE	BY	Aprv'd By
1	REVISED GENERATOR ENCLOSURE	2/5/07	JAF	PDF
2				
3				
4				
5				
6				

WEST YOST ASSOCIATES
Consulting Engineers

1260 Lake Boulevard
Suite 240
Davis, California 95616
(530) 756-5905
FAX (530) 756-5991



RECORD DRAWINGS

14-Mile Slough Pump Station Upgrades


BUILDING ELEVATIONS

DEPARTMENT OF MUNICIPAL UTILITIES
CITY OF STOCKTON, CALIFORNIA

SCALE: AS SHOWN	APPROVED BY: DATE: _____	SHEET No.
DESIGNED BY: JAF		S2.1
DRAWN BY: REM		32 of 89 SHEETS
CHECKED BY: JAF		PROJECT No. 293-00-05-01
RECORD Dwg.:	ASSISTANT DIRECTOR, DEPT. OF MUNICIPAL UTILITIES	

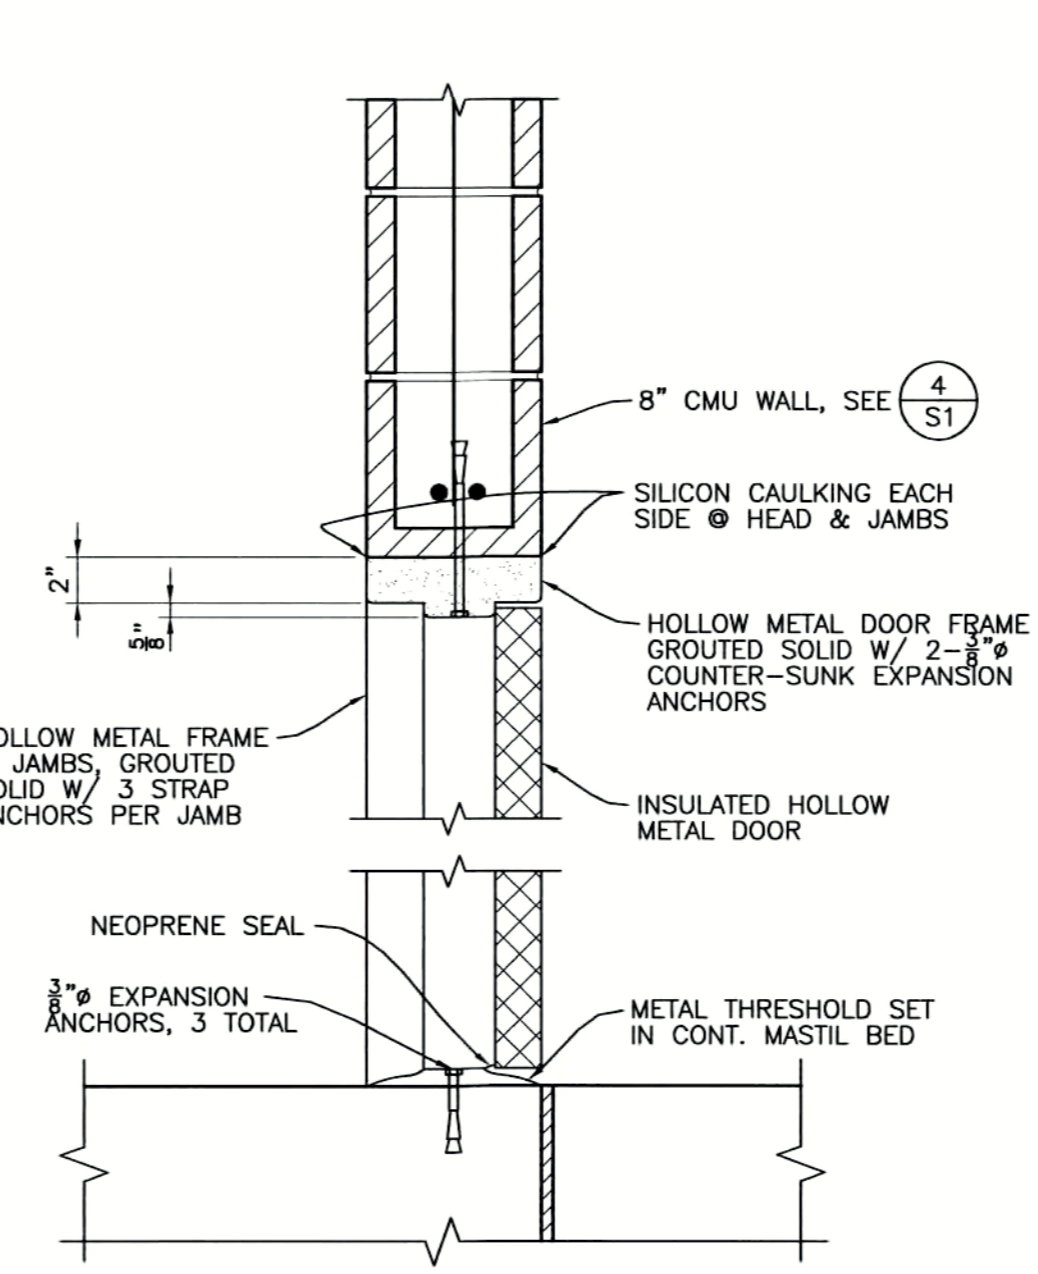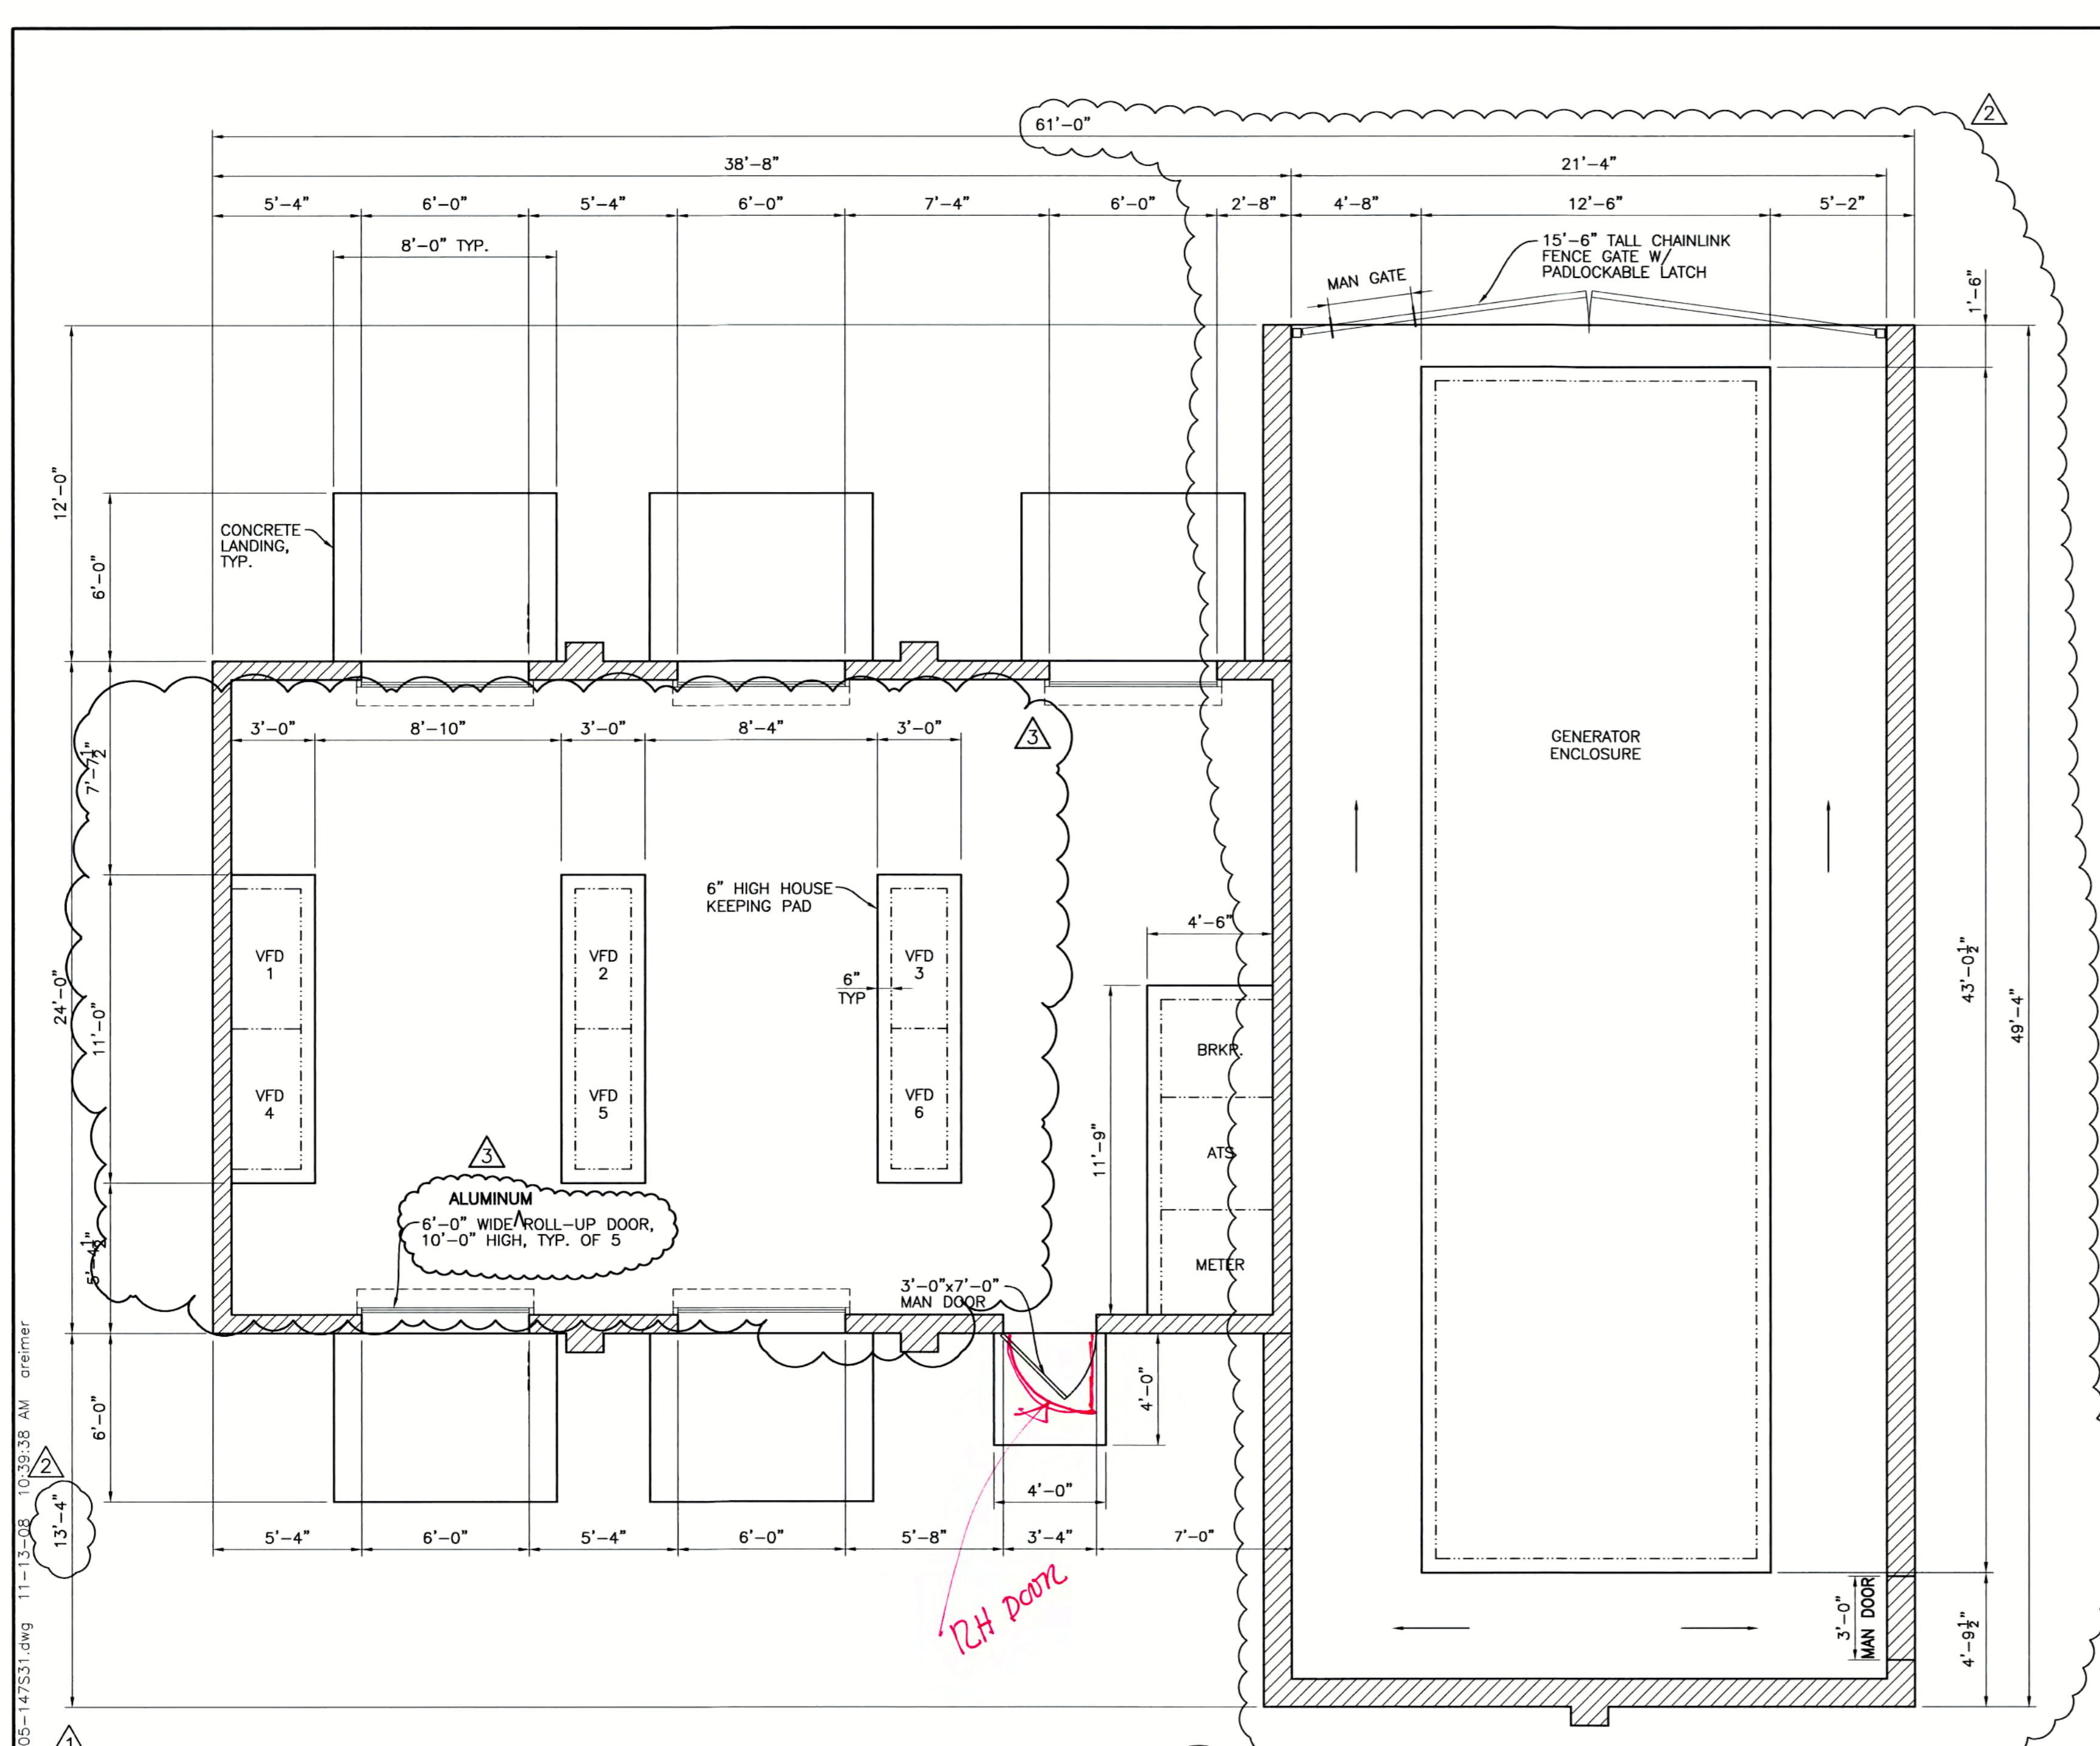

MAN-DOOR DETAIL
DETAIL 1
 1 1/2" = 1'-0" **S3.1**

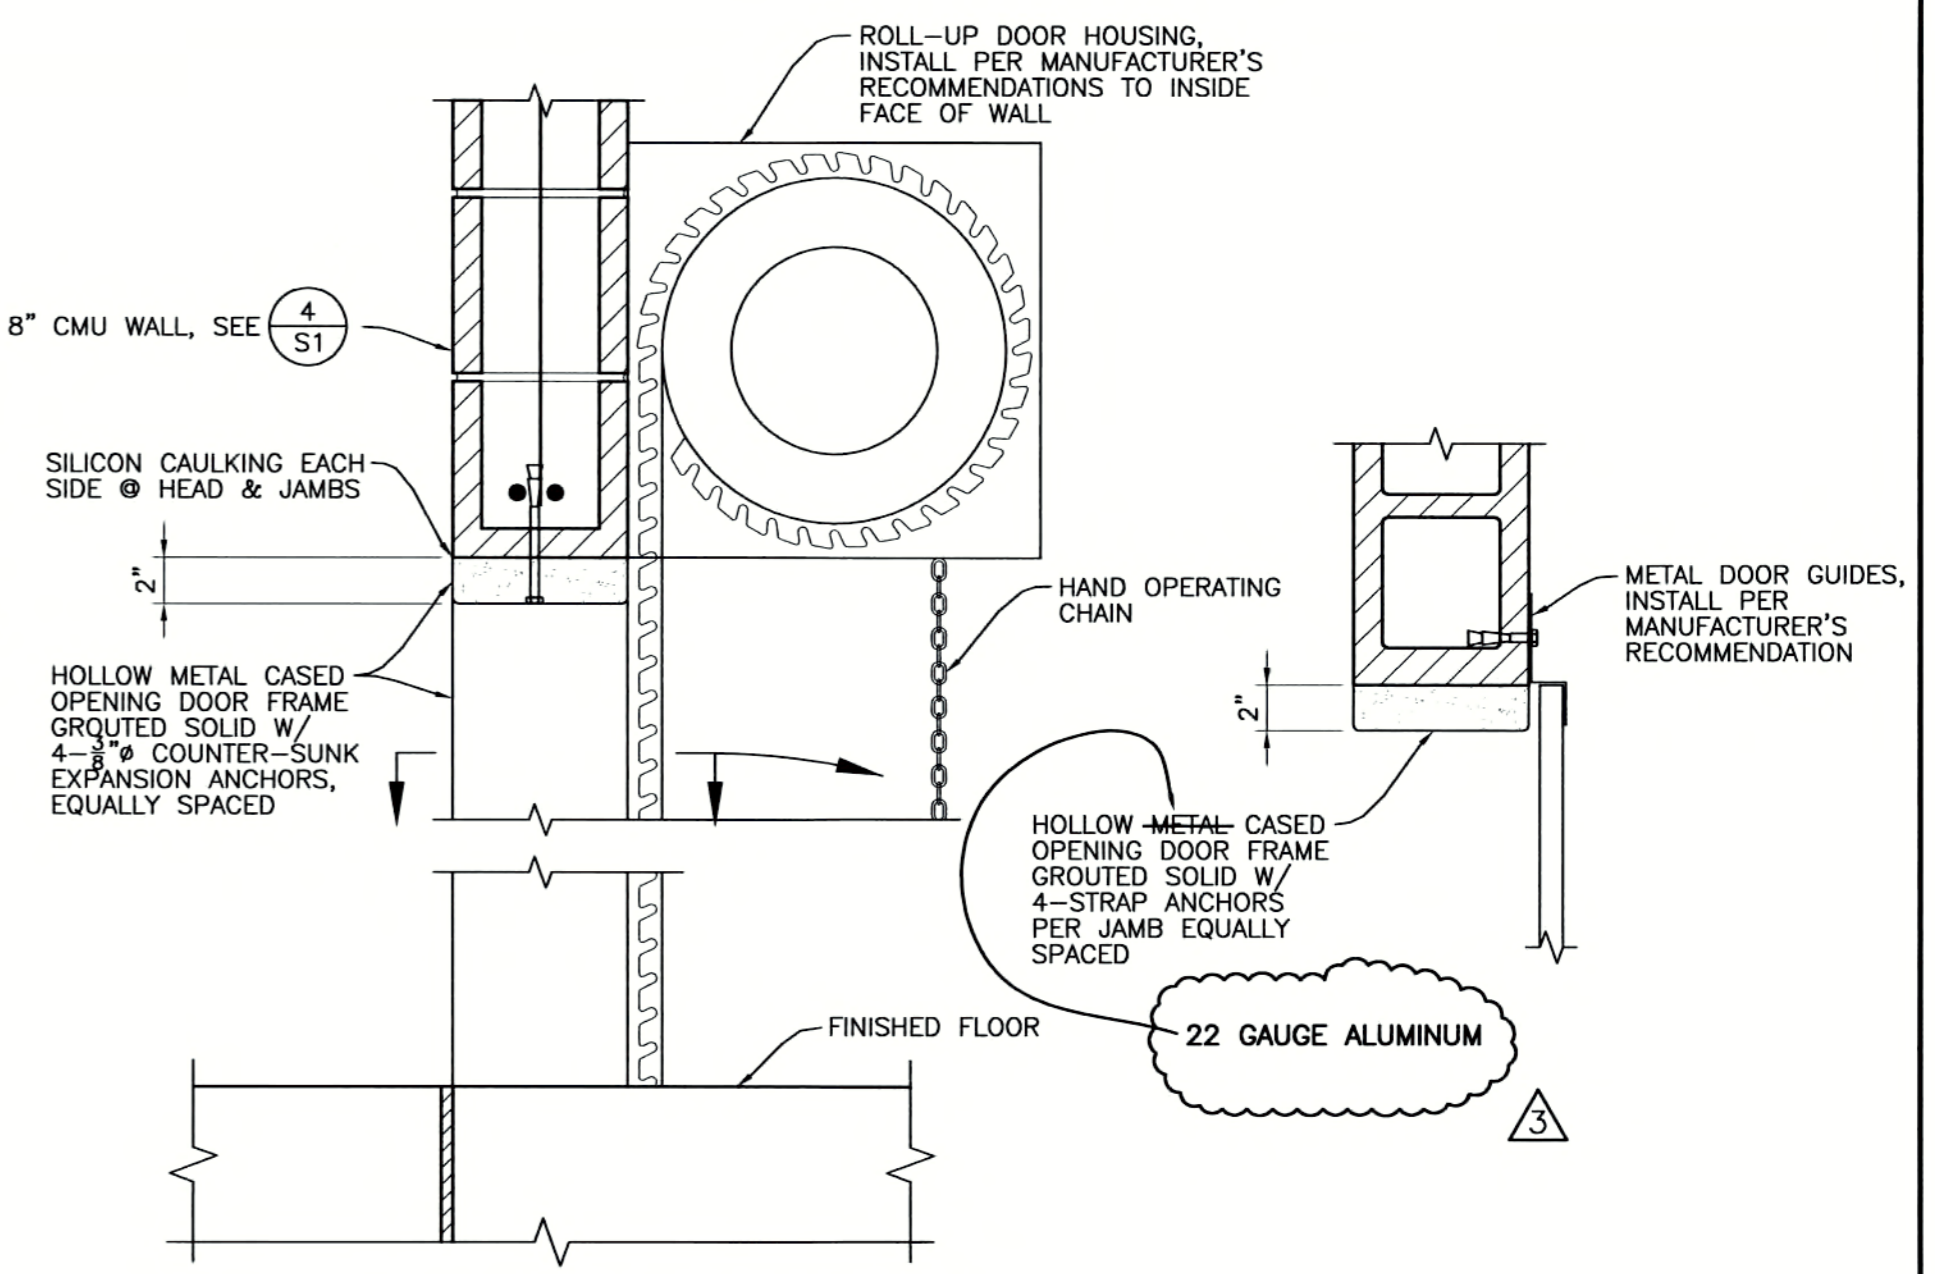

ROLL-UP-DOOR DETAIL
DETAIL 2
 1 1/2" = 1'-0" **S3.1**

NOTES
 1. THE CONTRACTOR SHALL PROVIDE THE CLEARANCES AROUND THE GENERATOR ENCLOSURE AS SHOWN HEREIN. IF CONTRACTOR'S PROPOSED GENERATOR SET REQUIRES EXPANSION OF THE CMU WALLS TO ACHIEVE THE CLEARANCES, THE CONTRACTOR SHALL INCLUDE ALL ADDITIONAL COSTS, INCLUDING BUT NOT LIMITED TO, ENGINEERING, DESIGN, CONSTRUCTION MATERIALS, AND LABOR IN THEIR BID PRICE.

FLOOR PLAN
 1/4" = 1'-0"

N:\Clients\233 - Sponosa\00-05-01 14-MSPS-Upgrade\CAD\Design\Asbuilt\05-147531.dwg 11-13-08 10:39:38 AM areimer

Underground Service Alert

TWO DAYS BEFORE YOU DIG
 Call TOLL FREE: 1-800-642-2444

REFER TO SET FOR SIGNATURE

REV. No.	DISCRIPTION	DATE	BY	Apr'd By
1	ADDENDUM NO. 3	5/25/06	JAF	PDF
2	REVISED GENERATOR ENCLOSURE	2/5/07	JAF	PDF
3	RECORD DRAWINGS	8/8/08	MAH	PDF

WEST YOST ASSOCIATES


 Consulting Engineers
 1260 Lake Boulevard
 Suite 240
 Davis, California 95616
 (530) 756-5905
 FAX (530) 756-5991

RECORD DRAWINGS
14-Mile Slough Pump Station Upgrades
FLOOR PLAN


DEPARTMENT OF MUNICIPAL UTILITIES
 CITY OF STOCKTON, CALIFORNIA

SCALE: AS SHOWN	APPROVED BY: DATE: _____	SHEET No. S3.1
DESIGNED BY: JAF		33 of 89 SHEETS
DRAWN BY: REM		PROJECT No. 293-00-05-01
CHECKED BY: JAF	ASSISTANT DIRECTOR, DEPT. OF MUNICIPAL UTILITIES	
RECORD Dwg.:		


N:\Clients\293_Sporos\00-05-01_14-WSFS Upgrades\CAD\Design\Submittals\05-147S41.dwg 11-13-08 10:44:10 AM oreimer

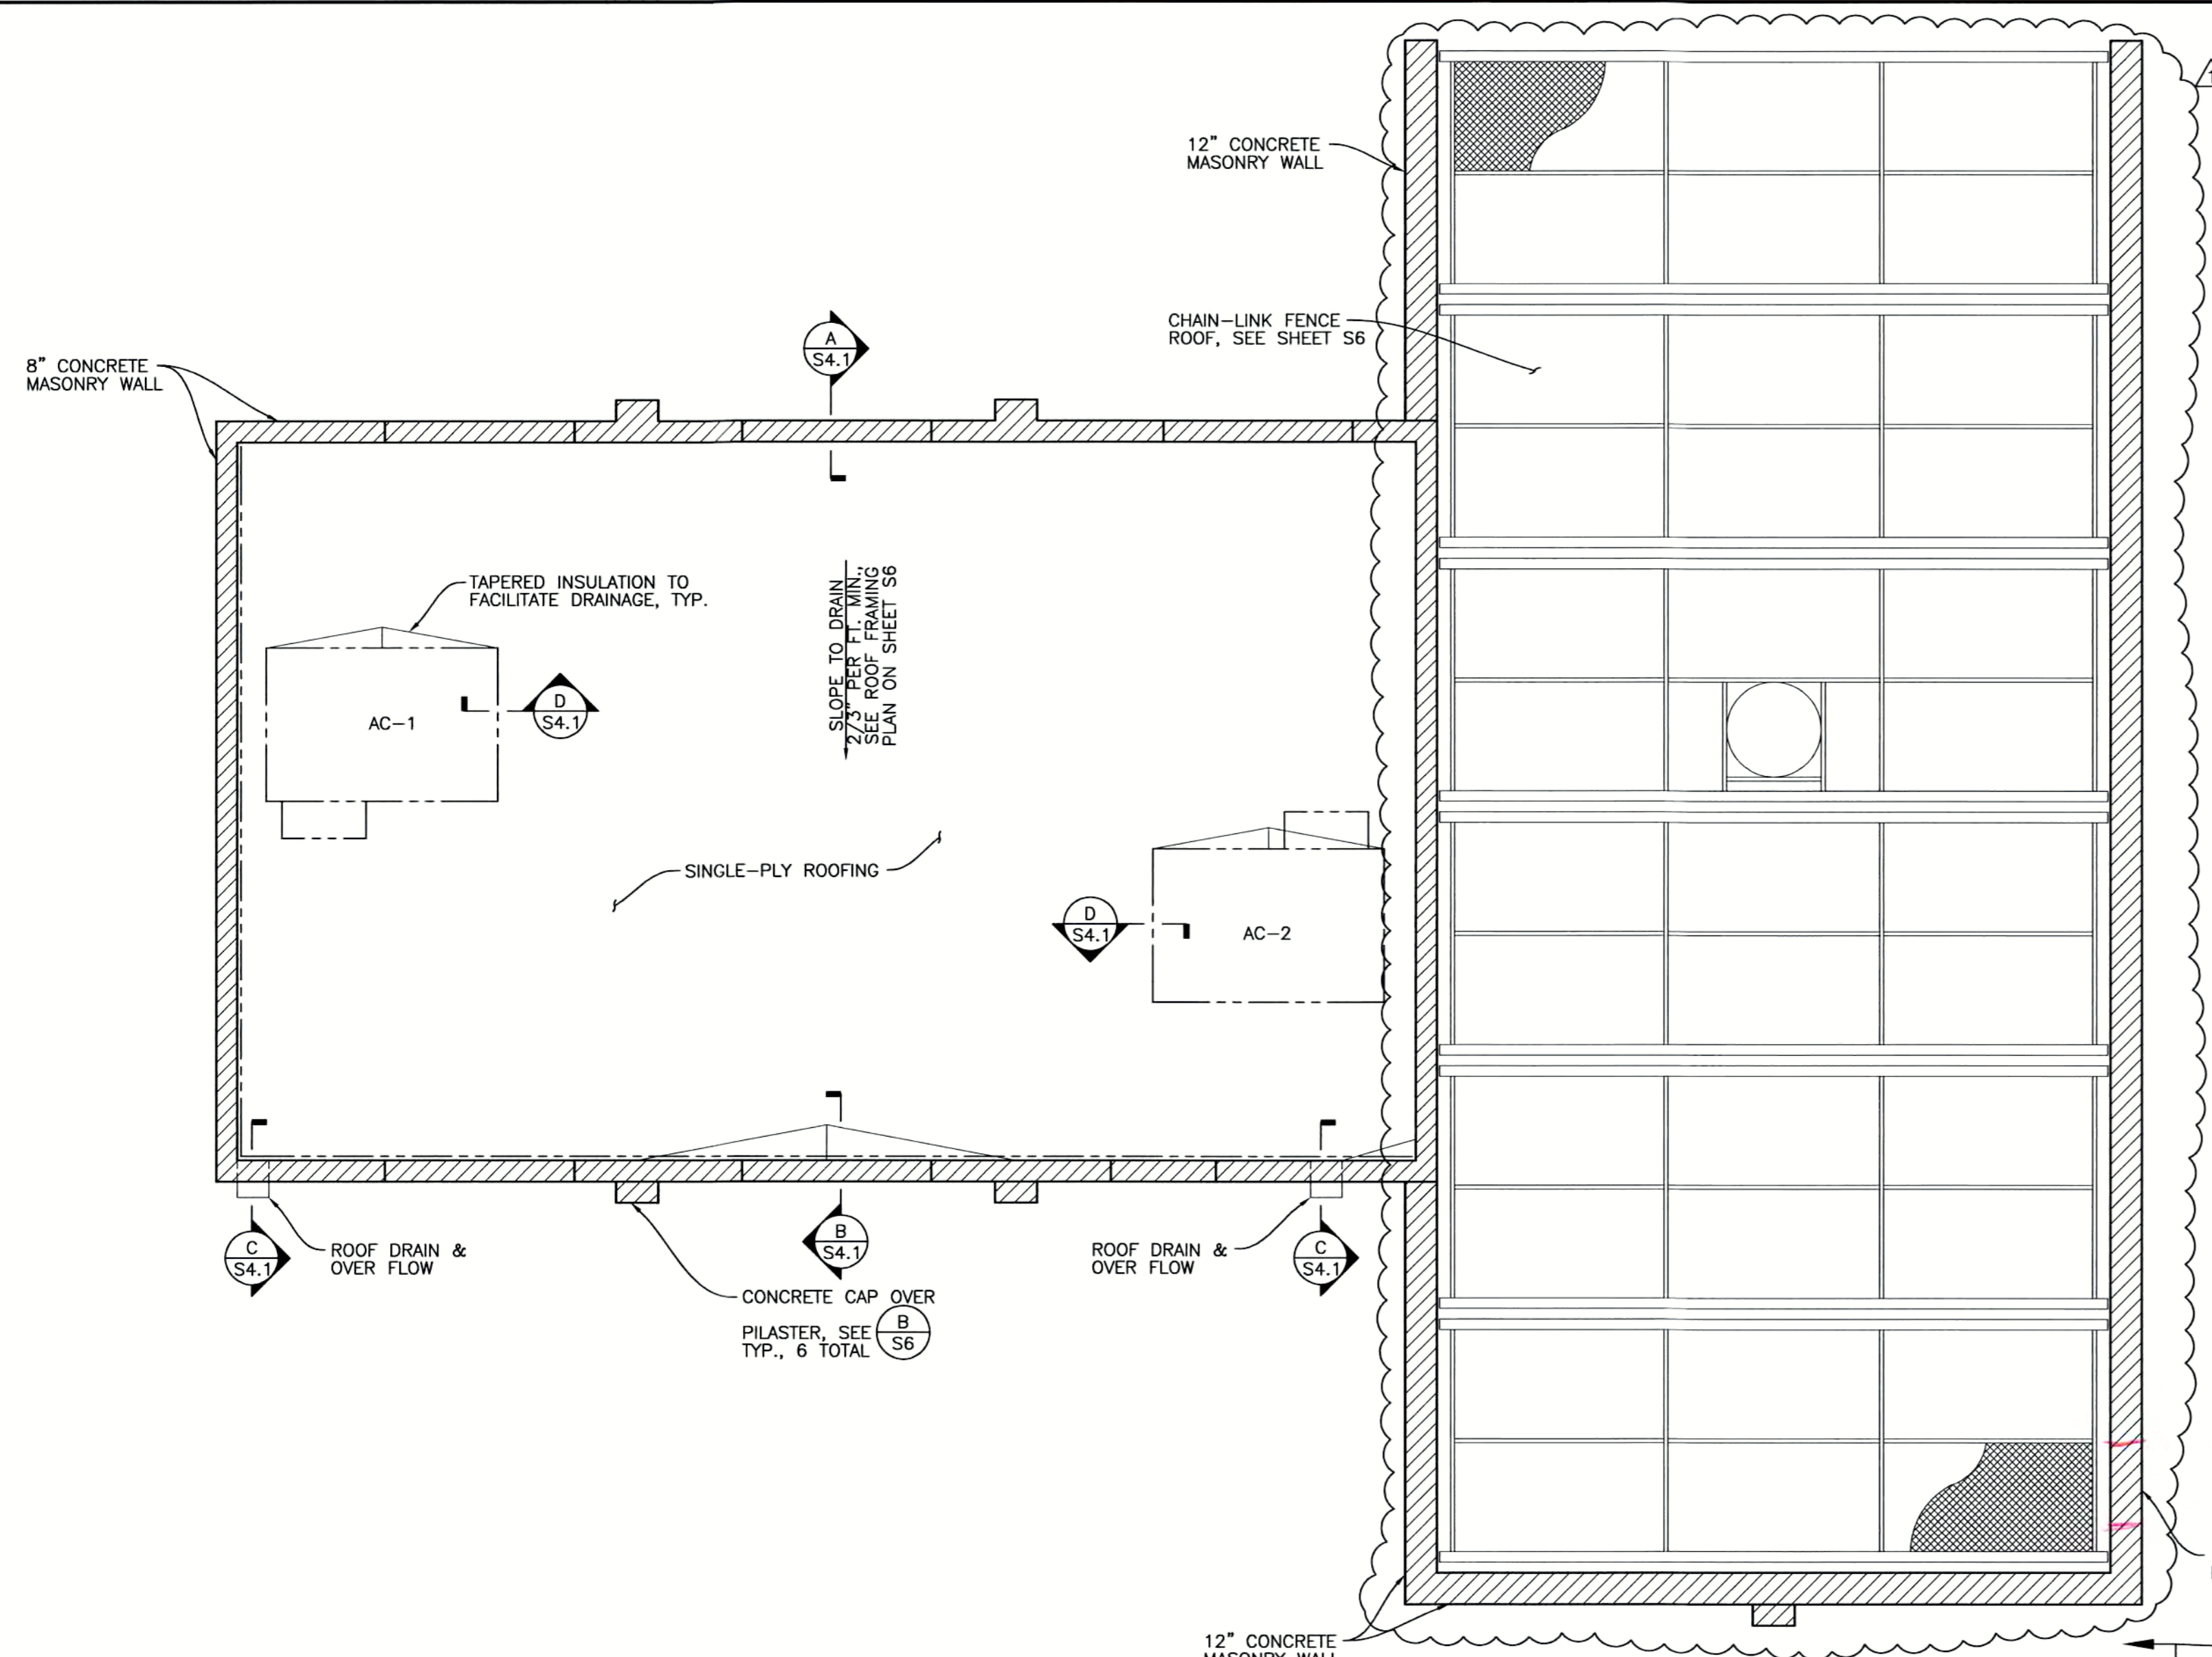


ROOF PLAN
1/4" = 1'-0"

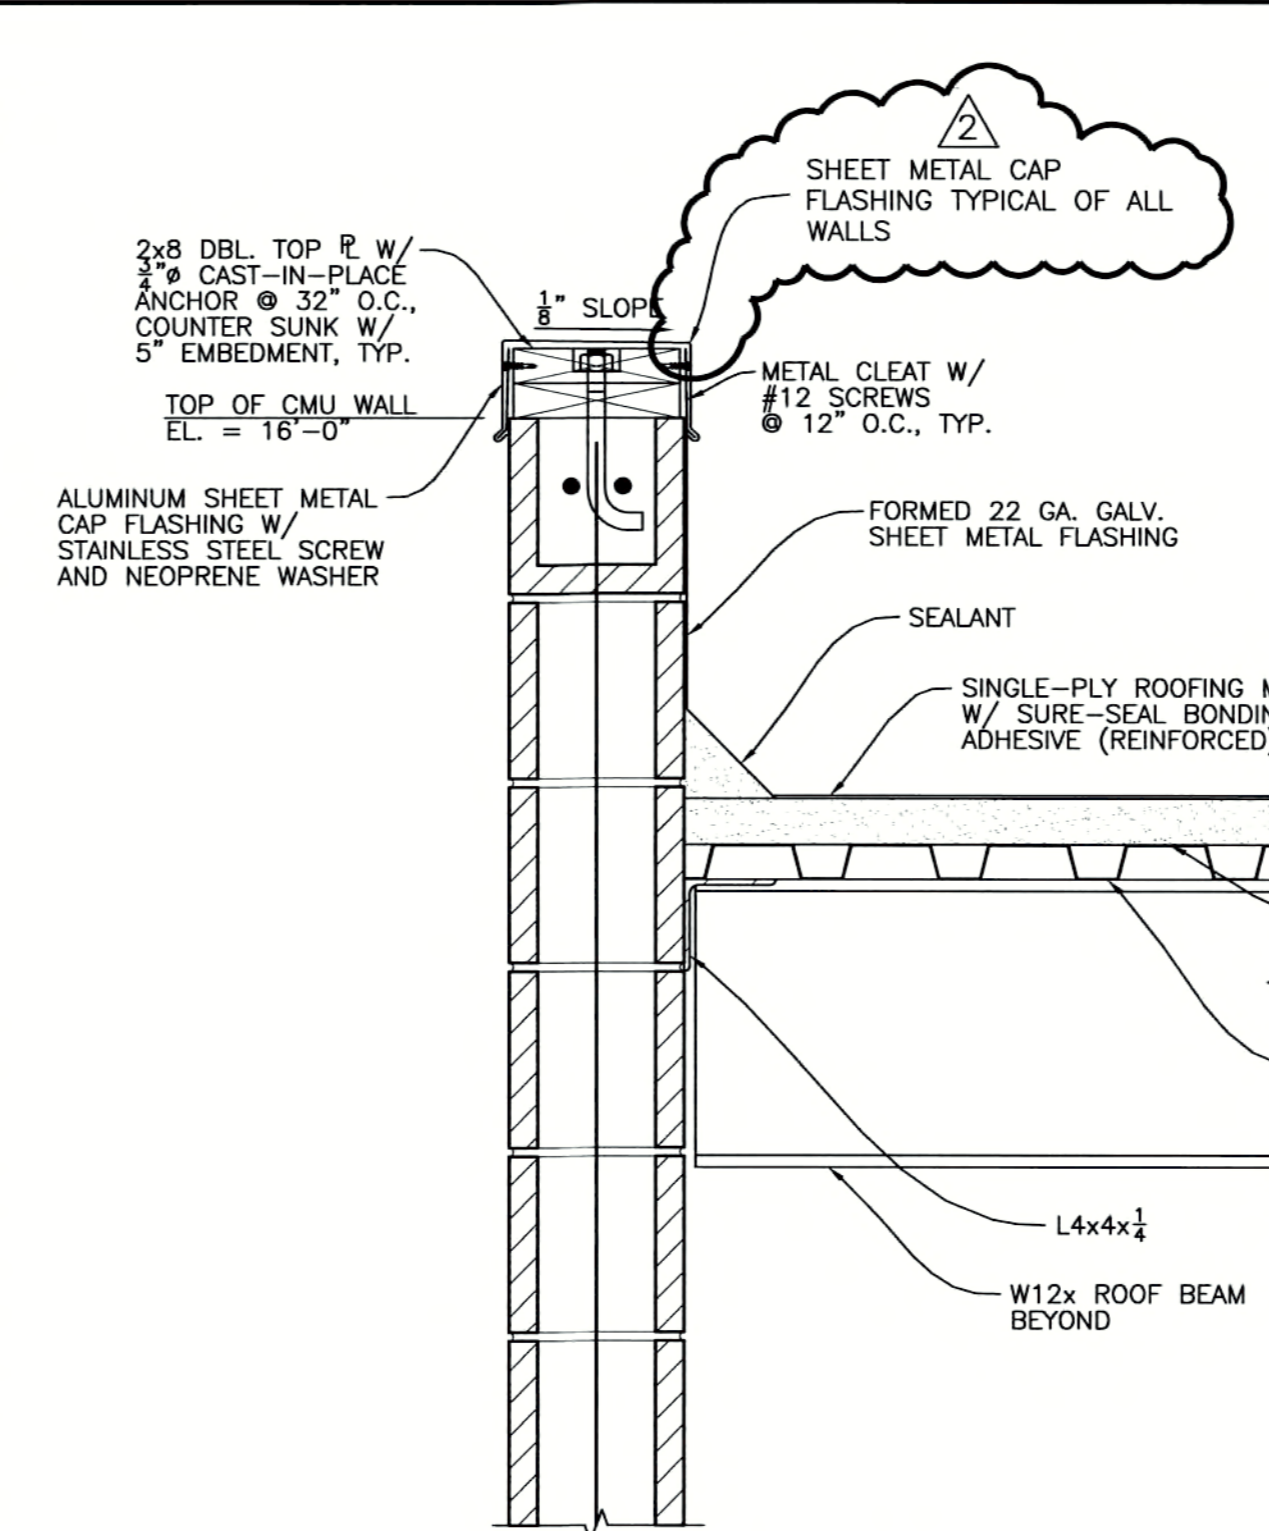



SECTION A
1 1/2" = 1'-0"
S4.1

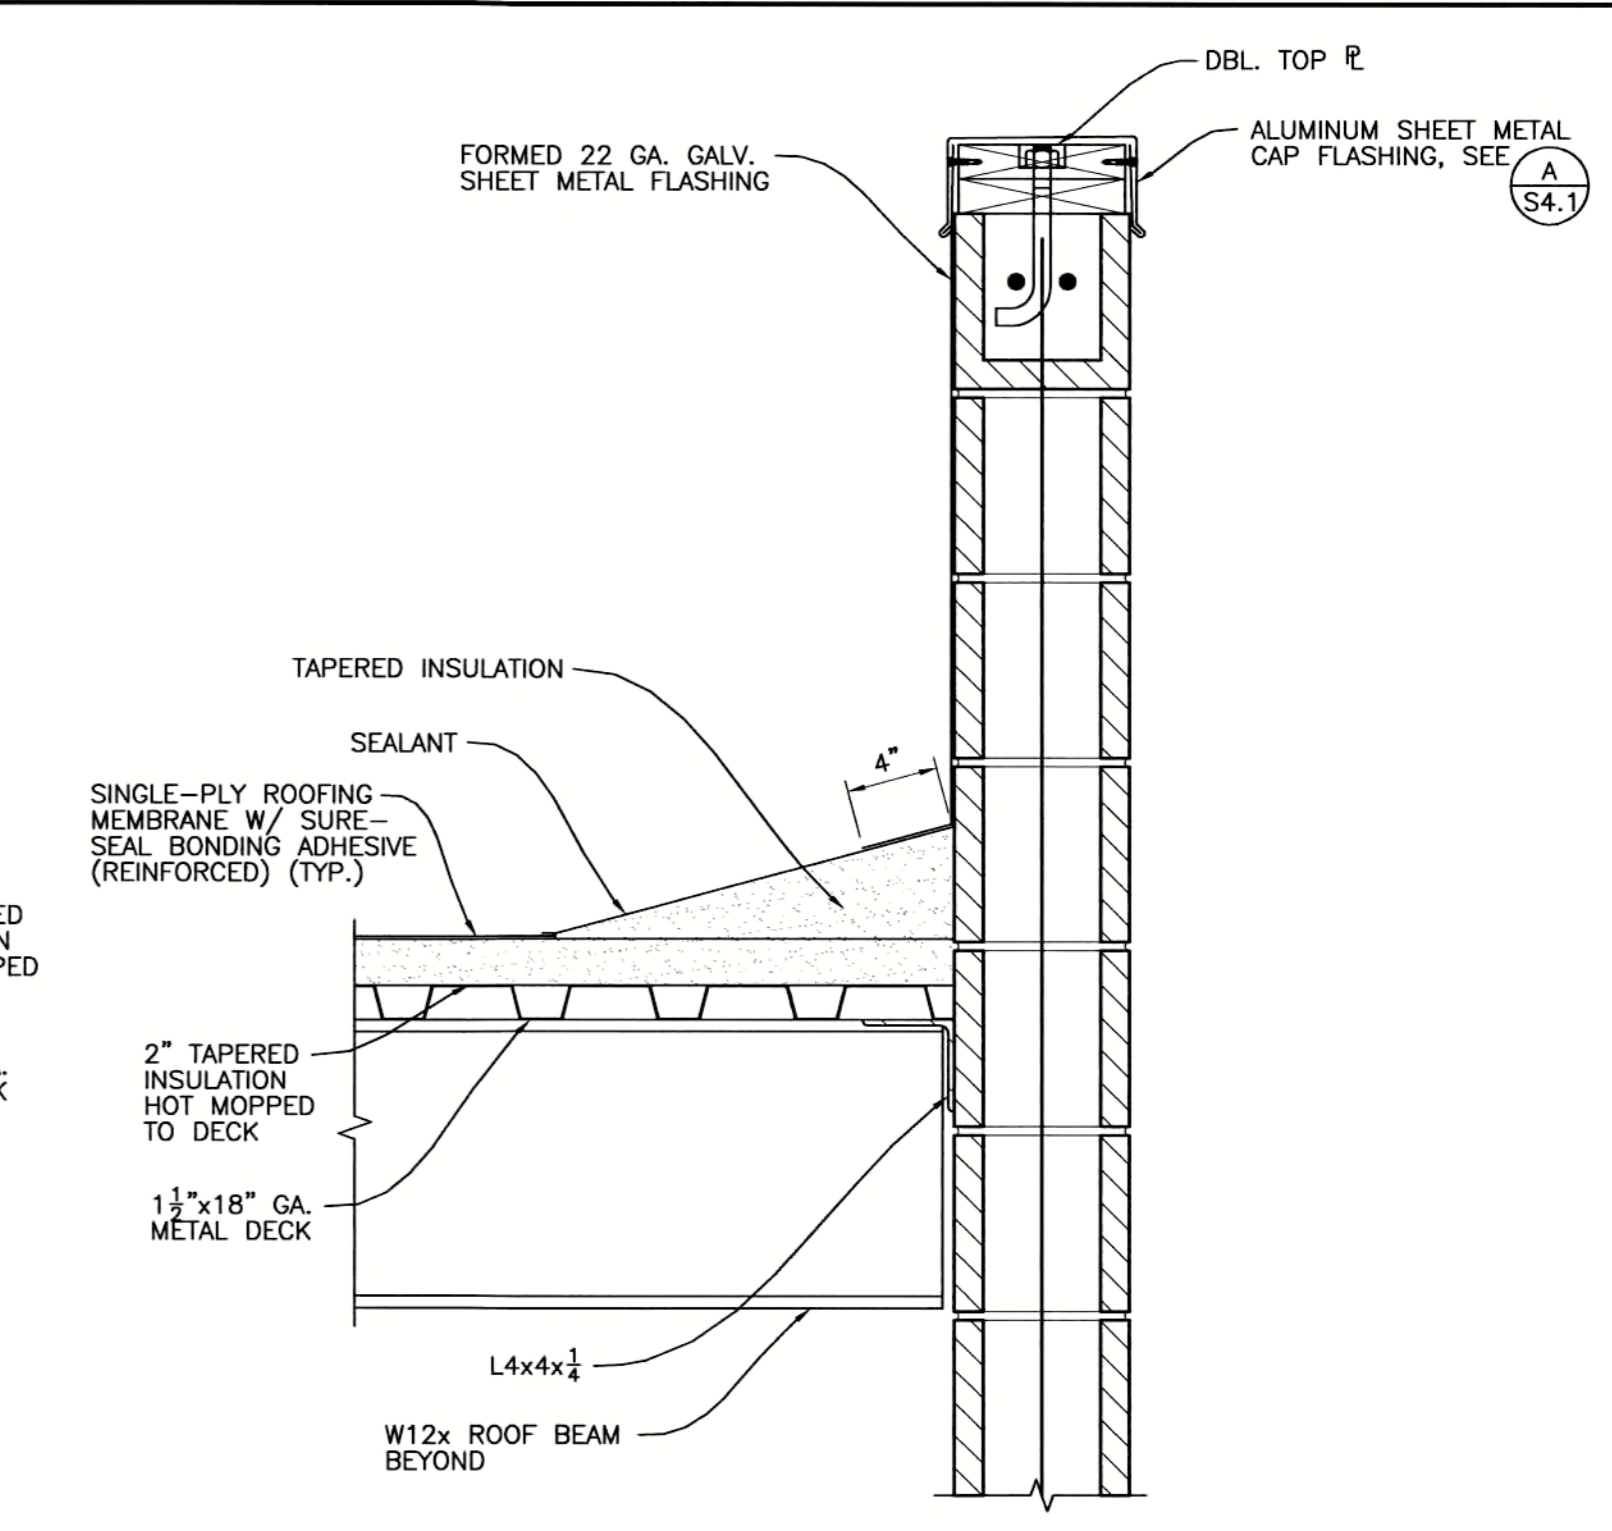

SECTION B
1 1/2" = 1'-0"
S4.1

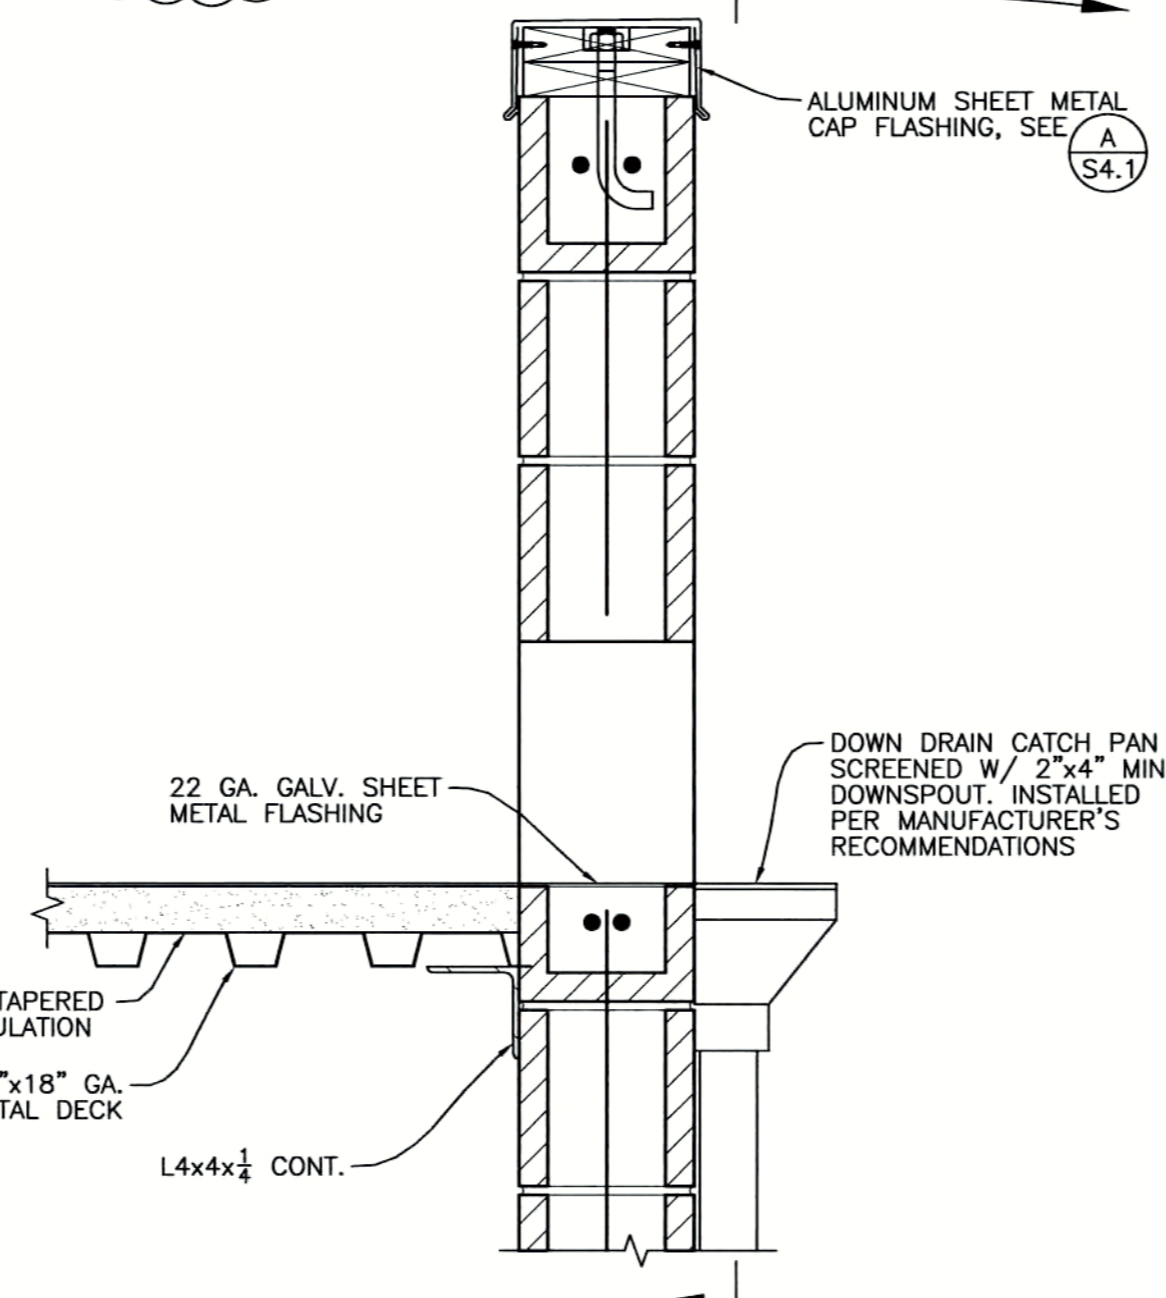

SECTION C
1 1/2" = 1'-0"
S4.1

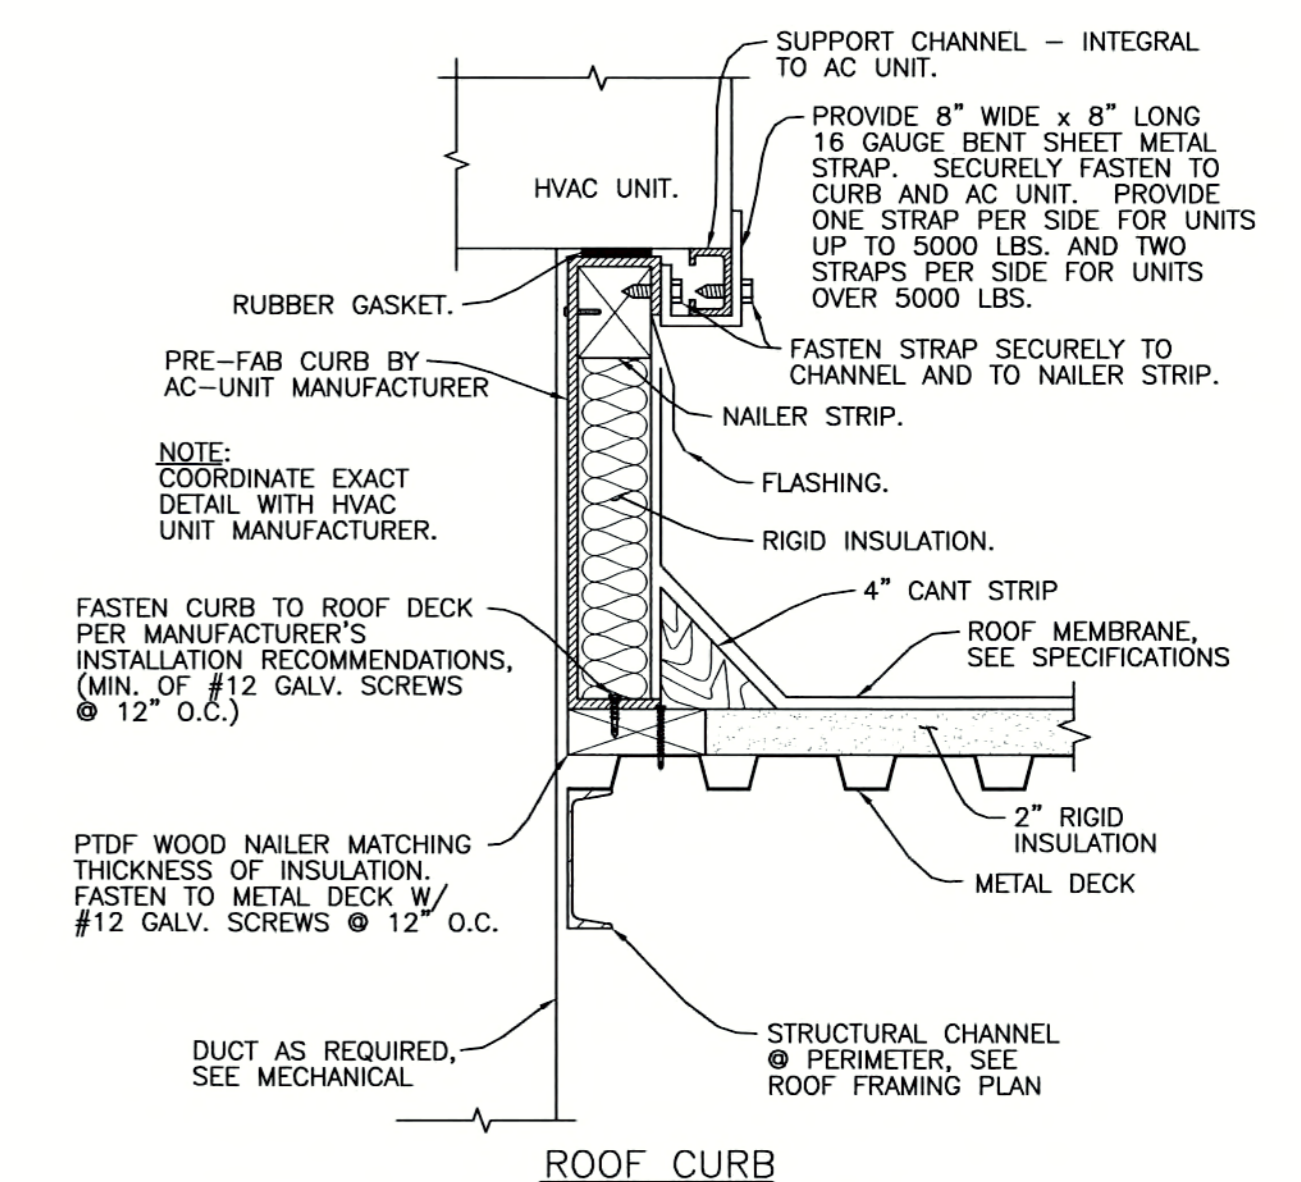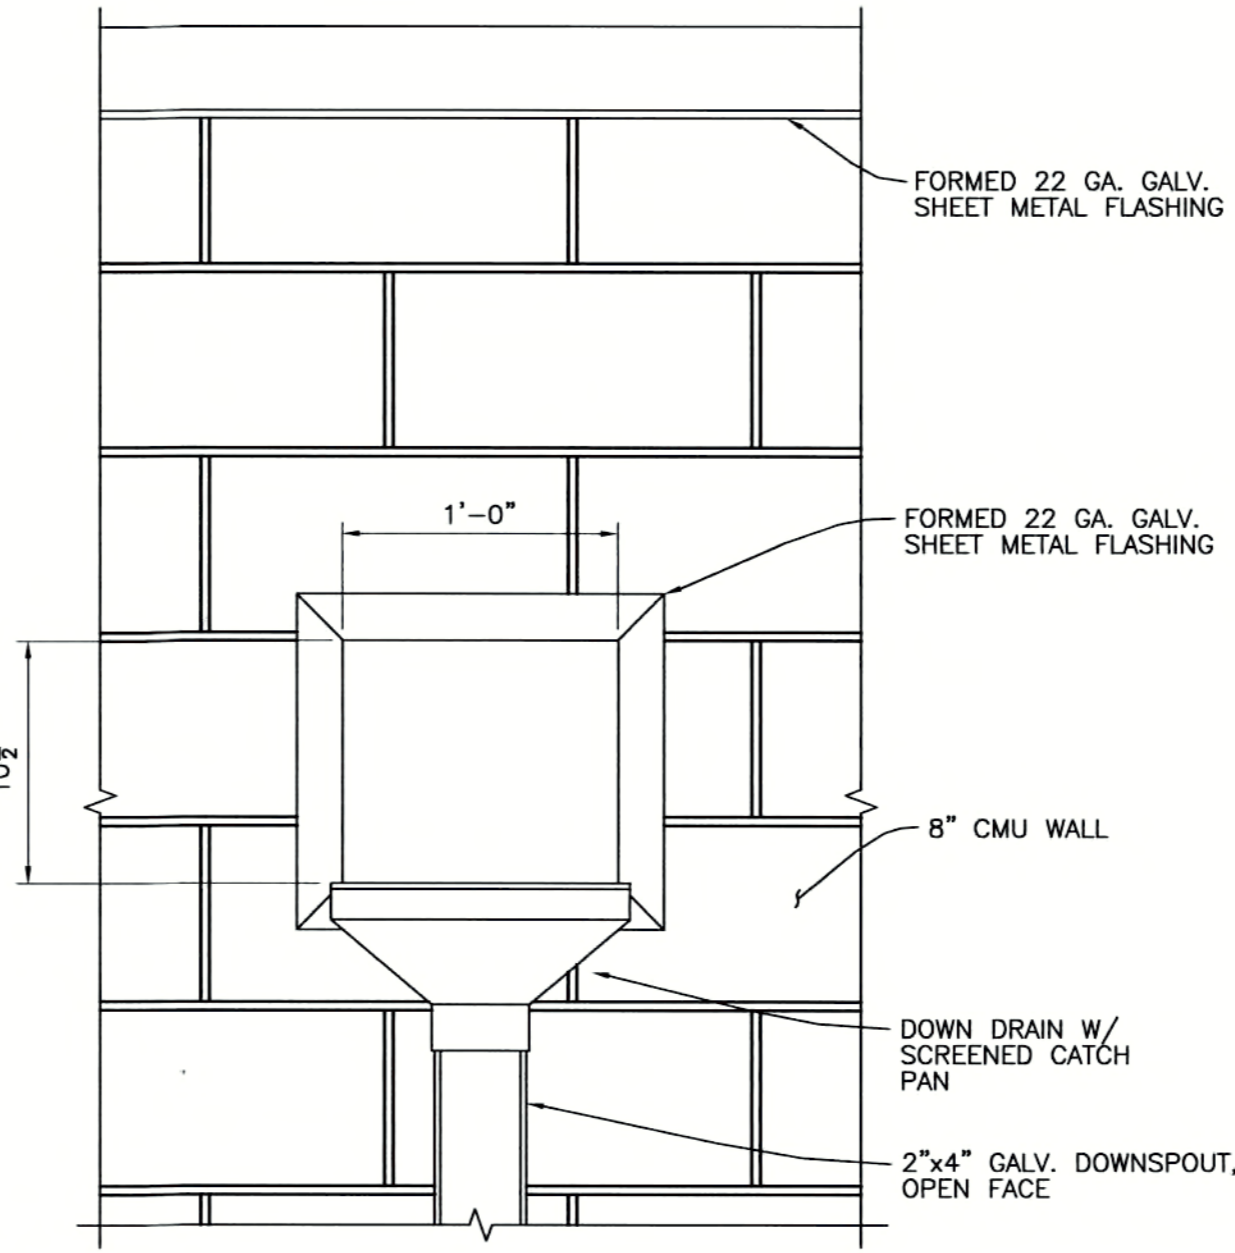

SECTION D
1 1/2" = 1'-0"
S4.1

RECORD DRAWINGS
14-Mile Slough Pump Station Upgrades
ROOF PLAN, SECTIONS & DETAILS

DEPARTMENT OF MUNICIPAL UTILITIES CITY OF STOCKTON, CALIFORNIA		
SCALE: AS SHOWN	APPROVED BY: DATE: _____	SHEET No. S4.1
DESIGNED BY: JAF	ASSISTANT DIRECTOR, DEPT. OF MUNICIPAL UTILITIES	34 of 89 SHEETS
DRAWN BY: REM		PROJECT No. 293-00-05-01
CHECKED BY: JAF		
RECORD Dwg.:		




REFER TO SET FOR SIGNATURE

REV. No.	DISCRIPTION	DATE	BY	Aprv'd By
1	REVISED GENERATOR ENCLOSURE	2/5/07	JAF	PDF
2	RECORD DRAWINGS	8/8/08	MAH	PDF
3				
4				
5				
6				

WEST YOST ASSOCIATES
Consulting Engineers


1260 Lake Boulevard
Suite 240
Davis, California 95616
(530) 756-5905
FAX (530) 756-5991

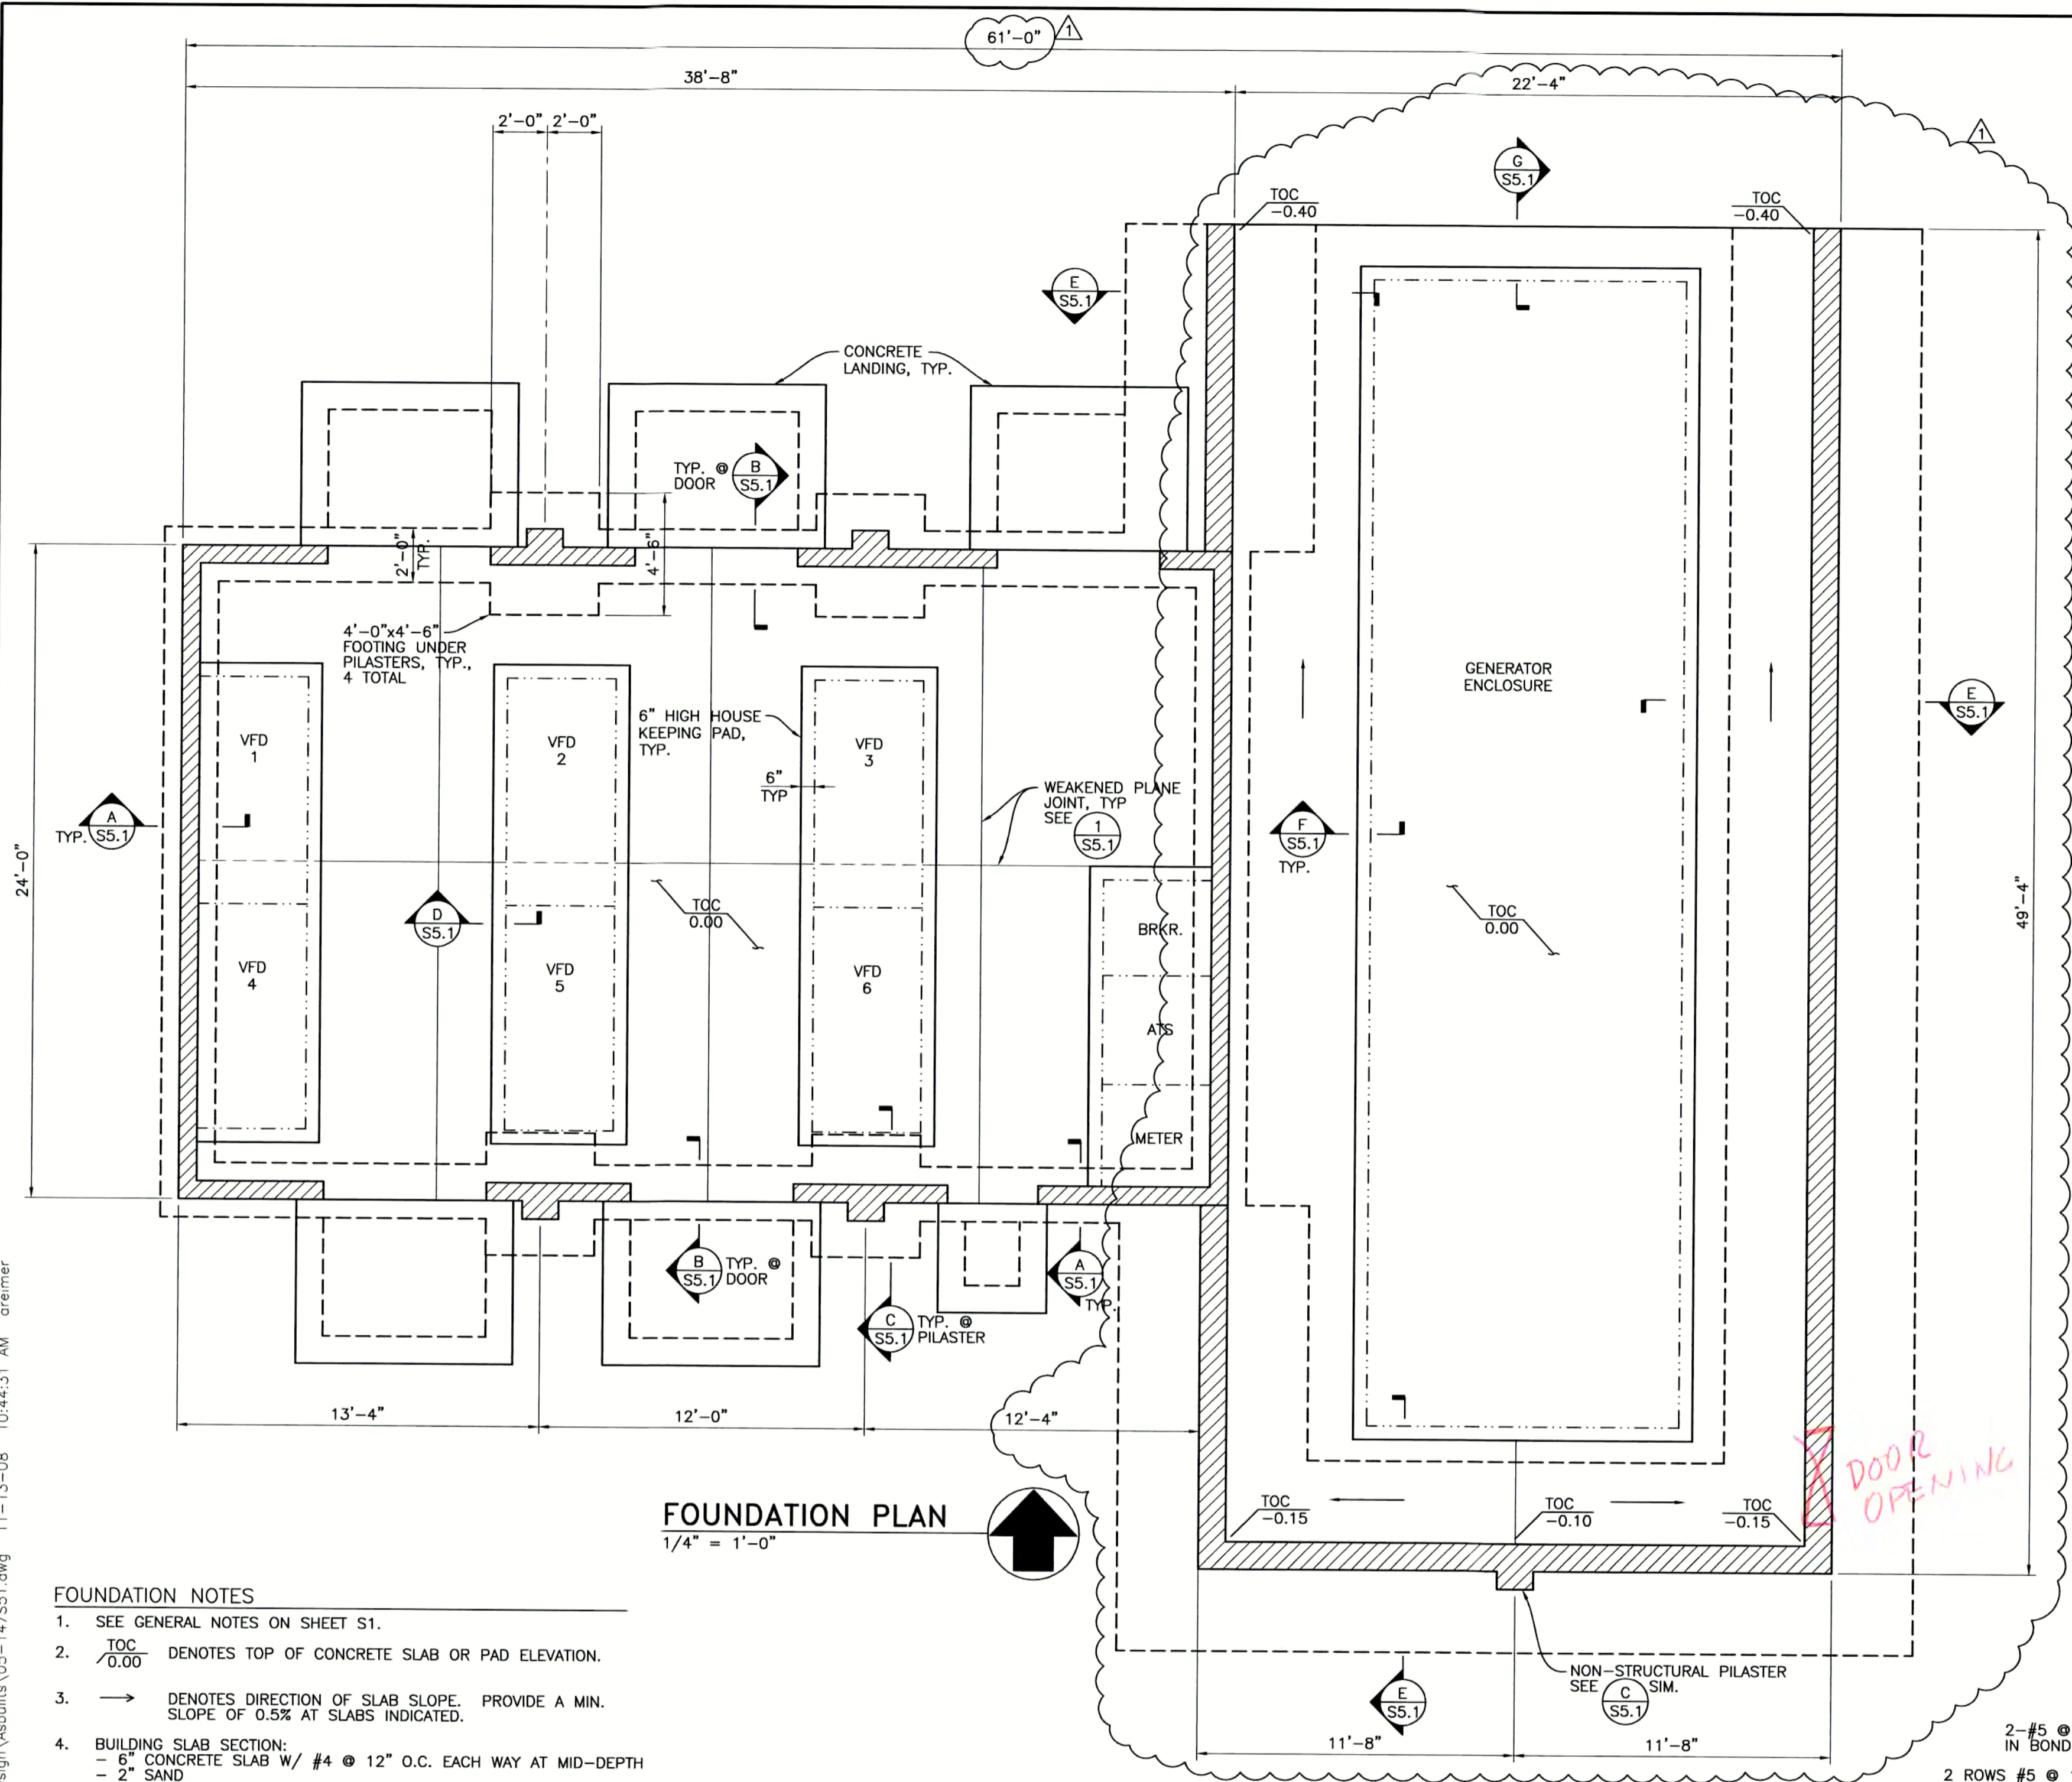


FOUNDATION PLAN
1/4" = 1'-0"

- FOUNDATION NOTES**
- SEE GENERAL NOTES ON SHEET S1.
 - TOC 0.00 DENOTES TOP OF CONCRETE SLAB OR PAD ELEVATION.
 - DENOTES DIRECTION OF SLAB SLOPE. PROVIDE A MIN. SLOPE OF 0.5% AT SLABS INDICATED.
 - BUILDING SLAB SECTION:
- 6" CONCRETE SLAB W/ #4 @ 12" O.C. EACH WAY AT MID-DEPTH
- 2" SAND
- IMPERMEABLE MEMBRANE, 10 MIL
- 4" CRUSHED ROCK
- 12" NON-EXPANSIVE FILL
- 12" CONDITIONED NATIVE SUBGRADE
(SEE SPECIFICATIONS SECTION 02300 FOR COMPACTION REQUIREMENTS)
 - ▨ DENOTES CONCRETE BLOCK WALL. GROUT ALL CELLS SOLID.
 - ANCHORAGE OF EQUIPMENT SHALL BE BY THE MANUFACTURER. MANUFACTURER SHALL SUBMIT DRAWINGS AND CALCULATIONS FOR THE EQUIPMENT ANCHORAGE FOR REVIEW. SEE PROJECT SPECIFICATIONS.
 - SEE SHEET S3 FOR DIMENSIONS NOT SHOWN.
 - SEE (3/S1) FOR TYPICAL CMU REINFORCEMENT AT WALL CORNERS & INTERSECTIONS AND ENDS.
 - SEE (4/S1) FOR TYPICAL CMU REINFORCEMENT AT OPENINGS.
 - SEE (2/S1) FOR FOUNDATION REINFORCEMENT AT PIPES/CONDUITS PASSING UNDER OR THROUGH FOOTINGS.

- NOTES:**
- SAW CUTTING SHALL BE COMPLETED NO MORE THAN 12 HOURS AFTER PLACING CONCRETE SLAB. PLACING CONCRETE SLAB.
 - JOINTS SHALL BE LOCATED AT 15'-0" O.C. MAX.
 - AT CONTRACTOR'S OPTION, IN LIEU OF SAWCUTTING, CONTRACTOR MAY INSTALL A 1 1/2" DEEP PREFORMED ZIP STRIP.

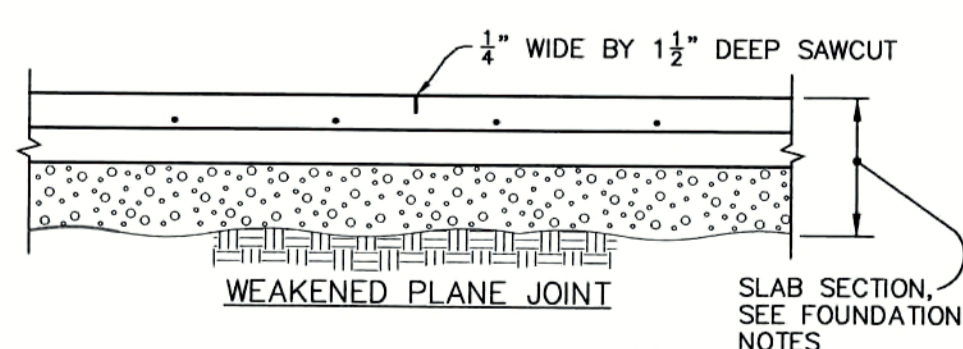


DETAIL 1
3/4" = 1'-0"

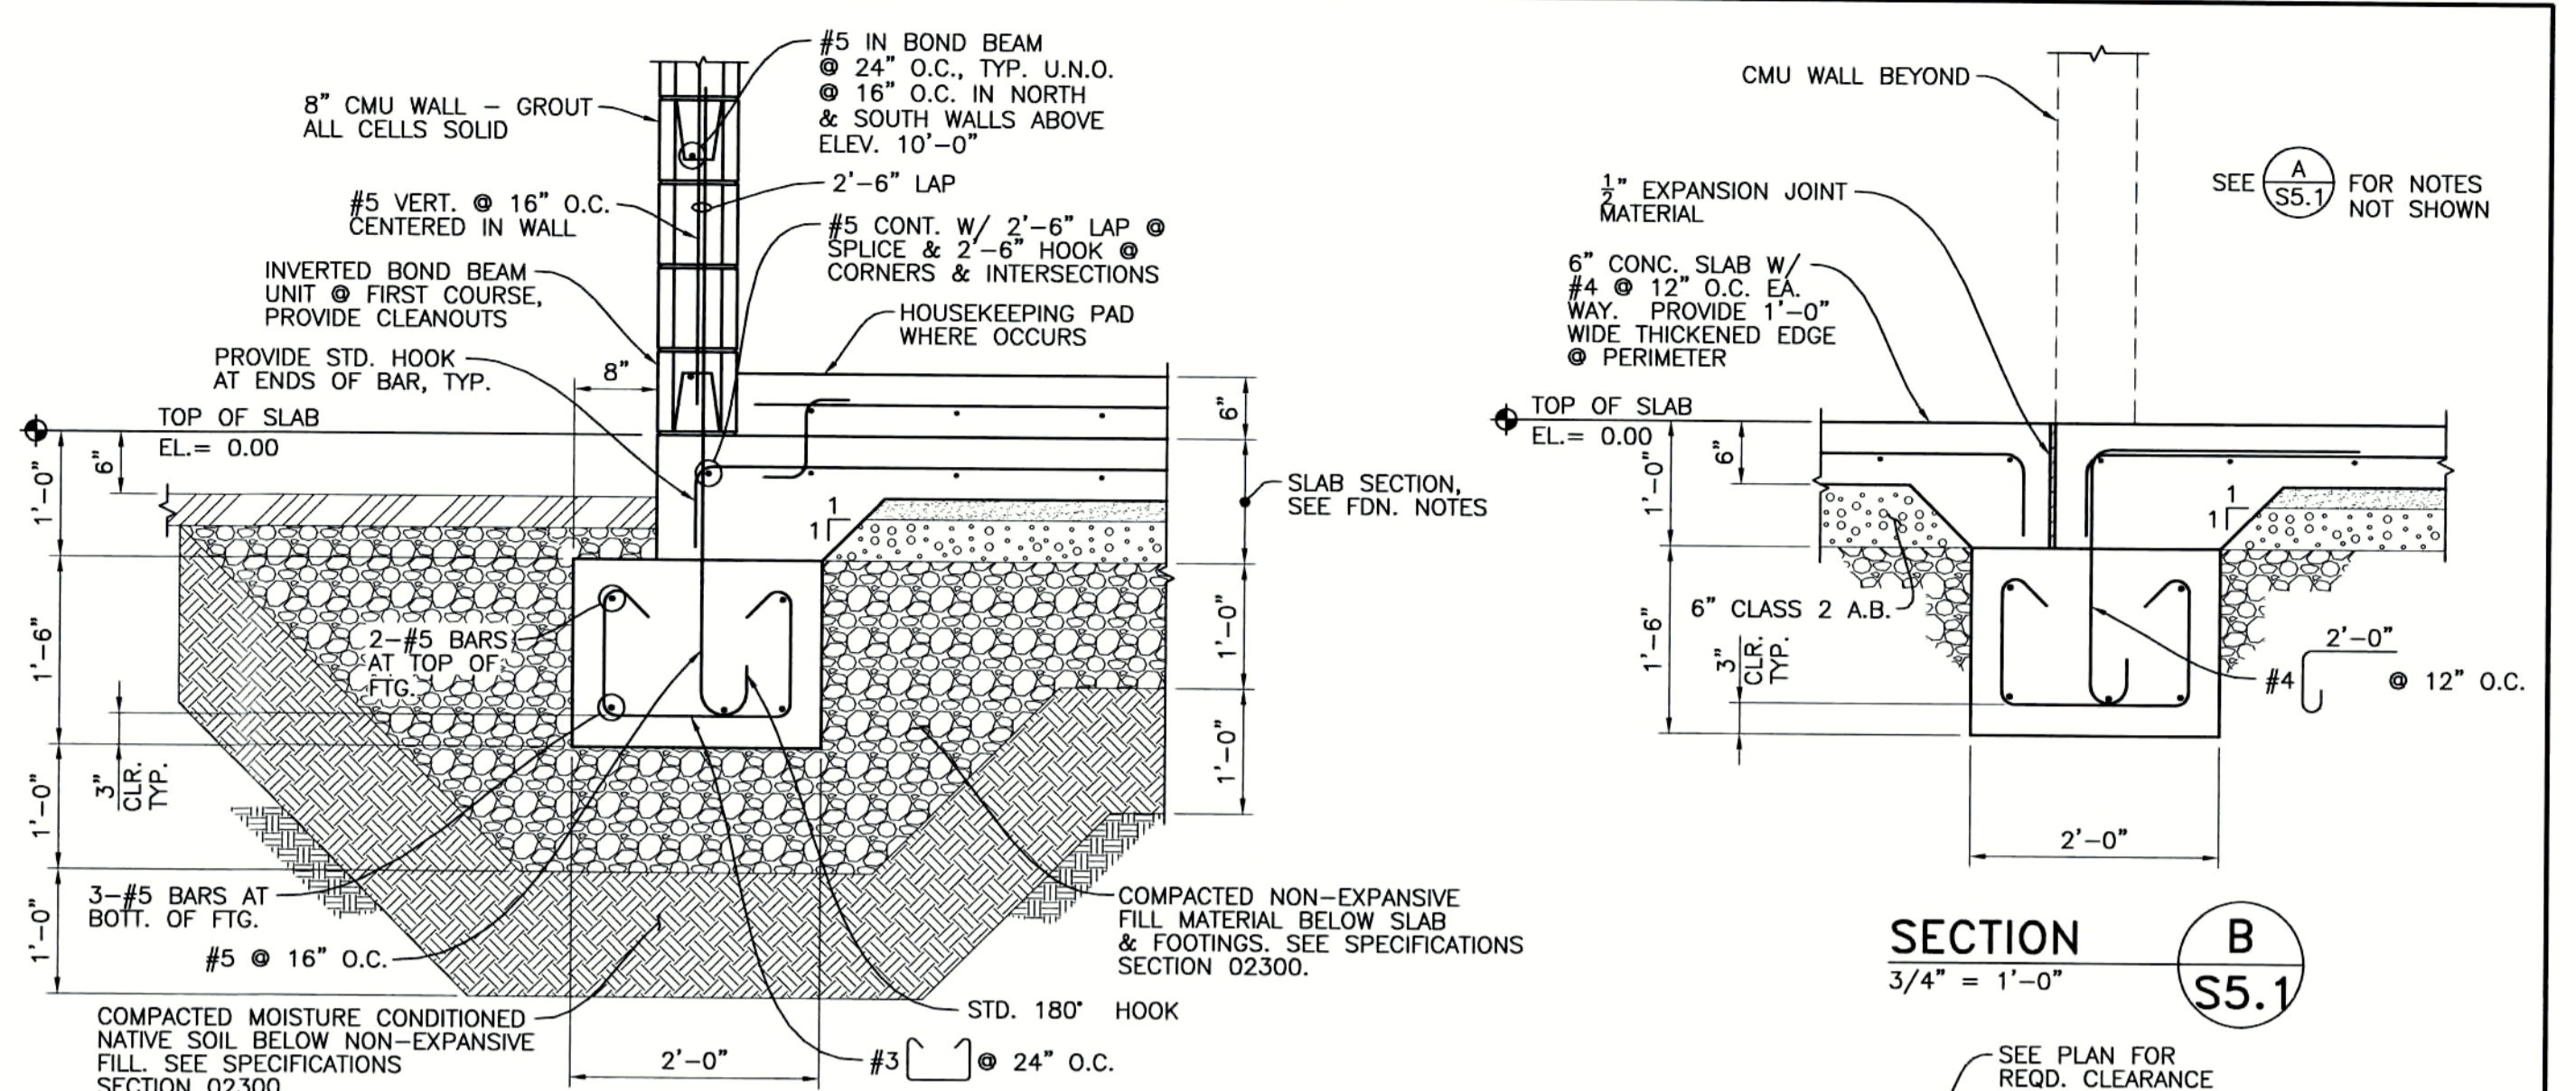


SECTION A
3/4" = 1'-0"


SECTION B
3/4" = 1'-0"

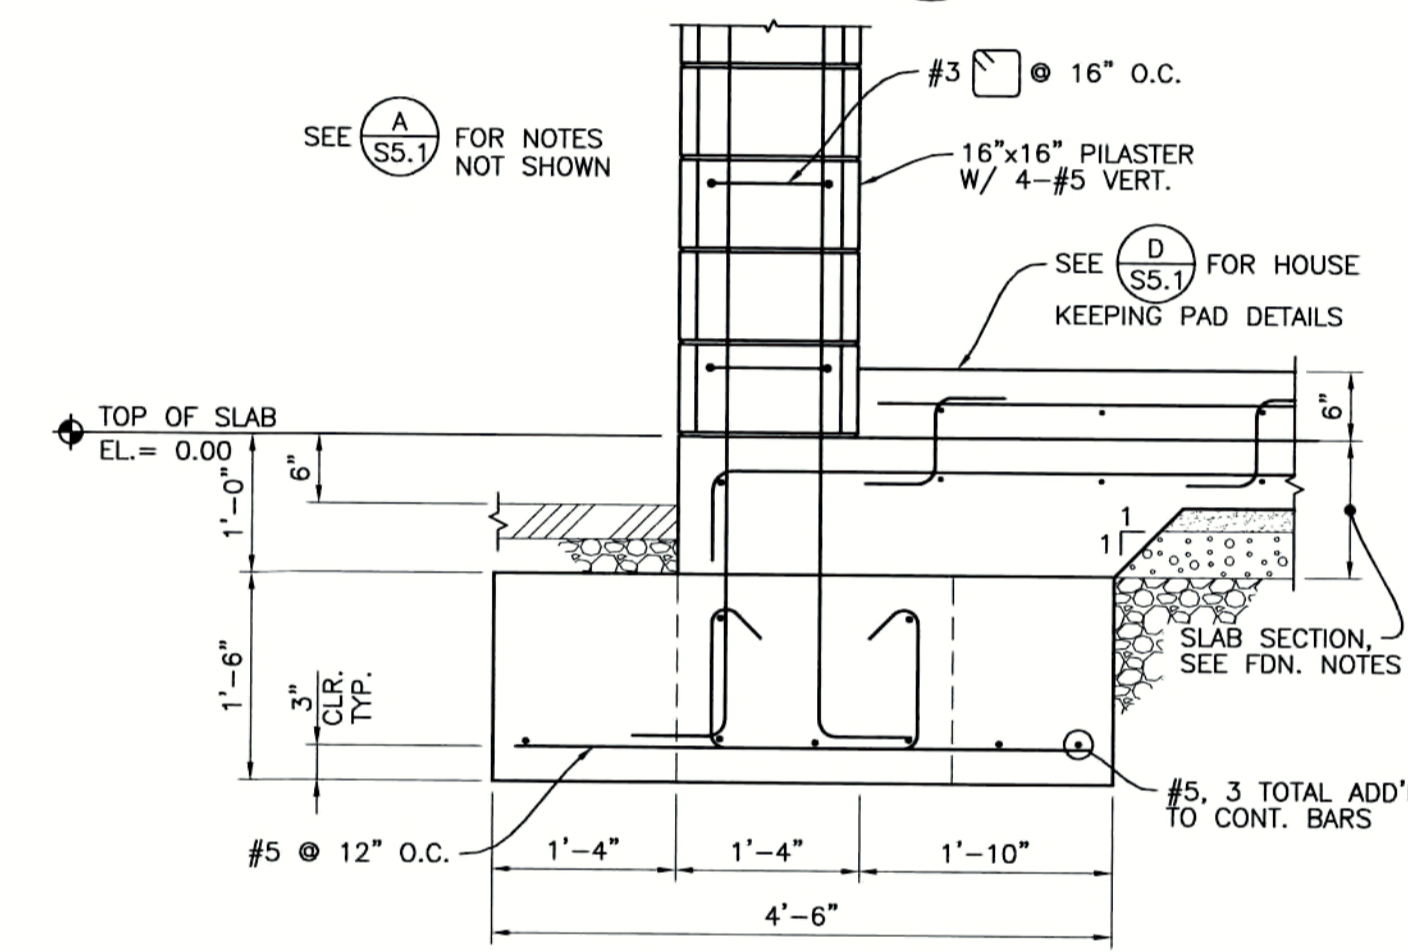


SECTION C
3/4" = 1'-0"

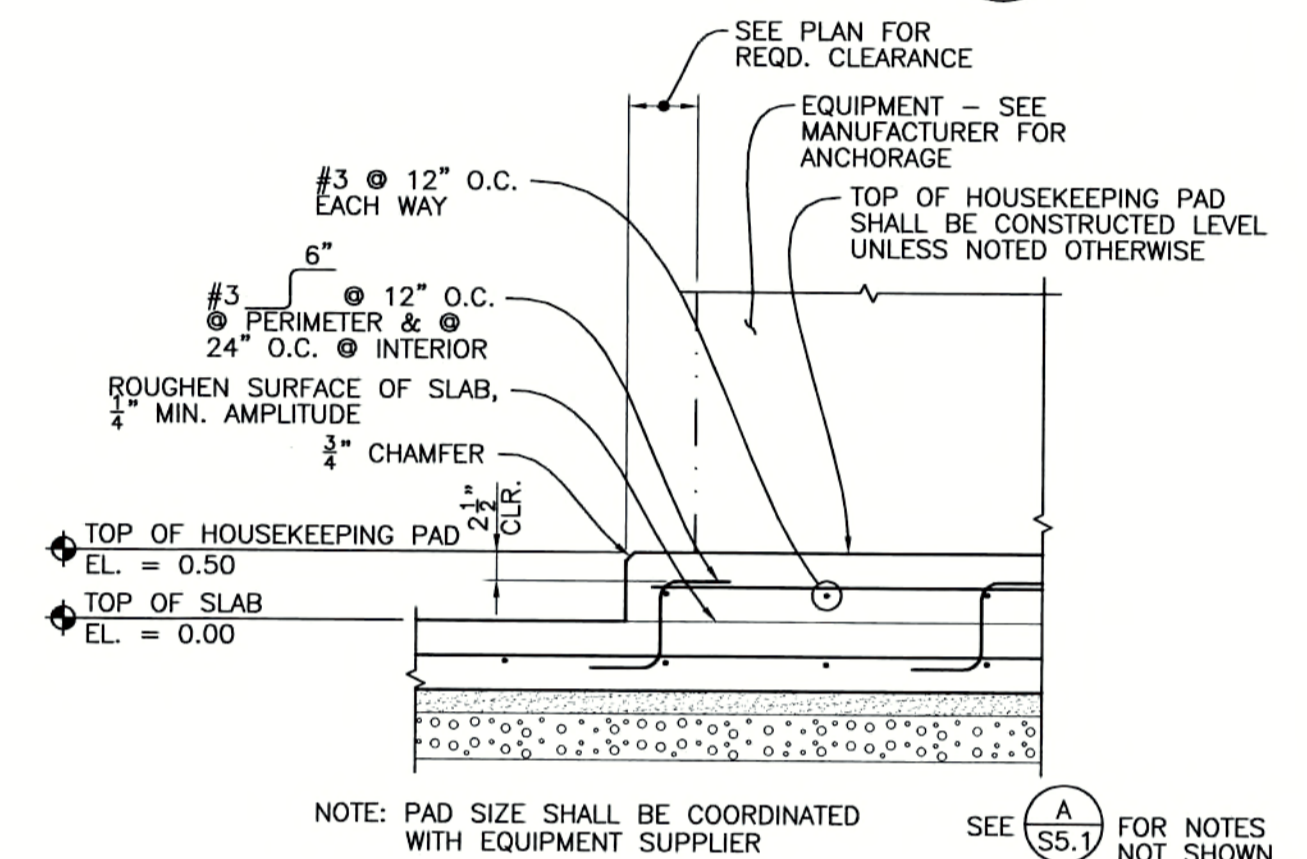

SECTION D
3/4" = 1'-0"

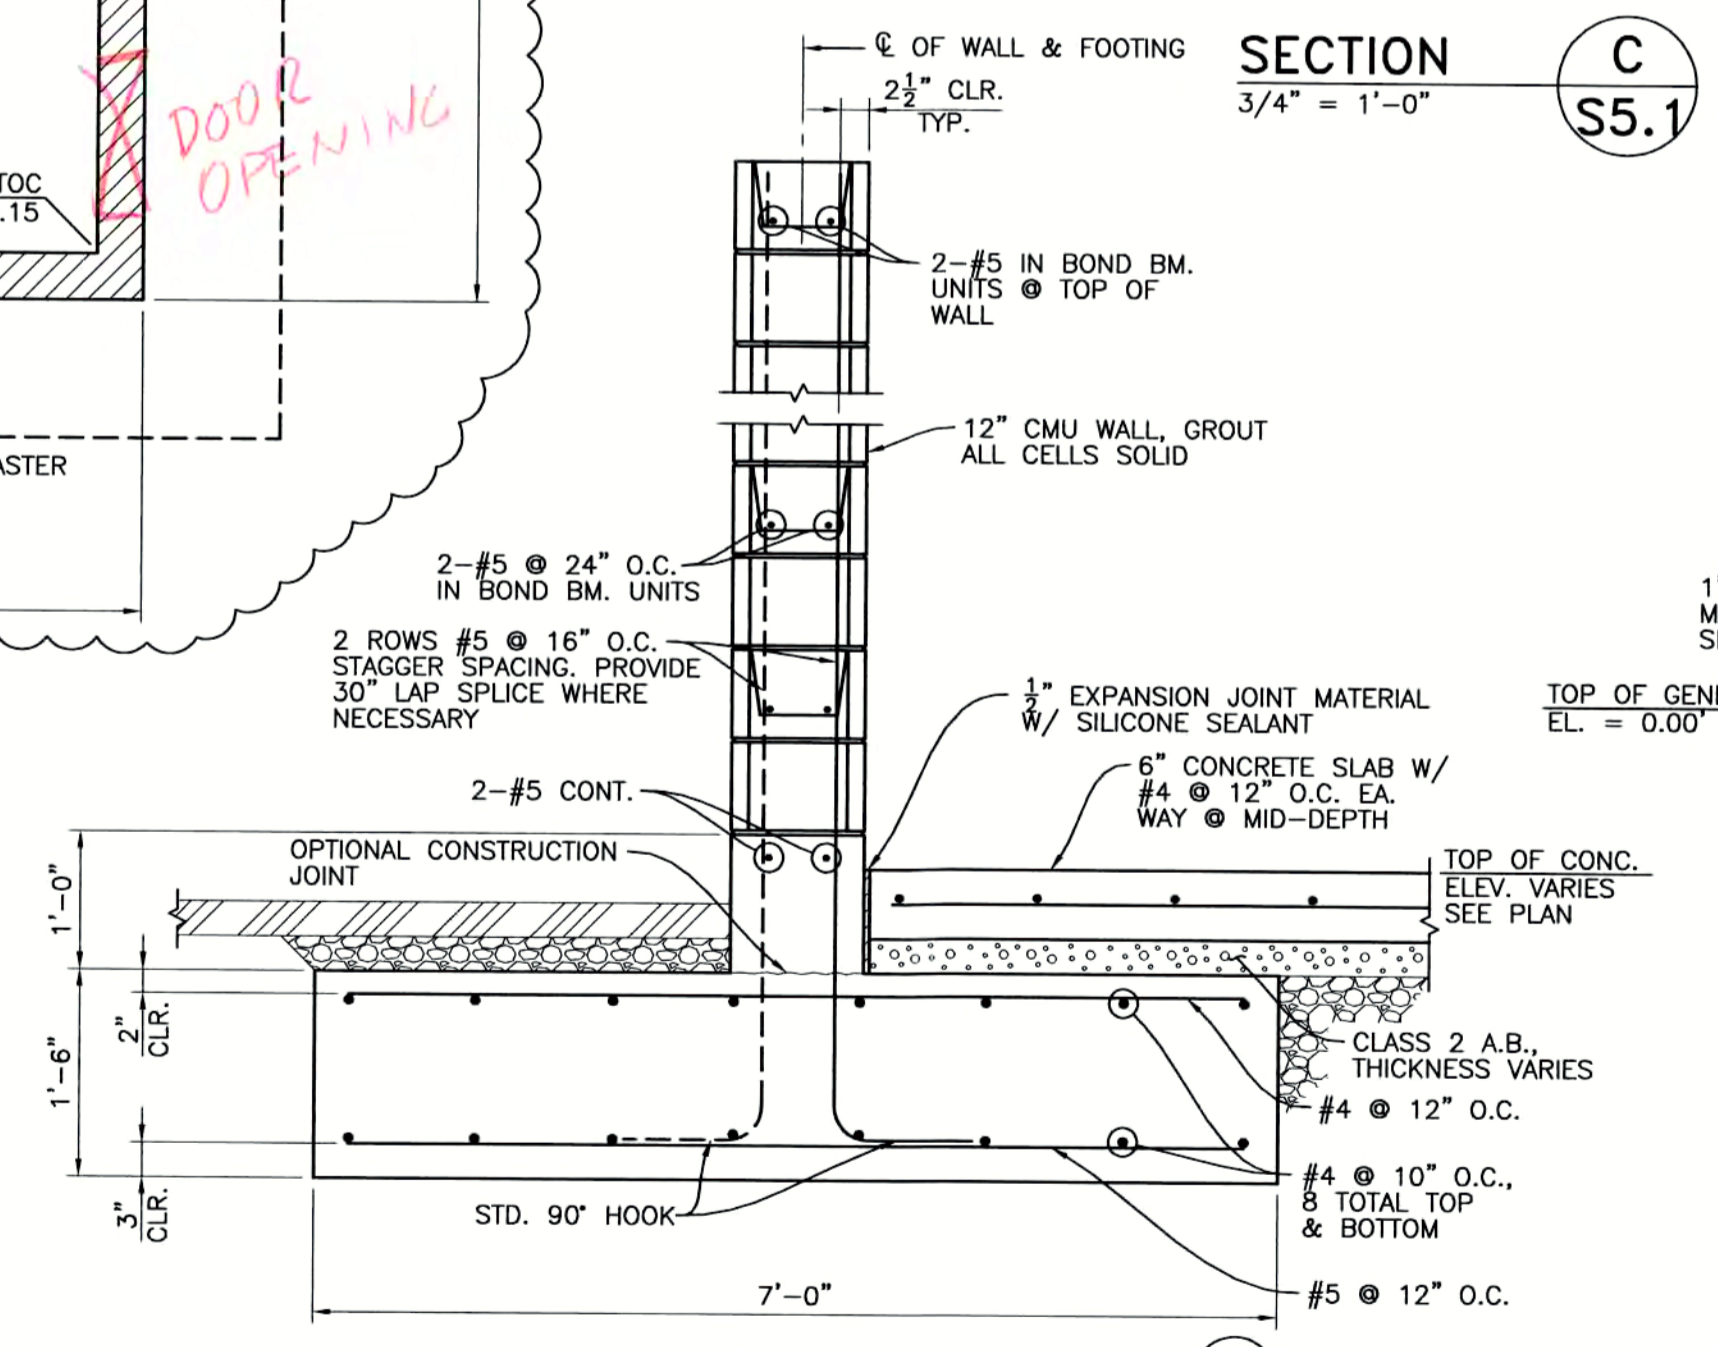

SECTION E
3/4" = 1'-0"

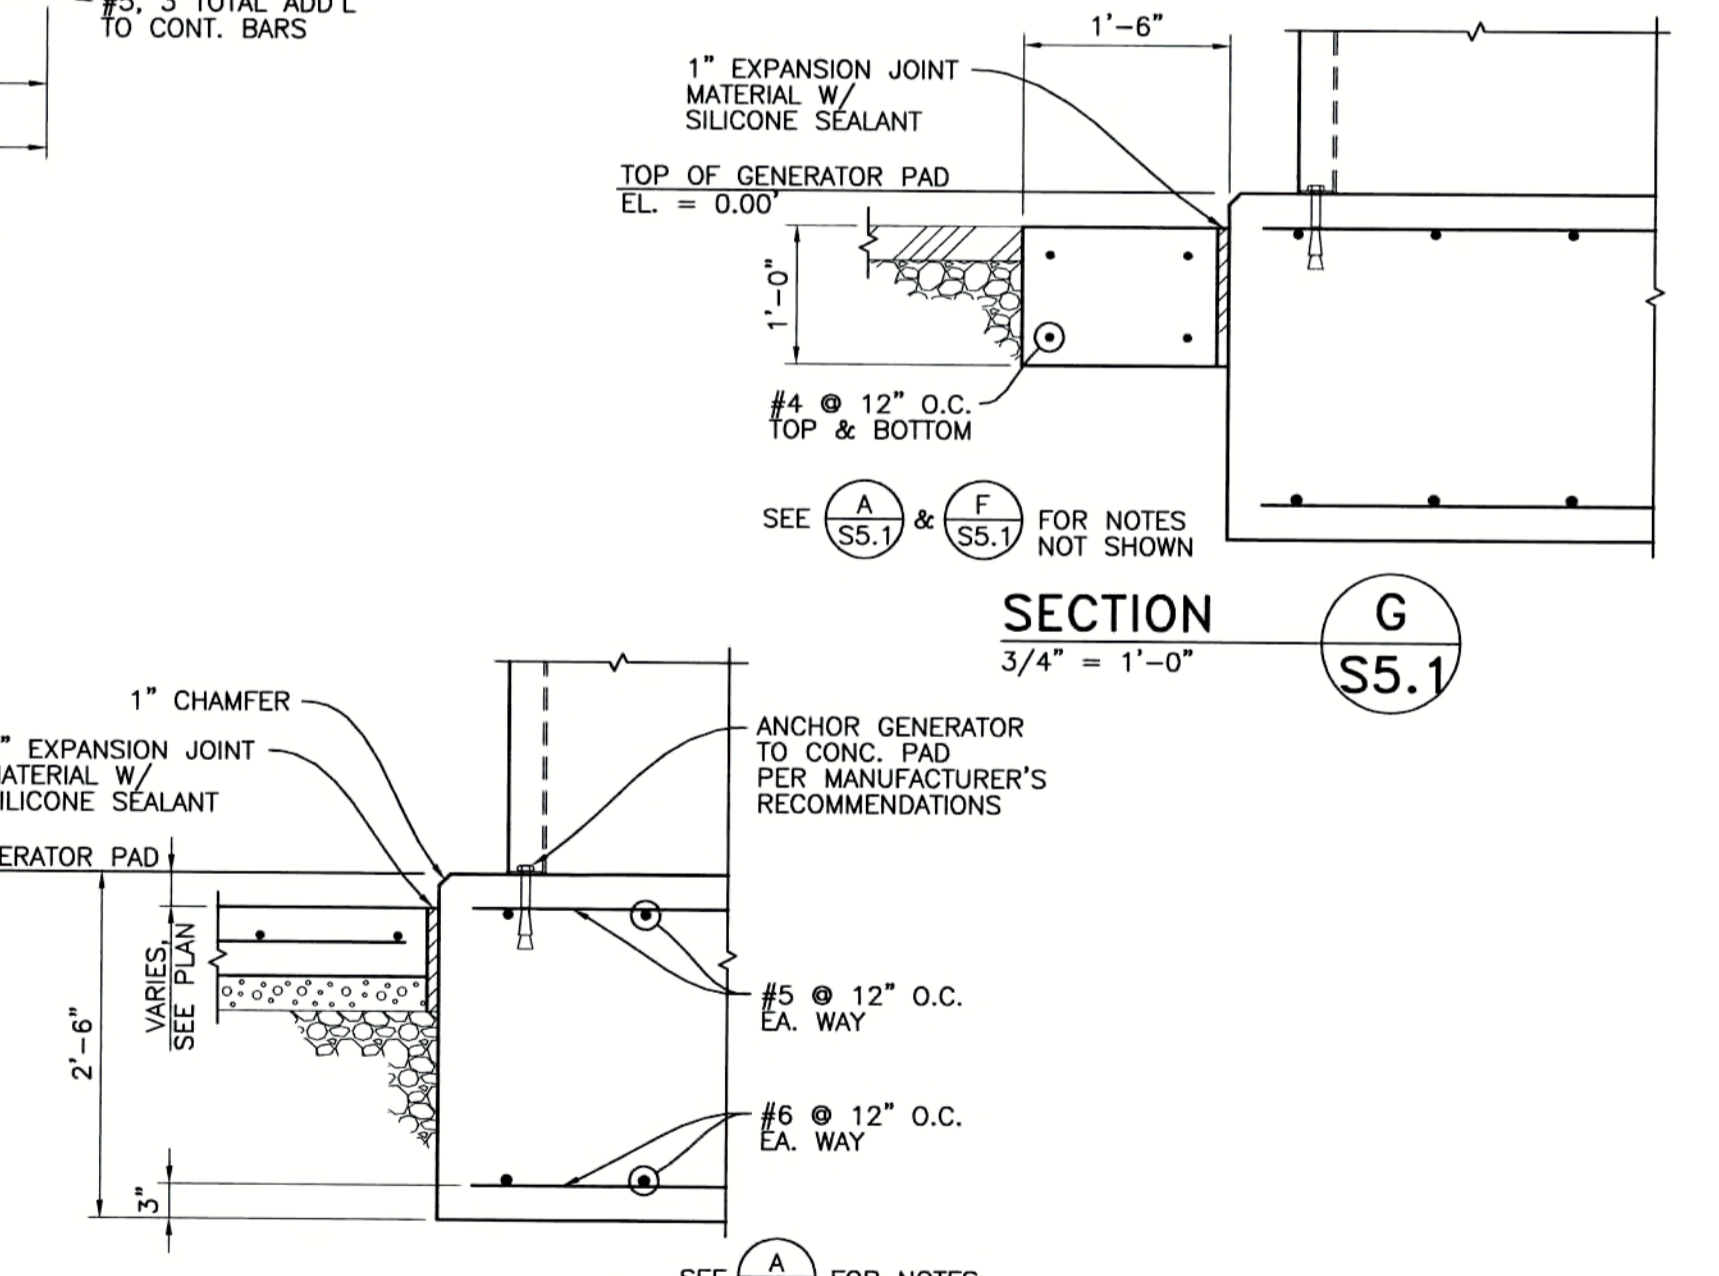

SECTION F
3/4" = 1'-0"

SECTION G
3/4" = 1'-0"

RECORD DRAWINGS
14-Mile Slough Pump Station Upgrades
FOUNDATION PLAN, SECTIONS & DETAILS




REFER TO SET FOR SIGNATURE


REV. No.	DISCUSSION	DATE	BY	App'd By
1	REVISED GENERATOR ENCLOSURE	2/5/07	JAF	PDF
2				
3				
4				
5				
6				

WEST YOST ASSOCIATES
Consulting Engineers
1260 Lake Boulevard Suite 240 Davis, California 95616
(530) 756-5905 FAX (530) 756-5991


SCALE: AS SHOWN	APPROVED BY: DATE: _____	SHEET No. S5.1
DESIGNED BY: JAF		35 of 89 SHEETS
DRAWN BY: REM		PROJECT No. 293-00-05-01
CHECKED BY: JAF	ASSISTANT DIRECTOR, DEPT. OF MUNICIPAL UTILITIES	
RECORD DWG.:		

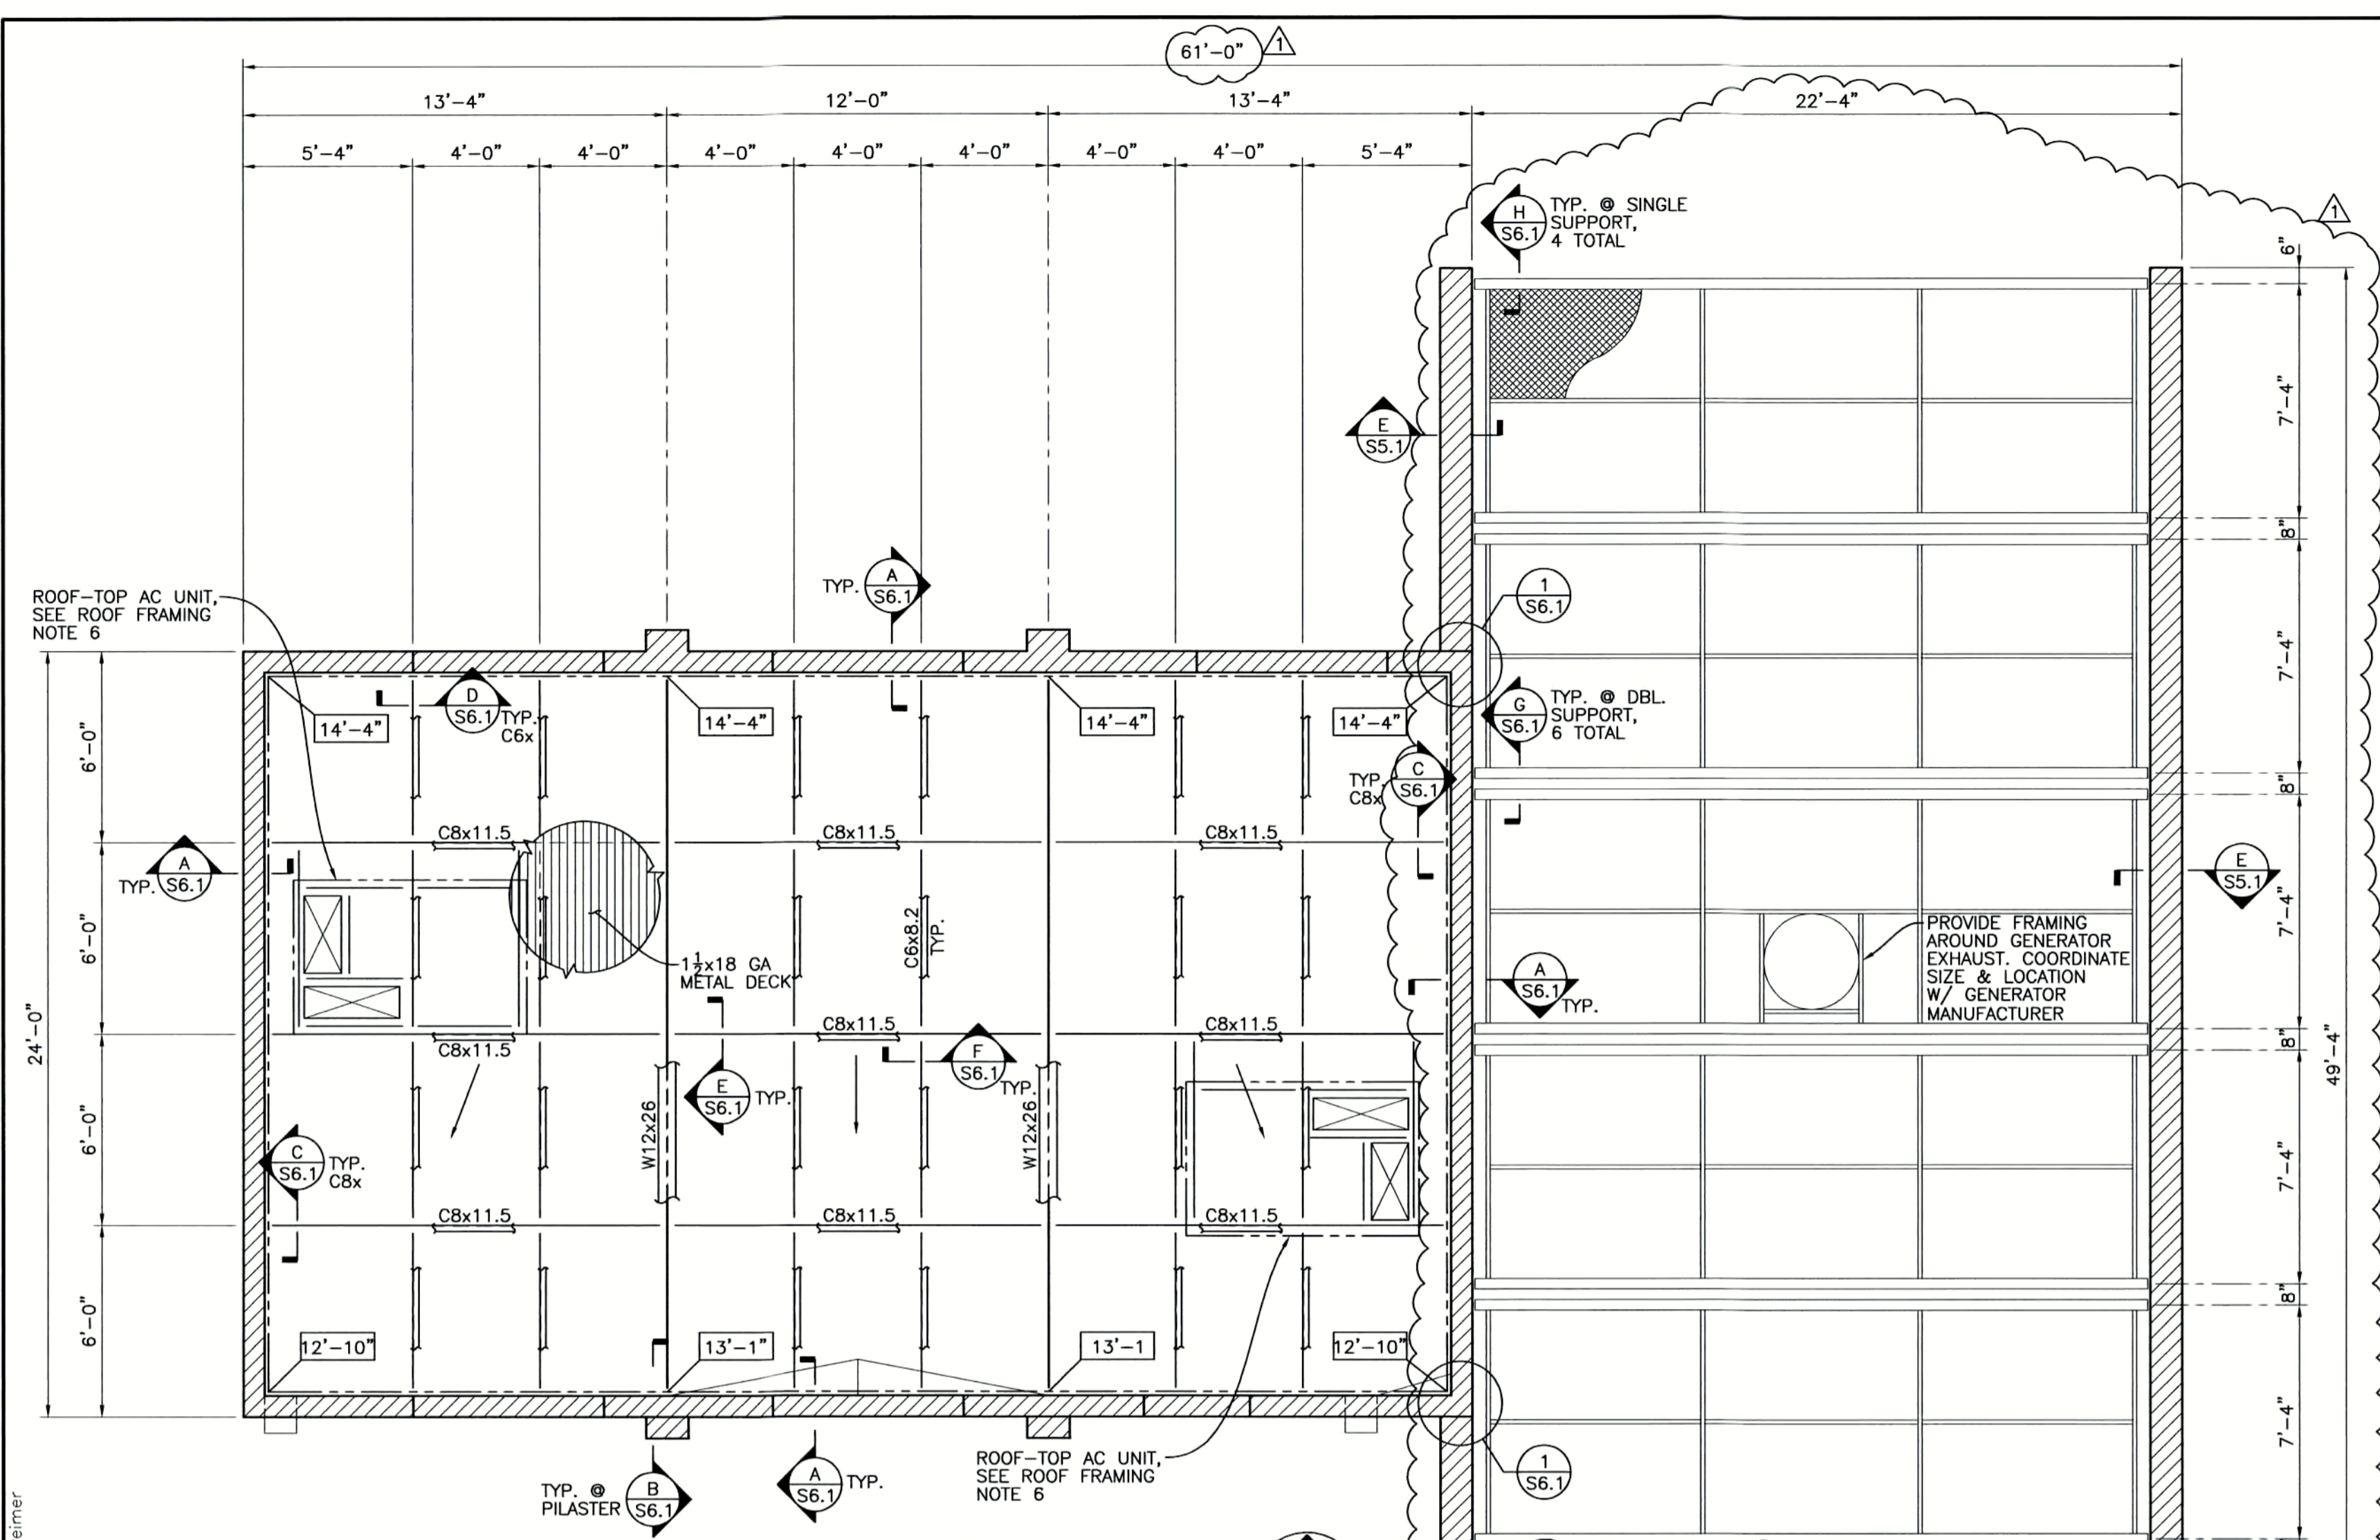


ROOF FRAMING PLAN
1/4" = 1'-0"

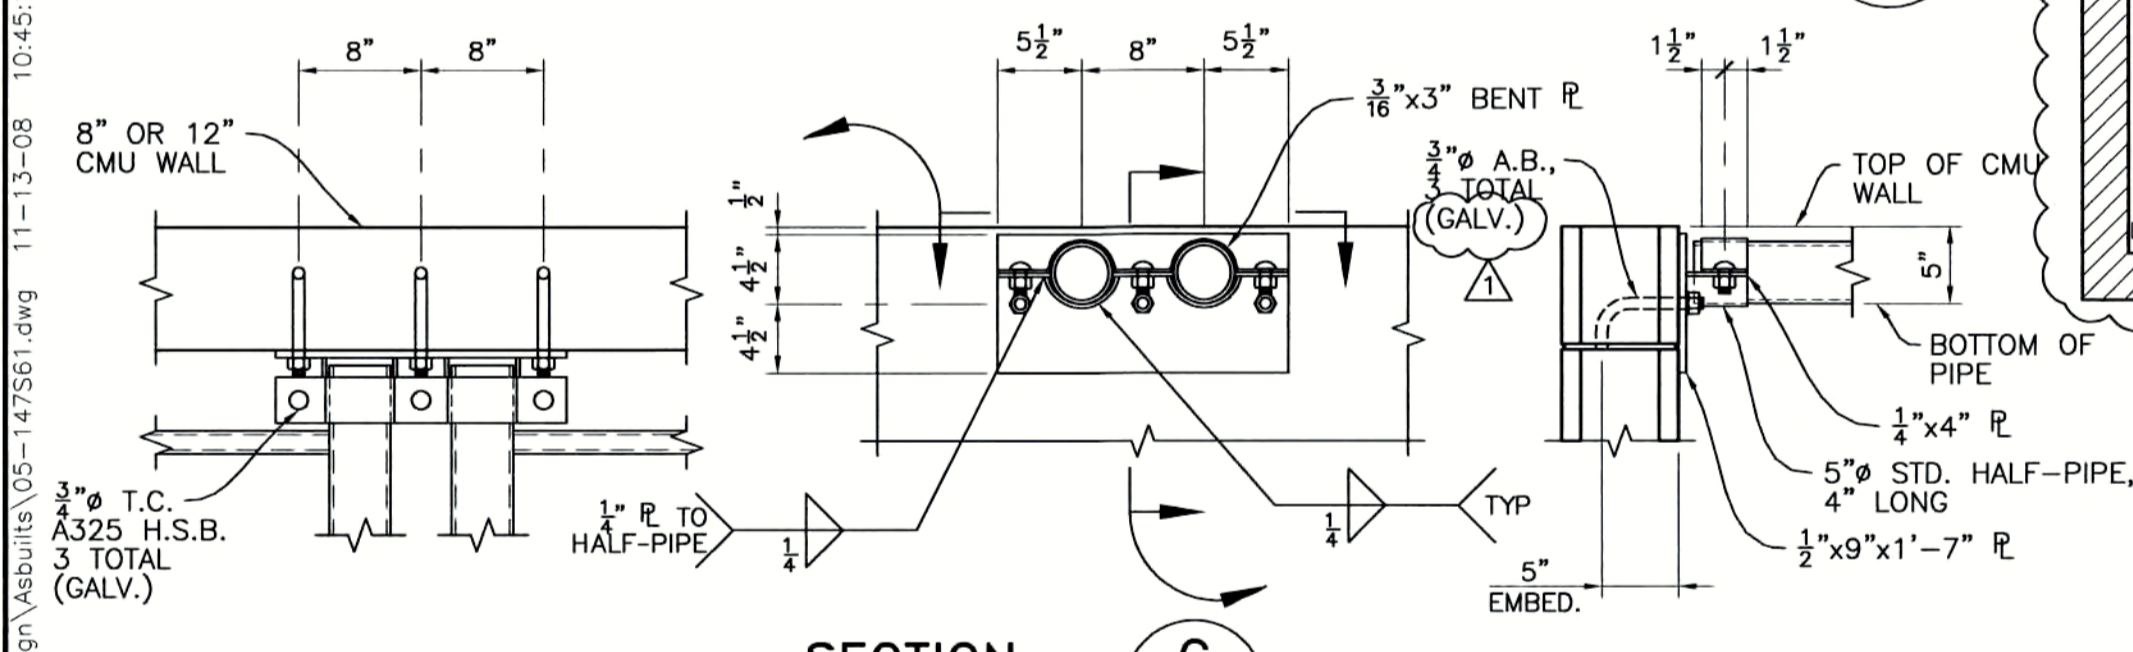


SECTION G
1" = 1'-0"

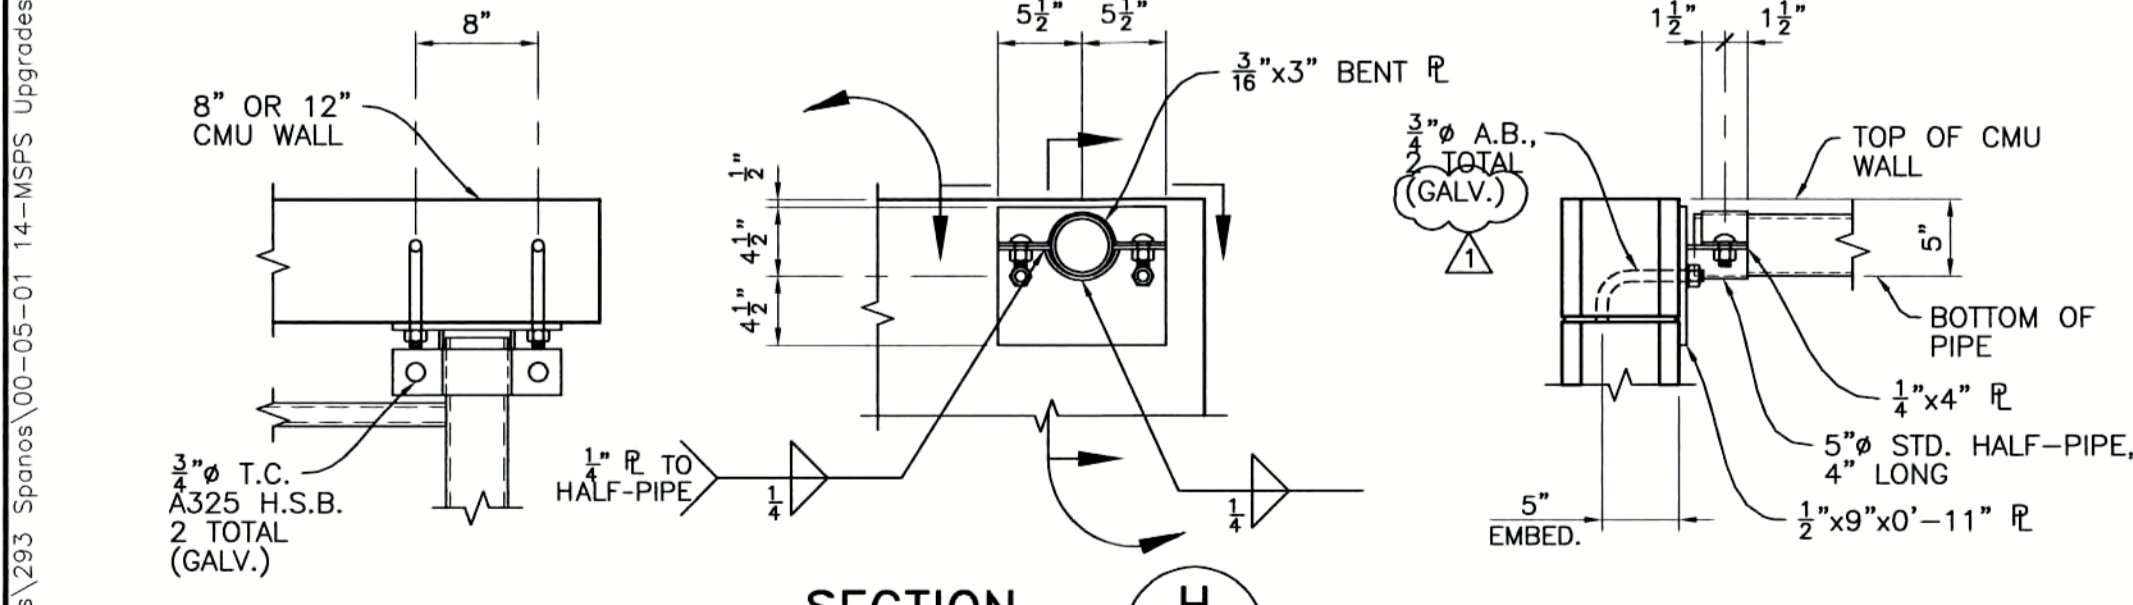


SECTION H
1" = 1'-0"

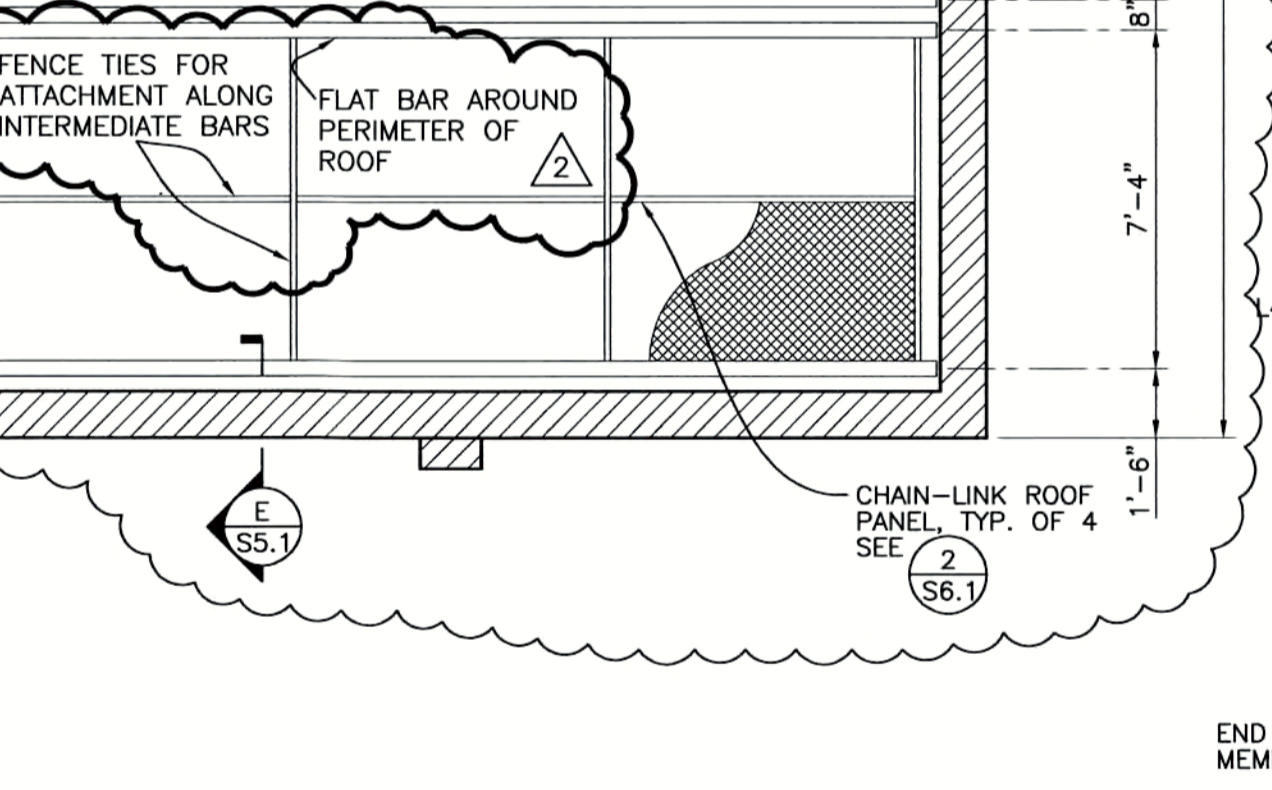


DETAIL 1
3/4" = 1'-0"

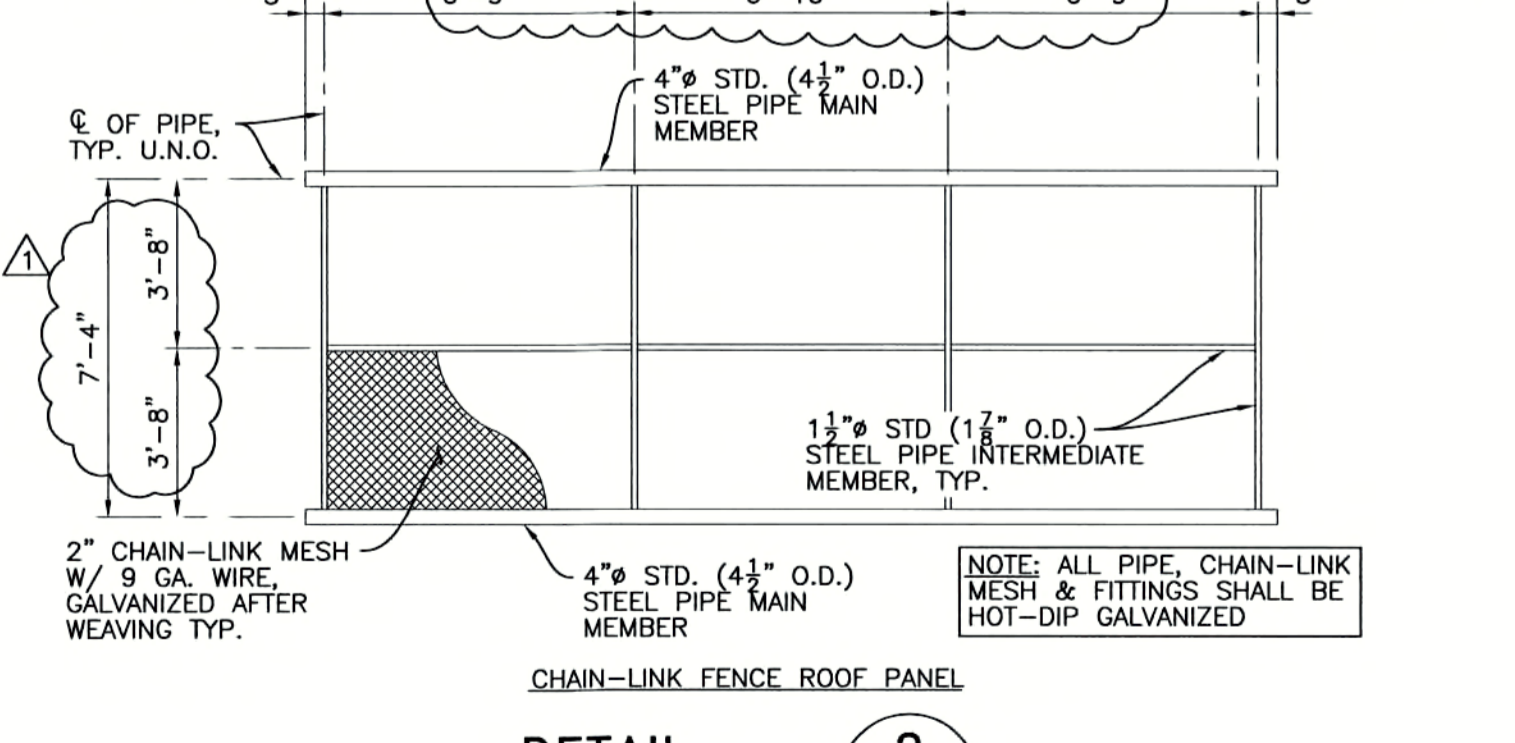


DETAIL 2
1/4" = 1'-0"

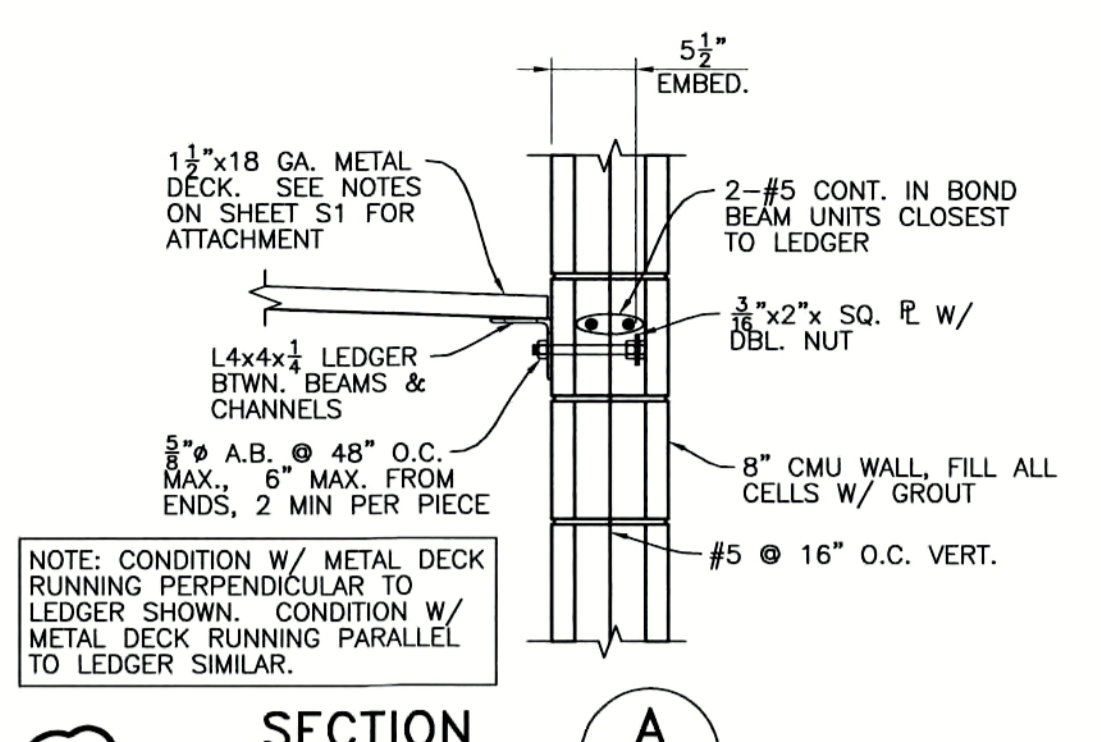


SECTION A
1" = 1'-0"

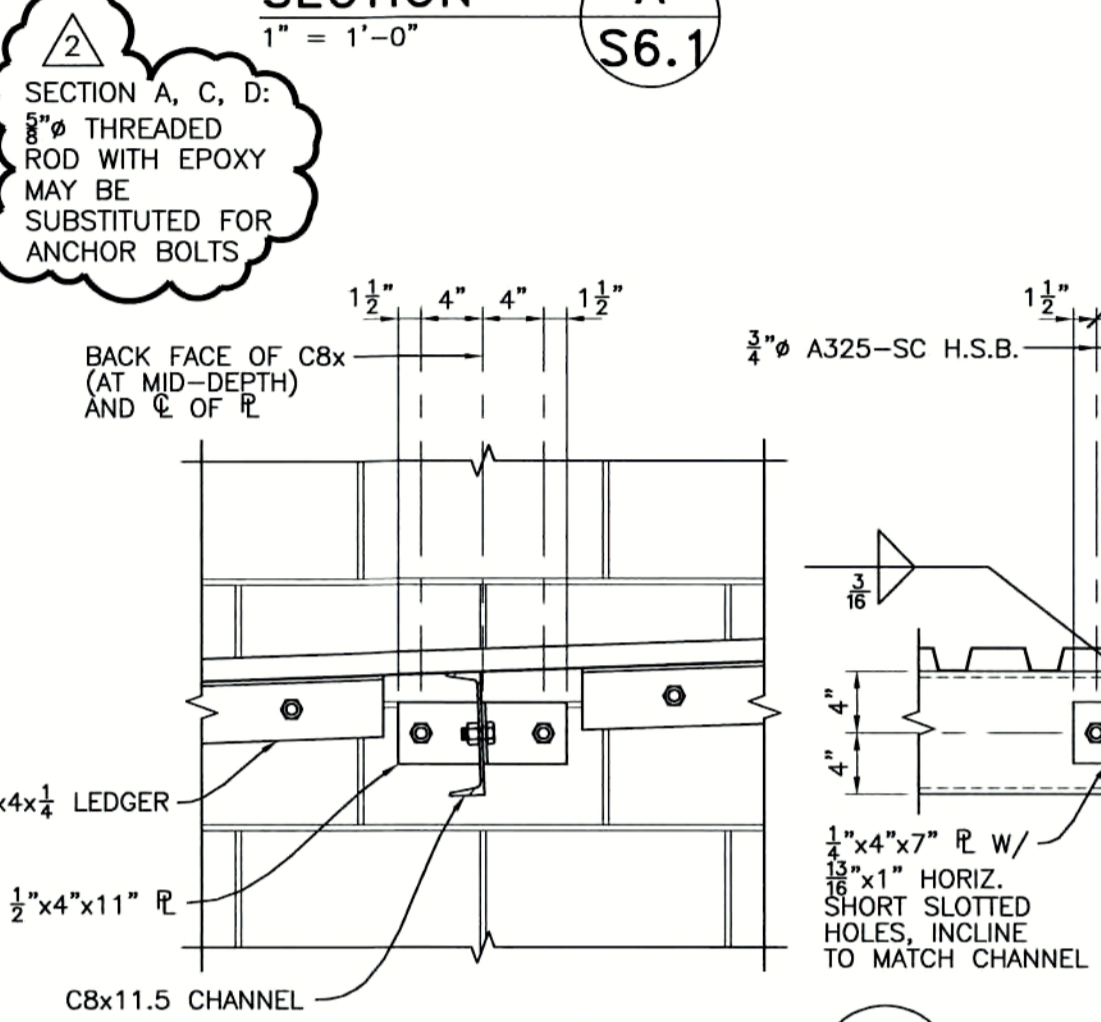


SECTION C
1" = 1'-0"

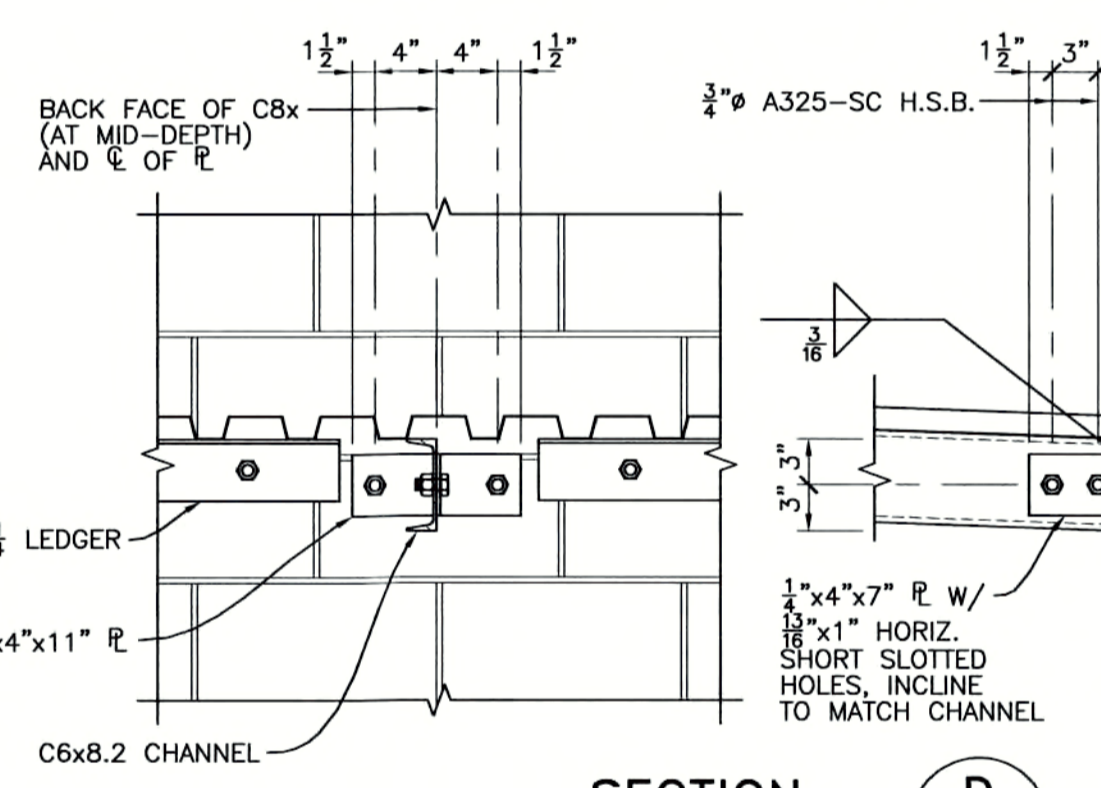


SECTION D
1" = 1'-0"

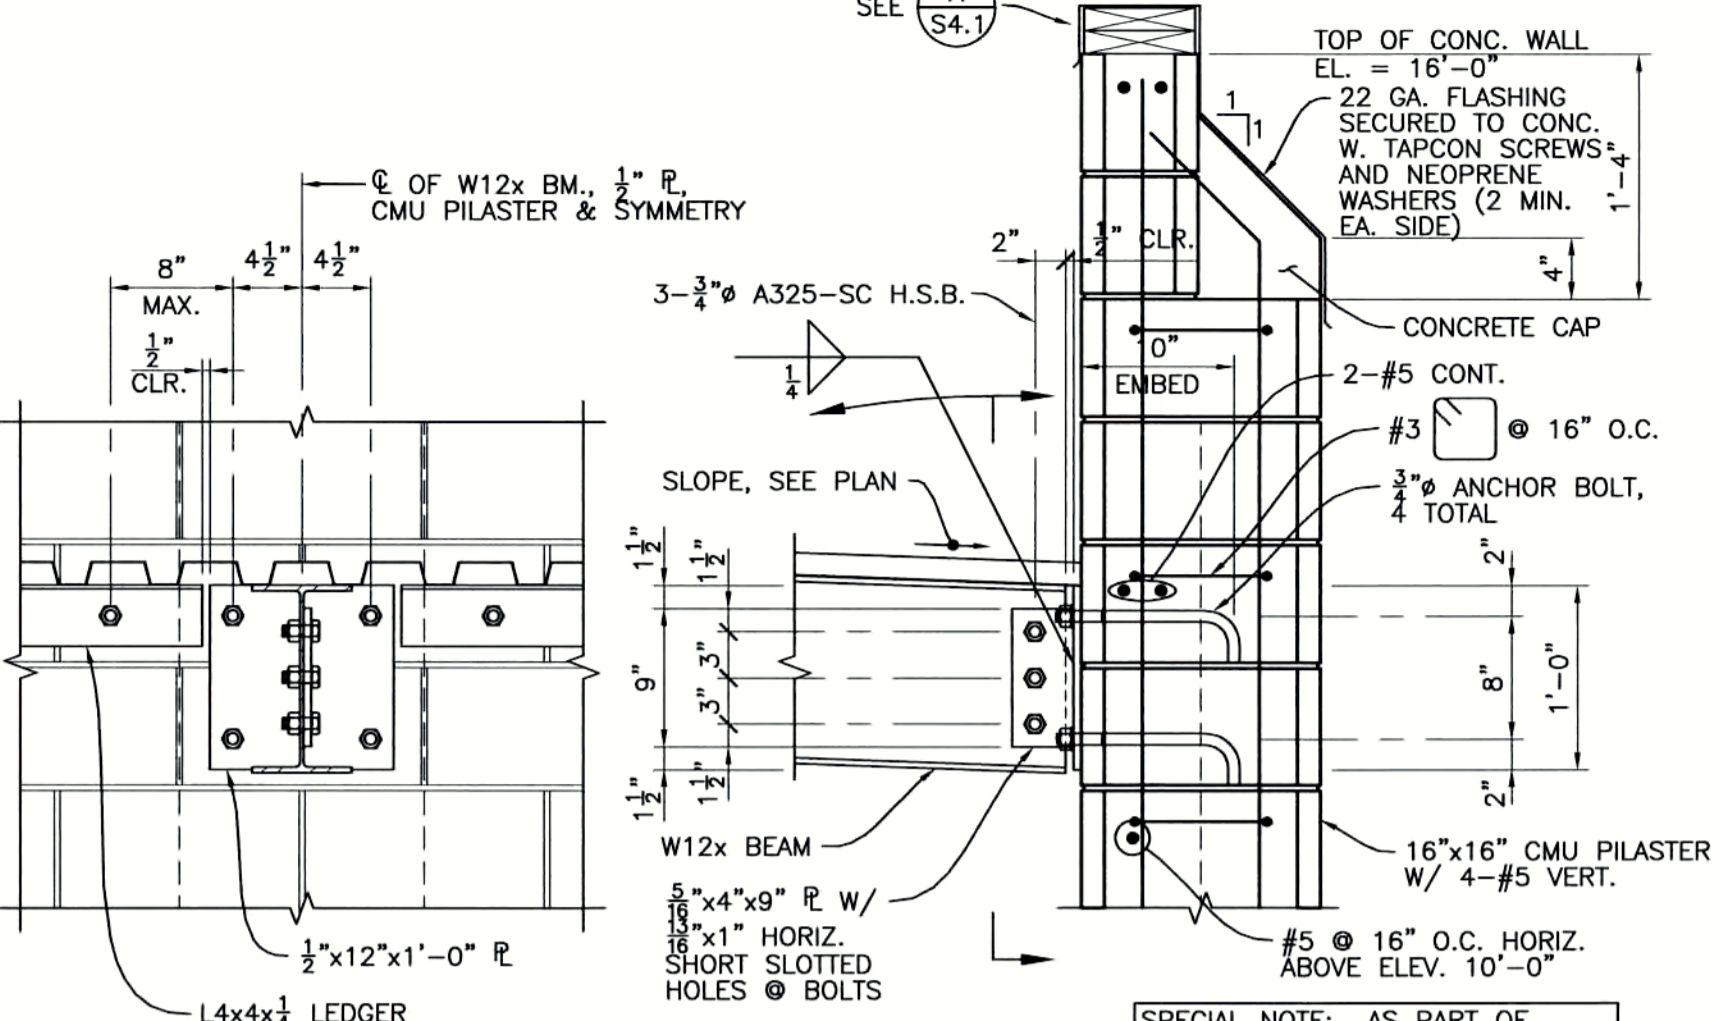

SECTION B
1" = 1'-0"

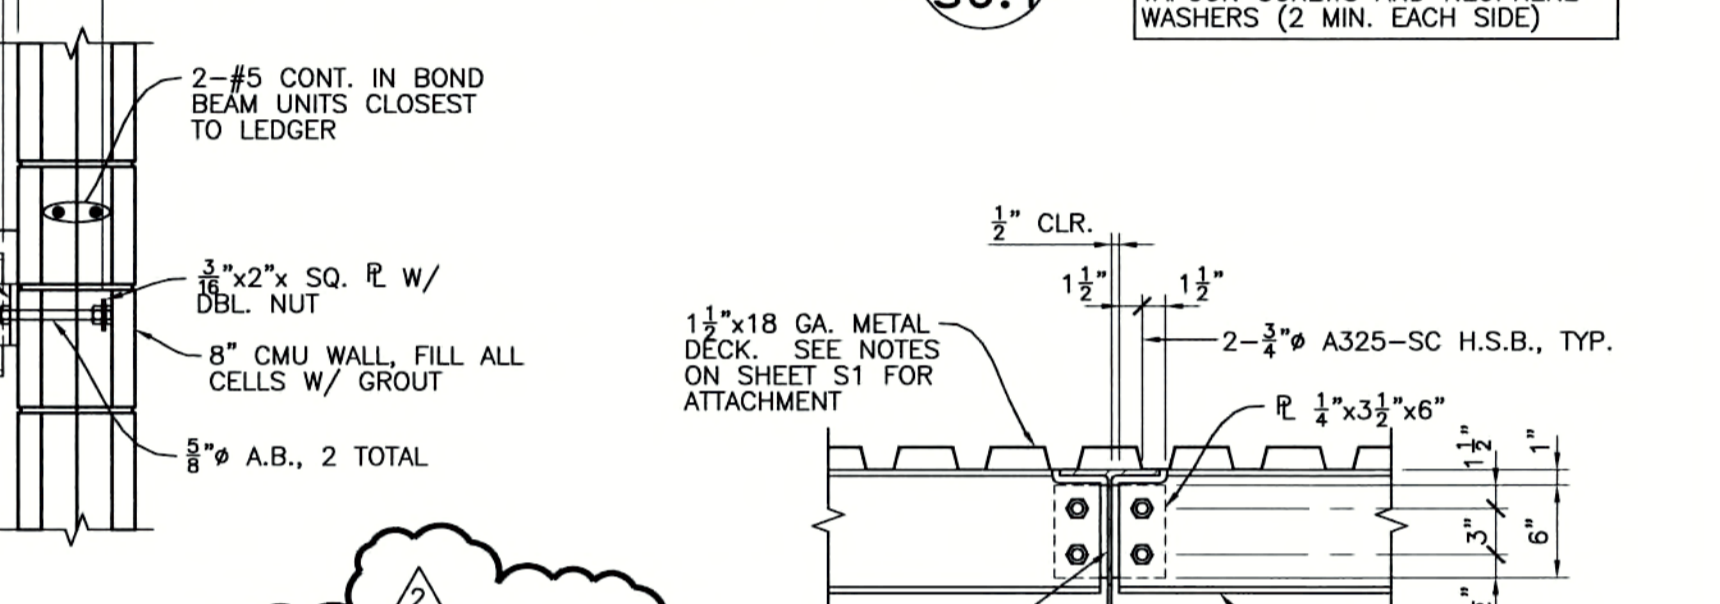

SECTION E
1" = 1'-0"

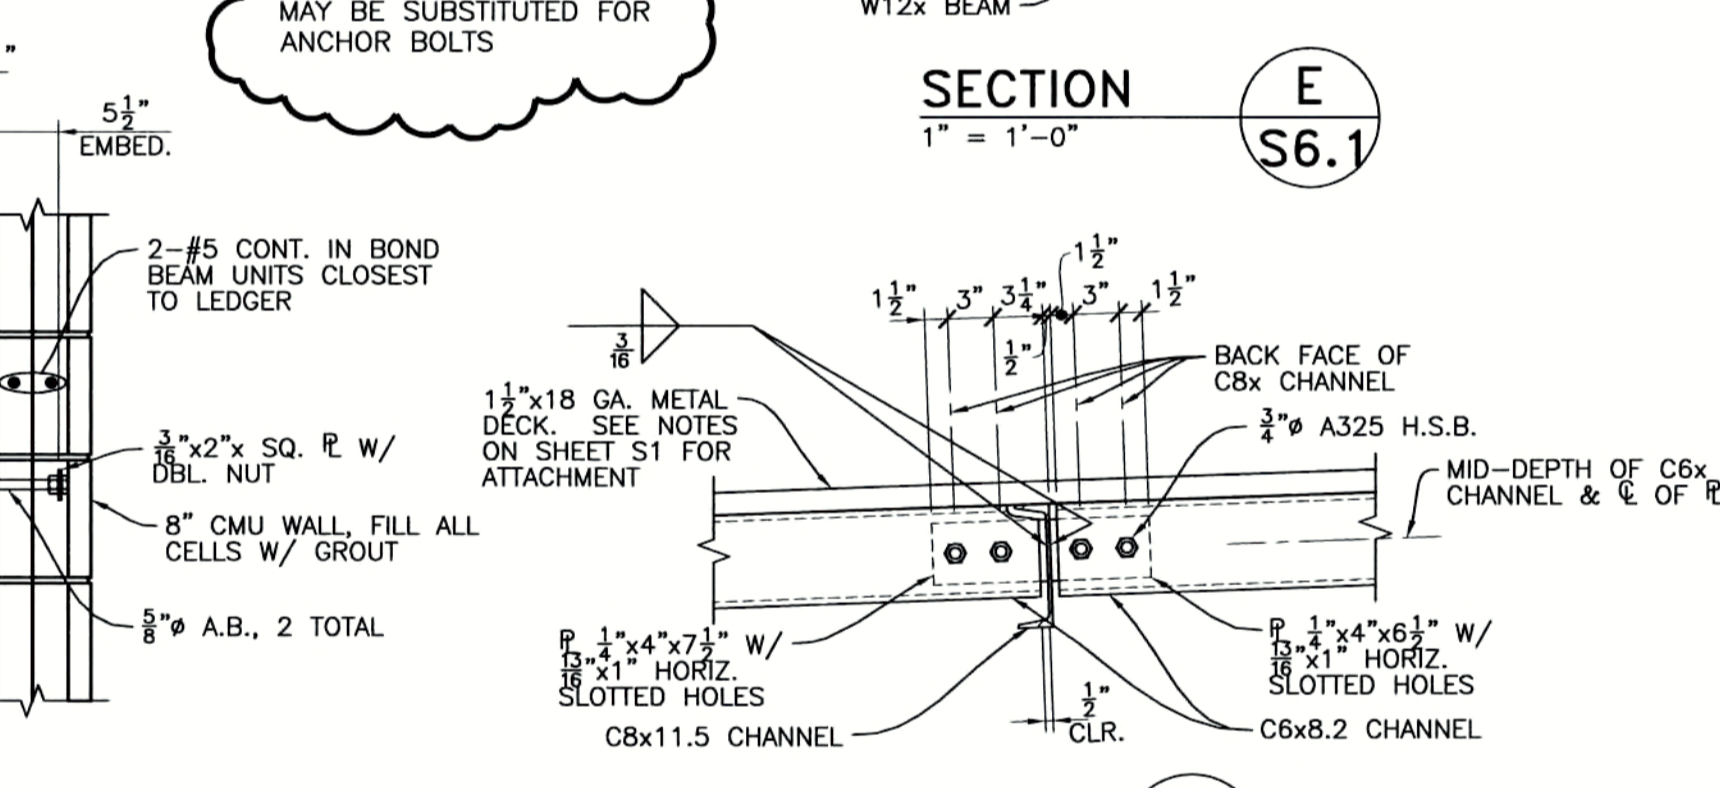

SECTION F
1" = 1'-0"

- ROOF FRAMING NOTES:**
- SEE GENERAL NOTES ON SHEET S1.
 - 13'-1 DENOTES TOP OF STEEL BEAM/LEDGER ELEVATION.
 - 13'-1 DENOTES DIRECTION OF ROOF SLOPE.
 - 13'-1 DENOTES CONCRETE BLOCK WALL. GROUT ALL CELLS SOLID.
 - SEE SHEET S3 FOR DIMENSIONS NOT SHOWN.
 - ROOF-TOP AC UNITS SHALL BE LOCATED PER THE MECHANICAL DWGS. SEE FLASHING DETAIL ON SHEET S4. C6x8.2 CHANNELS SHALL BE PROVIDED BENEATH PERIMETER OF UNIT AND AROUND PERIMETER OF ALL OPENINGS IN METAL DECK. SEE S6.1

RECORD DRAWINGS
14-Mile Slough Pump Station Upgrades
ROOF FRAMING PLAN, SECTIONS & DETAILS

DEPARTMENT OF MUNICIPAL UTILITIES CITY OF STOCKTON, CALIFORNIA		
SCALE: AS SHOWN	APPROVED BY: DATE: _____	SHEET No. S6.1
DESIGNED BY: JAF	ASSISTANT DIRECTOR, DEPT. OF MUNICIPAL UTILITIES	36 of 89 SHEETS
DRAWN BY: REM		PROJECT No. 293-00-05-01
CHECKED BY: JAF		
RECORD Dwg.:		

Underground Service Alert

TWO DAYS BEFORE YOU DIG


Call TOLL FREE: 1-800-642-2444

REFER TO SET FOR SIGNATURE

REV. No.	DISCRPTION	DATE	BY	Apr'd By
1	REVISED GENERATOR ENCLOSURE	2/5/07	JAF	PDF
2	RECORD DRAWINGS	8/6/08	MAH	PDF







WEST YOST ASSOCIATES
Consulting Engineers

1260 Lake Boulevard
Suite 240
Davis, California 95616
(530) 756-5905
FAX (530) 756-5991

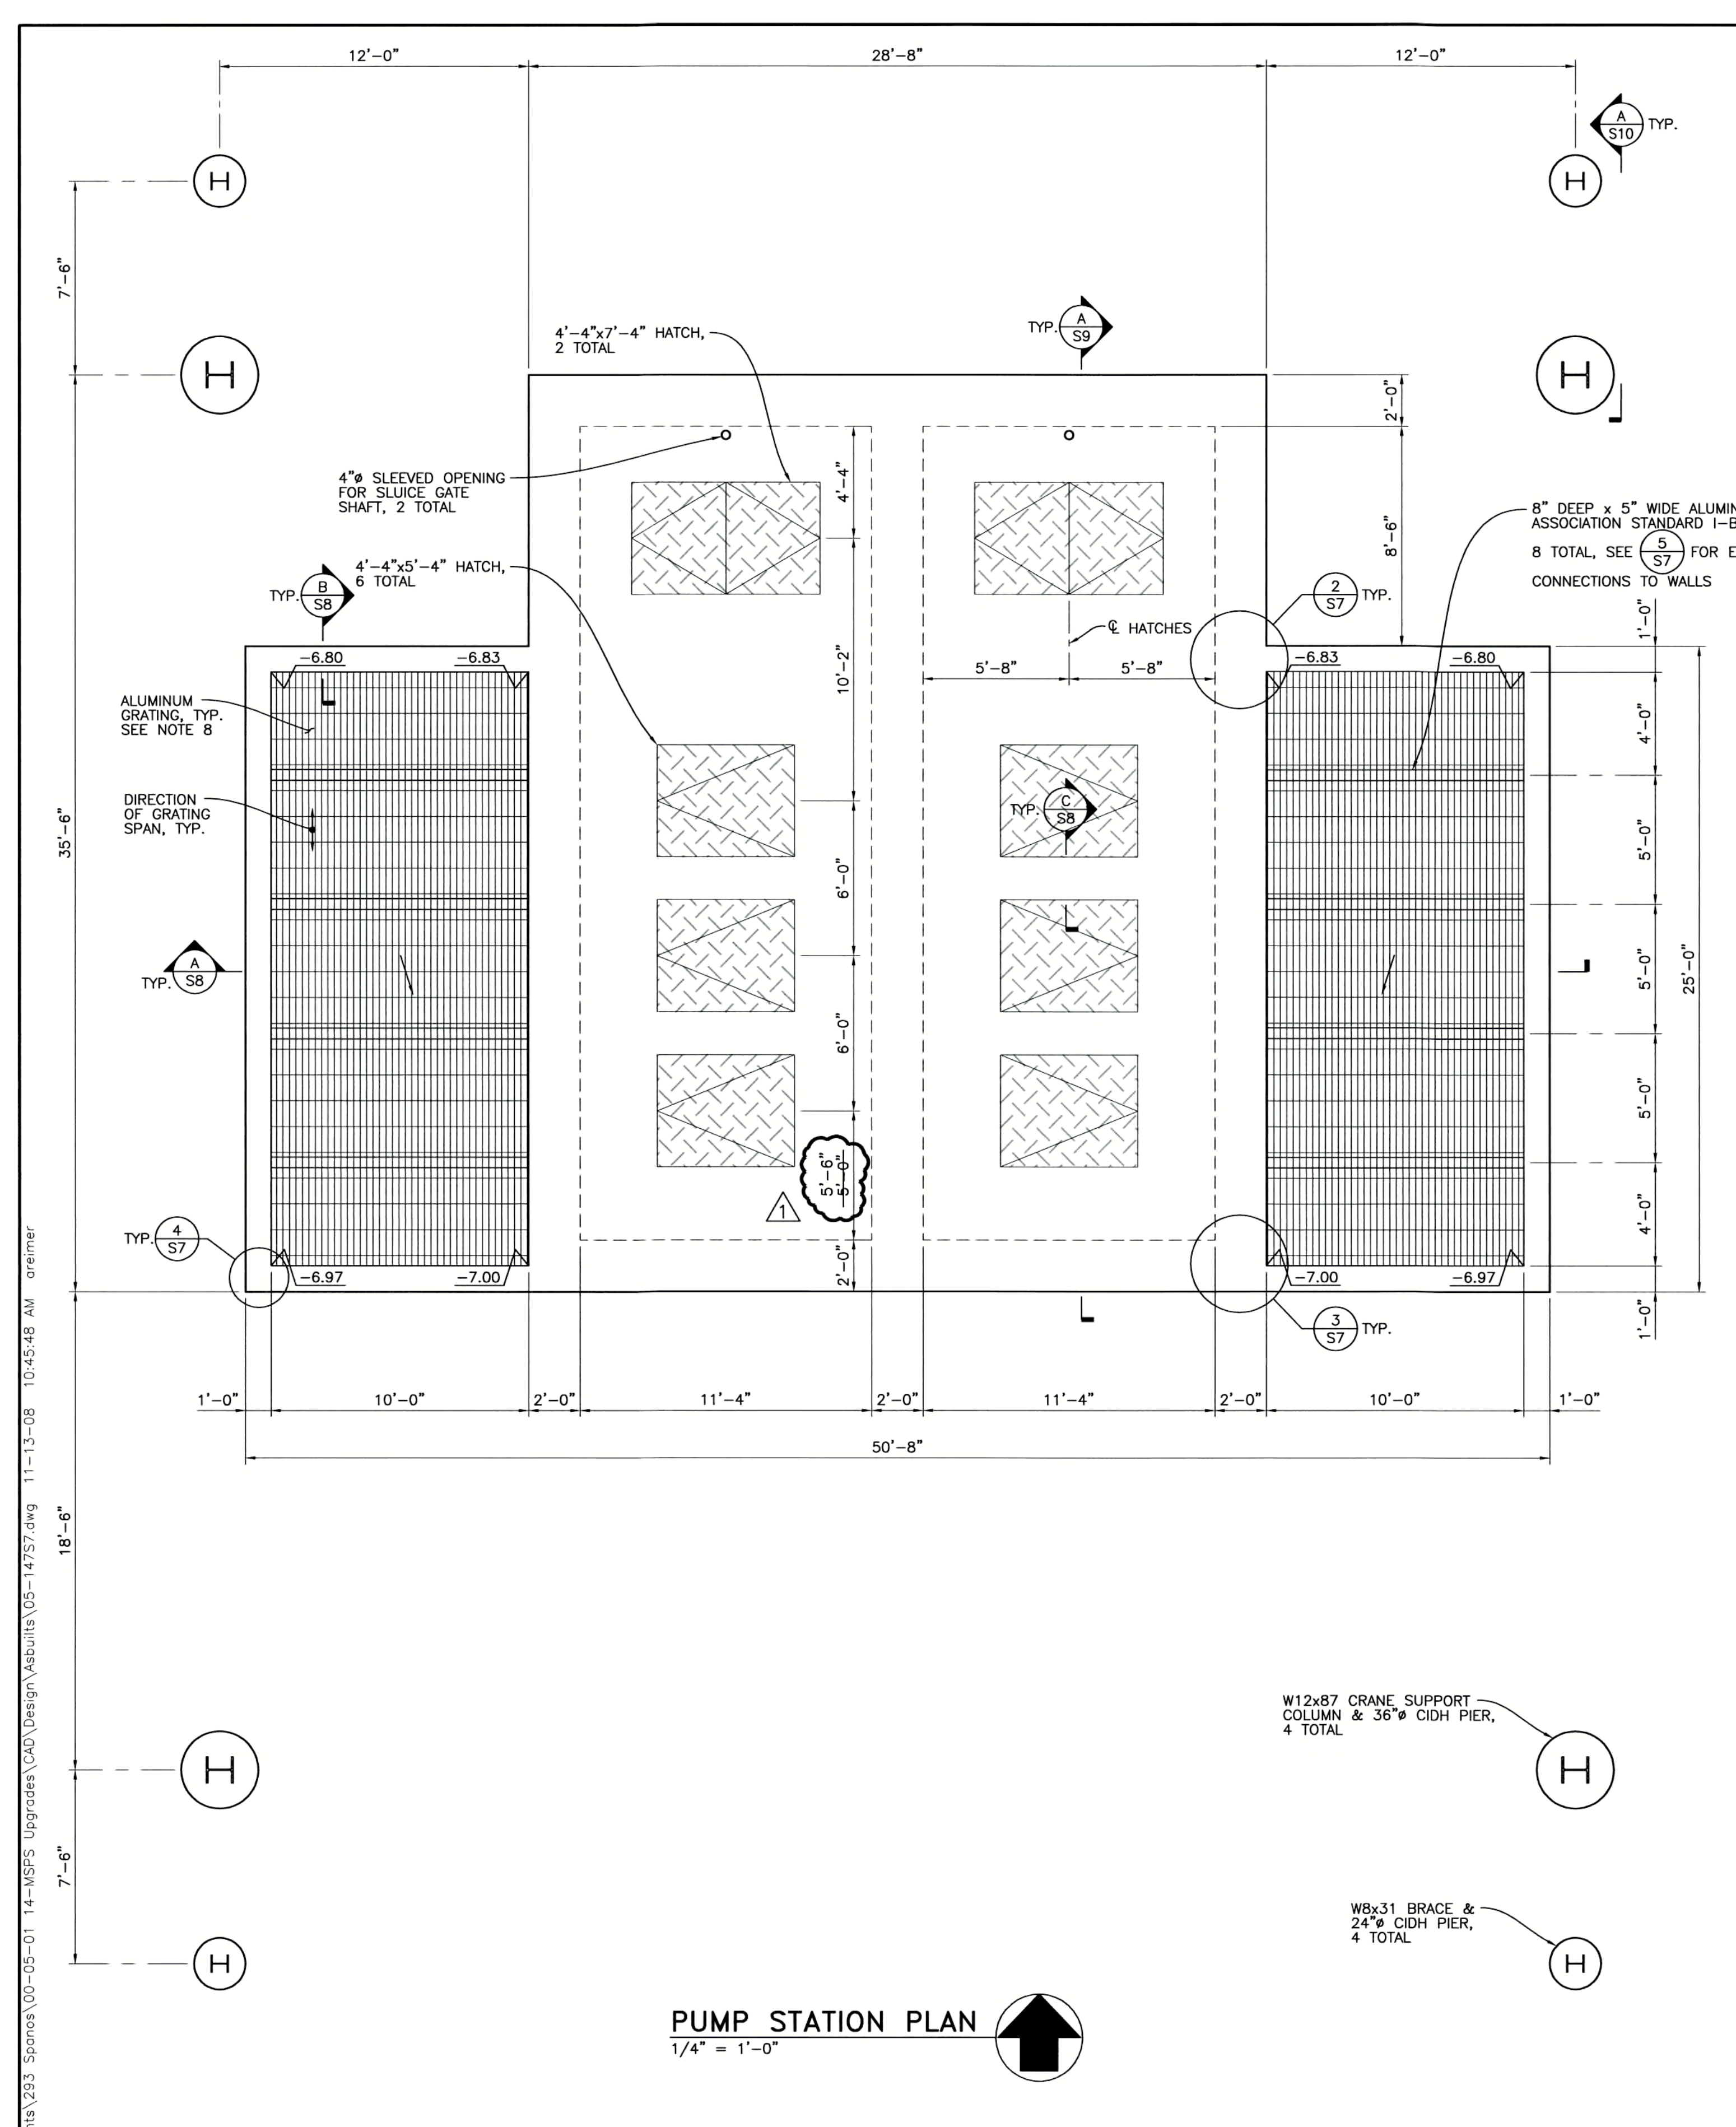

- PUMP STATION NOTES:**
- SEE GENERAL NOTES ON SHEET S1.
 - 8.00 DENOTES TOP OF VALVE VAULT CONC. BOTTOM SLAB
 - DENOTES DIRECTION OF CONC. SLAB SLOPE. PROVIDE A MIN. SLOPE OF 0.5%.
 - SEE MECH. DWGS. FOR PROFILE & ELEVATIONS OF MASS CONC. FILL. SEE PROJECT SPECIFICATIONS FOR MATERIAL REQUIREMENTS FOR MASS CONC. FILL.
 - ALL INTERIOR EXPOSED CONC. SURFACES ABOVE FLOOR OF PUMP STATION STRUCTURE SHALL BE PROTECTED WITH CORROSION PROTECTION LINER. ALL EXTERIOR SURFACES OF PUMP STATION CONC. WALLS SHALL BE MOISTURE-PROOFED.
 - THE MAXIMUM EXPECTED ELEVATION OF THE WATER TABLE IS 2'-0" BELOW GRADE. THE CONTRACTOR SHALL PROVIDE FOR THE COMPLETE DEWATERING OF THE EXCAVATION AS REQUIRED BY THE PROJECT SPECIFICATIONS & PROJECT SOILS REPORT.
 - REINFORCING TIES IN CONC. WALLS SHALL HOOK AROUND HORIZONTAL & VERTICAL BARS AND SHALL ALTERNATE DIRECTION & ORIENTATION AS SHOWN.
 - ALUMINUM GRATING SHALL BE 1 1/2" DEEP W/ 3/8" WIDE MAIN BARS @ 12" O.C. AND 1/2" WIDE CROSS BARS @ 4" O.C. MAX. SPAN SHALL BE 5'-0". SEE PROJECT SPECIFICATIONS FOR FURTHER REQUIREMENTS.

PUMP STATION REINFORCEMENT SCHEDULE				
MARK	ZONE	BAR SIZE	SPACING	NOTES
'a' BARS	A	#9	12" O.C.	
	B	#9	6" O.C.	
	C	#8	6" O.C.	
'b' BARS	A	#7	12" O.C.	
	B	#7	6" O.C.	
	C	#9	6" O.C.	
'c' BARS	A	#9	12" O.C.	'c' BARS & EVERY OTHER 'd' BAR SHALL BE CONTINUOUS BARS
	B	#8	6" O.C.	
	C	#9	12" O.C.	
'd' BARS	A	#9	6" O.C.	SEE NOTE FOR 'c' BARS.
	B	#8	3" O.C.	
	C	#9	6" O.C.	
'e' BARS	A	#7	6" O.C.	LAP W/ EVERY OTHER 'g' BAR
	B	#8	6" O.C.	
	C	#7	6" O.C.	
'f' BARS	A	#8	6" O.C.	
	B	#9	6" O.C.	
	C	#7	6" O.C.	
'g' BARS	A	#7	3" O.C.	1/2"-0" BARS @ 6" O.C. & 1/2"-0" BARS @ 6" O.C. SEE (B/S7)
	B	#8	3" O.C.	
	C	#7	3" O.C.	

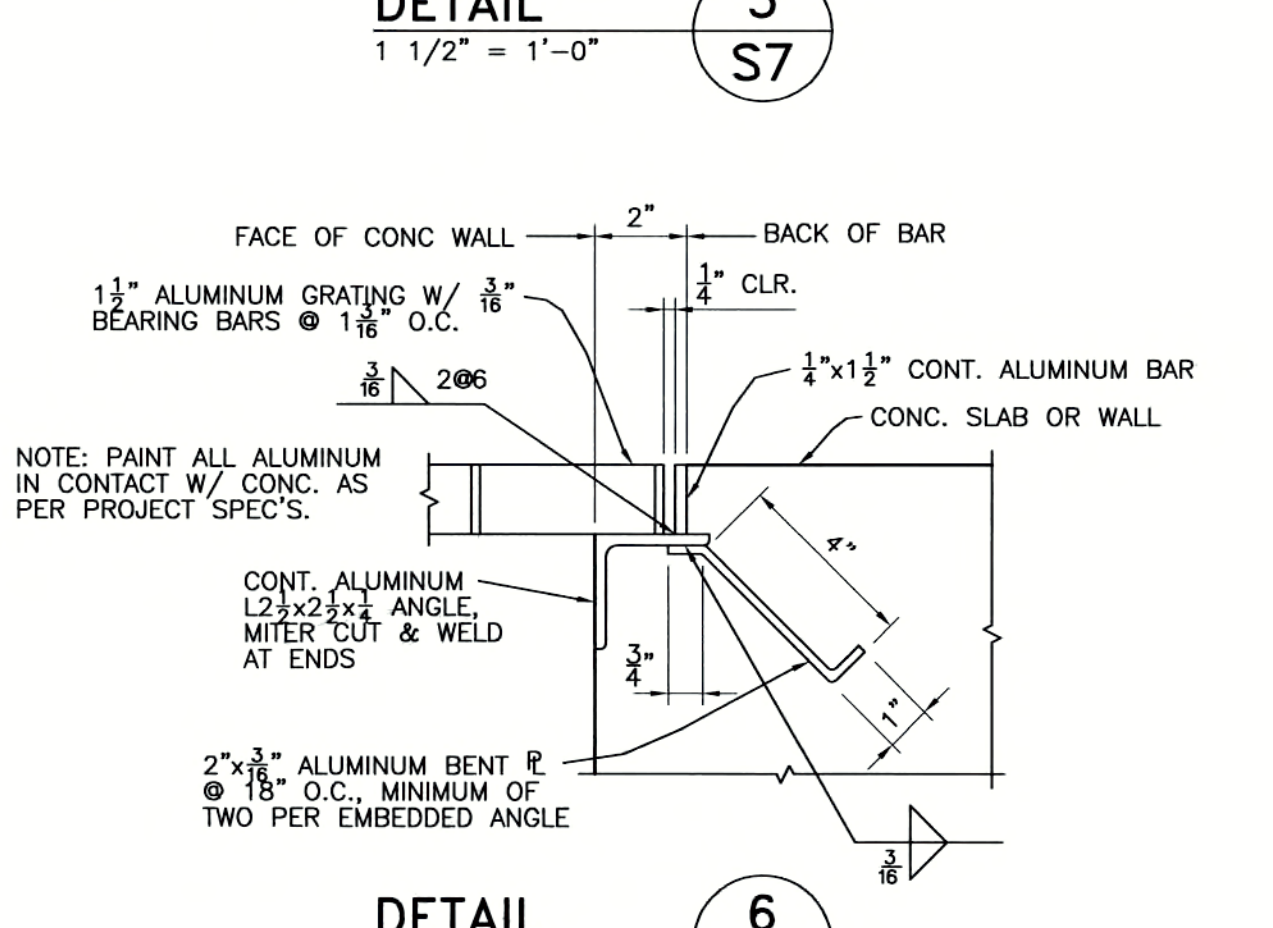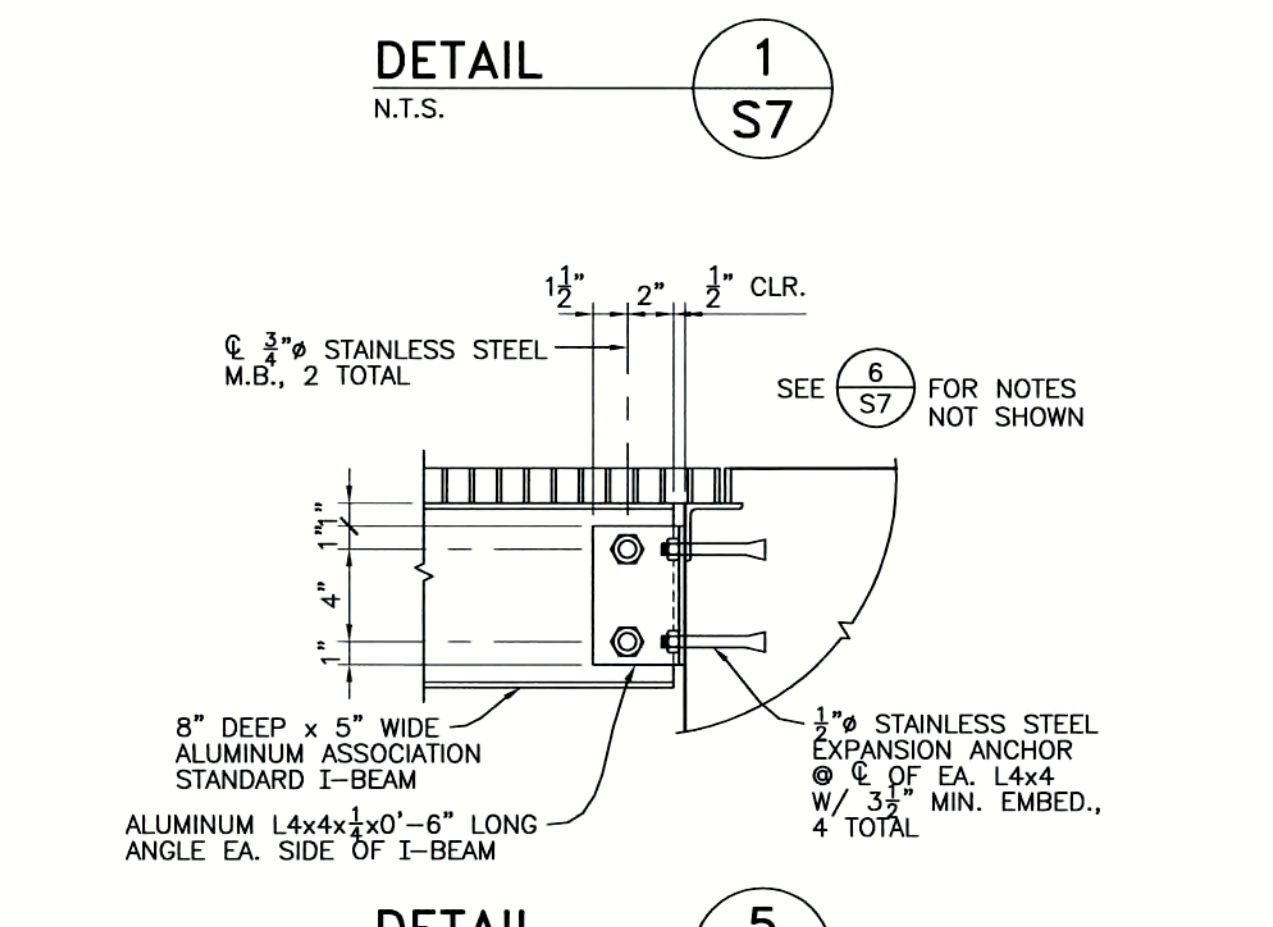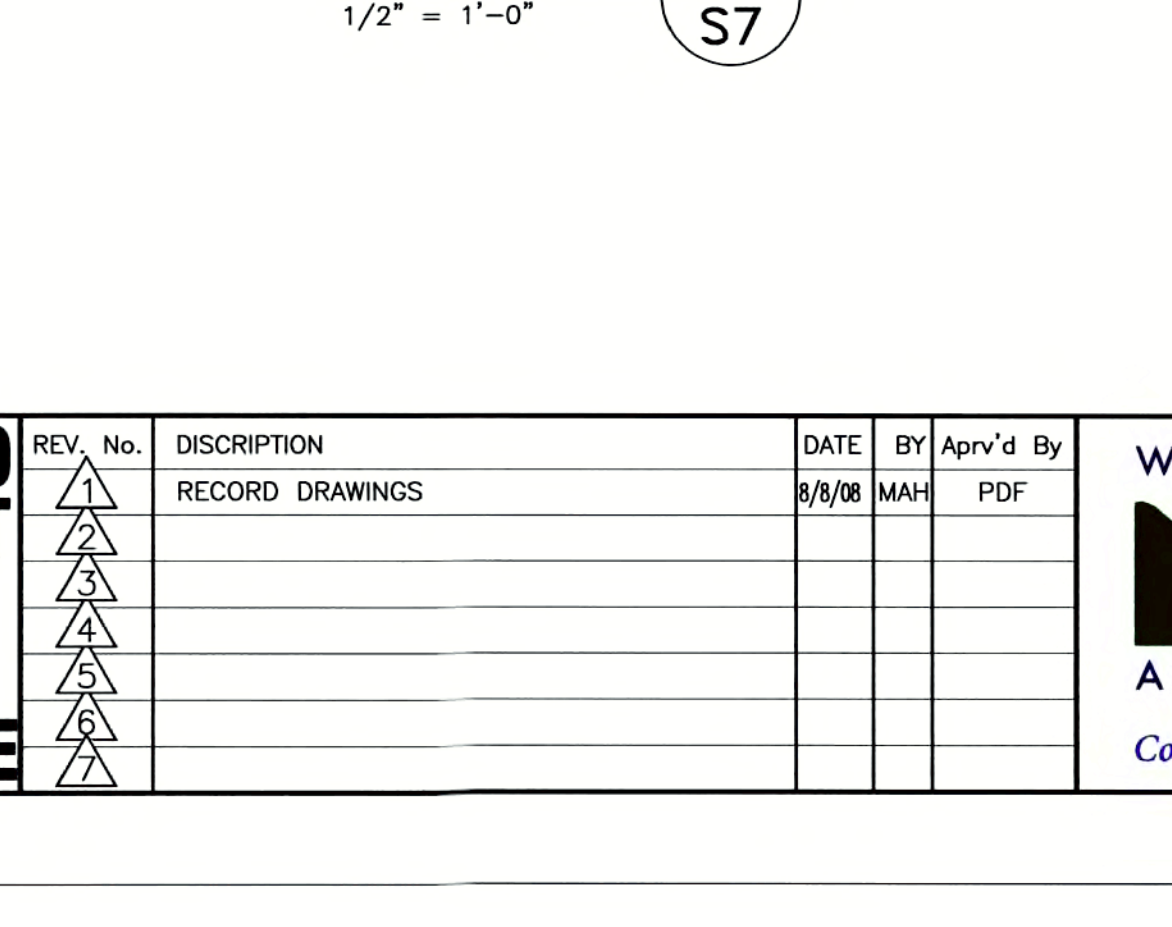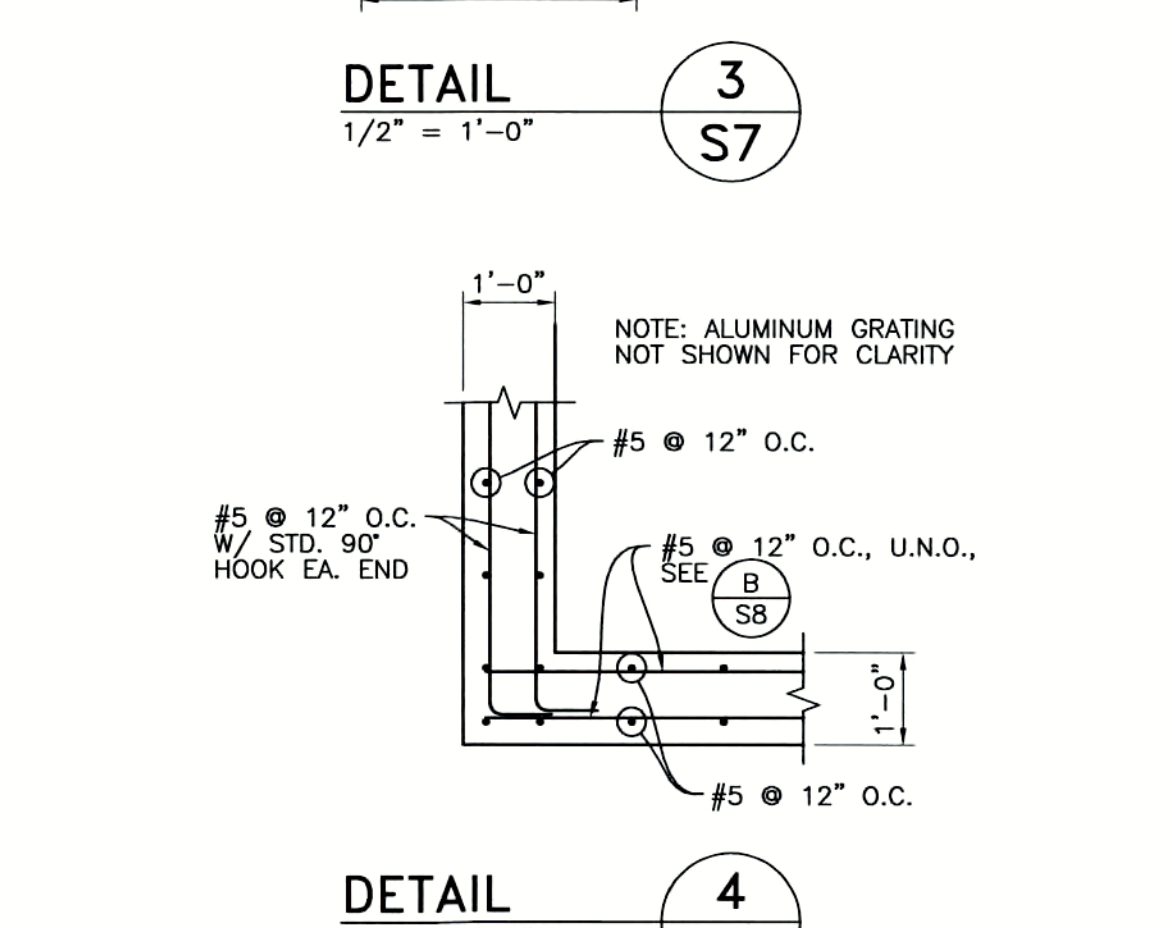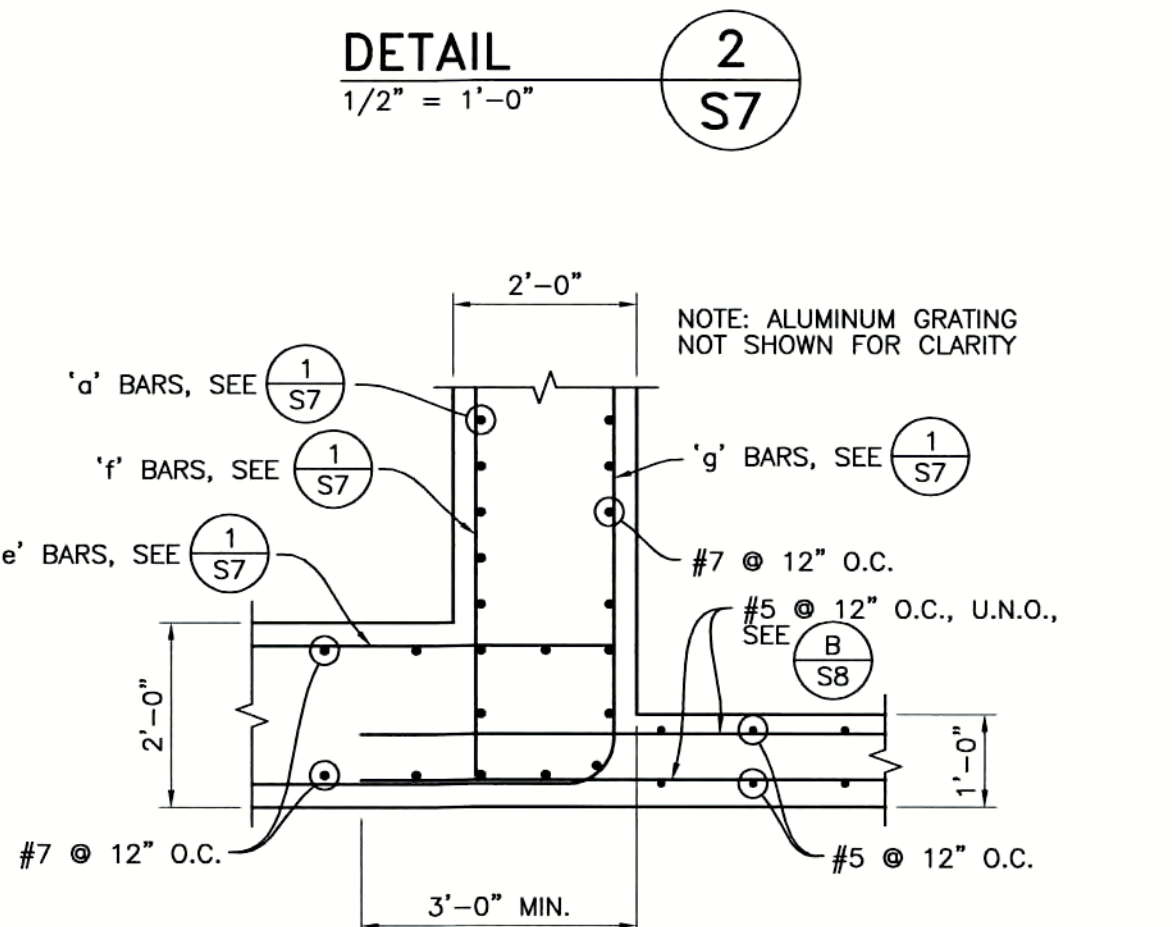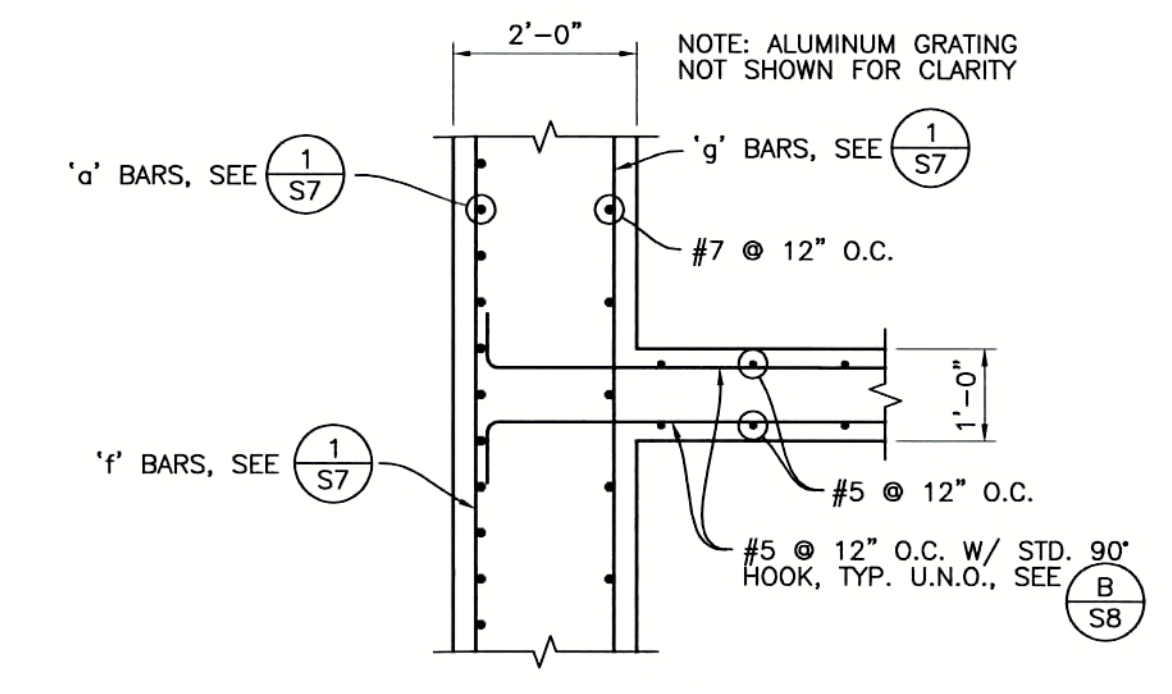

RECORD DRAWINGS
14-Mile Slough Pump Station Upgrades
PUMP STATION PLAN, NOTES & DETAILS

DEPARTMENT OF MUNICIPAL UTILITIES
CITY OF STOCKTON, CALIFORNIA

SCALE: AS SHOWN
DESIGNED BY: TEE
DRAWN BY: REM
CHECKED BY: JAF
RECORD Dwg.:

APPROVED BY: DATE: _____
ASSISTANT DIRECTOR, DEPT. OF MUNICIPAL UTILITIES

SHEET No. **S7**
37 of 89 SHEETS
PROJECT No. 293-00-05-01

Underground Service Alert

TWO DAYS BEFORE YOU DIG






Call TOLL FREE: 1-800-642-2444

REFER TO BID SET FOR SIGNATURE

REV. No.	DISCRPTION	DATE	BY	Apr'd By
1	RECORD DRAWINGS	8/8/08	MAH	PDF

WEST YOST ASSOCIATES
Consulting Engineers

1260 Lake Boulevard
Suite 240
Davis, California 95616
(530) 756-5905
FAX (530) 756-5991

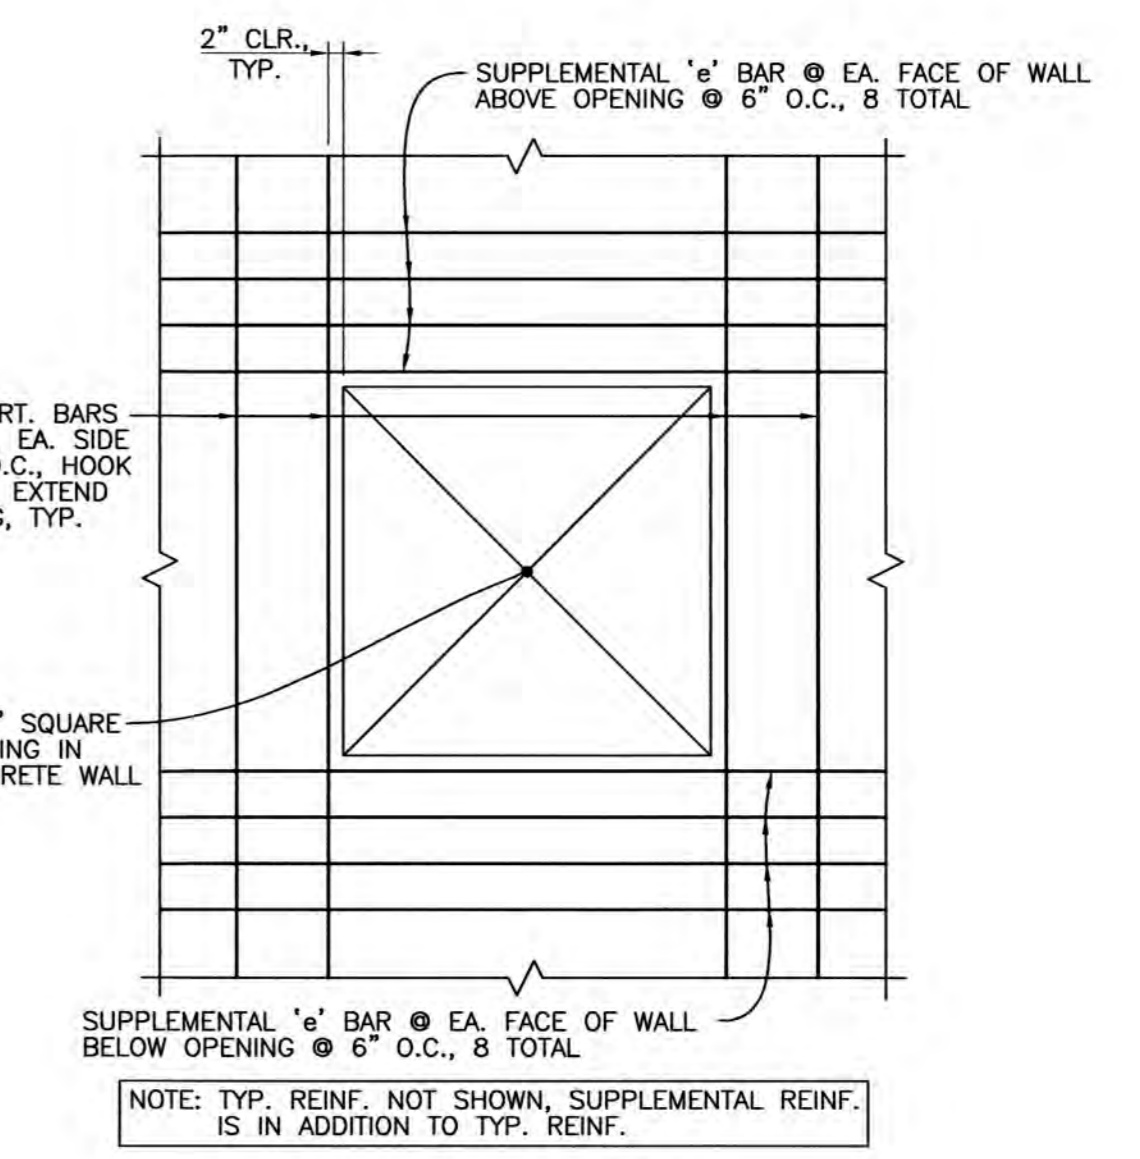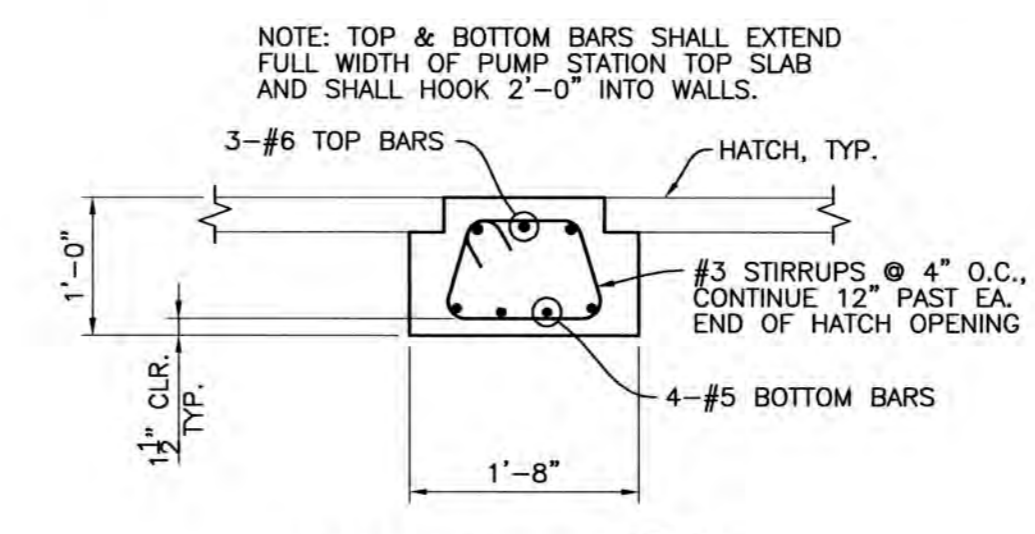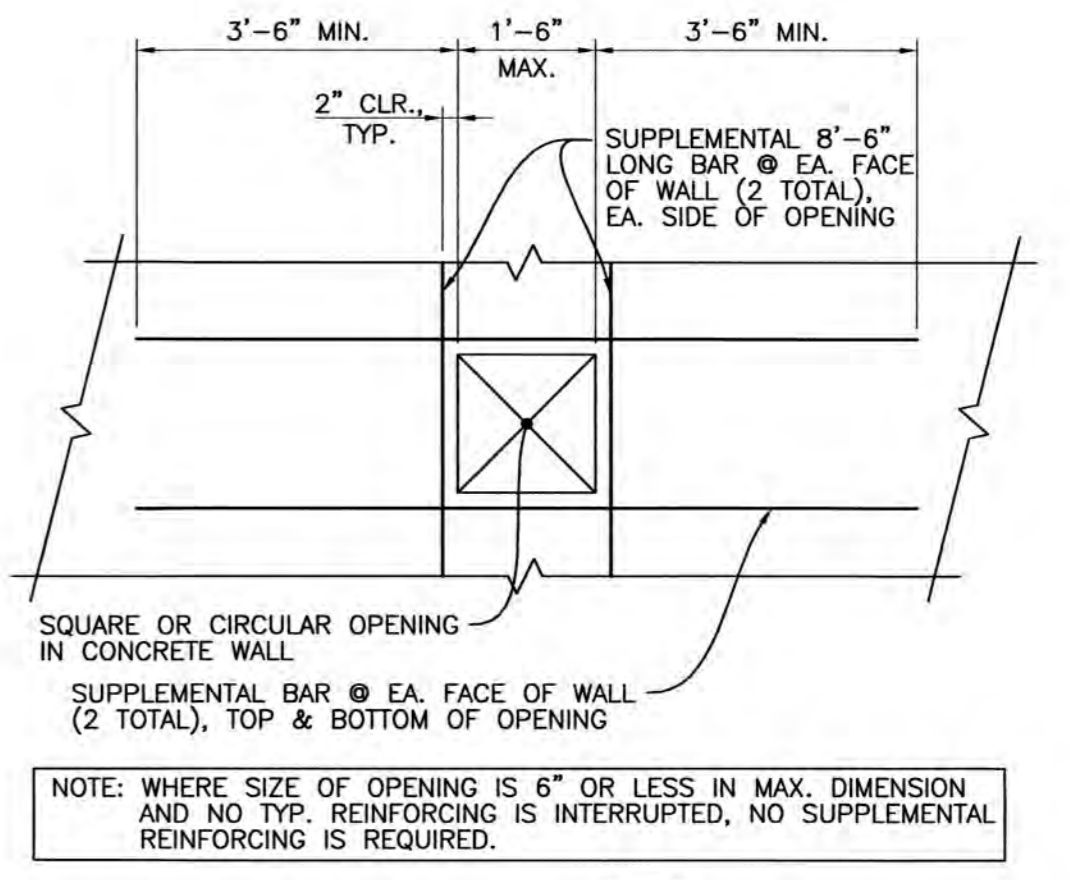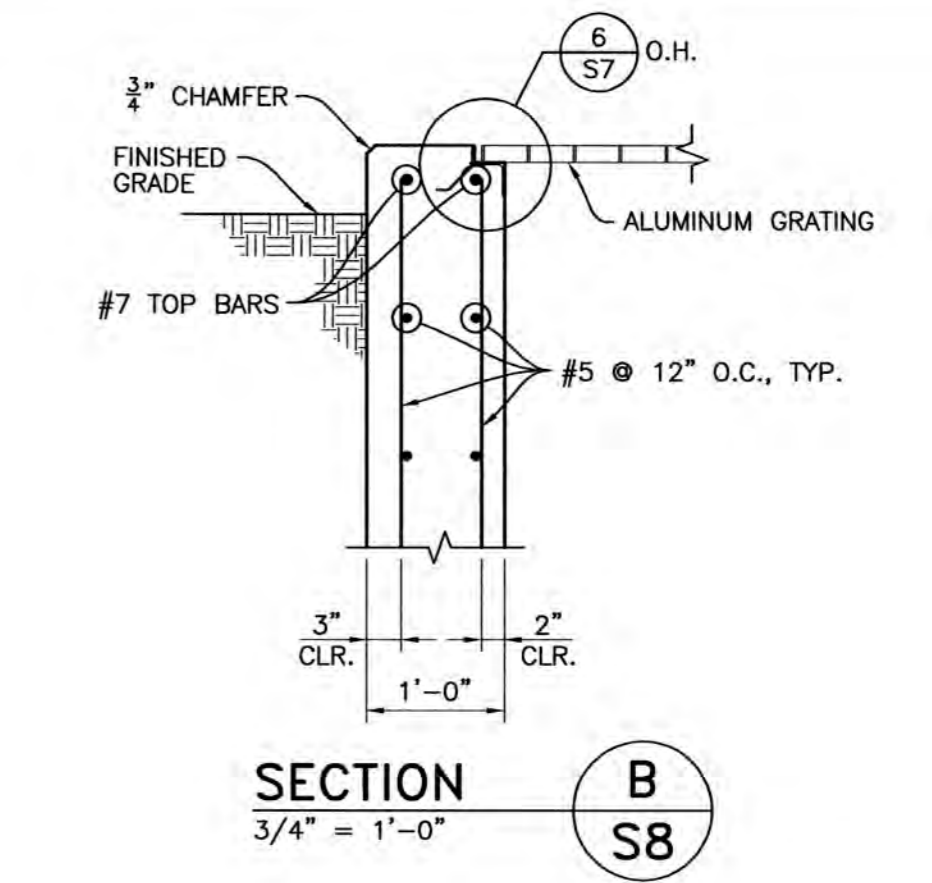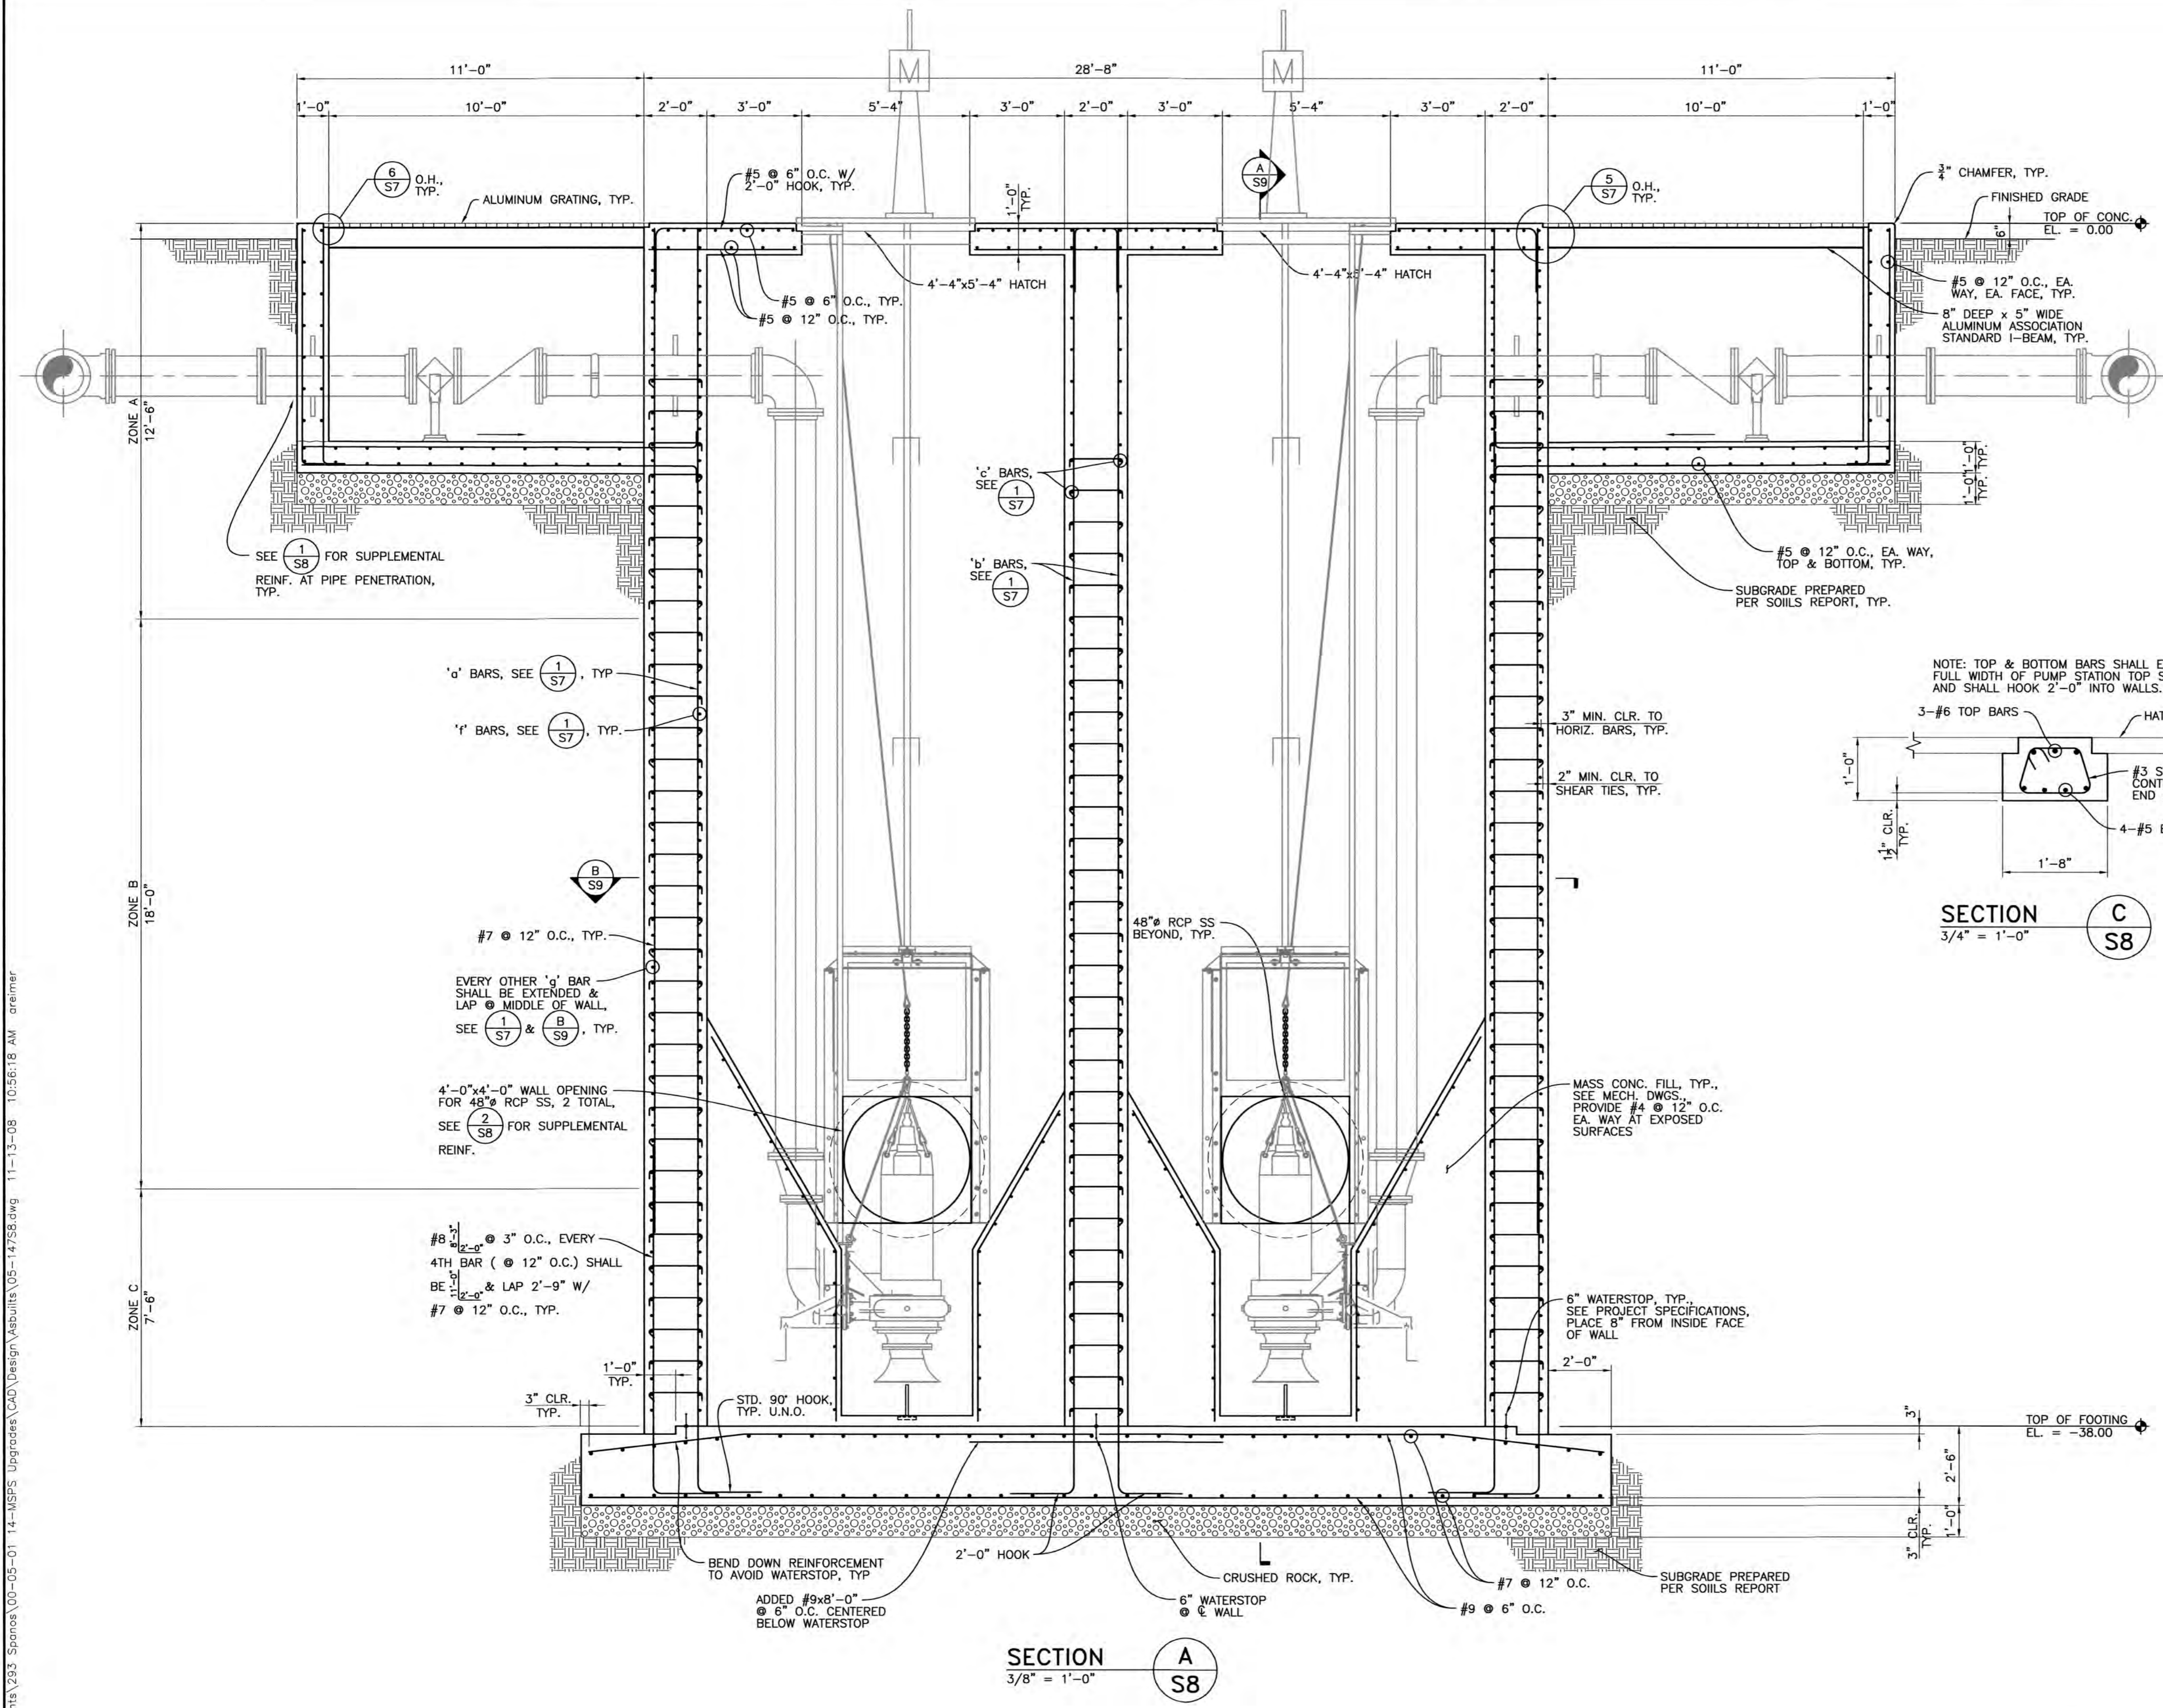

SECTION A
3/8" = 1'-0"

RECORD DRAWINGS
14-Mile Slough Pump Station Upgrades
PUMP STATION
SECTIONS & DETAILS

DEPARTMENT OF MUNICIPAL UTILITIES CITY OF STOCKTON, CALIFORNIA		SCALE: AS SHOWN	APPROVED BY: DATE: _____	SHEET No. S8
DESIGNED BY: TEE	DRAWN BY: REM	CHECKED BY: JAF	RECORD Dwg.:	38 of 89 SHEETS
ASSISTANT DIRECTOR, DEPT. OF MUNICIPAL UTILITIES			PROJECT No. 293-00-05-01	



N:\Clients\293_Sponas\00-05-01_14-MSPS_Upgrade\CAD\Design\Submittals\05-1758.dwg 11-13-08 10:56:18 AM areimer

Underground Service Alert
TWO DAYS BEFORE YOU DIG
Call TOLL FREE: 1-800-642-2444

REFER TO SET FOR SIGNATURE

REV. No.	DISCRPTION	DATE	BY	Apr'd By

WEST YOST ASSOCIATES
Consulting Engineers
1260 Lake Boulevard Suite 240 Davis, California 95616 (530) 756-5905 FAX (530) 756-5991

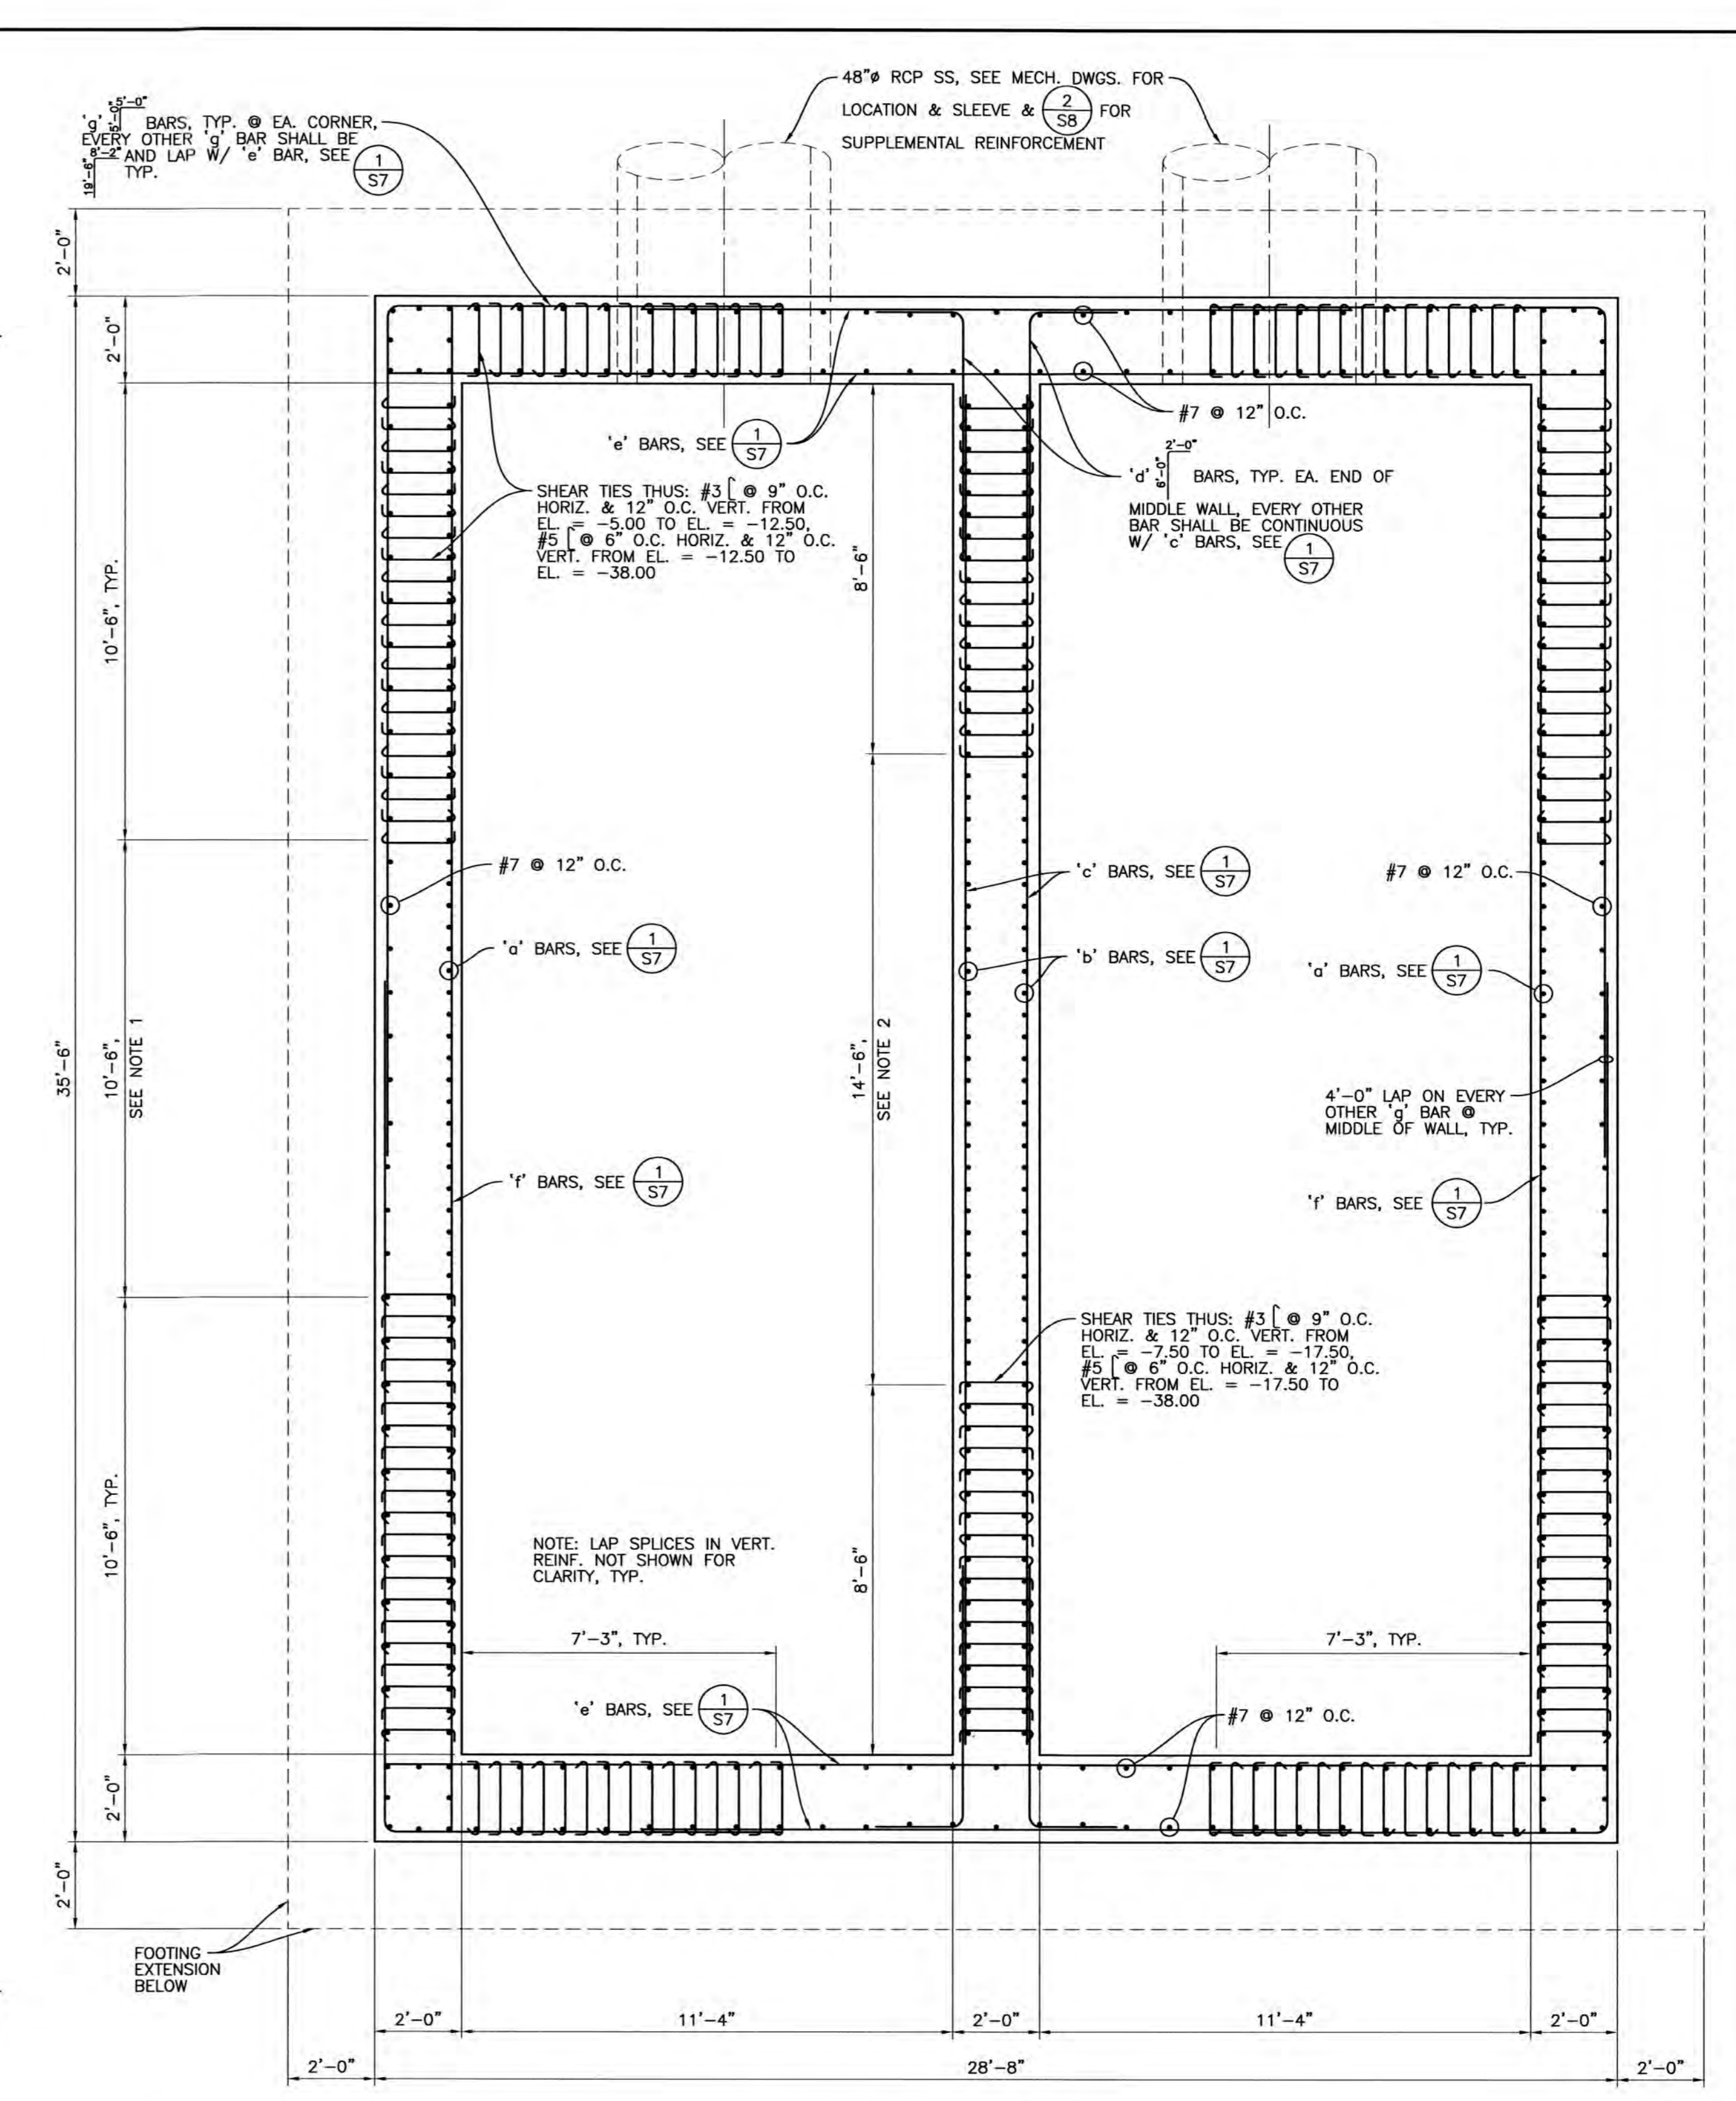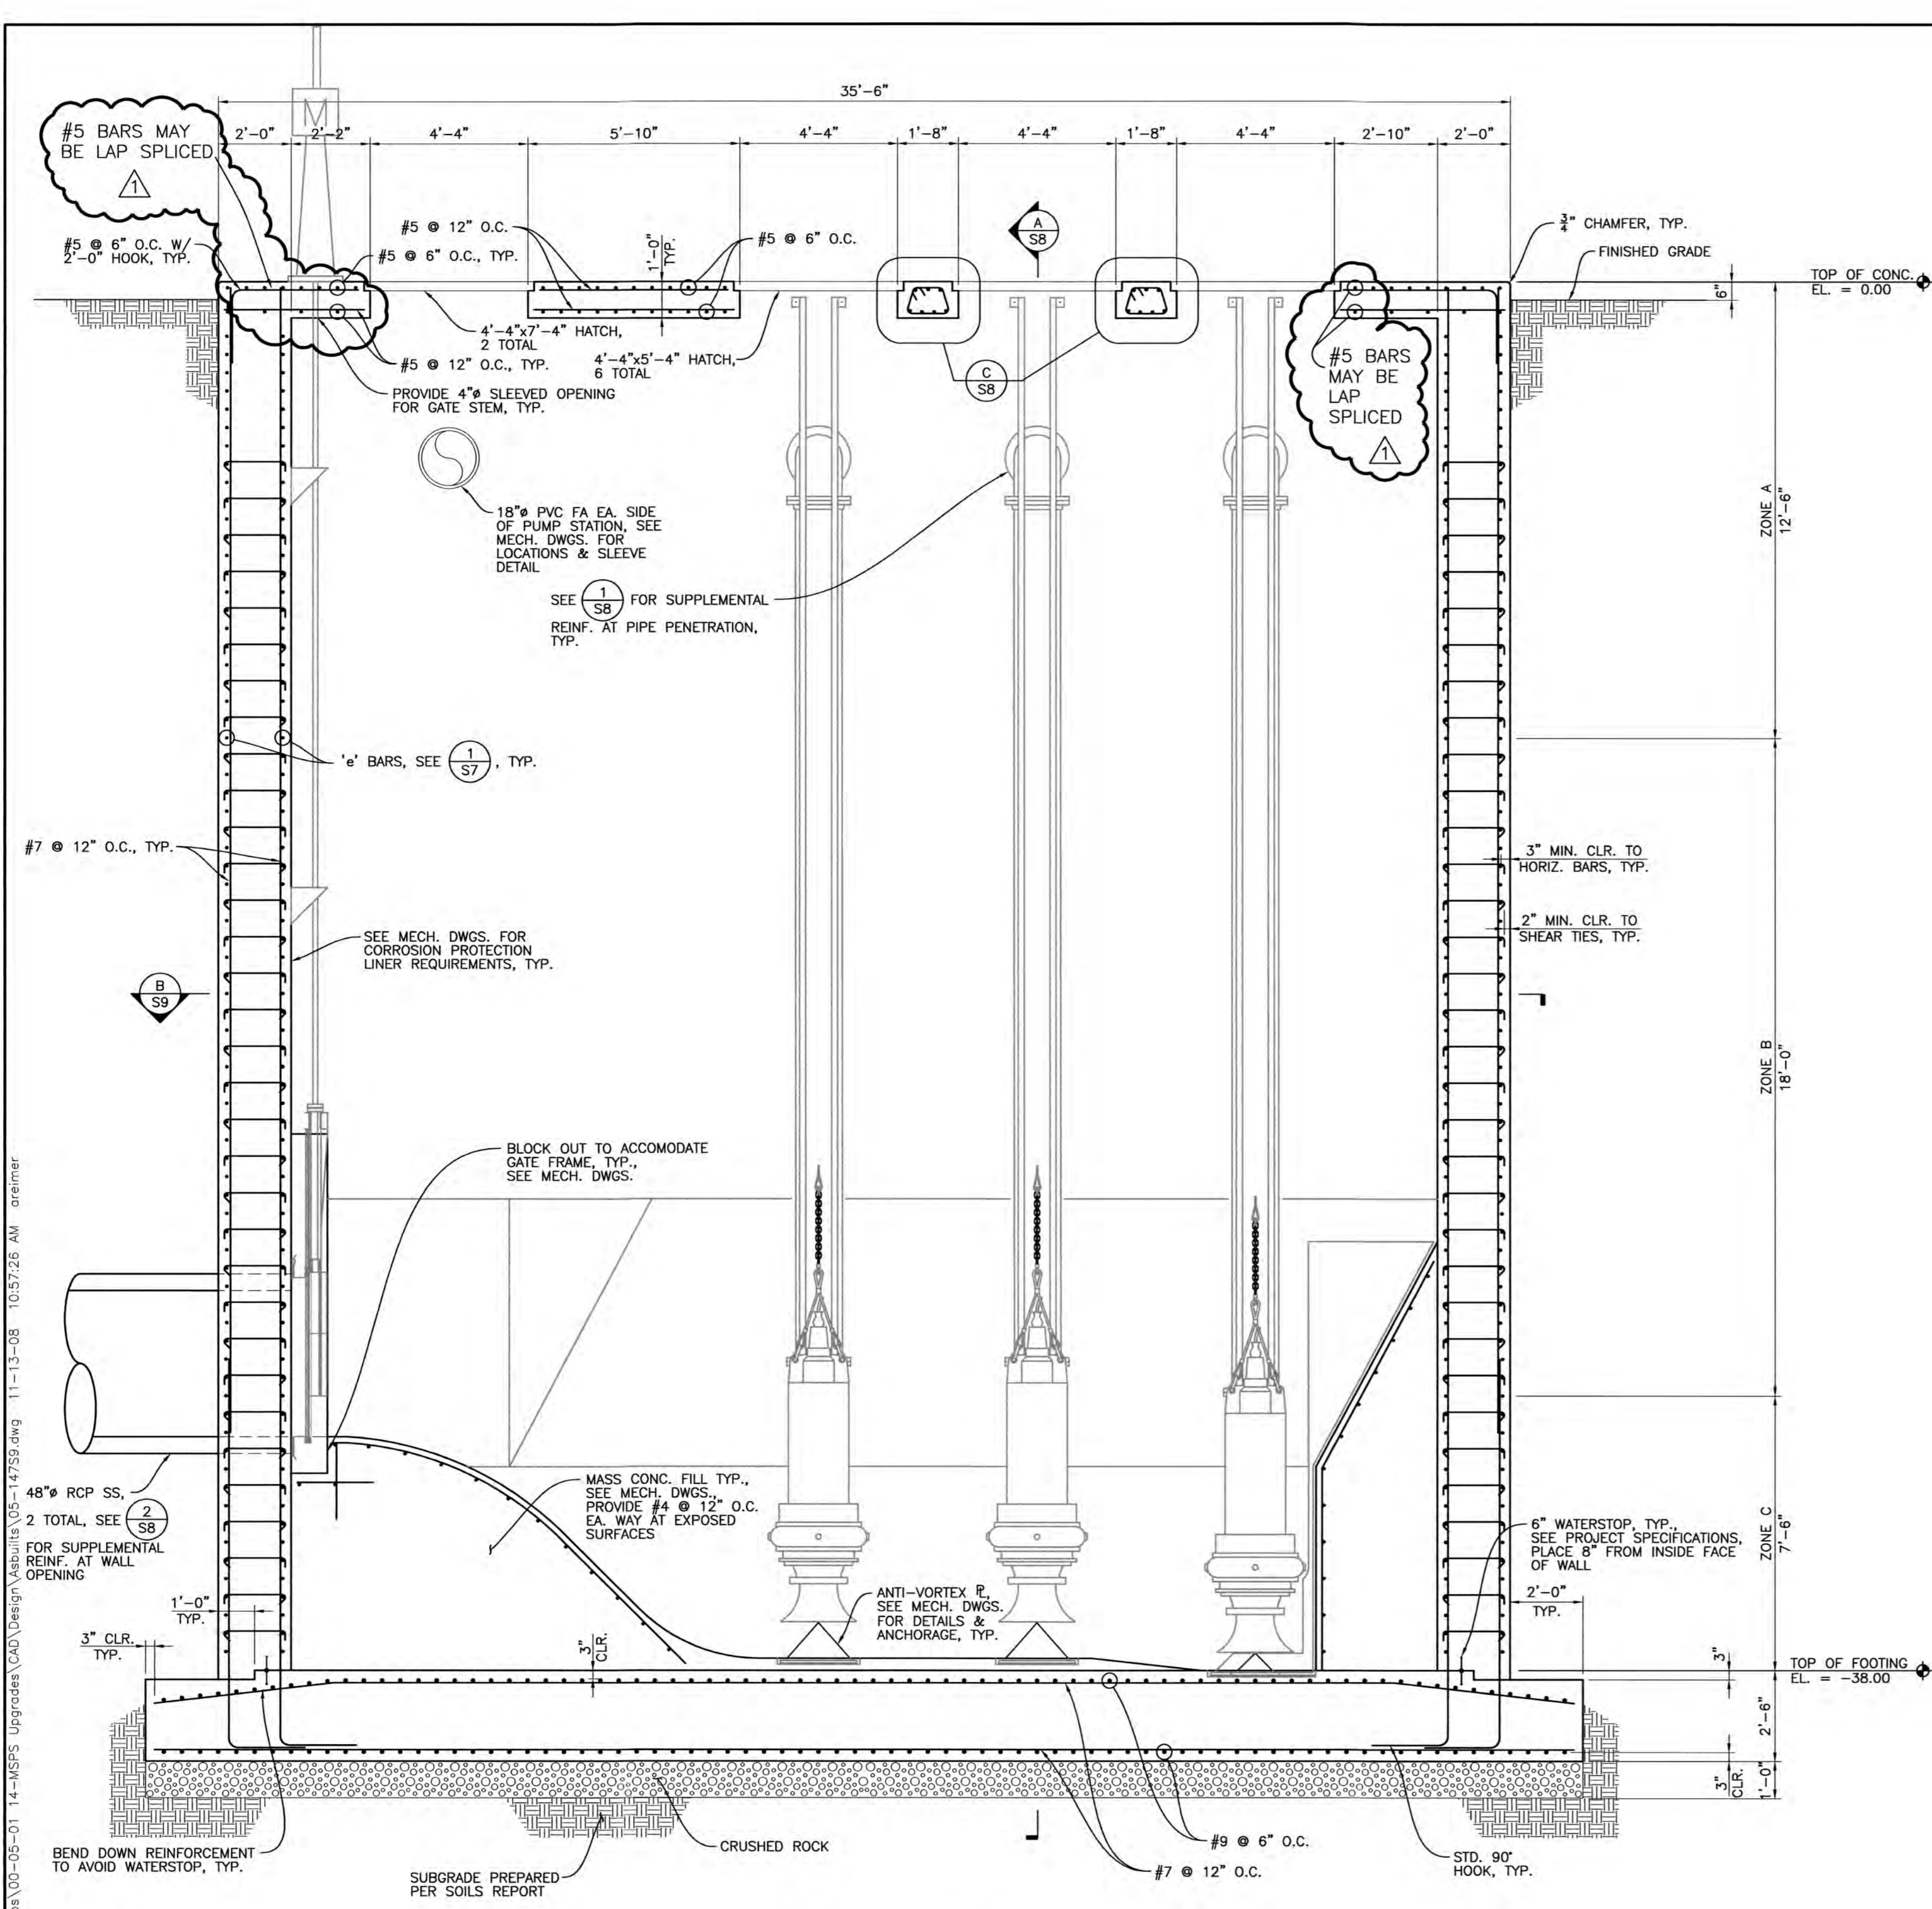

NOTES:
1. AT MIDDLE OF LONG EXTERIOR WALLS, PROVIDE #5 [SHEAR TIES @ 6" O.C. HORIZ. & 12" O.C. VERT. FROM EL. = -27.50 TO EL. = -38.00.
2. AT MIDDLE OF INTERIOR WALL, PROVIDE #5 [SHEAR TIES @ 6" O.C. HORIZ. & 12" O.C. VERT. FROM EL. = -29.50 TO EL. = -38.00.

RECORD DRAWINGS
14-Mile Slough Pump Station Upgrades
PUMP STATIONS SECTIONS

DEPARTMENT OF MUNICIPAL UTILITIES CITY OF STOCKTON, CALIFORNIA		
SCALE: AS SHOWN	APPROVED BY: DATE: _____	SHEET No. S9
DESIGNED BY: TEE	ASSISTANT DIRECTOR, DEPT. OF MUNICIPAL UTILITIES	39 of 89 SHEETS
DRAWN BY: REM		PROJECT No. 293-00-05-01
CHECKED BY: JAF		
RECORD Dwg.:		

Underground Service Alert

TWO DAYS BEFORE YOU DIG


Call TOLL FREE: 1-800-642-2444

REFER TO SET FOR SIGNATURE

REV. No.	DISCRPTION	DATE	BY	Apr'd By
1	RECORD DRAWINGS	8/8/08	MAH	PDF

WEST YOST ASSOCIATES
Consulting Engineers

1260 Lake Boulevard
Suite 240
Davis, California 95616
(530) 756-5905
FAX (530) 756-5991

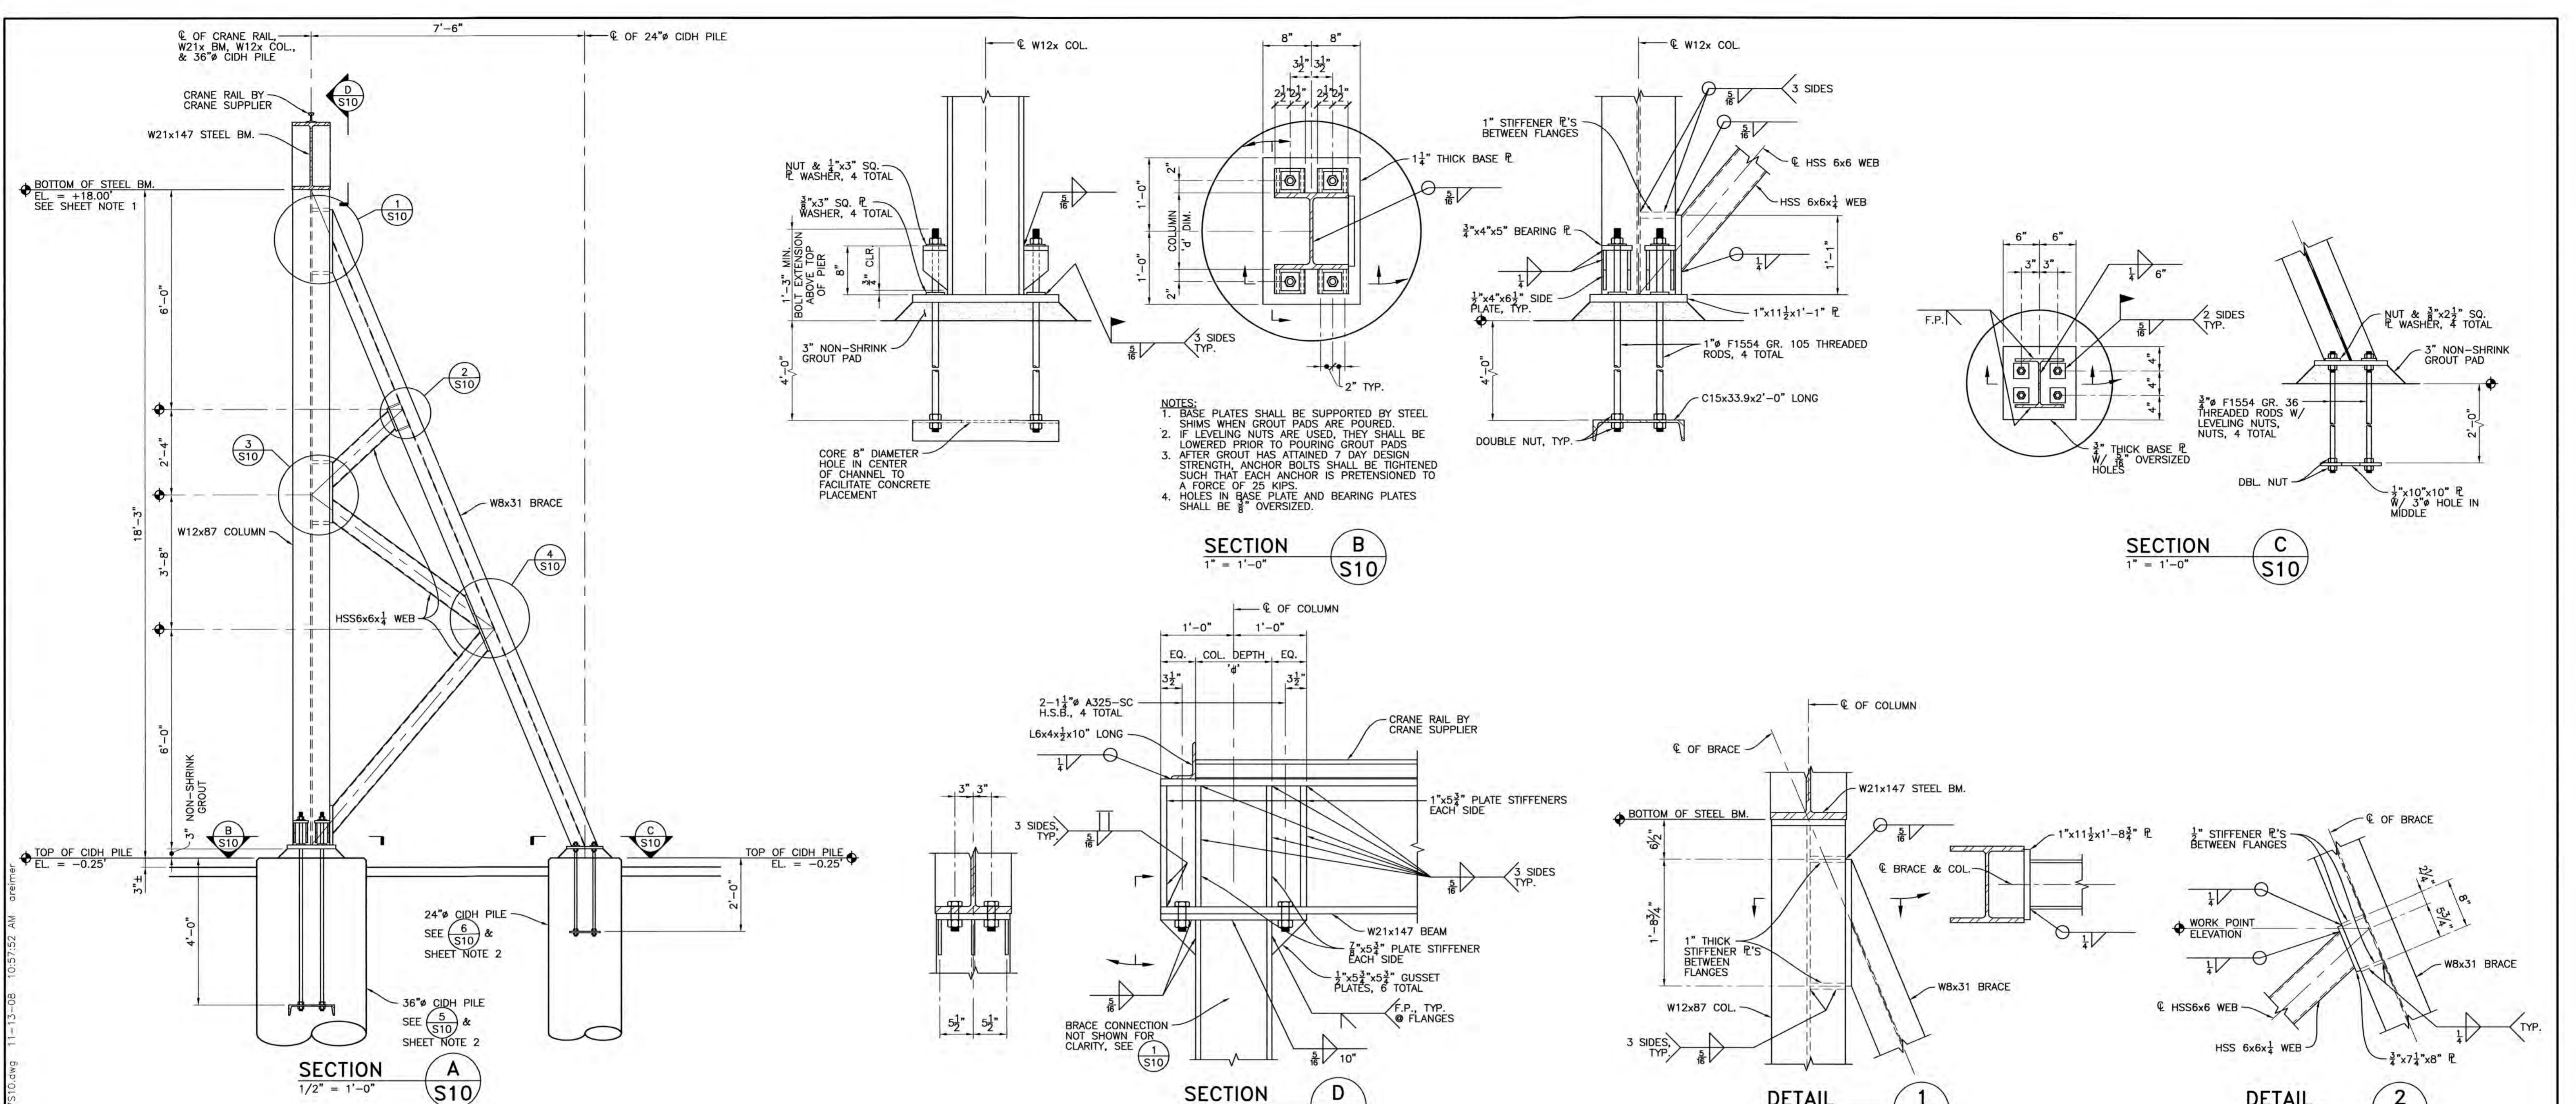

NOTES:

1. BASE PLATES SHALL BE SUPPORTED BY STEEL SHIMS WHEN GROUT PADS ARE POURED.
2. IF LEVELING NUTS ARE USED, THEY SHALL BE LOWERED PRIOR TO POURING GROUT PADS
3. AFTER GROUT HAS ATTAINED 7 DAY DESIGN STRENGTH, ANCHOR BOLTS SHALL BE TIGHTENED SUCH THAT EACH ANCHOR IS PRETENSIONED TO A FORCE OF 25 KIPS.
4. HOLES IN BASE PLATE AND BEARING PLATES SHALL BE $\frac{1}{8}$ " OVERSIZED.

SHEET NOTES:

1. CRANE SUPPLIER SHALL PROVIDE A BOTTOM OF HOOK ELEV. OF +18.00' MIN. IF ELEV. OF W21x147 BM. SHOWN DOES NOT ALLOW THIS, CRANE SUPPLIER SHALL CONTACT ENGINEER.
2. CIDH PILES SHALL BE DRILLED & CAST AFTER SOIL AROUND PUMP STATION HAS BEEN BACKFILLED & COMPACTED. TOP 2'-0" MAX. OF CIDH PILES MAY BE FORMED W/ SONOTUBES.



REFER TO SET FOR SIGNATURE

REV. No.	DISCUSSION	DATE	BY	Appr'd By

WEST YOST ASSOCIATES
Consulting Engineers

1260 Lake Boulevard
Suite 240
Davis, California 95616
(530) 756-5905
FAX (530) 756-5991


RECORD DRAWINGS

14-Mile Slough Pump Station Upgrades




PUMP STATION BRIDGE CRANE SECTIONS & DETAILS

DEPARTMENT OF MUNICIPAL UTILITIES
CITY OF STOCKTON, CALIFORNIA


SCALE: AS SHOWN	APPROVED BY: DATE: _____	SHEET No. S10
DESIGNED BY: TEE	ASSISTANT DIRECTOR, DEPT. OF MUNICIPAL UTILITIES	40 of 89 SHEETS
DRAWN BY: REM		PROJECT No. 293-00-05-01
CHECKED BY: JAF		
RECORD Dwg.:		

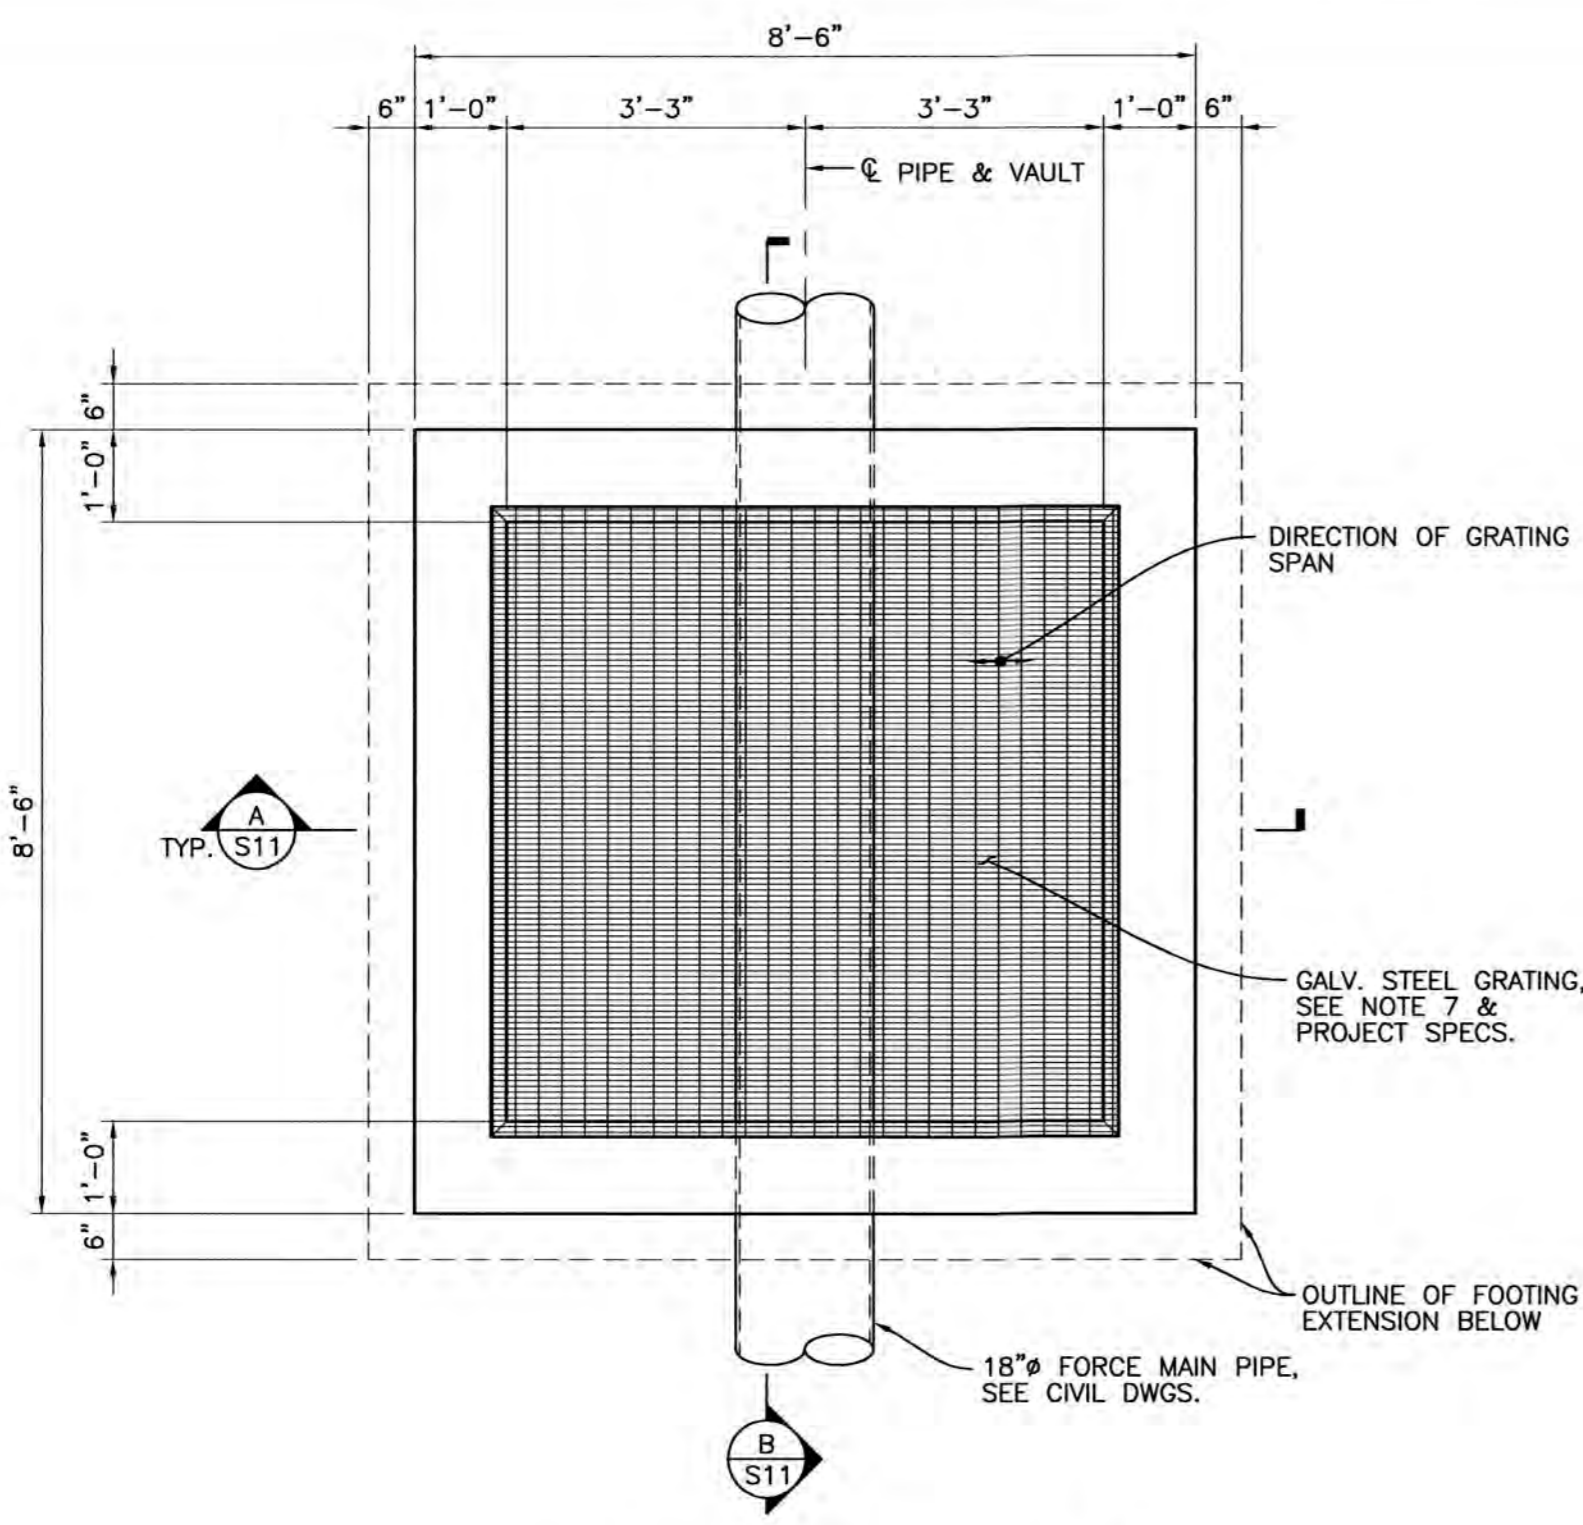



METER VAULT PLAN
1/2" = 1'-0"

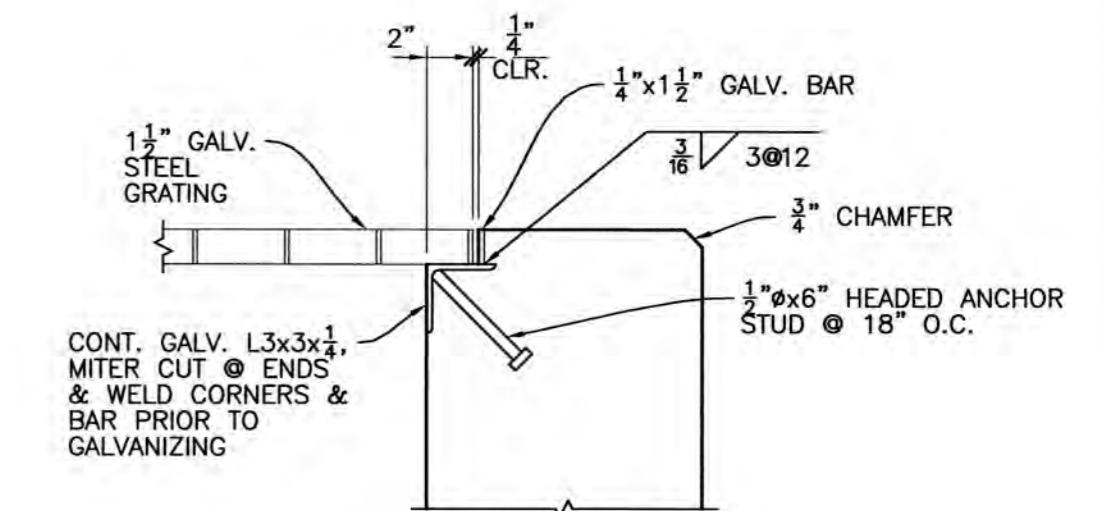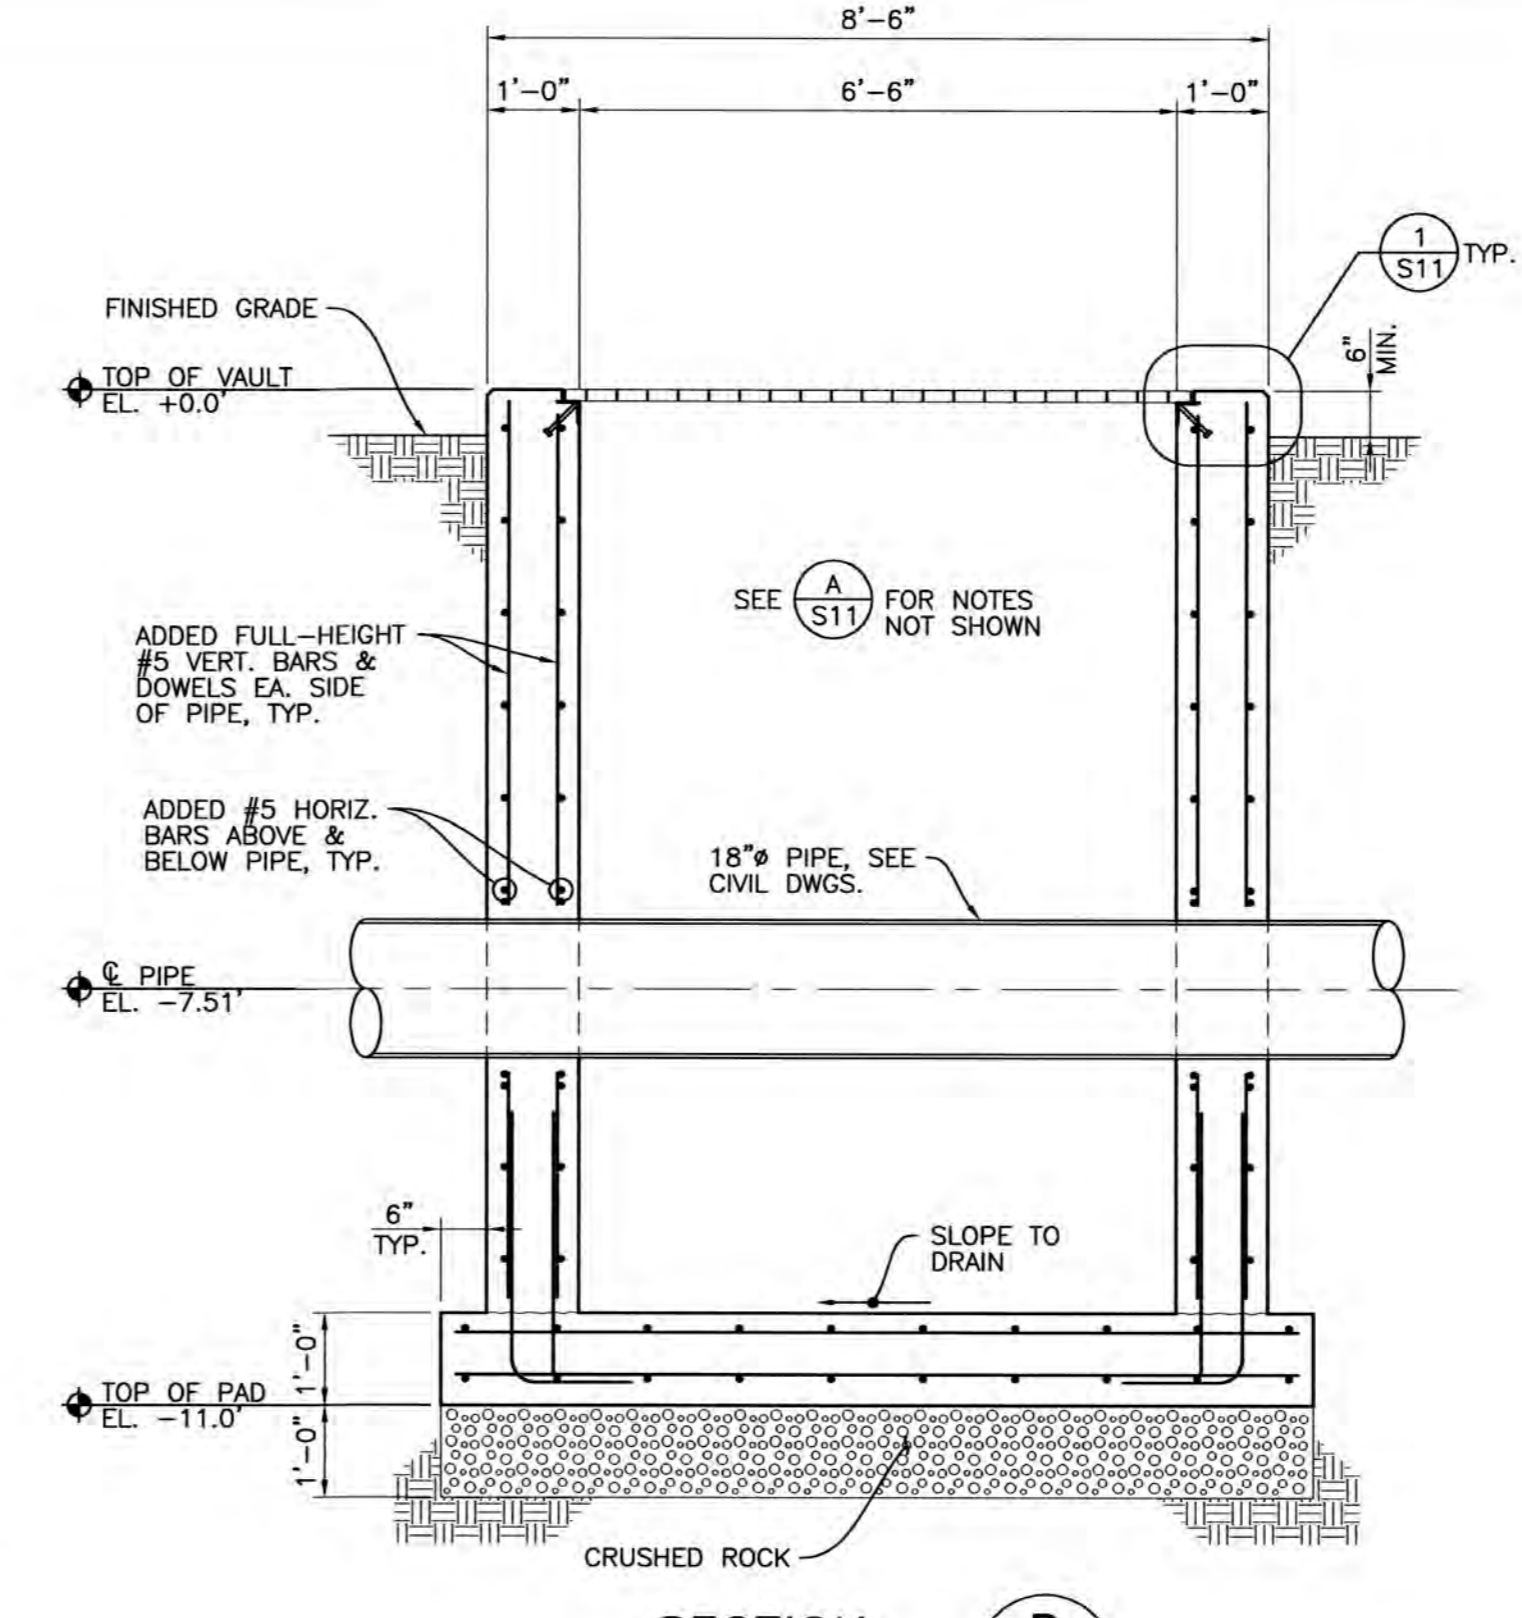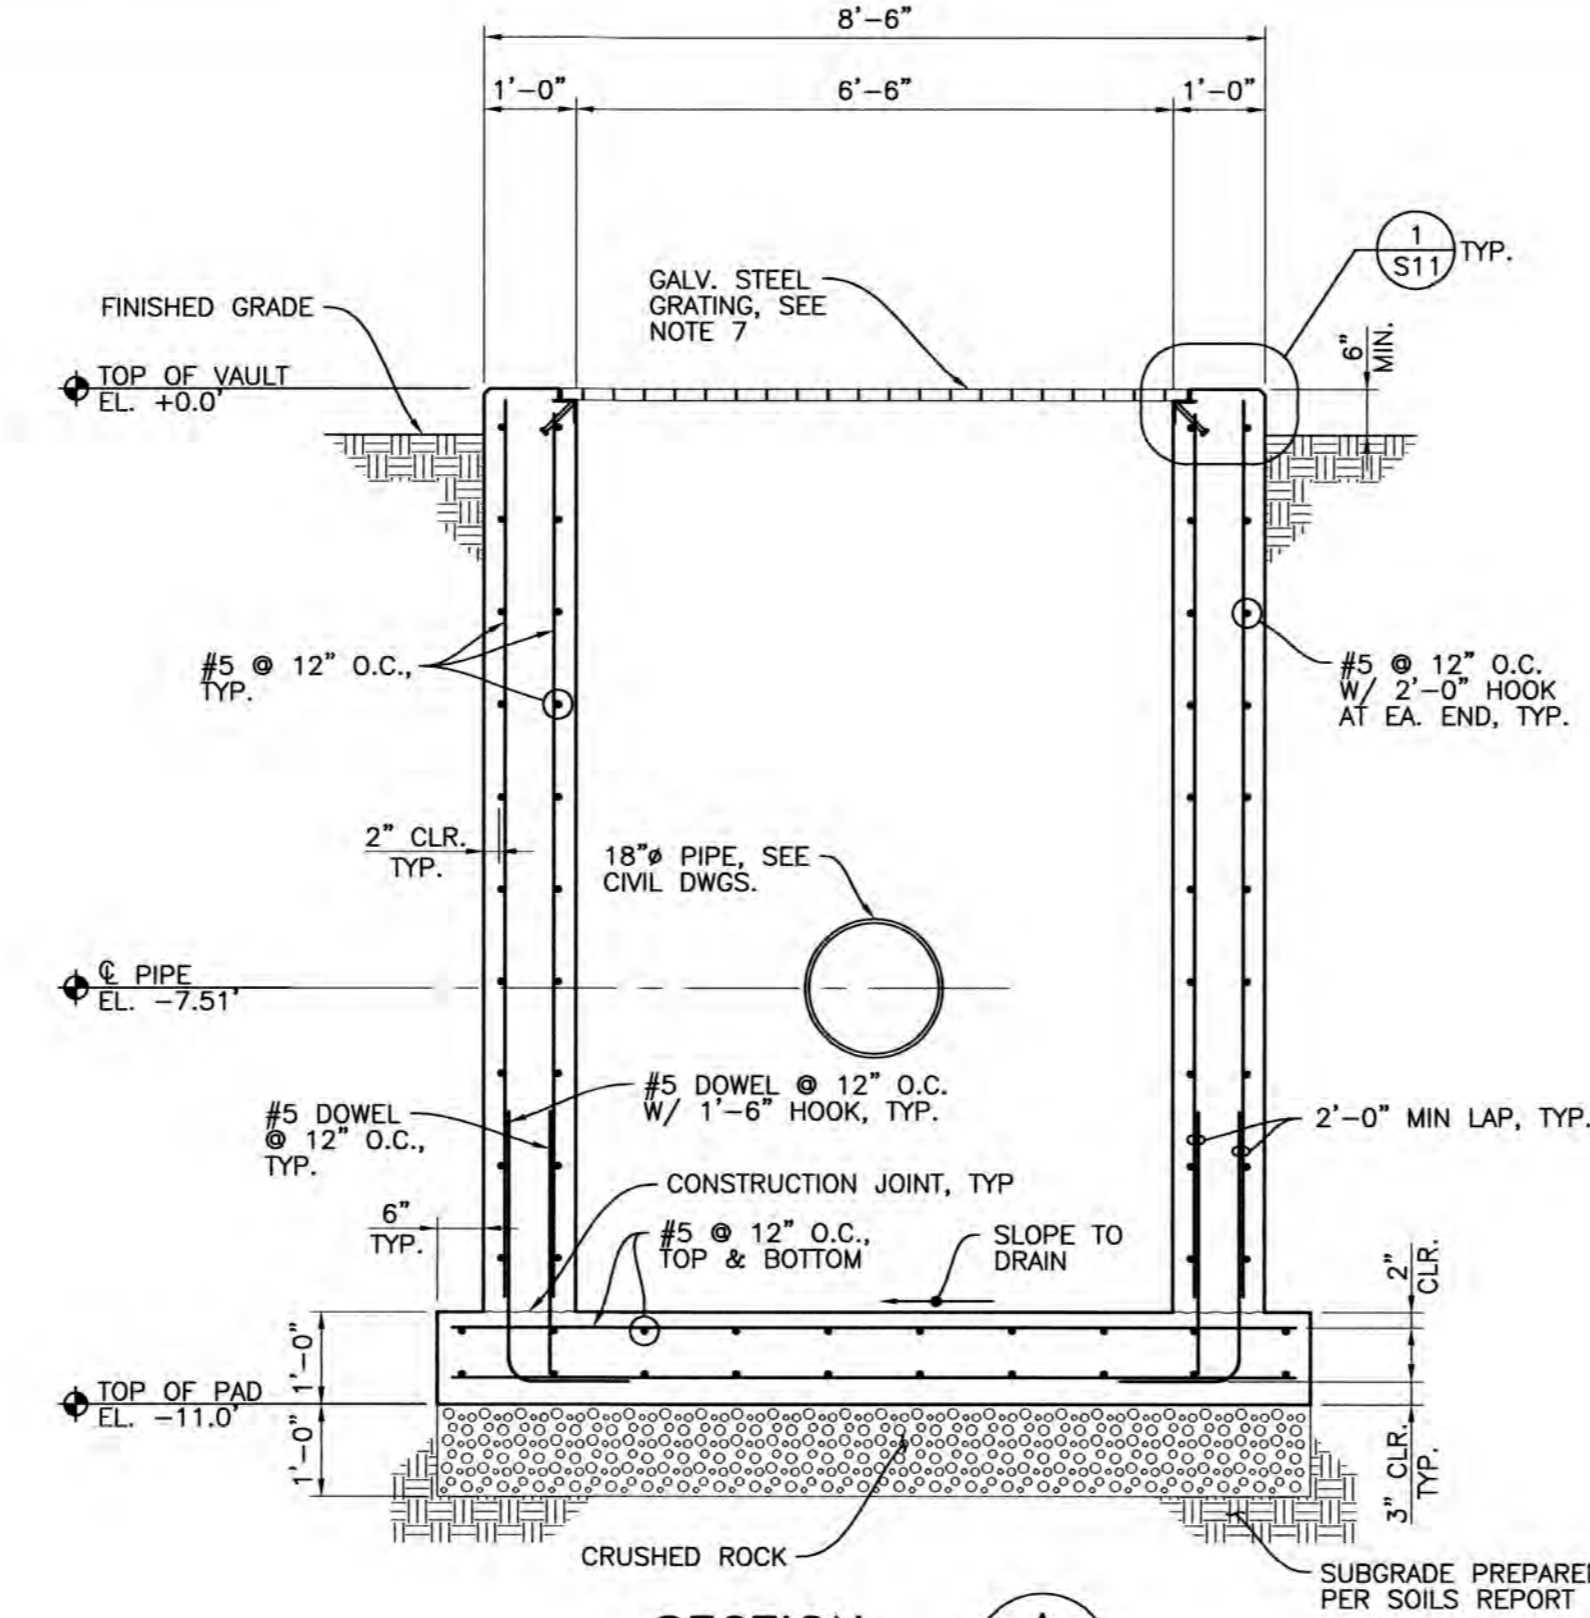

DETAIL 1
1 1/2" = 1'-0"

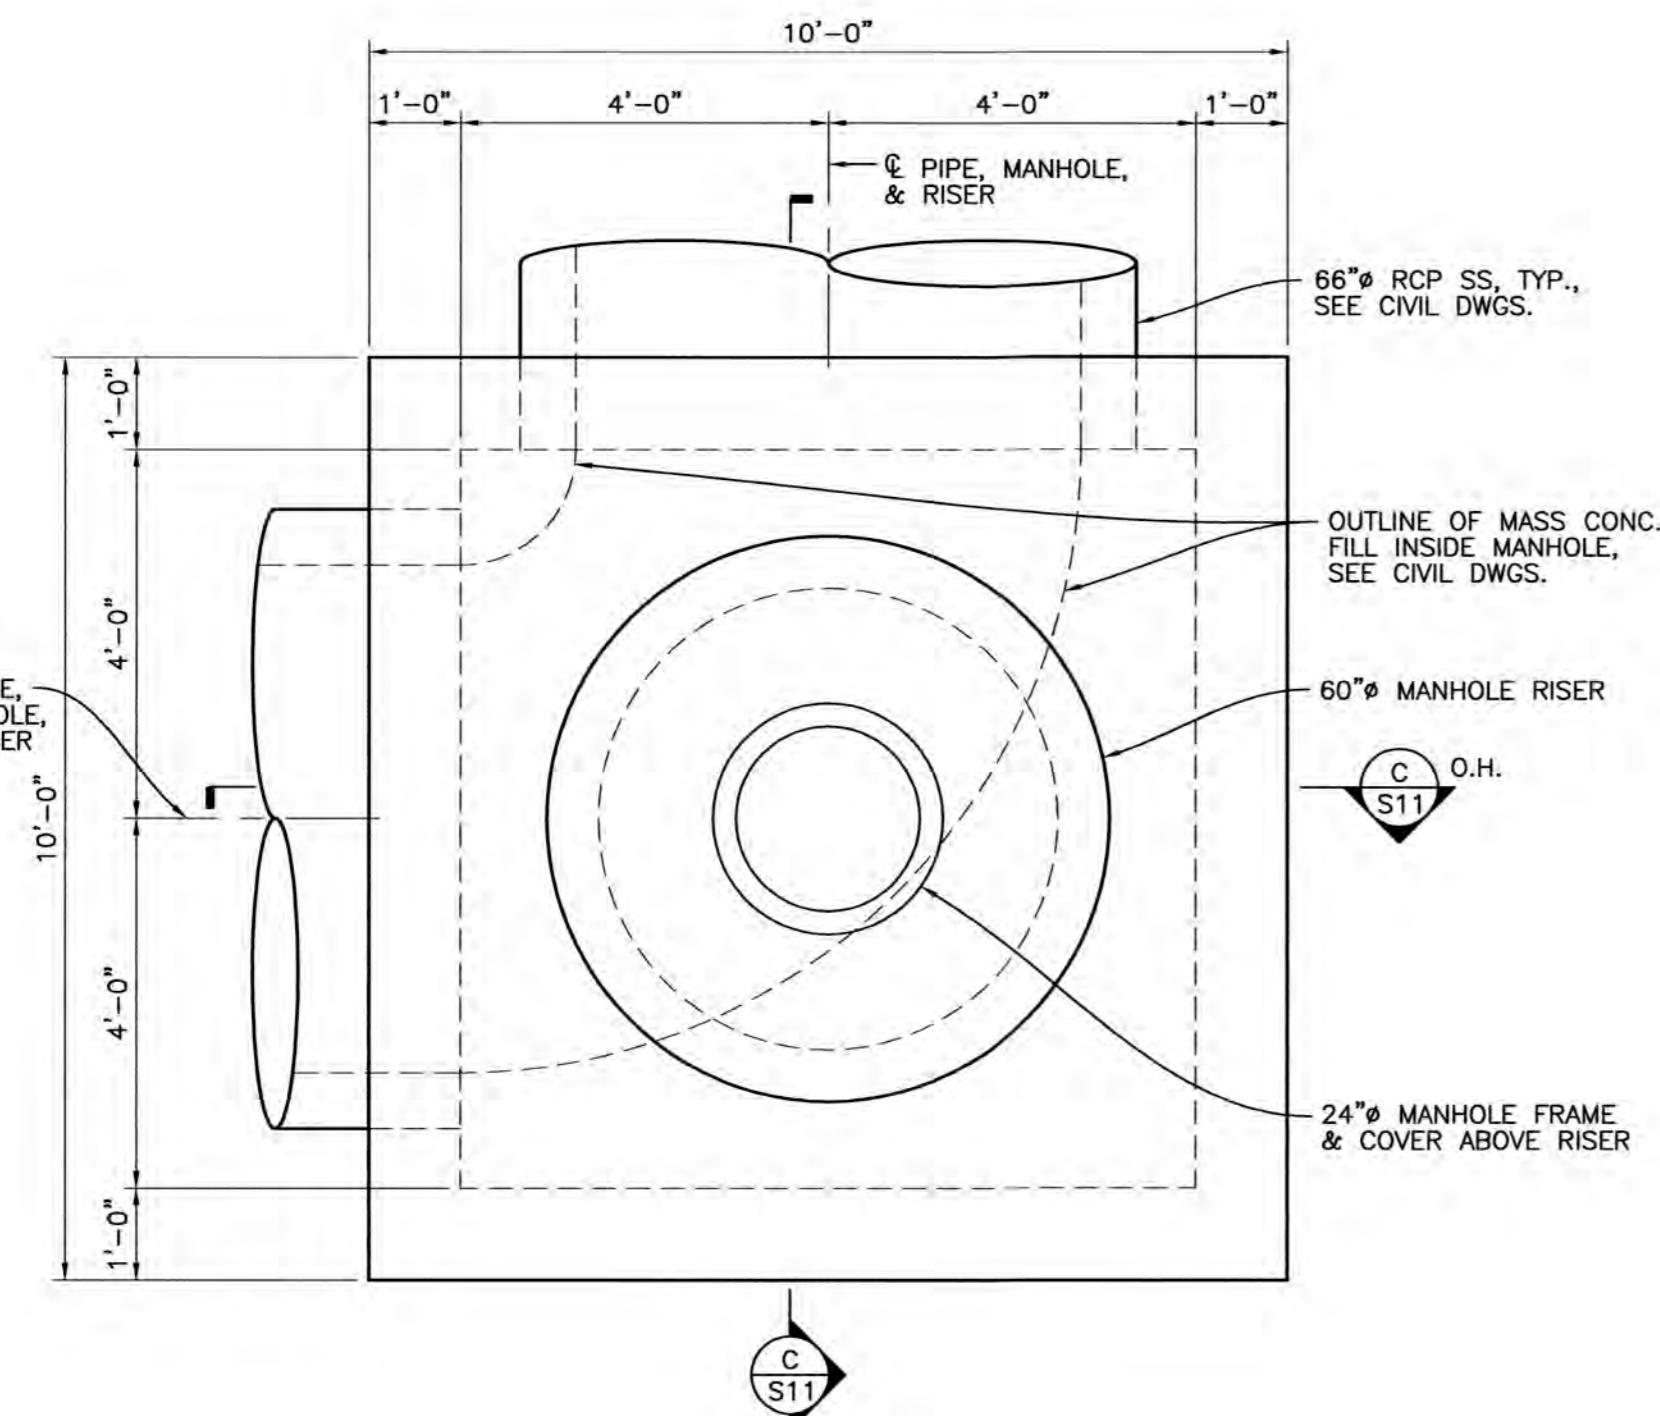

MANHOLE NO. 1 PLAN
1/2" = 1'-0"

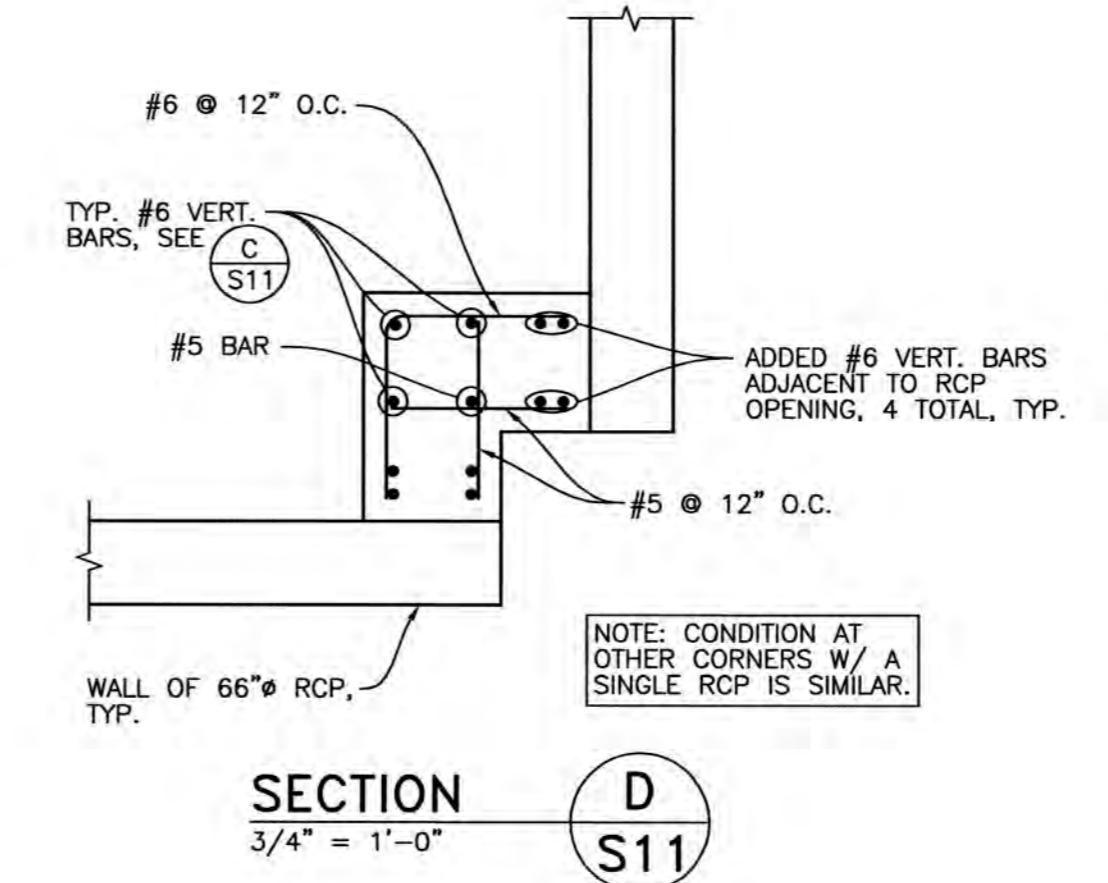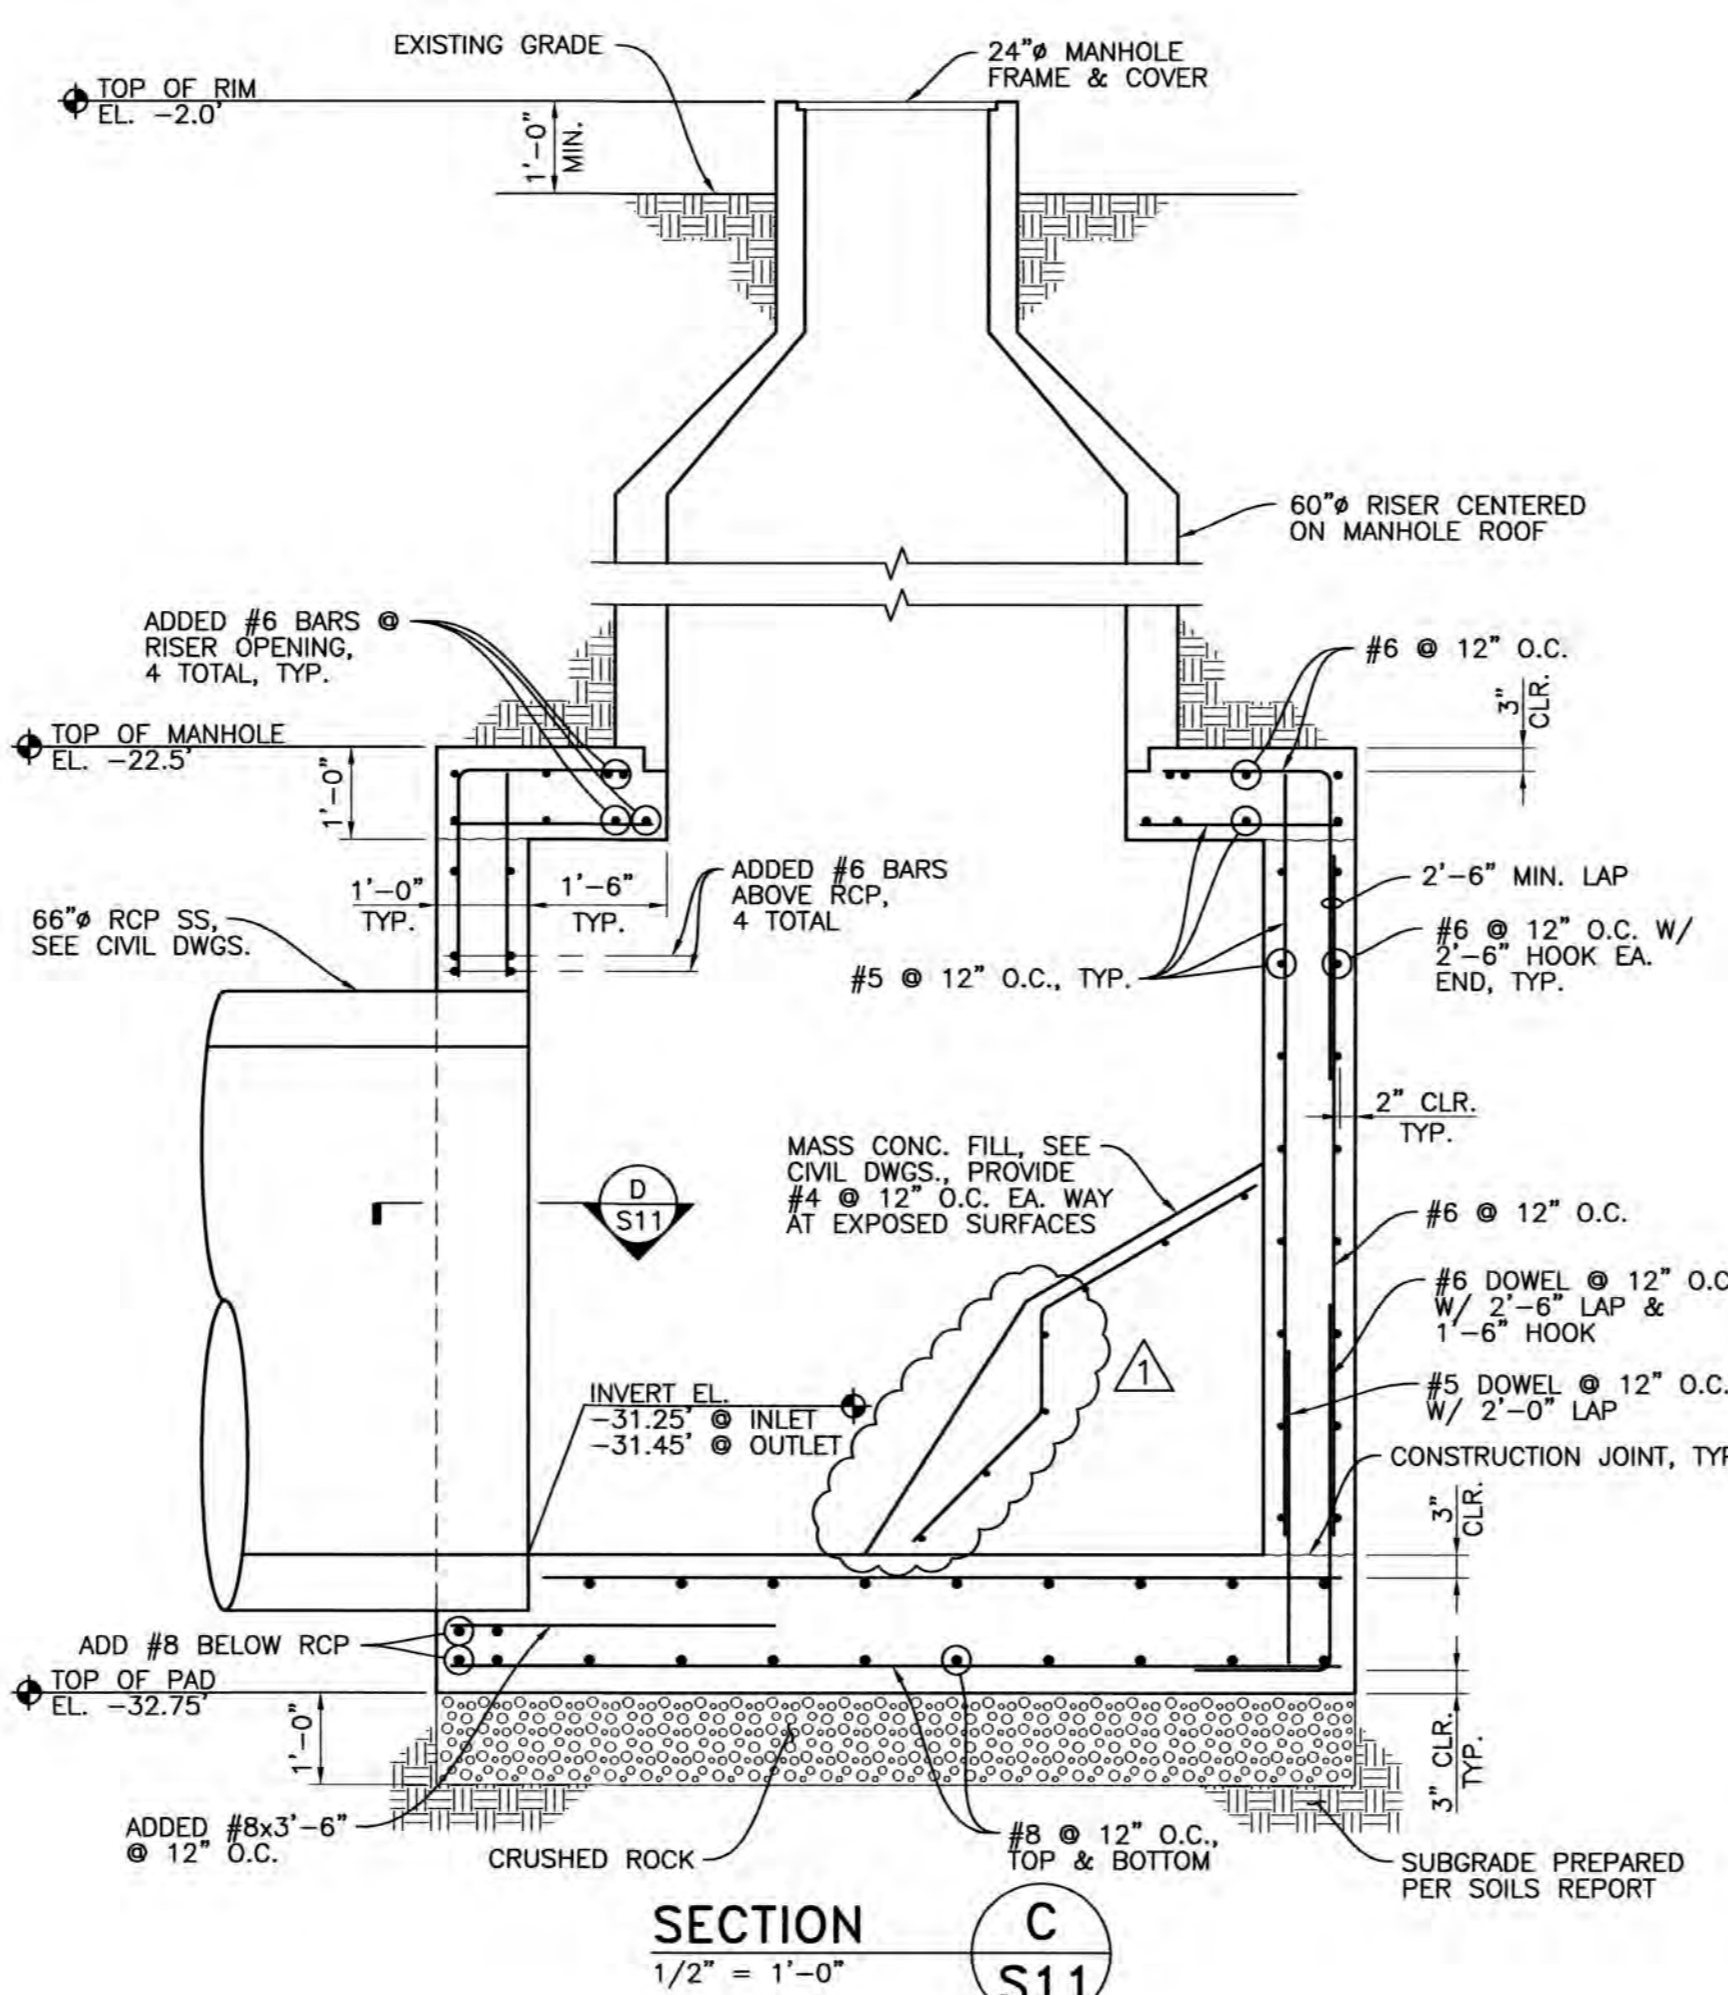

- METER VAULT & MANHOLE NO. 1 NOTES:
- SEE GENERAL NOTES ON SHEET S11.
 - 8.00 DENOTES TOP OF CONC. SLAB
 - DENOTES DIRECTION OF CONC. SLAB SLOPE. PROVIDE A MIN. SLOPE OF 1%.
 - SEE CIVIL DWGS. FOR PROFILE & ELEVATIONS OF MASS CONC. FILL. SEE PROJECT SPECIFICATIONS FOR MATERIAL REQUIREMENTS FOR MASS CONC. FILL.
 - ALL INTERIOR EXPOSED CONC. SURFACES OF MANHOLE NO. 1 SHALL BE PROTECTED WITH CORROSION PROTECTION LINER. ALL EXTERIOR SURFACES OF METER VAULT & MANHOLE NO. 1 CONC. WALLS SHALL BE MOISTURE-PROOFED.
 - THE MAXIMUM EXPECTED ELEVATION OF THE WATER TABLE IS 2'-0" BELOW GRADE. THE CONTRACTOR SHALL PROVIDE FOR THE COMPLETE DEWATERING OF THE EXCAVATION AS REQUIRED BY THE PROJECT SPECIFICATIONS & PROJECT SOILS REPORT.
 - GALV. STEEL GRATING SHALL BE 1 1/2" DEEP W/ 3/8" WIDE MAIN BARS @ 1 1/2" O.C. AND 1/2" WIDE CROSS BARS @ 4" O.C. MAX. SPAN SHALL BE 6'6". SEE PROJECT SPECIFICATIONS FOR FURTHER REQUIREMENTS.

RECORD DRAWINGS
14-Mile Slough Pump Station Upgrades
METER VAULT & MANHOLE NO. 1 PLANS,
SECTIONS, DETAILS & NOTES




REFER TO SET FOR SIGNATURE

REV. No.	DISCRPTION	DATE	BY	Apr'd By
1	RECORD DRAWINGS	8/8/08	MAH	PDF




1260 Lake Boulevard
Suite 240
Davis, California 95616
(530) 756-5905
FAX (530) 756-5991

DEPARTMENT OF MUNICIPAL UTILITIES CITY OF STOCKTON, CALIFORNIA		SHEET No.
SCALE: AS SHOWN	APPROVED BY: DATE:	S11
DESIGNED BY: TEE		41 of 89 SHEETS
DRAWN BY: REM		PROJECT No. 293-00-05-01
CHECKED BY: JAF	ASSISTANT DIRECTOR, DEPT. OF MUNICIPAL UTILITIES	
RECORD Dwg.:		

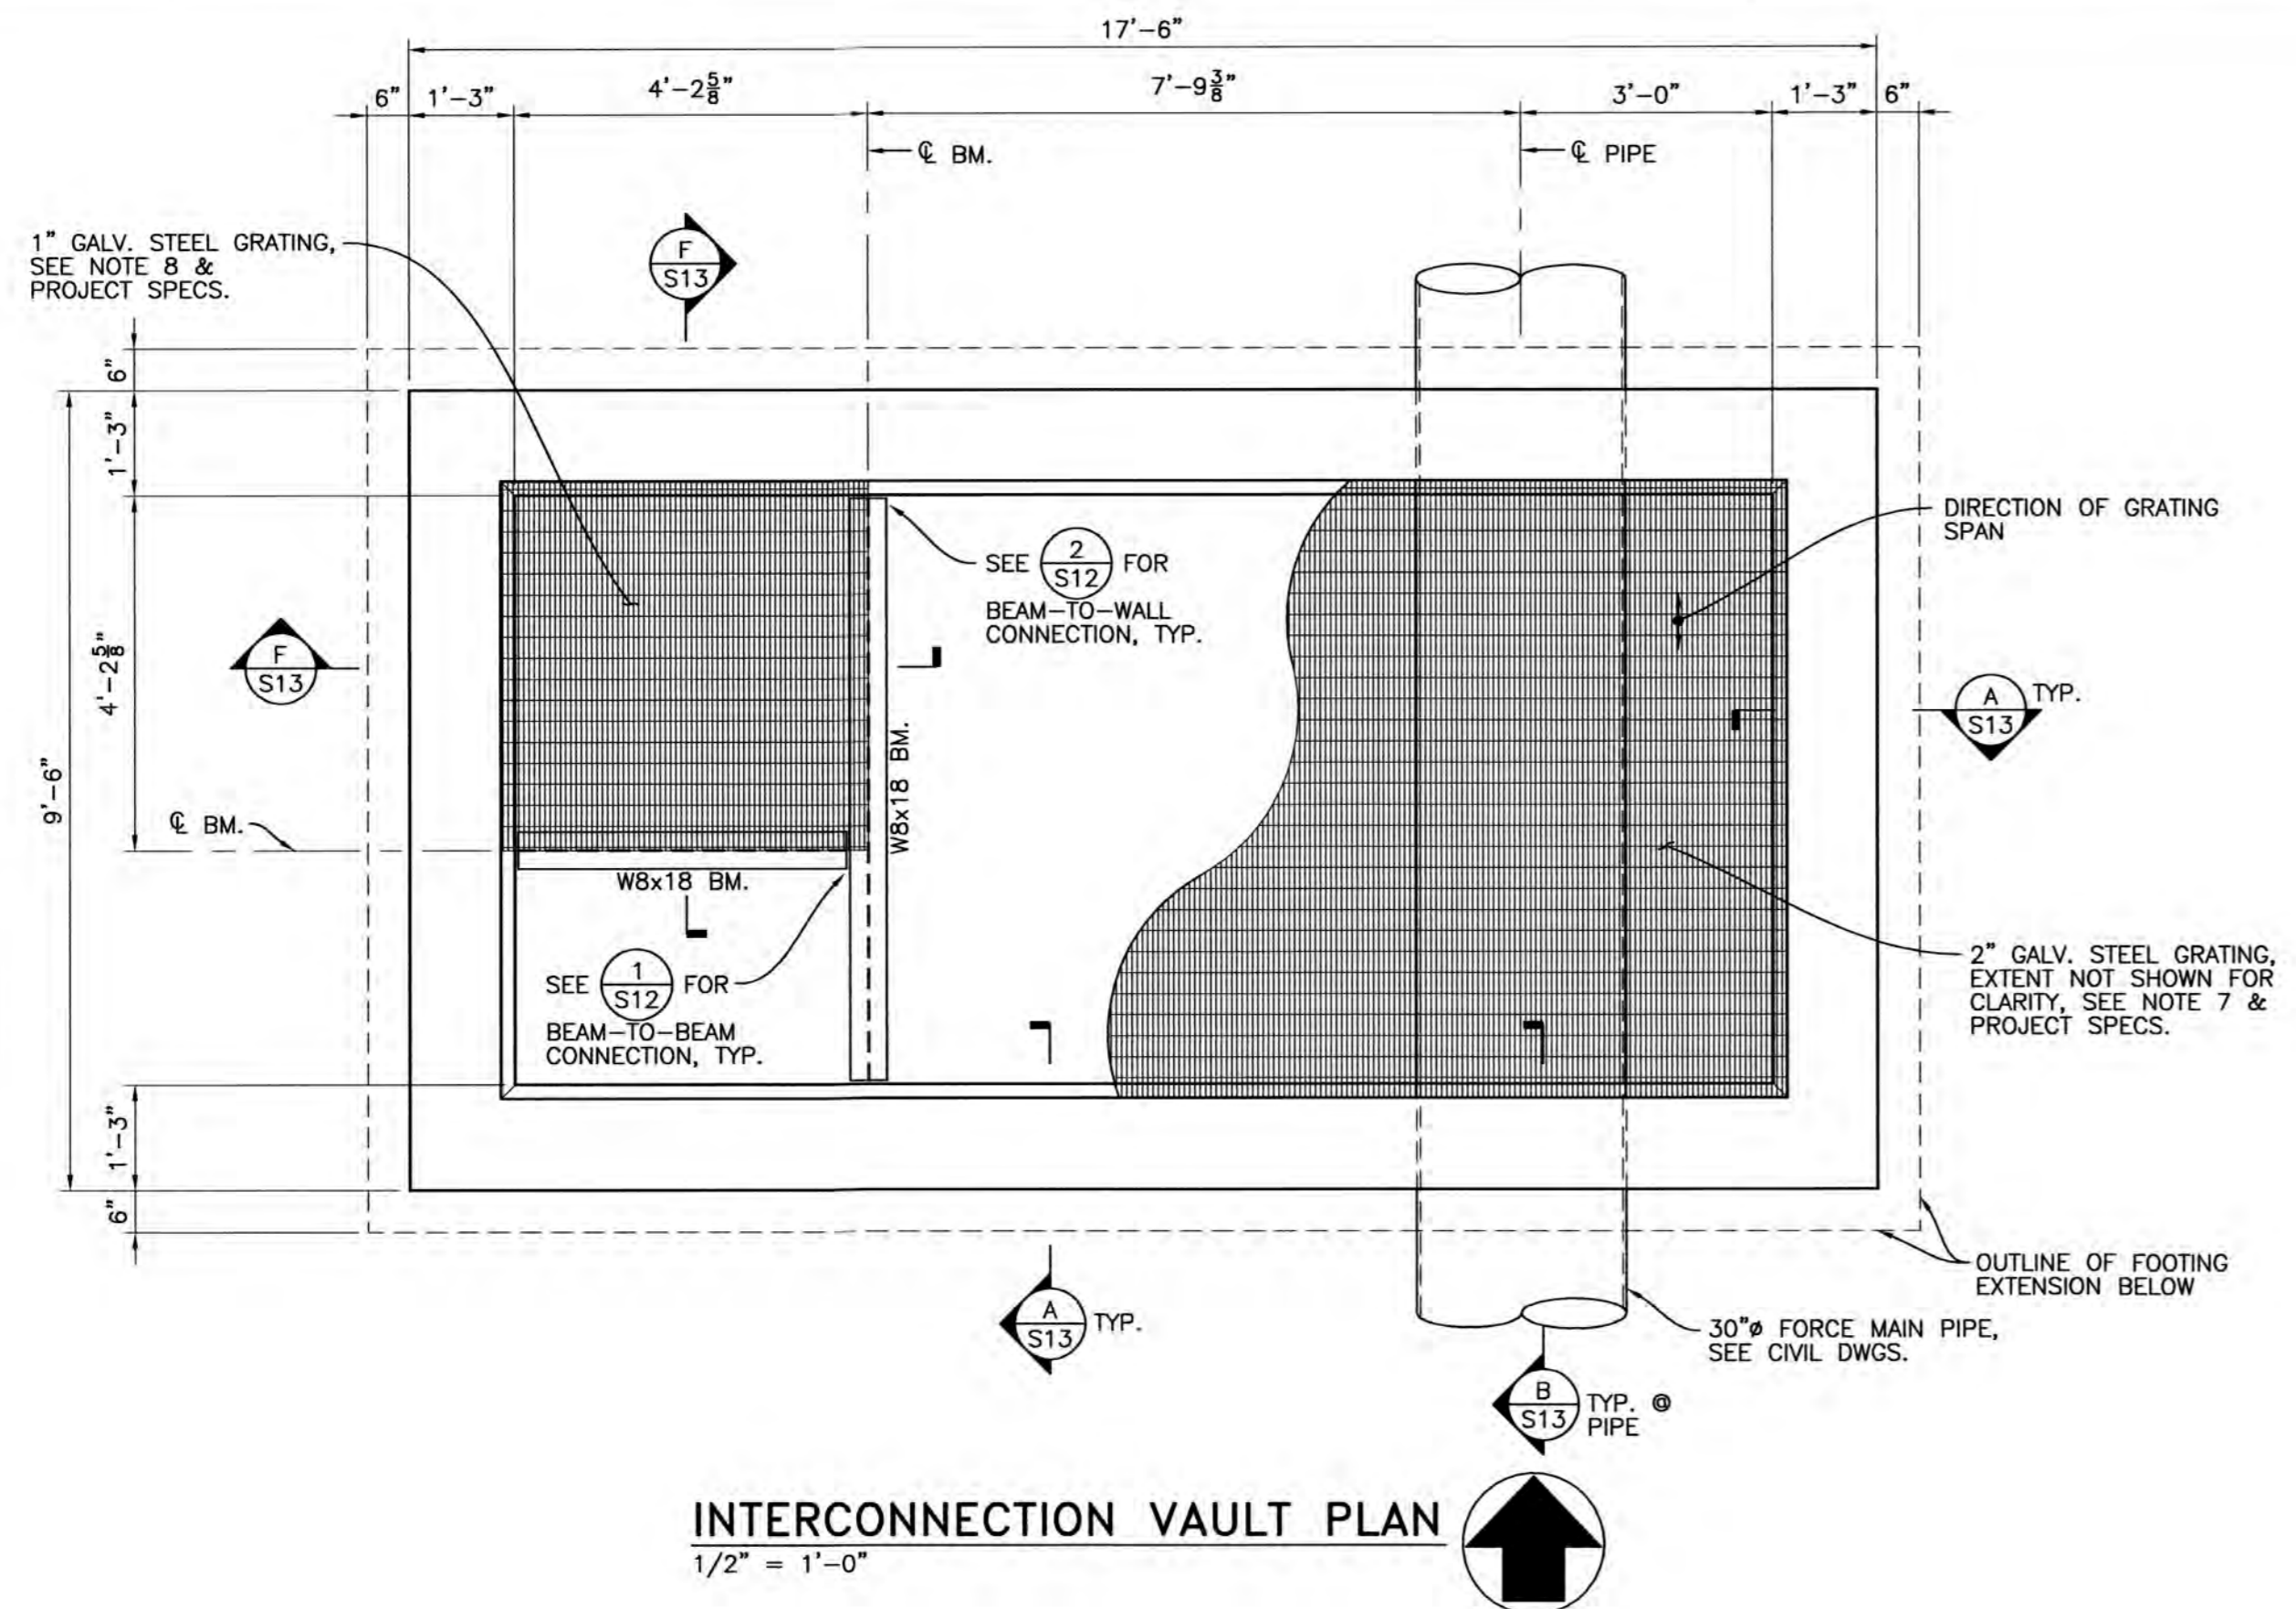


INTERCONNECTION VAULT PLAN
1/2" = 1'-0"

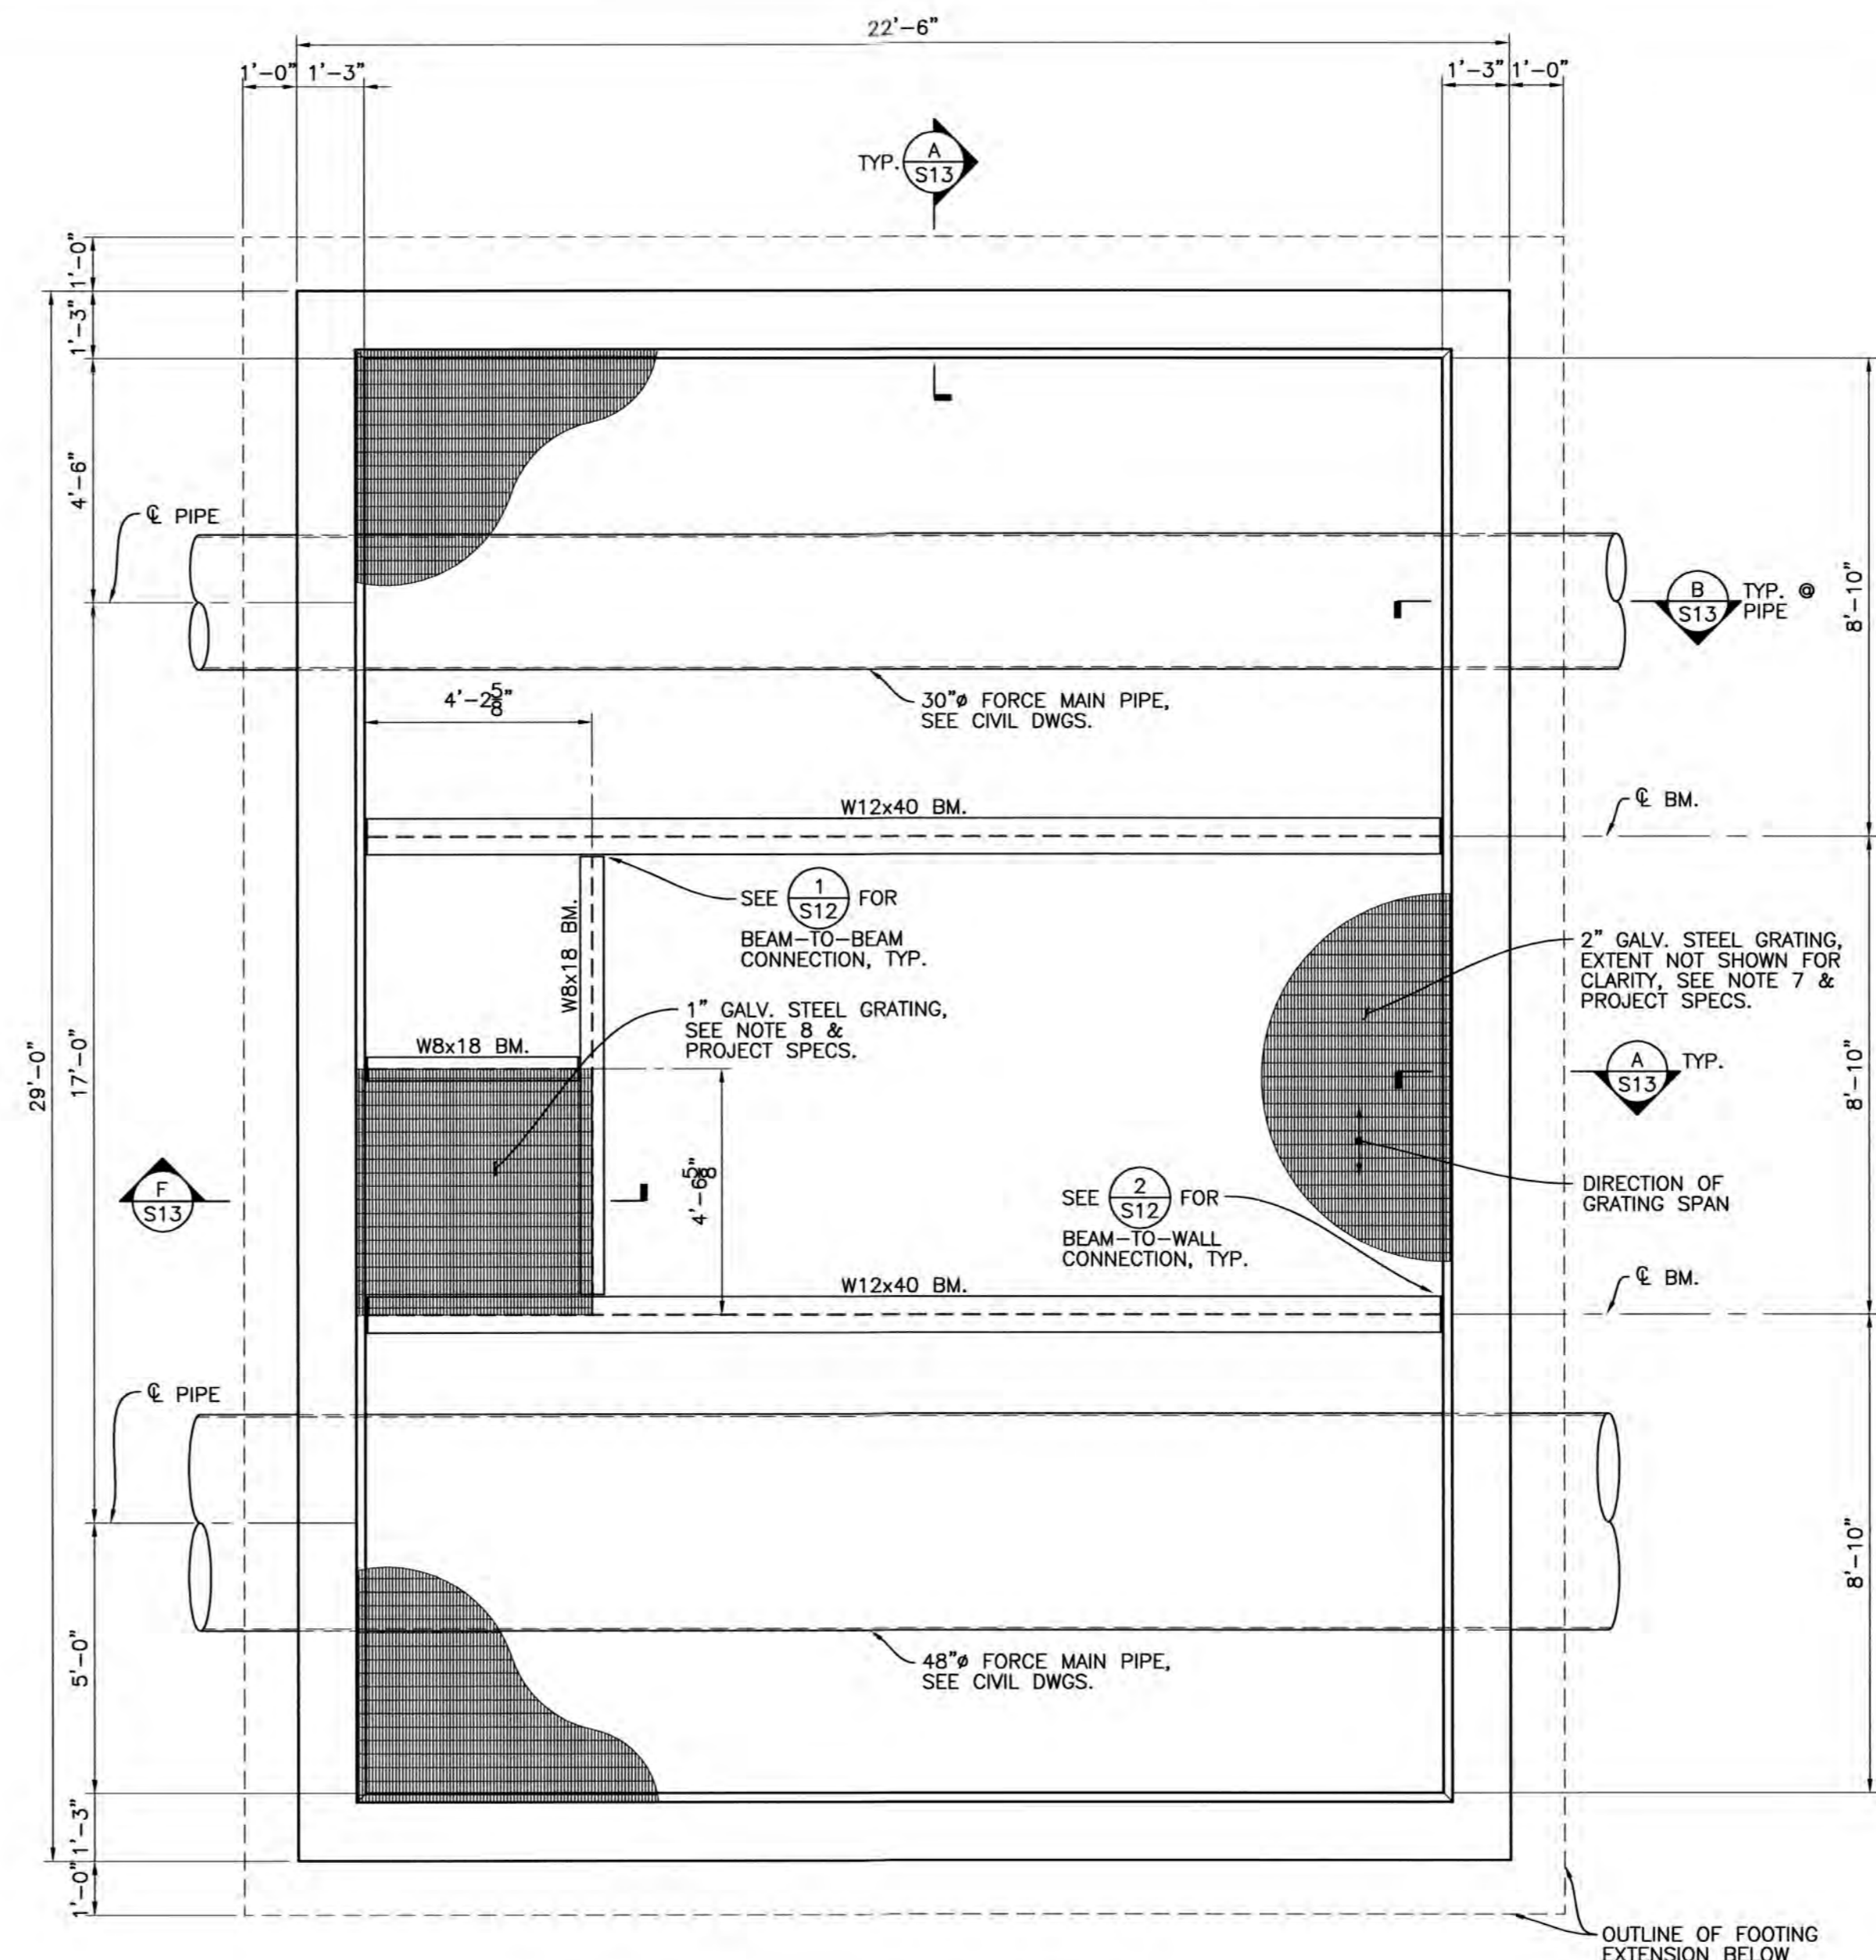


ISOLATION VAULT PLAN
3/8" = 1'-0"

- INTERCONNECTION VAULT, ISOLATION VAULT & JUNCTION STRUCTURE NOTES:**
- SEE GENERAL NOTES ON SHEET S1.
 - 8.00 DENOTES TOP OF CONC. SLAB
 - DENOTES DIRECTION OF CONC. SLAB SLOPE. PROVIDE A MIN. SLOPE OF 0.5%.
 - SEE CIVIL DWGS. FOR PROFILE & ELEVATIONS OF MASS CONC. FILL. SEE PROJECT SPECIFICATIONS FOR MATERIAL REQUIREMENTS FOR MASS CONC. FILL.
 - ALL INTERIOR EXPOSED CONC. SURFACES OF JUNCTION STRUCTURE SHALL BE PROTECTED WITH CORROSION PROTECTION LINER. ALL EXTERIOR SURFACES OF INTERCONNECTION VAULT, ISOLATION VAULT & JUNCTION STRUCTURE CONC. WALLS SHALL BE MOISTURE-PROOFED.
 - THE MAXIMUM EXPECTED ELEVATION OF THE WATER TABLE IS 2'-0" BELOW GRADE. THE CONTRACTOR SHALL PROVIDE FOR THE COMPLETE DEMATERING OF THE EXCAVATION AS REQUIRED BY THE PROJECT SPECIFICATIONS & PROJECT SOILS REPORT.
 - 2" GALV. STEEL GRATING SHALL BE 2" DEEP W/ 3/8" WIDE MAIN BARS @ 1 3/8" O.C. AND 3/4" WIDE CROSS BARS @ 4" O.C. MAX. SPAN SHALL BE 8'-10". SEE PROJECT SPECIFICATIONS FOR FURTHER REQUIREMENTS.
 - 1" GALV. STEEL GRATING SHALL BE 1" DEEP W/ 3/8" WIDE MAIN BARS @ 1 3/8" O.C. AND 3/4" WIDE CROSS BARS @ 4" O.C. MAX. SPAN SHALL BE 4'-0". SEE PROJECT SPECIFICATIONS FOR FURTHER REQUIREMENTS.

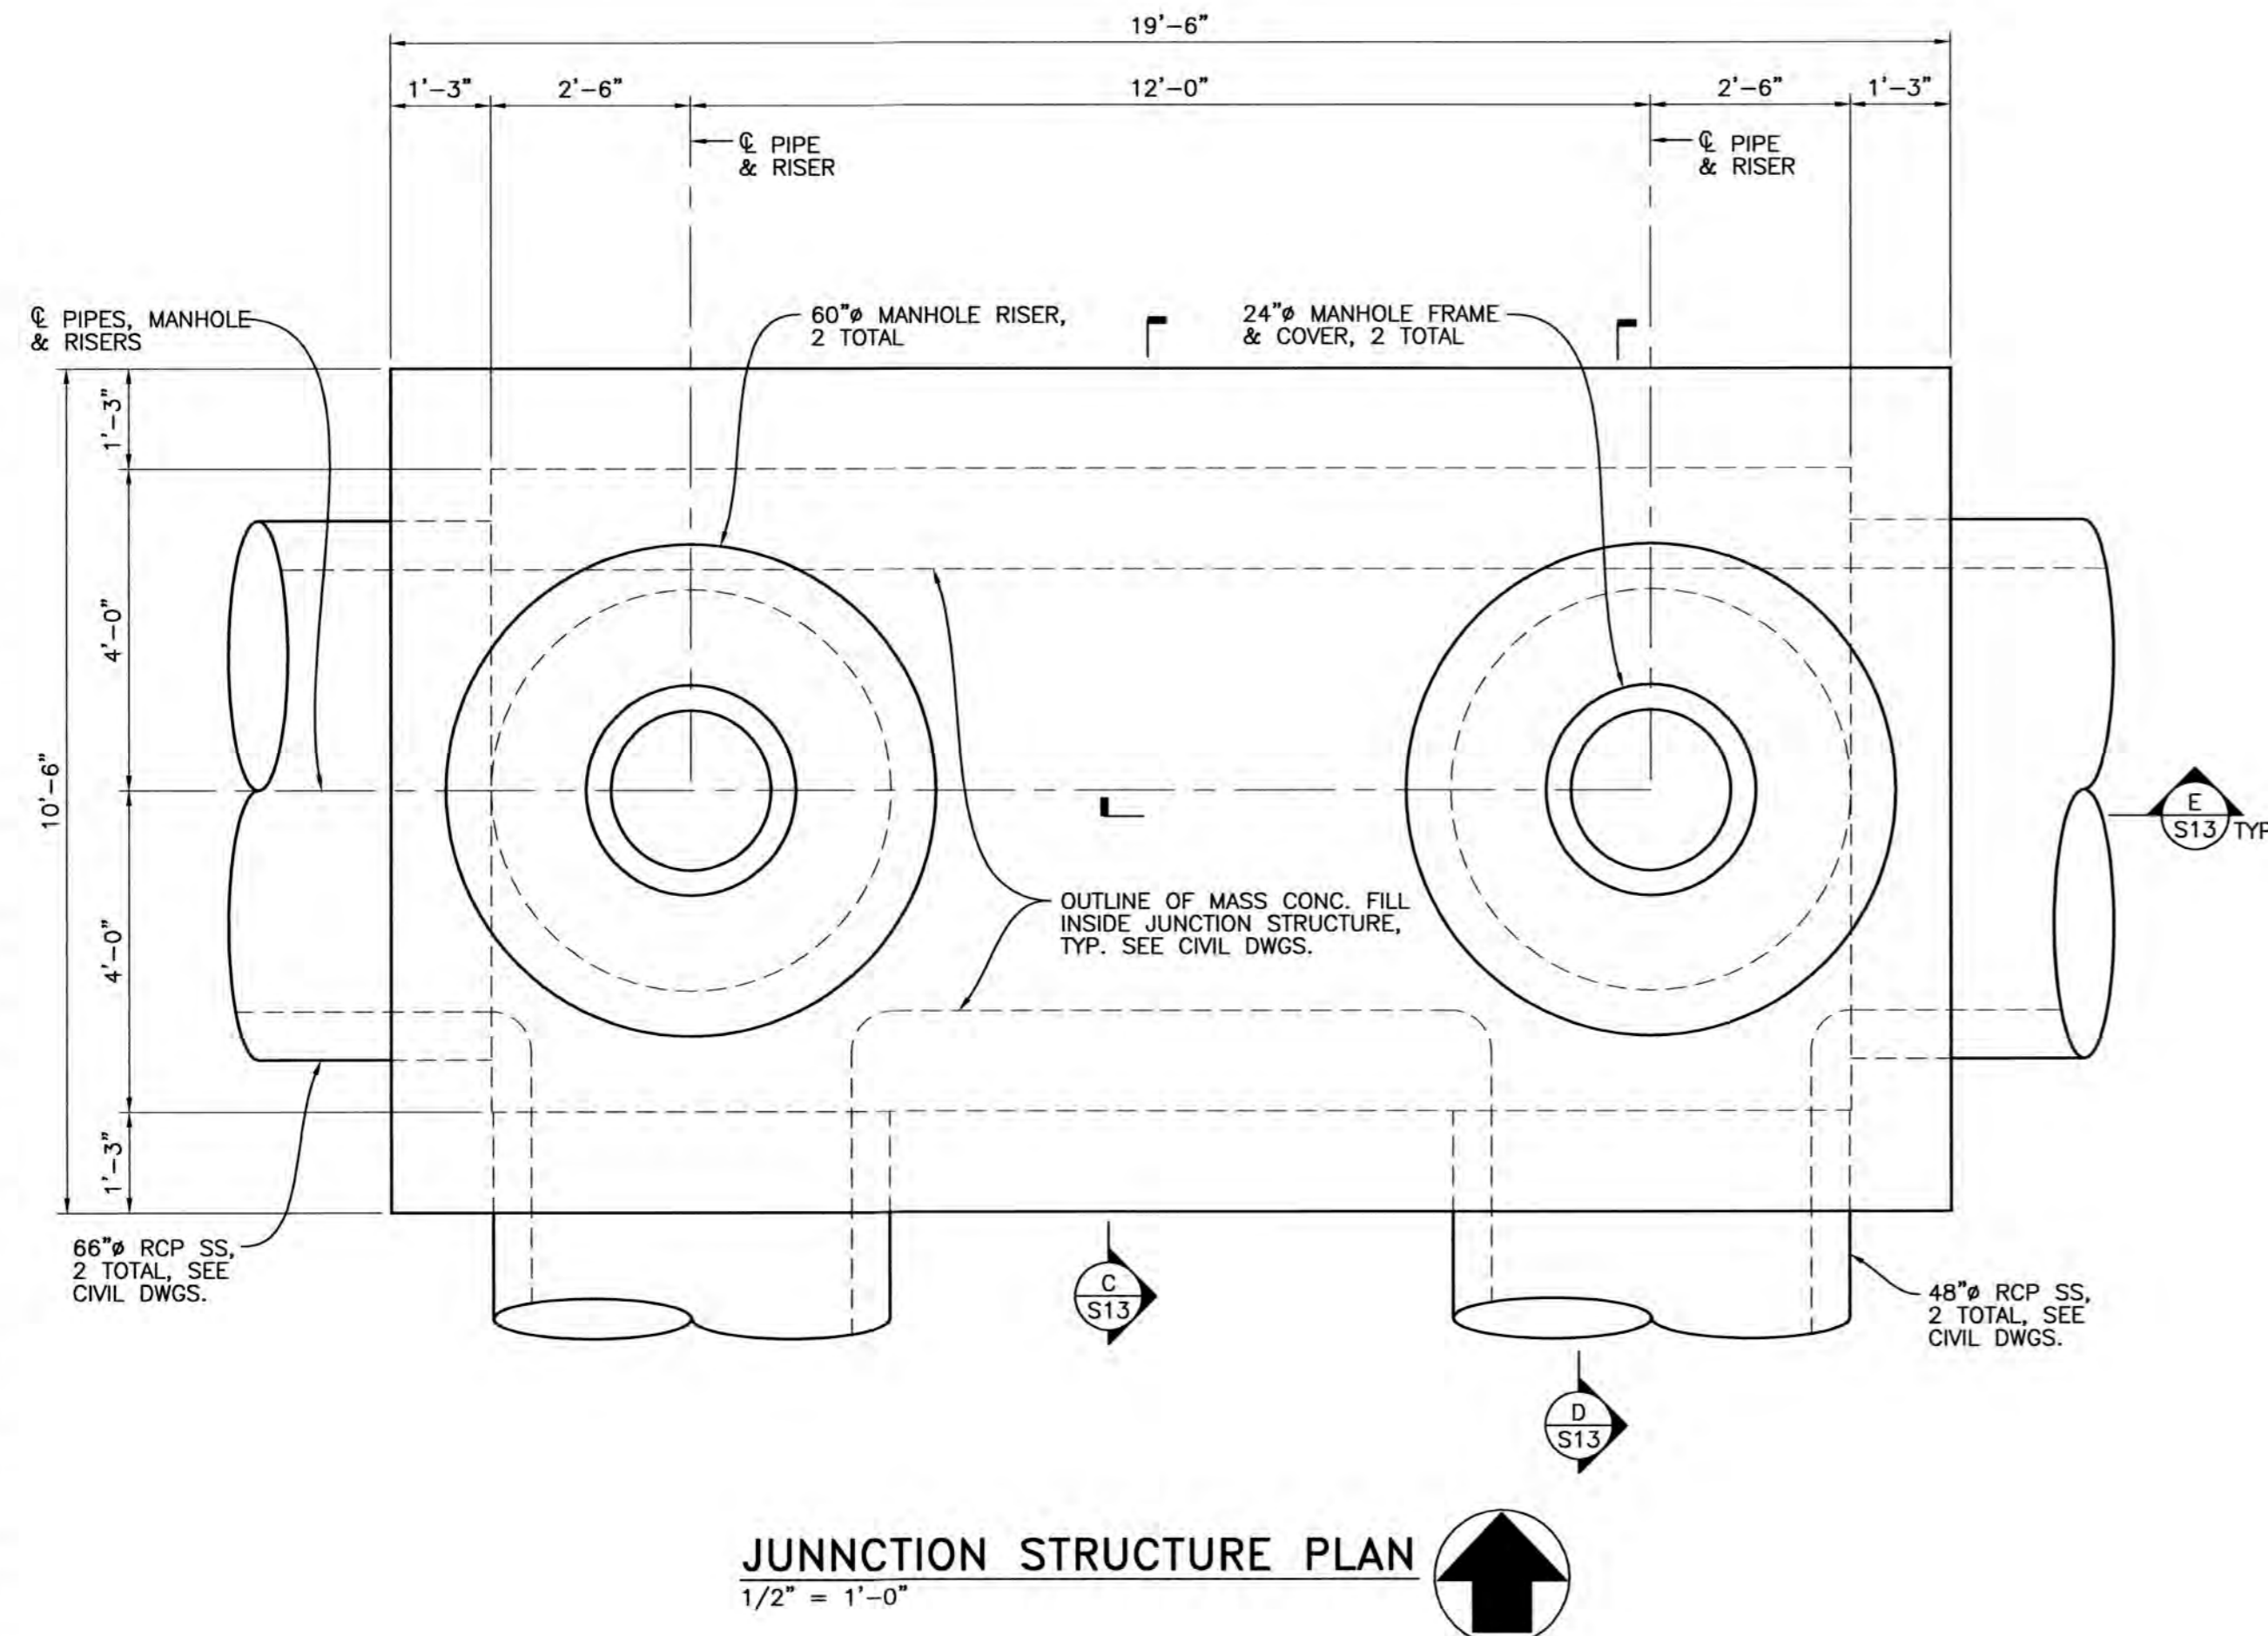


JUNCTION STRUCTURE PLAN
1/2" = 1'-0"

- NOTES:**
- CONDITION W/ W8x18 CARRYING BEAM IS SIMILAR.
 - BEAMS SHALL BE GALVANIZED AFTER FABRICATION IS COMPLETE.

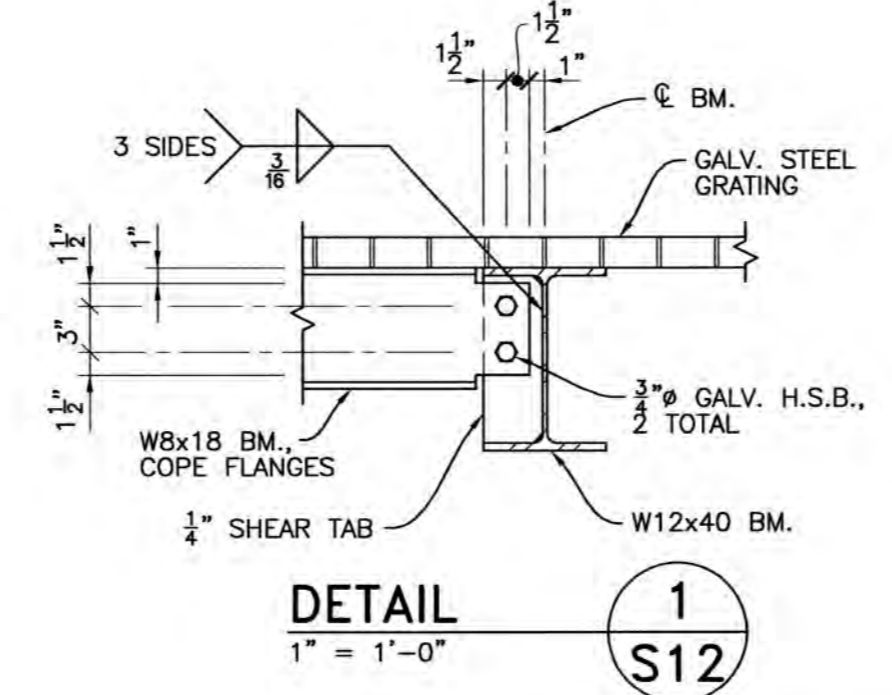


DETAIL 1
1" = 1'-0" S12

- NOTES:**
- CONDITION W/ W8x18 BM. SHOWN. CONDITION W/ W12x40 BM. IS SIMILAR.
 - BEAM & R's SHALL BE GALVANIZED AFTER FABRICATION IS COMPLETE.

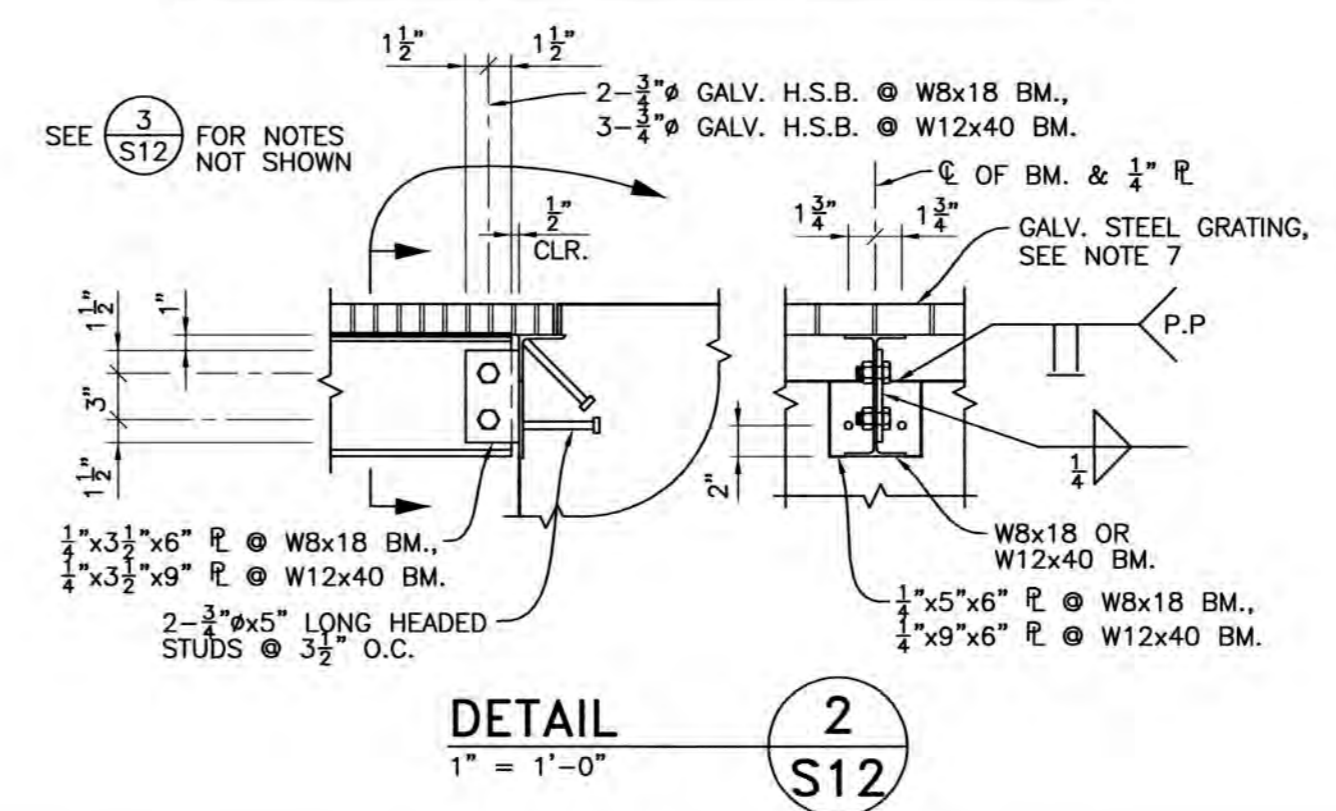

DETAIL 2
1" = 1'-0" S12

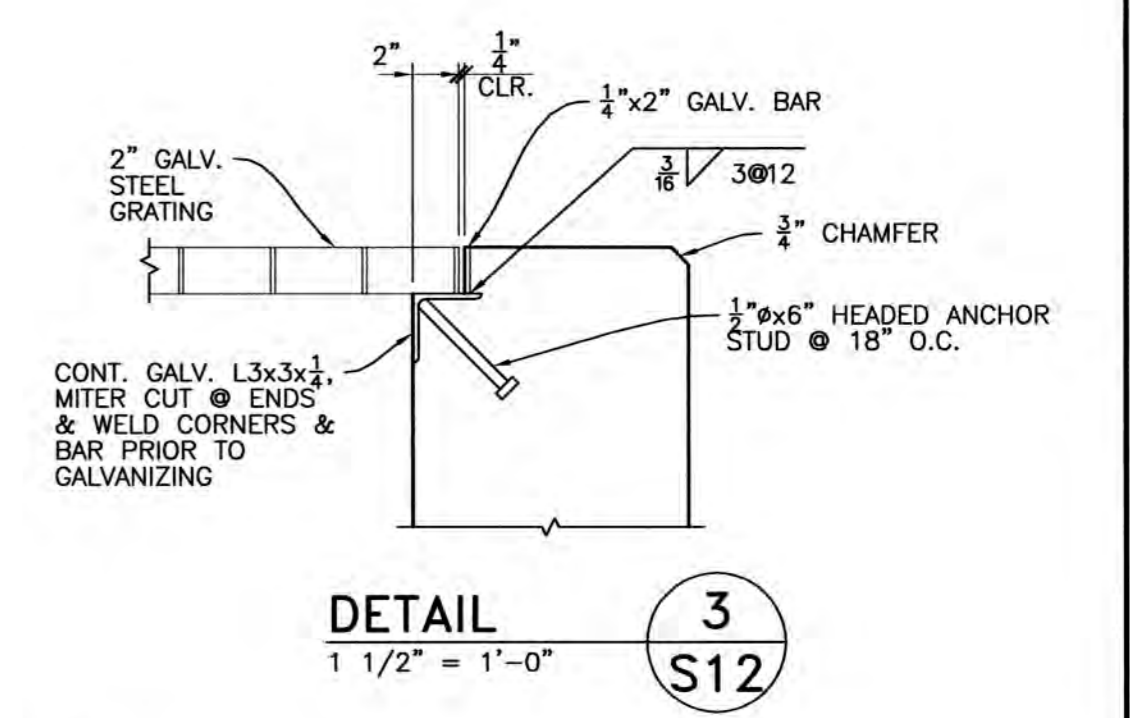

DETAIL 3
1 1/2" = 1'-0" S12

N:\Clients\283_Sponos\00-05-01_14-MSFS_Upgrade\CAD\Design\Asbuilt\05-147512.dwg 11-13-08 11:05:29 AM oreimer

Underground Service Alert

TWO DAYS BEFORE YOU DIG

Call TOLL FREE: 1-800-642-2444

REFER TO SET FOR SIGNATURE

REV. No.	DISCRPTION	DATE	By	App'd By
1				
2				
3				
4				
5				
6				
7				

WEST YOST ASSOCIATES

Consulting Engineers







1260 Lake Boulevard
Suite 240
Davis, California 95616
(530) 756-5905
FAX (530) 756-5991

RECORD DRAWINGS

14-Mile Slough Pump Station Upgrades

INTERCONNECTION VAULT, ISOLATION VAULT & JUNCTION STRUCTURE PLANS, DETAILS & NOTES

DEPARTMENT OF MUNICIPAL UTILITIES CITY OF STOCKTON, CALIFORNIA		SCALE: AS SHOWN	APPROVED BY: DATE:	SHEET No.
DESIGNED BY: TEE	DRAWN BY: REM	CHECKED BY: JAF	RECORD Dwg.:	S12
ASSISTANT DIRECTOR, DEPT. OF MUNICIPAL UTILITIES				42 of 89 SHEETS
				PROJECT No. 293-00-05-01

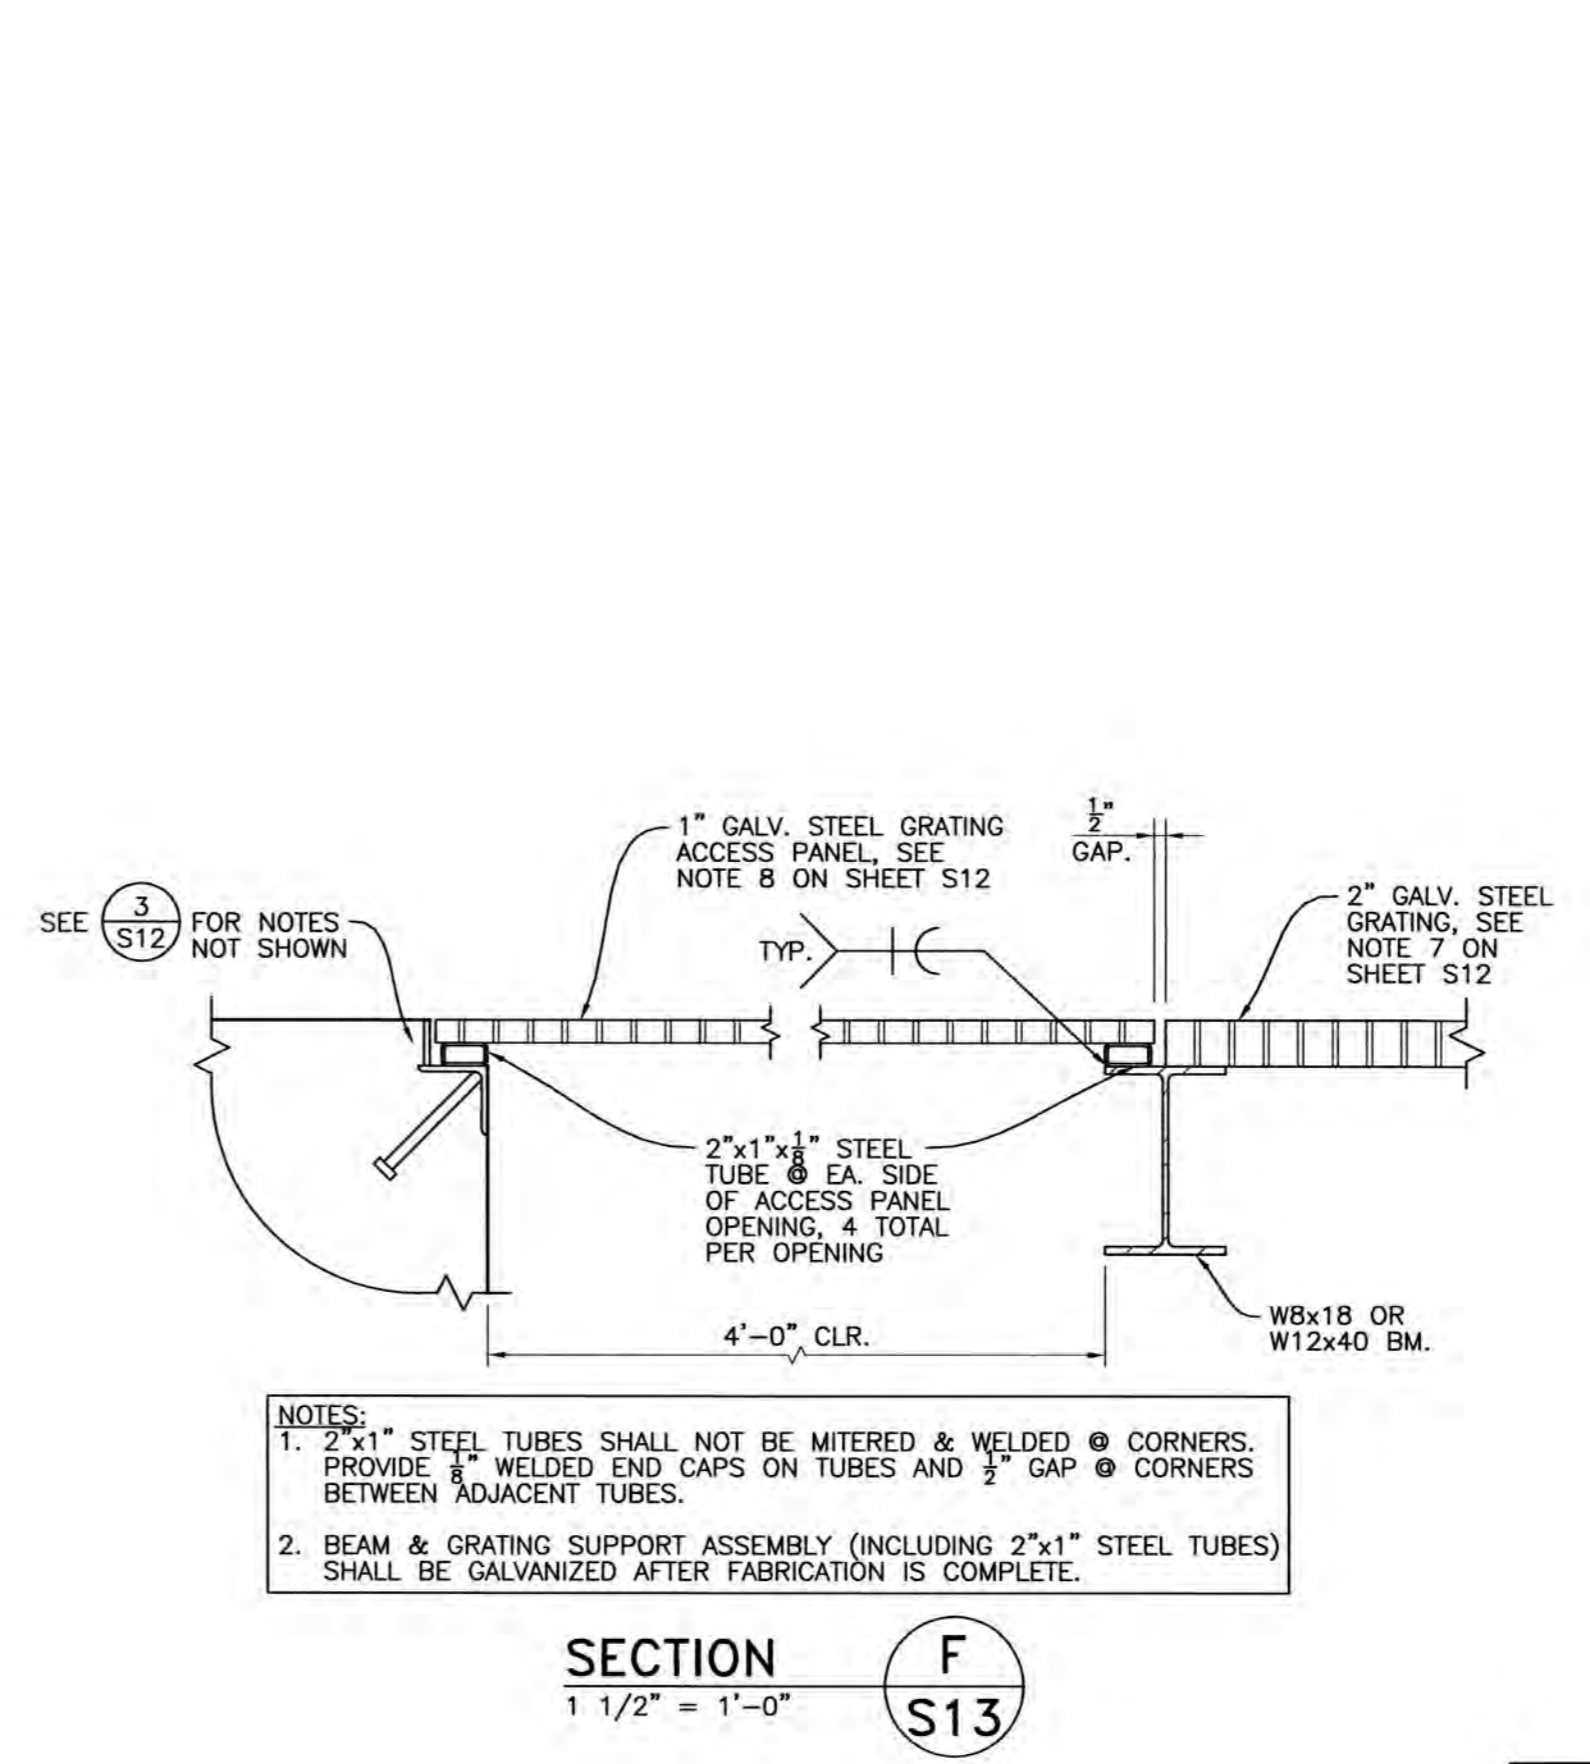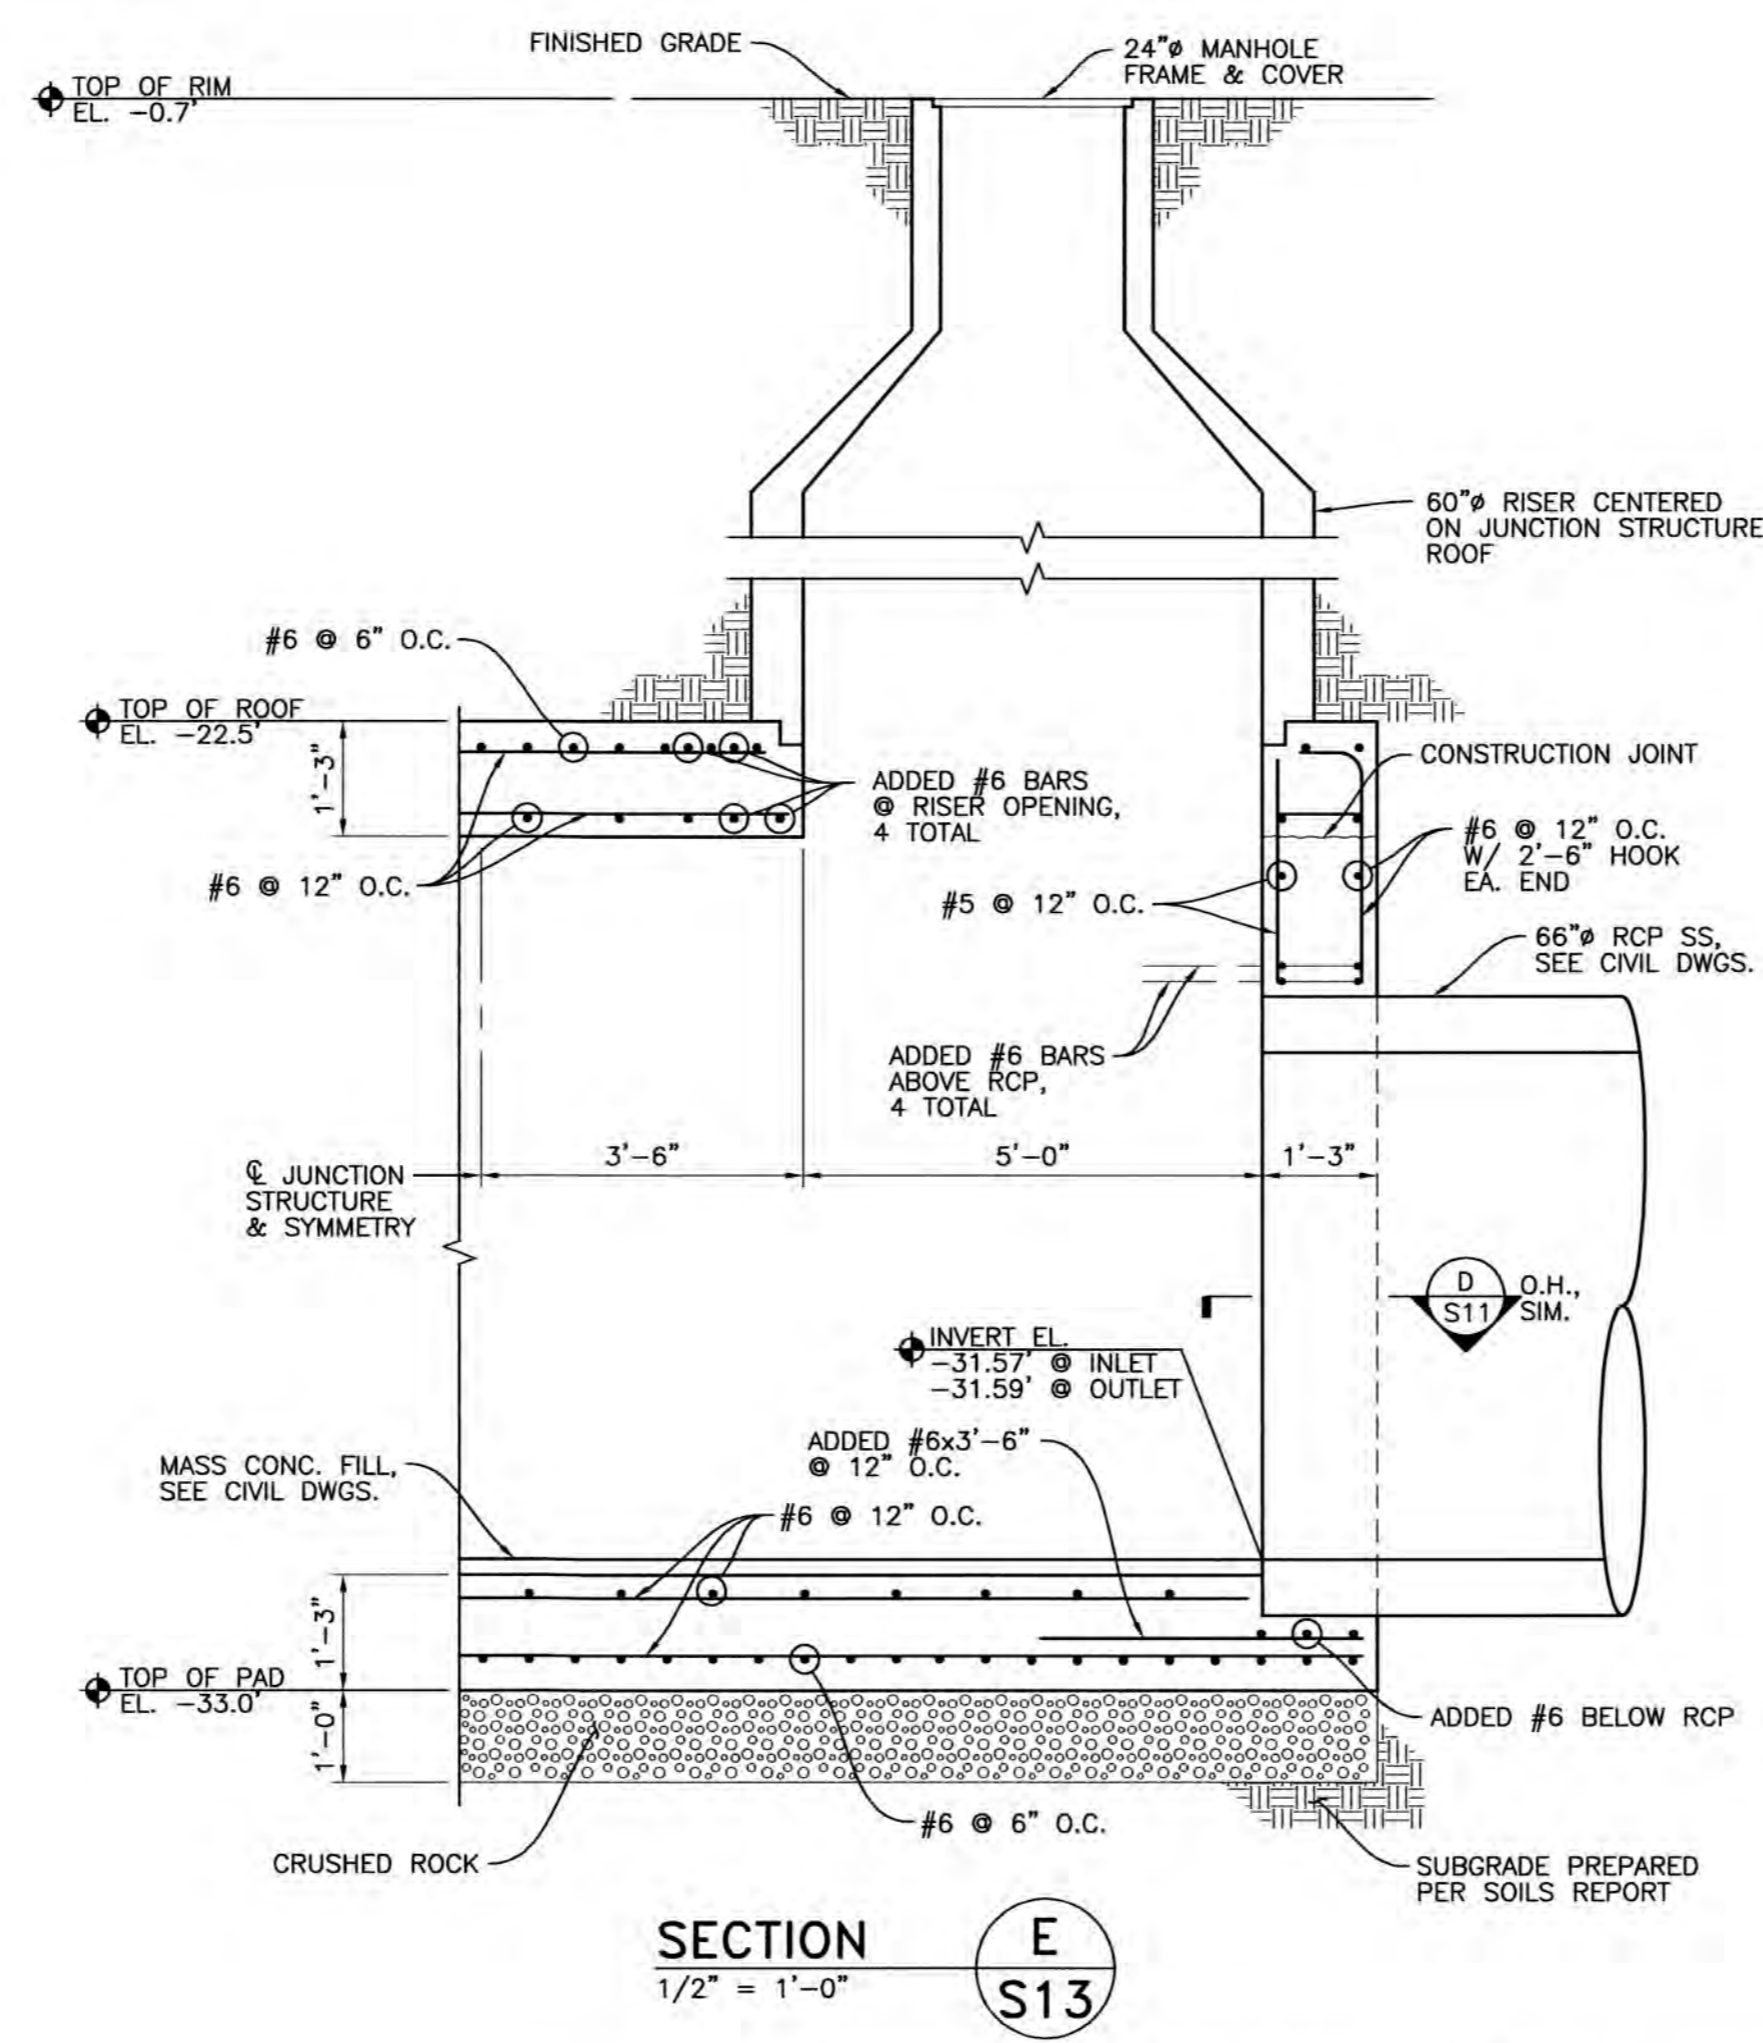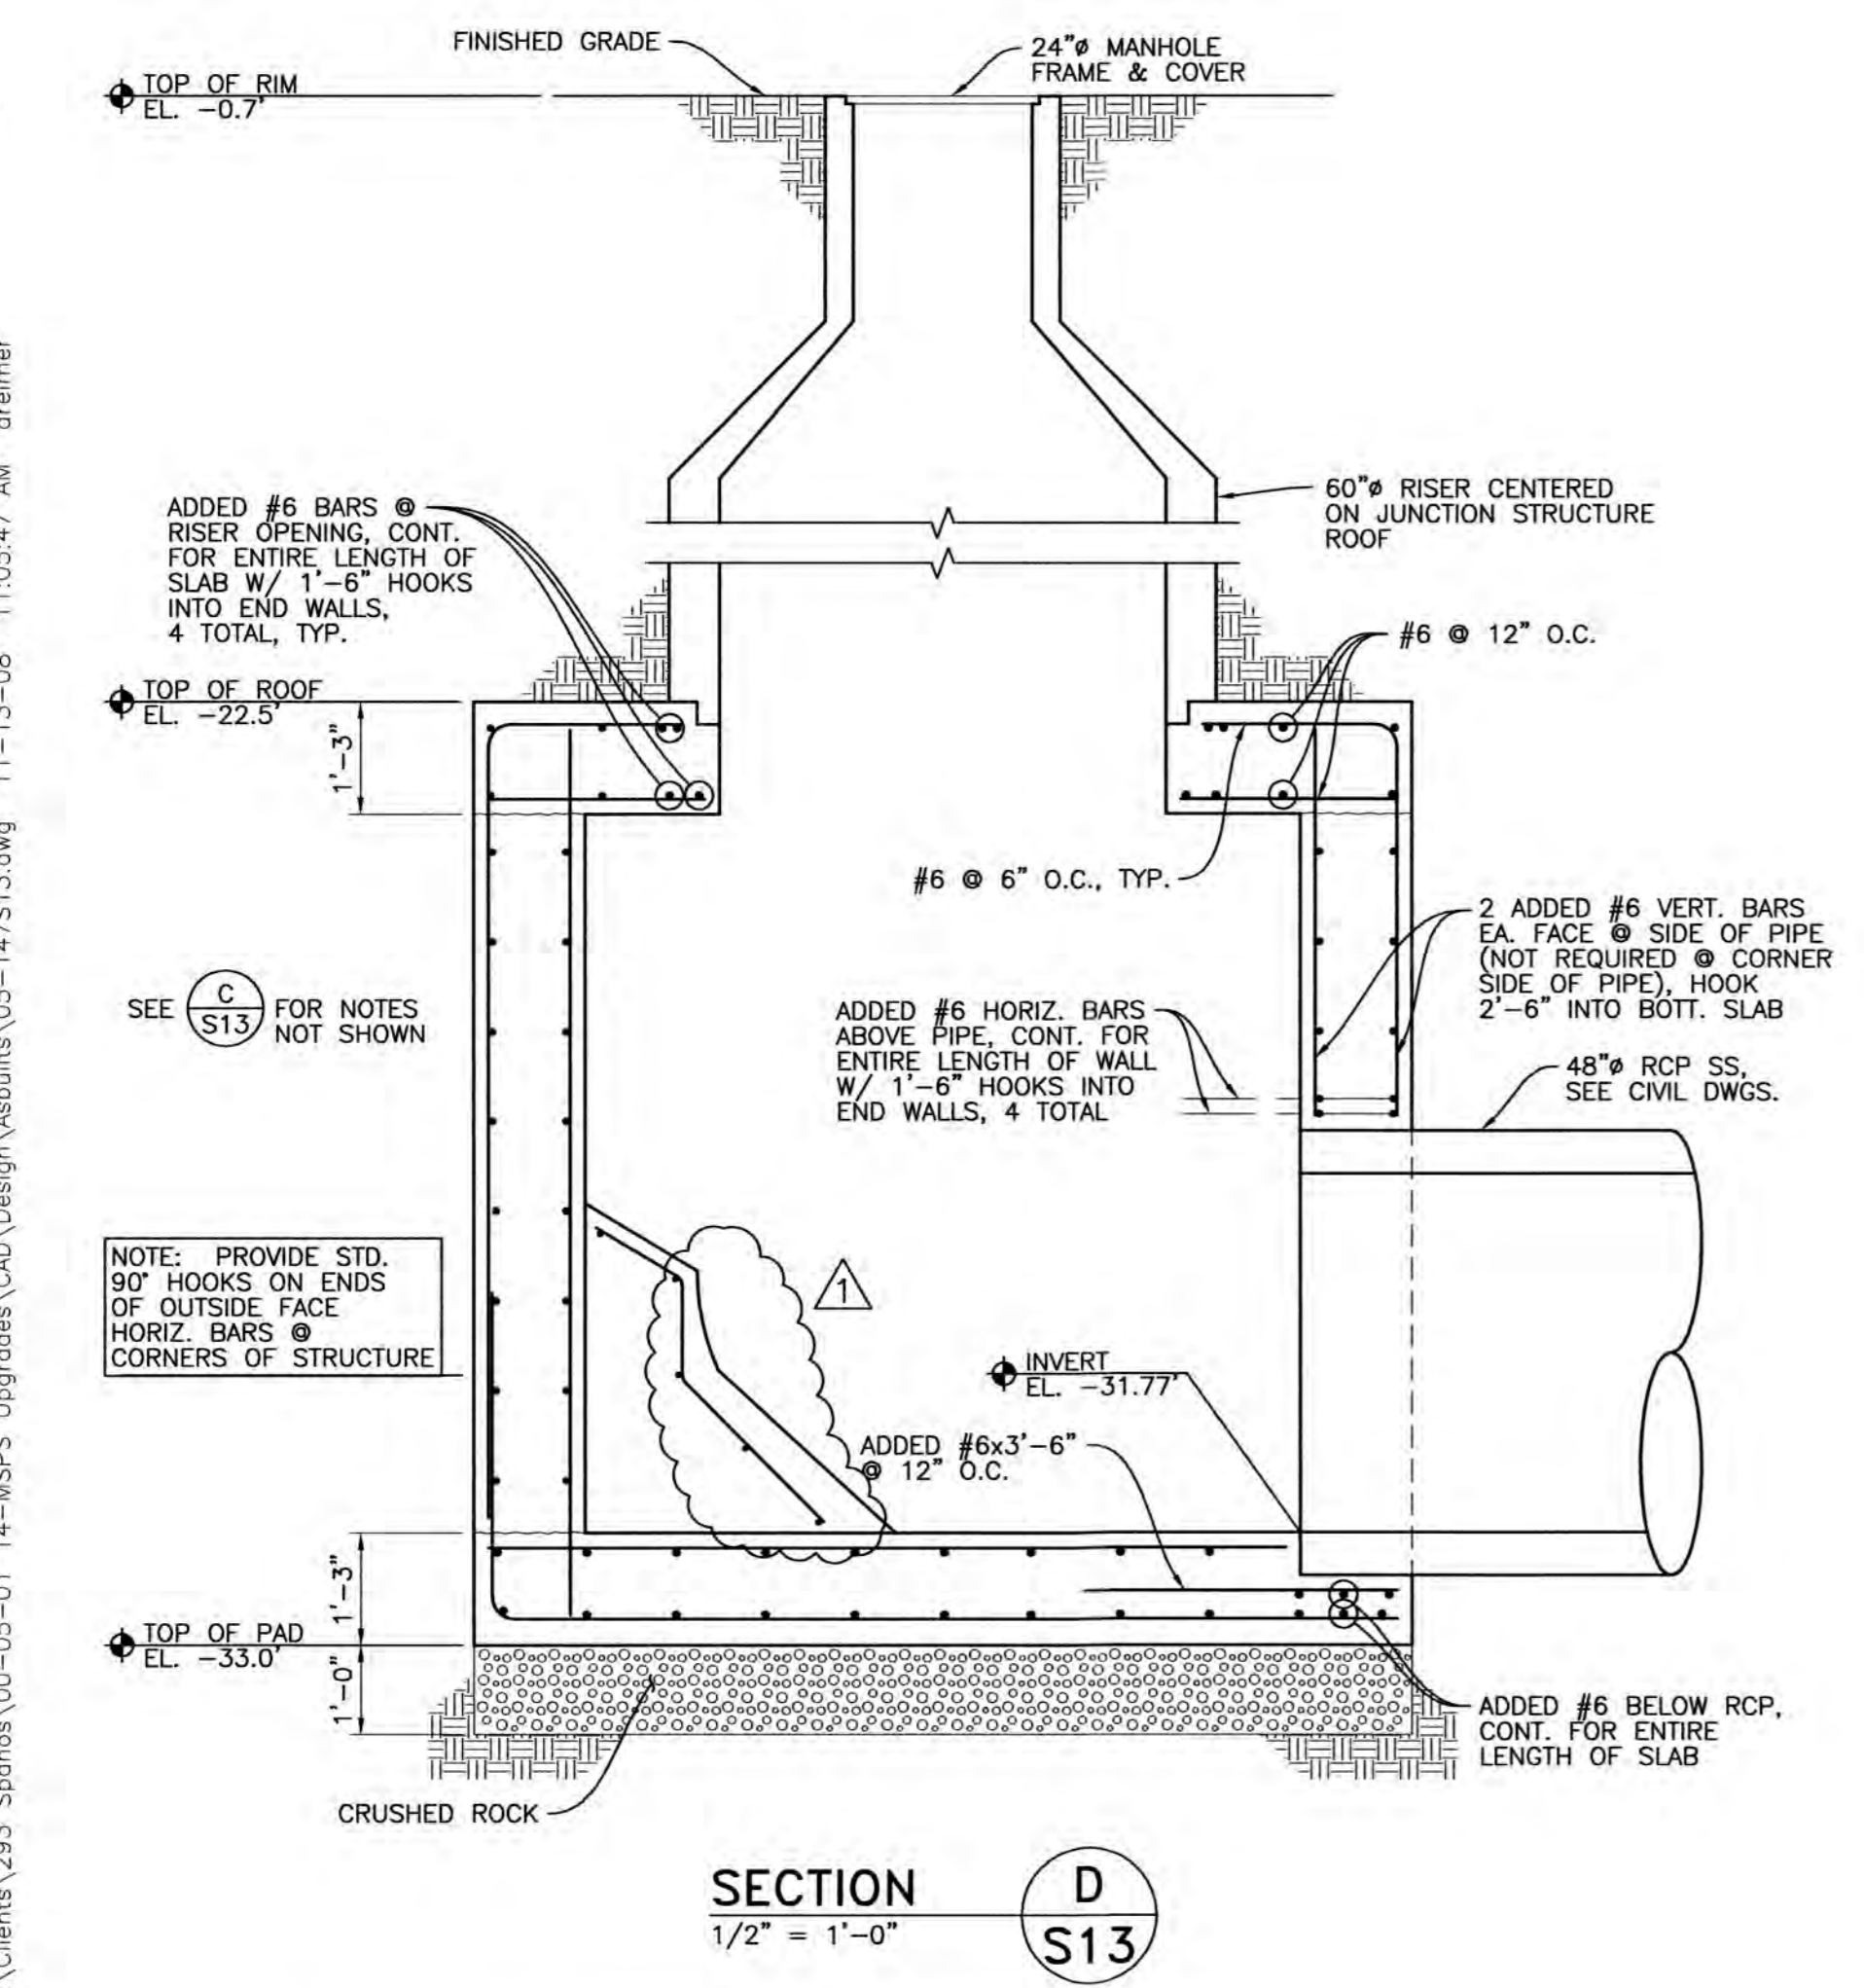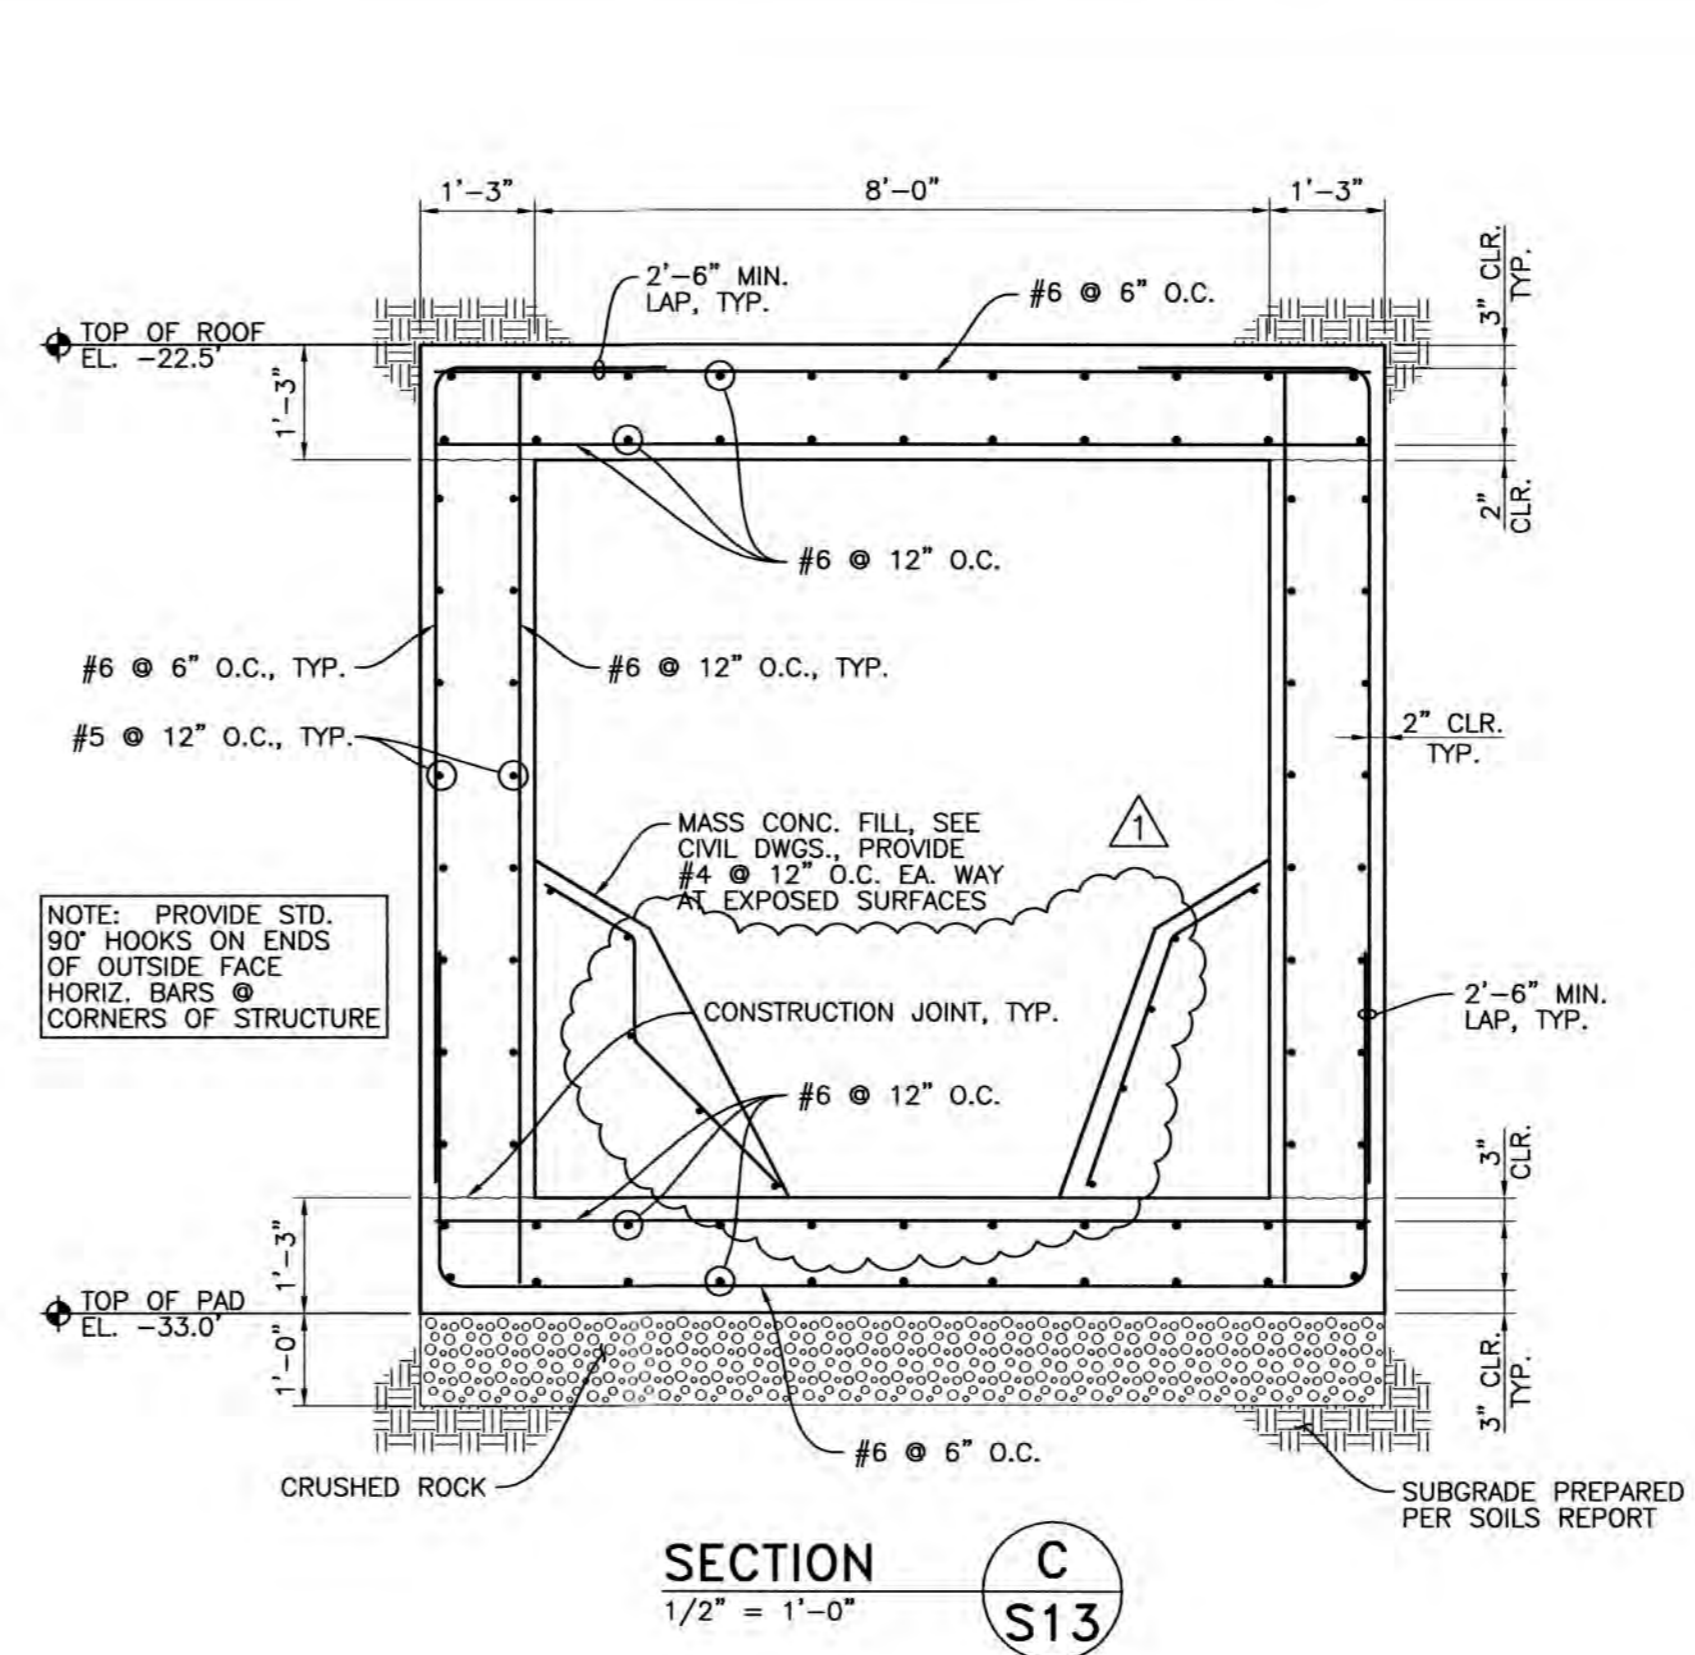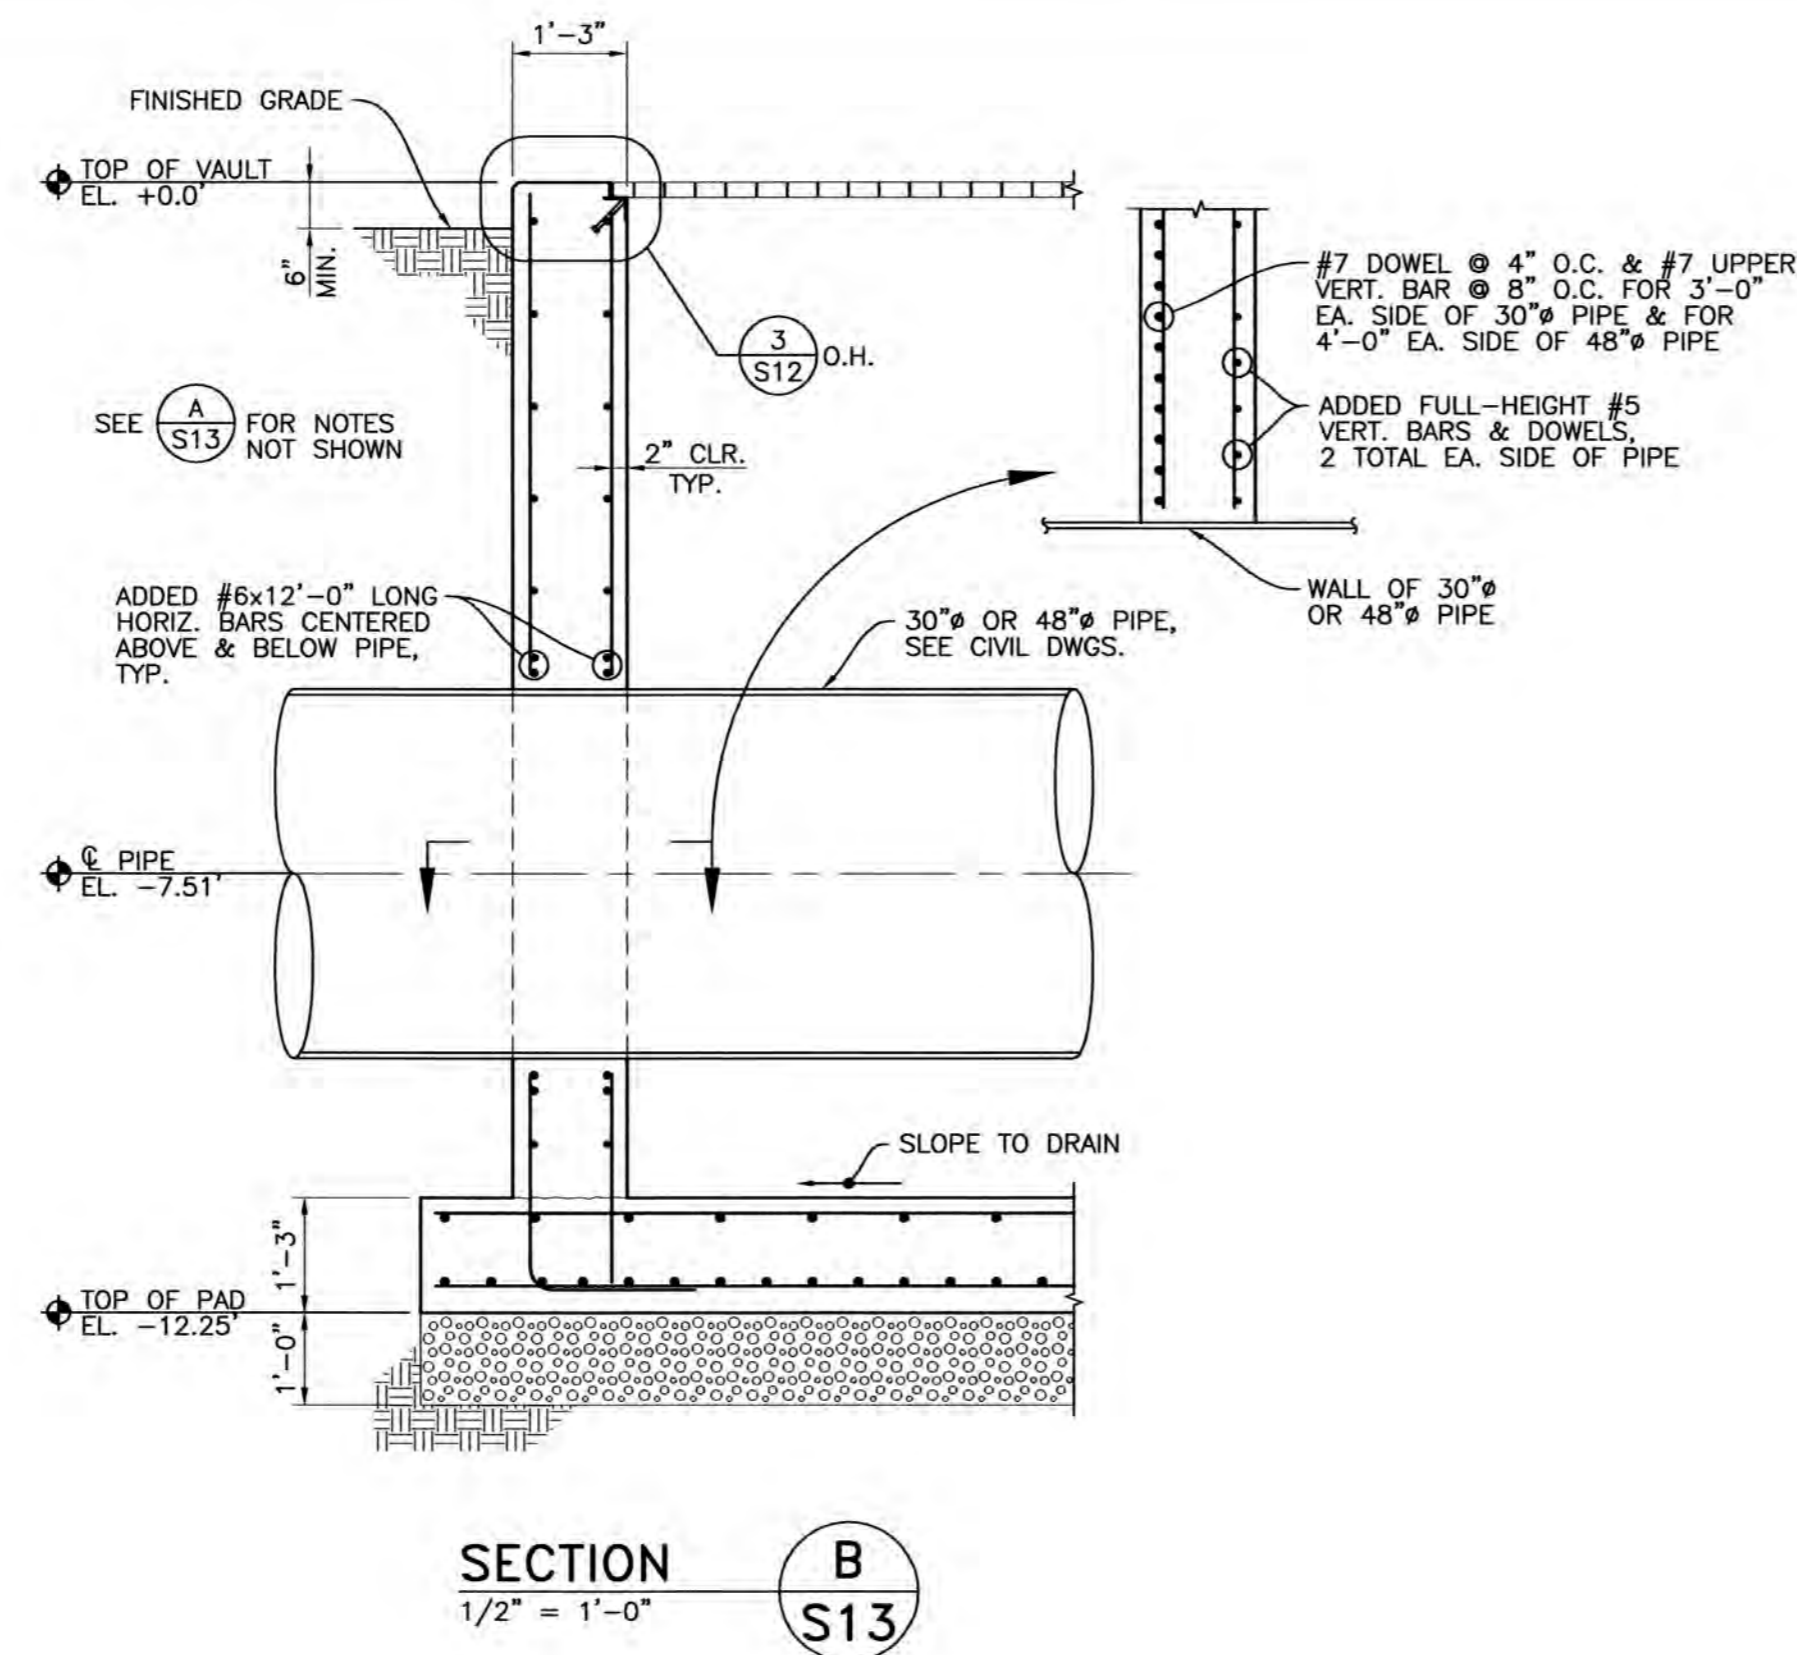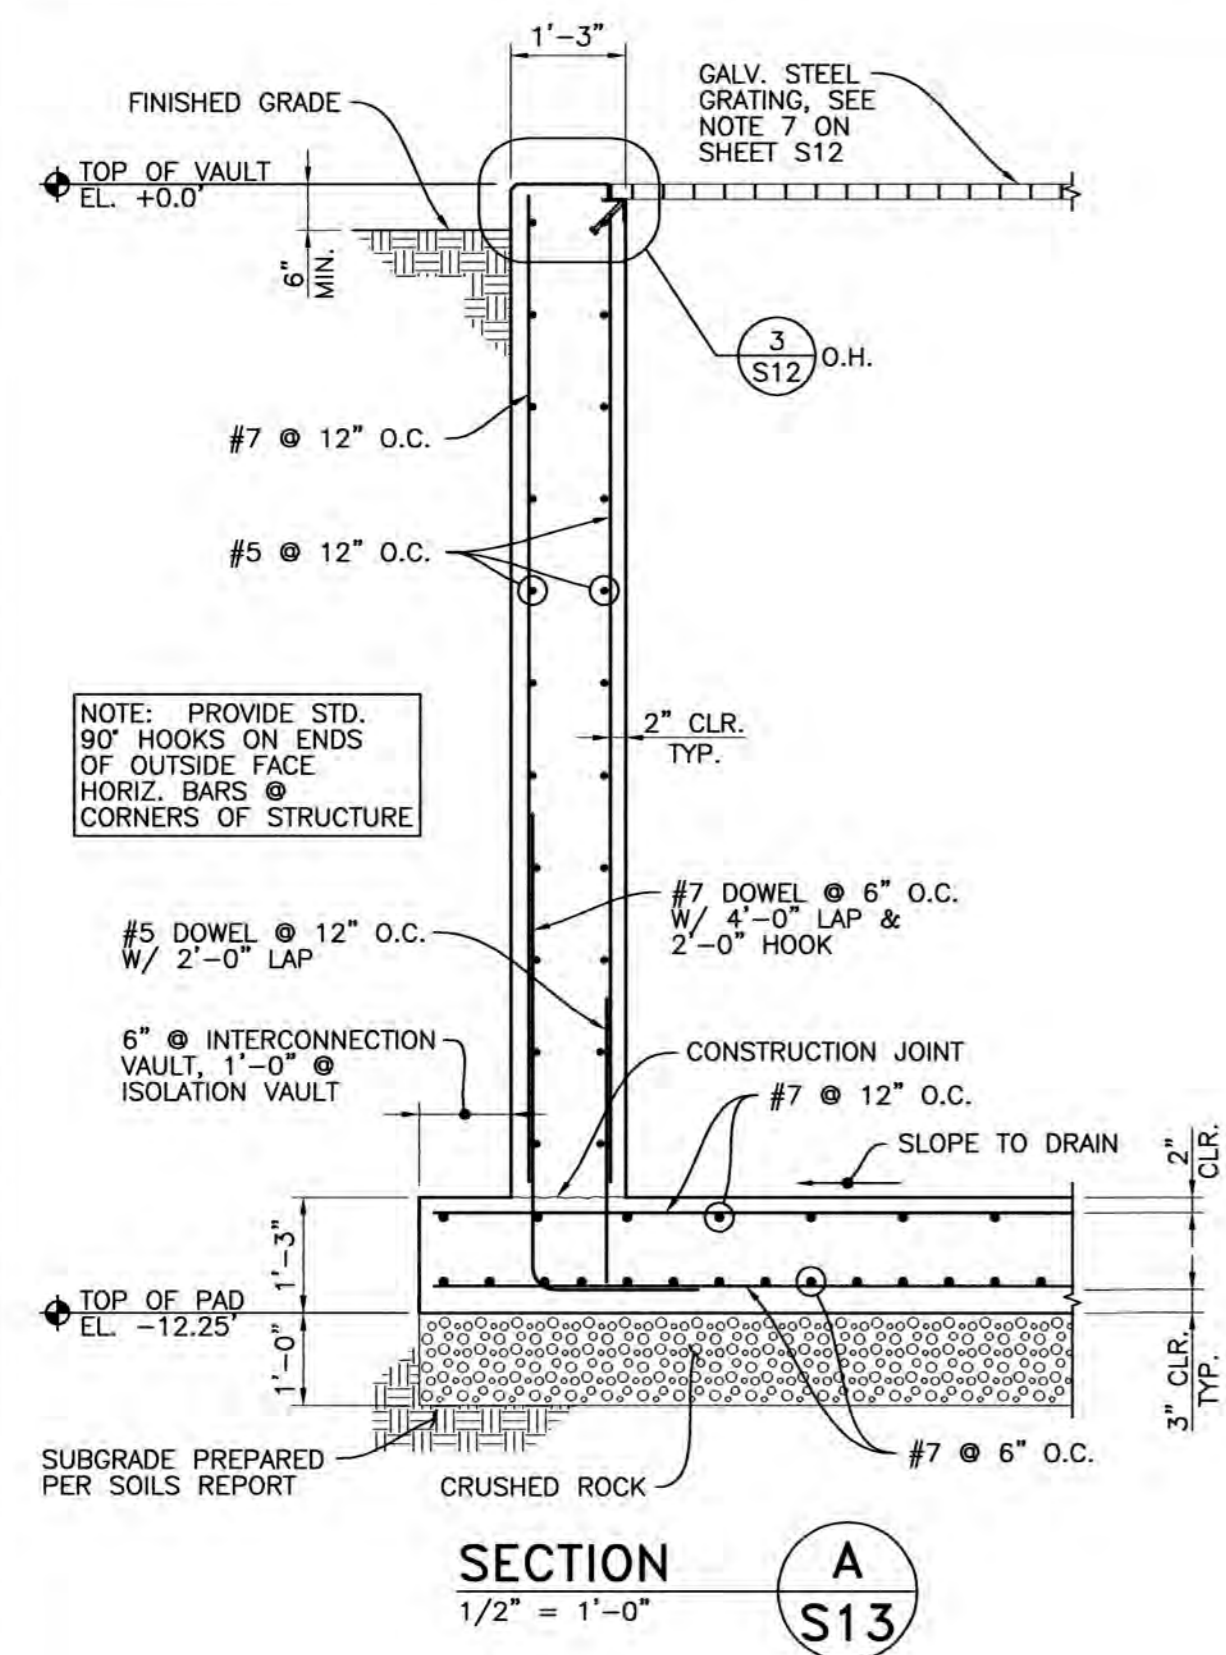

Underground Service Alert

TWO DAYS BEFORE YOU DIG

Call TOLL FREE: 1-800-642-2444

REFER TO SET FOR SIGNATURE

REV. No.	DISCRPTION	DATE	BY	Apr'd By
1	RECORD DRAWINGS	8/8/08	MAH	PDF
2				
3				
4				
5				
6				

WEST YOST ASSOCIATES

Consulting Engineers

1260 Lake Boulevard
Suite 240
Davis, California 95616
(530) 756-5905
FAX (530) 756-5991

RECORD DRAWINGS


14-Mile Slough Pump Station Upgrades

INTERCONNECTION VAULT, ISOLATION VAULT & JUNCTION STRUCTURE SECTIONS & DETAILS


DEPARTMENT OF MUNICIPAL UTILITIES
CITY OF STOCKTON, CALIFORNIA

SCALE: AS SHOWN	APPROVED BY: DATE: _____	SHEET No. S13
DESIGNED BY: TEE		43 of 89 SHEETS
DRAWN BY: REM		PROJECT No. 293-00-05-01
CHECKED BY: JAF	ASSISTANT DIRECTOR, DEPT. OF MUNICIPAL UTILITIES	
RECORD DWG.:		

N:\Client\293\Spurlock\00-05-01 14-MSFS Upgrades\CAD\Design\Asbuilt\293-0501A3-3&4.dwg 11-13-08 11:15:15 AM areimer

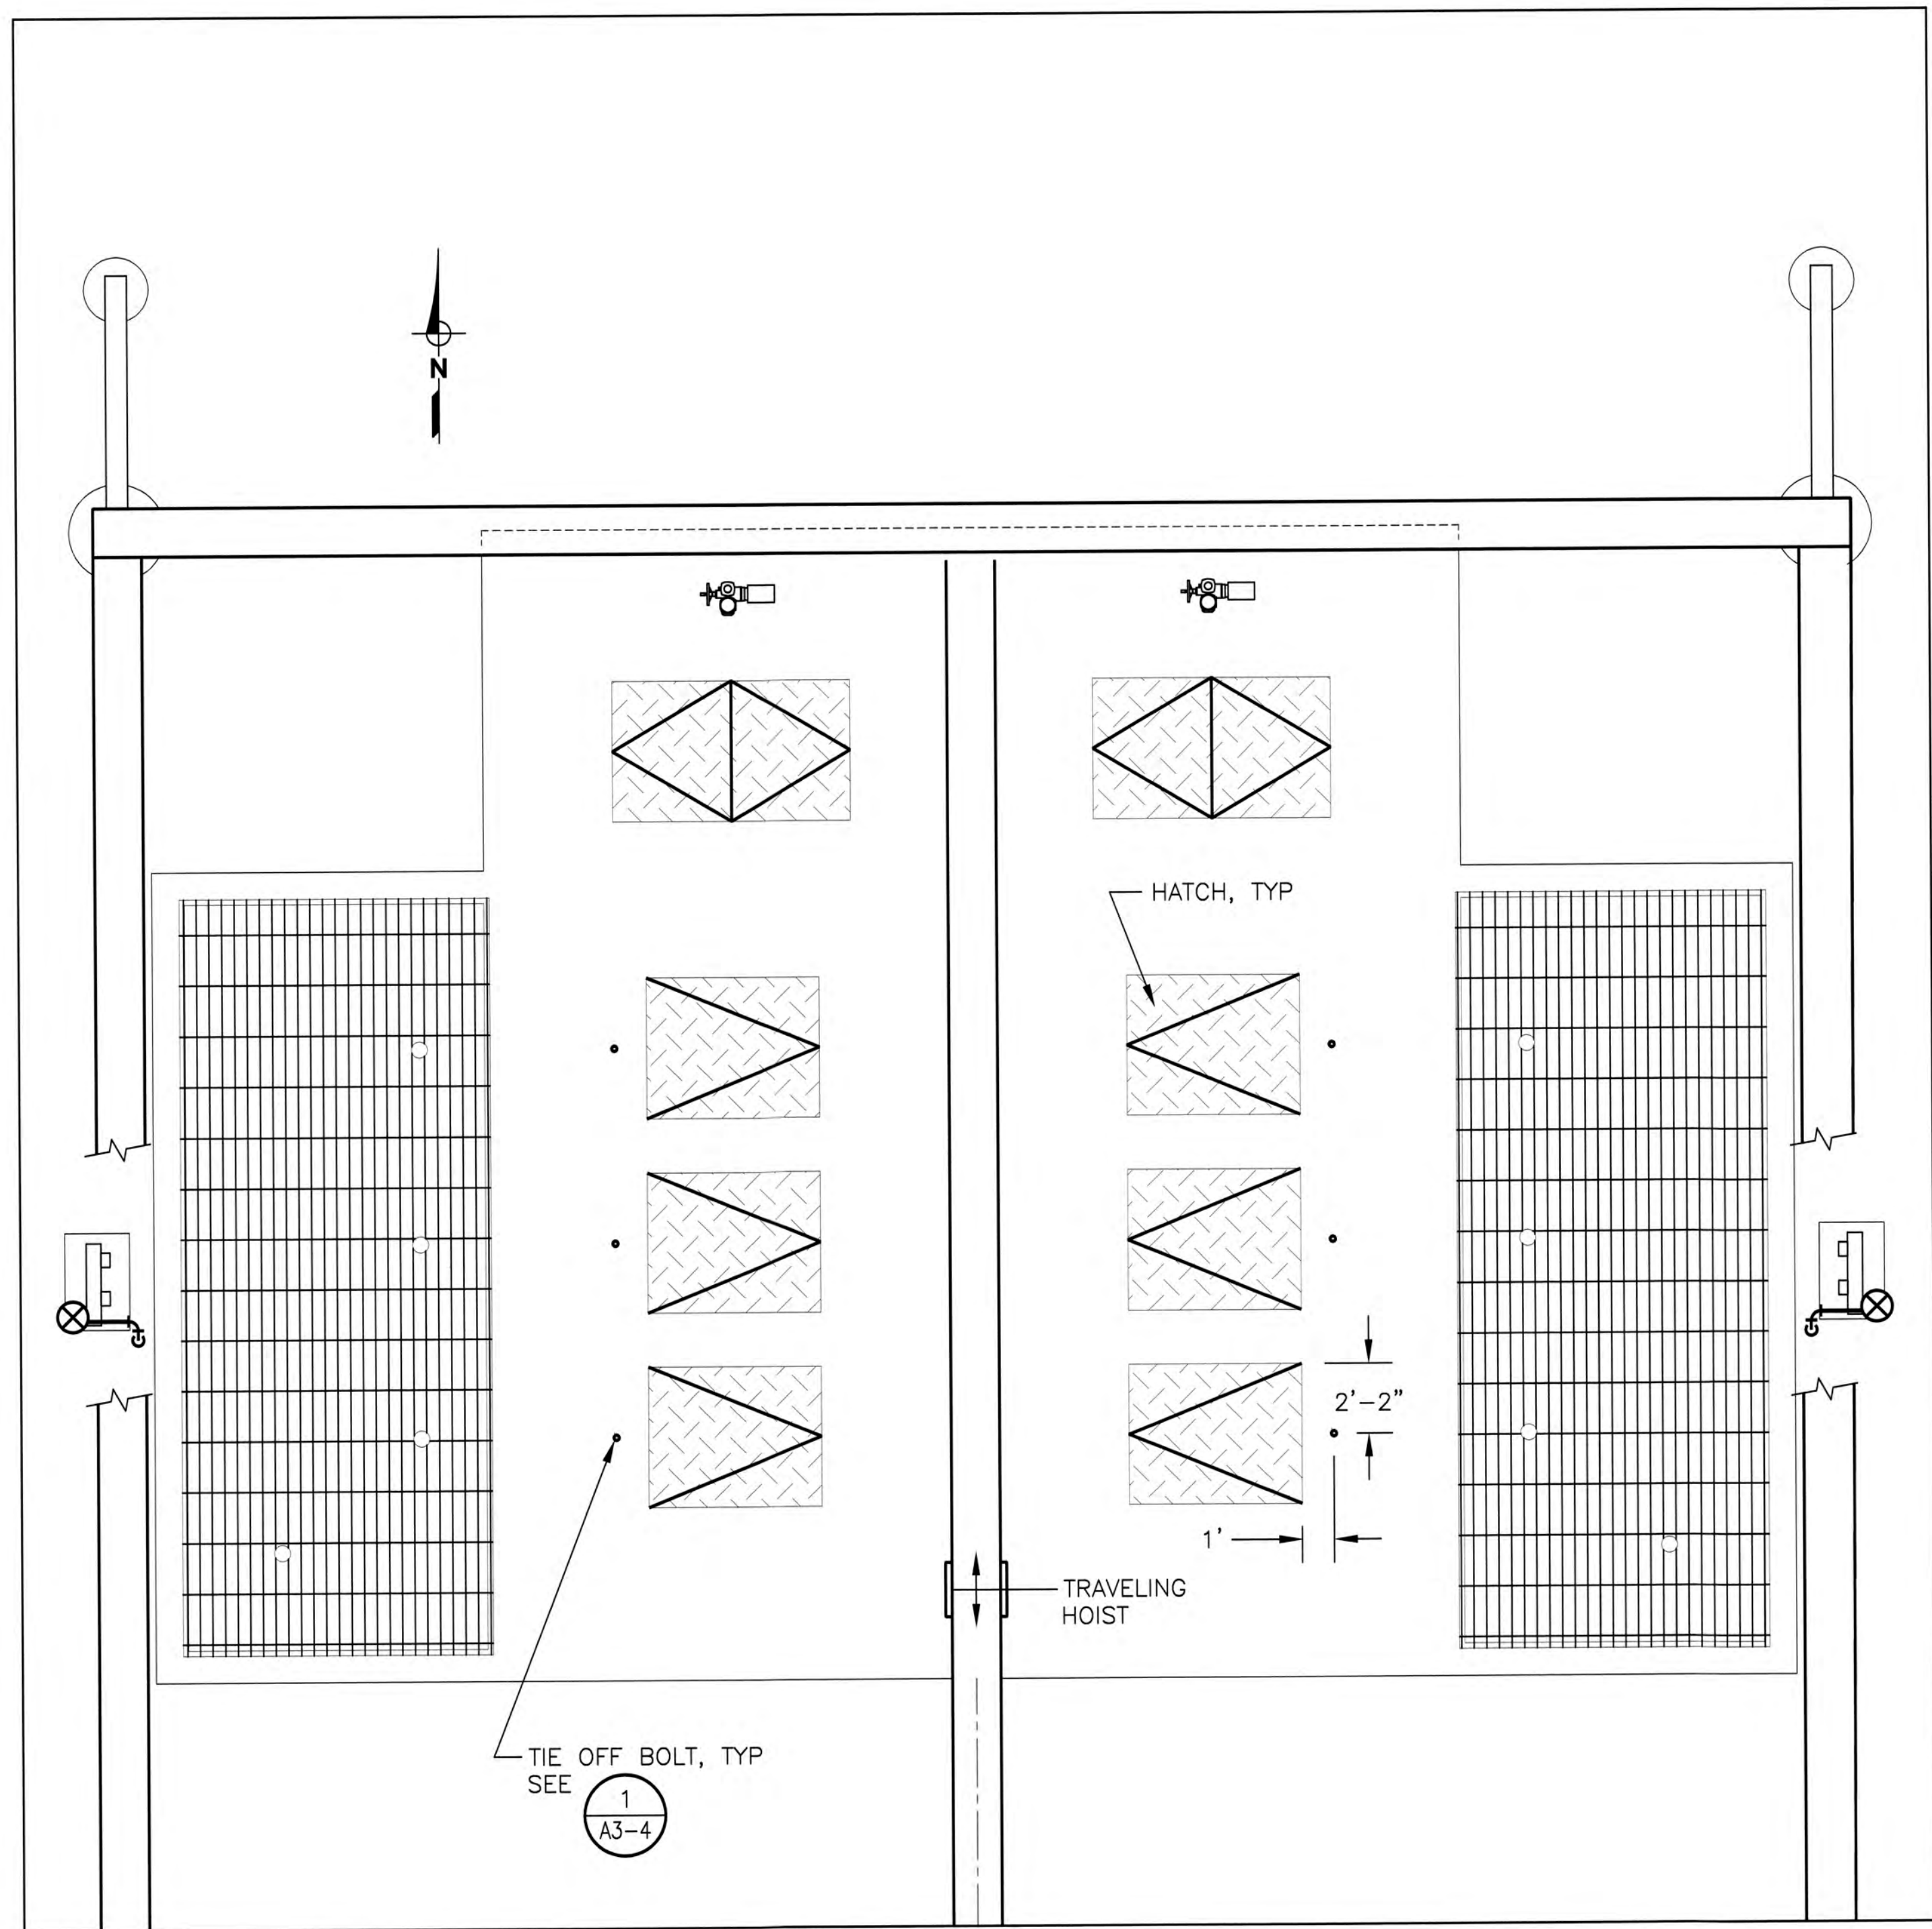

PUMP STATION
PLAN
SCALE: 1/4"=1'
SKETCH A3-3

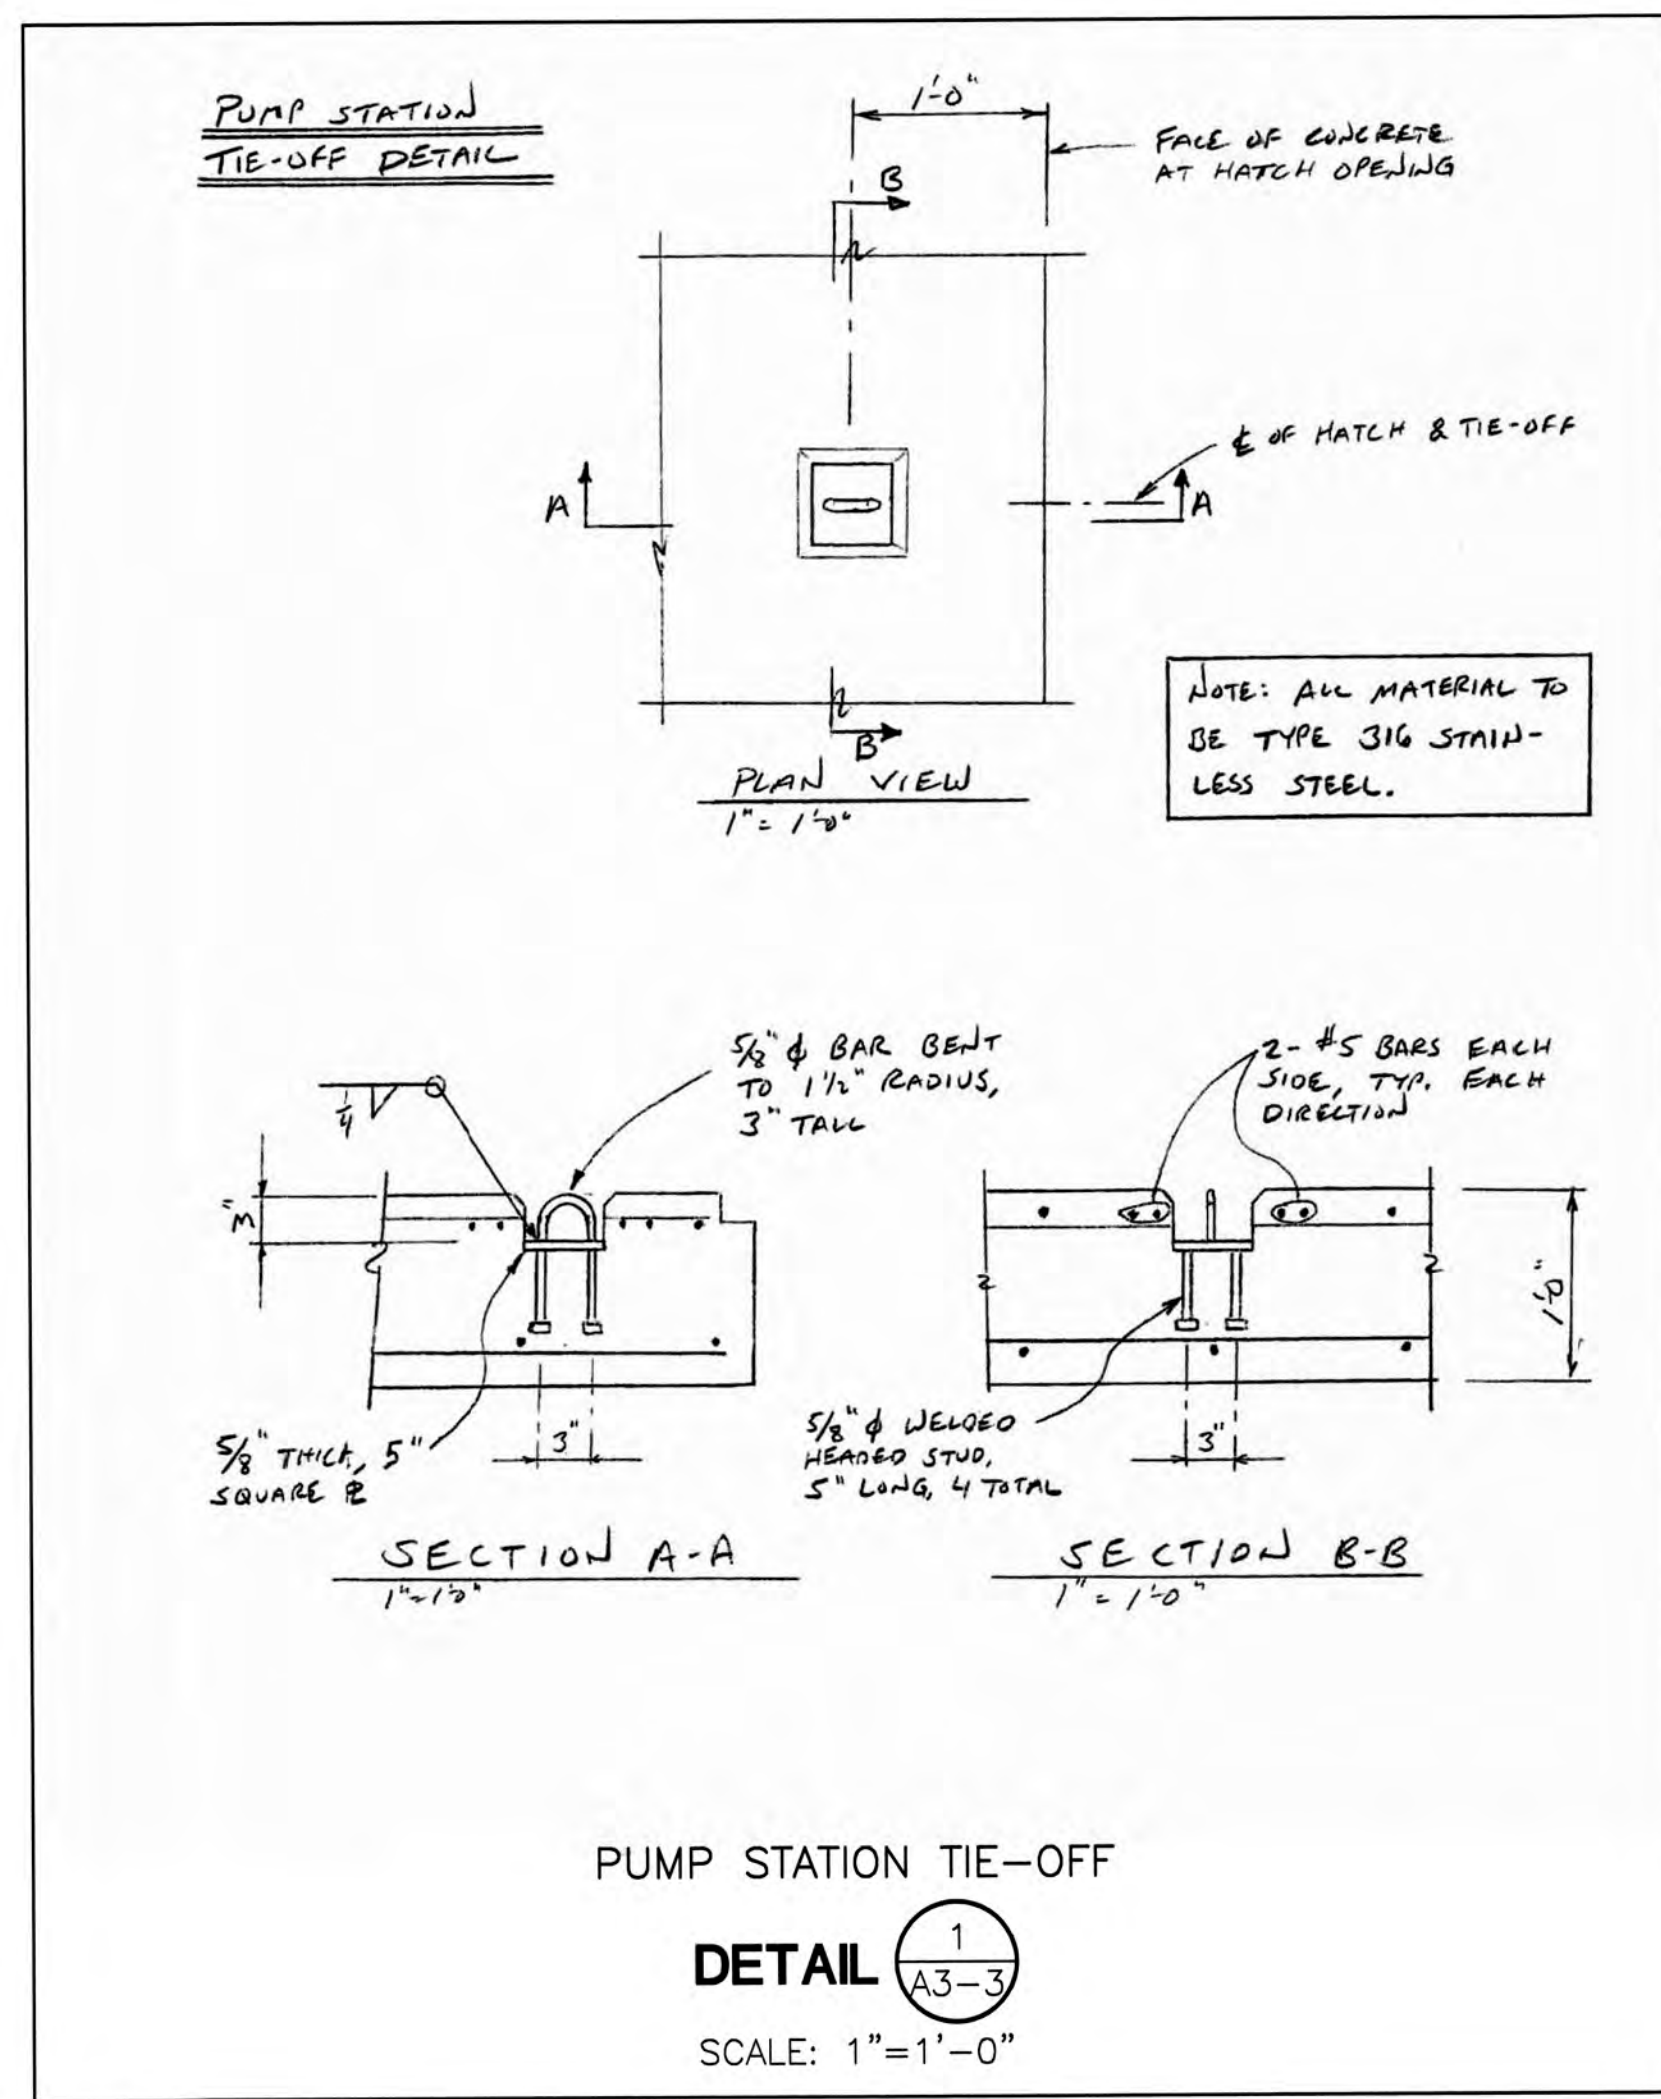

PUMP STATION TIE-OFF
DETAIL
SCALE: 1"=1'-0"

SKETCH A3-4

Underground Service Alert
TWO DAYS BEFORE YOU DIG
Call TOLL FREE: 1-800-642-2444



REFER TO BID SET FOR SIGNATURE

REV. No.	DISCRIPTION	DATE	BY	App'd By
1	ADDENDUM No. 3	5/25/08	TTT	PDF
2				
3				
4				
5				
6				
7				



WEST YOST ASSOCIATES
Consulting Engineers
1260 Lake Boulevard Suite 240 Davis, California 95616
(530) 756-5905 FAX (530) 756-5991

RECORD DRAWINGS		
14-Mile Slough Pump Station Upgrades		
ADDENDUM SKETCHES A3-3 & A3-4		
DEPARTMENT OF MUNICIPAL UTILITIES CITY OF STOCKTON, CALIFORNIA		
SCALE: AS SHOWN	APPROVED BY: DATE: _____	SHEET No. _____
DESIGNED BY: PDF/TTT	ASSISTANT DIRECTOR, DEPT. OF MUNICIPAL UTILITIES	44 of 89 SHEETS
DRAWN BY: RDB		PROJECT No. 293-00-05-01
CHECKED BY: GDH		
RECORD DWG.:		

▲ BOLTS ARE 304 SS

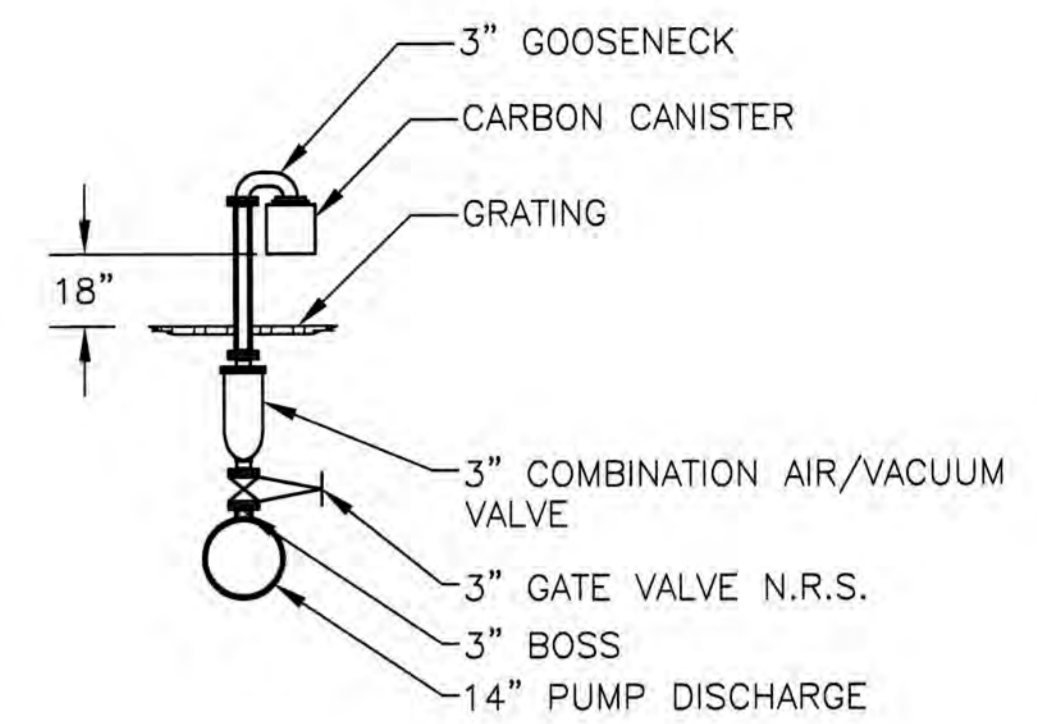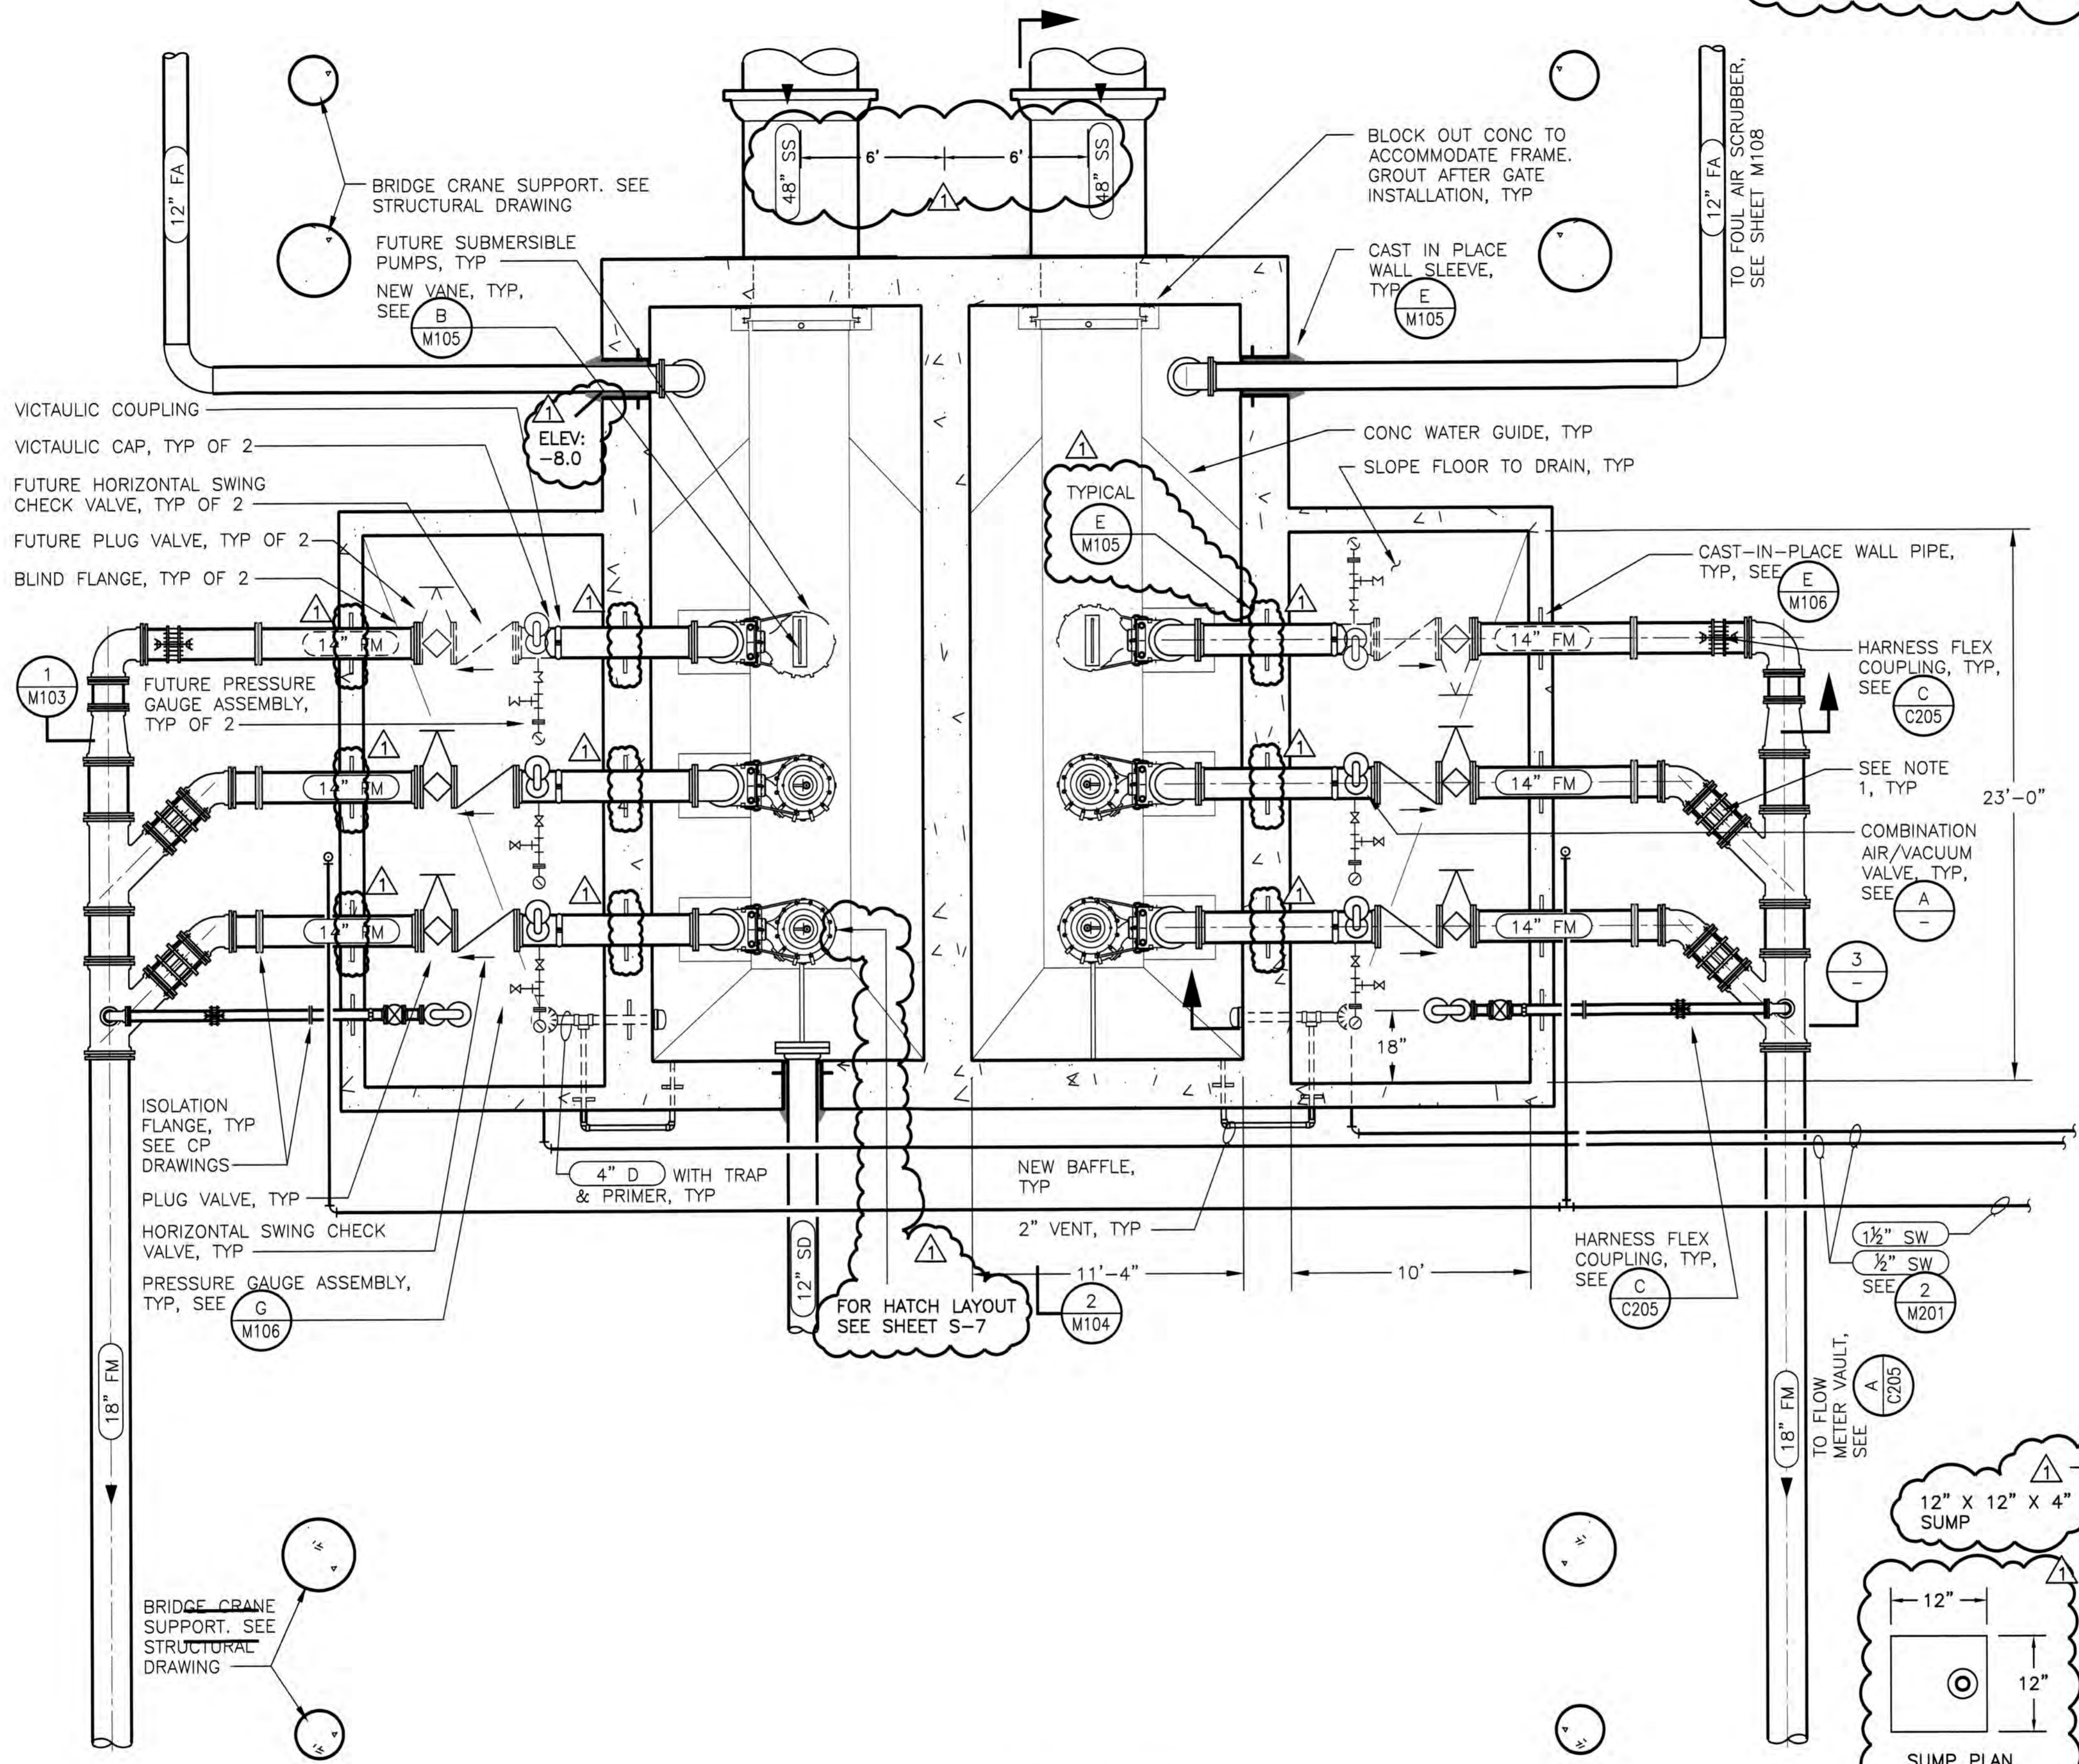

NOTE:
1. PROVIDE FLEXIBLE COUPLING WITH FOUR (4) 3/4\"/>

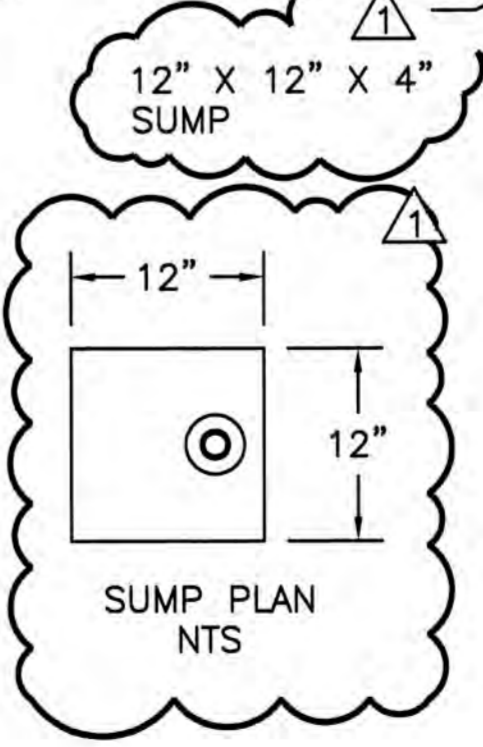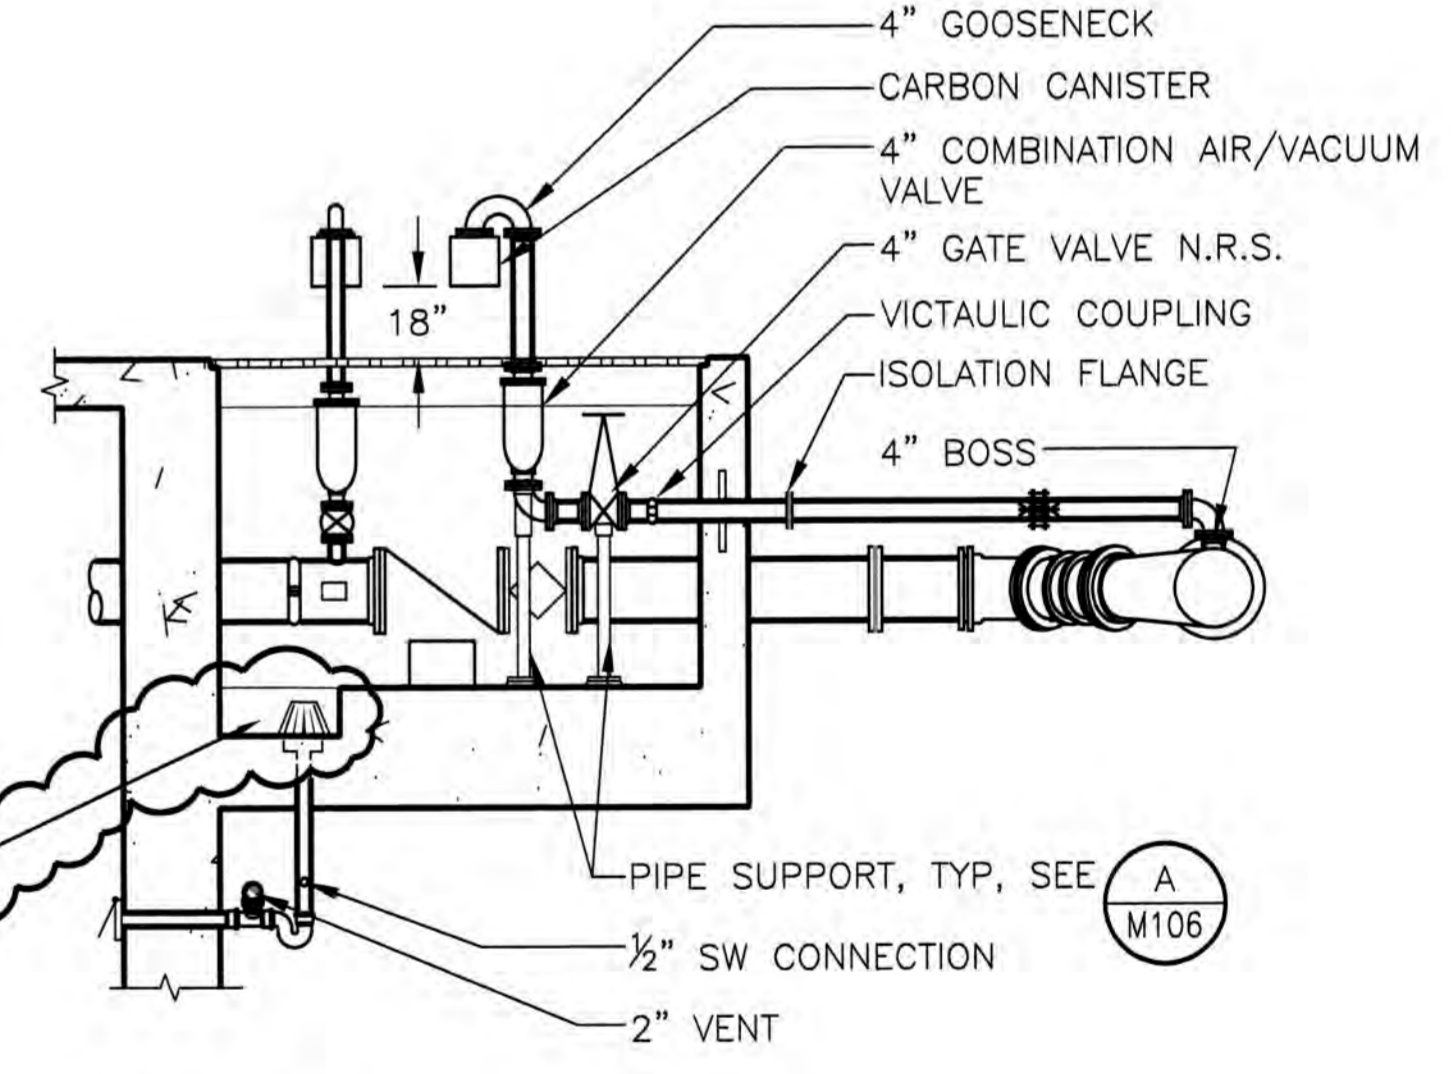

PUMP STATION - BOTTOM
PLAN
SCALE: 1/4"=1'-0"

RECORD DRAWINGS
14-Mile Slough Pump Station Upgrades

PUMP STATION BOTTOM PLAN		DEPARTMENT OF MUNICIPAL UTILITIES CITY OF STOCKTON, CALIFORNIA	
SCALE: AS SHOWN	DESIGNED BY: RCB	SHEET No. M101	
DRAWN BY: DTD	CHECKED BY: GDH	45 of 89 SHEETS	
RECORD Dwg.:		PROJECT No. 293-00-05-01	

Underground Service Alert
TWO DAYS BEFORE YOU DIG
Call TOLL FREE: 1-800-642-2444

BAR IS ONE INCH ON ORIGINAL DRAWING
IF NOT ONE INCH ON THIS SHEET, ADJUST SCALES ACCORDINGLY


REFER TO BID SET FOR SIGNATURE

REV. No.	DISCRPTION	DATE	BY	Apr'd By
1	RECORD DRAWINGS	6/08	CLB	PDF

WEST YOST ASSOCIATES
1260 Lake Boulevard
Suite 240
Davis, California 95616
(530) 756-5905
FAX (530) 756-5991

N:\Clients\293 Sponea\00-05-01 14-MSPS Upgrades\CAD\Design\Assemblies\293-0501M101-4.dwg 11-13-08 11:17:18 AM greimer

N:\Clients\293 Sponosa\00-05-01 14-MSPS Upgrades\CAD\Design\Submittals\293-0501M101-4.dwg 11-13-08 11:32:59 AM dreimer

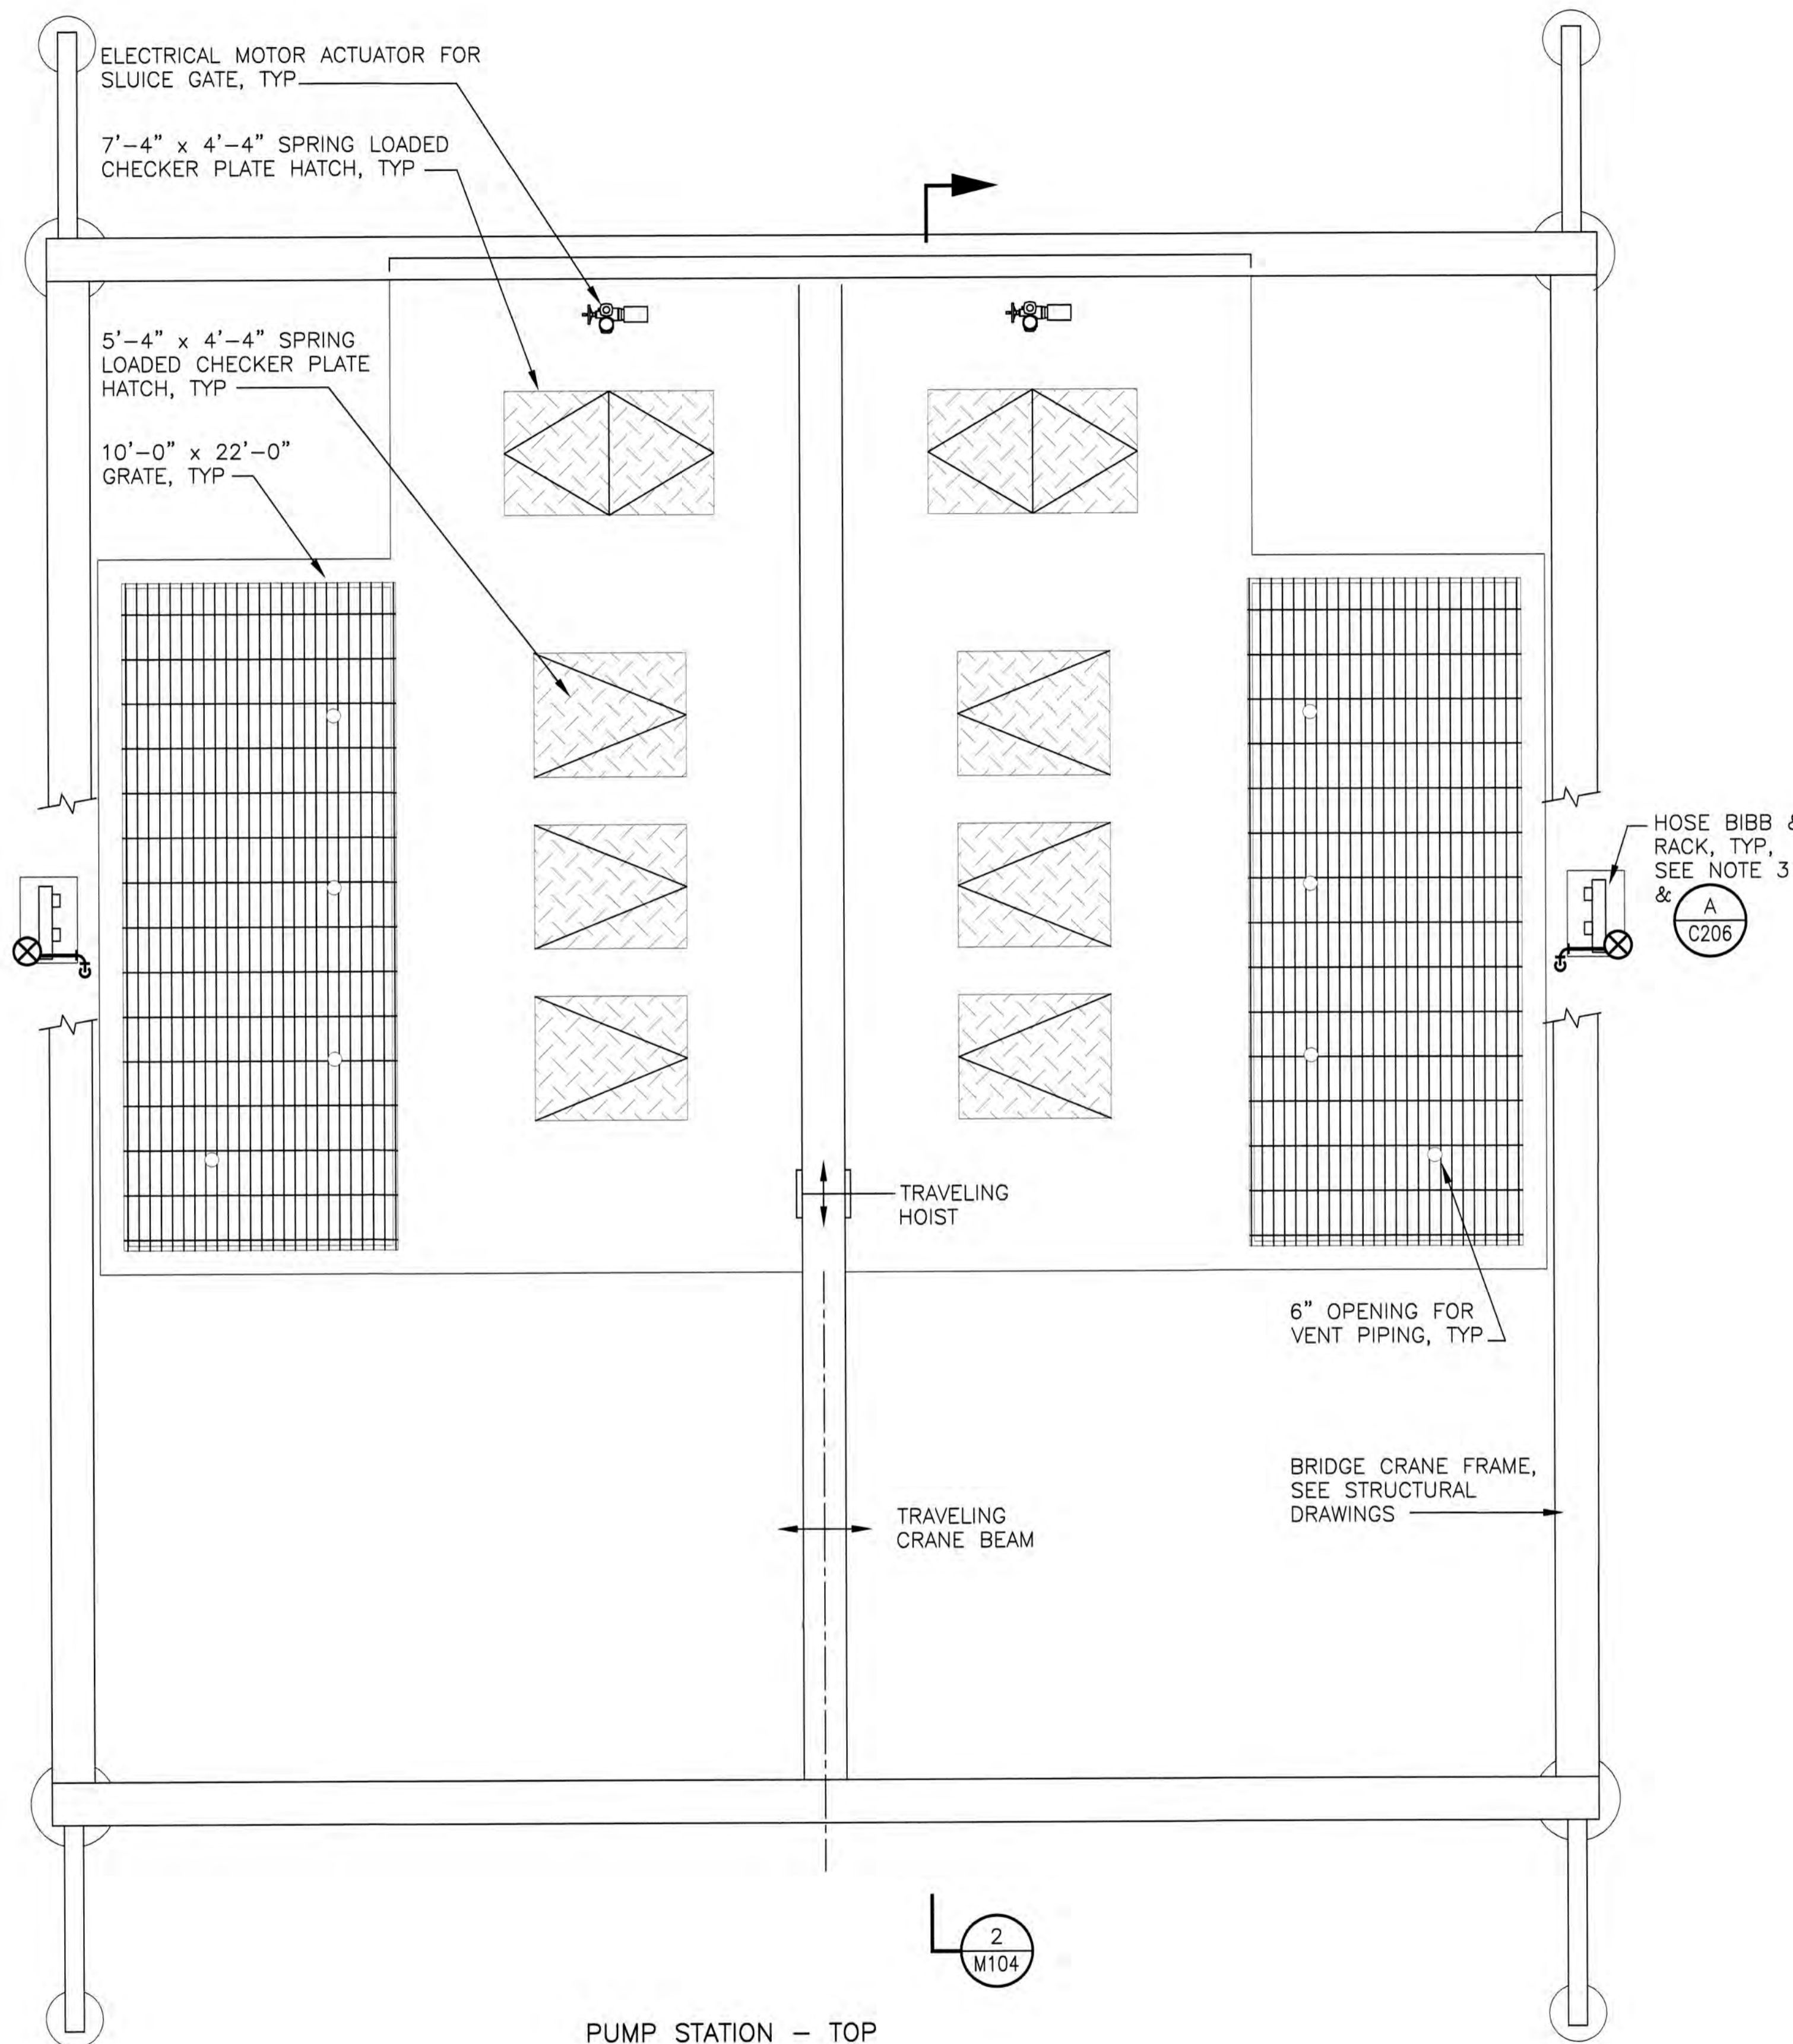

- NOTES:
1. OPENINGS IN GRATINGS SHALL BE CENTERED ON SEAMS BETWEEN GRATING PANELS
 2. VENT PIPING AND CARBON CANISTERS NOT SHOWN FOR CLARITY
 3. HOSE BIBB & RACK SHALL BE CENTERED ON VALVE VAULT AND FACE AWAY FROM STATION. CONCRETE PAD FOR HOSE RACK SHALL BE ADJACENT TO VALVE VAULT CONCRETE

PUMP STATION - TOP

PLAN

SCALE: 1/4"=1'-0"

RECORD DRAWINGS		
14-Mile Slough Pump Station Upgrades		
PUMP STATION TOP PLAN		
DEPARTMENT OF MUNICIPAL UTILITIES CITY OF STOCKTON, CALIFORNIA		
SCALE: AS SHOWN		SHEET No.
DESIGNED BY: RCB		M102
DRAWN BY: DTD		46 of 89 SHEETS
CHECKED BY: GDH		PROJECT No. 293-00-05-01
RECORD Dwg.:		

Underground Service Alert

TWO DAYS BEFORE YOU DIG

Call TOLL FREE: 1-800-642-2444

BAR IS ONE INCH ON ORIGINAL DRAWING

IF NOT ONE INCH ON THIS SHEET, ADJUST SCALES ACCORDINGLY


REFER TO BID SET FOR SIGNATURE

REGISTERED PROFESSIONAL ENGINEER
No. C65879
STATE OF CALIFORNIA


REV. No.	DISCRPTION	DATE	BY	Apr'v'd By
1				
2				
3				
4				
5				
6				
7				

WEST YOST ASSOCIATES

1260 Lake Boulevard
Suite 240
Davis, California 95616
(530) 756-5905
FAX (530) 756-5991

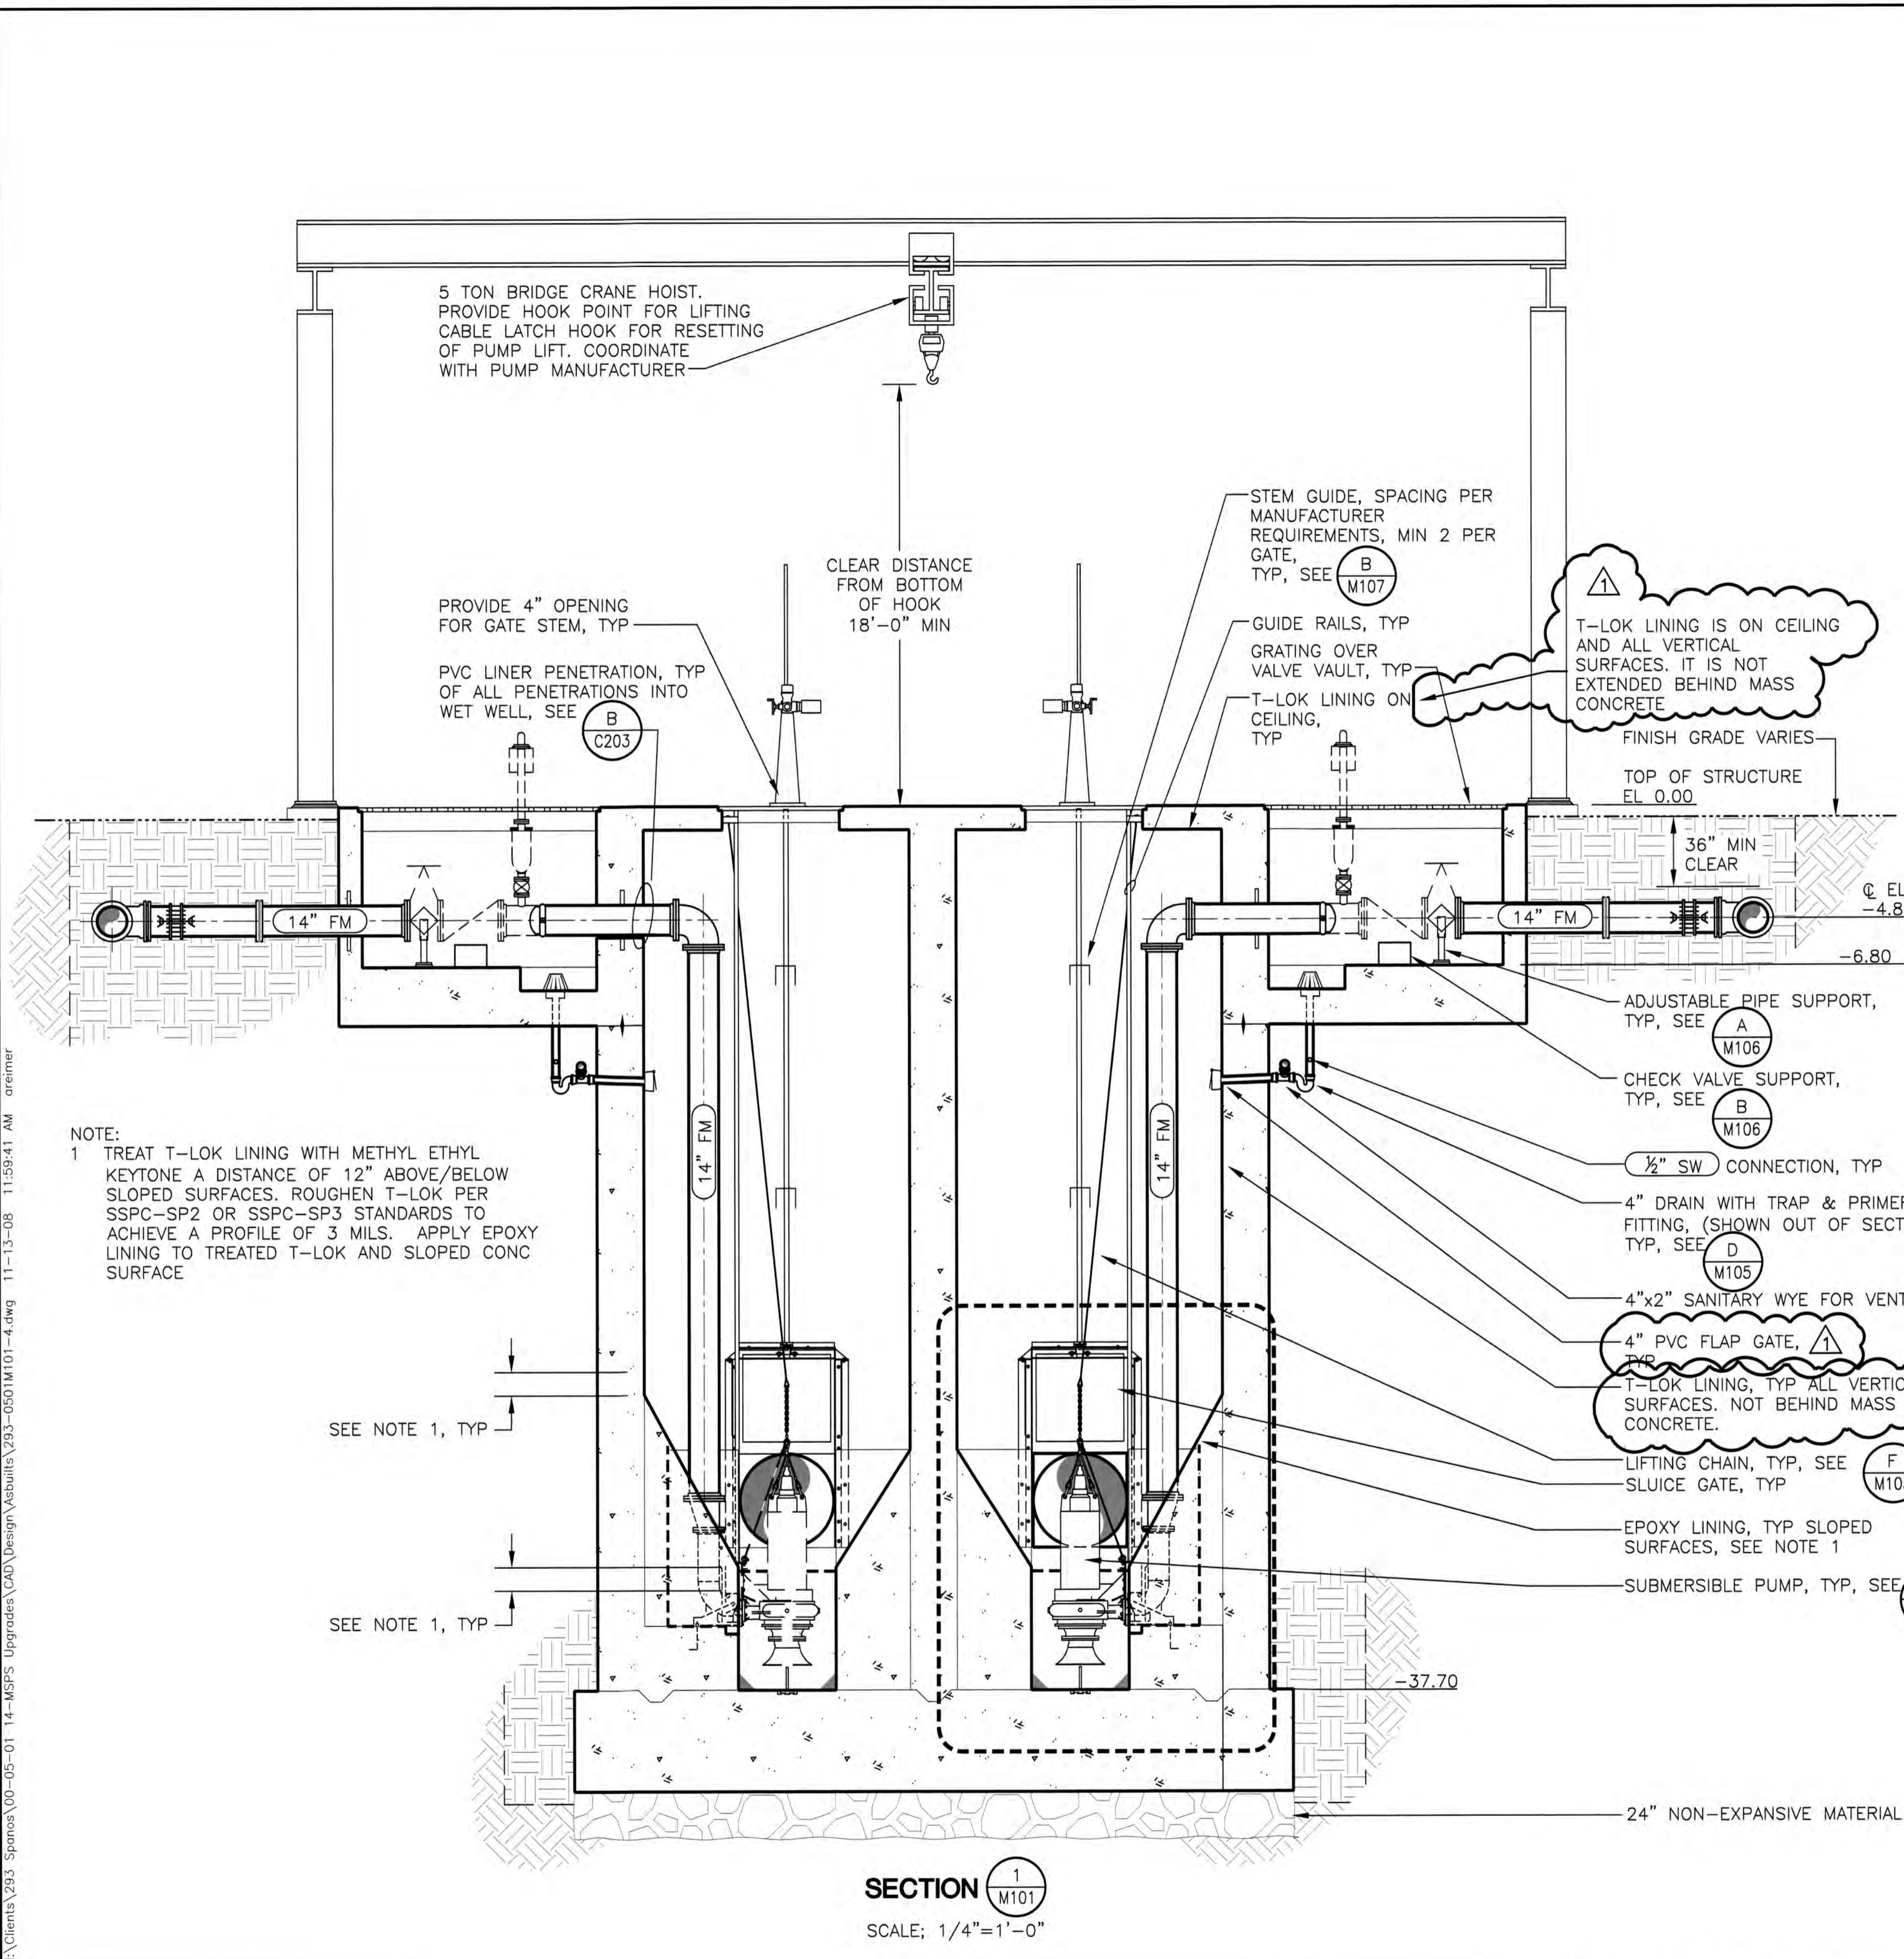

SECTION 1
M101
SCALE: 1/4"=1'-0"

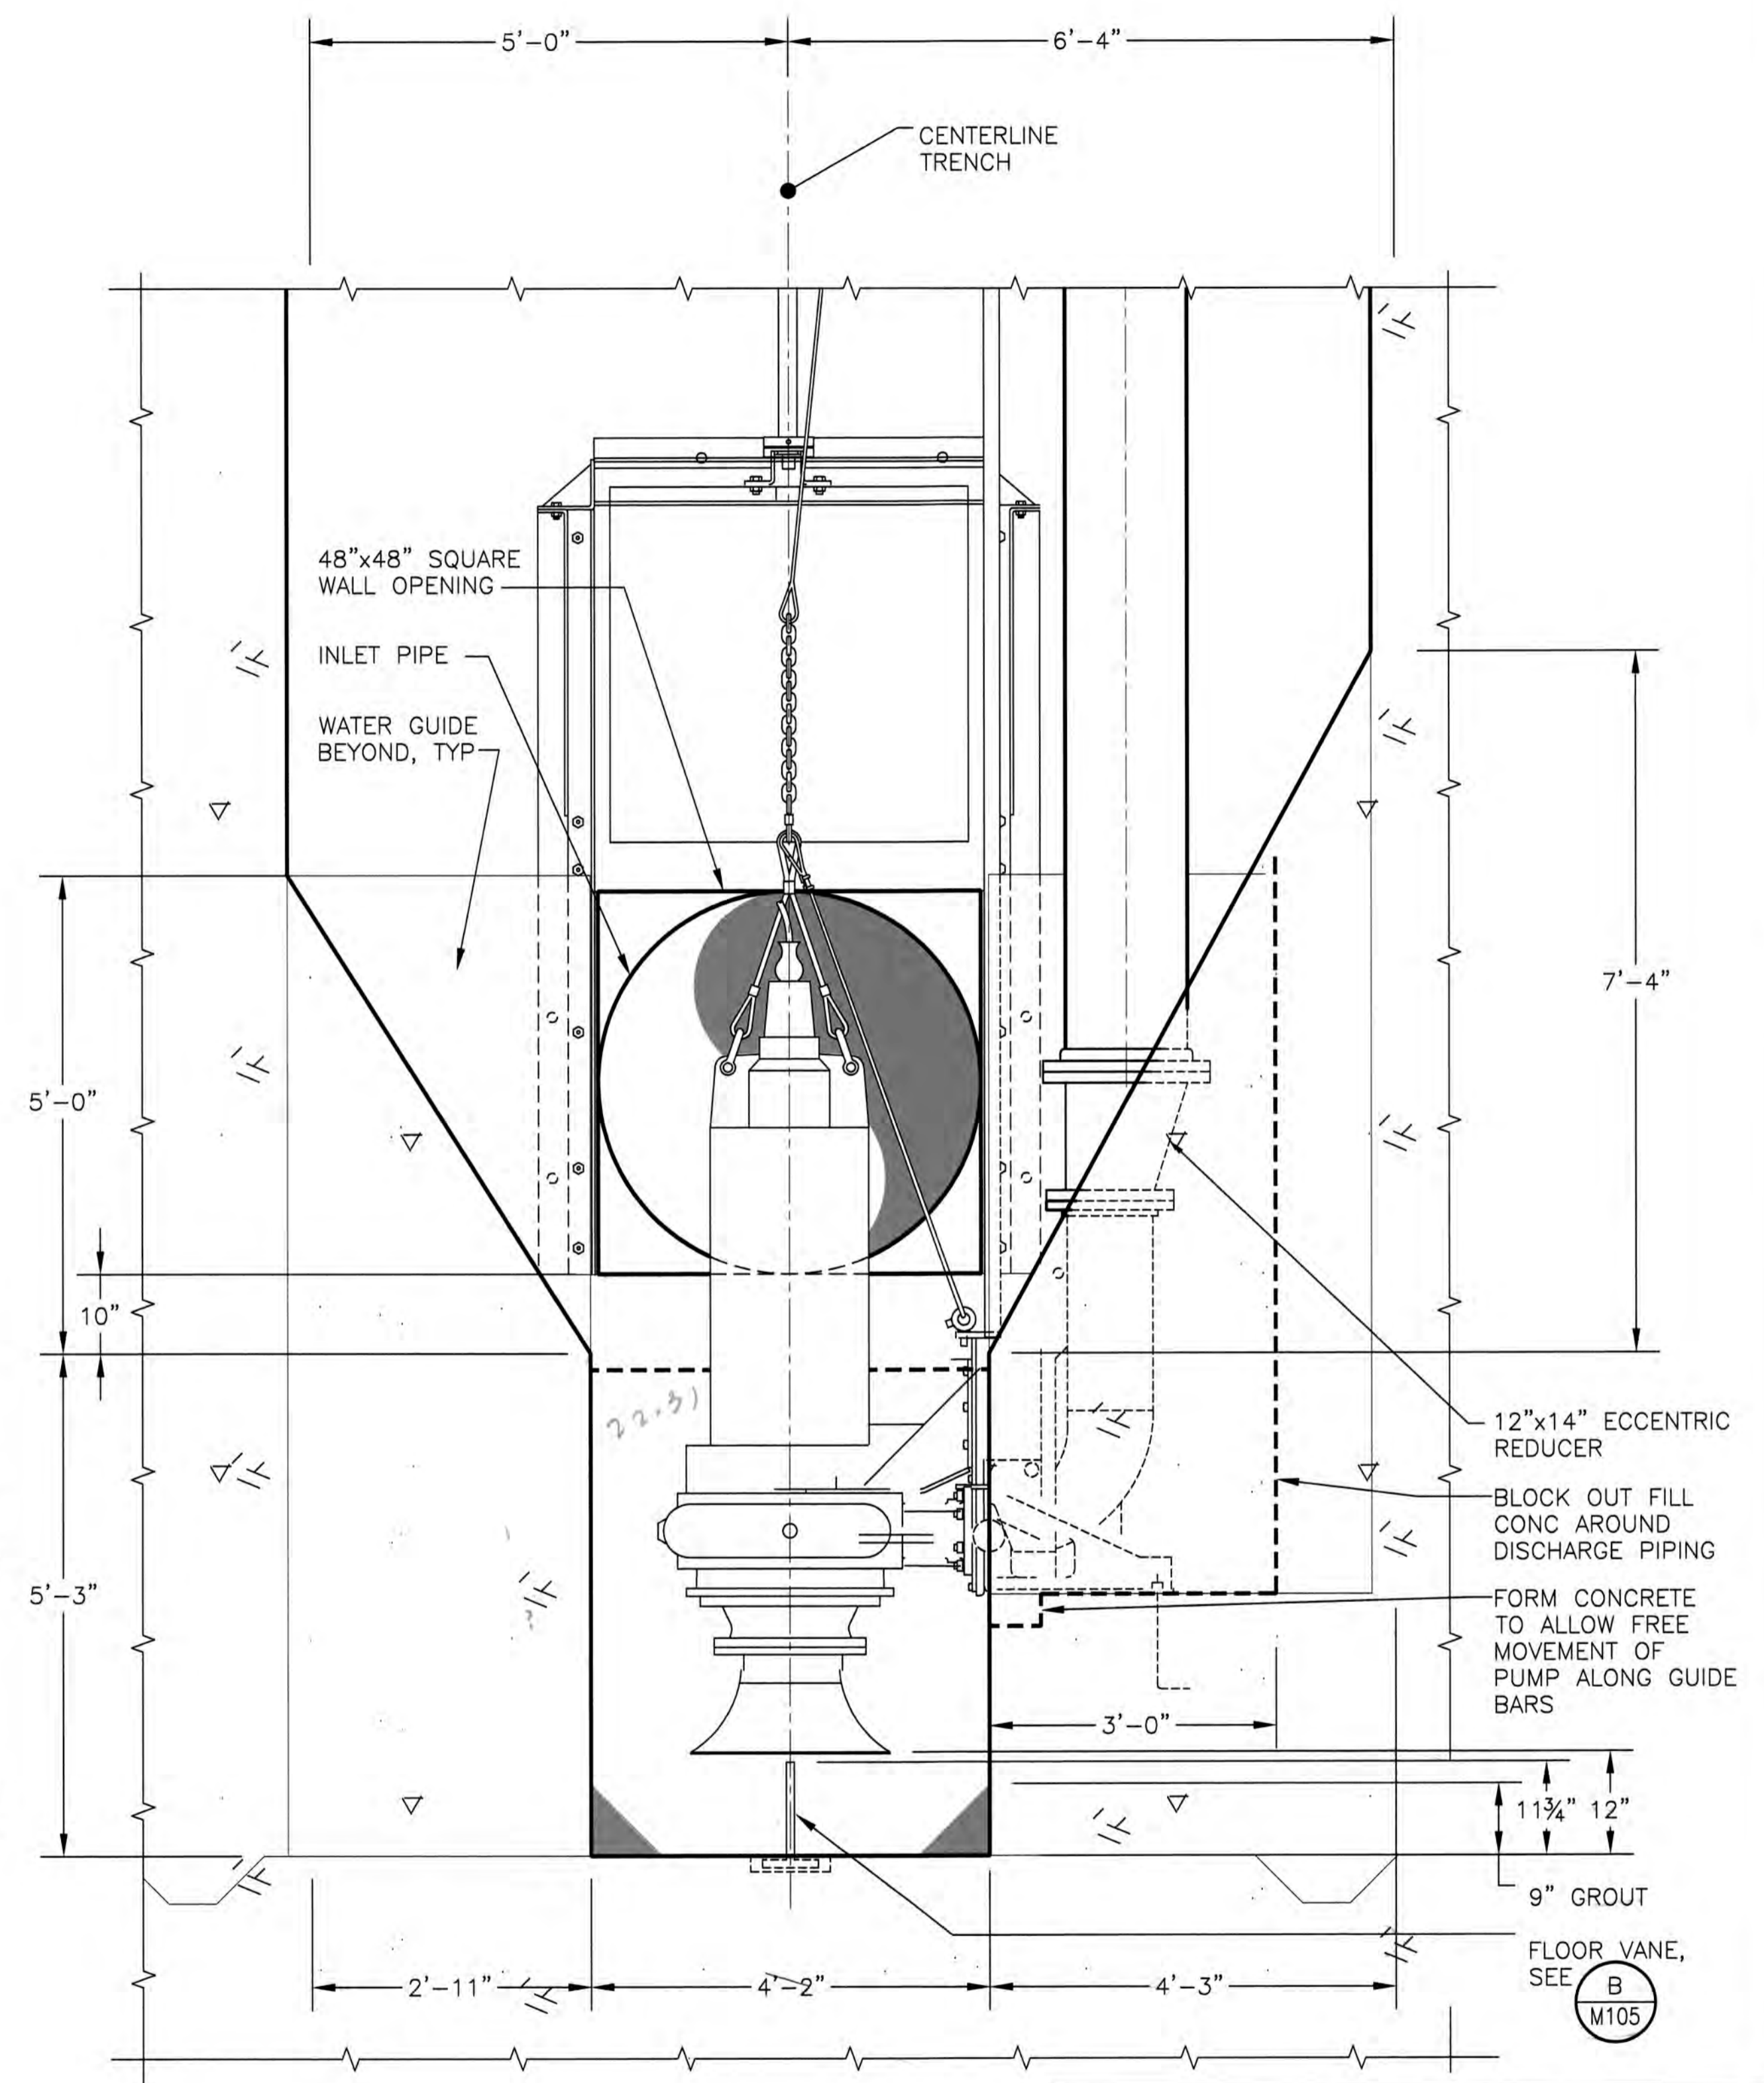

DETAIL A
SCALE: 3/4"=1'-0"

NOTE:
1 TREAT T-LOK LINING WITH METHYL ETHYL KEYTONE A DISTANCE OF 12" ABOVE/BELOW SLOPED SURFACES. ROUGHEN T-LOK PER SSPC-SP2 OR SSPC-SP3 STANDARDS TO ACHIEVE A PROFILE OF 3 MILS. APPLY EPOXY LINING TO TREATED T-LOK AND SLOPED CONC SURFACE

N:\Clients\293_Sponos\00-05-01_14-MSPS_Upgrade\CAD\Design\Asbults\293-050\M101-4.dwg 11-13-08 11:59:41 AM areimer

Underground Service Alert

TWO DAYS BEFORE YOU DIG

Call TOLL FREE: 1-800-642-2444

BAR IS ONE INCH ON ORIGINAL DRAWING

IF NOT ONE INCH ON THIS SHEET, ADJUST SCALES ACCORDINGLY

REFER TO BID SET FOR SIGNATURE

REV. No.	DISCRPTION	DATE	BY	App'd By
1	RECORD DRAWINGS	6/08	CLB	PDF
2				
3				
4				
5				
6				
7				

WEST YOST ASSOCIATES

1260 Lake Boulevard
Suite 240
Davis, California 95616
(530) 756-5905
FAX (530) 756-5991

RECORD DRAWINGS


14-Mile Slough Pump Station Upgrades

PUMP STATION SECTIONS 1


DEPARTMENT OF MUNICIPAL UTILITIES
CITY OF STOCKTON, CALIFORNIA

SCALE: AS SHOWN	SHEET No.
DESIGNED BY: RCB	M103
DRAWN BY: DTD	47 of 89 SHEETS
CHECKED BY: GDH	PROJECT No. 293-00-05-01
RECORD Dwg.:	


N:\Clients\293 - Sprints\00-05-01 14-MSPS Upgrades\CAD\Design\Submittals\293-0501M101-4.dwg 11-13-08 12:00:01 PM areimer

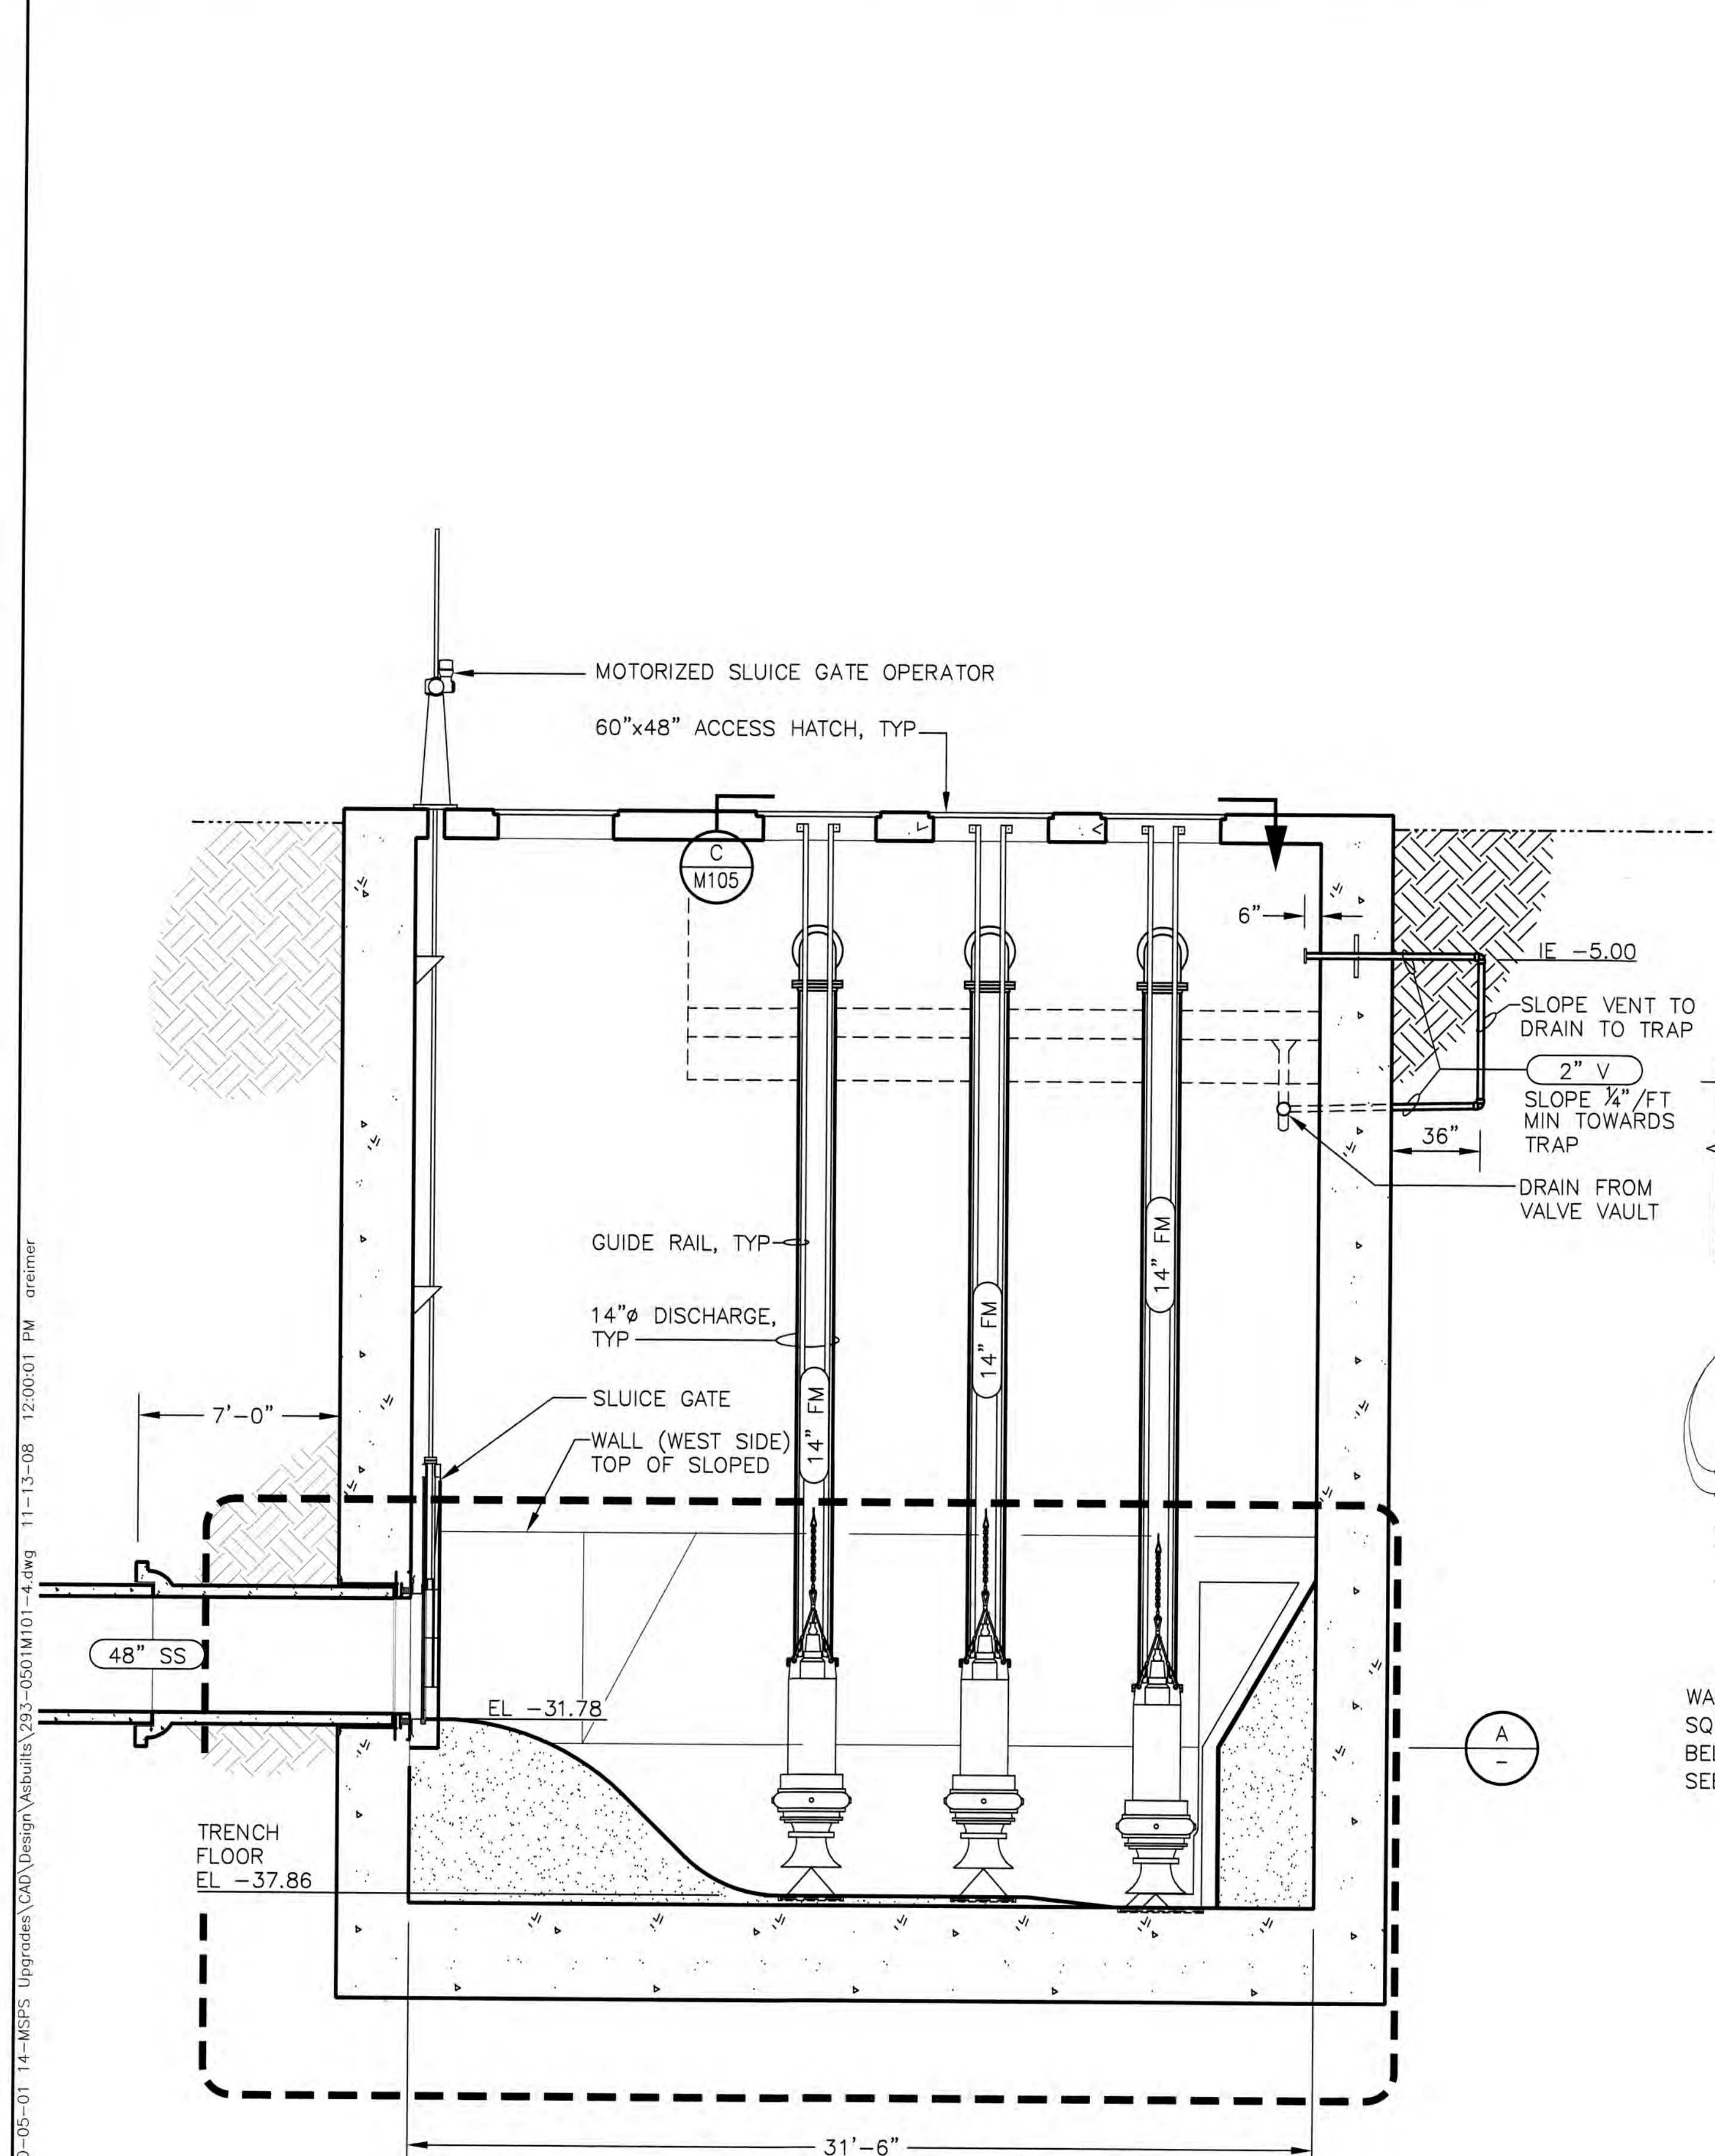

SECTION 2
M101
SCALE: 1/4"=1'-0"

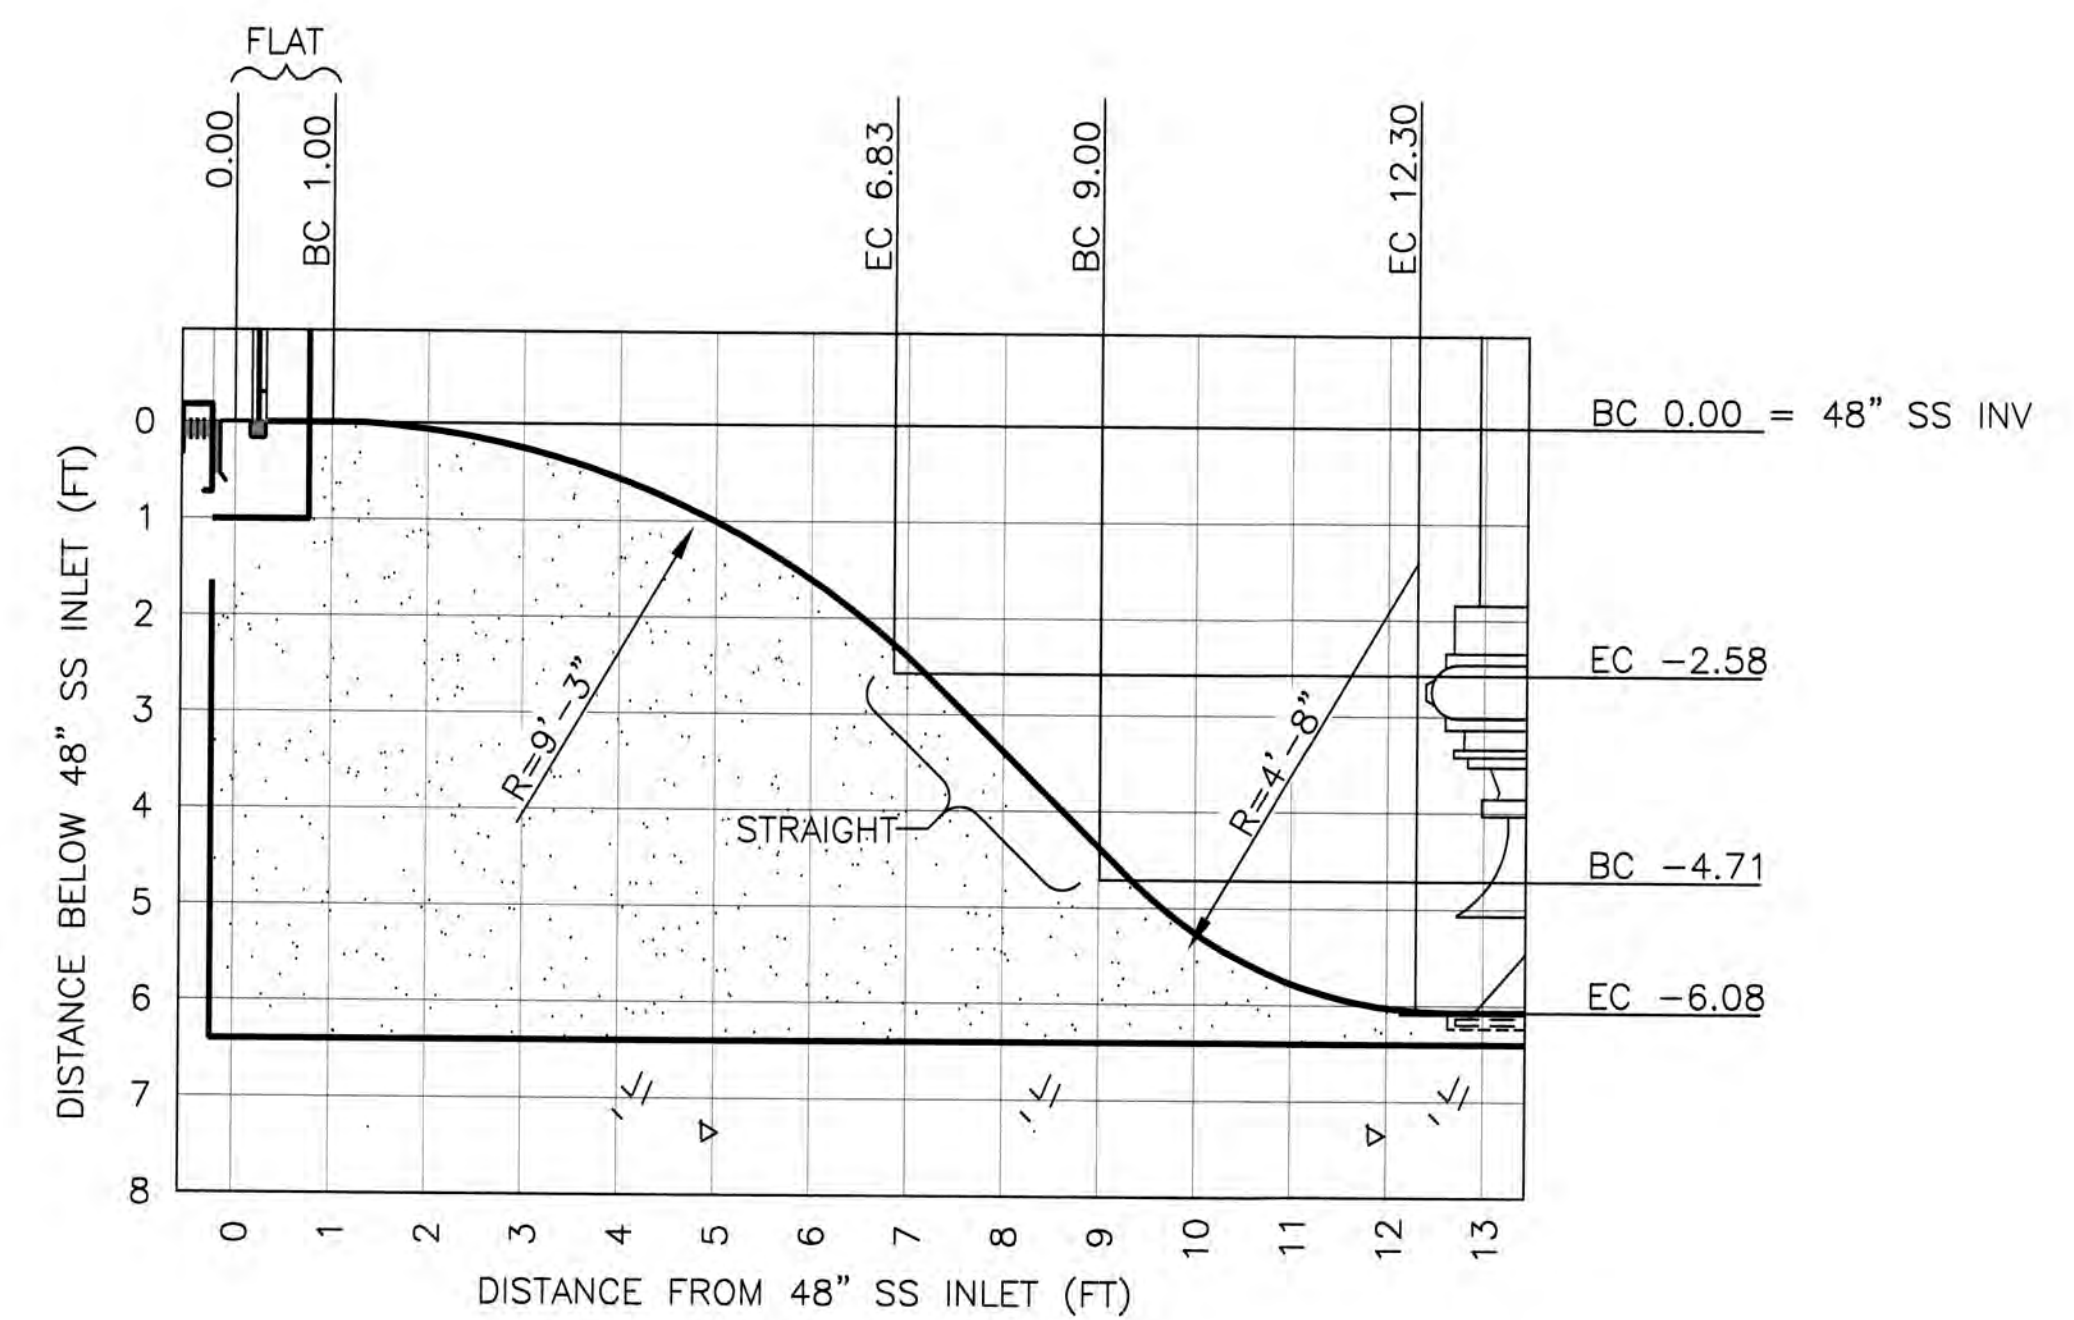

DETAIL B
SCALE: 1/2"=1'-0"

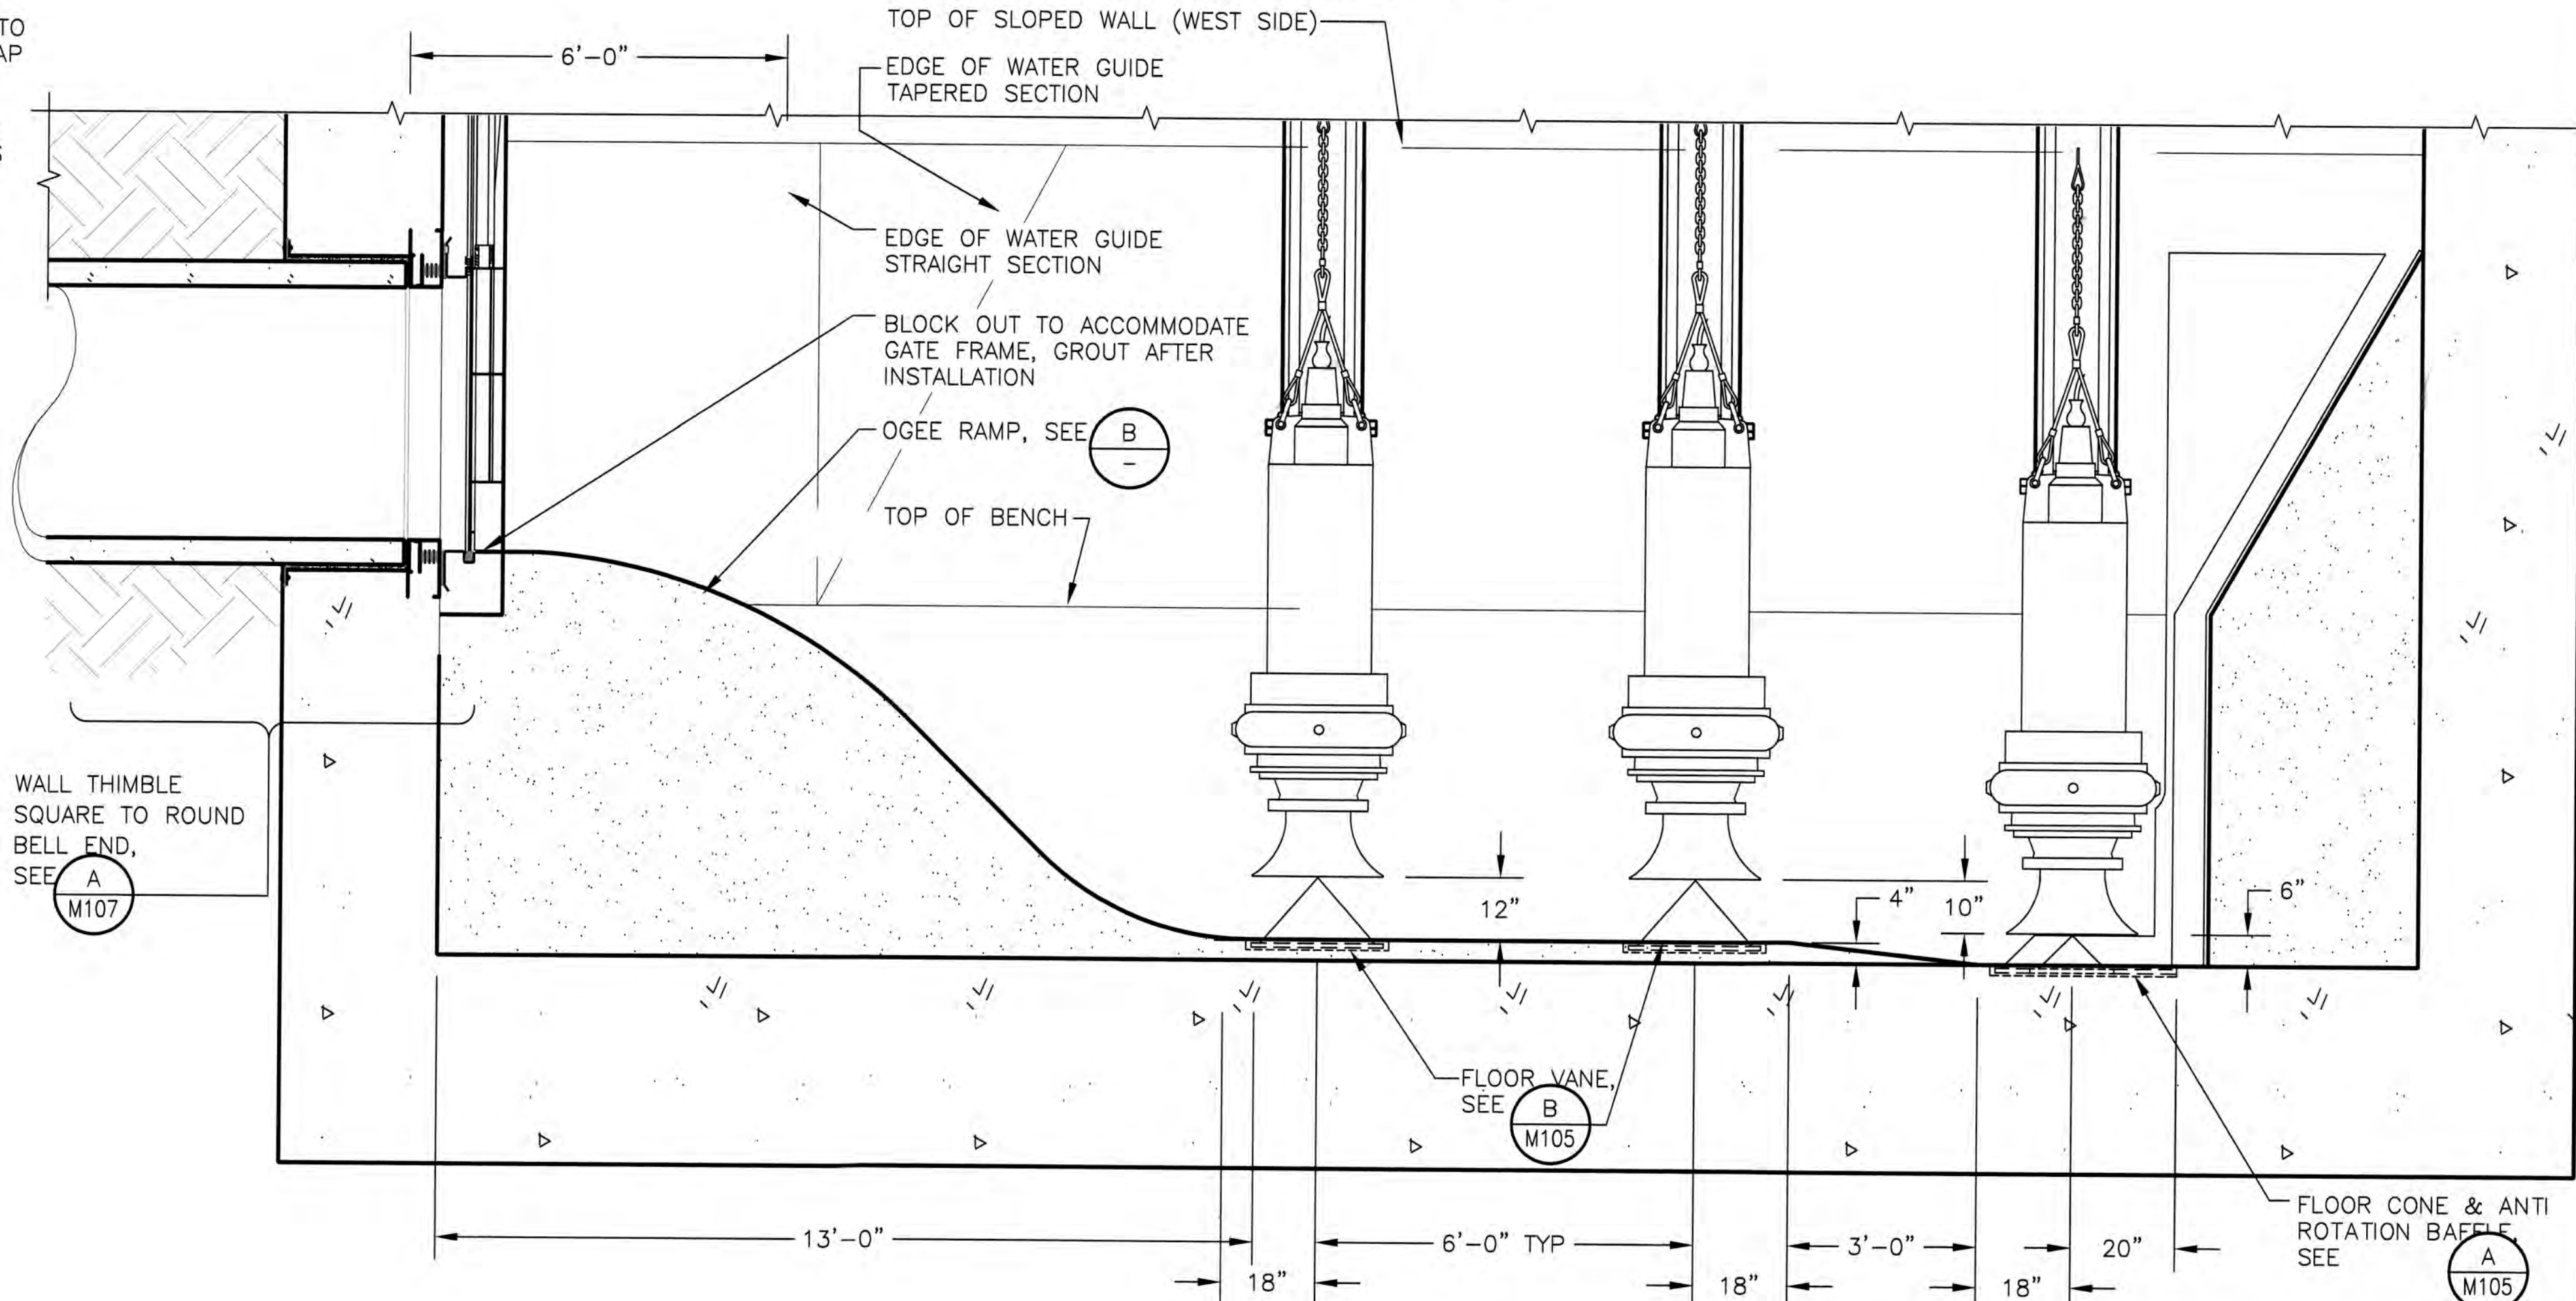

DETAIL A
SCALE: 1/2"=1'-0"

RECORD DRAWINGS
14-Mile Slough Pump Station Upgrades

PUMP STATION SECTIONS 2

DEPARTMENT OF MUNICIPAL UTILITIES
CITY OF STOCKTON, CALIFORNIA

SCALE: AS SHOWN	SHEET No.
DESIGNED BY: RCB	M104
DRAWN BY: DTD	4R of 89 SHEETS
CHECKED BY: GDH	PROJECT No. 293-00-05-01
RECORD Dwg.:	

Underground Service Alert

TWO DAYS BEFORE YOU DIG

Call TOLL FREE: 1-800-642-2444

BAR IS ONE INCH ON ORIGINAL DRAWING

IF NOT ONE INCH ON THIS SHEET, ADJUST SCALES ACCORDINGLY


REFER TO BID SET FOR SIGNATURE

No. C65879

REV. No.	DISCRPTION	DATE	BY	Apr'd By
1				
2				
3				
4				
5				
6				
7				


WEST YOST ASSOCIATES

1260 Lake Boulevard
Suite 240
Davis, California 95616
(530) 756-5905
FAX (530) 756-5991

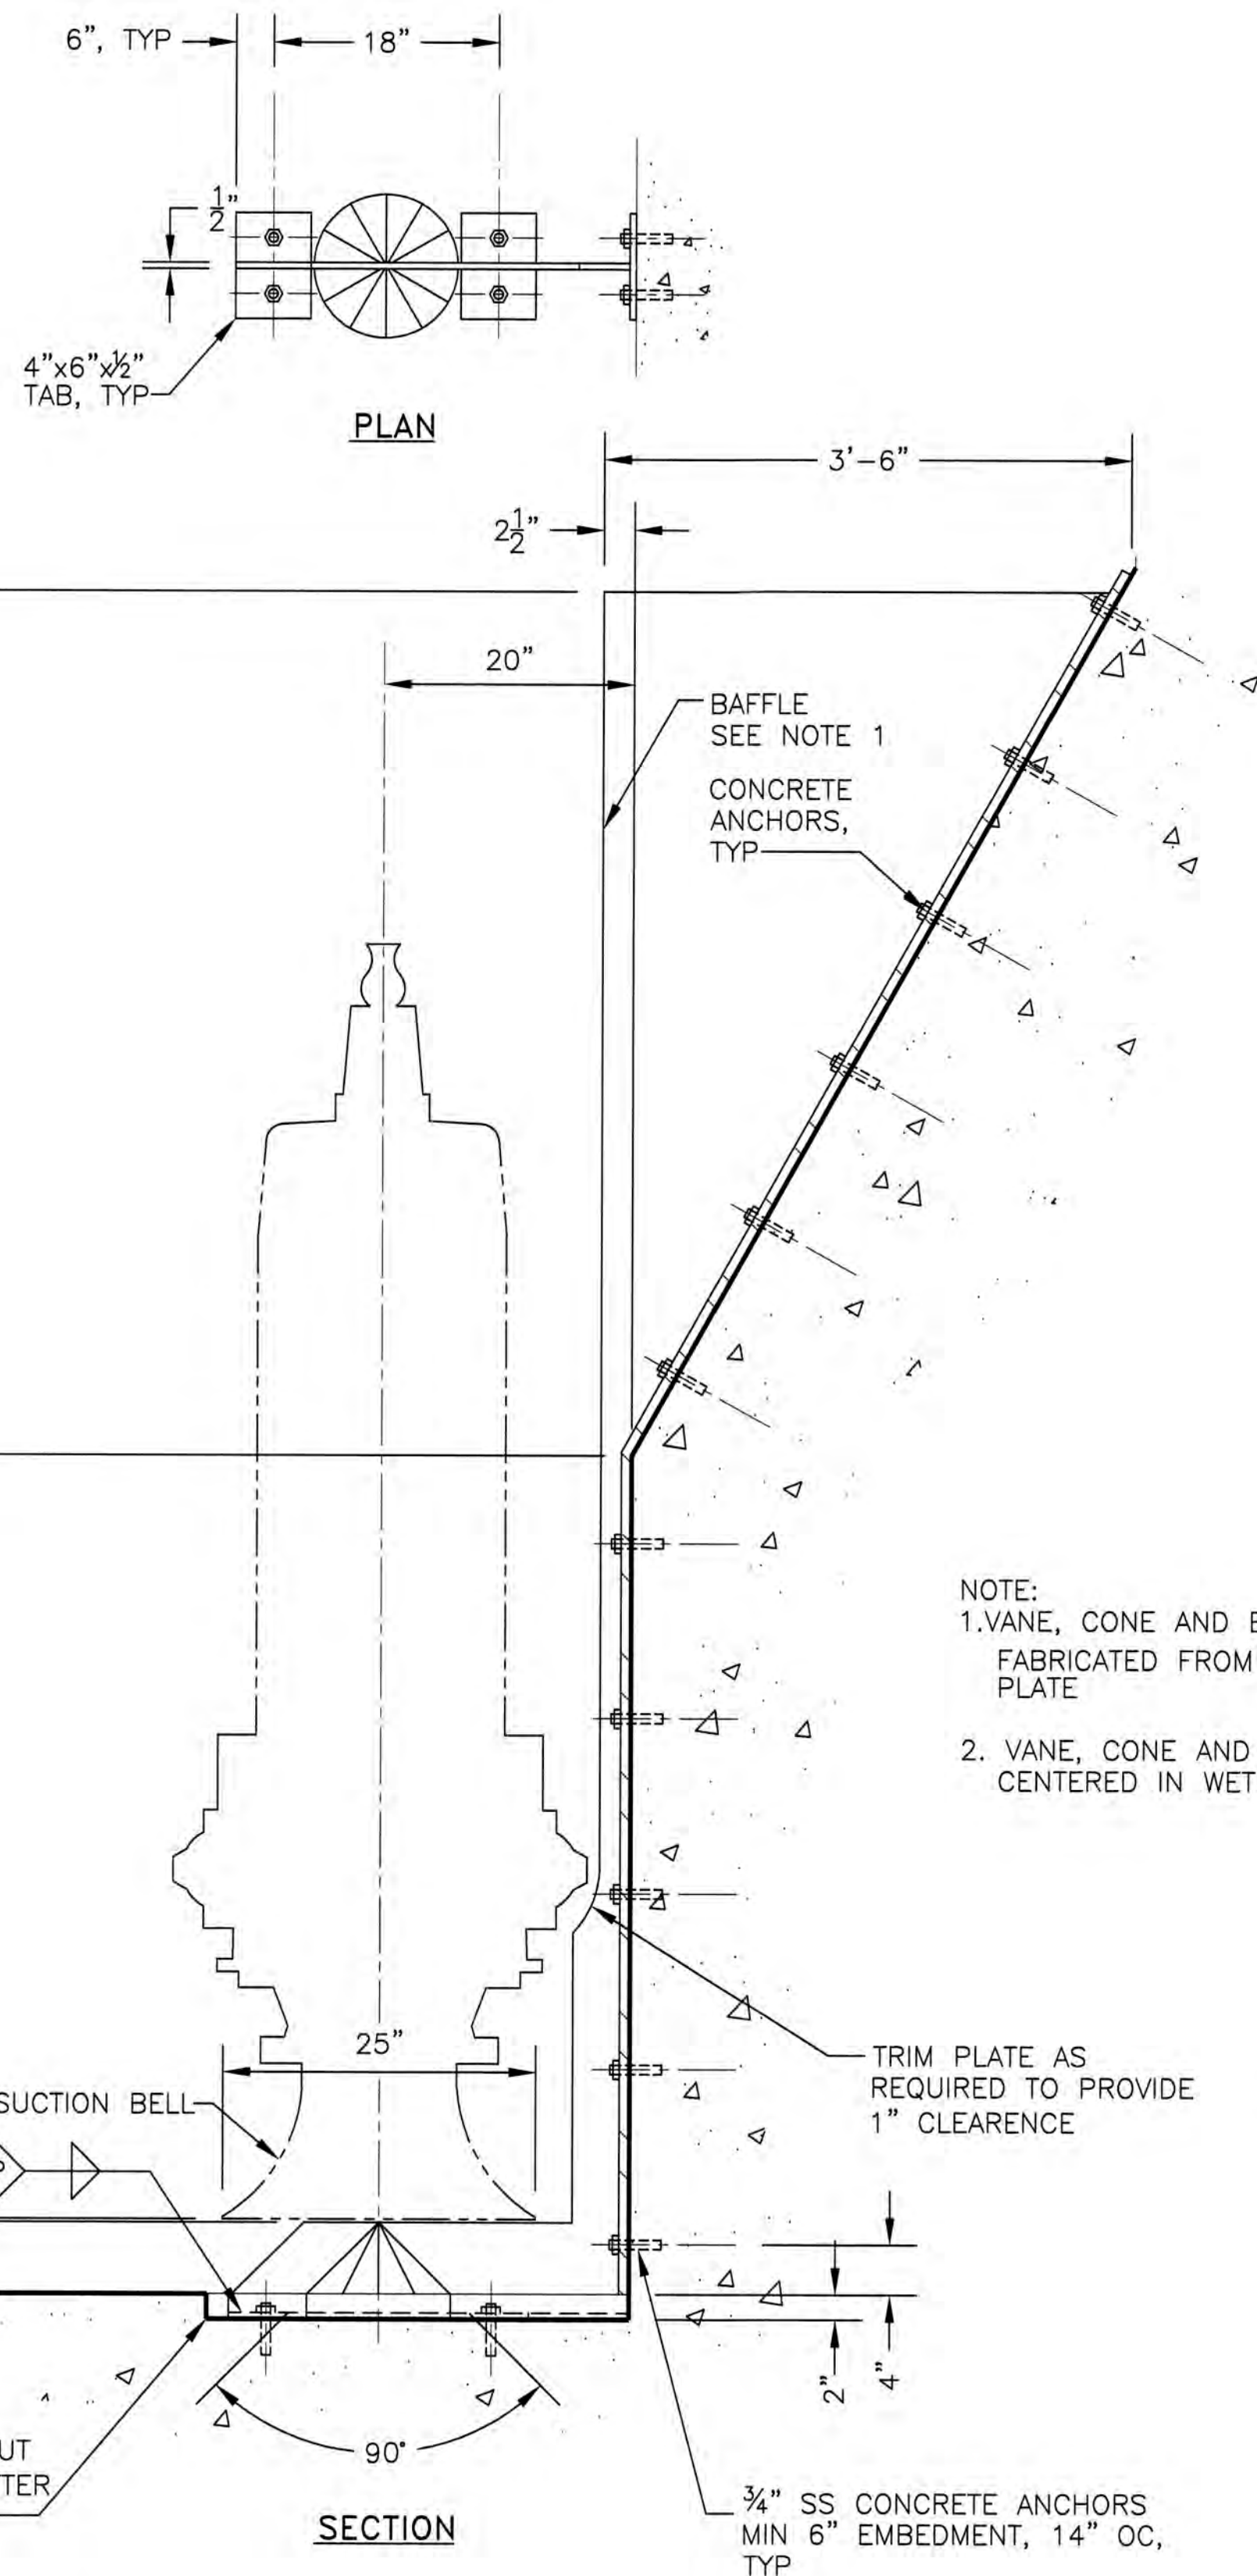


CONE & ANTI-ROTATION BAFFLE
 DETAIL (A) M104
 1"=1'-0"


NOTE:
 1. VANE, CONE AND BAFFLE SHALL BE FABRICATED FROM 1/2" TYPE 316 SS PLATE
 2. VANE, CONE AND BAFFLE SHALL BE CENTERED IN WET WELL TRENCH

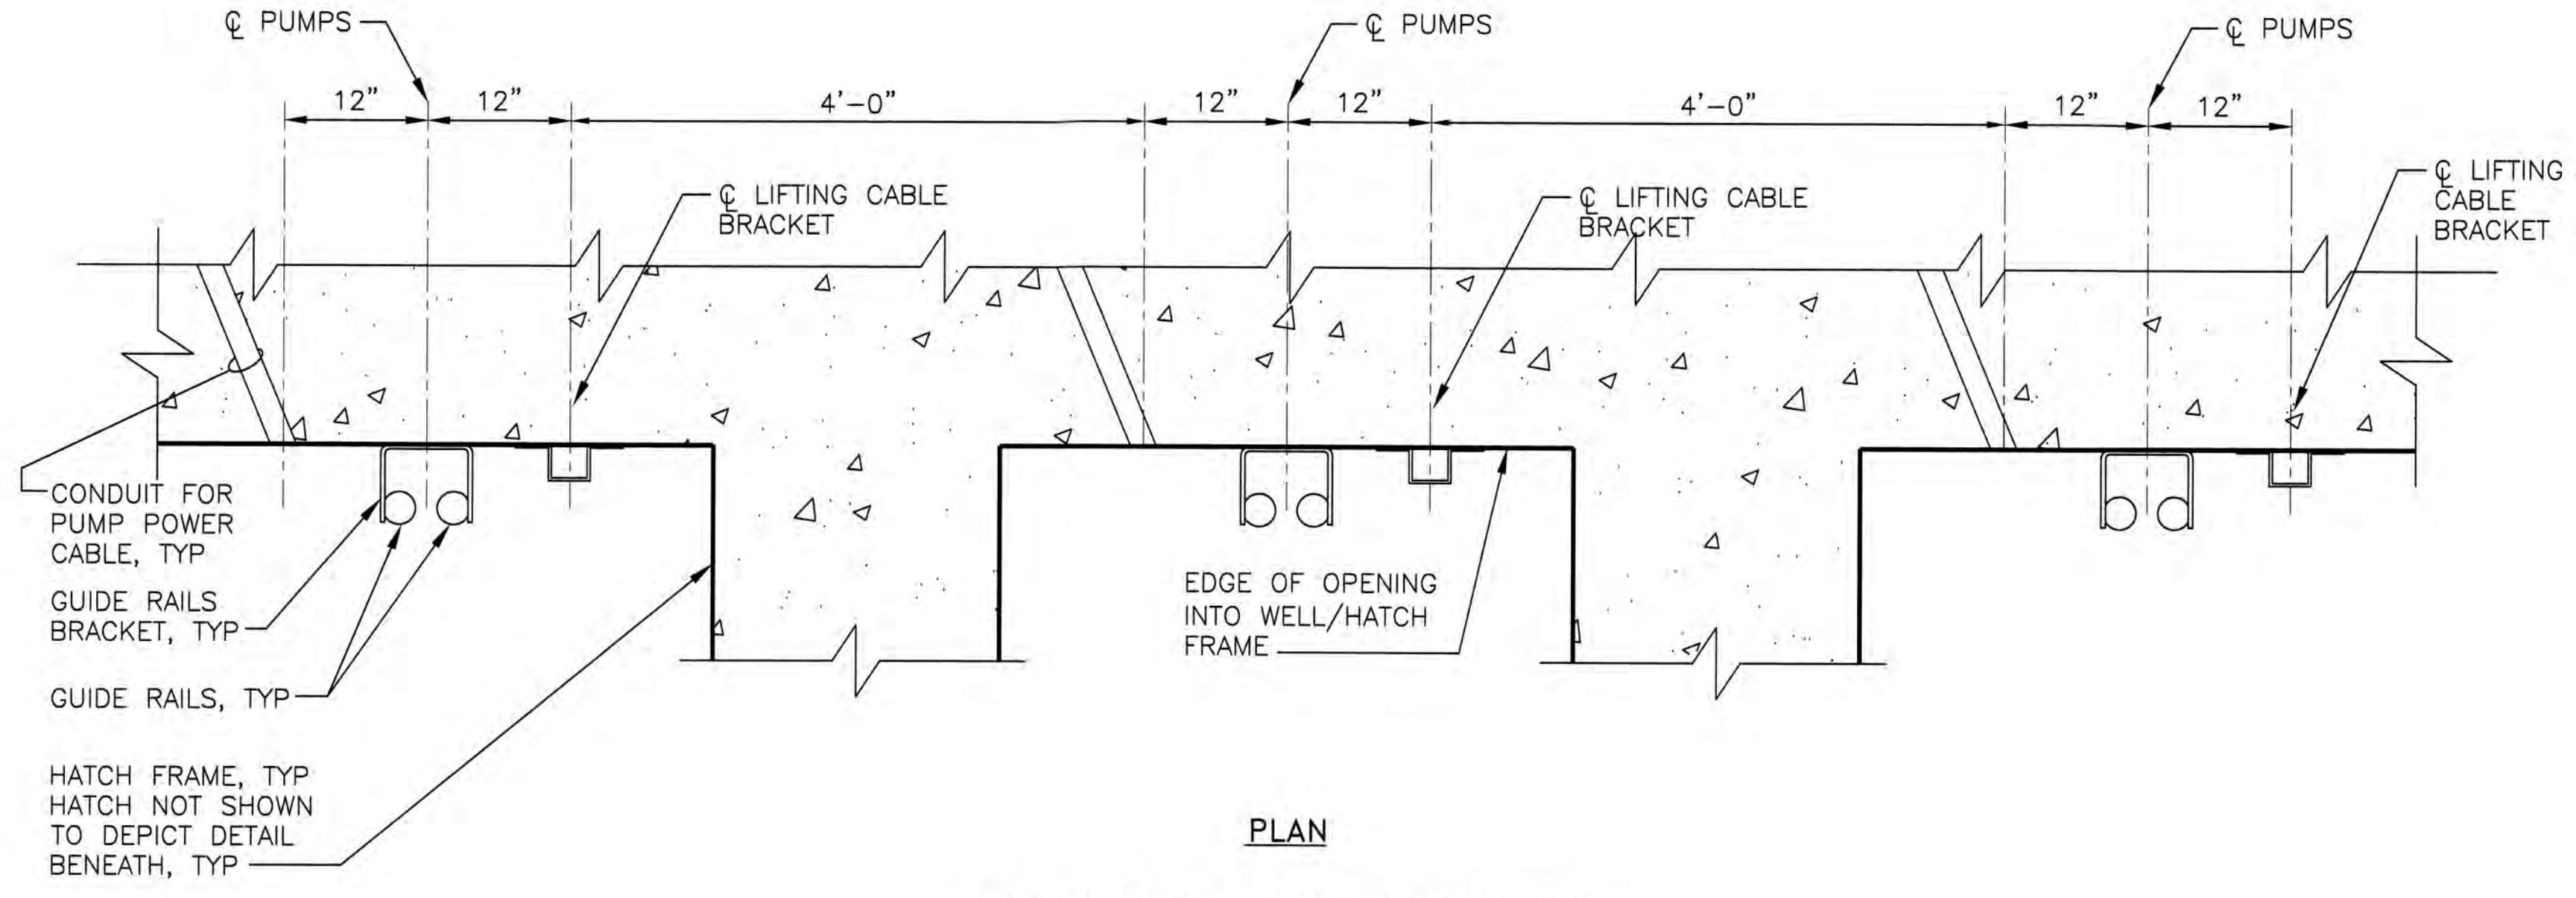


TYPICAL DETAIL @ ACCESS HATCHES
 DETAIL (C) M104
 1"=1'-0"

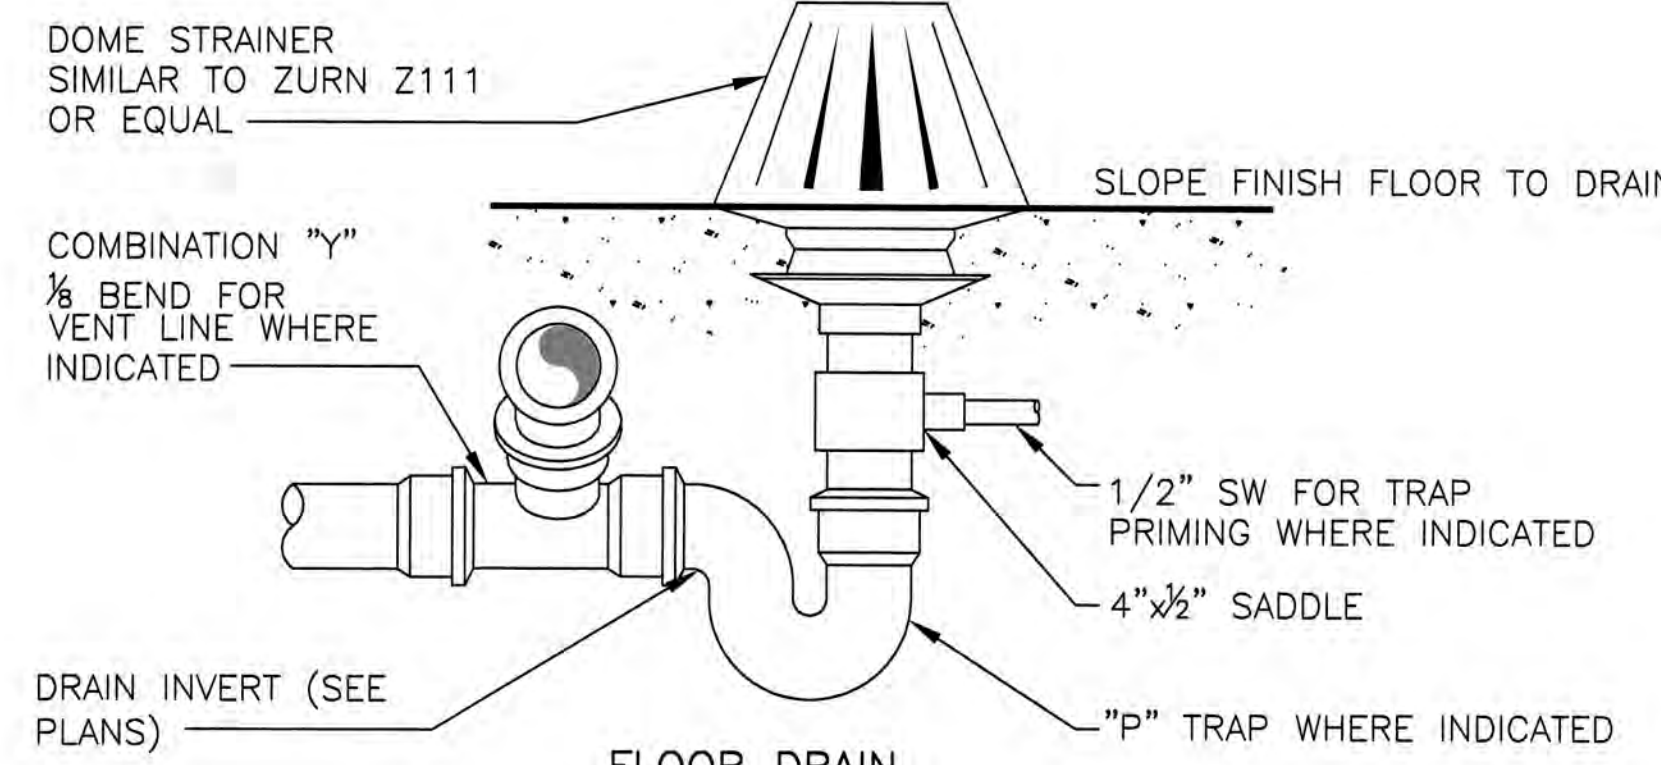


FLOOR DRAIN
 DETAIL (D) VAR
 SCALE: NONE

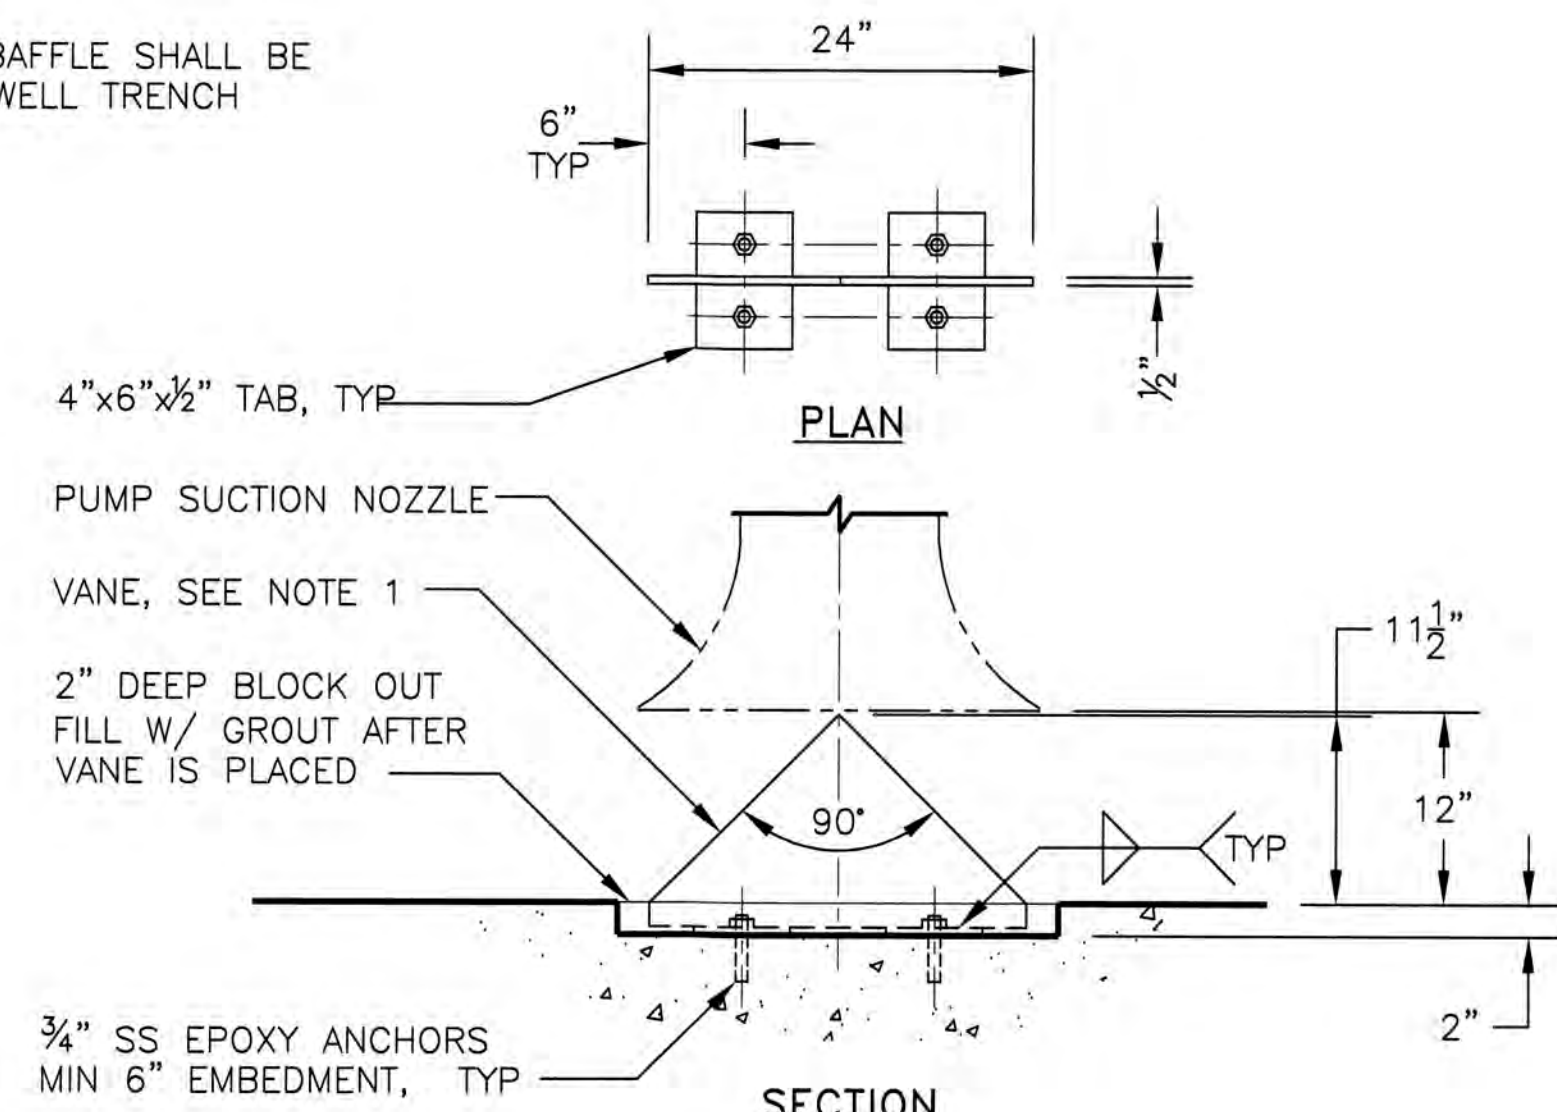

FLOOR VANE
 DETAIL (B) M104
 1"=1'-0"

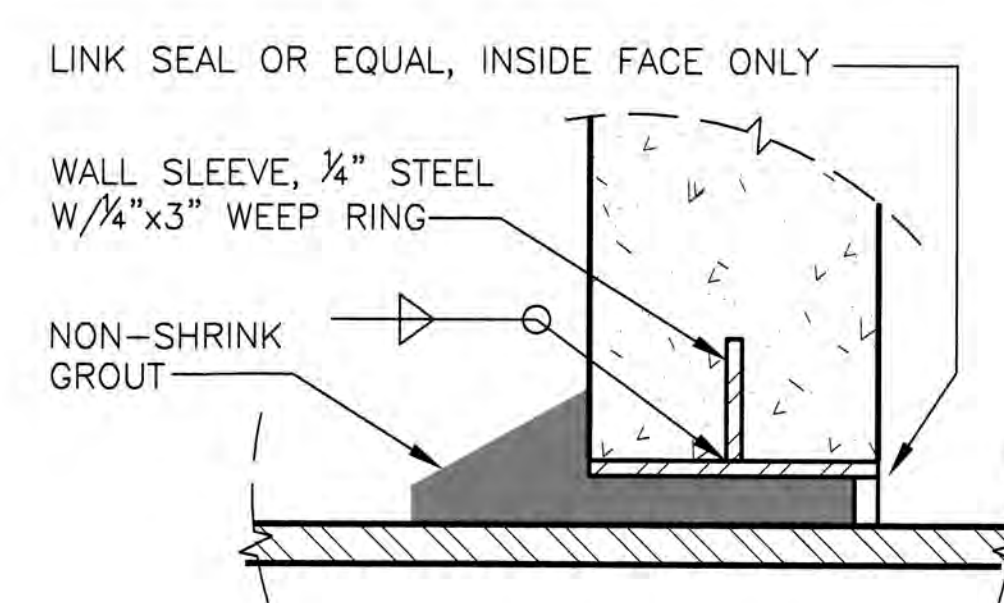

WALL SLEEVE
 DETAIL (E) -
 NOT TO SCALE

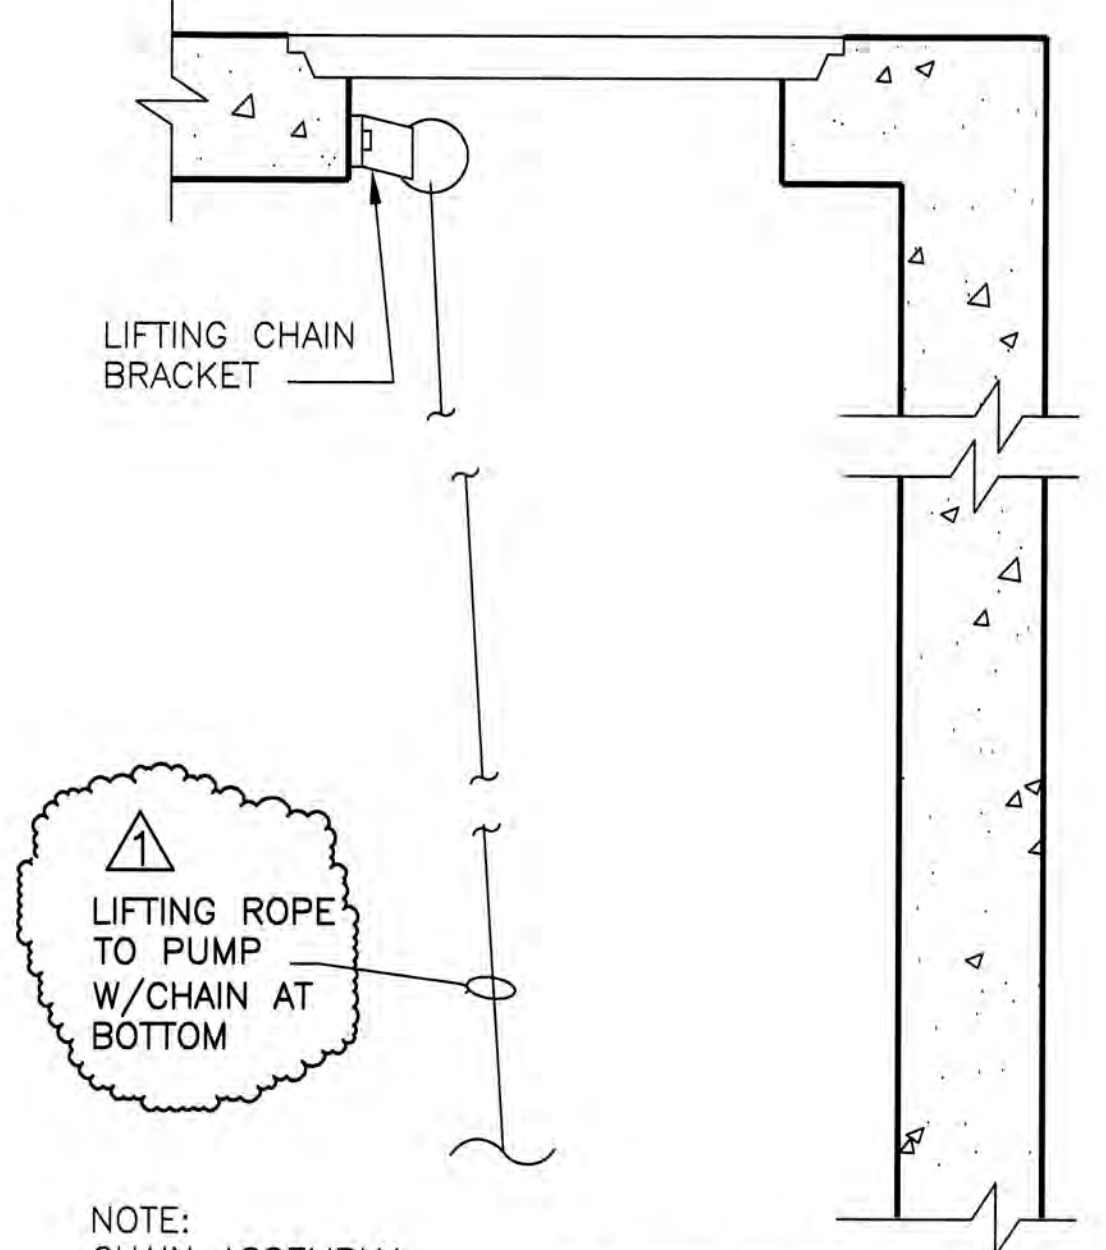

NOTE: CHAIN ASSEMBLY SHALL HAVE 5 TON CAPACITY, MIN
 LIFTING CHAIN
 DETAIL (F) M103
 SCALE: NONE

RECORD DRAWINGS		
14-Mile Slough Pump Station Upgrades		
PUMP STATION DETAILS 1		
DEPARTMENT OF MUNICIPAL UTILITIES CITY OF STOCKTON, CALIFORNIA		
SCALE: AS SHOWN	APPROVED BY: DATE: _____	SHEET No. M105
DESIGNED BY: RCB		49 of 89 SHEETS
DRAWN BY: DTD		PROJECT No. 293-00-05-01
CHECKED BY: GDH	ASSISTANT DIRECTOR, DEPT. OF MUNICIPAL UTILITIES	
RECORD Dwg.:		

Underground Service Alert

 TWO DAYS BEFORE YOU DIG
 Call TOLL FREE: 1-800-642-2444


REFER TO BID SET FOR SIGNATURE

REV. No.	DISCRPTION	DATE	BY	Apr'd By
1	RECORD DRAWINGS			
2				
3				
4				
5				
6				
7				

WEST YOST ASSOCIATES


 Consulting Engineers
 1260 Lake Boulevard
 Suite 240
 Davis, California 95616
 (530) 756-5905
 FAX (530) 756-5991

N:\Clients\293 - Spontes\00-05-01 14-MSFS Upgrade\CAD\Design\Submittal\293-0501M106.dwg 11-13-08 12:00:52 PM greimer

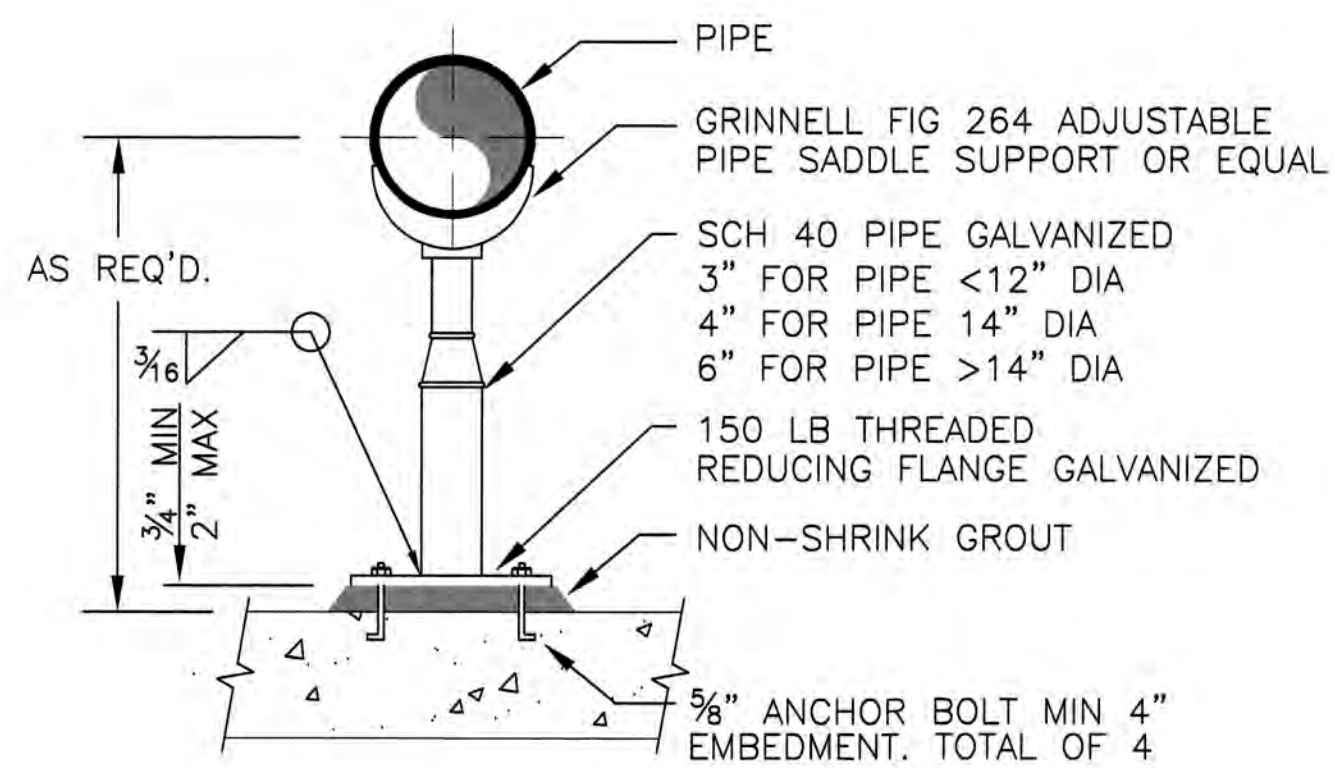


ADJUSTABLE PIPE SUPPORT

DETAIL **A**
VAR
NOT TO SCALE

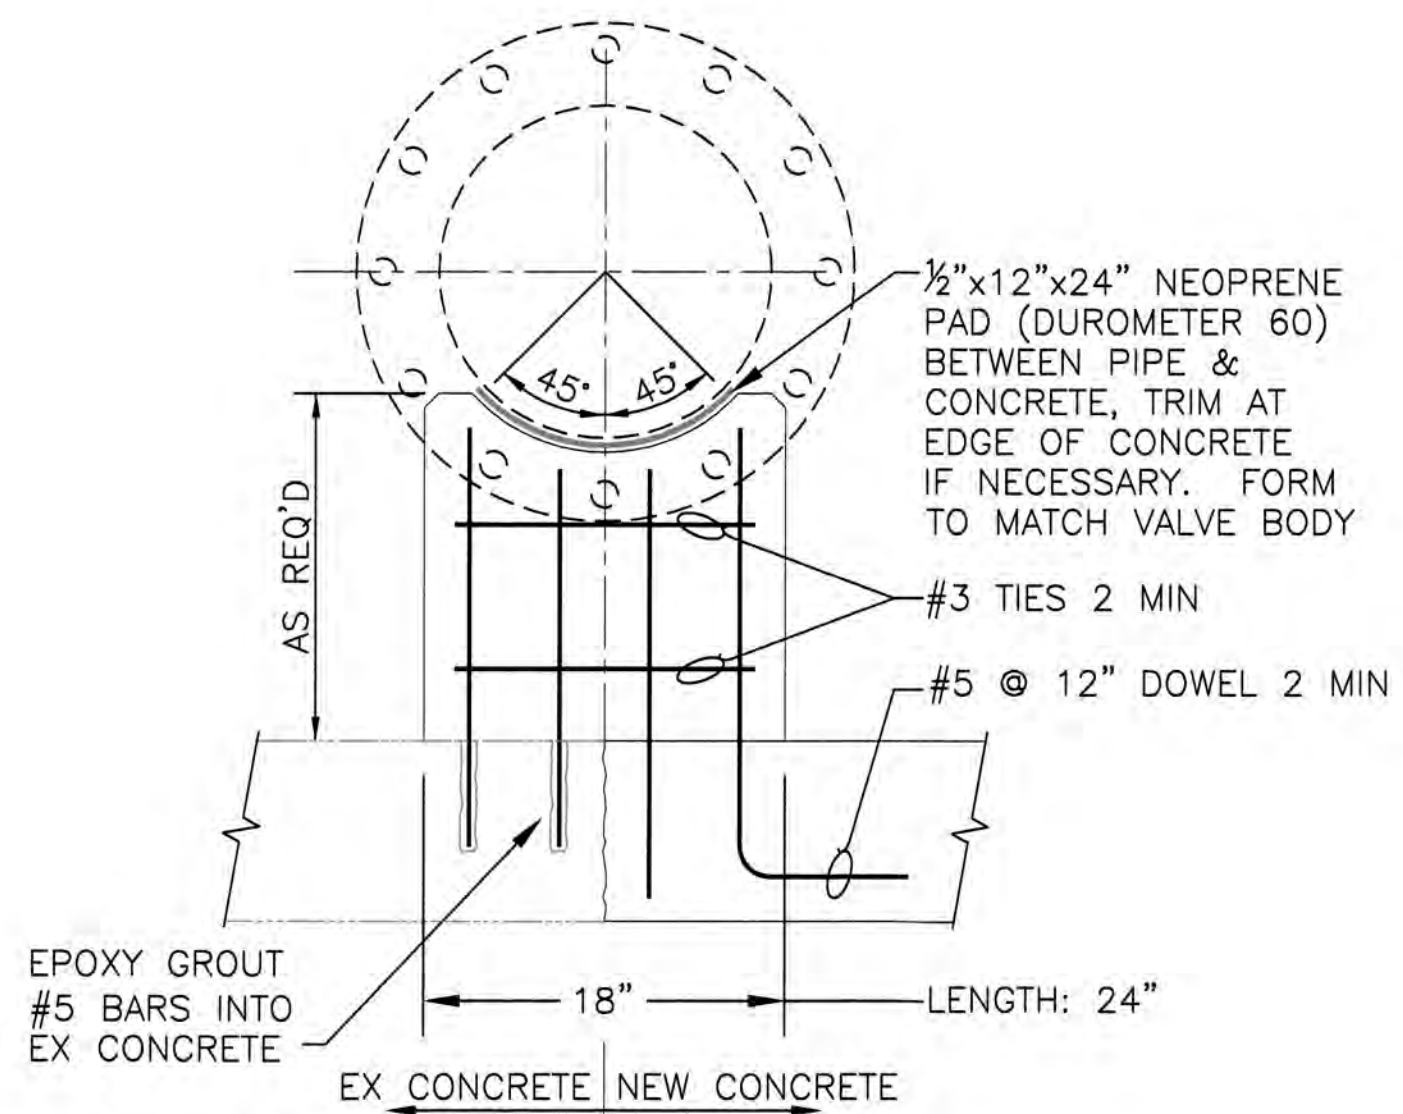


PIPE & VALVE SUPPORT

DETAIL **B**
VAR
NOT TO SCALE

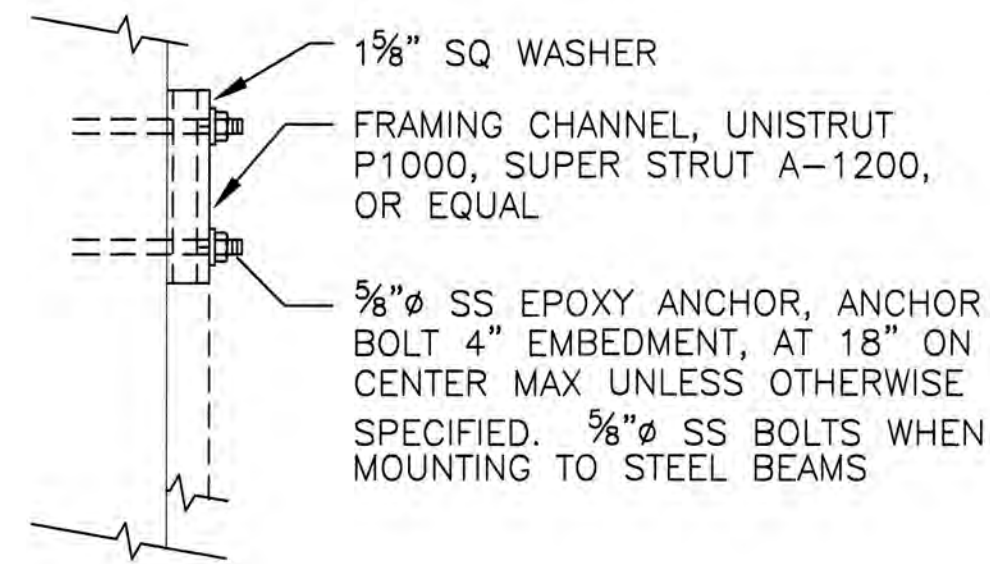


FRAMING CHANNEL STRUCTURAL ATTACHMENT


DETAIL **C**
NOT TO SCALE

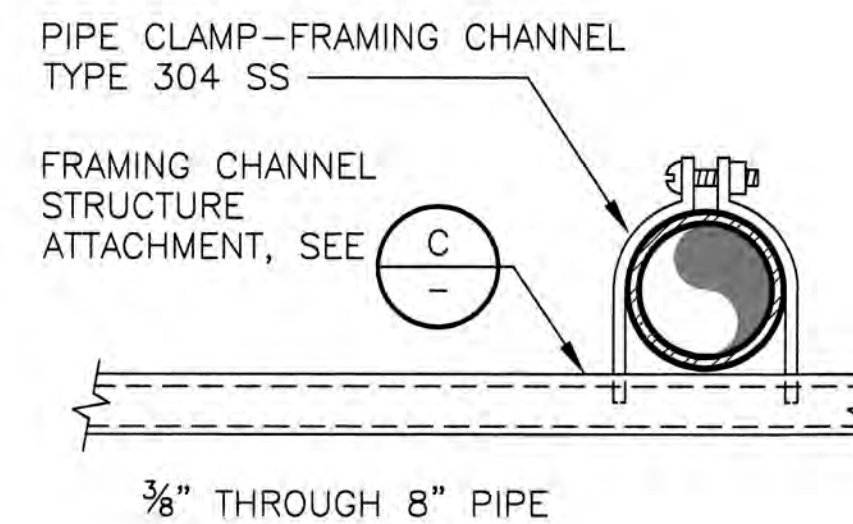

PIPE HANGER
DETAIL **D**
VAR
NOT TO SCALE

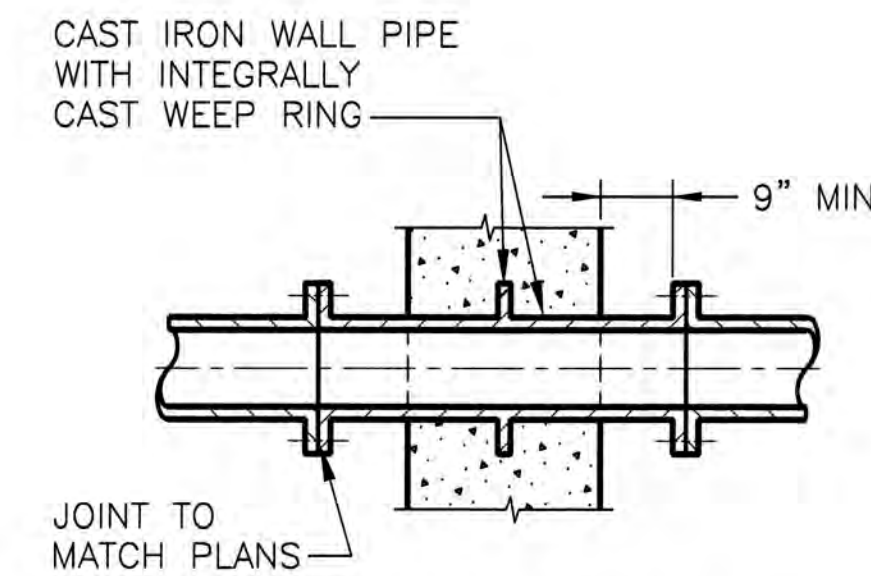


CAST IN PLACE WALL PIPE
DETAIL **E**
VAR
NOT TO SCALE

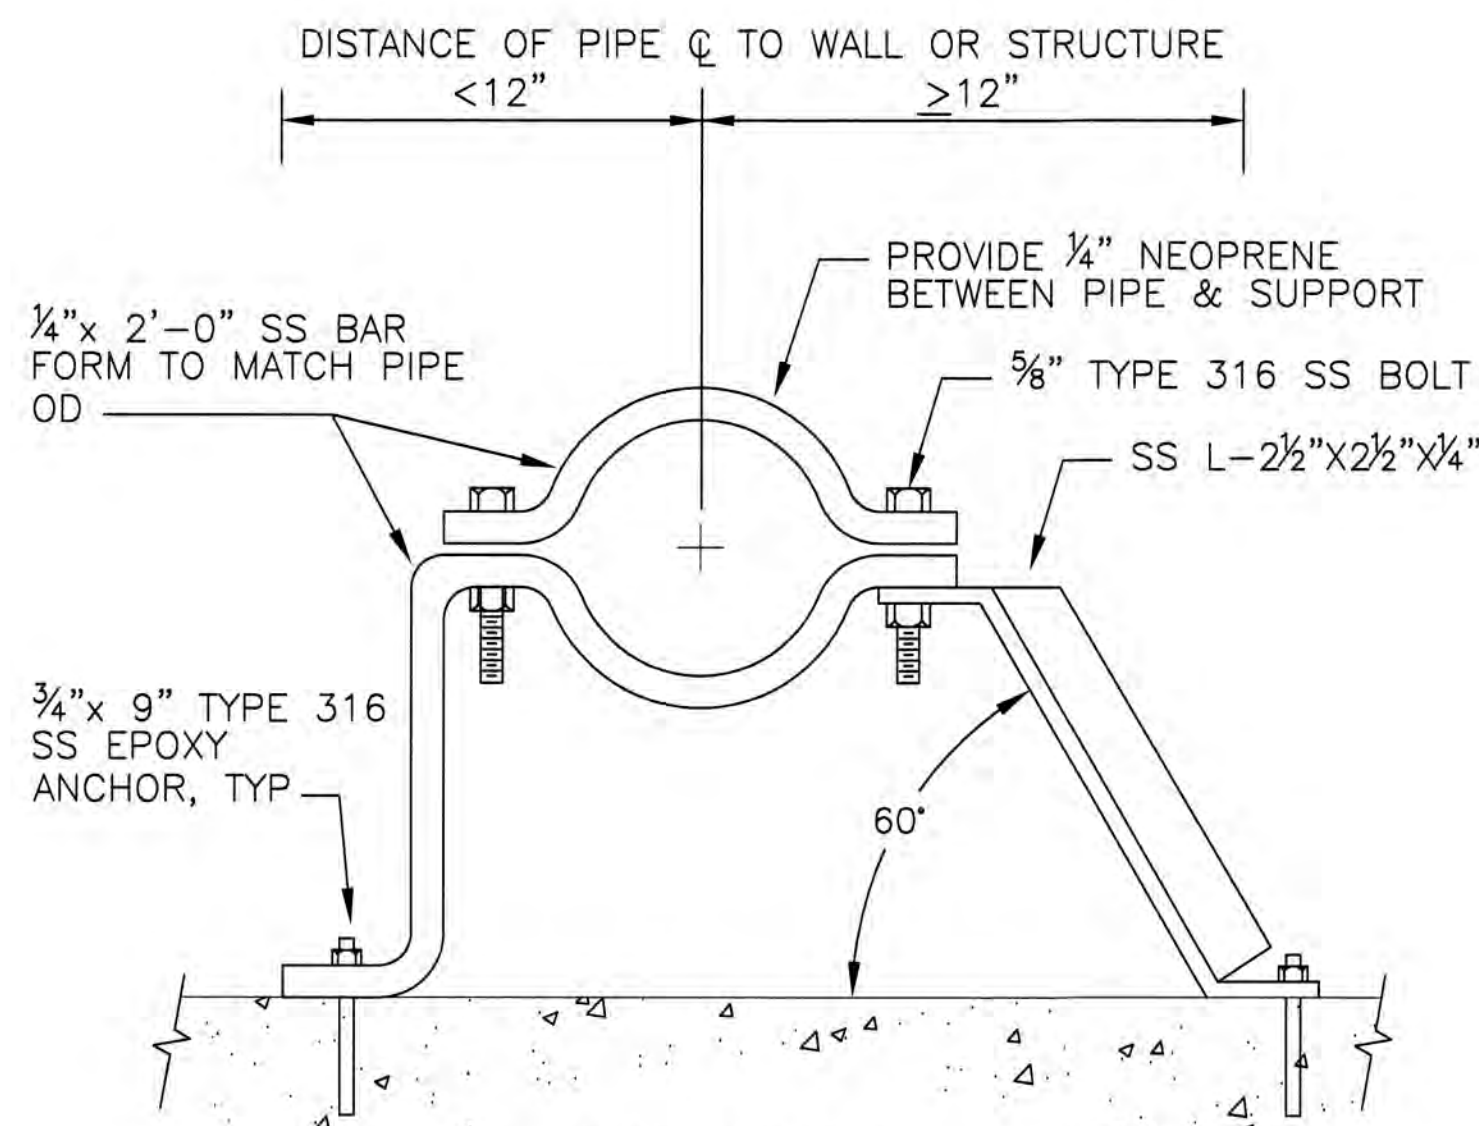

PIPE SUPPORT

DETAIL **F**
VAR
NOT TO SCALE

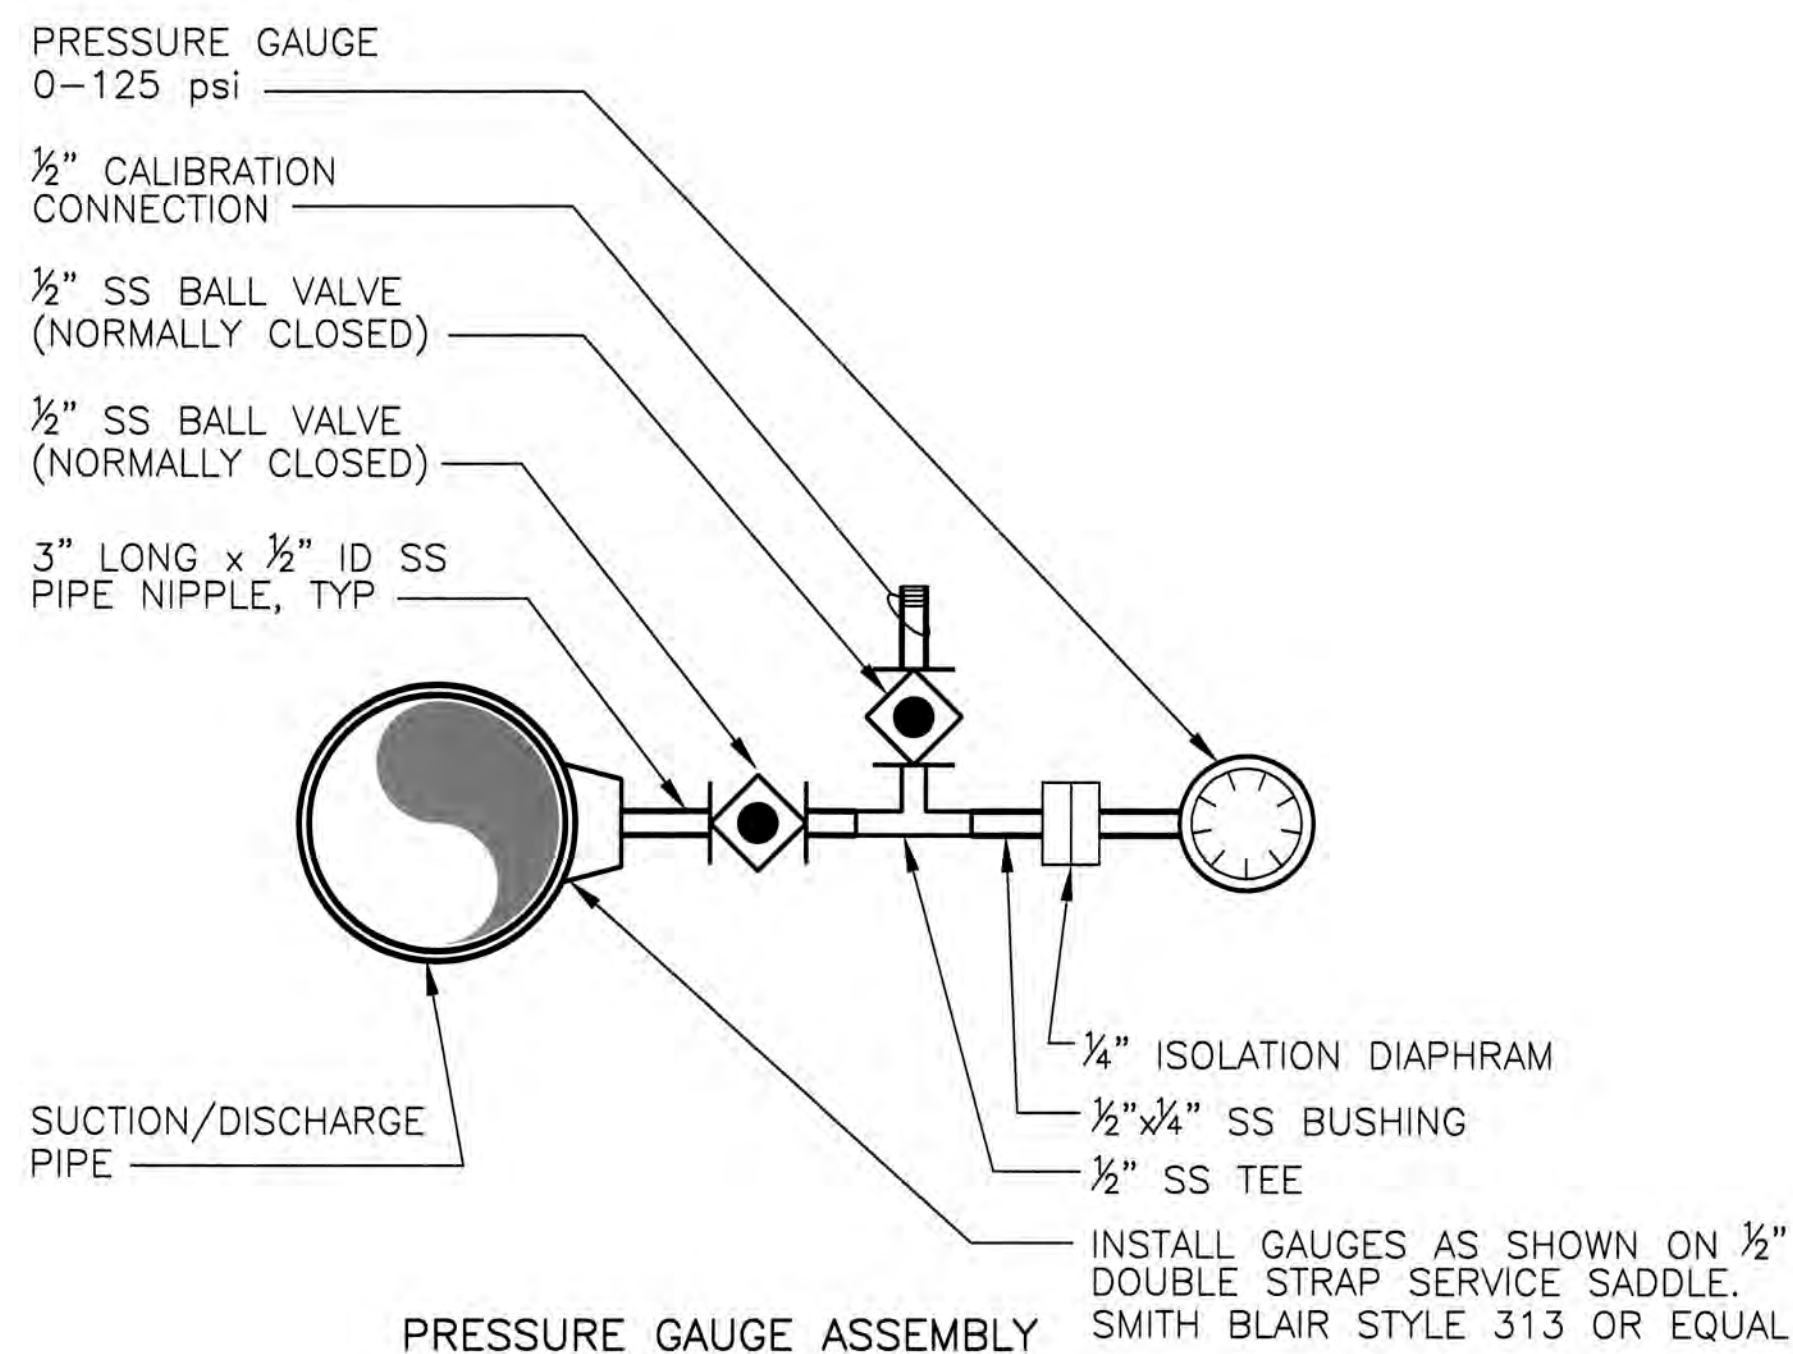

PRESSURE GAUGE ASSEMBLY

DETAIL **G**
M101
NOT TO SCALE

RECORD DRAWINGS		
14-Mile Slough Pump Station Upgrades		
PUMP STATION DETAILS 2		
DEPARTMENT OF MUNICIPAL UTILITIES CITY OF STOCKTON, CALIFORNIA		
SCALE: AS SHOWN	APPROVED BY: DATE: _____	SHEET No.
DESIGNED BY: RCB		M106
DRAWN BY: DTD		50 of 89 SHEETS
CHECKED BY: GDH	ASSISTANT DIRECTOR, DEPT. OF MUNICIPAL UTILITIES	PROJECT No. 293-00-05-01
RECORD Dwg.:		

Underground Service Alert

TWO DAYS BEFORE YOU DIG

Call TOLL FREE: 1-800-642-2444


REFER TO BID SET FOR SIGNATURE

REV. No.	DISCRPTION	DATE	BY	Apr'd By
1				
2				
3				
4				
5				
6				
7				

WEST YOST ASSOCIATES
Consulting Engineers

1260 Lake Boulevard
Suite 240
Davis, California 95616
(530) 756-5905
FAX (530) 756-5991


- NOTES:
 1. WALL THIMBLE SHALL BE STAINLESS STEEL
 2. ROUND BELL END SHALL MATCH RCP MANUFACTURER'S BELL DIMENSIONS

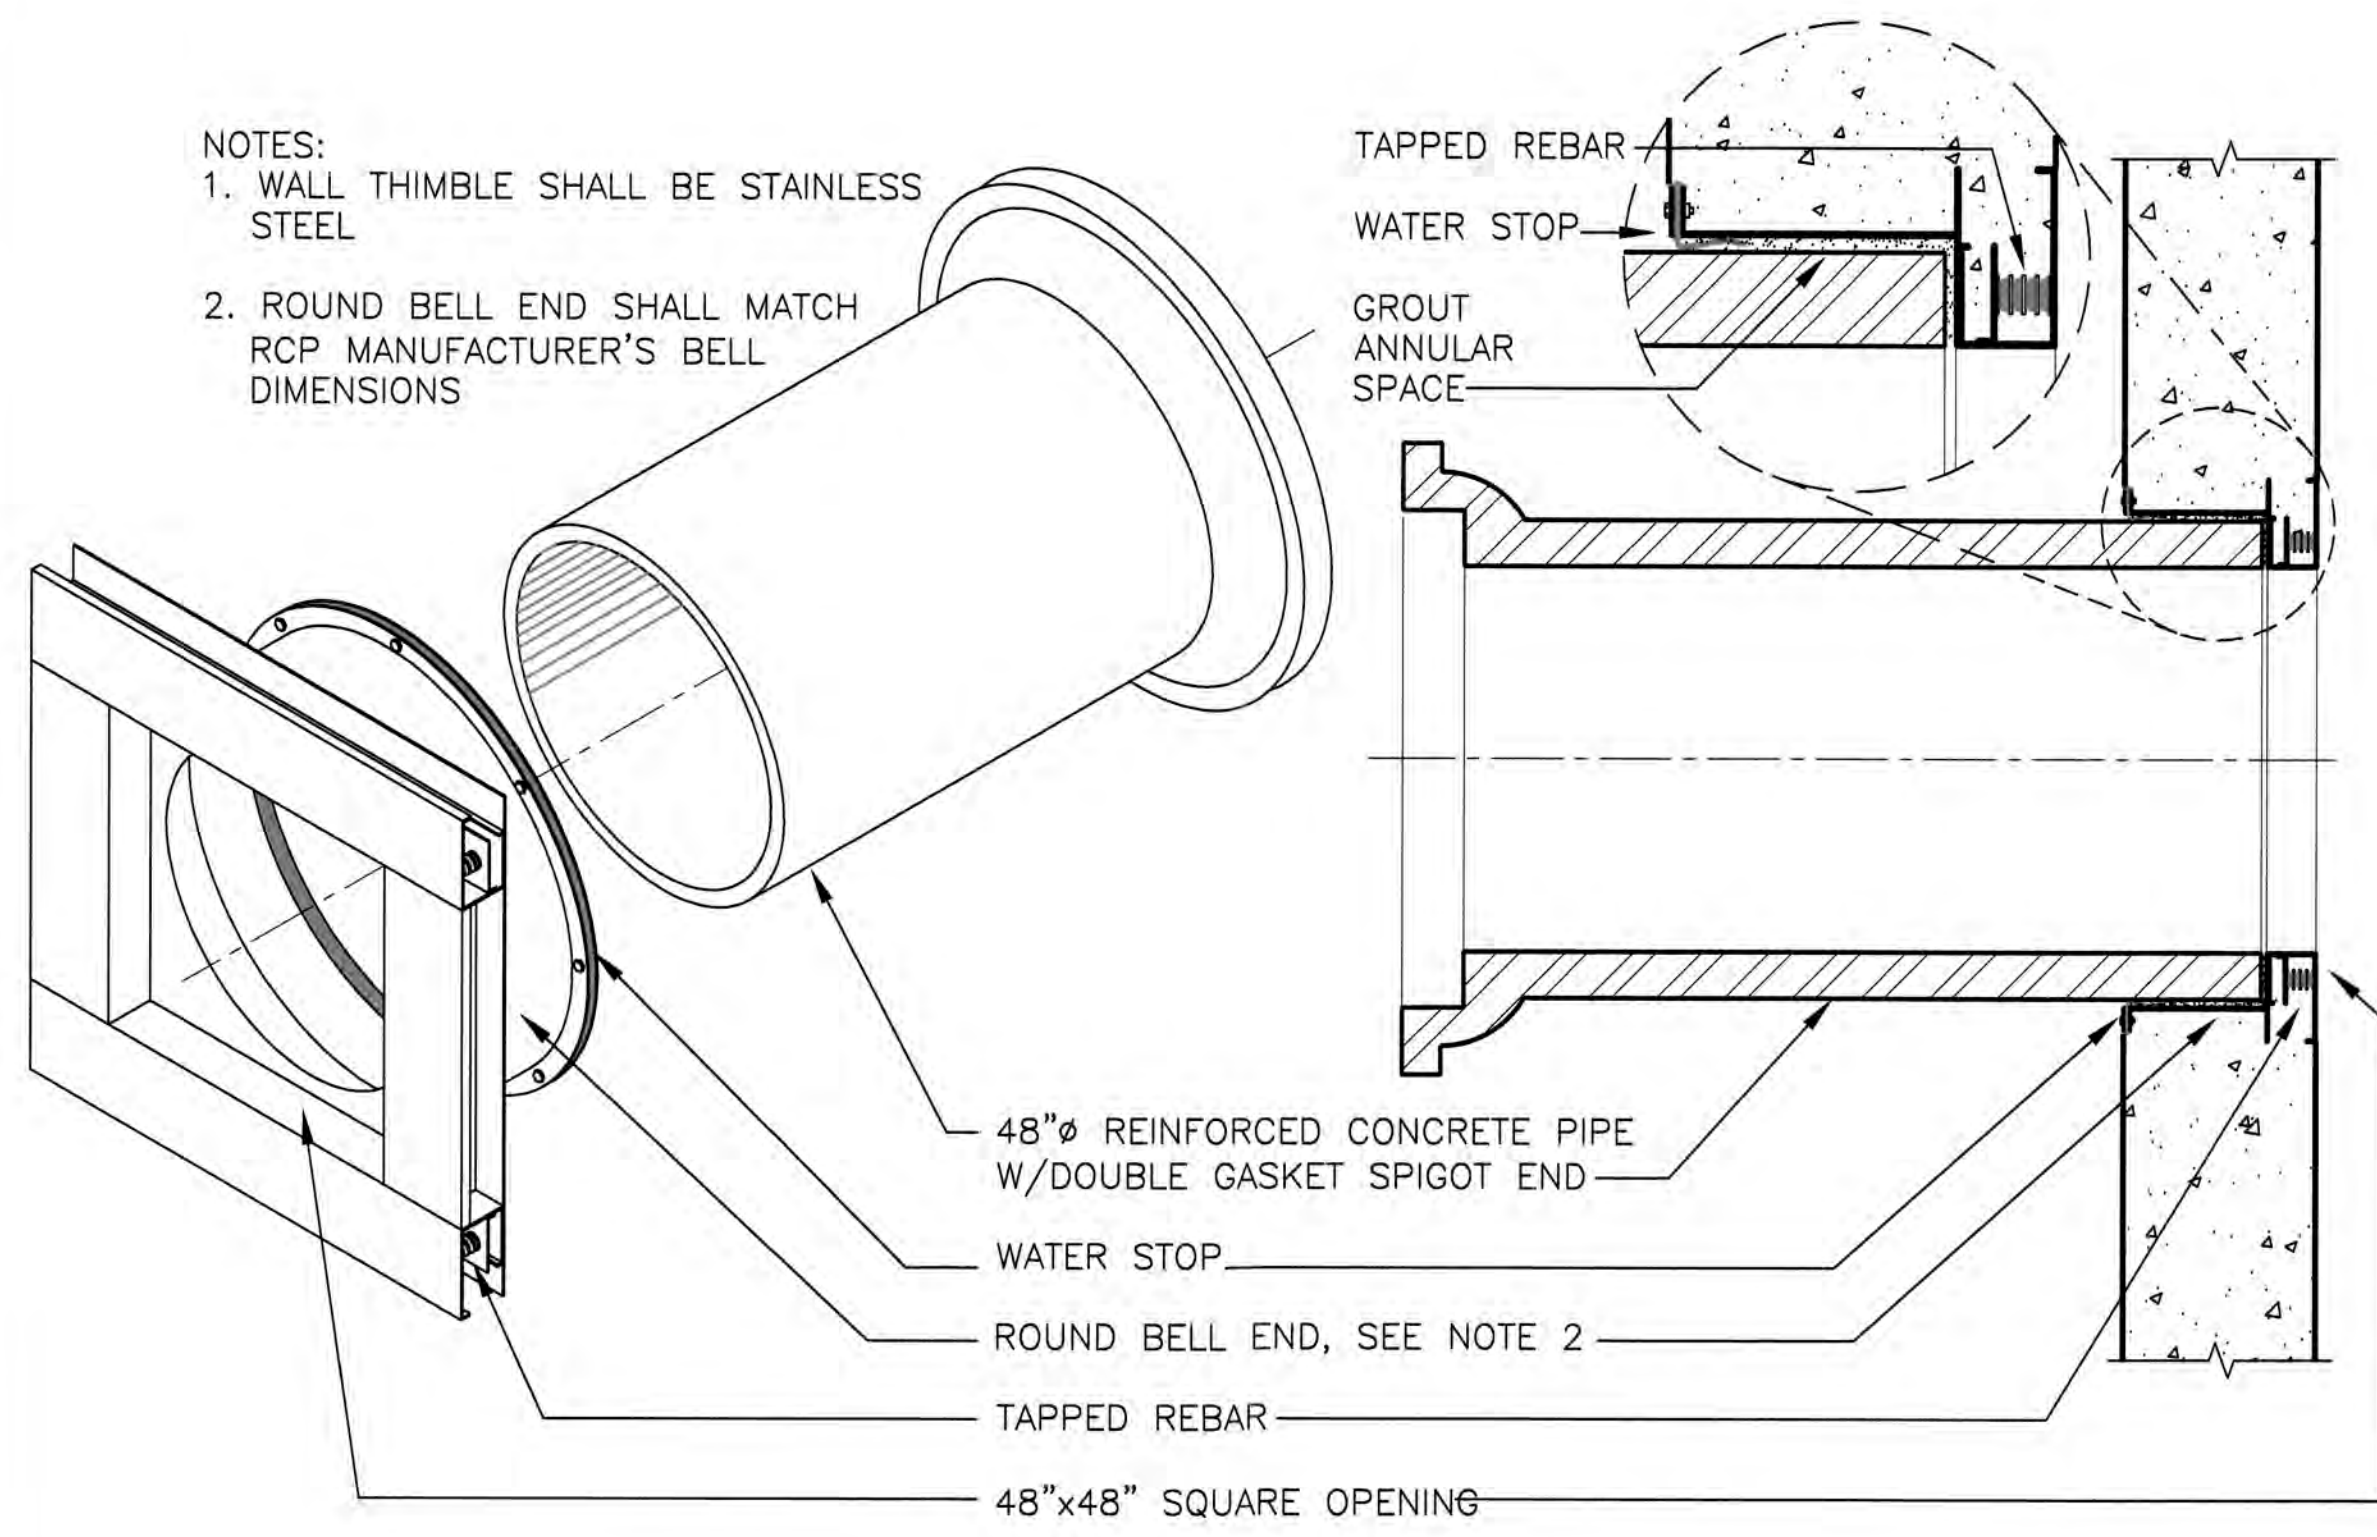


WALL THIMBLE - 48"Ø TO 48" SQUARE

DETAIL A M104
NOT TO SCALE


USE BLOCKOUT IN LIEU OF CASTING IN WALL THIMBLE

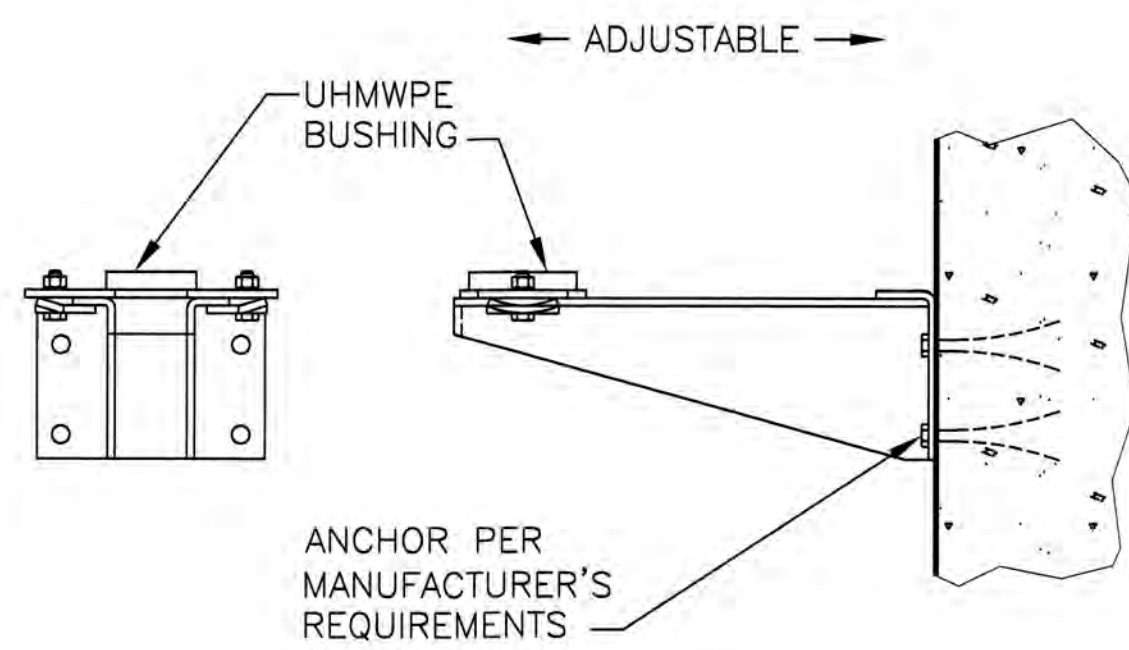

STEM GUIDE
DETAIL B VAR
NOT TO SCALE

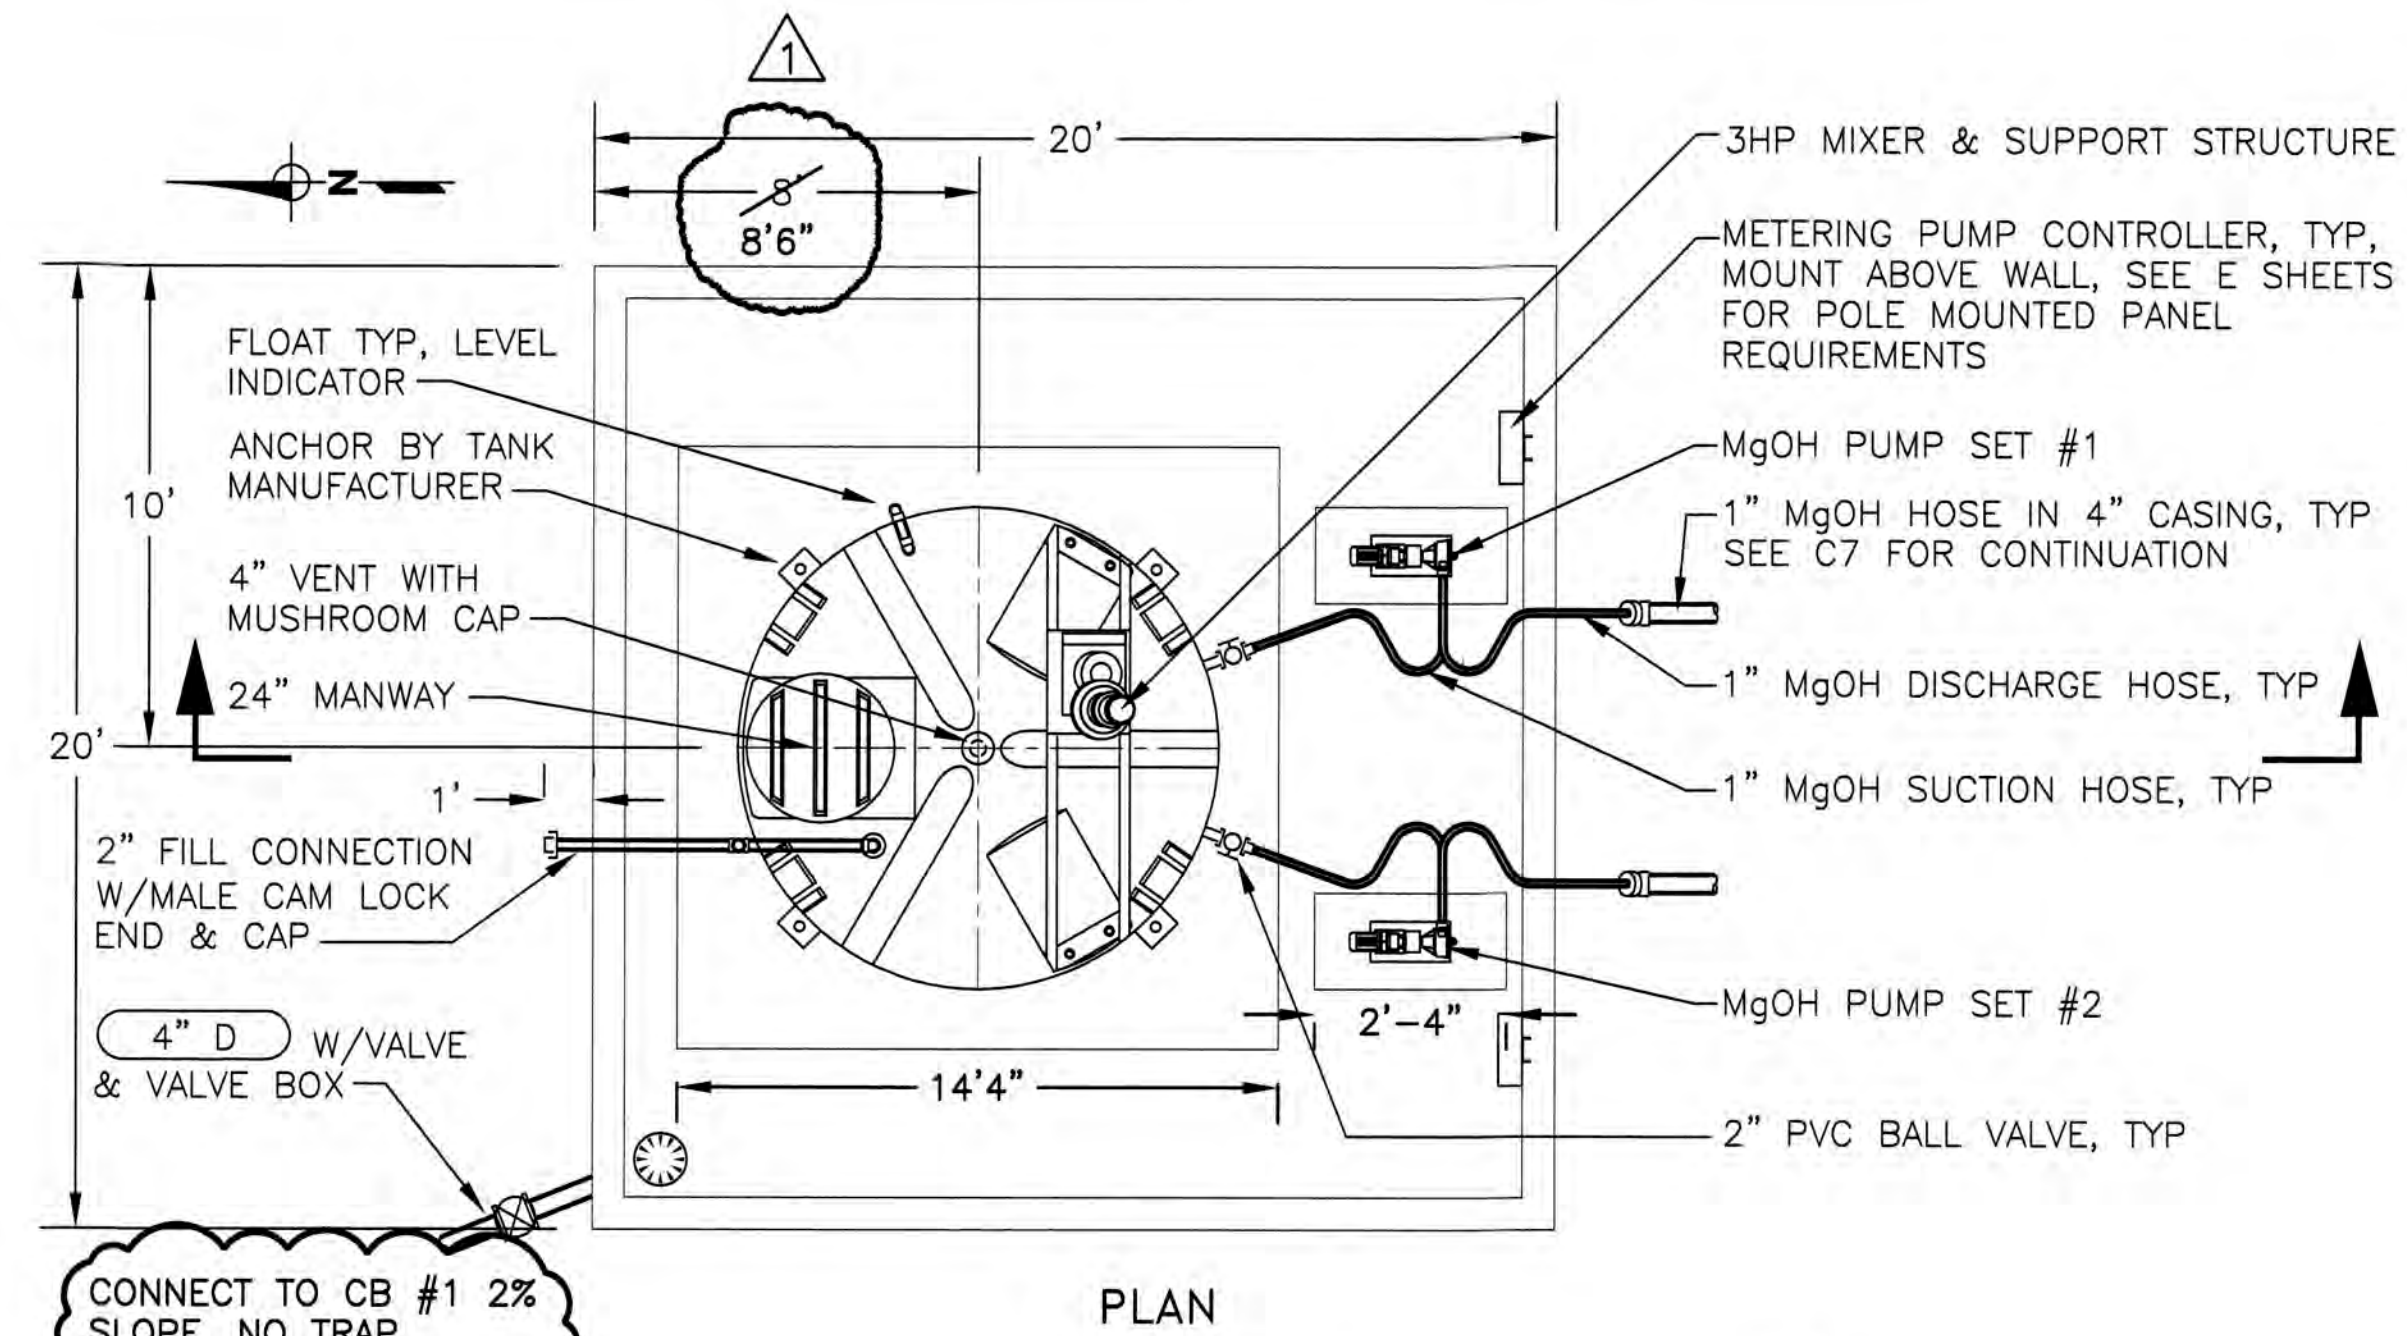


PLAN

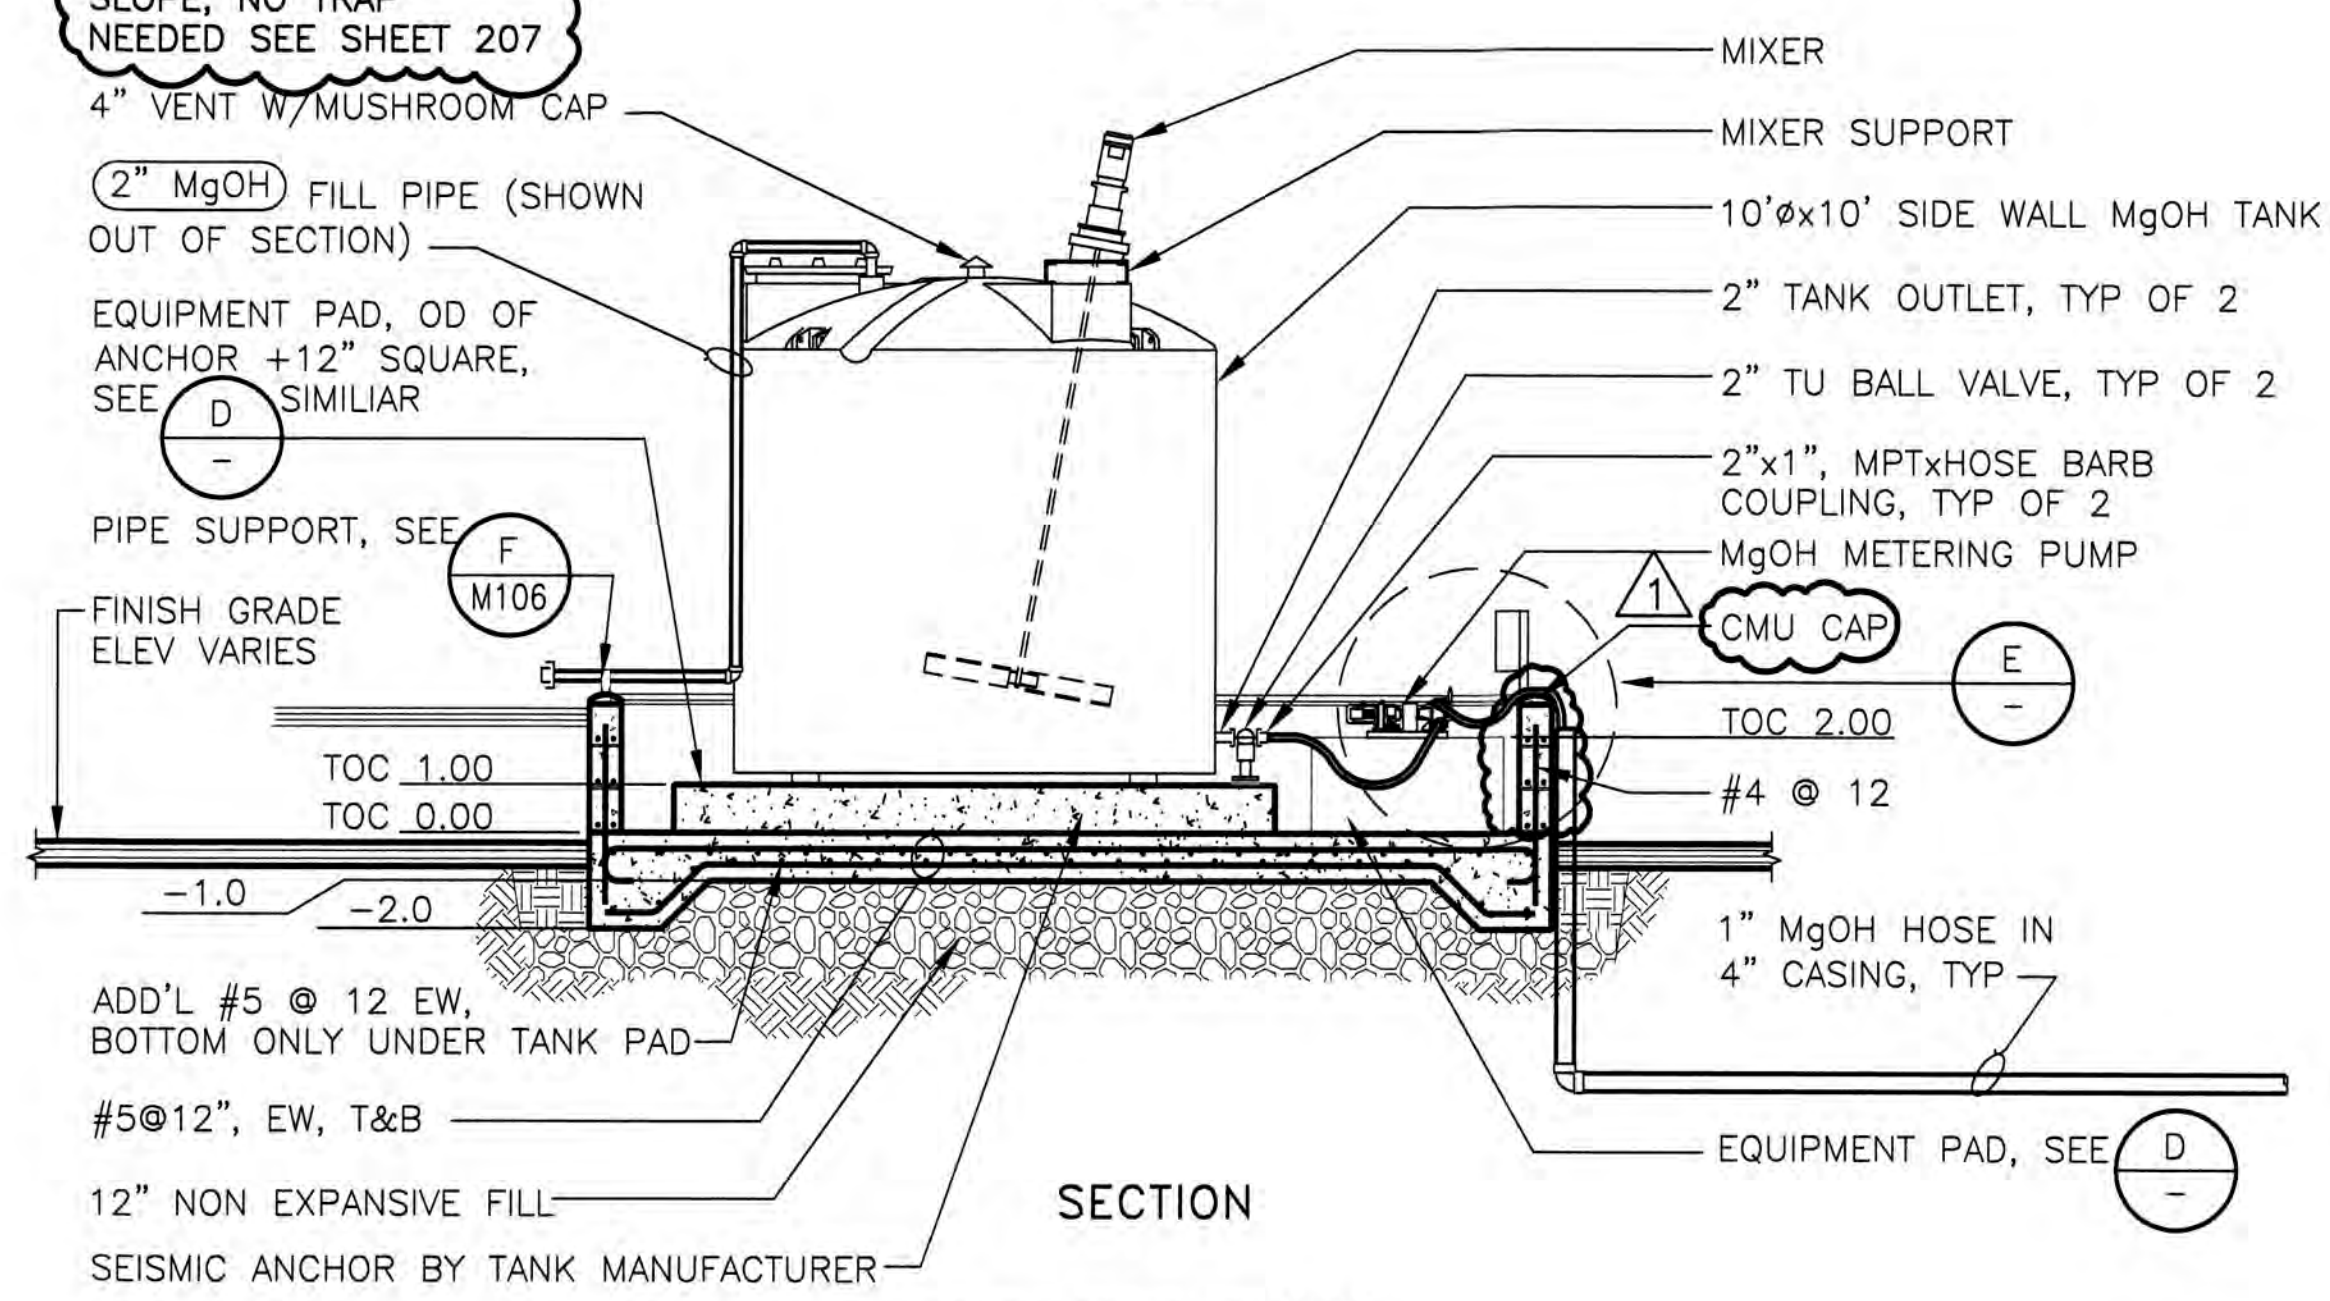

SECTION


MgOH FEED STATION

DETAIL C C1&C7
SCALE: 1/4"=1'-0"

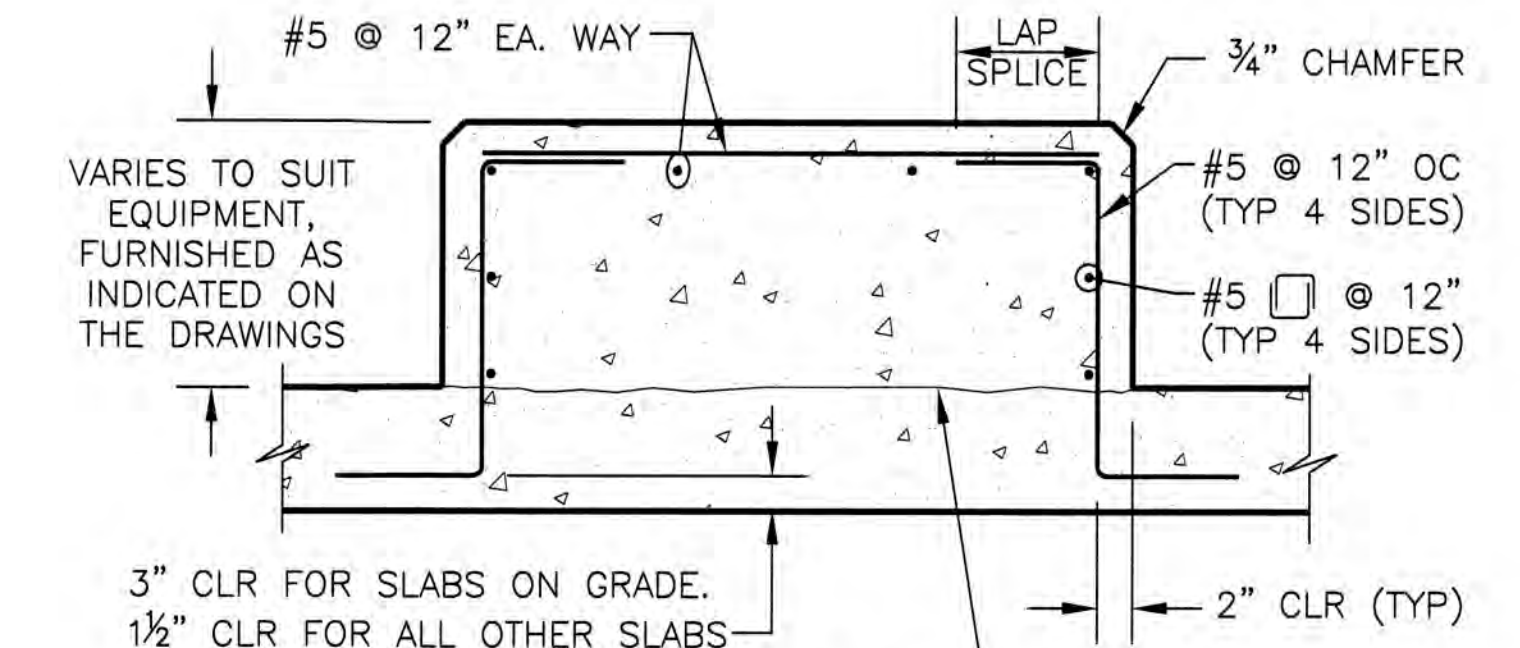

- NOTES:
1. THE MINIMUM PAD SIZE SHALL BE AS INDICATED OR AS SHOWN ON THE DRAWINGS OR AS DETERMINED BY THE EQUIPMENT MANUFACTURER.
 2. THE SIZE, NUMBER, TYPE, LOCATION AND THREAD PROJECTION OF THE ANCHOR BOLTS SHALL BE DETERMINED BY THE EQUIPMENT MANUFACTURER. HOLD CONCRETE ANCHOR BOLTS IN POSITION WITH A TEMPLATE WHILE PAD IS BEING PLACED.
 3. USE ANCHOR BOLT SLEEVES TO PROVIDE THE ANCHOR BOLT A MINIMUM MOVEMENT OF 1/2" IN ALL DIRECTIONS. SLEEVES SHALL BE FILLED WITH NON-SHRINK GROUT.
 4. ANCHOR BOLT SLEEVES SHALL HAVE A MINIMUM INTERNAL DIAMETER 1" GREATER AND A MAXIMUM INTERNAL DIAMETER 3" GREATER THAN ANCHOR BOLT DIAMETER.
 5. EQUIPMENT BASES SHALL BE INSTALLED LEVEL UNO
 6. PROVIDE WEDGES OR SHIMS TO SUPPORT THE BASE WHILE THE NON-SHRINK GROUT IS PLACED. TEMPORARY LEVELING NUTS SHALL BE BACKED OFF. THE WEDGES OR SHIMS THAT REMAIN IN PLACE SHALL NOT BE EXPOSED TO VIEW.
 7. WHERE CONCRETE SLAB OR BEAM THICKNESS WILL NOT ACCOMMODATE THE ANCHOR BOLT, PROVIDE EXTRA THICKNESS OF SLAB OR BEAM.
 8. CONTRACTOR TO PROVIDE STRUCTURAL CALCULATIONS FOR EQUIPMENT ANCHORS STAMPED BY A CALIFORNIA REGISTERED ENGINEER. ANCHORS SHALL BE STAINLESS STEEL.

DETAIL D
NOT TO SCALE

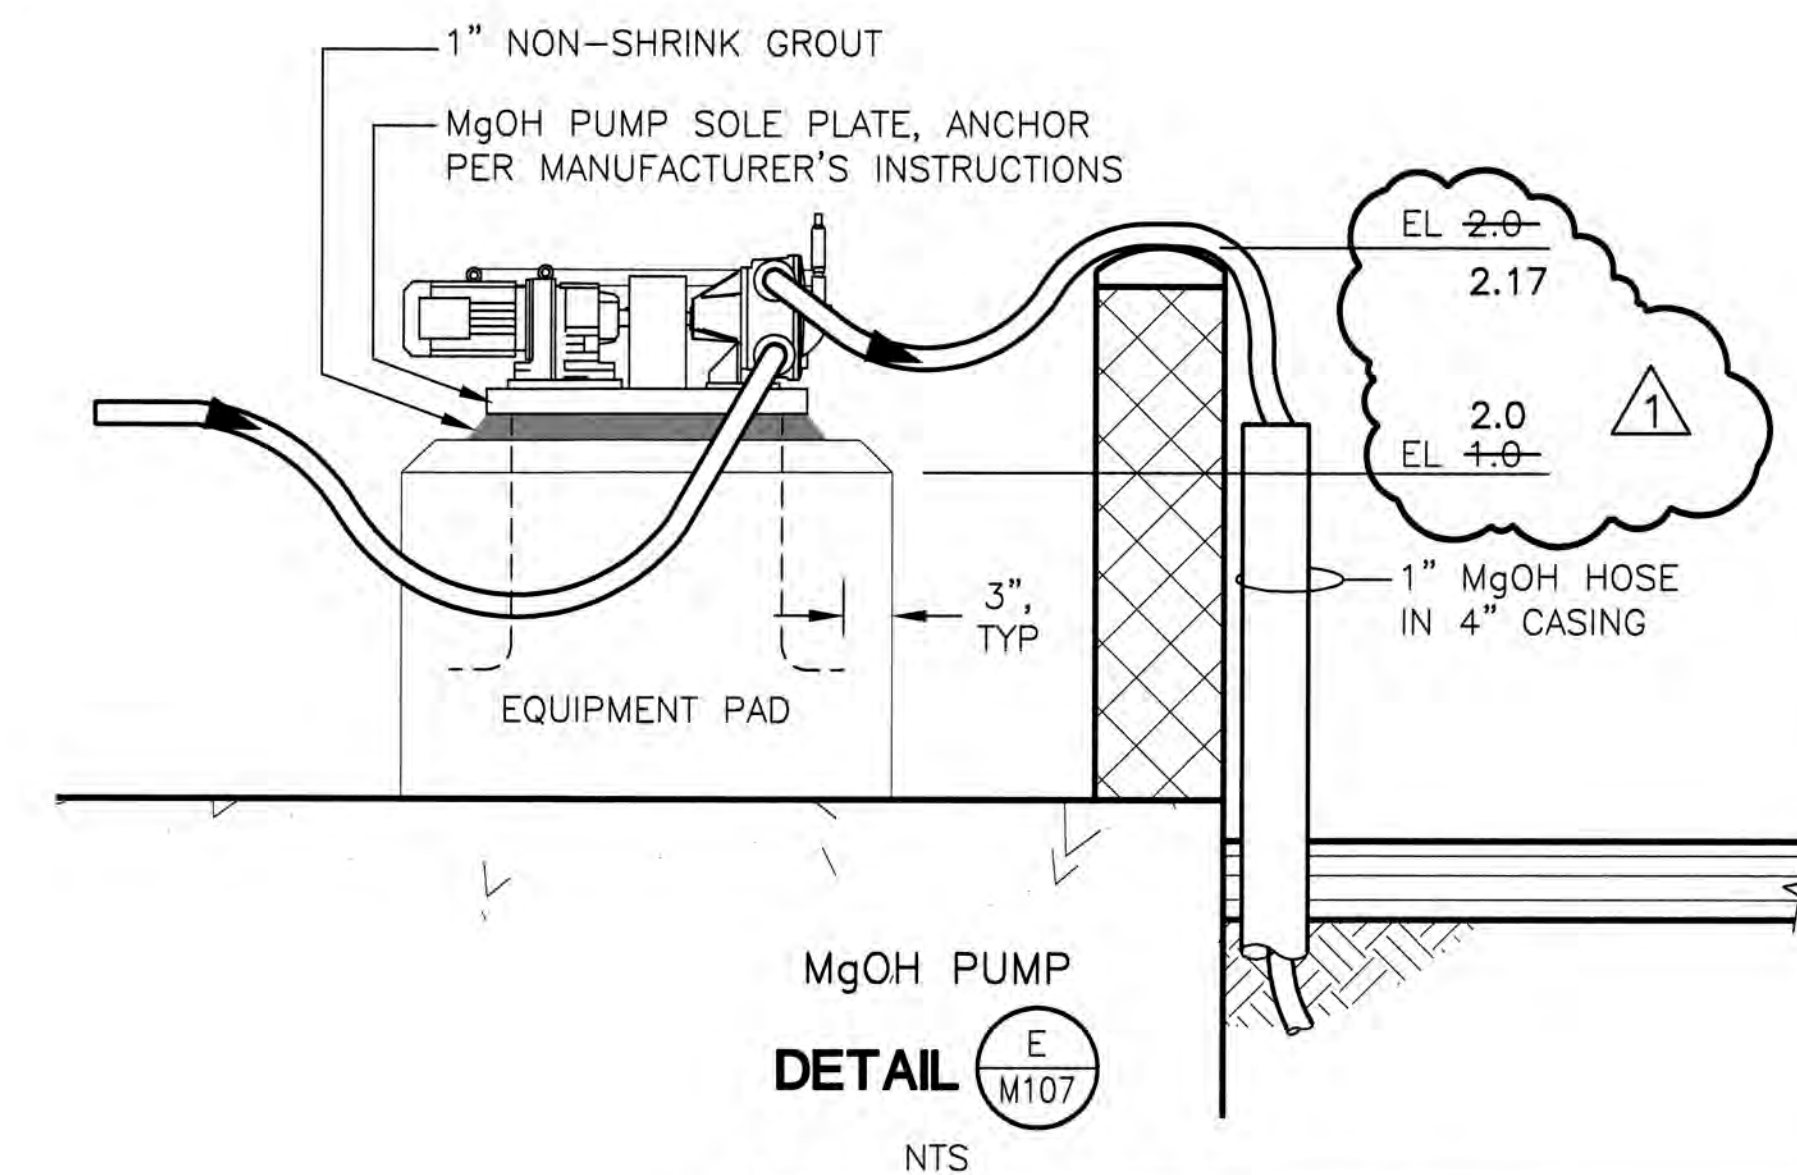

DETAIL E M107
NTS

RECORD DRAWINGS
 14-Mile Slough Pump Station Upgrades

PUMP STATION
 DETAILS 3

DEPARTMENT OF MUNICIPAL UTILITIES CITY OF STOCKTON, CALIFORNIA		SHEET No.
SCALE: AS SHOWN	APPROVED BY: DATE:	M107
DESIGNED BY: PDF		51 of 89 SHEETS
DRAWN BY: RDB		PROJECT No. 293-00-05-01
CHECKED BY: GDH	ASSISTANT DIRECTOR, DEPT. OF MUNICIPAL UTILITIES	
RECORD Dwg.:		

N:\Clients\293 Spans\00-05-01 14-MSPS Upgrades\CAD\Design\Submittals\293-0501M107.dwg 11-13-08 12:01:51 PM areimer

Underground Service Alert

TWO DAYS BEFORE YOU DIG

Call TOLL FREE: 1-800-642-2444


REFER TO BID SET FOR SIGNATURE

REV. No.	DISCRPTION	DATE	BY	Appr'd By
1	RECORD DRAWINGS	6/08	CLB	PDF
2				
3				
4				
5				
6				
7				


WEST YOST ASSOCIATES
 Consulting Engineers

1260 Lake Boulevard
 Suite 240
 Davis, California 95616
 (530) 756-5905
 FAX (530) 756-5991


K:\Clients\293_Sponosa\00-05-01_14-MSPS_Upgrade\CAO_Design\Utilities\293-0501M108.dwg 11-13-08 12:09:49 PM areimer

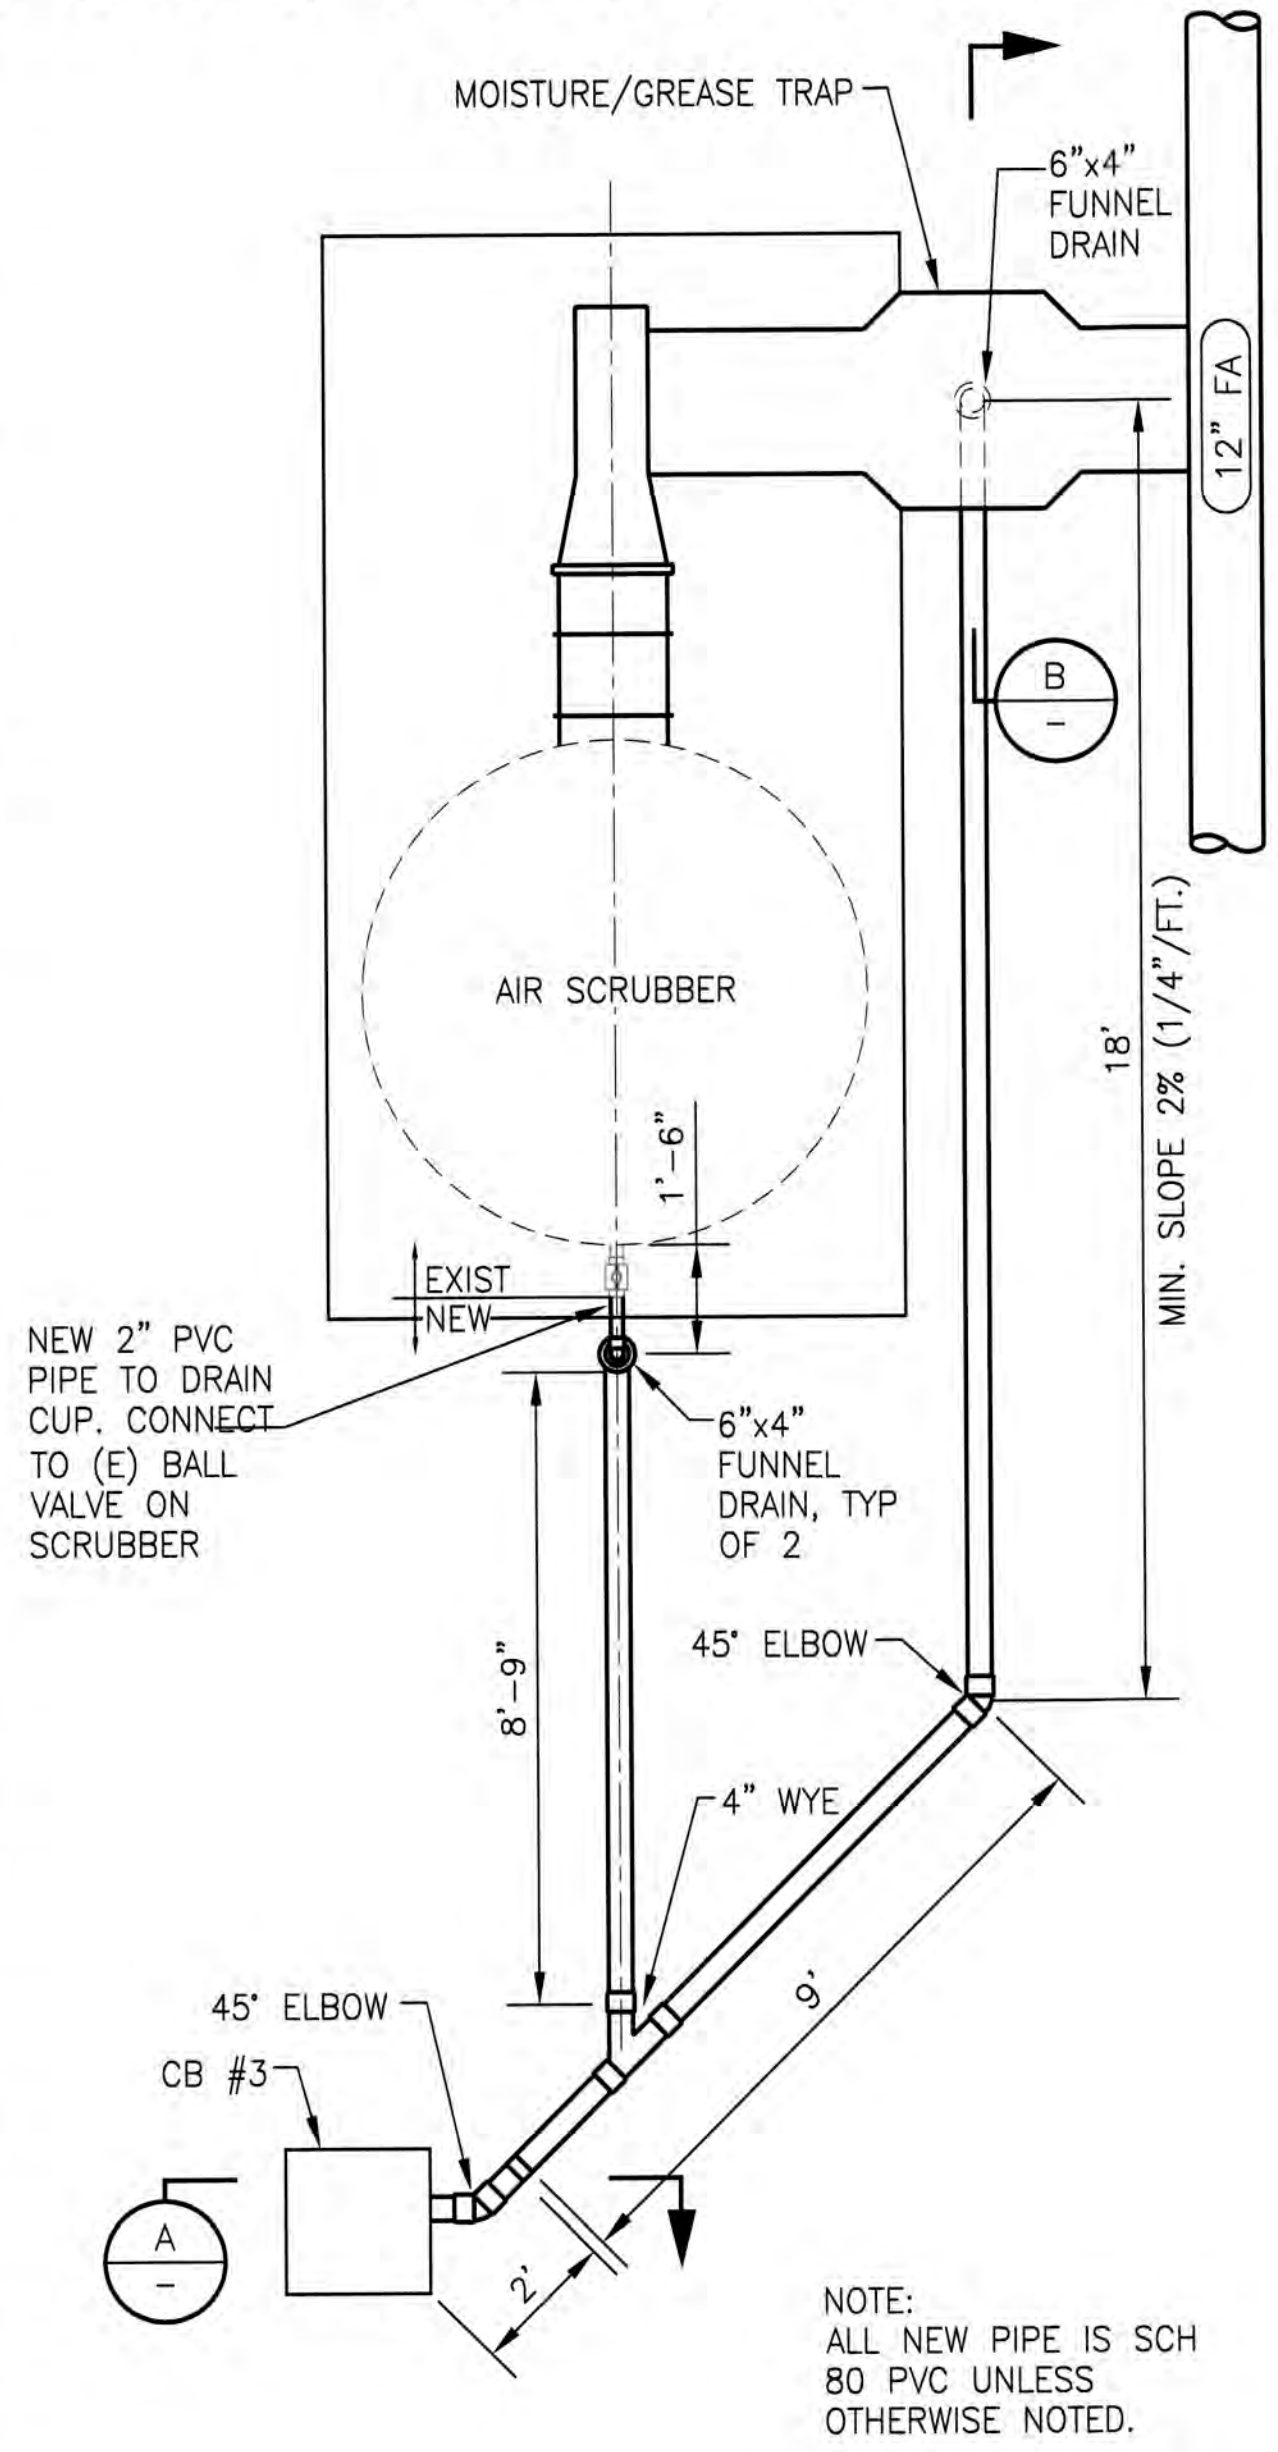


PLAN
SCALE: 3/8"=1'-0"

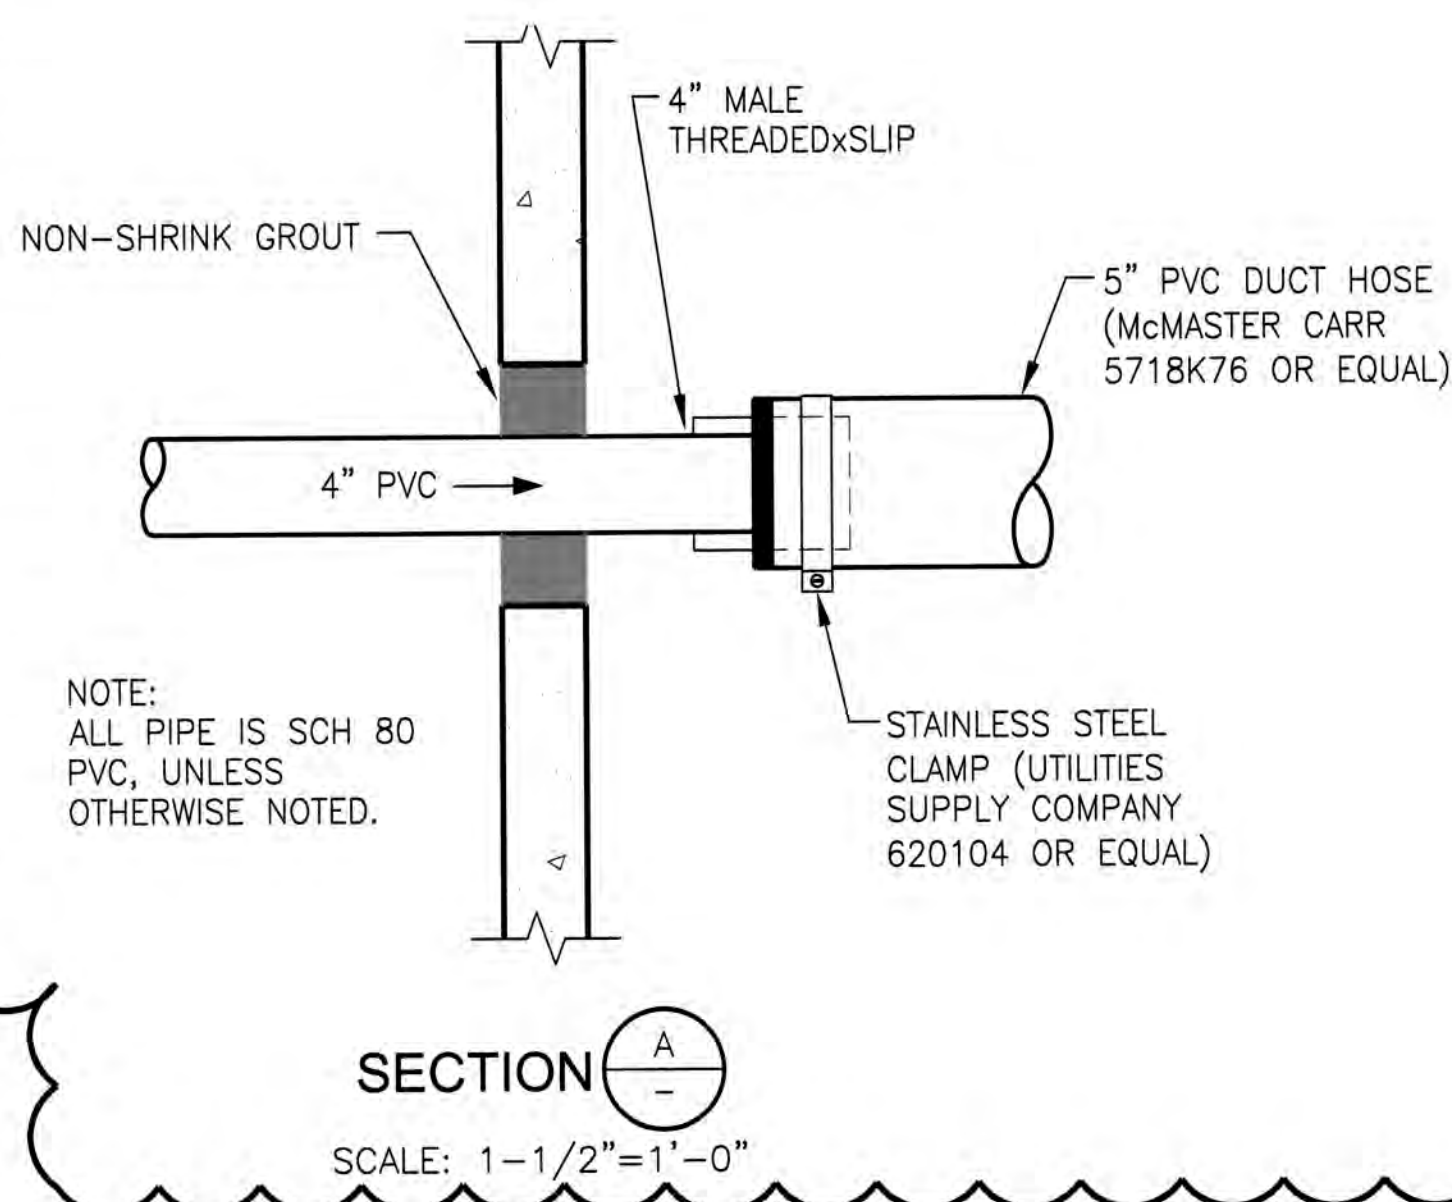


SECTION A-A
SCALE: 1-1/2"=1'-0"

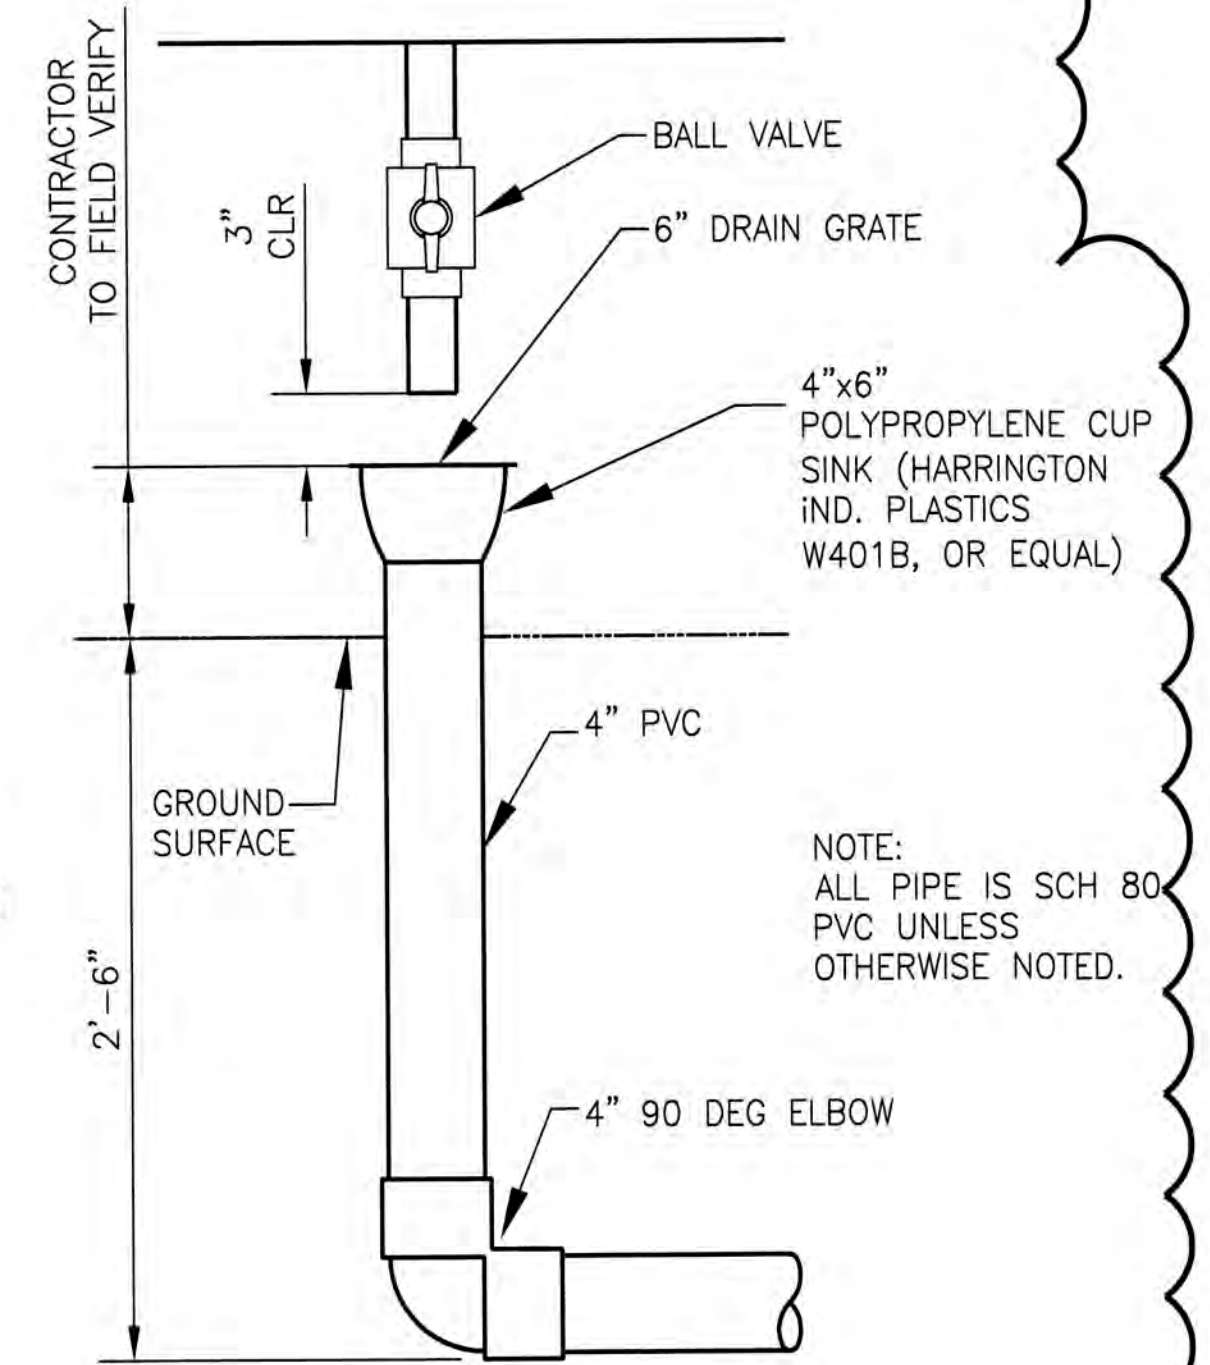


SECTION B-B
SCALE: 1-1/2"=1'-0"

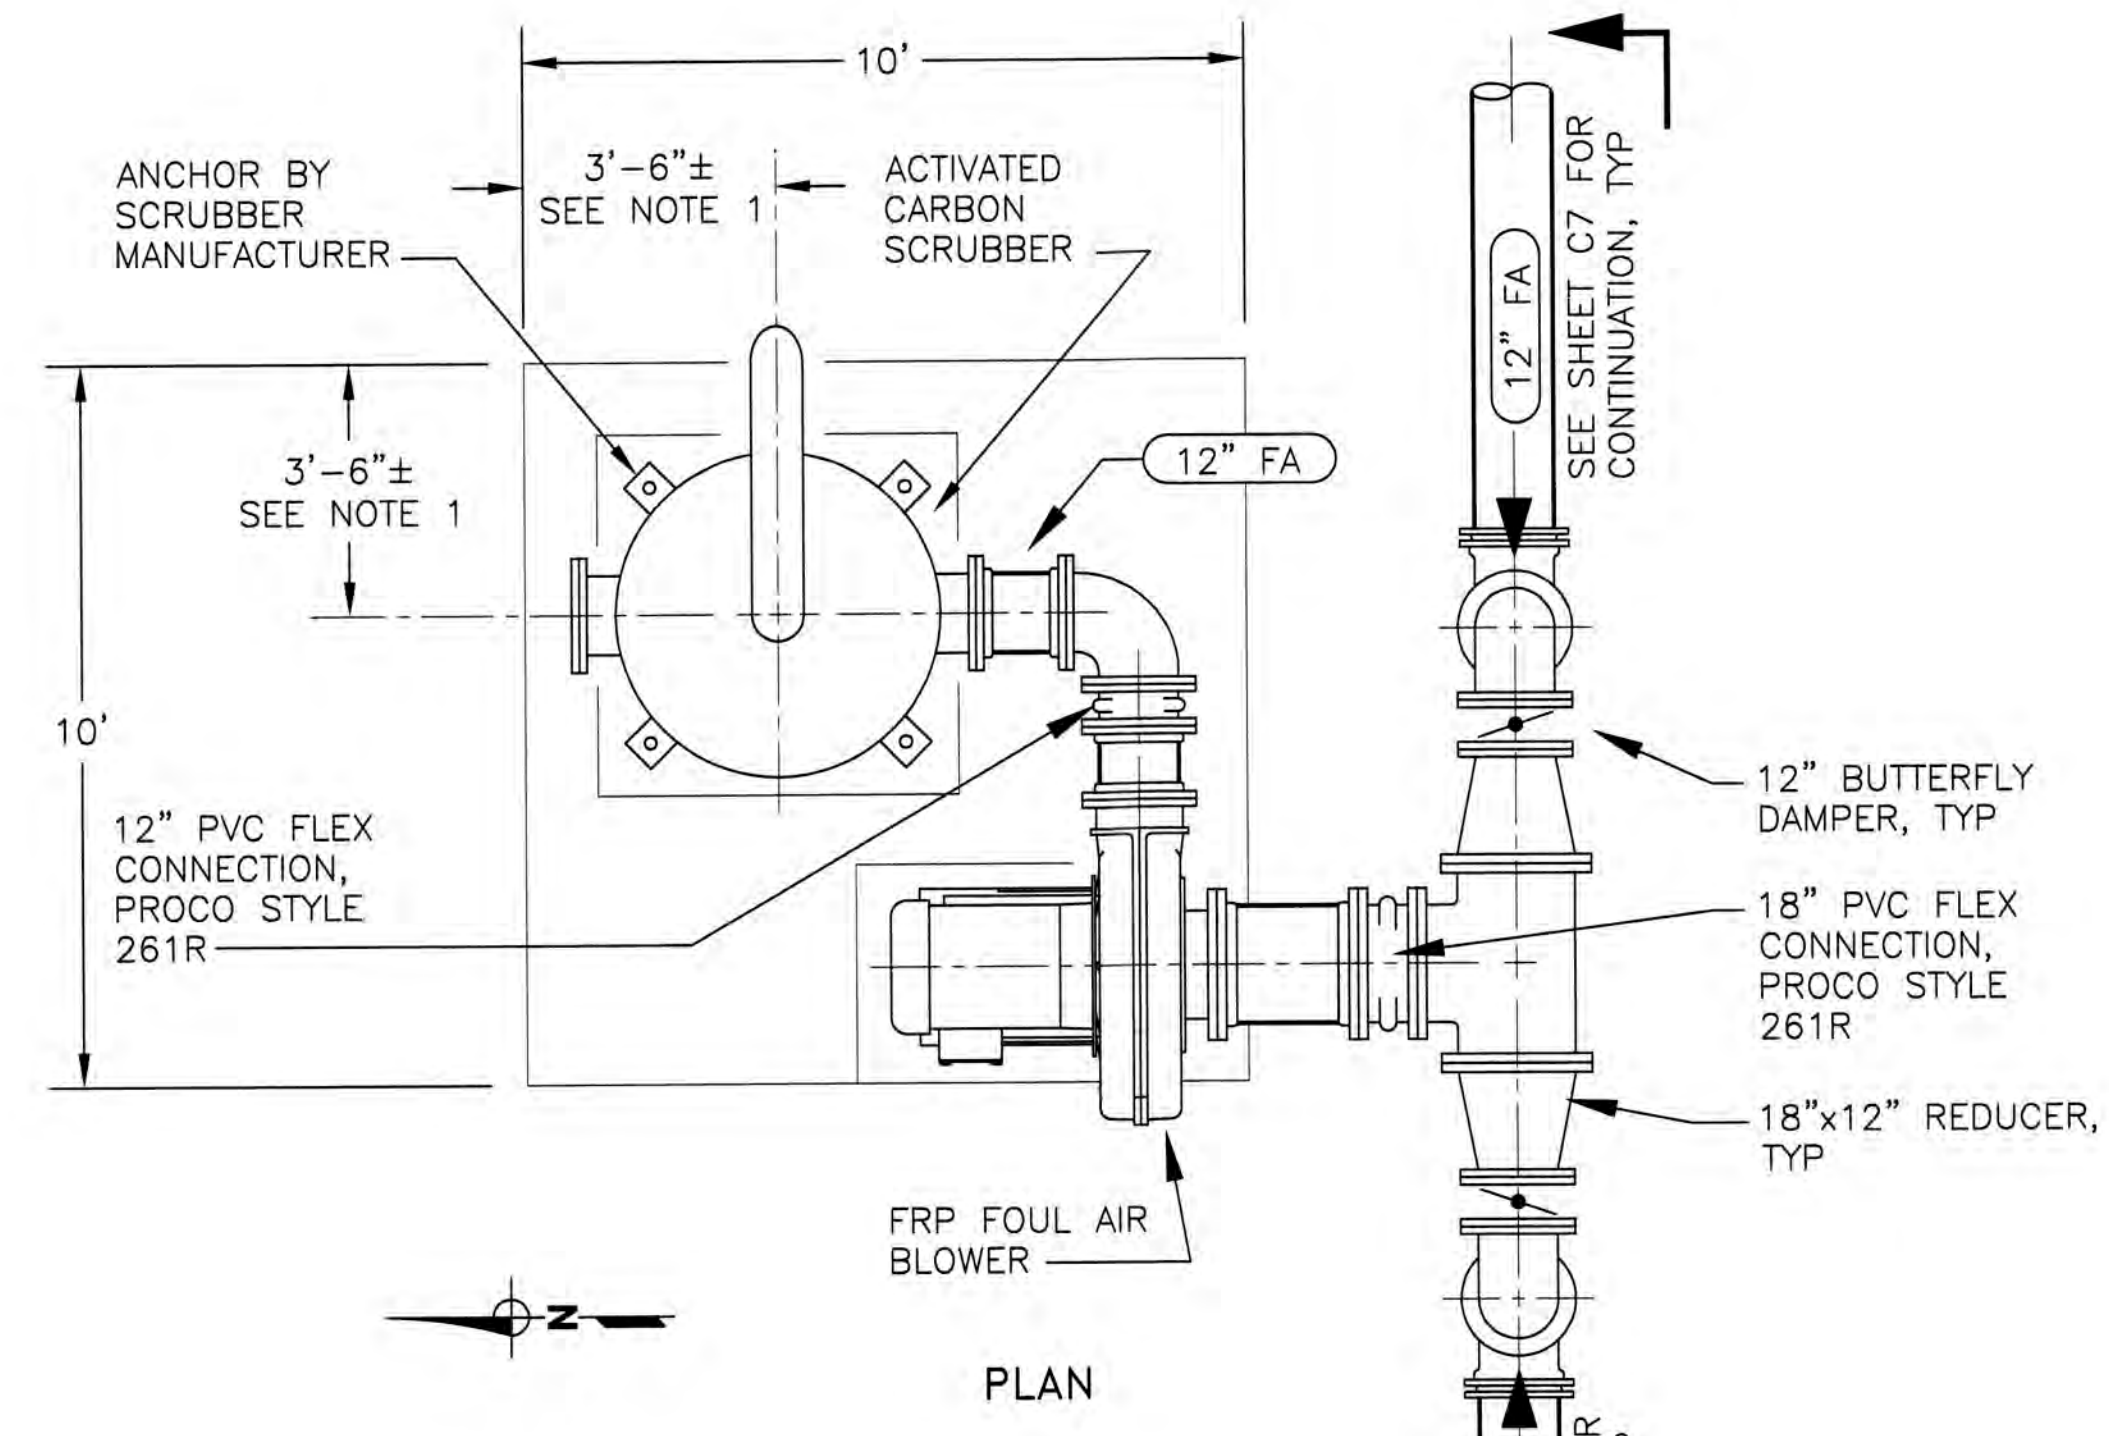

PLAN

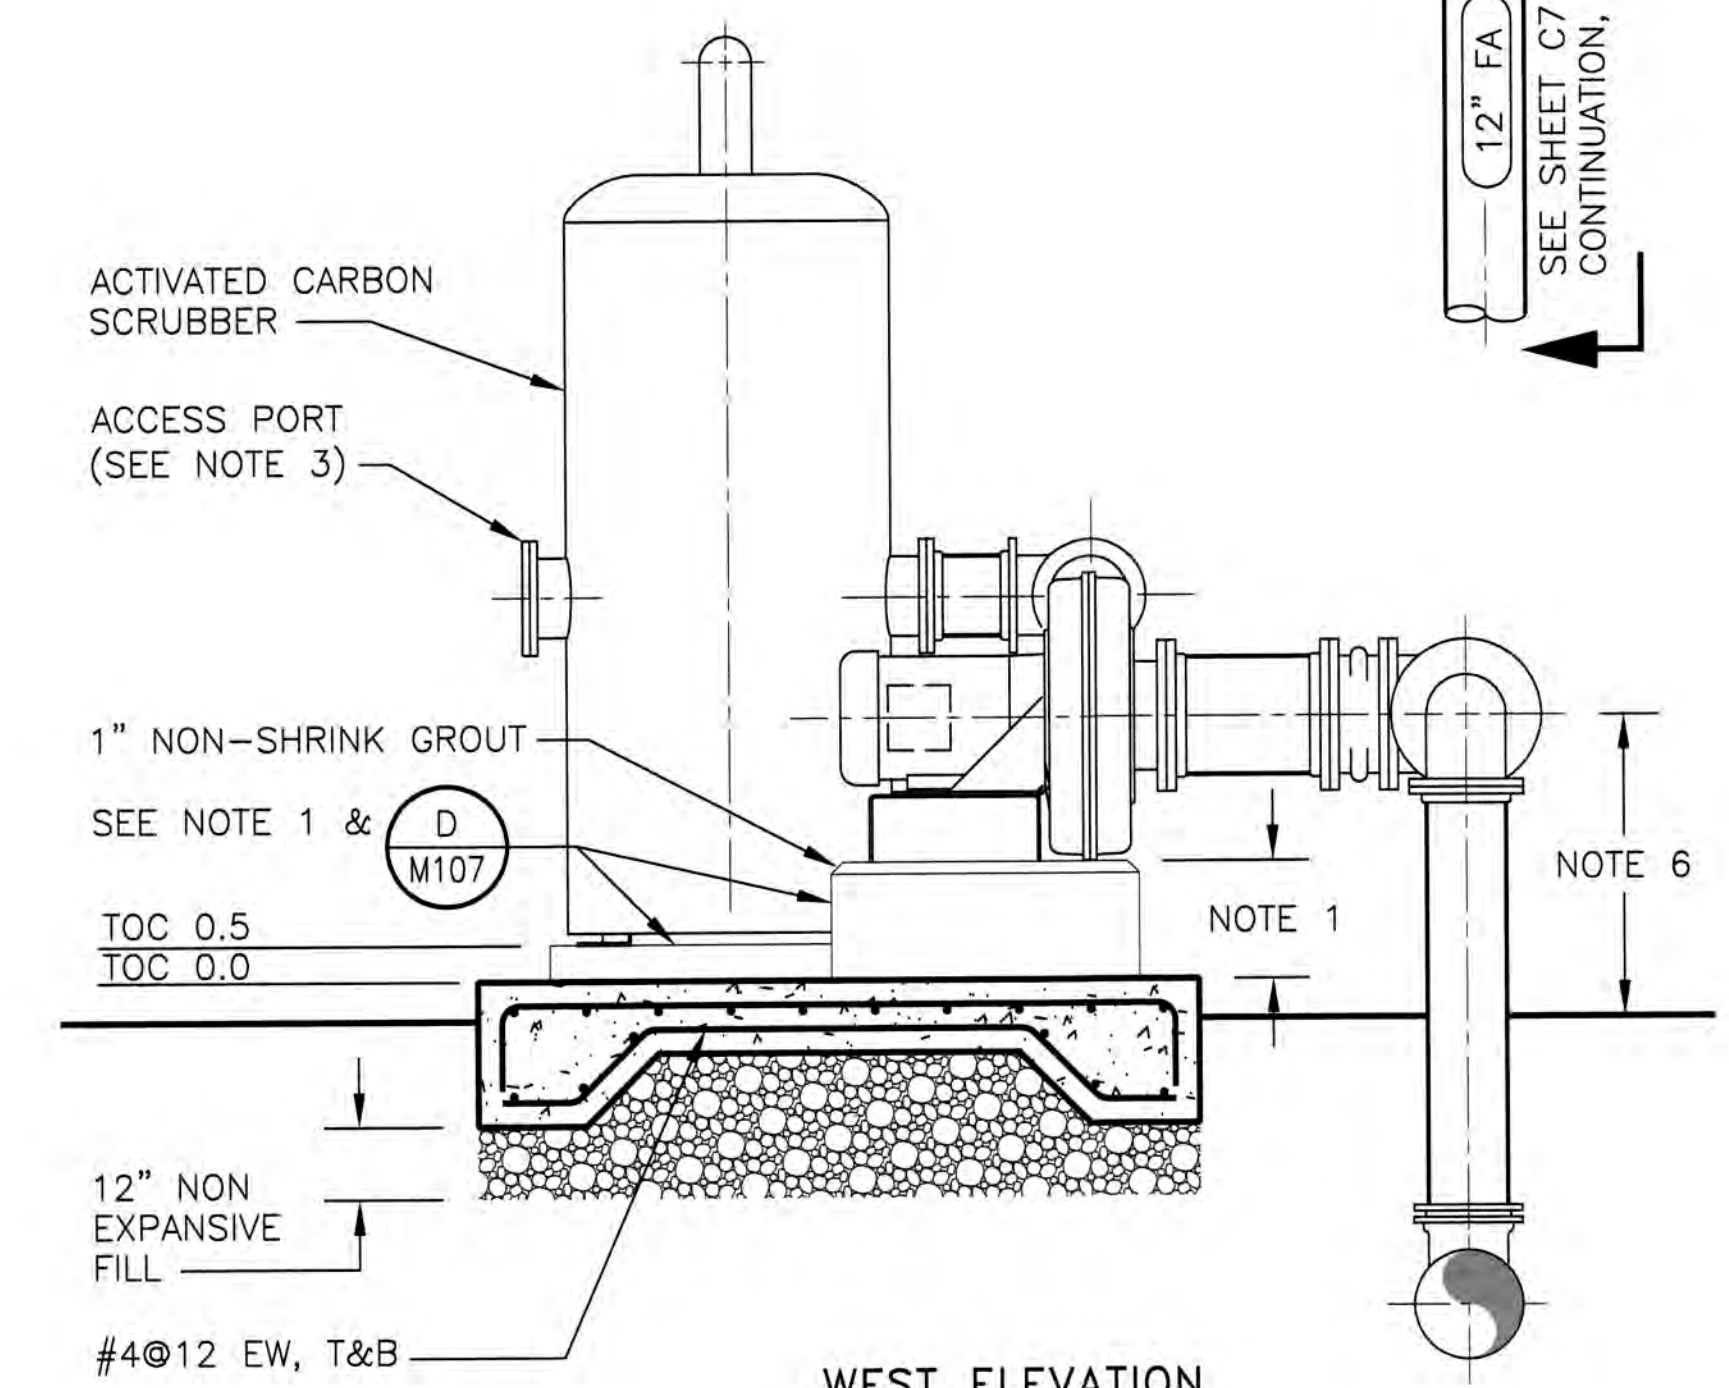

**WEST ELEVATION
FOUL AIR SCRUBBER
DETAIL A-A**
SCALE: 3/8"=1'-0"

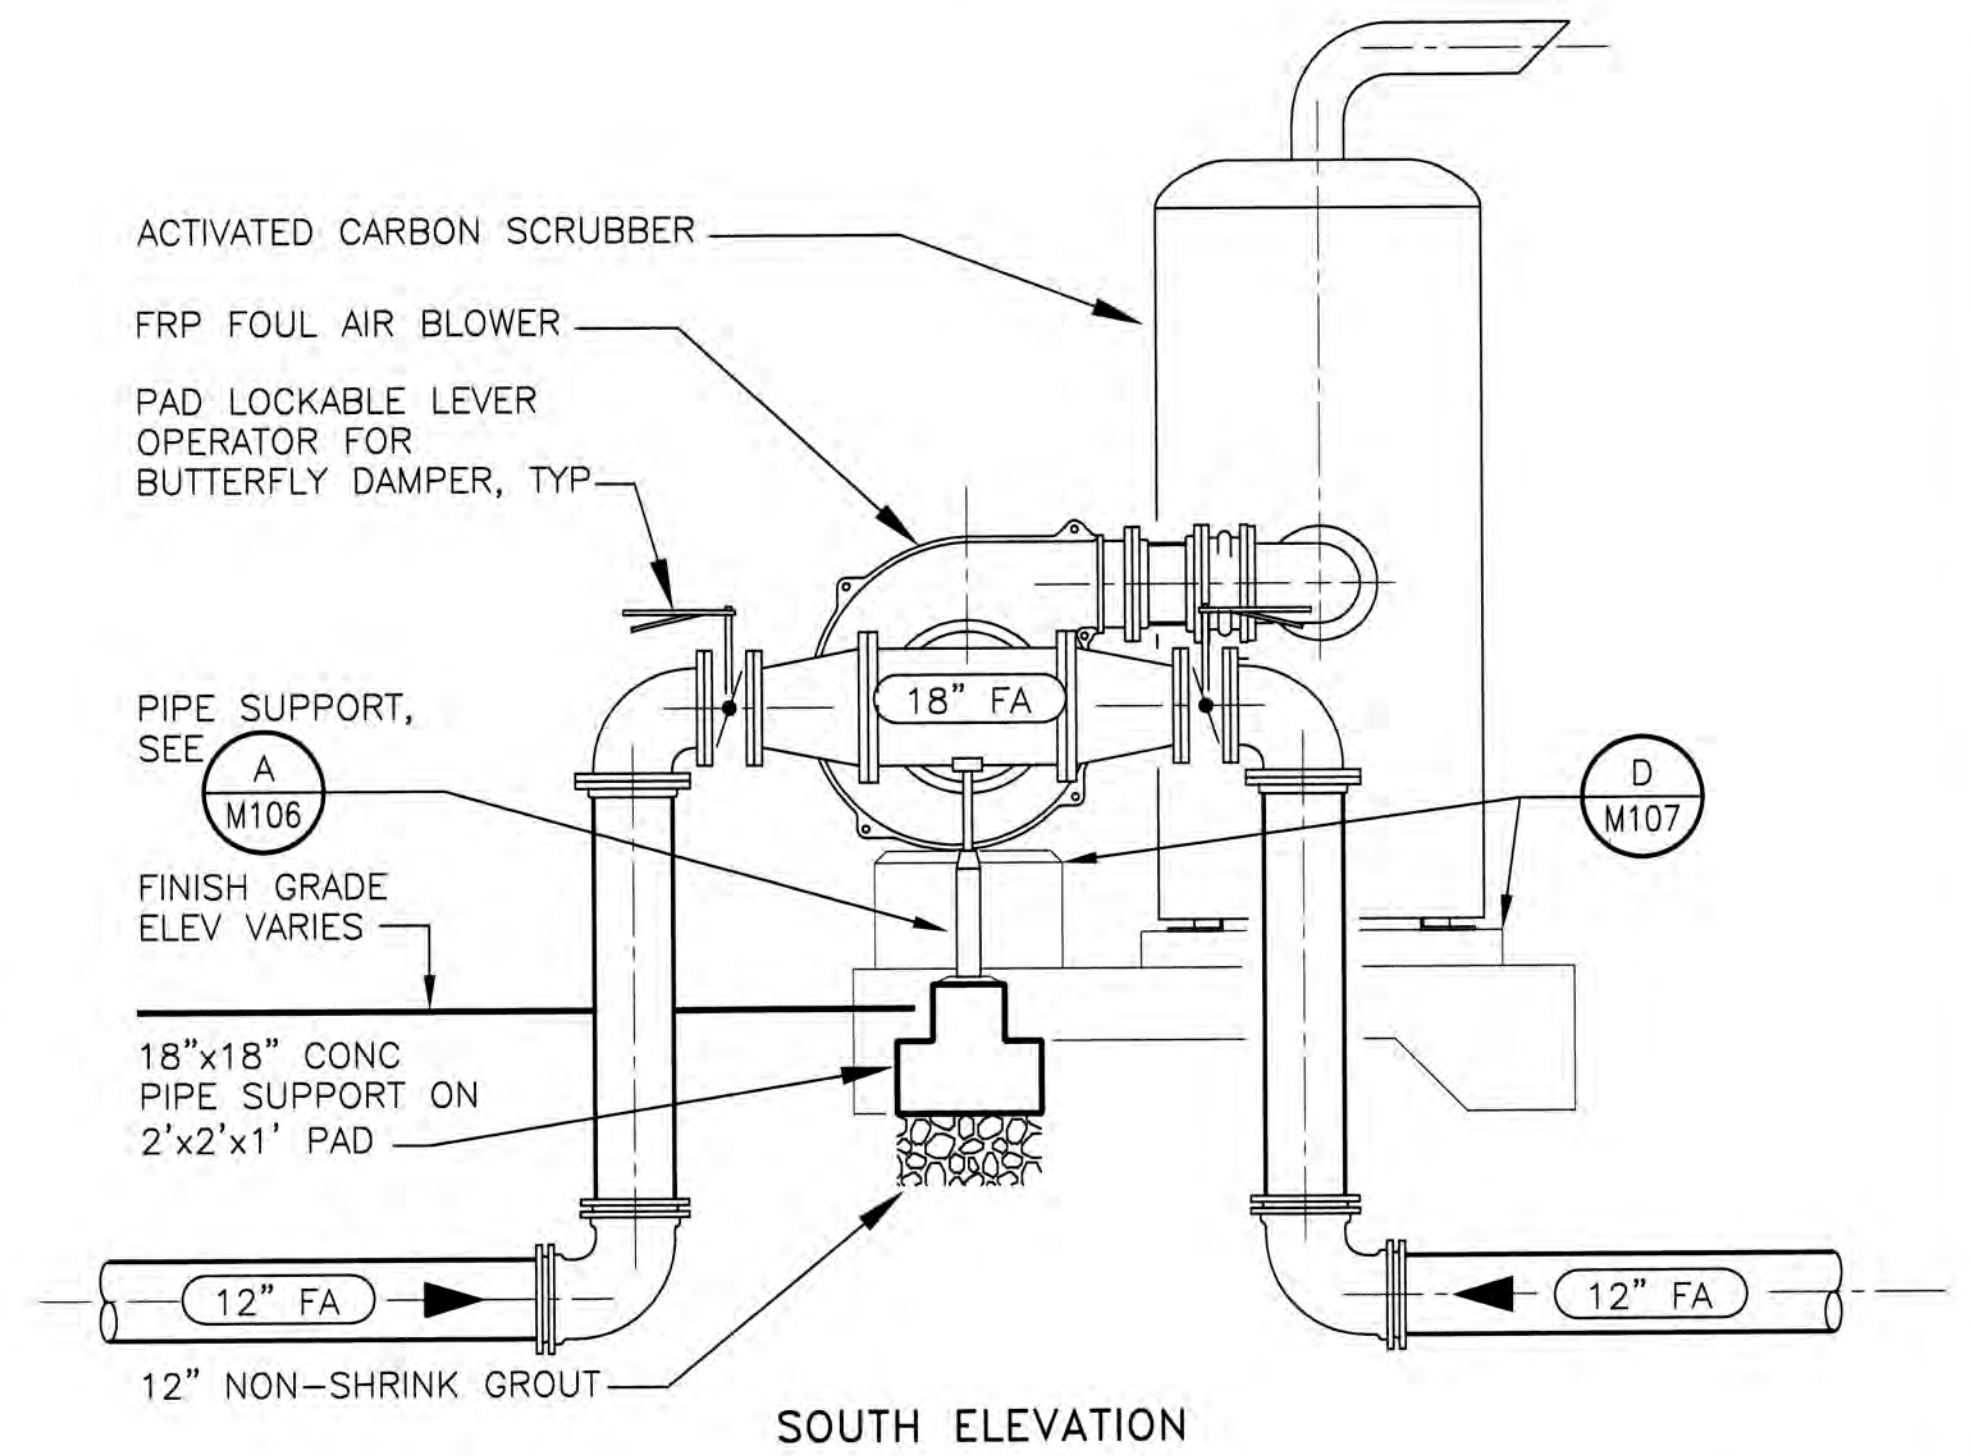

SOUTH ELEVATION

- NOTES:**
- COORDINATE BLOWER AND SCRUBBER PAD DIMENSIONS/LOCATION WITH EQUIPMENT FURNISHED AND INSTALLED. SIZE TO SUITE BLOWER/SCRUBBER PLUS 3" ALL AROUND
 - ANCHOR BLOWER AND SCRUBBER PER MANUFACTURER'S RECOMMENDATION. ANCHORAGE CALCULATIONS SHALL BE PREPARED BY A PROFESSIONAL ENGINEER
 - ALL FITTINGS AND APPURTENANCES ON SCRUBBER (REGENERATION PORTS, MEDIA REMOVAL PORTS, ETC.) ARE NOT SHOWN AND SHALL BE DESIGNED BY SCRUBBER MANUFACTURER
 - FA PIPING SHALL BE C900 PVC, VALVES AND APPURTENANCES SHALL BE PVC, FASTENERS SHALL BE TYPE 316 STAINLESS STEEL UNLESS OTHERWISE NOTED
 - BLOWER SHALL BE EQUIPPED WITH VIBRATION ISOLATION PER MANUFACTURER'S REQUIREMENTS
 - BLOWER/SCRUBBER CONNECTIONS SHALL BE DESIGNED BY SCRUBBER SUPPLIER
 - FOUL AIR PIPING SHALL BE FLANGED ABOVE GROUND, BELL & SPIGOT BELOW GROUND
 - ALL FASTENERS, ANCHORS METALLIC HARDWARE SHALL BE TYPE 316 STAINLESS STEEL

RECORD DRAWINGS		
14-Mile Slough Pump Station Upgrades		
PUMP STATION DETAILS 4		
DEPARTMENT OF MUNICIPAL UTILITIES CITY OF STOCKTON, CALIFORNIA		
SCALE: AS SHOWN	APPROVED BY: DATE: _____	SHEET No. _____
DESIGNED BY: PDF	ASSISTANT DIRECTOR, DEPT. OF MUNICIPAL UTILITIES	M108
DRAWN BY: RDB		52 of 89 SHEETS
CHECKED BY: GDH		PROJECT No. 293-00-05-01
RECORD DWG.:		

Underground Service Alert

TWO DAYS BEFORE YOU DIG

Call TOLL FREE: 1-800-642-2444

REFER TO BID SET FOR SIGNATURE

REV. No.	DISCRPTION	DATE	BY	Appr'd By
1	RECORD DRAWINGS	6/08	CLB	PDF
2				
3				
4				
5				
6				
7				


WEST YOST ASSOCIATES
Consulting Engineers

1260 Lake Boulevard
Suite 240
Davis, California 95616
(530) 756-5905
FAX (530) 756-5991

DOUBLE CONTAINED PIPE BELOW GRADE, SEE C7 & M401 FOR CONTINUATION OF FUEL OIL SUPPLY & RETURN

CHAIN LINK GATE

SEE NOTE 3

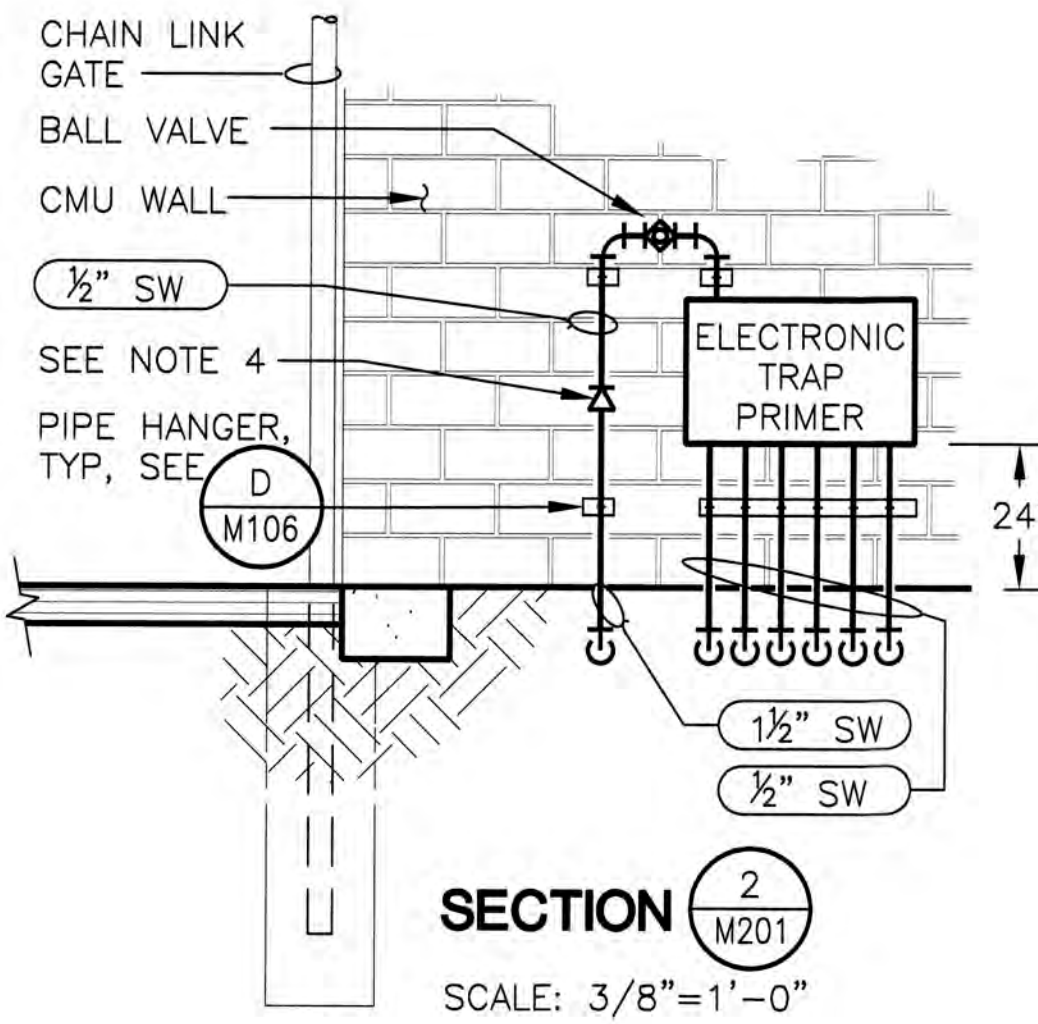


NOTES:

1. REDUCE FOS & FOR PIPING SIZE AS REQUIRED FOR CONNECTION TO GENERATOR & OIL SAFETY VALVE
2. MOUNT FOS & FOR PIPING TO INSIDE FACE OF GENERATOR ENCLOSURE
3. FOR CONTINUATION SEE YARD PIPING PLAN, SHEET C7
4. PROVIDE REDUCING COUPLING TO MATCH PIPE MATERIAL AS REQUIRED BY ELECTRONIC TRAP PRIMER. EXPOSED PVC SHALL BE COATED PER SPECS
5. IRRIGATION CONTROLLER CLOSE TO TRAP PRIMER
6. FOS & FOR CARRIER PIPES TO BE BLACK STEEL, ASTM A53 GRADE B
7. FOS & FOR PUMPS SUPPLIED BY 2000KW GENERATOR SUPPLIER



DIMENSION PER STRUCTURAL DRAWING


CONTROL BUILDING

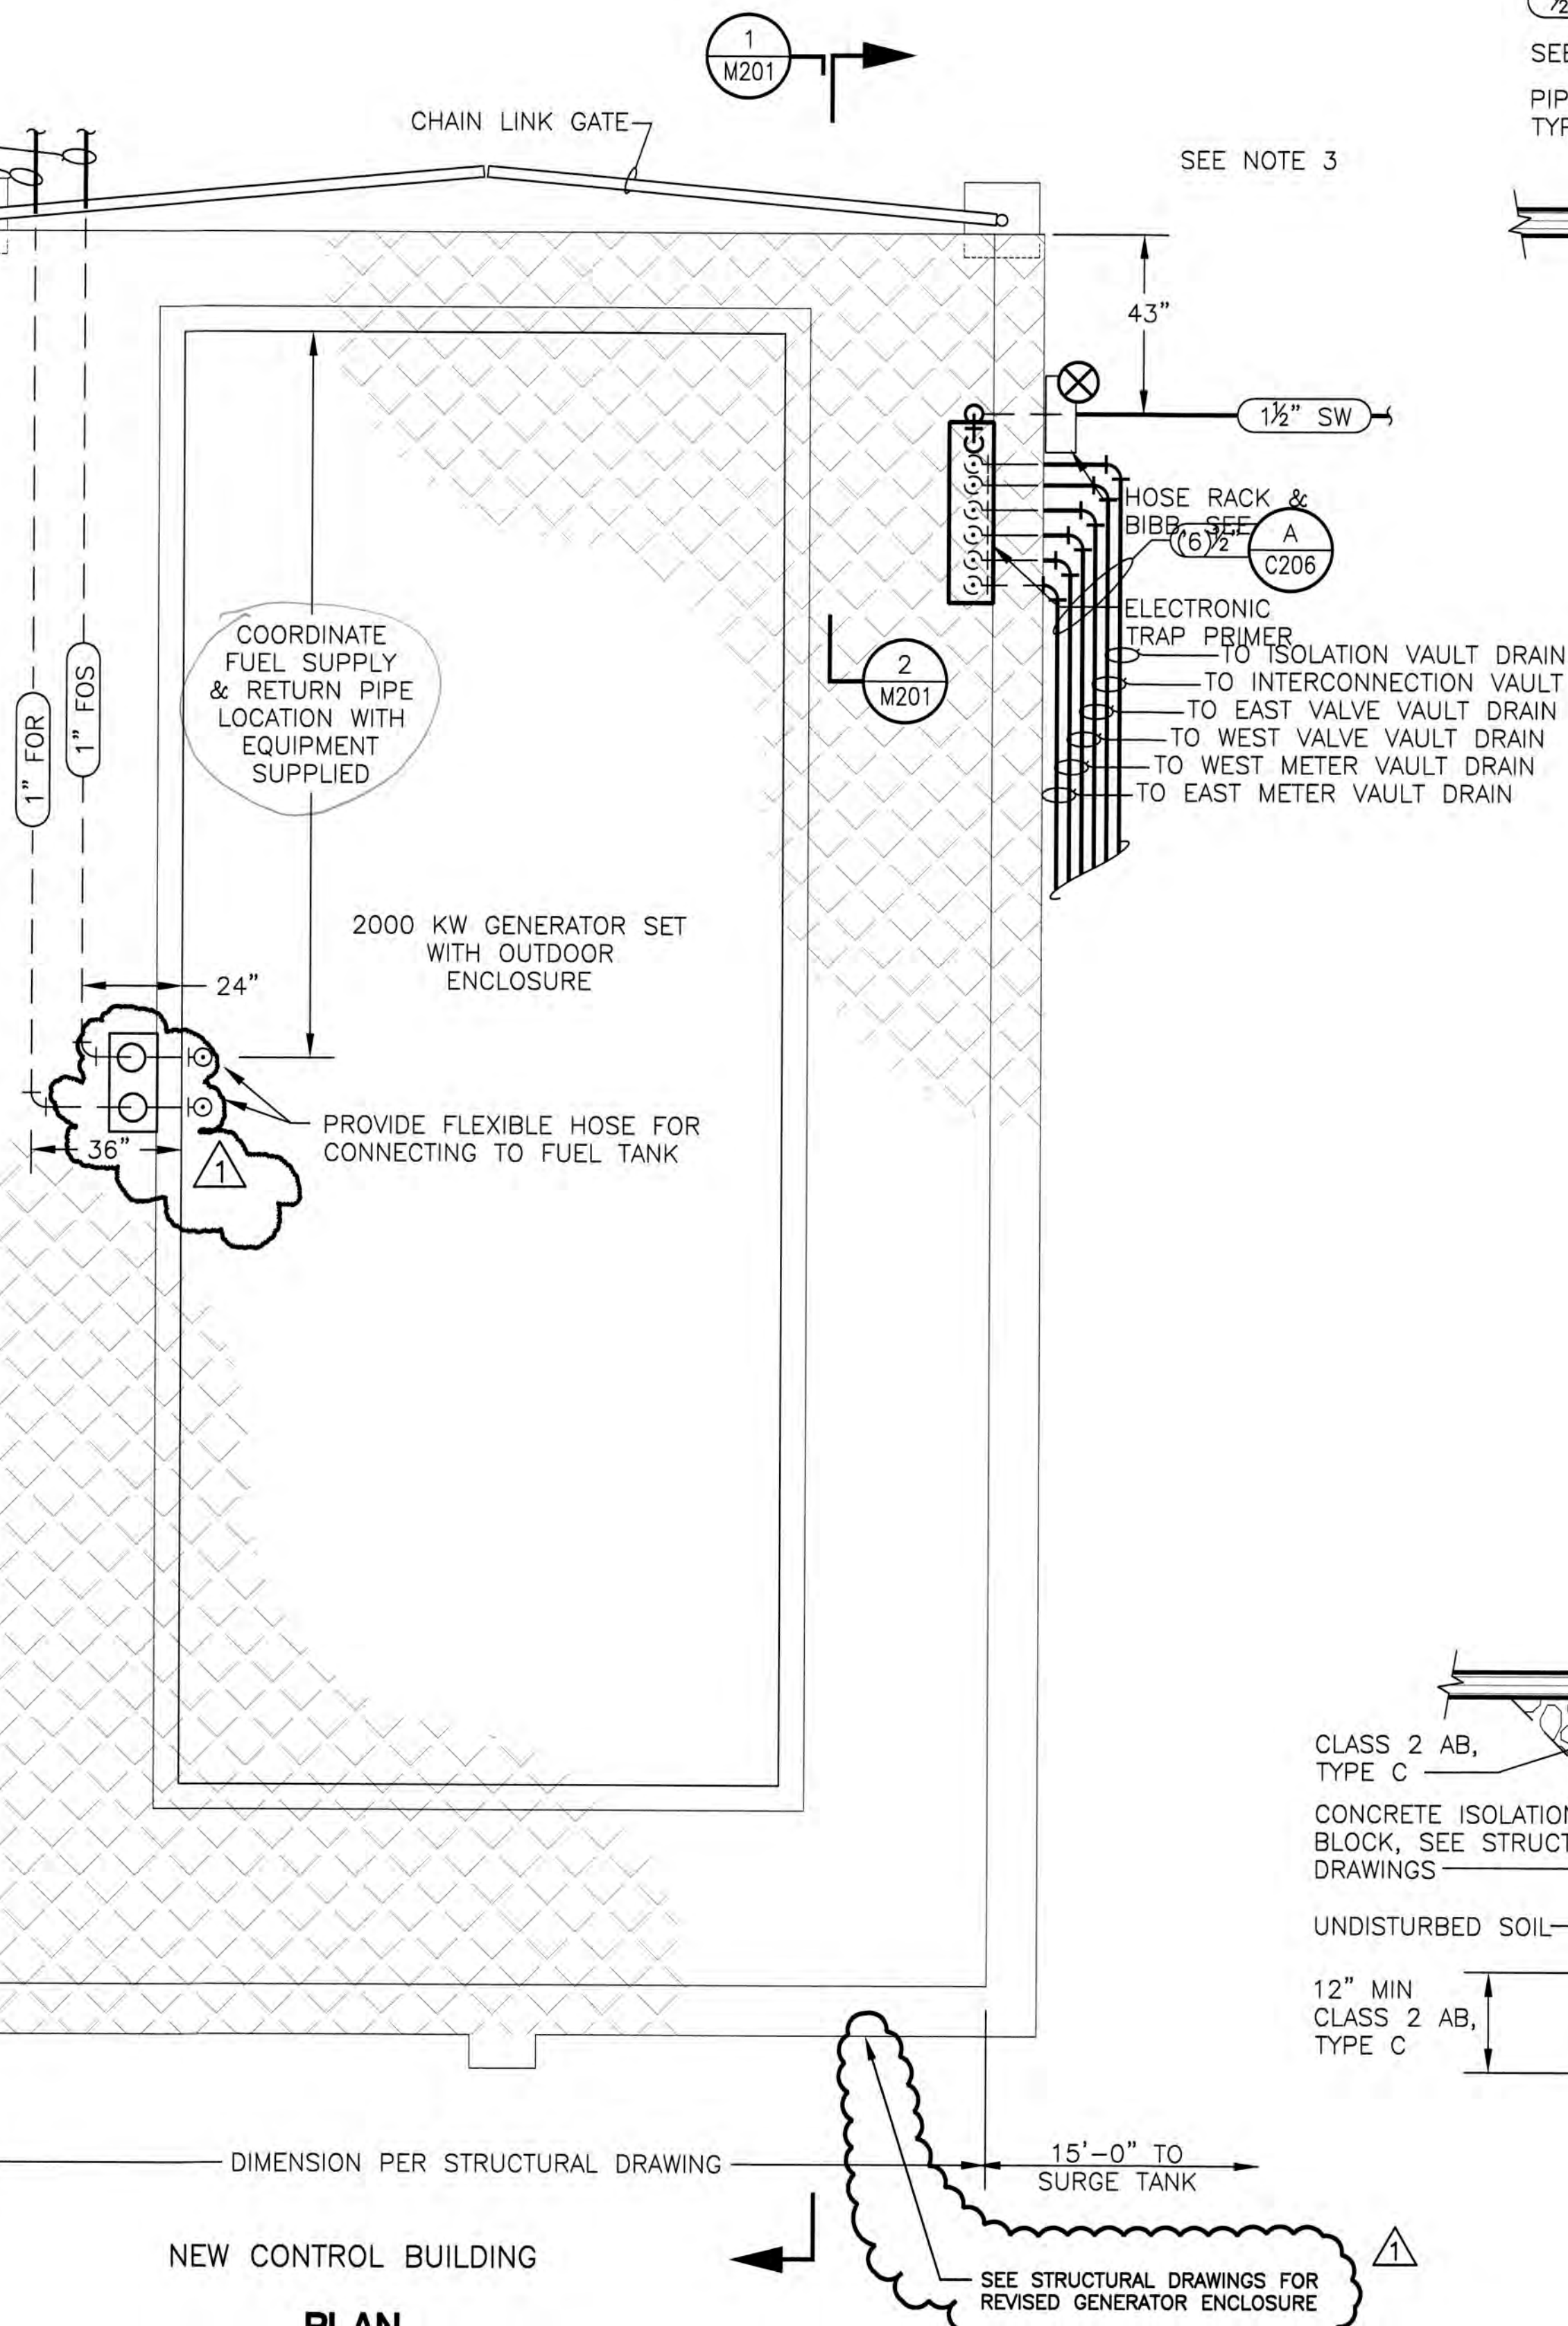

NEW CONTROL BUILDING

PLAN

SCALE: 3/8"=1'-0"

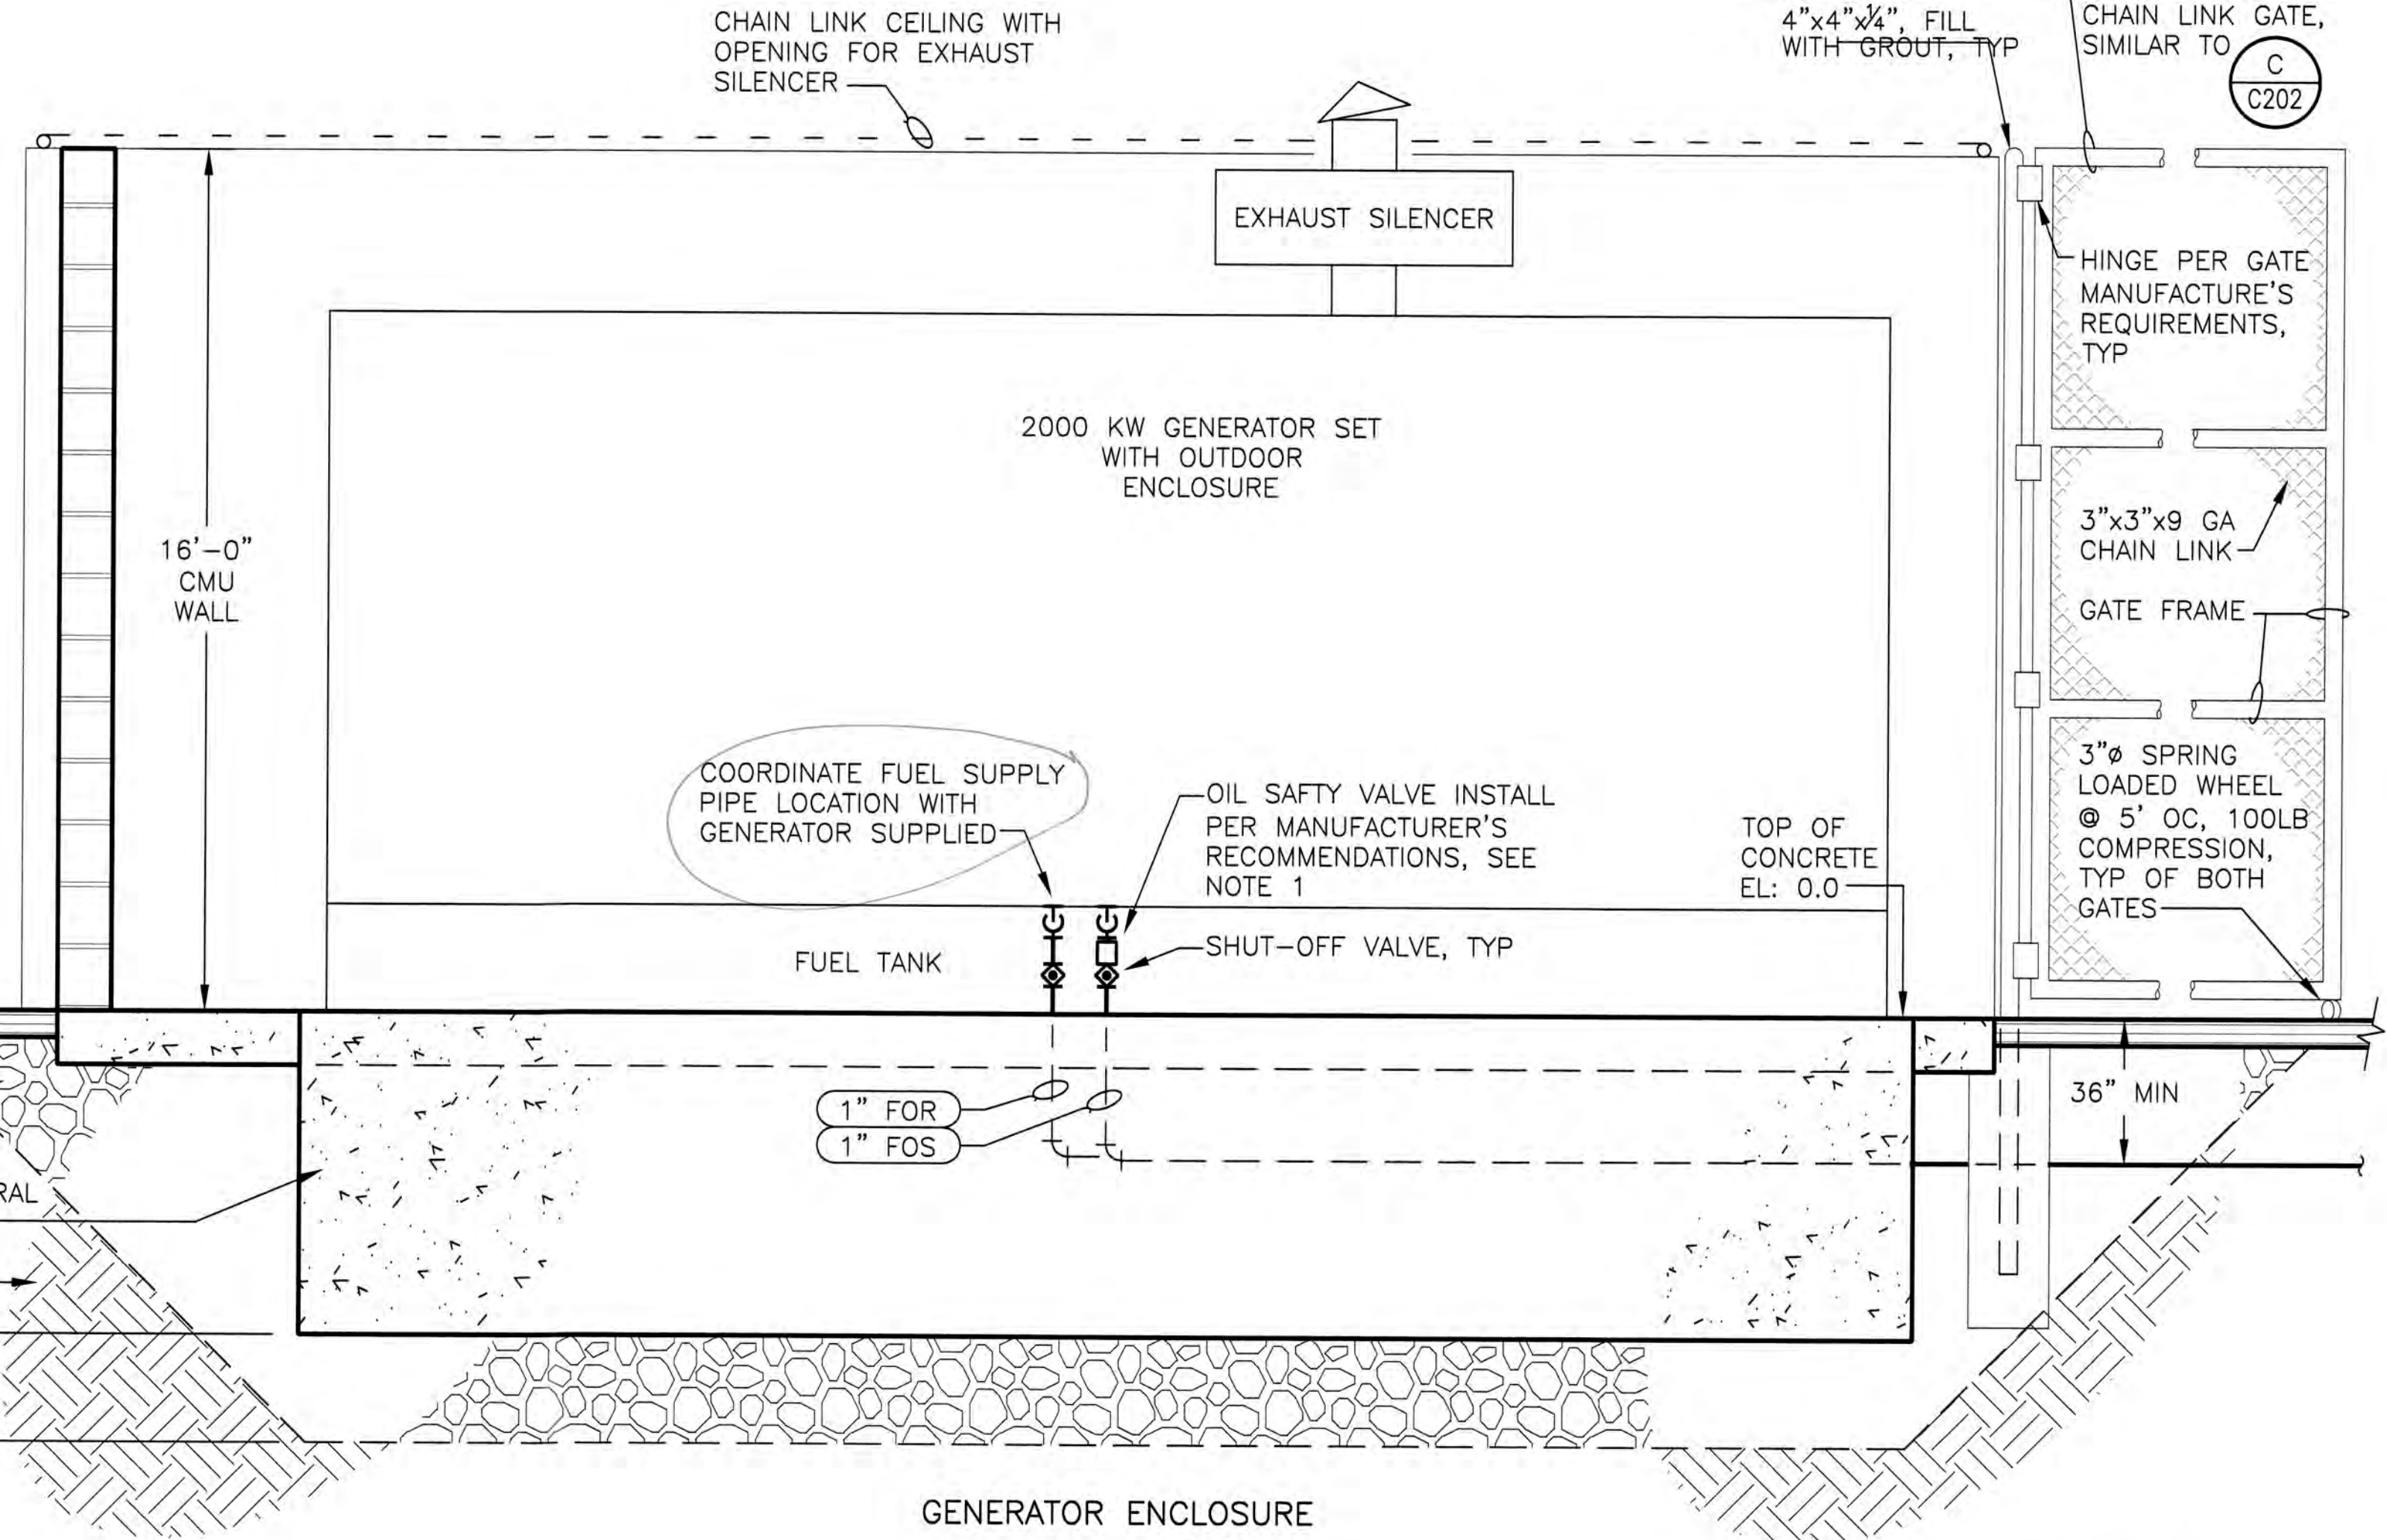

GENERATOR ENCLOSURE

SECTION 1 M201

SCALE: 3/8"=1'-0"

RECORD DRAWINGS

14-Mile Slough Pump Station Upgrades

CONTROL BUILDING
GENERATOR ENCLOSURE

DEPARTMENT OF MUNICIPAL UTILITIES
CITY OF STOCKTON, CALIFORNIA

SCALE: AS SHOWN	APPROVED BY: DATE: _____	SHEET No.
DESIGNED BY: PDF		M201
DRAWN BY: DTD		53 of 89 SHEETS
CHECKED BY: GDH	ASSISTANT DIRECTOR, DEPT. OF MUNICIPAL UTILITIES	PROJECT No. 293-00-05-01
RECORD Dwg.:		

Underground Service Alert

TWO DAYS BEFORE YOU DIG

Call TOLL FREE: 1-800-642-2444

BAR IS ONE INCH ON ORIGINAL DRAWING

IF NOT ONE INCH ON THIS SHEET, ADJUST SCALES ACCORDINGLY

REFER TO SET FOR SIGNATURE


REGISTERED PROFESSIONAL ENGINEER
No. 57272
D. J. PETERSON

REV. No.	DISCUSSION	DATE	BY	App'd By
1	RECORD DRAWINGS	6/08	CLB	PDF
2				
3				
4				
5				
6				
7				

WEST YOST ASSOCIATES
Consulting Engineers


1260 Lake Boulevard
Suite 240
Davis, California 95616
(530) 756-5905
FAX (530) 756-5991

N:\Clients\293 Spinos\00-05-01_14-MSFS Upgrades\CAD\Design\Submittals\293-0501M201.dwg 11-13-08 12:12:01 PM orimer


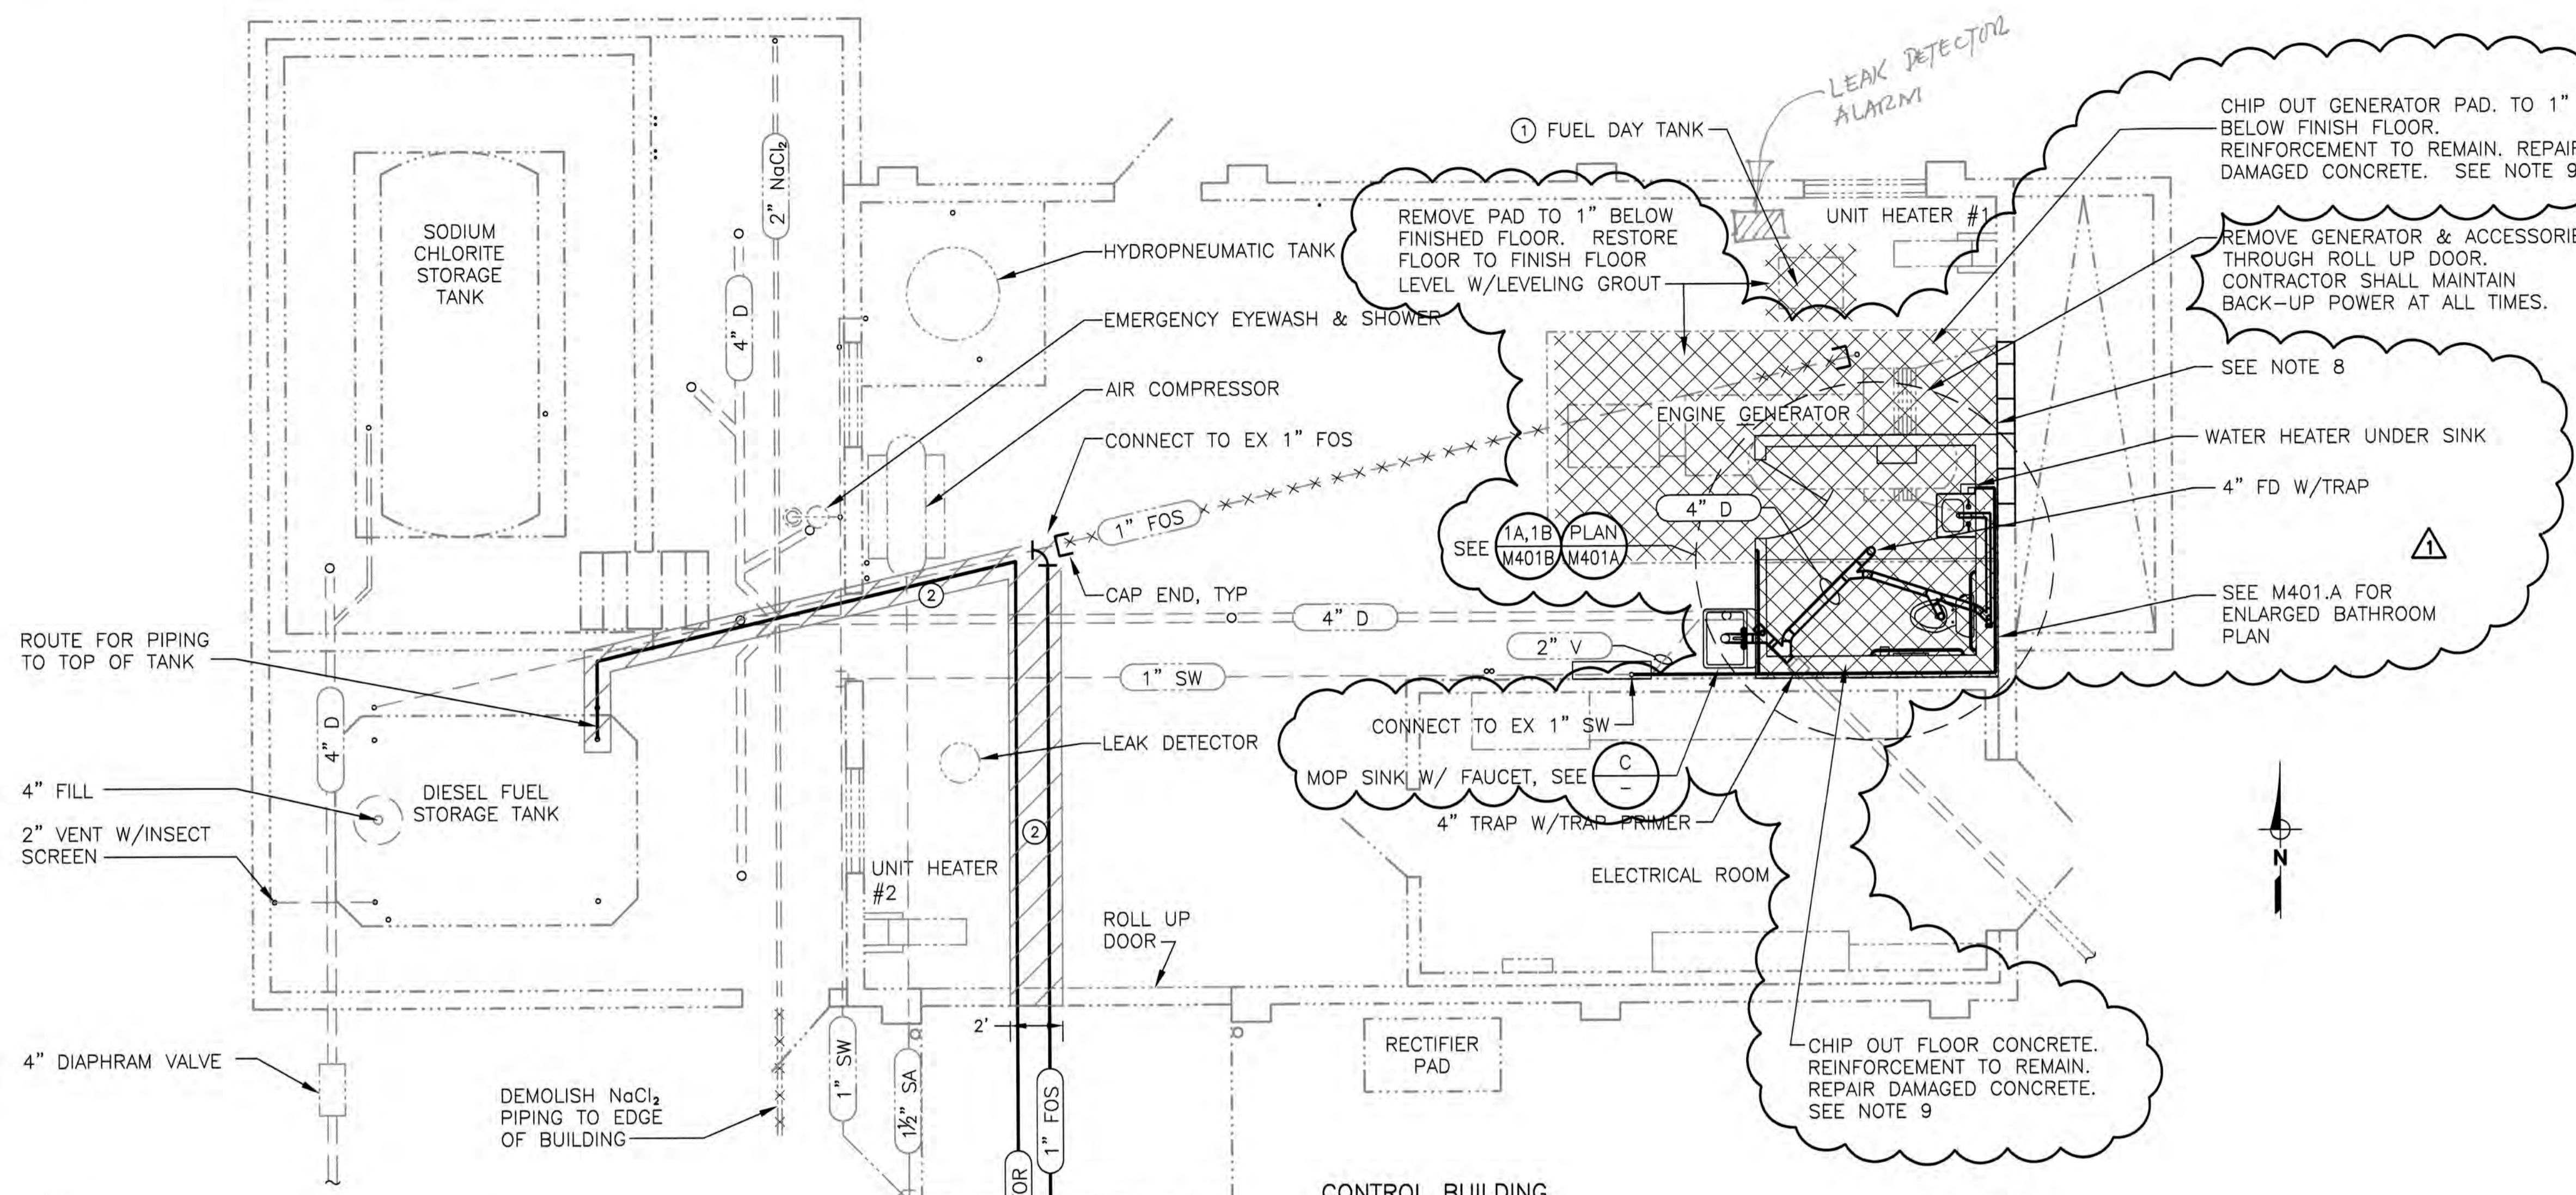


- NOTES:**
- CUTS IN CONCRETE SHALL BE STRAIGHT AND SMOOTH. WIDTH OF EXCAVATION SHALL BE TWO FEET OR LESS. ANY WATER USED IN THE BUILDING SHALL BE CONTAINED TO PREVENT DAMAGE TO EXISTING FACILITIES
 - THE EXISTING FOOTING SHALL NOT BE DISTURBED. HAND DIG AS REQUIRED TO COMPLETE WORK AROUND THE FOOTING
 - MATCH EXISTING FOUNDATION MATERIALS AND DIMENSIONS WHEN INSTALLING & BACKFILLING UNDER EXISTING CONCRETE. REPAIR REBAR AS DIRECTED BY THE ENGINEER
 - CONCRETE SHALL BE FINISHED TO MATCH EXISTING SURFACES AND SLOPES
 - PIPING CONTINUES ON C7
 - THE EXISTING LEAK DETECTION SYSTEM SHALL BE PRESERVED AND NEW FOS AND FOR PIPING SHALL BE INCORPORATED
 - NEW FOS AND FOR PIPING MAY BE INSTALLED IN THE SAME TRENCH
 - REMOVE LOUVER & EXISTING FRAME. CONTRACTOR TO DELIVER LOUVER TO CITY. LOUVER OPENING APPROXIMATELY 7' WIDE X 8' HIGH (CONTRACTOR TO FIELD VERIFY). FILL IN LOUVER OPENING W/CMU BLOCK TO MATCH EXISTING. SEE (B) W401A
 - REPLACE REMOVED CONCRETE TO ±1 INCH BELOW FINISH FLOOR WITH CONCRETE. DAMAGED CONCRETE FROM ±1 INCH BELOW FINISH FLOOR TO TOP OF FLOOR, SHALL BE REPAIRED WITH FLOOR LEVELING GROUT. SLOPE FLOOR IN BATHROOM TO 4" FD.

- KEYNOTES:**
- REMOVE & SALVAGE
 - SAWCUT & REMOVE EXISTING CONCRETE SLAB. REPAIR TO SAME DEPTH & FINISH UPON COMPLETION

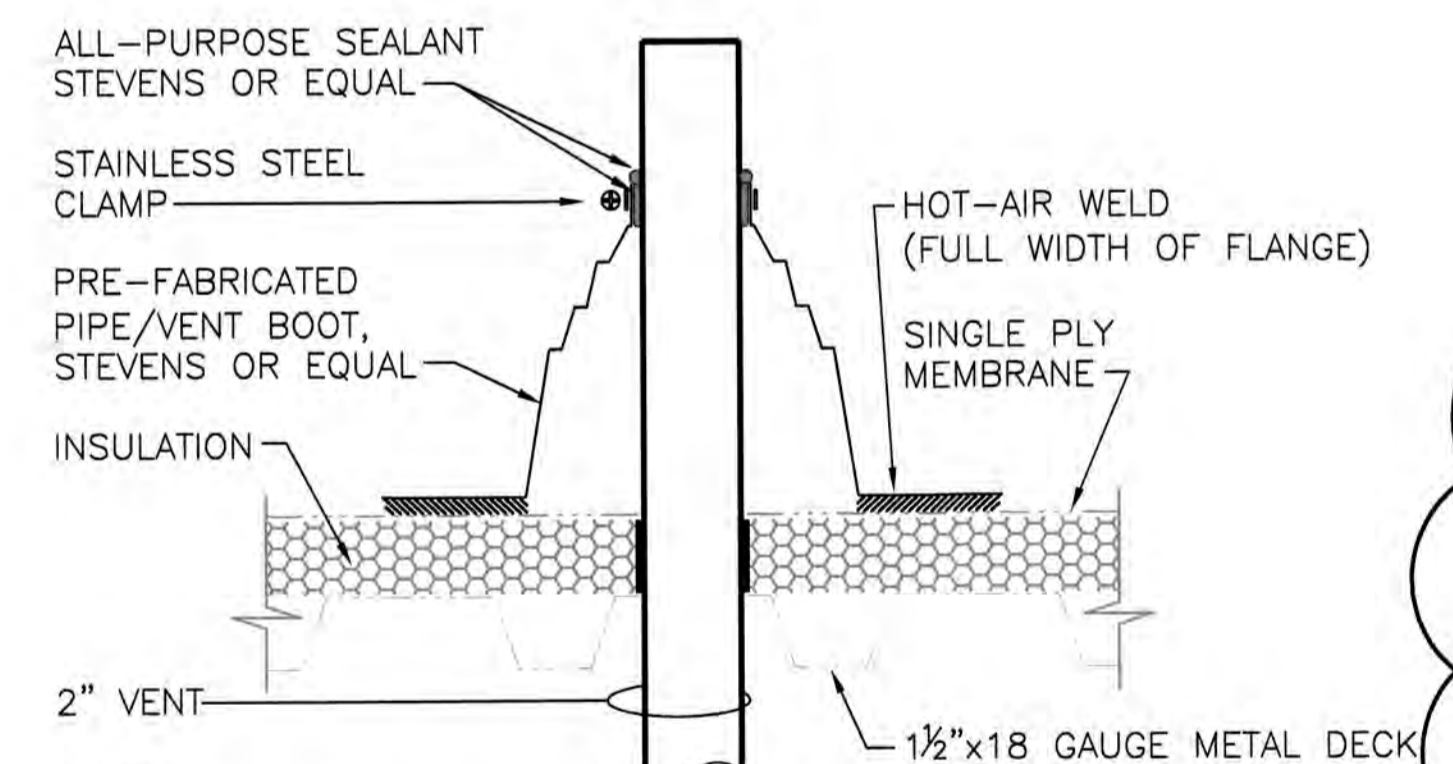

- NOTES:**
- PRIOR TO HOT-AIR WELDING, CLEAN AND PREPARE THE WELD AREA OF THE BOOT AND ROOFING MEMBRANE USING PROCEDURES OUTLINED IN THE BOOT MANUFACTURERS SPECIFICATION
 - INSULATION AND FIELD MEMBRANE MUST BE CUT TIGHTLY AROUND VENT PIPE BASE

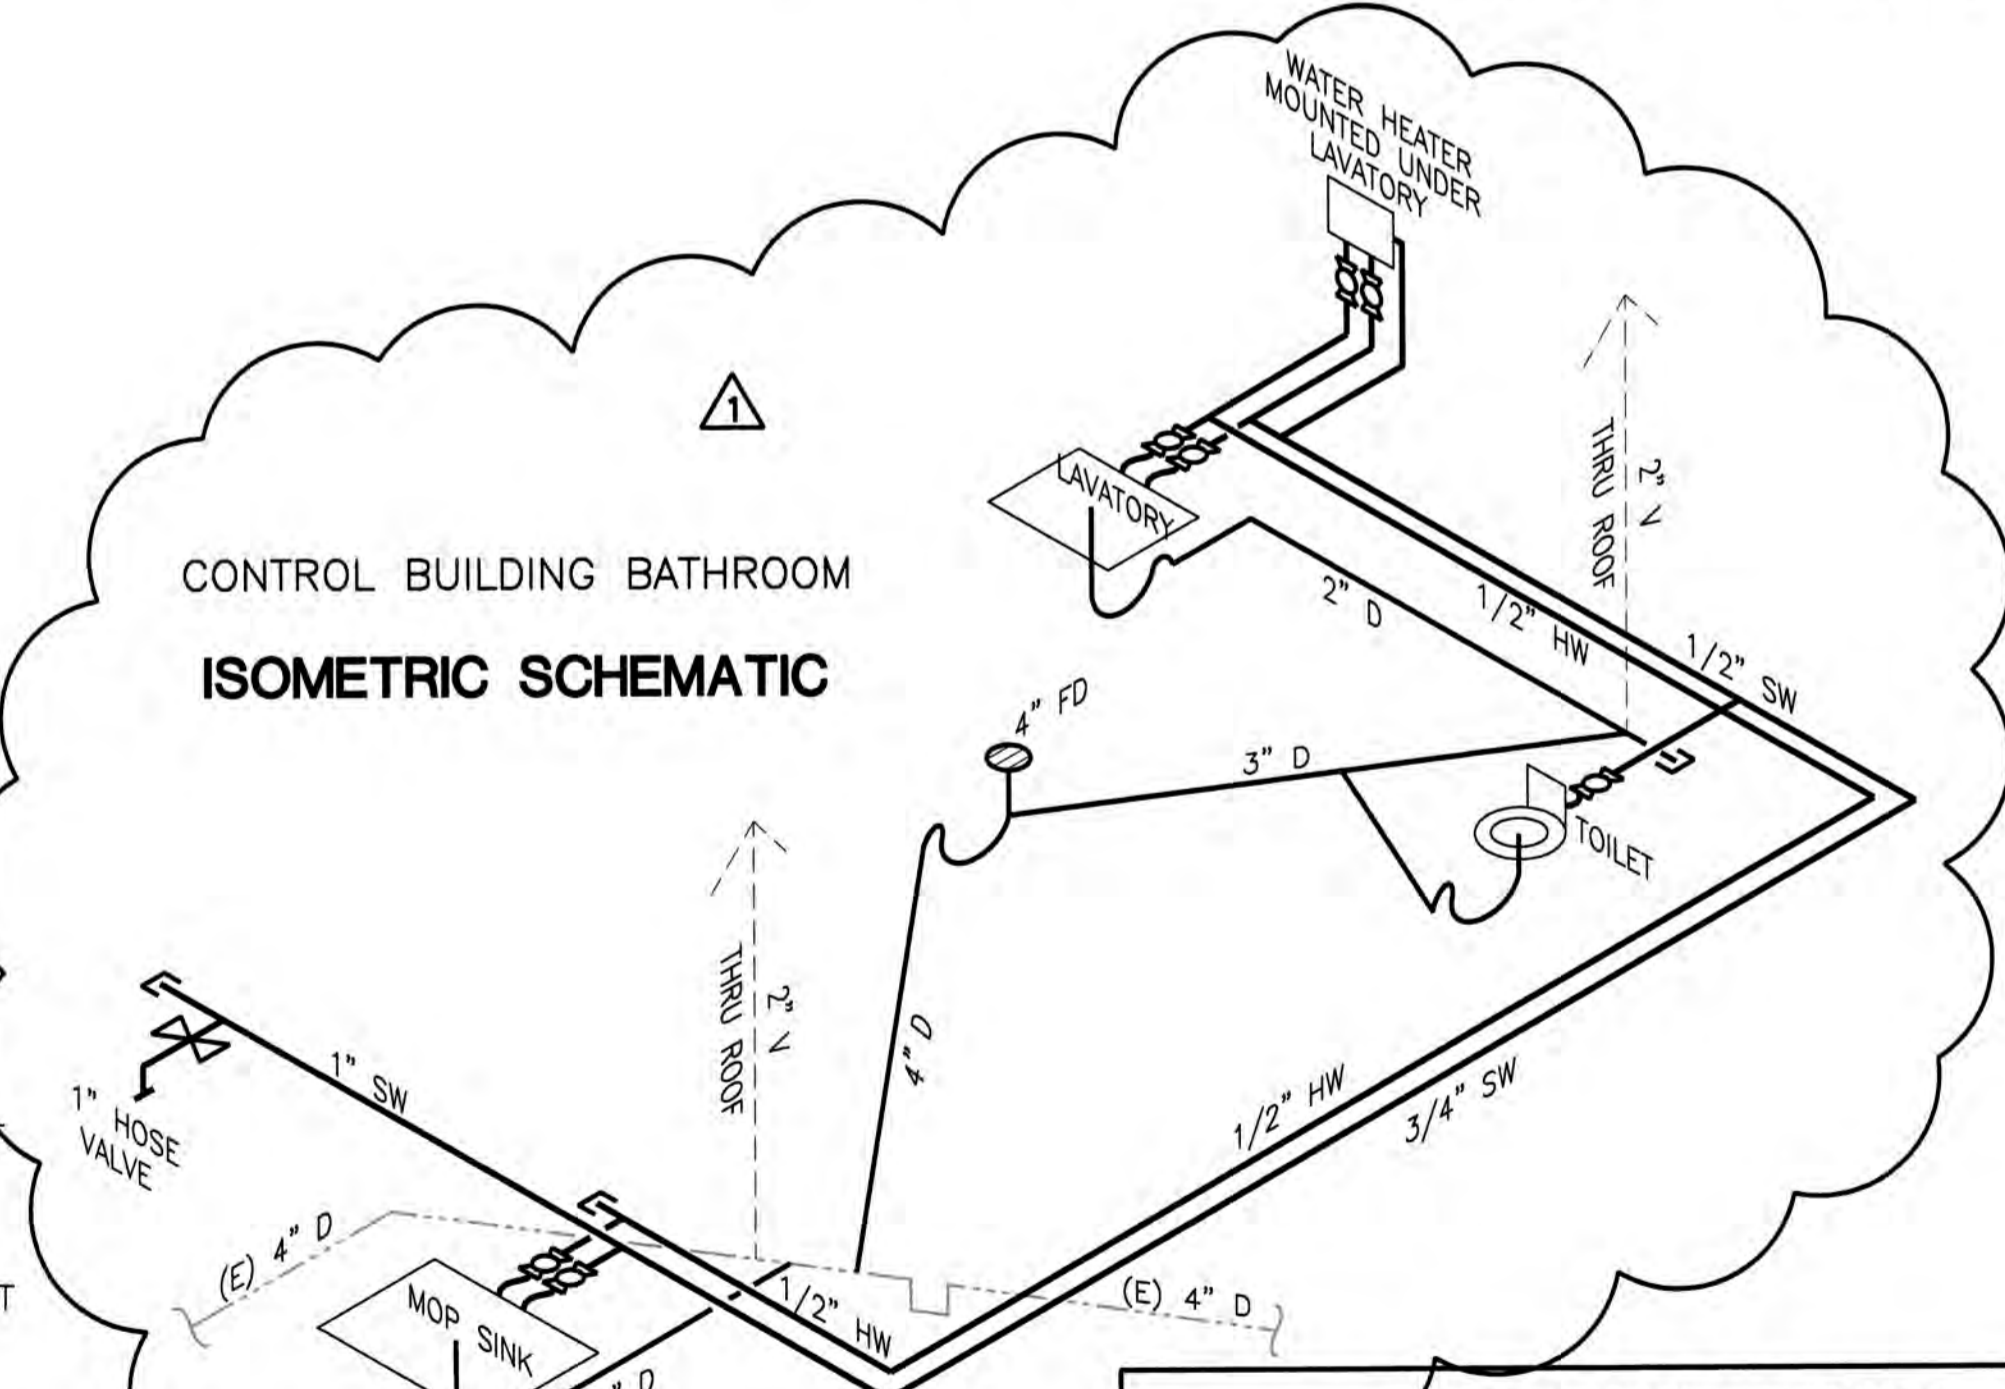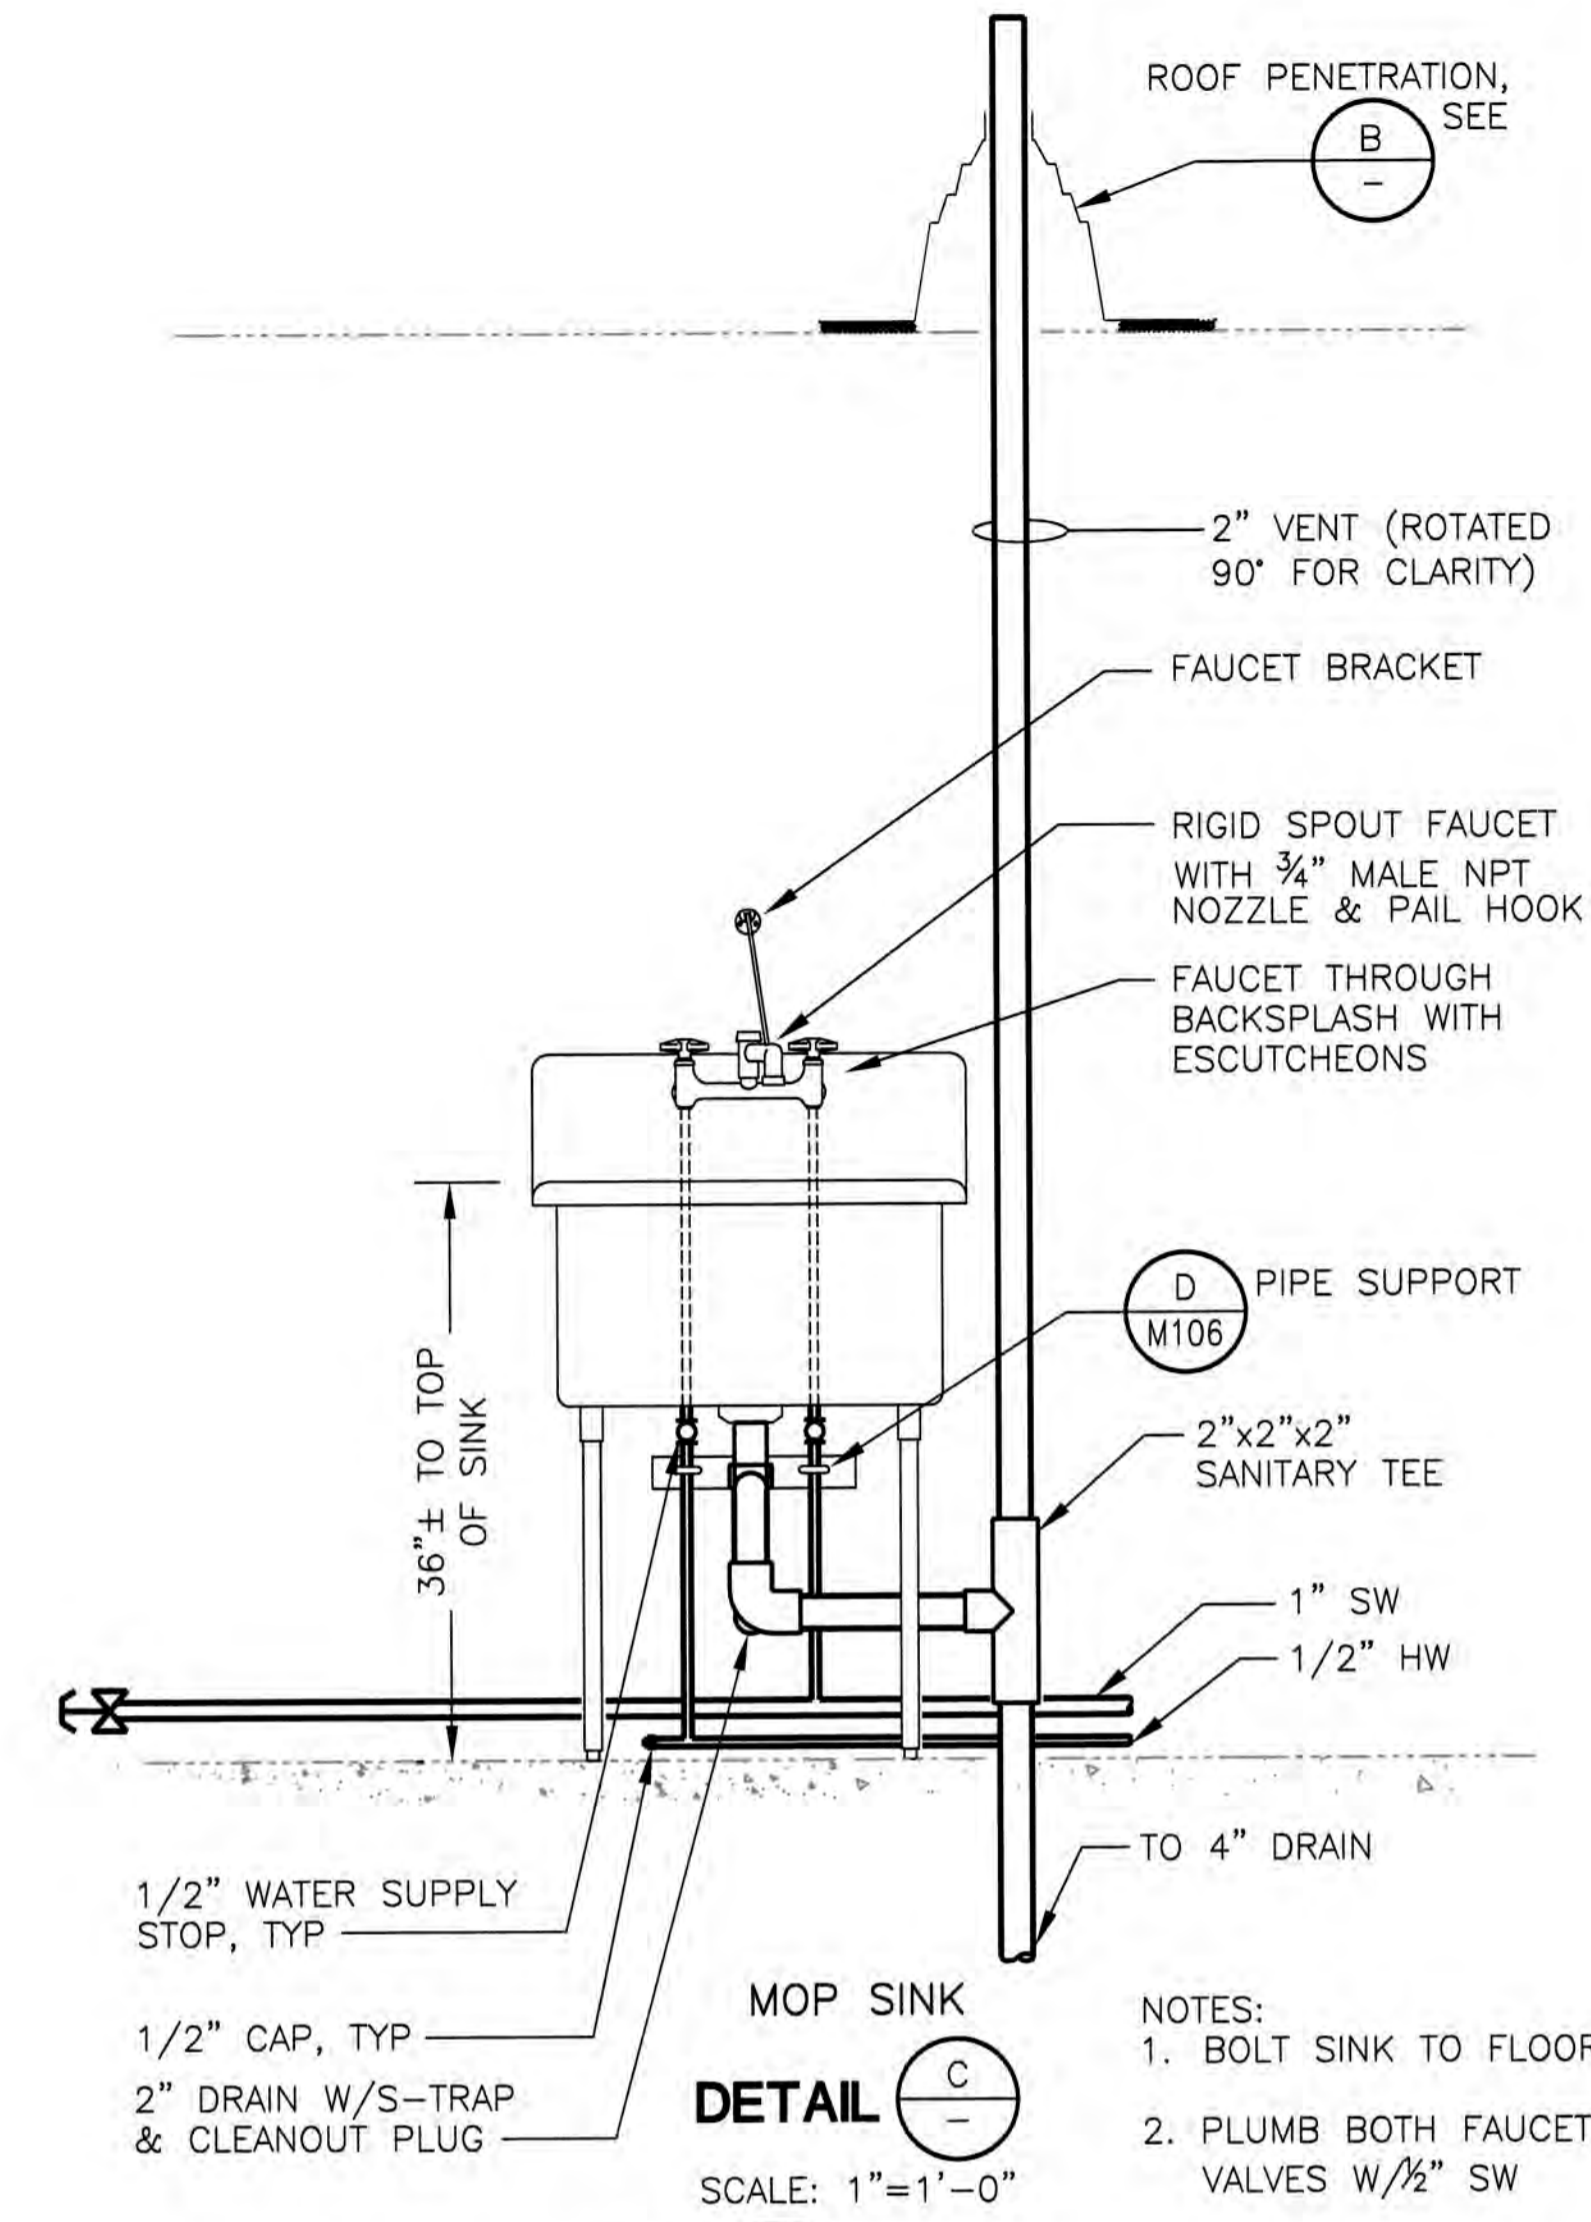

BAR IS ONE INCH ON ORIGINAL DRAWING
IF NOT ONE INCH ON THIS SHEET, ADJUST SCALES ACCORDINGLY


REFER TO SET FOR SIGNATURE

REV. No.	DISCRIPTION	DATE	BY	Aprv'd By
1	BATHROOM DETAILS	7/5/08	OS	
2	RECORD DRAWINGS	8/08/08	MAH	PDF
3				
4				
5				
6				
7				


WEST YOST ASSOCIATES
Consulting Engineers
1260 Lake Boulevard Suite 240
Davis, California 95616
(530) 756-5905
FAX (530) 756-5991

RECORD DRAWINGS		
14-Mile Slough Pump Station Upgrades		
EXISTING CONTROL BUILDING		
DEPARTMENT OF MUNICIPAL UTILITIES CITY OF STOCKTON, CALIFORNIA		
SCALE: AS SHOWN	APPROVED BY: DATE: _____	SHEET No. M401.1
DESIGNED BY: PDF		54 of 89 SHEETS
DRAWN BY: DTD		PROJECT No. 293-00-05-01
CHECKED BY: GDH	ASSISTANT DIRECTOR, DEPT. OF MUNICIPAL UTILITIES	
RECORD Dwg.:		


R:\Client\293_Spokane\00-05-01_14-MSPS_Upgrade\CAD\Design\Utilities\293-0501M401.dwg 11-13-08 12:24:29 PM oreimer

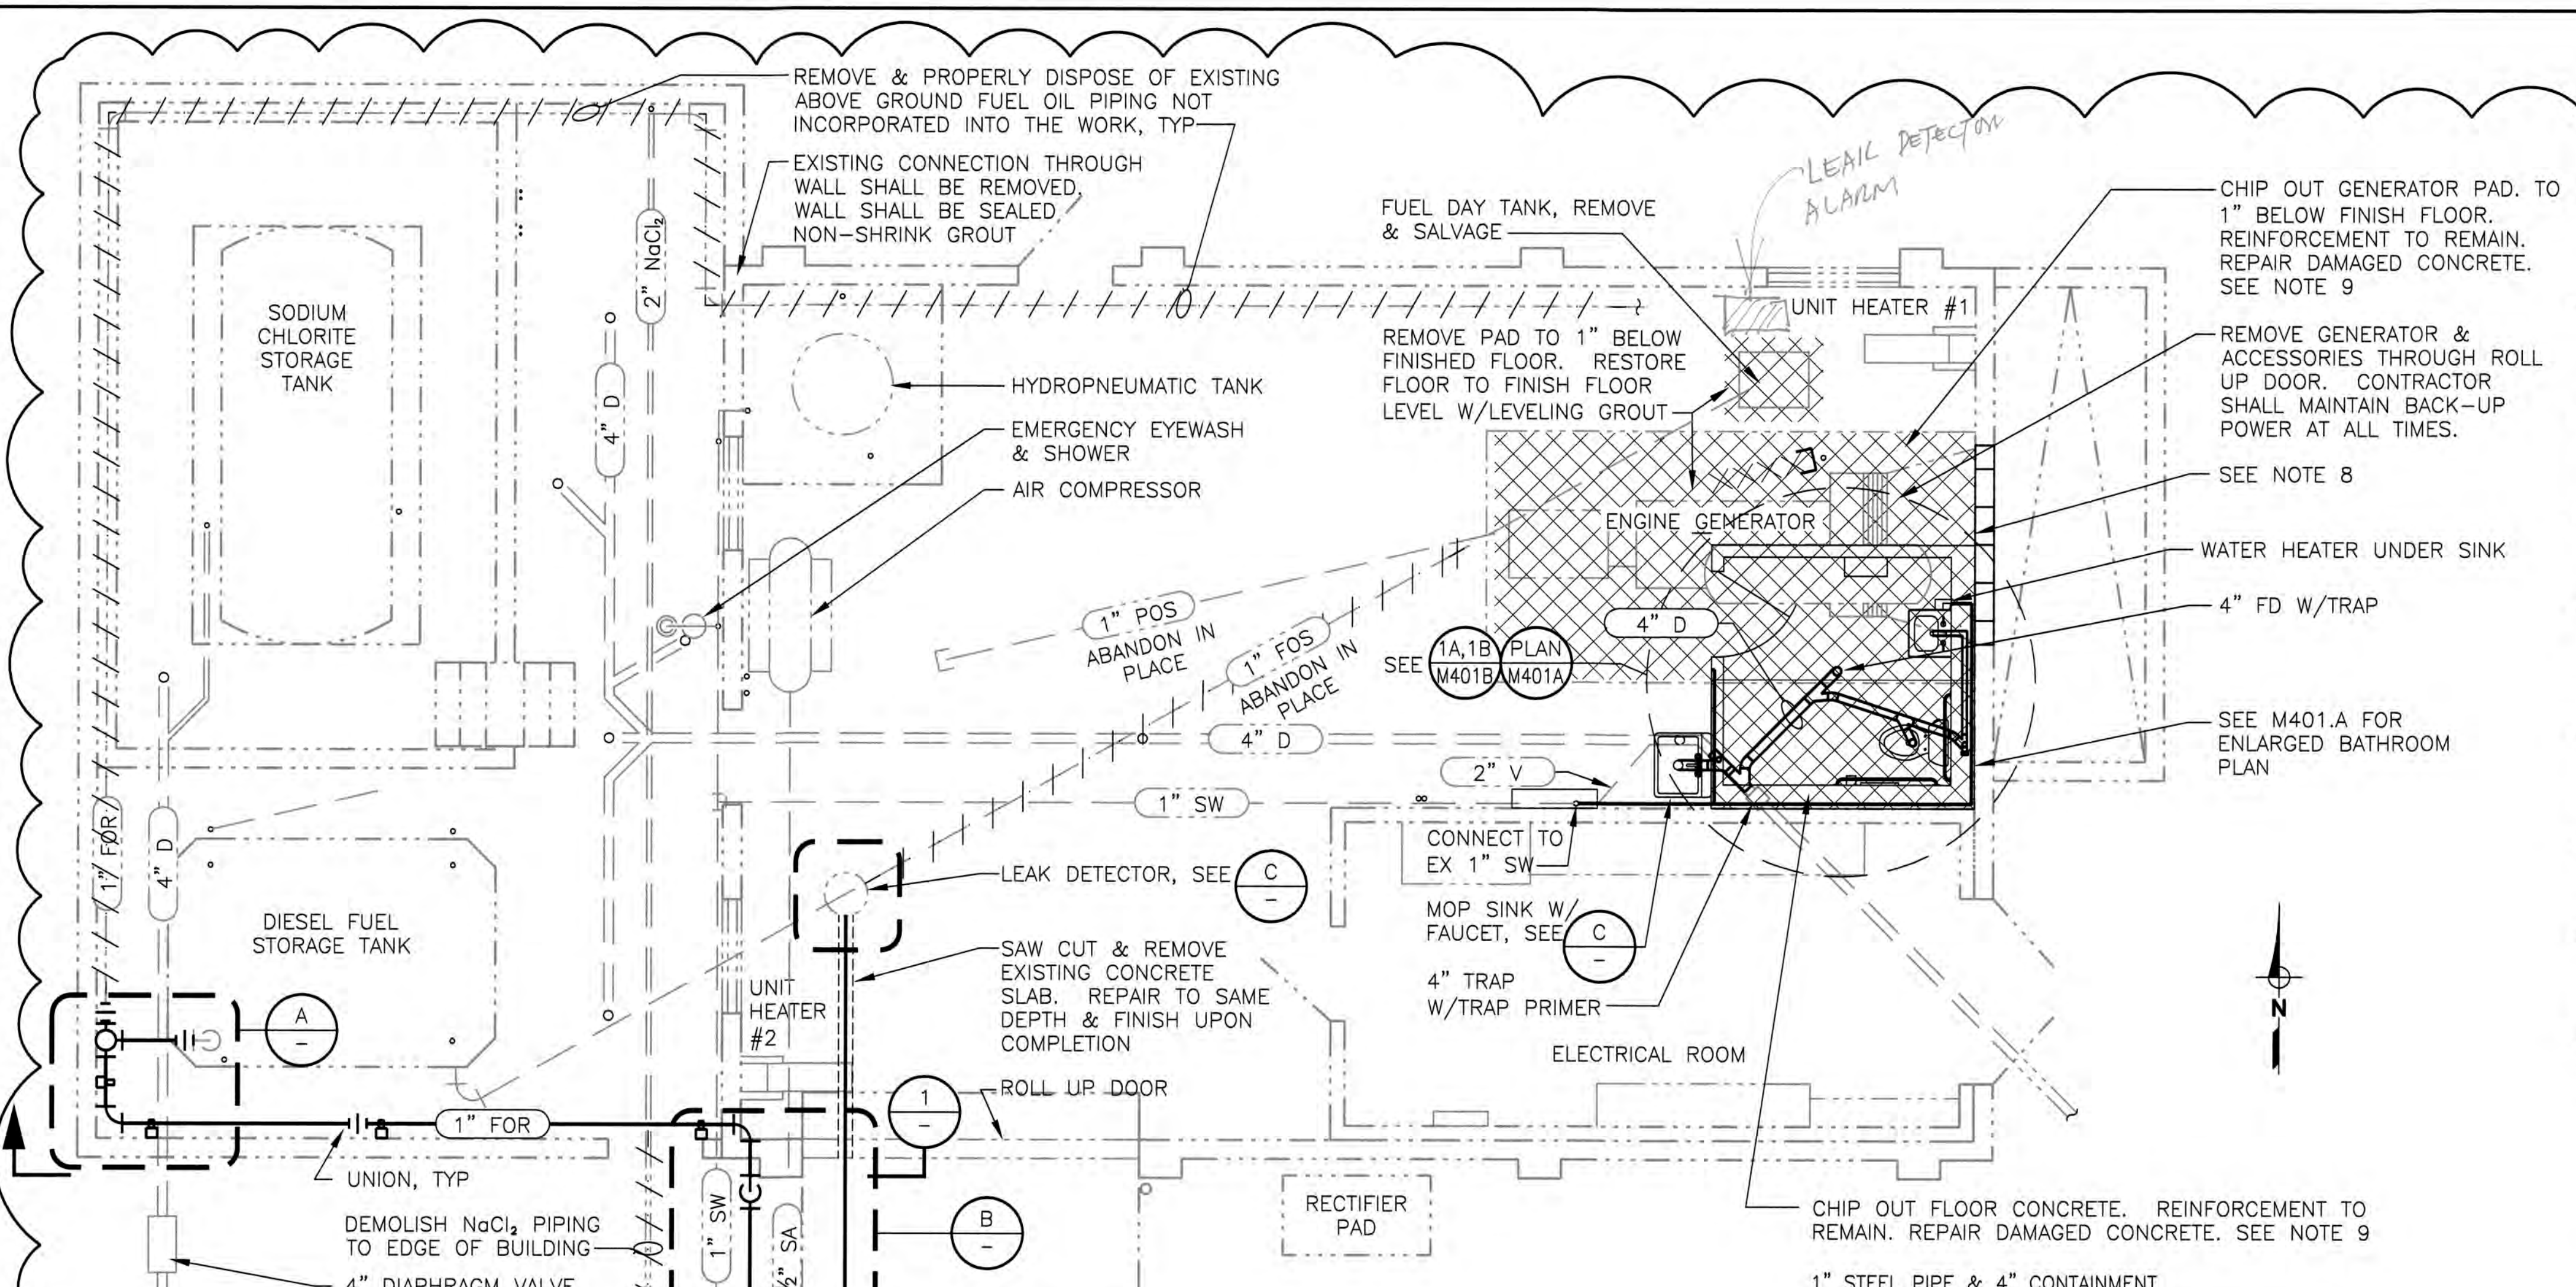


CONTROL BUILDING PLAN
SCALE: 1/4"=1'-0"

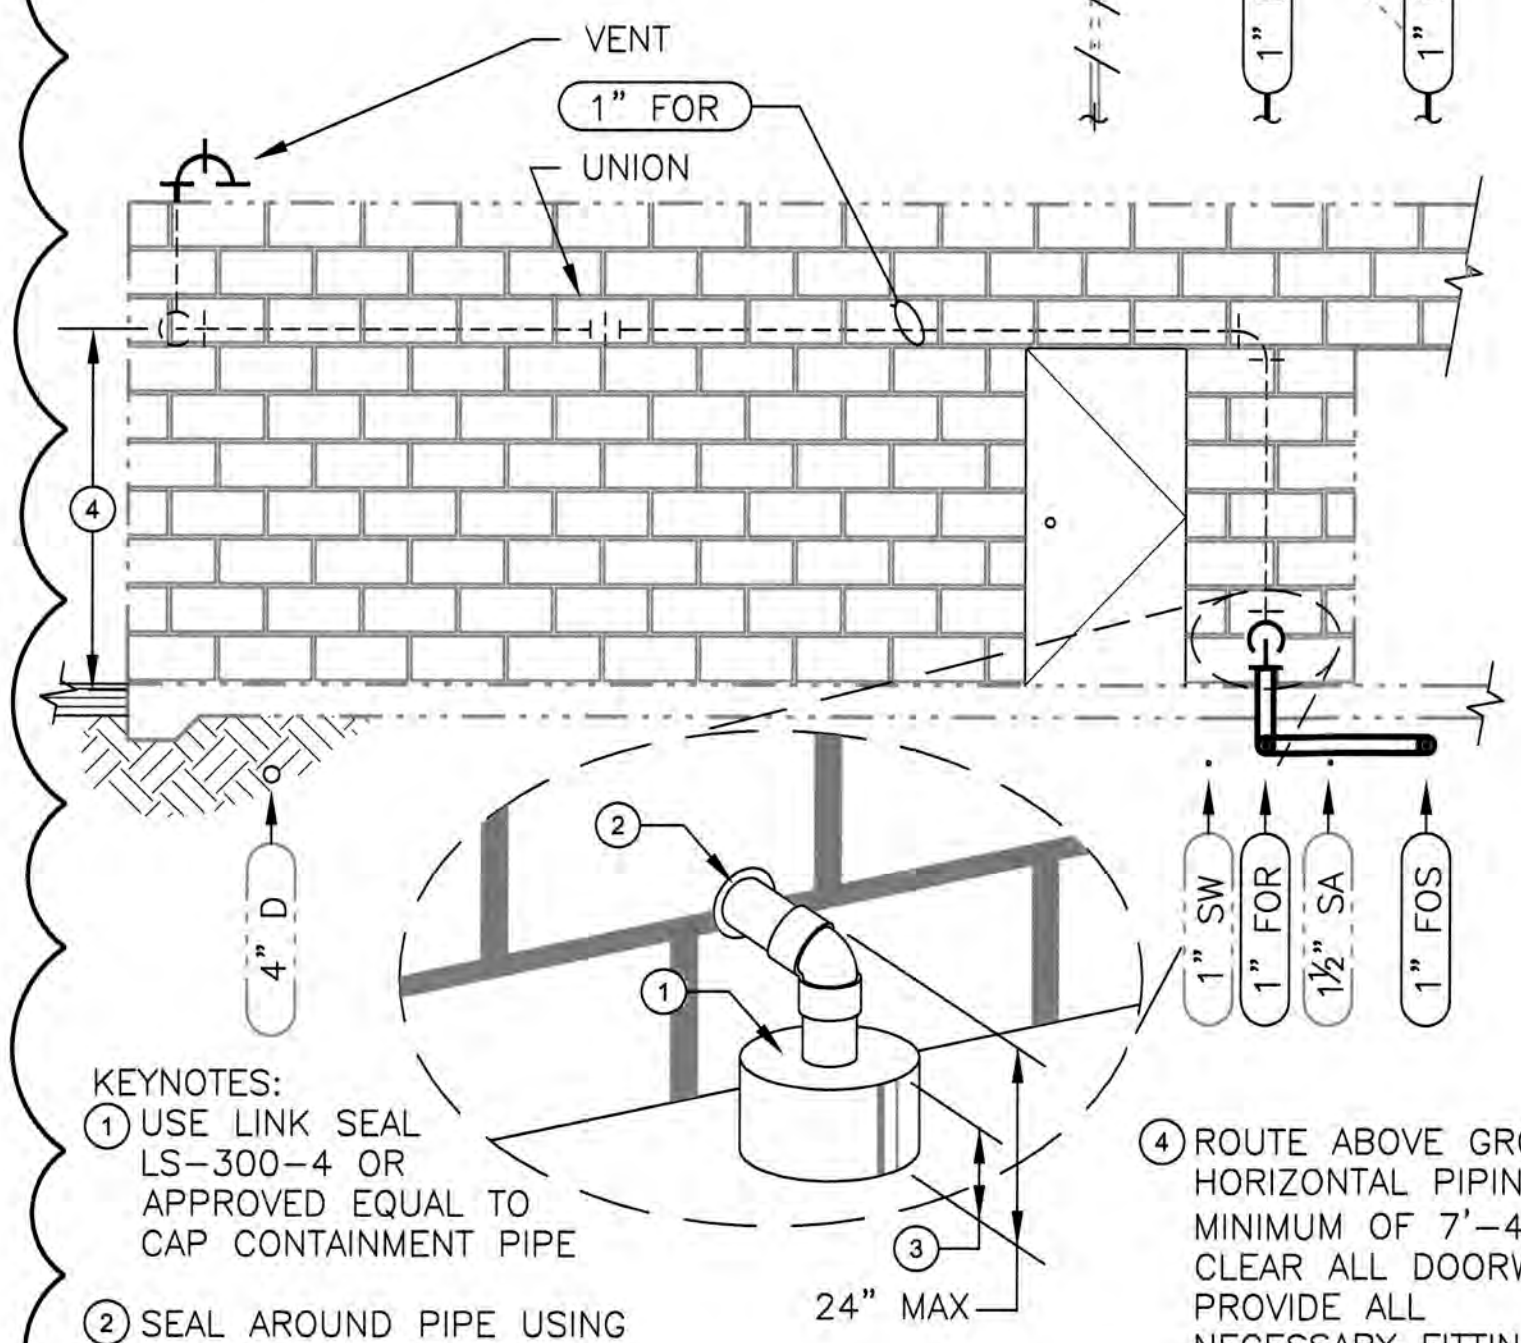


SECTION 1
SCALE: 1/4"=1'-0"

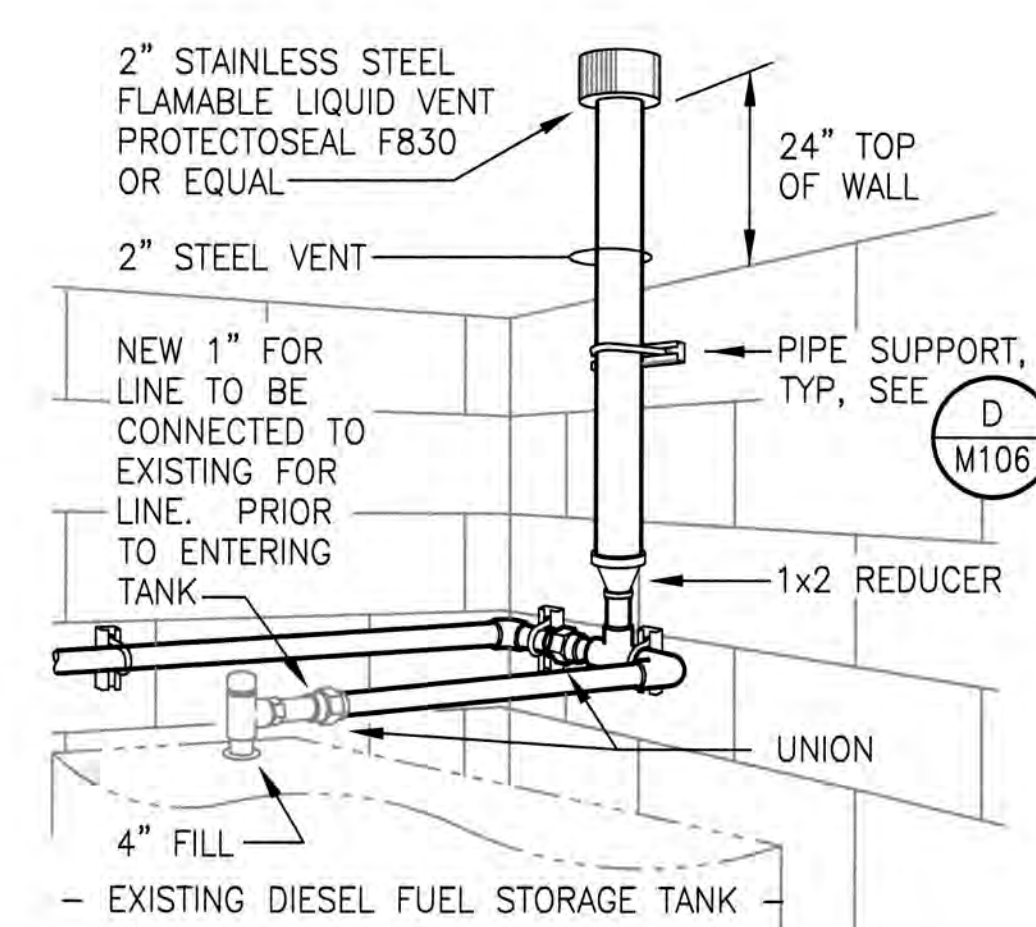

DETAIL A
NTS

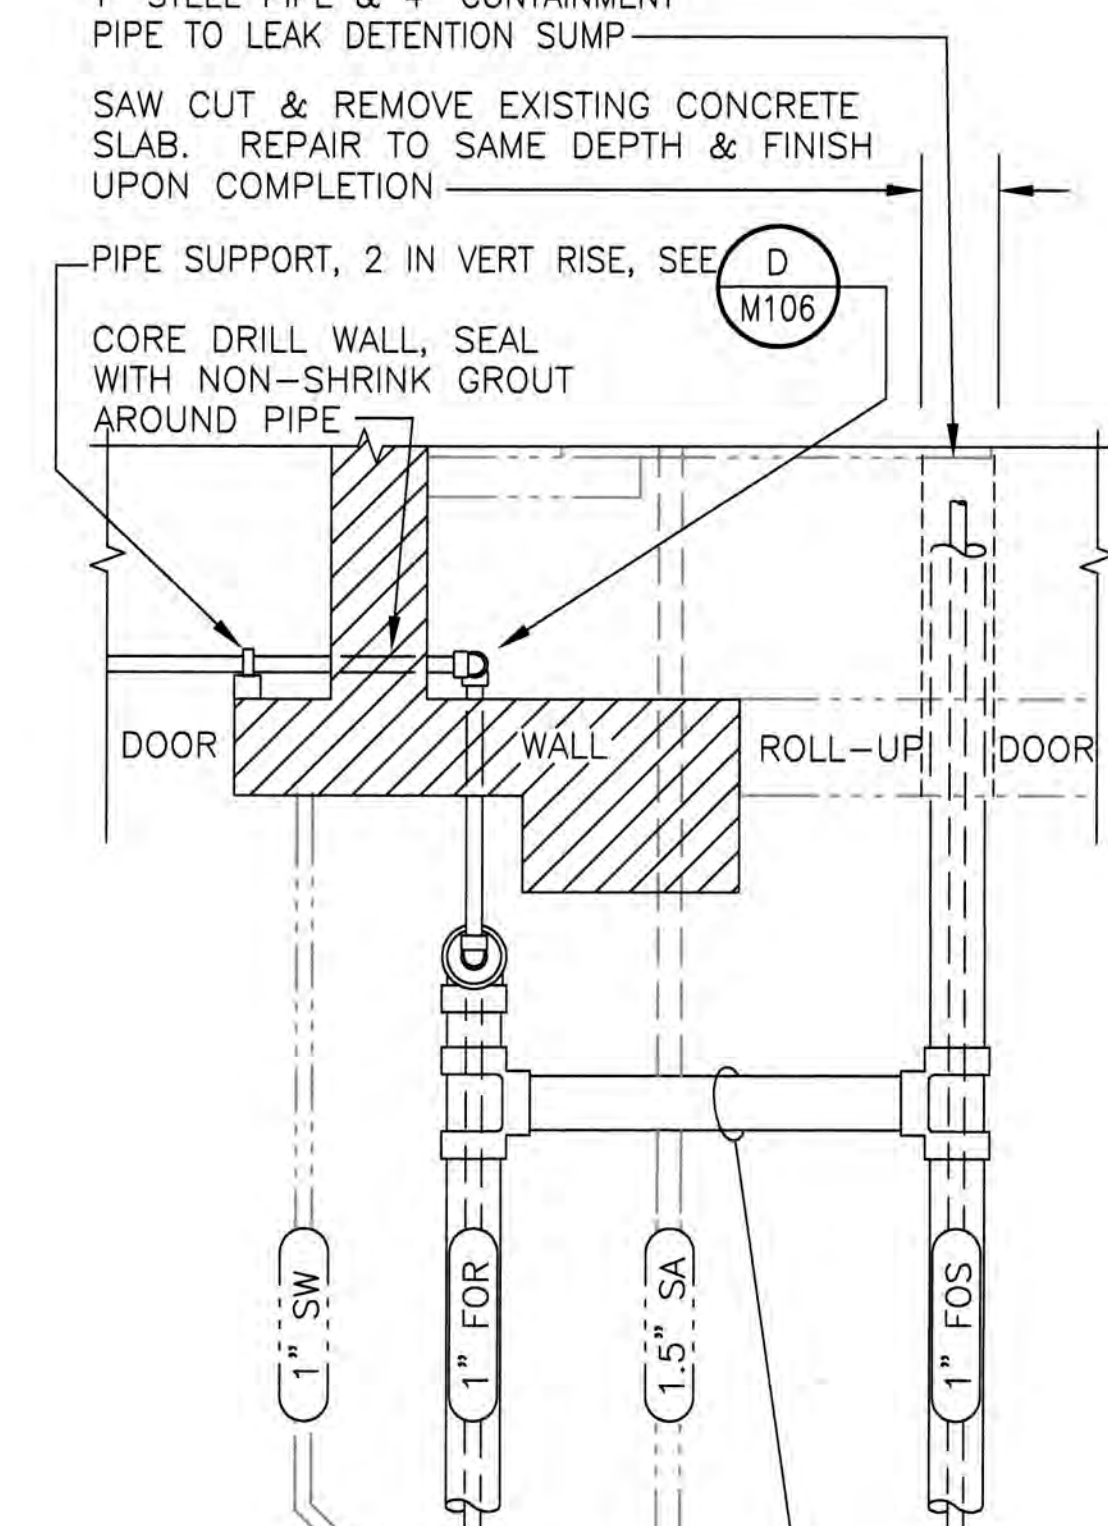

DETAIL B
SCALE: 3/4"=1'-0"

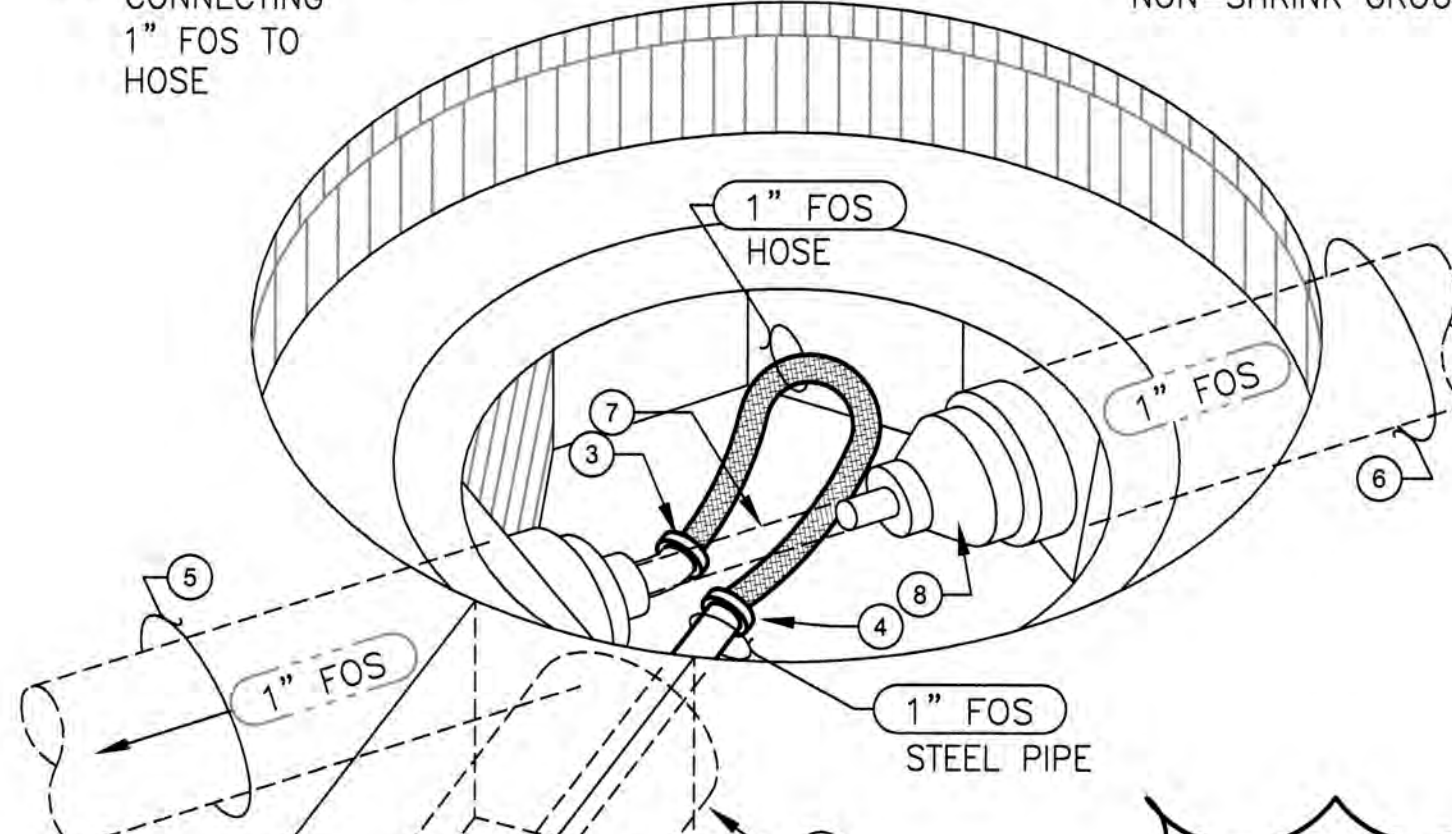

DETAIL C
NTS

- NOTES:
- CUTS IN CONCRETE SHALL BE STRAIGHT AND SMOOTH. WIDTH OF EXCAVATION SHALL BE TWO FEET OR LESS. ANY WATER USED IN THE BUILDING SHALL BE CONTAINED TO PREVENT DAMAGE TO EXISTING FACILITIES
 - THE EXISTING FOOTING SHALL NOT BE DISTURBED. HAND DIG AS REQUIRED TO COMPLETE WORK AROUND THE FOOTING
 - MATCH EXISTING FOUNDATION MATERIALS AND DIMENSIONS WHEN INSTALLING & BACKFILLING UNDER EXISTING CONCRETE. REPAIR REBAR AS DIRECTED BY THE ENGINEER
 - CONCRETE SHALL BE FINISHED TO MATCH EXISTING SURFACES AND SLOPES
 - PIPING CONTINUES ON C7
 - THE EXISTING LEAK DETECTOR SYSTEM SHALL BE PRESERVED AND NEW FOS AND FOR PIPING SHALL BE INCORPORATED
 - THE EXISTING LEAK DETECTOR SYSTEM SHALL BE PRESERVED AND NEW FOS AND FOR PIPING SHALL BE INCORPORATED
 - NEW FOS AND FOR PIPING MAY BE INSTALLED IN THE SAME TRENCH
 - REMOVE LOUVER & EXISTING FRAME. CONTRACTOR TO DELIVER LOUVER TO CITY. LOUVER OPENING APPROXIMATELY 7' WIDE x 8' HIGH (CONTRACTOR TO FIELD VERIFY). FILL IN LOUVER OPENING W/CMU BLOCK TO MATCH EXISTING. SEE (B) M401A
 - REPLACE REMOVED CONCRETE TO ± INCH BELOW FINISH FLOOR WITH CONCRETE. DAMAGED CONCRETE FROM ±1 INCH BELOW FINISH FLOOR TO TOP OF FLOOR, SHALL BE REPAIRED WITH FLOOR LEVELING GROUT. SLOPE FLOOR IN BATHROOM TO 4" FD

- NOTES:
- VERIFY ALL EXISTING MATERIALS & DIAMETERS PRIOR TO PURCHASE NEW MATERIALS
 - CONTRACTOR SHALL PURCHASE SUFFICIENT HOSE LENGTH TO MAKE REQUIRED CONNECTIONS
 - HOSE SHALL BE GENERAL PURPOSE BUNA-N RUBBER PETROLEUM HOSE WITH STEEL WIRE SPIRAL REINFORCEMENT. HOSE AVAILABLE FROM McMASTER CARR, PHONE: (330)995-550
 - WRAP MALE PIPE THREADS WITH TEFLON TAPE. TAPE SHALL BE WRAPPED TO ALLOW 1/2" WIDTH OVERLAP

- KEYNOTES:
- CUT HERE IN LEAK DETECTOR SUMP FOR CONTAINMENT PIPE. SEAL SUMP/PIPE OPENING WATER-TIGHT WITH NON-SHRINK GROUT
 - 4" CONTAINMENT PIPE
 - STEEL HOSE BARB x HOSE BARB COUPLING USED TO CONNECT EXISTING HOSE TO NEW HOSE
 - STEEL HOSE BARB x NTP CONNECTING 1" FOS TO HOSE
 - EXISTING 1" FUEL SUPPLY LINE TO EXISTING CON VAULT TANK
 - EXISTING 1" LINE TO BE ABANDONED
 - EXISTING HOSE. CUT AS CLOSE TO ABANDONED LINE AS POSSIBLE AND ATTACH TO NEW HOSE
 - REMOVE EXISTING FITTINGS SEAL ABANDONED 1" FOS LINE PLUG WITH WATERTIGHT WITH NON-SHRINK GROUT

Underground Service Alert

TWO DAYS BEFORE YOU DIG

Call TOLL FREE: 1-800-642-2444

BAR IS ONE INCH ON ORIGINAL DRAWING

IF NOT ONE INCH ON THIS SHEET, ADJUST SCALES ACCORDINGLY

REFER TO SET FOR SIGNATURE

REV. No.	DISCRPTION	DATE	BY	Apr'd By
1	BATHROOM DETAILS	7/05	OS	
2	FUEL/OIL FOR DETAILS	8/02	HP	
3				
4				
5				
6				
7				

WEST YOST ASSOCIATES
Consulting Engineers





1260 Lake Boulevard
Suite 240
Davis, California 95616
(530) 756-5905
FAX (530) 756-5991

RECORD DRAWINGS
14-Mile Slough Pump Station Upgrades

EXISTING CONTROL BUILDING

DEPARTMENT OF MUNICIPAL UTILITIES
CITY OF STOCKTON, CALIFORNIA

SCALE: AS SHOWN	APPROVED BY: DATE: _____	SHEET No. _____
DESIGNED BY: PDF		M401.2
DRAWN BY: DTD		54 of 89 SHEETS
CHECKED BY: GDH	ASSISTANT DIRECTOR, DEPT. OF MUNICIPAL UTILITIES	PROJECT No. 293-00-05-01
RECORD Dwg.:		

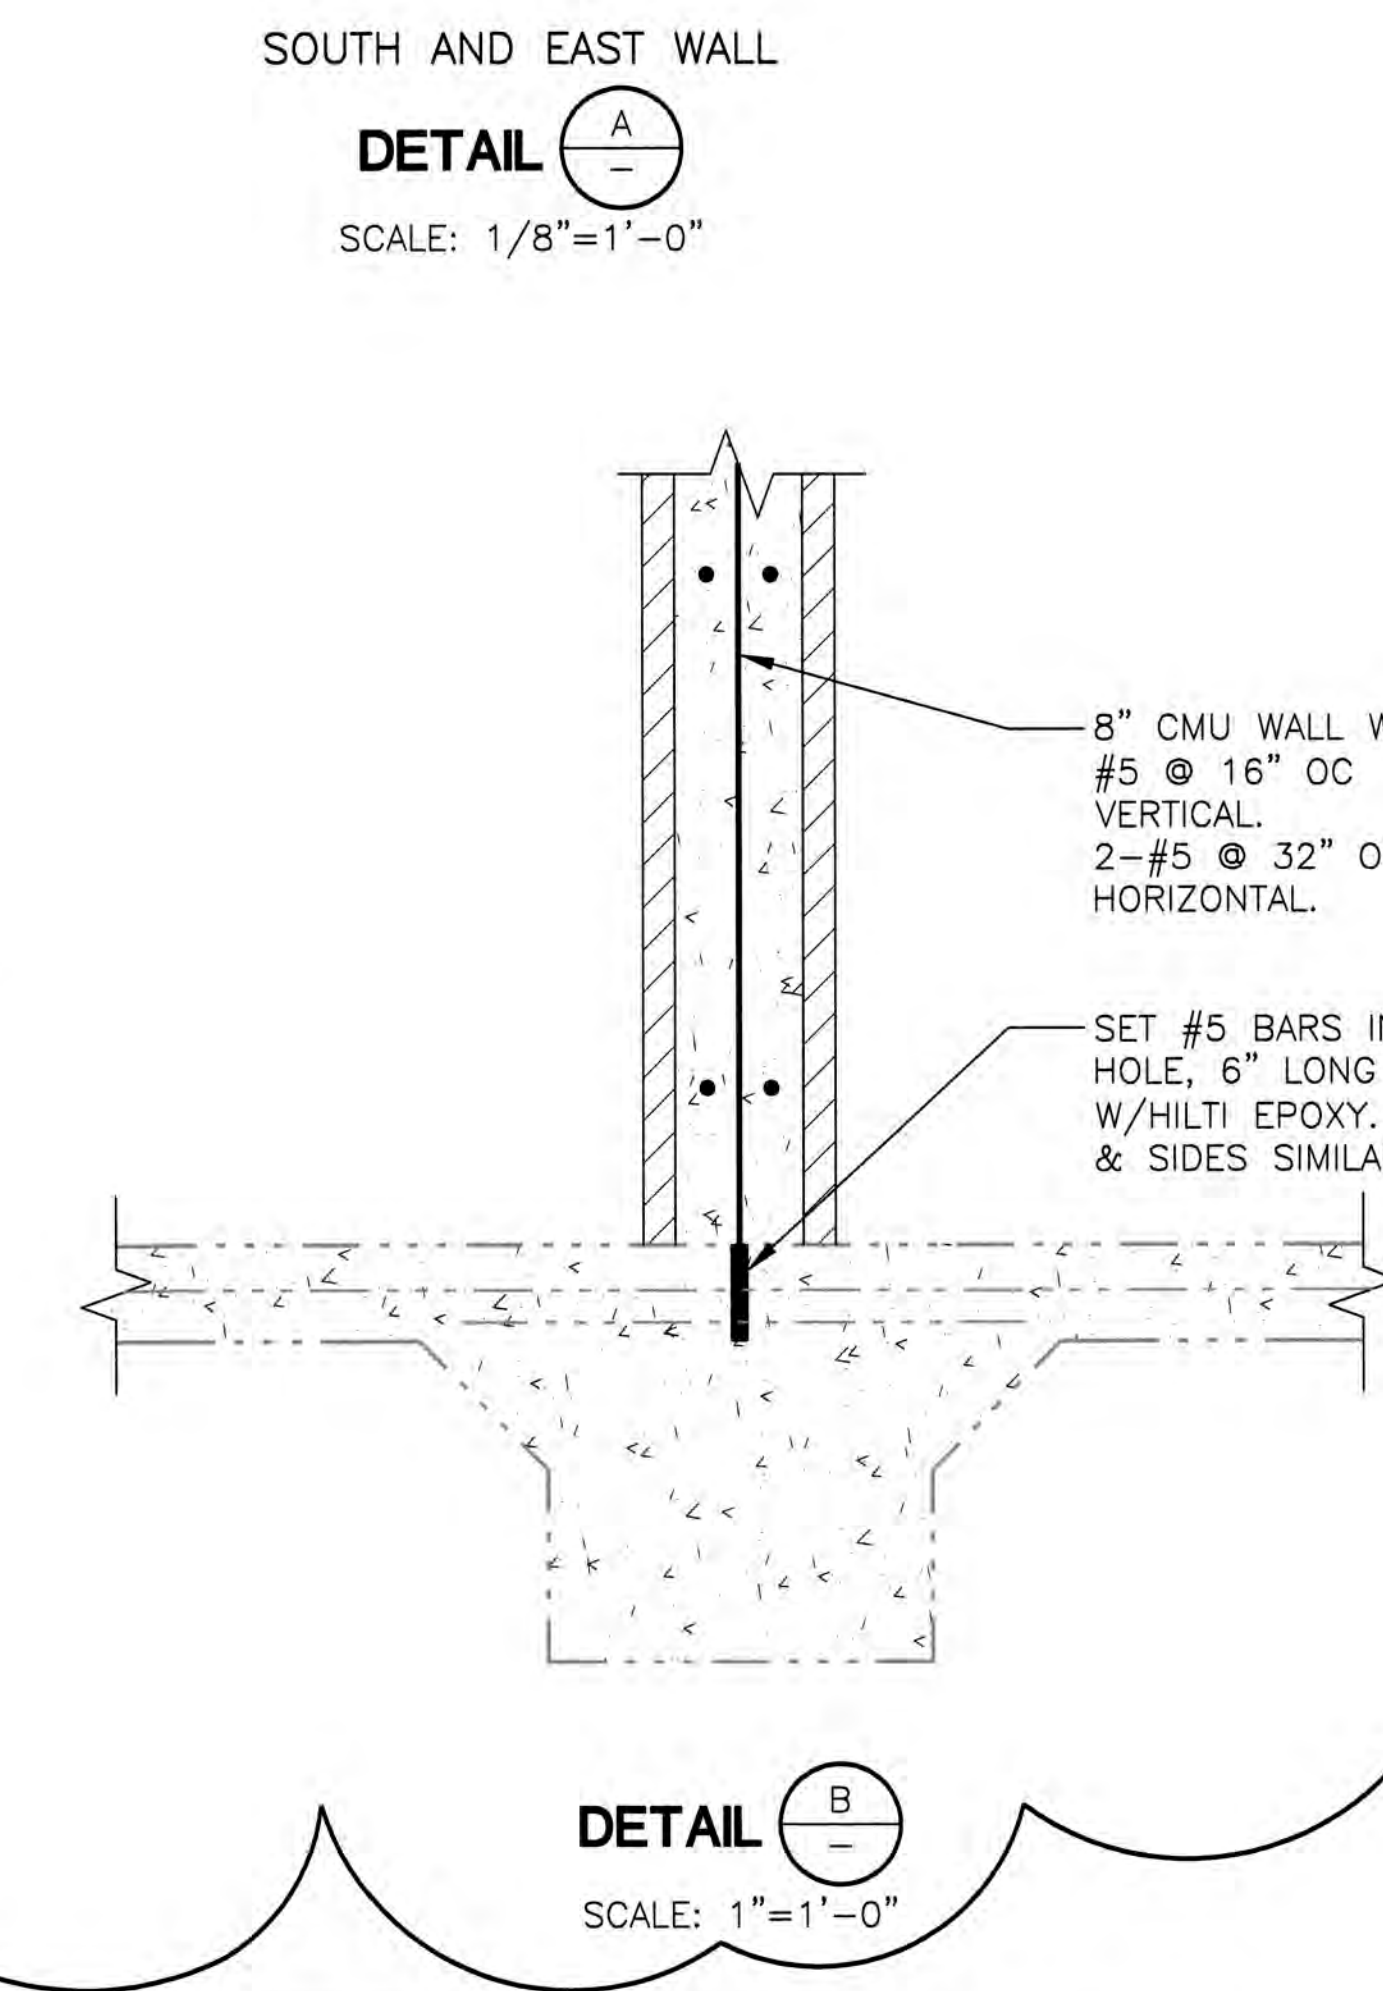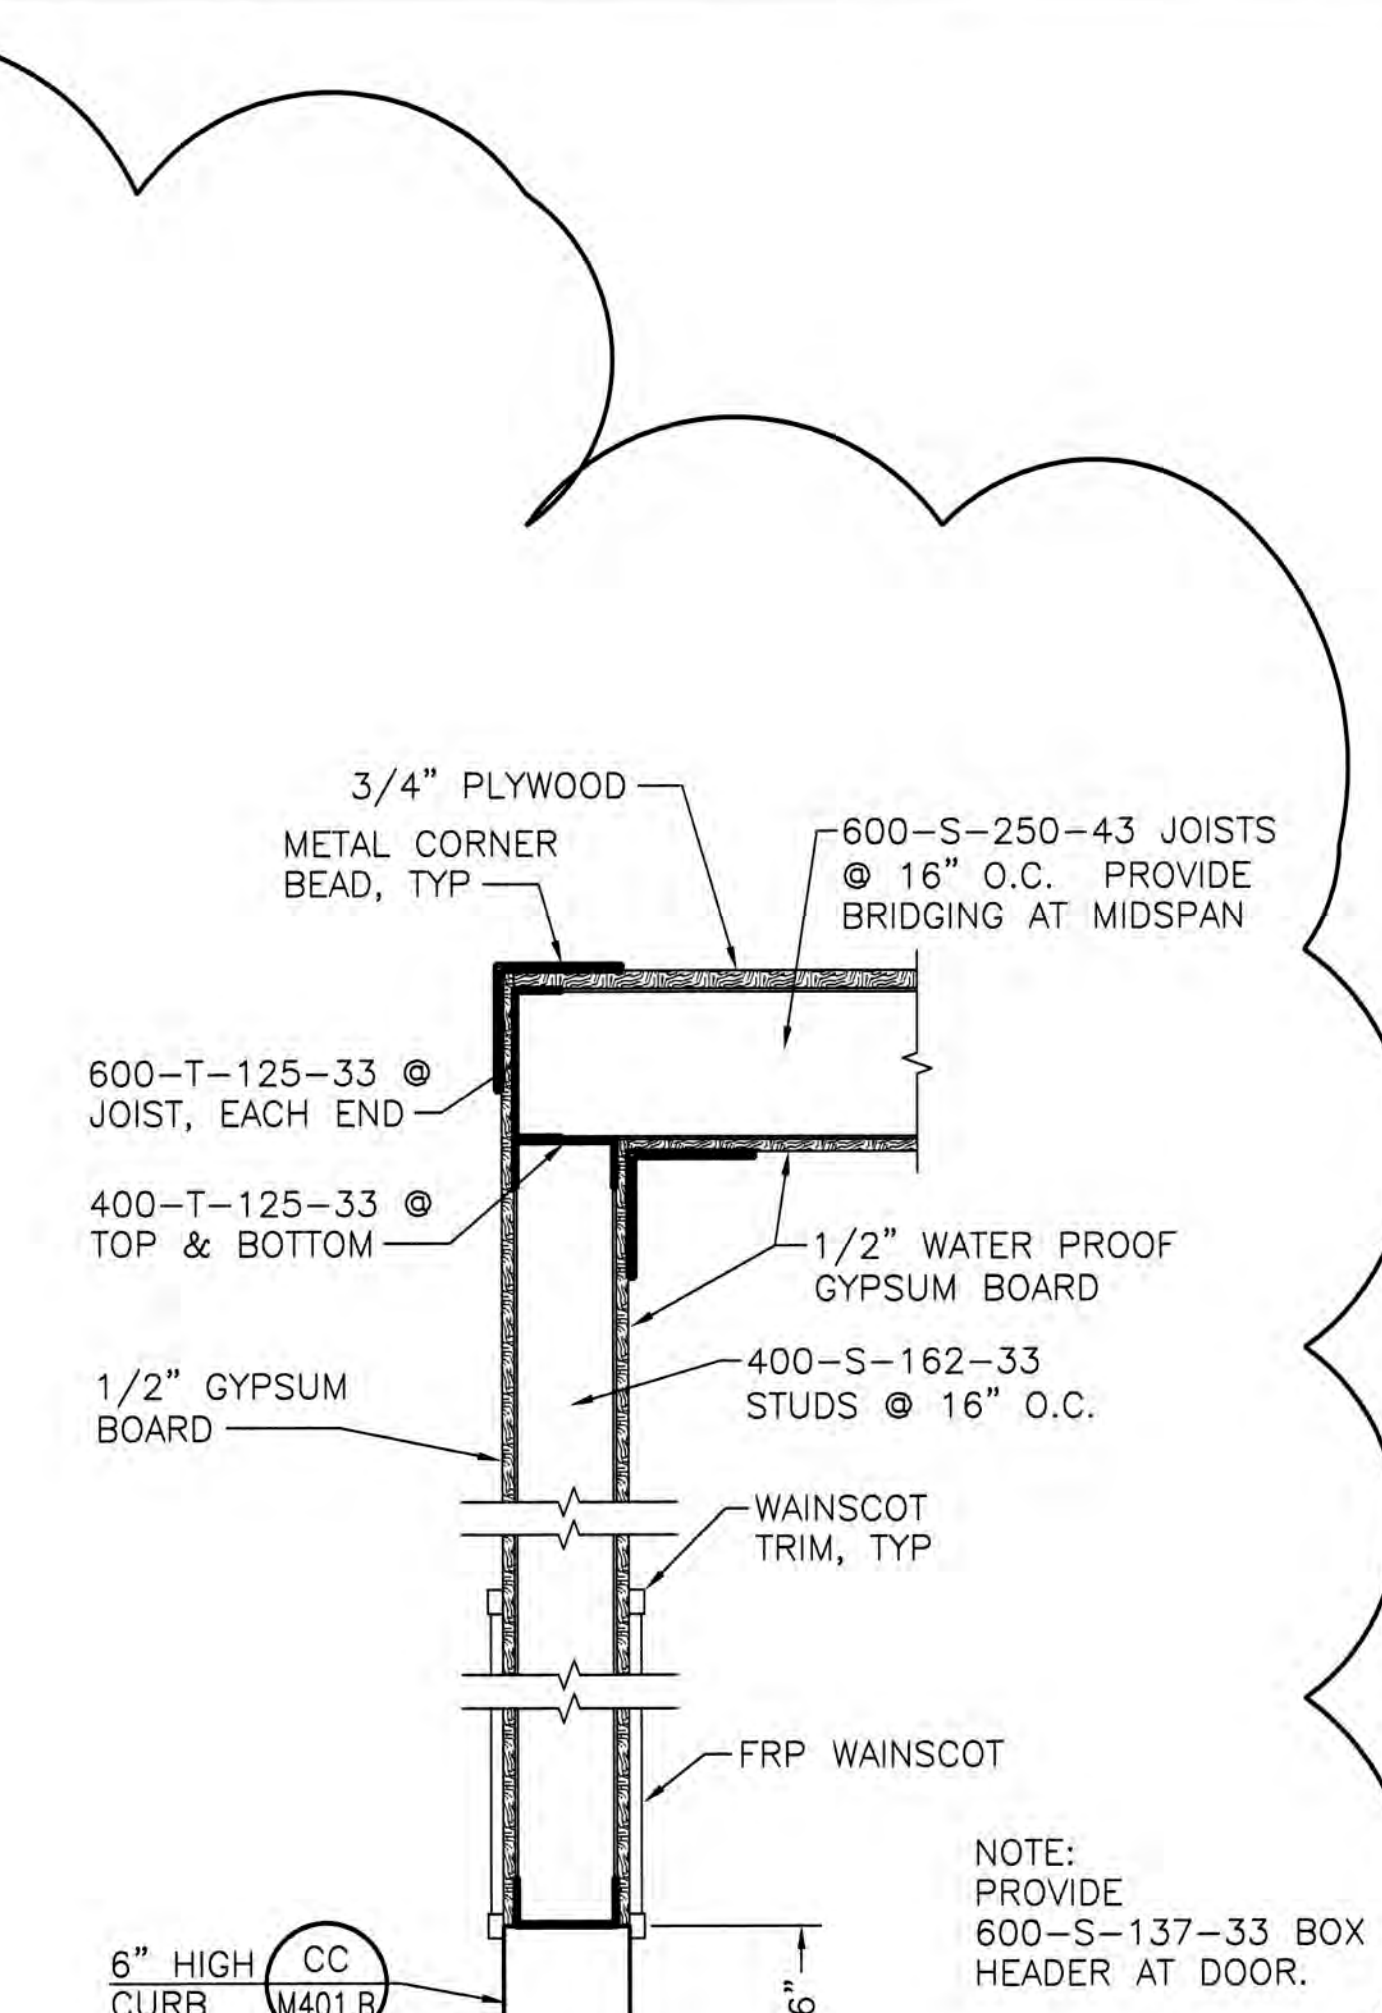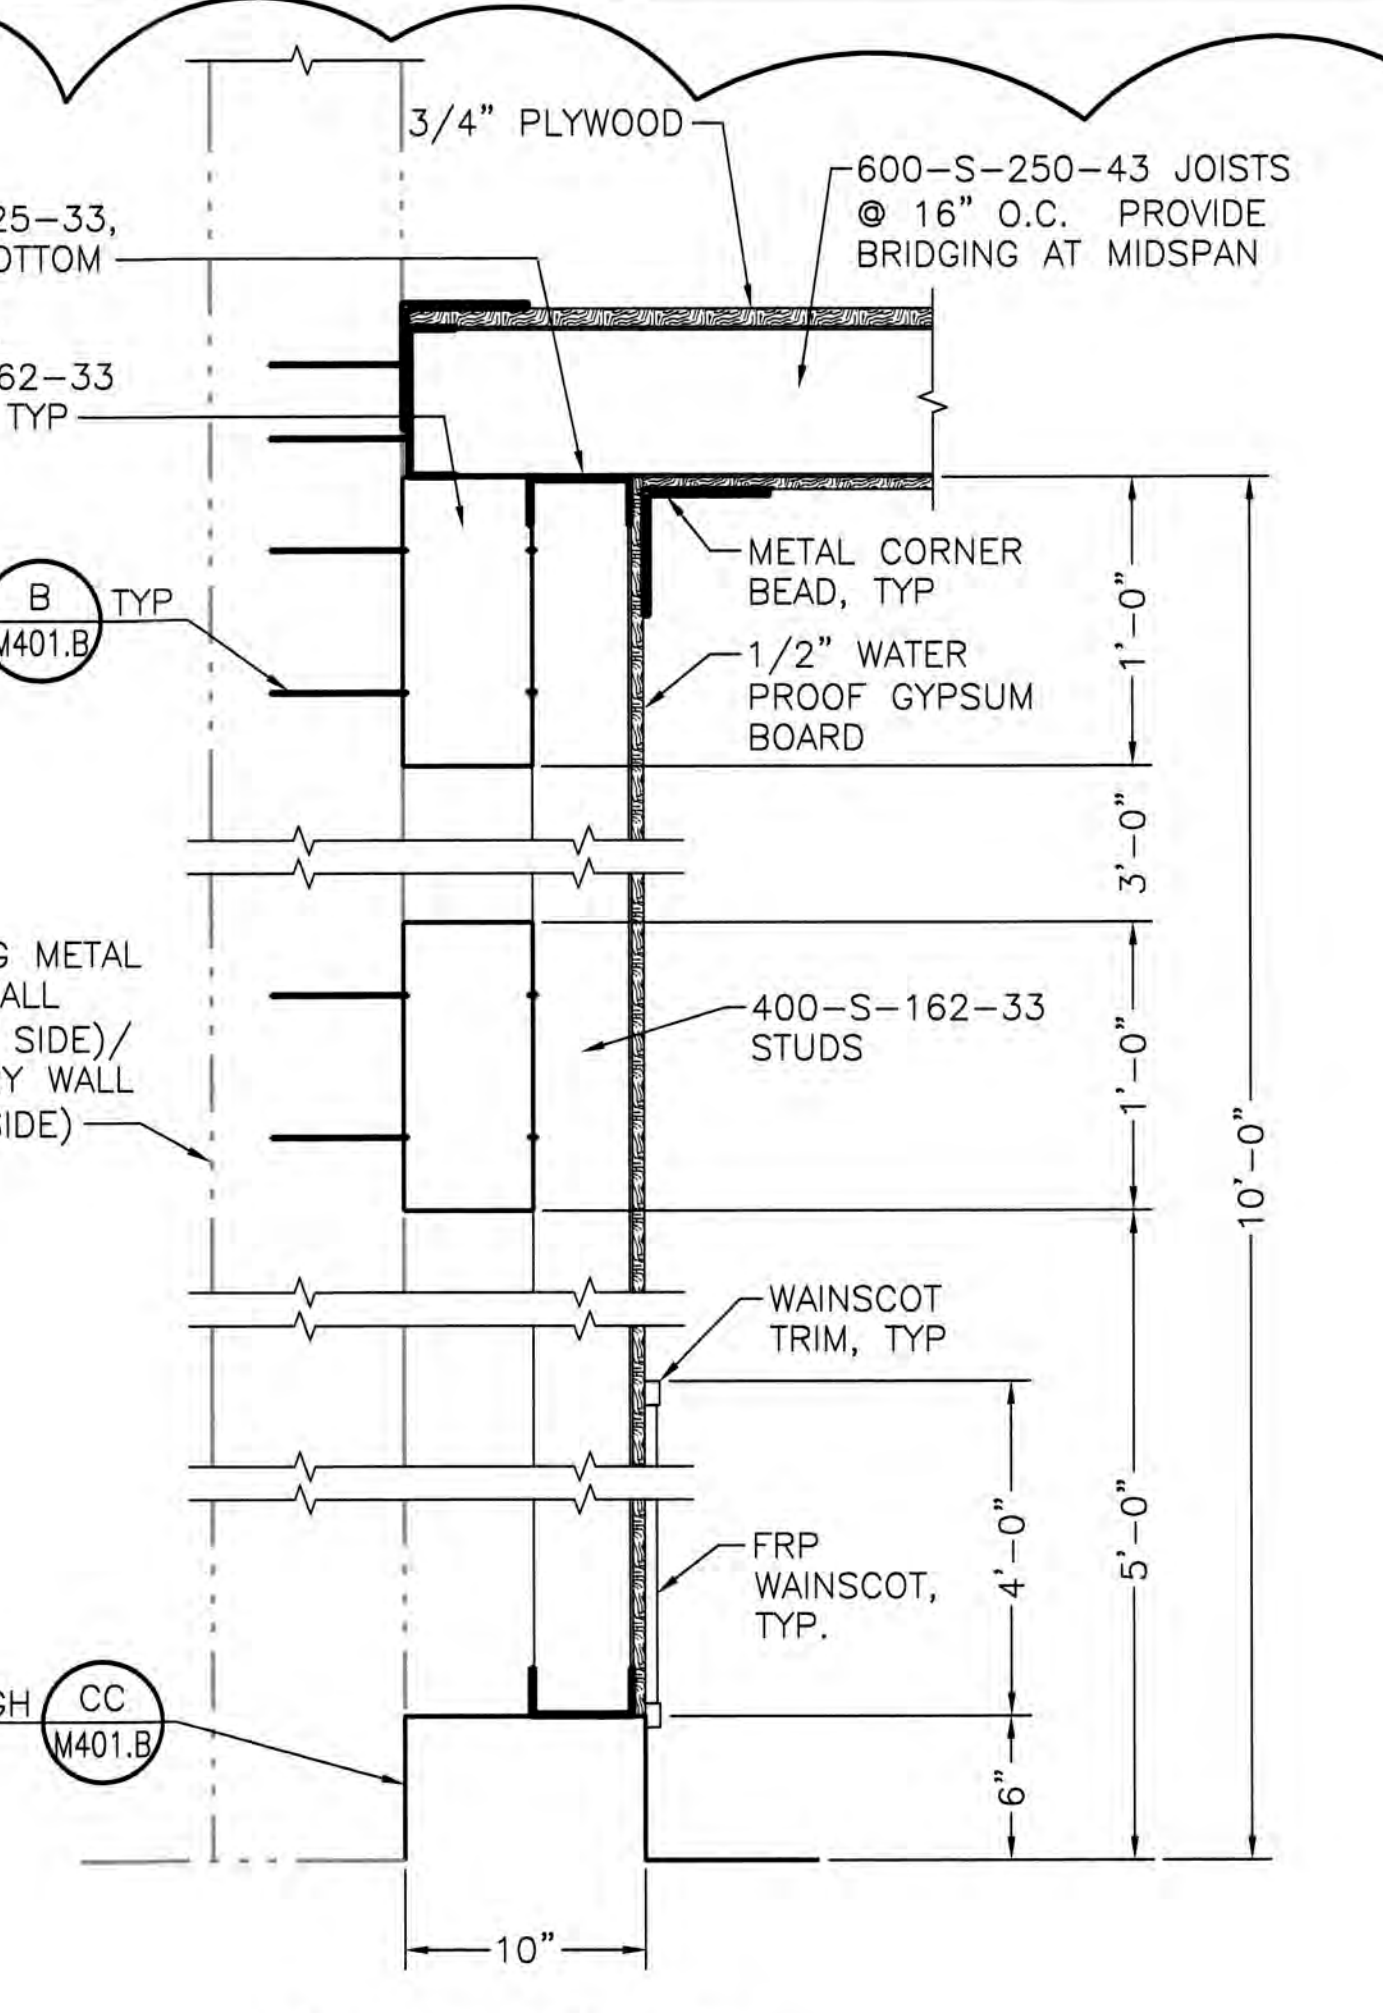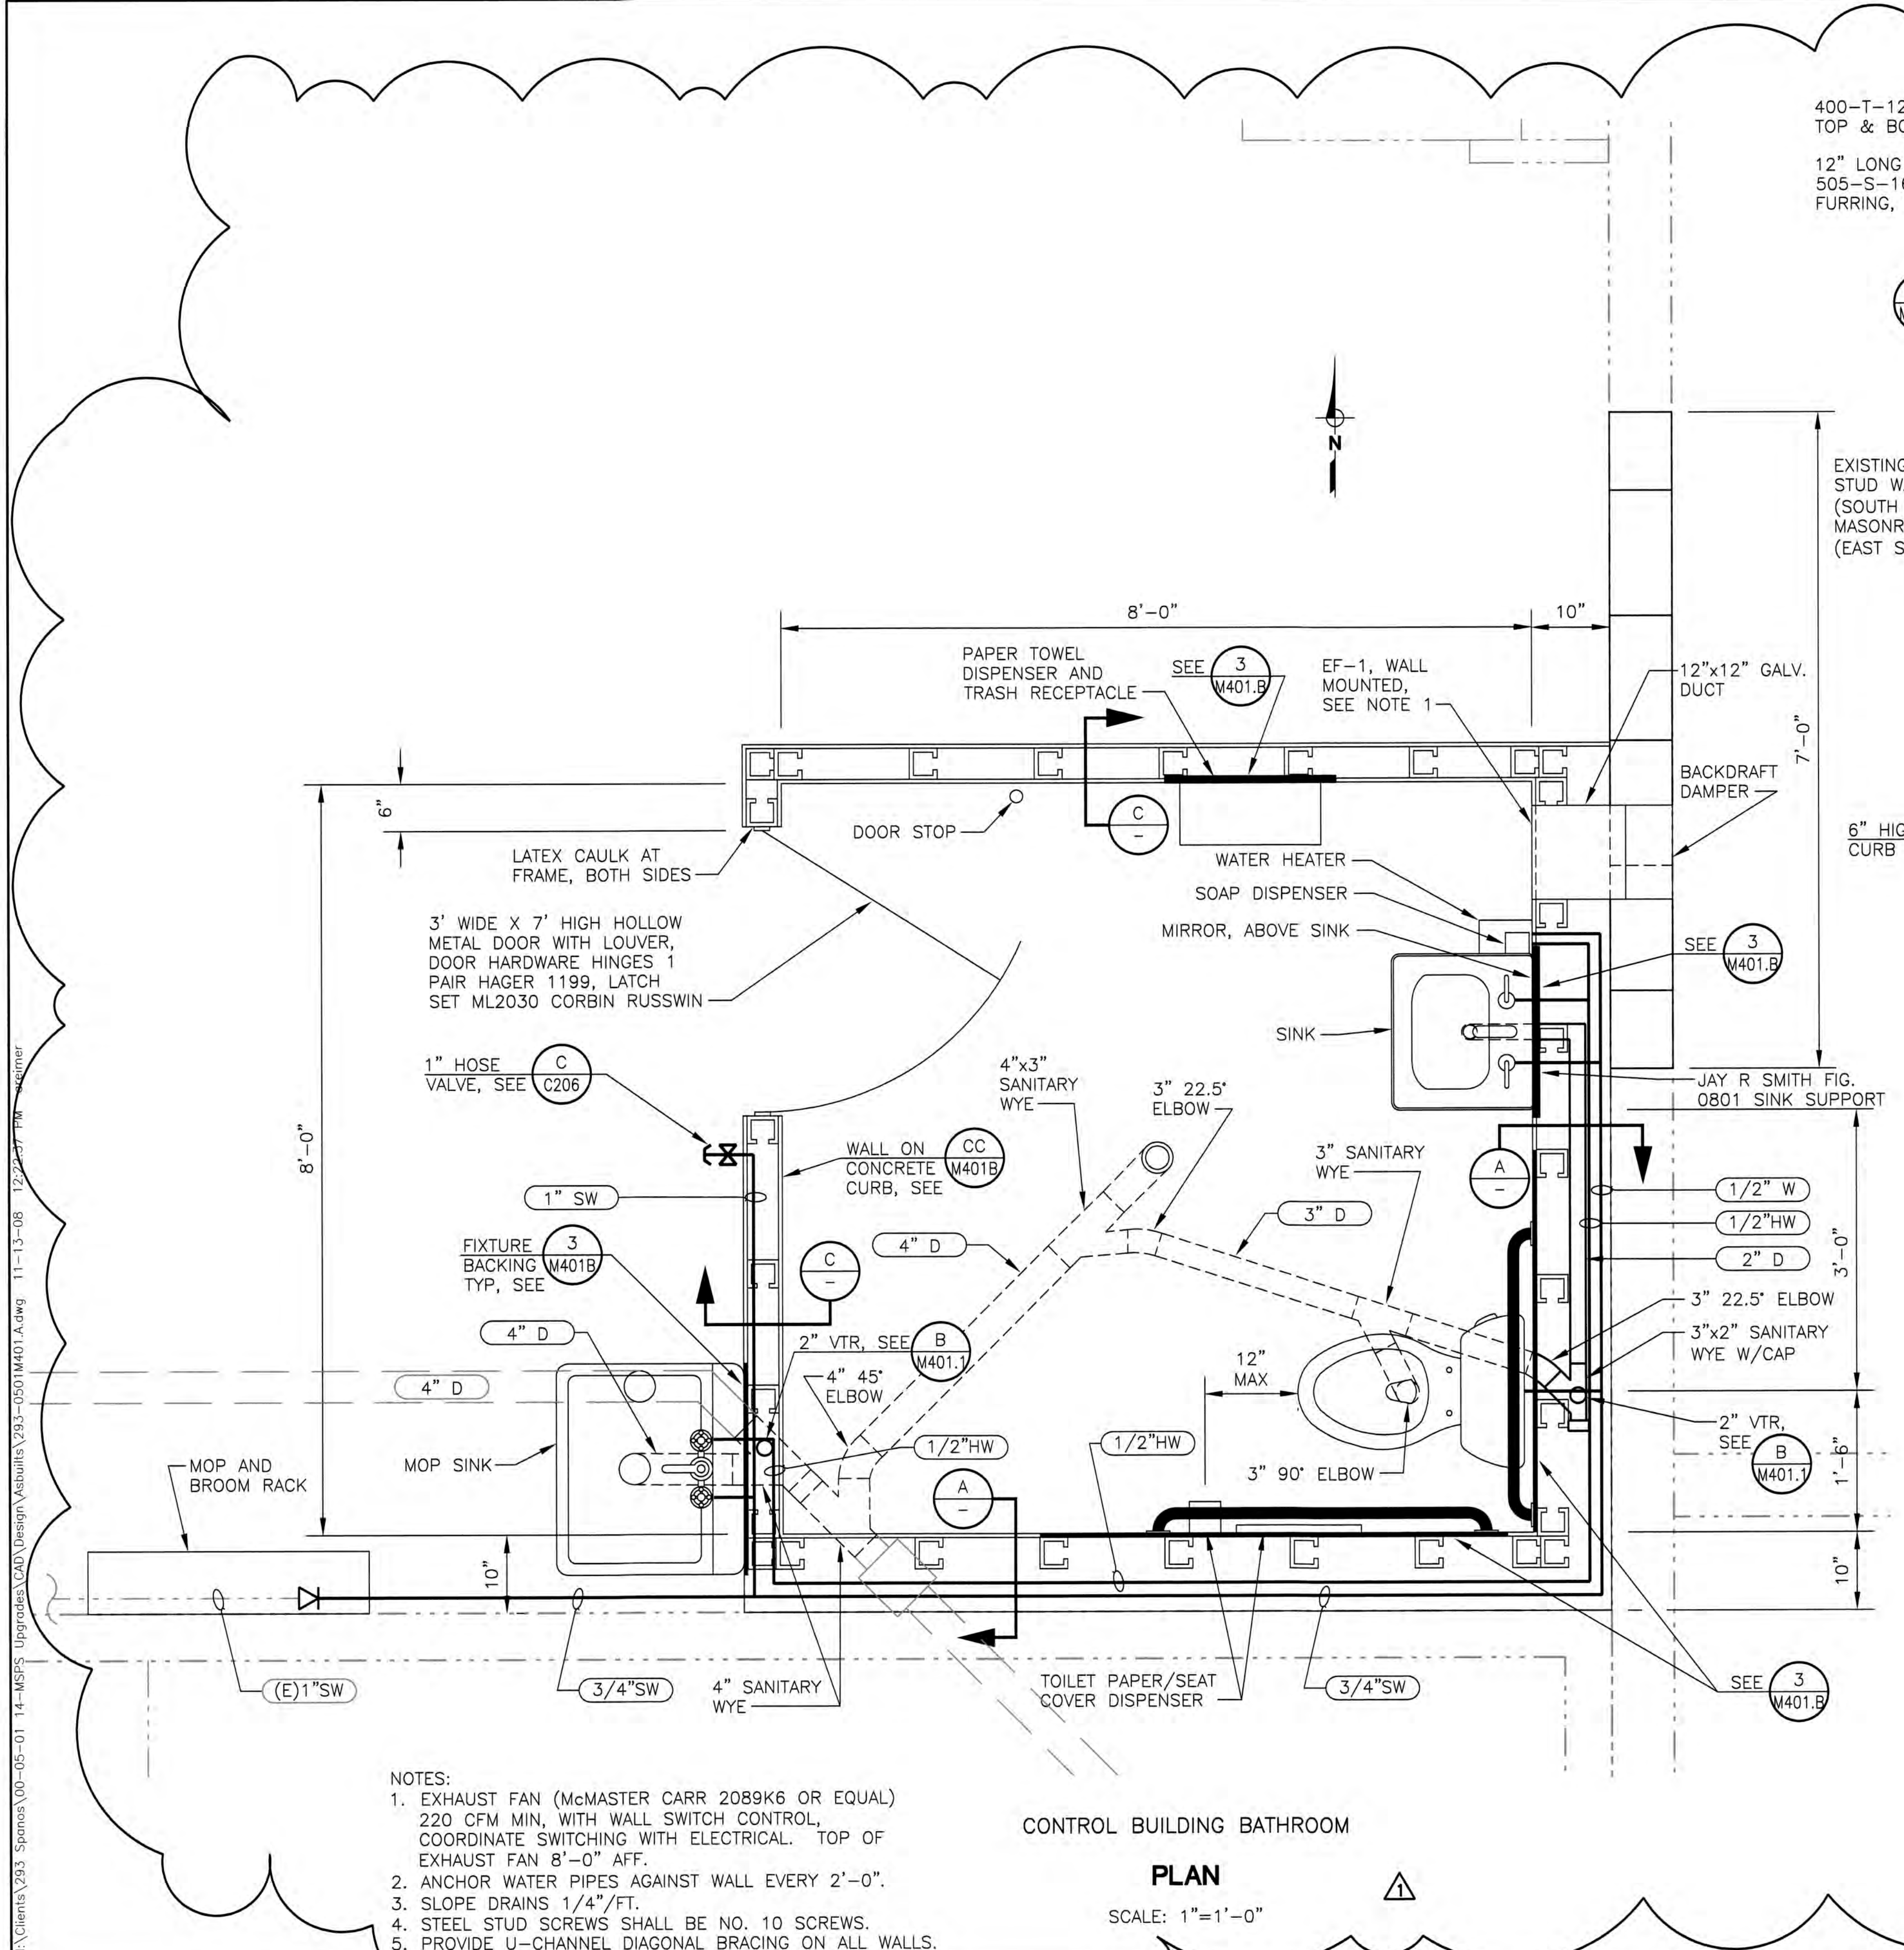

Underground Service Alert

TWO DAYS BEFORE YOU DIG

Call TOLL FREE: 1-800-642-2444

BAR IS ONE INCH ON ORIGINAL DRAWING

IF NOT ONE INCH ON THIS SHEET, ADJUST SCALES ACCORDINGLY

REFER TO BID SET FOR SIGNATURE

No. 66841

REV. No.	DISCRPTION	DATE	By	Apr'd By
1	BATHROOM DETAILS	7/5 OS		
2	RECORD DRAWINGS	8/08 OS		
3				
4				
5				
6				
7				

WEST YOST ASSOCIATES

Consulting Engineers

1260 Lake Boulevard
Suite 240
Davis, California 95616
(530) 756-5905
FAX (530) 756-5991

RECORD DRAWINGS

14-Mile Slough Pump Station Upgrades


CONTROL BUILDING BATHROOM
DETAIL

DEPARTMENT OF MUNICIPAL UTILITIES
CITY OF STOCKTON, CALIFORNIA


SCALE: AS SHOWN
DESIGNED BY: OS
DRAWN BY: OS
CHECKED BY: PDF
RECORD Dwg.:

APPROVED BY: DATE: _____
ASSISTANT DIRECTOR,
DEPT. OF MUNICIPAL UTILITIES


SHEET No.
M401.A
of 89 SHEETS
PROJECT No.
293-00-05-01

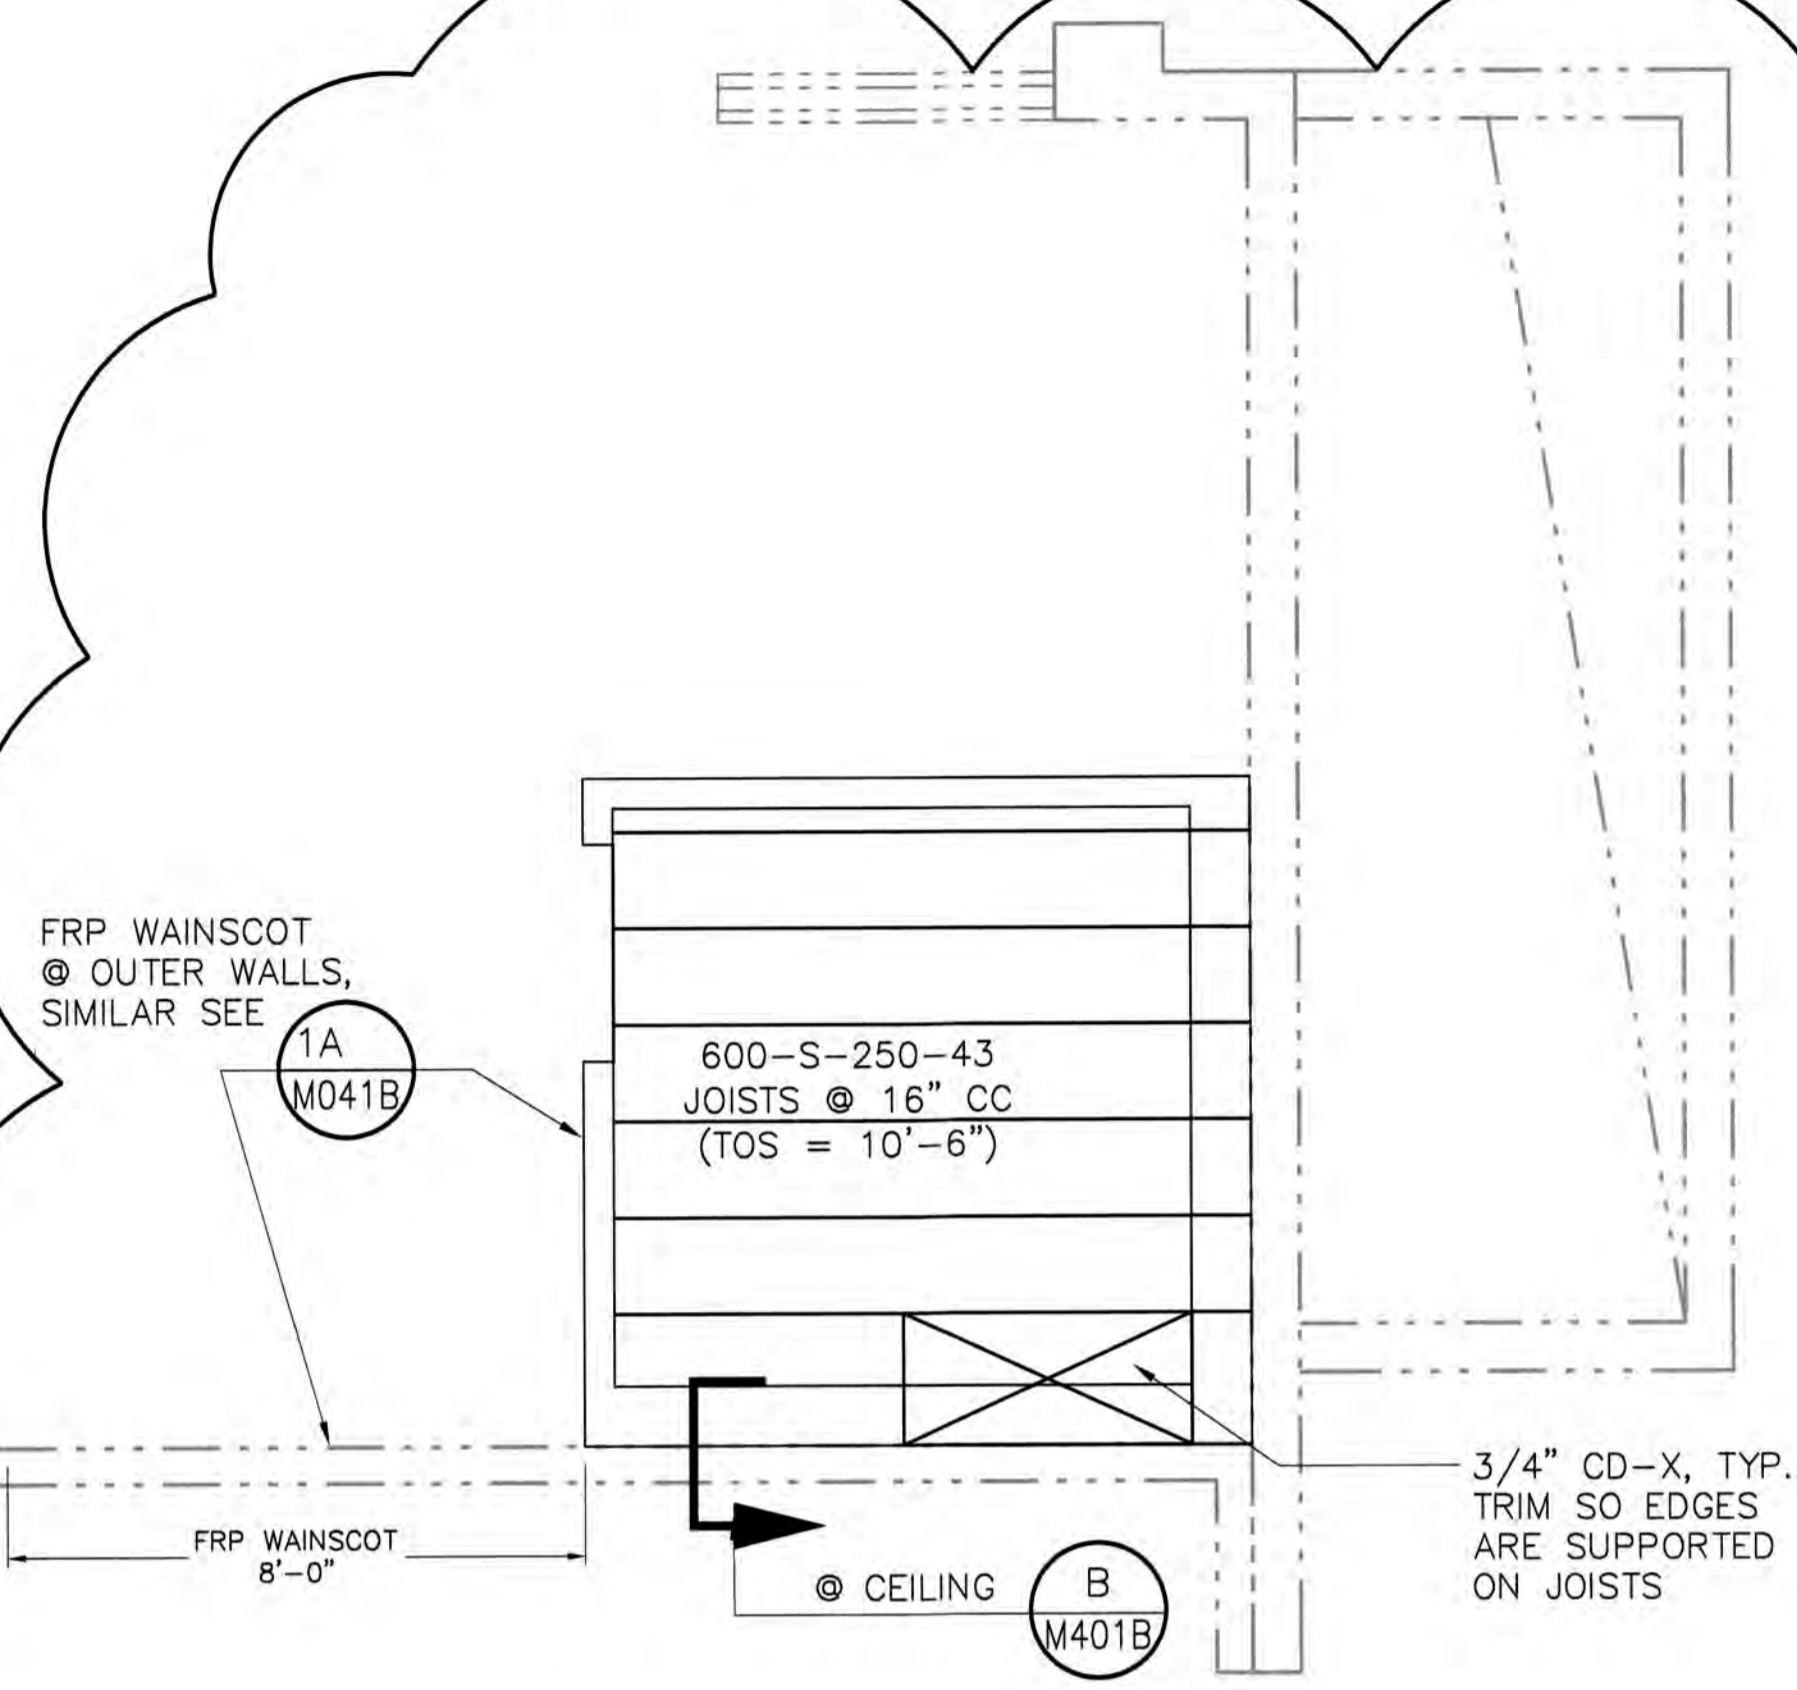

1B TOILET CEILING FRAMING
SCALE: 3/8"=1'-0"

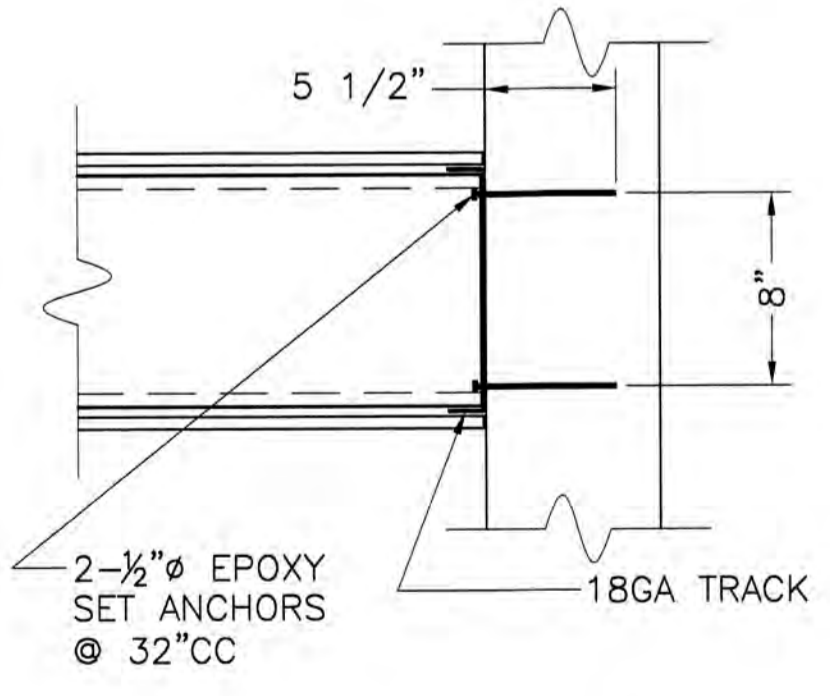


DETAIL B M401B
SCALE: 1 1/2"=1'-0"

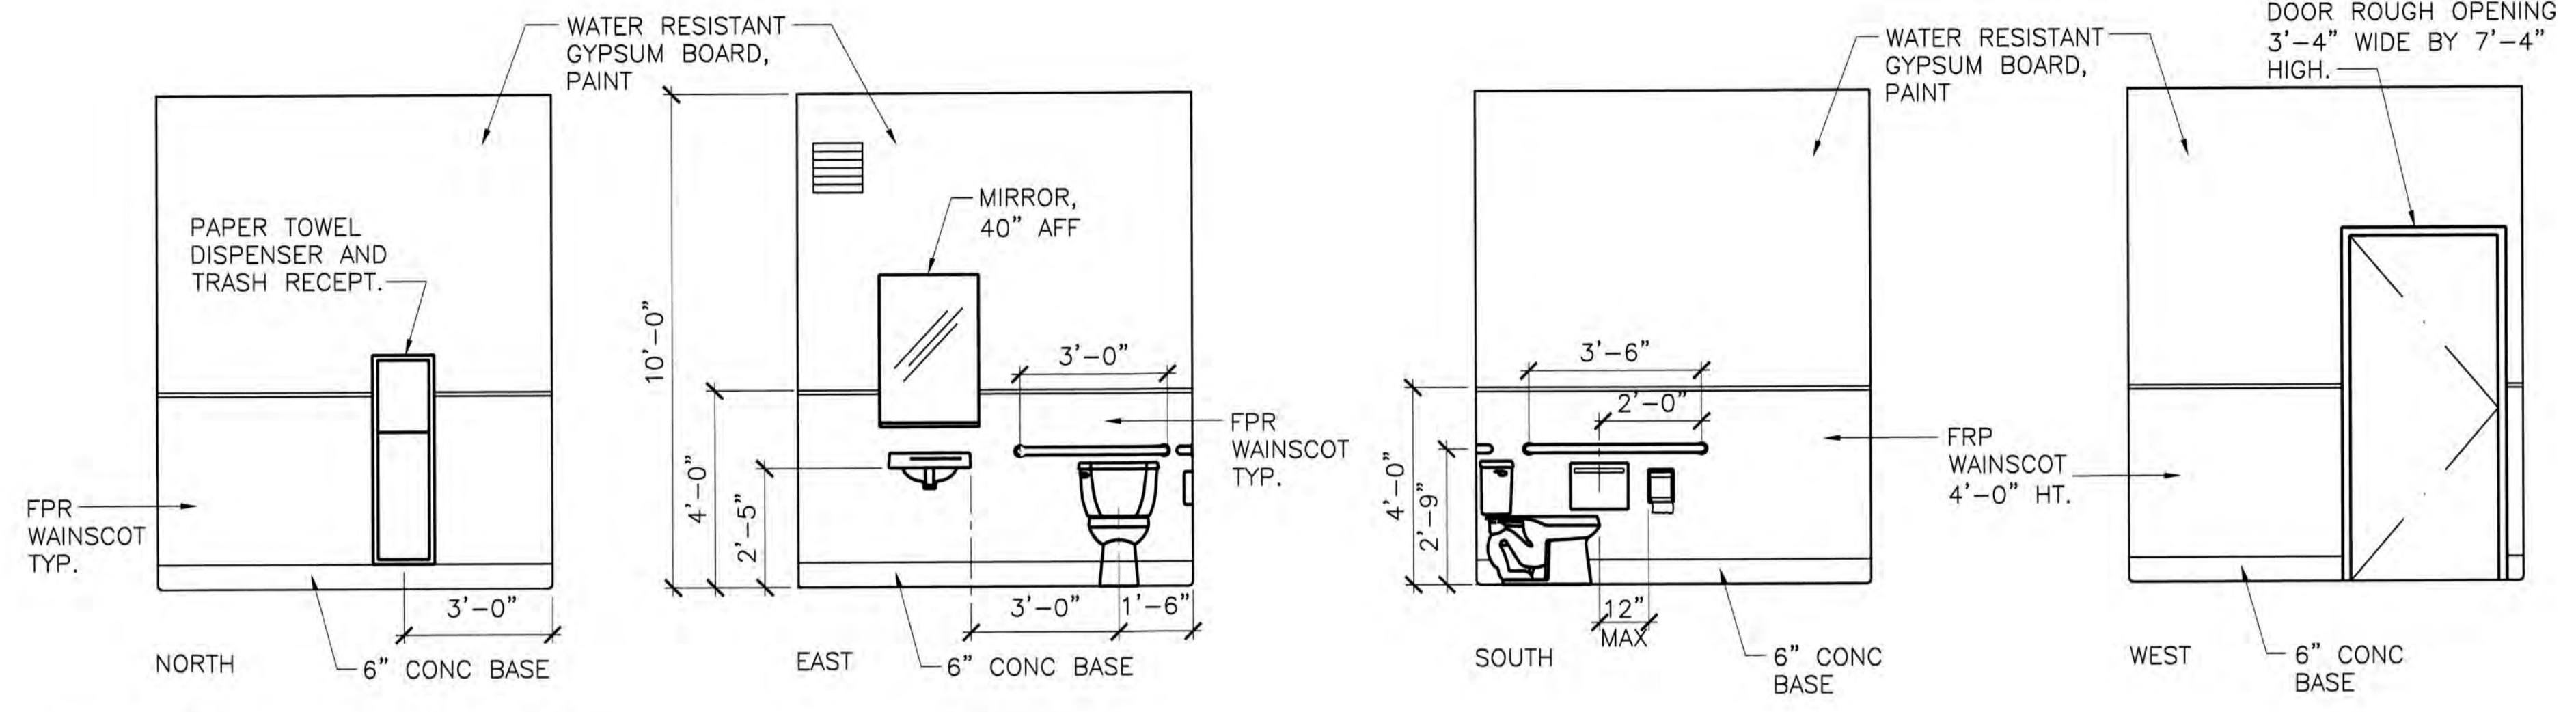


1A RESTROOM ELEVATIONS (INSULATE WATER LINES AND WASTE LINES AT LAVATORY)
SCALE: 3/8"=1'-0"

NOTE:
1. FINISH EXPOSED GYP BOARD WITH COATING SYSTEM L-1, ENAMEL SHEEN, ORANGE PEEL TEXTURE PER SECTION 09020 OF THE SPECIFICATIONS PRIOR TO PLACING WAINSCOT.

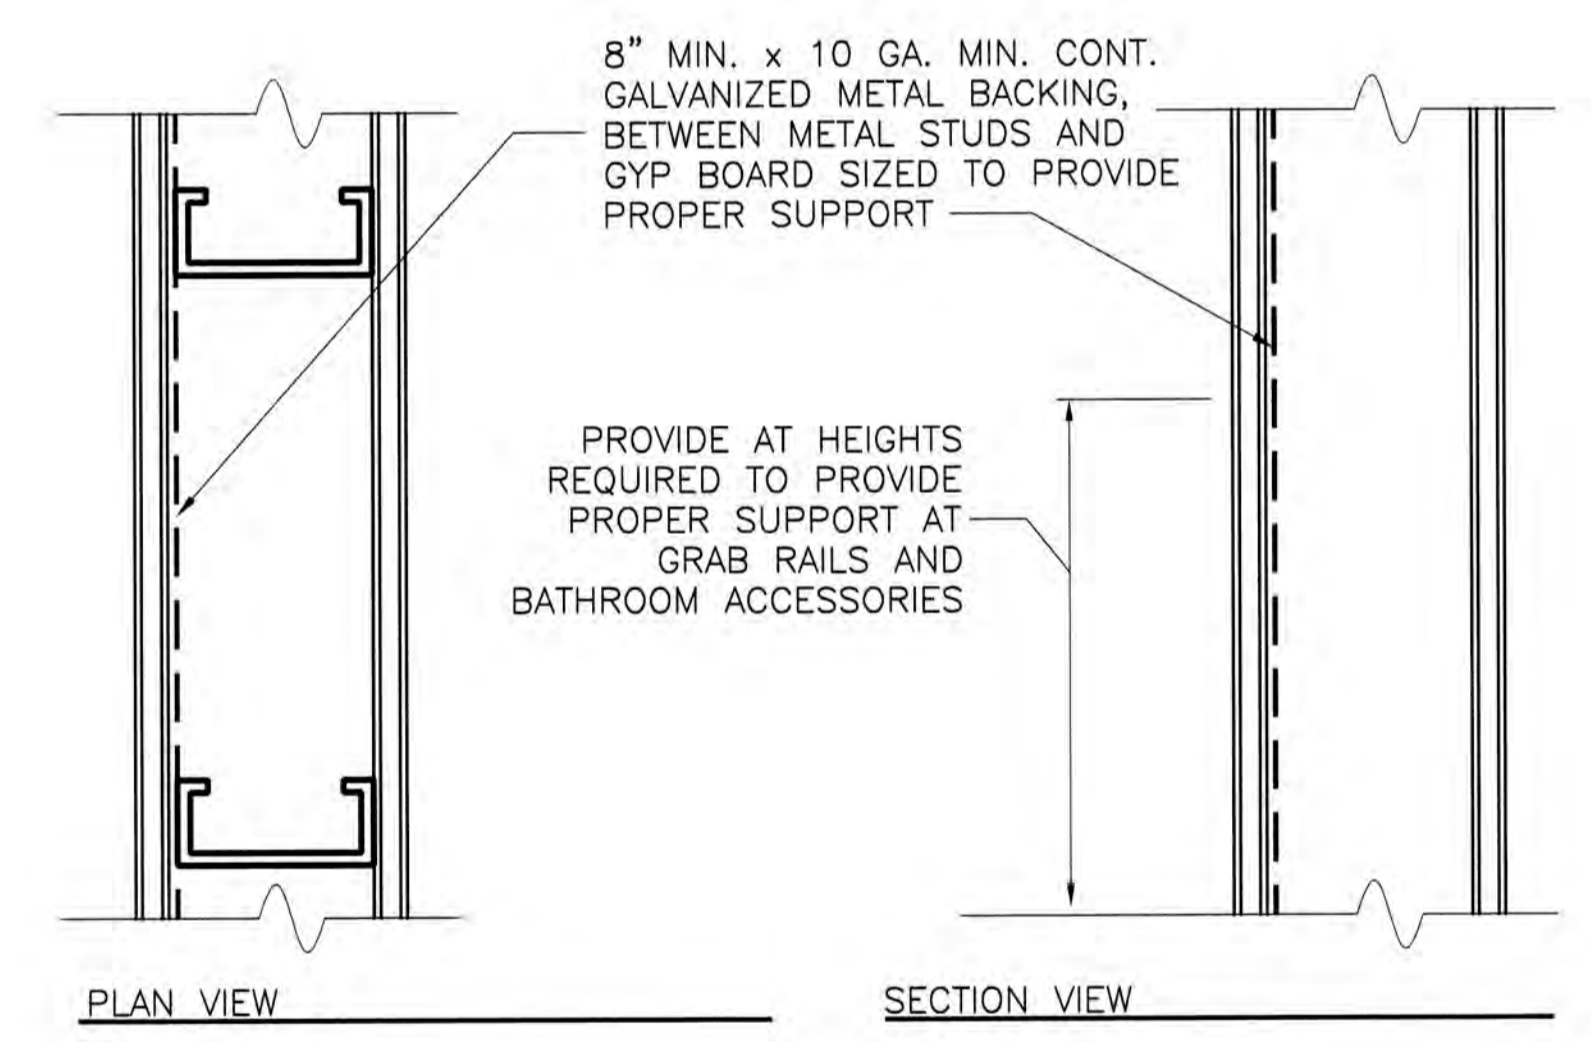

DETAIL 3 M401B
SCALE: 1 1/2"=1'-0"

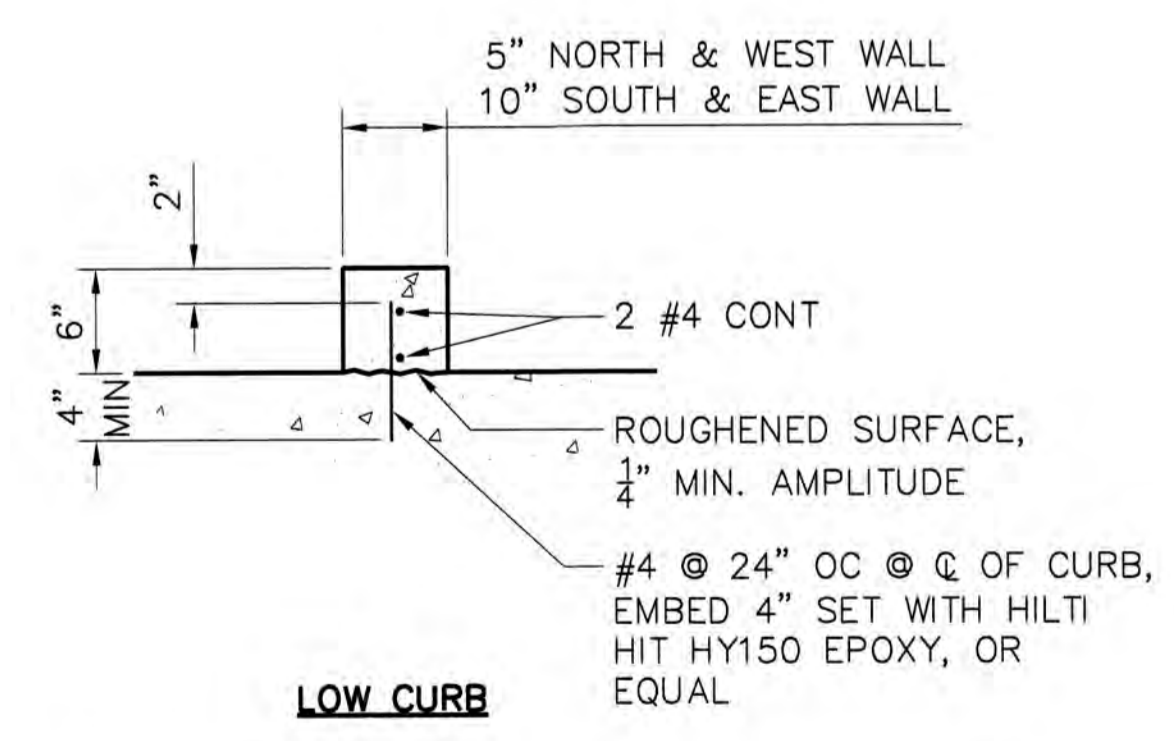

LOW CURB CONCRETE CURB
SCALE: NONE

RECORD DRAWINGS
14-Mile Slough Pump Station Upgrades

RESTROOM INTERIOR ELEVATIONS

DEPARTMENT OF MUNICIPAL UTILITIES CITY OF STOCKTON, CALIFORNIA		
SCALE: AS SHOWN	APPROVED BY: DATE:	SHEET No. M401.B
DESIGNED BY: OS		of 89 SHEETS
DRAWN BY: OS		PROJECT No. 293-00-05-01
CHECKED BY: PDF	ASSISTANT DIRECTOR, DEPT. OF MUNICIPAL UTILITIES	
RECORD Dwg.:		

REV. No.	DISCUSSION	DATE	BY	App'd By
1	BATHROOM DETAILS	7/5	OS	
2	RECORD DRAWINGS	8/08	OS	
3				
4				
5				
6				
7				

WEST YOST ASSOCIATES
Consulting Engineers

1260 Lake Boulevard
Suite 240
Davis, California 95616
(530) 756-5905
FAX (530) 756-5991

REFER TO BID SET FOR SIGNATURE

No. 66841

Underground Service Alert

TWO DAYS BEFORE YOU DIG

Call TOLL FREE: 1-800-642-2444

N:\Client\293_Spokane\00-05-01_14-MSPS_Upgrade\CAD\Design\Assemblies\293-0501M401.B.dwg 11-13-08 12:23:00 PM orimer

MECHANICAL SYMBOL LIST

DUCTWORK

- SUPPLY AIR
- RETURN OR EXHAUST AIR
- OUTSIDE AIR
- ROOM THERMOSTAT
- EQUIPMENT IDENTIFICATION
- DIFFUSER OR GRILLE IDENTIFICATION

DAMPERS

- VOLUME DAMPER
- FIRE DAMPER
- FIRE/SMOKE DAMPER
- SMOKE DAMPER
- MOTORIZED DAMPER

DUCTWORK FITTINGS

- MITERED ELBOW WITH TURNING VANES
- RADIUS ELBOW
- RECTANGULAR MAIN WITH ROUND BRANCH
- RECTANGULAR MAIN WITH RECTANGULAR BRANCH
- CONCENTRIC SQUARE TO ROUND
- ECCENTRIC TRANSITION, RECTANGULAR OR ROUND
- NON-SYMMETRICAL WYE
- SYMMETRICAL WYE
- RECTANGULAR DUCT RISER
- ROUND DUCT RISER
- RECTANGULAR DUCT DROP
- ROUND DUCT DROP
- RECTANGULAR OFFSET LESS THAN 15°
- RECTANGULAR OFFSET MORE THAN 15°
- ROUND WYE
- EXTRACTOR
- BELLMOUTH
- ROUND DUCT WITH ROUND BRANCH
- CONCENTRIC TRANSITION, RECTANGULAR OR ROUND
- ACOUSTICALLY LINED DUCT (SIZES SHOWN ARE NET INSIDE)
- FLEXIBLE CONNECTION

PIPING VALVES

- VALVE, GENERAL
- CHECK VALVE
- QUARTER TURN VALVE
- GLOBE VALVE

PIPING FITTINGS

- PIPE RISE
- PIPE DROP
- TEE UP ON PIPE
- TEE DOWN ON PIPE
- CONTINUATION
- CAP
- UNION
- PIPE BELOW GRADE
- HOSE BIBB

ABBREVIATIONS

- A/C AIR CONDITION(ED)
- AD ACCESS DOOR
- AFF ABOVE FINISHED FLOOR
- BDD BACKDRAFT DAMPER
- BFP BACKFLOW PREVENTER
- BFF BELOW FINISHED FLOOR
- BHP BRAKE HORSEPOWER
- CD CEILING DIFFUSER
- CD CONDENSATE DRAIN
- CV CHECK VALVE
- COP COEFFICIENT OF PERFORMANCE
- CONT. CONTINUATION
- CU CONDENSING UNIT
- CW COLD WATER
- D DROP
- DB DECIBEL
- DB DRY BULB
- DIA DIAMETER
- DX DIRECT EXPANSION
- EAT ENTERING AIR TEMPERATURE
- EER ENERGY EFFICIENCY RATING
- EF EXHAUST FAN
- EEF EFFICIENT
- ELECT ELECTRICAL
- EWT ENTERING WATER TEMPERATURE
- EXH EXHAUST
- F FAHRENHEIT
- FD FIRE DAMPER
- FLA FULL LOAD AMPS

- FT FEET
- GAL GALLONS
- GPH GALLONS PER HOUR
- GPM GALLONS PER MINUTE
- HD HEAD
- HP HORSEPOWER
- HTG HEATING
- HTR HEATER
- HWC HOT WATER COIL
- ID INSIDE DIAMETER
- IE INVERT ELEVATION
- IN INCHES
- KW KILOWATT
- LAT LEAVING AIR TEMPERATURE
- LBS. POUNDS
- LH LATENT HEAT
- MA MIXED AIR
- MAX MAXIMUM
- MBH THOUSAND BTU'S PER HOUR
- MD MOTORIZED DAMPER
- MIN MINIMUM
- N/A NOT APPLICABLE
- NIC NOT IN CONTRACT
- NO. NUMBER
- NTS NOT TO SCALE
- OA OUTSIDE AIR
- OBD OPPOSED BLADE DAMPER
- OC ON CENTER
- OD OUTSIDE DIAMETER
- PD PRESSURE DROP
- PH PHASE
- PRV PRESSURE REDUCING VALVE
- PSI POUNDS PER SQUARE INCH
- QTY QUANTITY
- R RISE
- RA RETURN AIR
- RET RETURN
- RPM REVOLUTIONS PER MINUTE
- SA SUPPLY AIR
- SEER SEASONAL ENERGY EFFICIENCY RATING
- SF SQUARE FEET
- SH SENSIBLE HEAT
- SOV SHUT OFF VALVE
- SP STATIC PRESSURE
- TD TEMPERATURE DIFFERENCE
- TEMP TEMPERATURE
- TH TOTAL HEAT
- TP TOTAL PRESSURE
- V VOLT
- W WATT
- W/ WITH
- WB WET BULB
- WC WATER COLUMN

ROOFTOP AIR CONDITIONING UNIT SCHEDULE

SYMBOL	AREA SERVED	AIR FLOW (CFM)	MIN OSA (CFM)	FAN E.S.P. (IN.H2O)	COOLING			HEATING			BASIS OF DESIGN	MAX WT (LBS)	ELECTRICAL			REMARKS
					TOTAL (MBH)	SENS. (MBH)	EER	INPUT (MBH)	OUTPUT (MBH)	MIN. EFF.			VOLT/PH	MCA	MOCP	
AC-1	ELECTRICAL ROOM	4,000	150	0.80	125.8	91.5	11.0	NONE	-	-	CARRIER 50HJ012---6-1	1,400	460/3	27.6	30	1,2,3
AC-2	ELECTRICAL ROOM	4,000	150	0.80	125.8	91.5	11.0	NONE	-	-	CARRIER 50HJ012---6-1	1,400	460/3	27.6	30	1,2,3

NOTES:

- PROVIDE FACTORY INSULATED ROOF CURB.
- PROVIDE 100% MODULATING ECONOMIZER WITH MODULATING POWER EXHAUST (MICROMETL 4682-0303)
- WEIGHT LISTED ABOVE INCLUDES WEIGHT OF CURB AND ECONOMIZER.

DIFFUSER, REGISTER AND GRILLE SCHEDULE

SYMBOL	TYPE	FACE	FRAME	DAMPER	FINISH	BASIS OF DESIGN	REMARKS
CD-1	CEILING DIFFUSER	ROUND ADJUSTABLE	SURFACE	NONE	WHITE	TITUS XC-310	1
CRG-1	CEILING RETURN GRILLE	EGGCRATE	SURFACE	NONE	WHITE	TITUS 50R	

NOTES:

- PROVIDE WITH TITUS AG-65 ADJUSTABLE DAMPER WITH GRID.

DRAWING INDEX

- H1 HVAC SCHEDULES, SYMBOLS AND ABBREVIATIONS
- H2 HVAC FLOOR PLAN
- H3 HVAC TITLE 24

RECORD DRAWINGS

14-Mile Slough Pump Station Upgrades

HVAC SYMBOLS, ABBREVIATIONS & EQUIPMENT SCHEDULES

DEPARTMENT OF MUNICIPAL UTILITIES
CITY OF STOCKTON, CALIFORNIA


SCALE: AS SHOWN	APPROVED BY: _____	DATE: _____	SHEET No.
DESIGNED BY: LAF			H1
DRAWN BY: LAF			55 of 89 SHEETS
CHECKED BY: LAF			PROJECT No. 293-00-05-01
RECORD DWG.:	ASSISTANT DIRECTOR, DEPT. OF MUNICIPAL UTILITIES		

Underground Service Alert



Contact
Larry Froess
Project
2006-0012

8950 CAL CENTER DR., SUITE 250, SACRAMENTO, CA 95826
PHONE 916.288.6200 FAX 916.288.6250

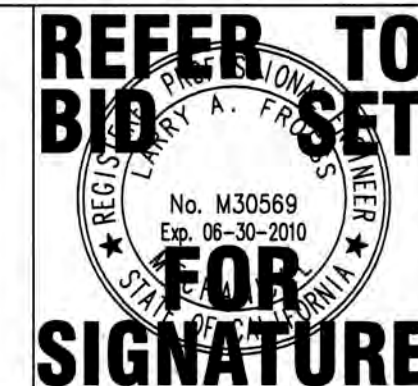

REV. No.	DISCRPTION	DATE	By	Apr'd By

WEST YOST
ASSOCIATES
Consulting Engineers

1260 Lake Boulevard
Suite 240
Davis, California 95616
(530) 756-5905
FAX (530) 756-5991

GENERAL NOTES

- A. COORDINATE EXACT LOCATION OF DIFFUSERS AND GRILLES WITH ARCHITECT BEFORE INSTALLING.
- B. EQUIPMENT SHALL BE SEISMICALLY RESTRAINED, IF REQUIRED.
- C. INSTALL EQUIPMENT PER MANUFACTURERS INSTRUCTIONS. DO NOT INSTALL OR MODIFY EQUIPMENT IN A WAY THAT WOULD VOID THE WARRANTY.
- D. CONDENSATE SHALL NOT ULTIMATELY DRAIN TO AN IMPERMEABLE SURFACE.
- E. MOUNT THERMOSTATS 48" AFF.
- F. PROVIDE APPROPRIATE TRANSITIONS AND FITTINGS AT THE DUCT CONNECTION TO EACH DIFFUSER AND GRILLE.
- G. PROVIDE SUPPORTS AND BRACING FOR EQUIPMENT, PIPING AND DUCTWORK, PER LATEST CMC, SMACNA, AND LOCAL ORDINANCES.
- H. PROVIDE FLEXIBLE CONNECTIONS AT CONNECTIONS TO AC UNITS.
- I. FRESH AIR INTAKES SHALL BE AT LEAST 10 FEET AWAY FROM OR 3 FEET BELOW ANY EXHAUST OUTLET OR PLUMBING VENT.
- J. ADJUST DIFFUSERS TO DISCHARGE SUPPLY AIR IN AN EVENLY DISTRIBUTED PATTERN.
- K. HEIGHT OF DIFFUSERS AND DUCTS (INCLUDING FLANGES AND SUPPORTS) SHALL NOT BE LOWER THAN 9'-0" A.F.F.
- L. DIFFUSERS ATTACHED TO THE UNDERSIDE OF THE DUCTWORK SHALL BE INSTALLED WITH A 'DAMPER WITH EQUALIZING GRID', TITUS MODEL AG-65 OR EQUAL.
- M. AIR-MOVING SYSTEMS SUPPLYING IN EXCESS OF 2000 CUBIC FEET PER MINUTE TO ENCLOSED SPACES WITHIN BUILDINGS SHALL BE EQUIPPED WITH AN AUTOMATIC SHUTOFF. SHUTOFFS SHALL STOP THE AIR-MOVING EQUIPMENT WHEN SMOKE IS DETECTED IN A SUPPLY AIR DUCT OR WHEN SMOKE IS DETECTED IN ROOMS SERVED BY THE SYSTEM. EXCEPTIONS: (1) ROOMS HAVE A DIRECT EXIT TO THE EXTERIOR OF THE BUILDING, OR (2) SYSTEMS ARE DESIGNED FOR SMOKE CONTROL (SEC. 608, CMC). IN-DUCT SMOKE DETECTORS SHALL HAVE A UL-268A LISTING COMPLYING WITH ALL AMBIENT CONDITIONS, FROM 0 CFM TO MAXIMUM ANTICIPATED CFM. (NOTE: THIS PROJECT FALLS UNDER EXCEPTION #1).

NOTES THIS SHEET


- ① ROUTE CONDENSATE LINE DOWN FROM ROOF AND SPILL TO LANDSCAPE.

SEQUENCE OF OPERATION


AC-1 SHALL BE PRIMARY UNIT FOR THE ROOM TO PROVIDE COOLING AT ALL TIMES. ADJUST AC-1 THERMOSTAT SETPOINT TO 80°.

AC-2 IS FOR BACKUP AND COMPENSATION PURPOSES. ADJUST AC-2 THERMOSTAT SETPOINT TO 90°.

AC-1 & AC-2 CAN BE MANUALLY SET FOR LEAD-LAG BY SWAPPING THE THERMOSTAT SETPOINTS ON A REGULAR INTERVAL.

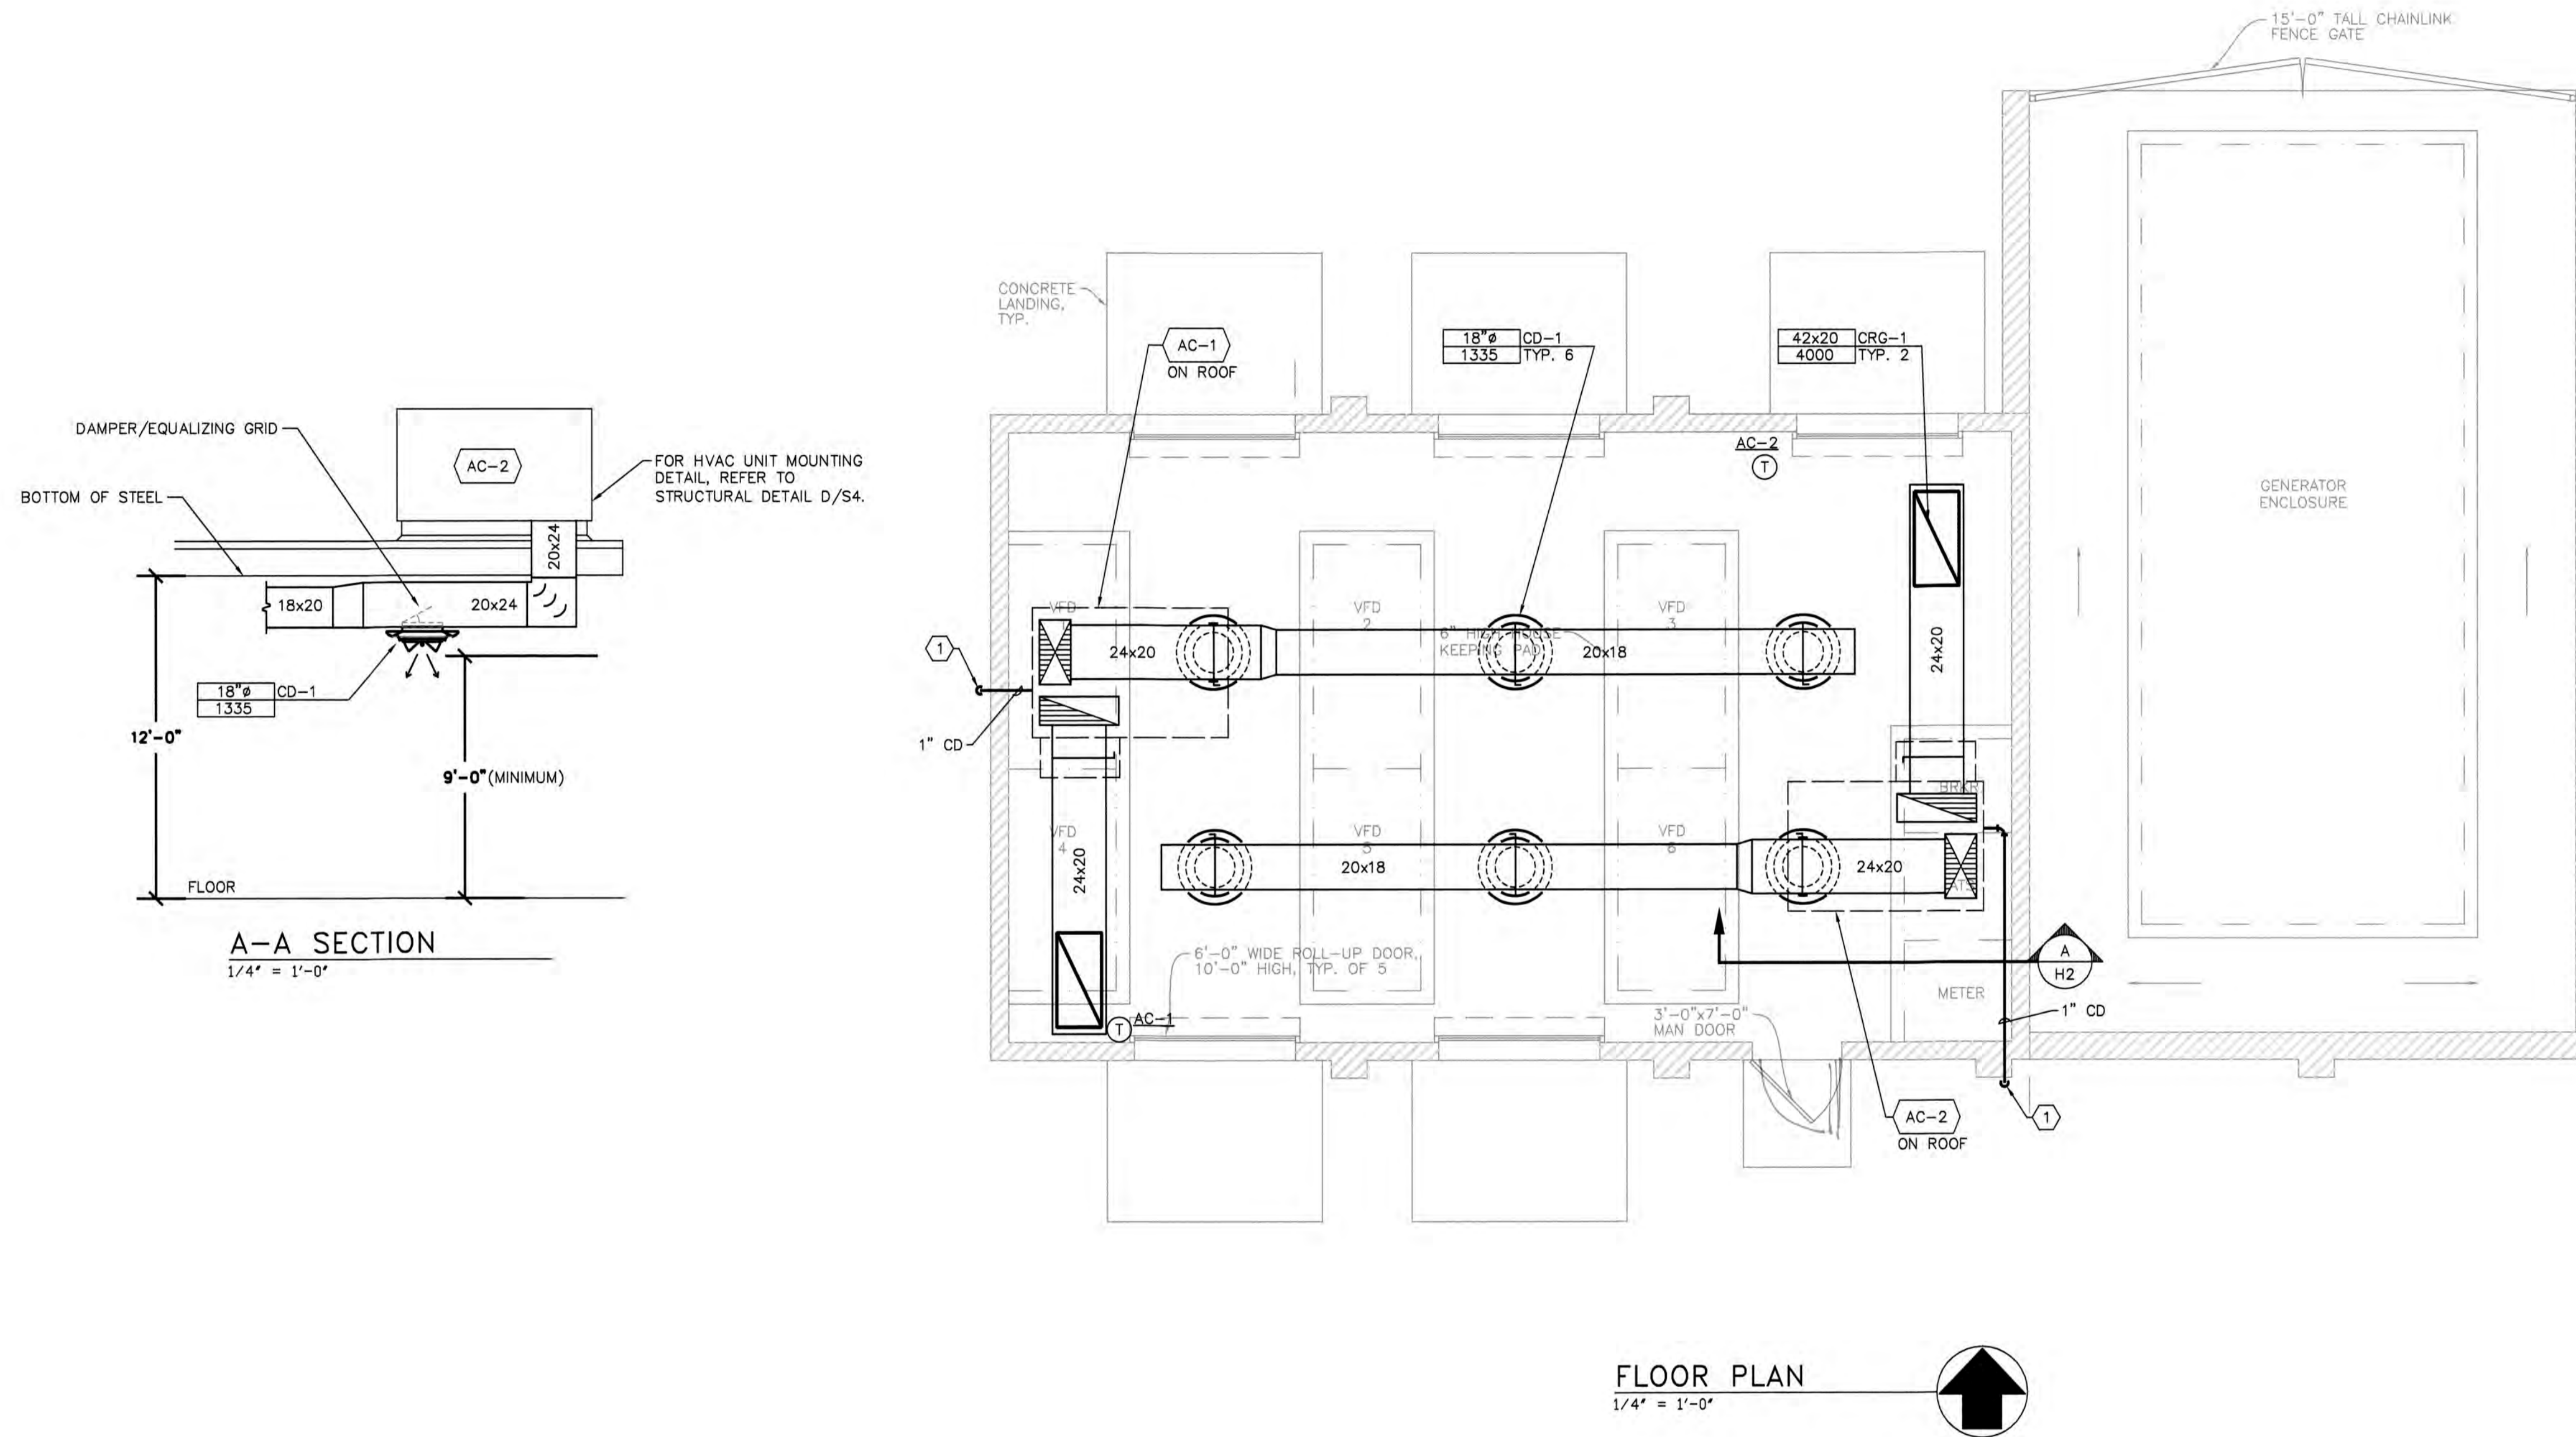

FLOOR PLAN
1/4" = 1'-0"

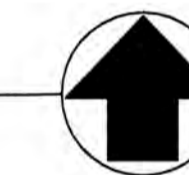

RECORD DRAWINGS

14-Mile Slough Pump Station Upgrades

HVAC FLOOR PLAN

DEPARTMENT OF MUNICIPAL UTILITIES
CITY OF STOCKTON, CALIFORNIA

SCALE: AS SHOWN	APPROVED BY: _____	DATE: _____	SHEET No.
DESIGNED BY: LAF			H2
DRAWN BY: LAF			56 of 89 SHEETS
CHECKED BY: LAF			PROJECT No. 293-00-05-01
RECORD Dwg.:	ASSISTANT DIRECTOR, DEPT. OF MUNICIPAL UTILITIES		

Underground Service Alert



TWO DAYS
BEFORE
YOU DIG

Call TOLL FREE: 1-800-642-2444

Contact
Larry Froese
Project
2006-0012

INTERFACE
ENGINEERING

8950 CAL CENTER DR., SUITE 250, SACRAMENTO, CA 95826
PHONE 916.288.6200 FAX 916.288.6290

**REFER TO
BID SET
FOR
SIGNATURE**

REV. No.	DISCRIPTION	DATE	BY	Appr'd By
1				
2				
3				
4				
5				
6				

WEST YOST
ASSOCIATES
Consulting Engineers

1260 Lake Boulevard
Suite 240
Davis, California 95616
(530) 756-5905
FAX (530) 756-5991

PERFORMANCE CERTIFICATE OF COMPLIANCE Part 1 of 3 PERF-1

PROJECT NAME: 14-Mile Slough Pump Station Upgrades DATE: 1/30/2006

PROJECT ADDRESS: Stockton

PRINCIPAL DESIGNER - ENVELOPE: West Yost & Associates (530) 756-5905 Building Permit #

DOCUMENTATION AUTHOR: INTERFACE ENGINEERING (516) 288-6200 Checked by Date: [Signature]

GENERAL INFORMATION

DATE OF PLANS: BUILDING CONDITIONED FLOOR AREA: 840 sq.ft. CLIMATE ZONE: 12

BUILDING TYPE: NONRESIDENTIAL HIGH RISE RESIDENTIAL HOTEL/MOTEL/GUEST ROOM

PHASE OF CONSTRUCTION: NEW CONSTRUCTION ADDITION ALTERATION EXISTING + ADDITION

STATEMENT OF COMPLIANCE

This Certificate of Compliance lists the building features and performance specifications needed to comply with Title 24, Parts 1 and 6 of the California Code of Regulations. This certificate applies only to a building using the performance compliance approach.

The documentation preparer hereby certifies that the documentation is accurate and complete.

DOCUMENTATION AUTHOR: Interface Engineering SIGNATURE: [Signature] DATE: 1/30/2006

The Principal Designer hereby certifies that the proposed building complies in this set of construction documents with the requirements of the California Code of Regulations, Title 24, Part 1 and 6, and with any other calculations submitted with this permit application. The proposed building as designed meets the energy efficiency requirements contained in sections 110, 115, 116, 117, 143 or 149 of Title 24, Part 6.

I, the undersigned, hereby certify that I am a duly licensed professional engineer or architect in the State of California.

I, the undersigned, hereby certify that I am eligible under the provisions of Division 3 of the Business and Professions Code to sign this document as the person responsible for its preparation, and that I am licensed in the State of California as a civil engineer, mechanical engineer, or I am a licensed architect.

I affirm that I am eligible under the provisions of Division 3 of the Business and Professions Code Section 5537.2 or 6737.3 to sign this document as the person responsible for its preparation, and that I am a licensed contractor performing this work.

I affirm that I am eligible under Division 3 of the Business and Professions Code to sign this document as the person responsible for its preparation, and that I am licensed pursuant to Business and Professions Code Sections 5537, 6539, and 6737.1 (These sections of the Business and Professions Code are printed in full in the Nonresidential Manual).

ENVELOPE COMPLIANCE

Indicate location on plans of Note Block for Mandatory Measures

Required Form: ENV-1

PRINCIPAL ENVELOPE DESIGNER - NAME: West Yost & Associates SIGNATURE: [Signature] LIC. NO.: DATE:

LIGHTING COMPLIANCE

Indicate location on plans of Note Block for Mandatory Measures

Required Form: This Submitted

PRINCIPAL LIGHTING DESIGNER - NAME: SIGNATURE: LIC. NO.: DATE:

MECHANICAL COMPLIANCE

Indicate location on plans of Note Block for Mandatory Measures

Required Forms: MECH-1, MECH-2, MECH-3, MECH-4, MECH-5

PRINCIPAL MECHANICAL DESIGNER - NAME: Interface Engineering SIGNATURE: [Signature] LIC. NO.: M30569 DATE: 1/30/2006

Run Initiation Time: 01/30/06 14:13:32 Run Code: 1138659212

EnergyPlus 4.0 by EnergySoft User Number: 4922 Job Number: Page 2 of 12

PERFORMANCE CERTIFICATE OF COMPLIANCE Part 2 of 3 PERF-1

PROJECT NAME: 14-Mile Slough Pump Station Upgrades DATE: 1/30/2006

ANNUAL TDV ENERGY USE SUMMARY (kBtu/sq.ft/yr)

ENERGY COMPONENT	Standard Design	Proposed Design	Compliance Margin
Space Heating	0.00	0.00	0.00
Space Cooling	670.50	615.48	84.02
Indoor Fans	459.03	461.79	-2.76
Heat Rejection	0.00	0.00	0.00
Pumps & Misc.	0.00	0.00	0.00
Domestic Hot Water	0.00	0.00	0.00
Lighting	48.81	40.88	7.93
Receptacle	10.74	10.74	0.00
Process	3,223.53	3,223.53	0.00
TOTALS:	4,413.62	4,362.37	51.25

Percent better than Standard: 1.16% (0.1% excluding process)

GENERAL INFORMATION

Building Orientation: (N) 0 deg. Unconditioned Floor Area: 840 sq.ft.

Number of Stories: 1 Unconditioned Floor Area: 840 sq.ft.

Number of Systems: 2 Conditioned Footprint Area: 840 sq.ft.

Number of Zones: 3 Fuel Type: Natural Gas

Front Elevation

Orientation	Gross Area	Glazing Area	Glazing Ratio
Front Elevation (N)	385 sq.ft.	0 sq.ft.	0.0%
Left Elevation (E)	220 sq.ft.	0 sq.ft.	0.0%
Rear Elevation (S)	385 sq.ft.	0 sq.ft.	0.0%
Right Elevation (W)	220 sq.ft.	0 sq.ft.	0.0%
Total	1,210 sq.ft.	0 sq.ft.	0.0%

Roof: 840 sq.ft. 0 sq.ft. 0.0%

Lighting Compliance

	Standard	Proposed
Lighting Power Density	0.700 W/sq.ft.	0.700 W/sq.ft.
Prescriptive Env. Heat Loss	589 Btu/h-F	589 Btu/h-F
Prescriptive Env. Heat Gain	21,633 Btu/h-F	25,130 Btu/h-F

Remarks:

Run Initiation Time: 01/30/06 14:13:32 Run Code: 1138659212

EnergyPlus 4.0 by EnergySoft User Number: 4922 Job Number: Page 3 of 12

PERFORMANCE CERTIFICATE OF COMPLIANCE Part 3 of 3 PERF-1

PROJECT NAME: 14-Mile Slough Pump Station Upgrades DATE: 1/30/2006

ZONE INFORMATION

System Name	Zone Name	Occupancy Type	Floor Area (sq.ft.)	Inst. LPO (W/sq.ft.)	Crit. Coeffs (W/sq.ft.)	Allowable LPO (W/sq.ft.)	Pres. Loads (W/sq.ft.)
AC-1 & 2	Elec Room	Electrical Mechanical Room	840	10.74			10.00

EXCEPTIONAL CONDITIONS COMPLIANCE CHECKLIST

The local enforcement agency should pay special attention to the items specified in this checklist. These items require special written justification and documentation, and special verification to be used with the performance approach. The local enforcement agency determines the adequacy of the justification, and may reject a building design that otherwise complies based on the adequacy of the special justification and documentation submitted.

The Room "Elec Room" has a Cooling Indoor Design Temperature of 65 degrees F.

Notes: 1. See LPO-C. 2. See LPO-C. 3. See LPO-C. 4. See LPO-C. 5. Items above require special documentation.

Run Initiation Time: 01/30/06 14:13:32 Run Code: 1138659212

EnergyPlus 4.0 by EnergySoft User Number: 4922 Job Number: Page 4 of 12

CERTIFICATE OF COMPLIANCE ENV-1-C

PROJECT NAME: 14-Mile Slough Pump Station Upgrades DATE: 1/30/2006

OPAQUE SURFACES

#	Surface Type	Area	U-Fac	Insulation	Act. Coef.	Cond. Status	Joint Appendix Status	Location / Comments
1	Roof	840	0.00	None	R-10	0	New	05-AS Elec Room
2	Wall	220	0.00	None	R-10	0	New	12-AS Elec Room
3	Door	190	1.45	None	R-2	0	New	28-A1 Elec Room
4	Wall	385	0.00	None	R-10	0	New	12-AS Elec Room
5	Wall	220	0.00	None	R-10	0	New	12-AS Elec Room
6	Door	190	1.45	None	R-2	0	New	28-A1 Elec Room
7	Wall	220	0.00	None	R-10	0	New	12-AS Elec Room

BENEFITATION SURFACES

#	Type	Area	U-Fac	SHGC	Act. Coef.	Cond. Status	Glazing Type	Location / Comments
---	------	------	-------	------	------------	--------------	--------------	---------------------

EXTERIOR SHADING

#	Exterior Shade Type	SHGC	Window Hgt. Wd.	Overhang Len. Hgt. LEAF:REAR	Left Fin. Dist. Len. Hgt.	Right Fin. Dist. Len. Hgt.
---	---------------------	------	-----------------	------------------------------	---------------------------	----------------------------

MINIMUM SKYLIGHT AREA FOR LARGE ENCLOSED SPACES

The proposed building contains an enclosed space with floor area greater than 25,000 sq. ft. A skylight greater than 15 feet and a LPO for general lighting of at least 0.5 Watts/sq.ft. must be provided. See Section 110.10 of the California Code of Regulations, Title 24, Part 6, for more information.

Run Initiation Time: 01/30/06 14:13:32 Run Code: 1138659212

EnergyPlus 4.0 by EnergySoft User Number: 4922 Job Number: Page 5 of 12

CERTIFICATE OF COMPLIANCE MECH-1-C

PROJECT NAME: 14-Mile Slough Pump Station Upgrades DATE: 1/30/2006

Designer:

This form is to be used by the designer and attached to the plans. Listed below are all the acceptance tests for mechanical systems. The designer is required to check the boxes by all acceptance tests that apply and list all equipment that requires an acceptance test. If all equipment of a certain type requires a test, list the equipment description and the number of systems to be tested in parentheses. The N2 number designates the Section in the Appendix of the Nonresidential ACM Manual that describes the test. Also indicate the person responsible for performing the tests (i.e. the installing contractor, design professional or an agent selected by the owner). Since this form will be part of the plans, completion of this section will allow the responsible party to budget for the scope of work appropriately.

Building Departments:

SYSTEM ACCEPTANCE: Before an occupancy permit is granted for a newly constructed building or space, or a new space-conditioning system serving a building or space is operated for normal use, all control devices serving the building or space shall be certified as meeting the Acceptance Requirements for Code Compliance.

In addition a Certificate of Acceptance, MECH-1-A Form shall be submitted to the building department that certifies plans, specifications, installation certificates, and operating and maintenance information meet the requirements of Section 10-103(b) and Title 24, Part 6.

STATEMENT OF COMPLIANCE

MECH-2-A: Ventilation System Acceptance Document
Variable Air Volume Systems Outdoor Air Acceptance
Constant Air Volume Systems Outdoor Air Acceptance
Equipment requiring acceptance testing.

MECH-3-A: Packaged HVAC System Acceptance Document
Equipment requiring acceptance testing.

MECH-4-A: Air Distribution Acceptance Document
Equipment requiring acceptance testing.

MECH-5-A: Air-Size Economizer Acceptance Document
Equipment requiring acceptance testing.

MECH-6-A: Demand Control Ventilation Acceptance Document
Equipment requiring acceptance testing.

MECH-7-A: Supply Fan Variable Flow Control Acceptance Document
Equipment requiring acceptance testing.

MECH-8-A: Hydronic System Control Acceptance Document
Variable Flow Controls
Automatic Isolation Controls
Water-loop Heat Pump Controls
Variable Frequency Controls
Equipment requiring acceptance testing.

EnergyPlus 4.0 by EnergySoft User Number: 4922 Job Number: Page 6 of 12

ENVELOPE MANDATORY MEASURES ENV-MM

PROJECT NAME: 14-Mile Slough Pump Station Upgrades DATE: 1/30/2006

DESCRIPTION	Designer	Enforcement
<input checked="" type="checkbox"/> 118(a) Installed Insulating Material shall have been certified by the manufacturer to comply with the California Quality Standards for insulating material, Title 26, Chapter 4, Article 3.		
<input checked="" type="checkbox"/> 118(c) All Insulating Materials shall be installed in compliance with the flame spread rating and smoke density requirements of Sections 902 and 707 of Title 24, Part 2.		
<input checked="" type="checkbox"/> 117(a) All Exterior Joints and openings in the building that are observable sources of air leakage shall be caulked, gasketed, weatherstripped or otherwise sealed.		
<input checked="" type="checkbox"/> 118(b) Site Constructed Doors, Windows and Skylights shall be caulked between the unit and the building, and shall be weatherstripped (except for unframed glass doors and fire doors).		
<input checked="" type="checkbox"/> 118(a) Manufactured Doors and Windows installed shall have air infiltration rates not exceeding those shown in Table Number 1-E, of the Standards. Manufactured fenestration products must be labeled for U-value according to NFRC procedures.		
<input checked="" type="checkbox"/> 118(e) Demising Walls in Nonresidential Buildings: The opaque portions of framed demising walls in nonresidential buildings shall have insulation with an installed R-value of no less than R-11 between framing members.		

EnergyPlus 4.0 by EnergySoft User Number: 4922 Job Number: Page 7 of 12

MECHANICAL MANDATORY MEASURES Part 1 of 2 MECH-MM

PROJECT NAME: 14-Mile Slough Pump Station Upgrades DATE: 1/30/2006

DESCRIPTION	Designer	Enforcement
<input checked="" type="checkbox"/> 111 Equipment for which there is a California standard established in the Appliance Efficiency Regulations will comply with the applicable standard.		
<input type="checkbox"/> 115(a) Fan type central furnaces shall not have a pilot light.		
<input checked="" type="checkbox"/> 123 Piping, except that conveying fluids at temperatures between 60 and 105 degrees Fahrenheit, or within HVAC equipment, shall be insulated in accordance with Standards Section 123.		
<input checked="" type="checkbox"/> 124 Air handling duct systems shall be installed and insulated in compliance with Sections 601, 603 and 604 of the Uniform Mechanical Code.		
<input checked="" type="checkbox"/> 122(a) Each space conditioning system shall be installed with one of the following: 122(a)(1) Each space conditioning system serving building types such as offices and manufacturing facilities (and all others not explicitly exempt from the requirements of Section 112.60) shall be installed with an automatic time switch with an accessible manual override that allows operation of the system during off-hours for up to 4 hours. The time switch shall be capable of programming different schedules for weekdays and weekends and have program backup capabilities that prevent the loss of the device's program and time setting for at least 10 hours if power is interrupted; or 122(a)(2) An occupancy sensor to control the operating period of the system; or 122(a)(3) A 4-hour timer that can be manually operated to control the operating period of the system.		
<input type="checkbox"/> 122(b) Each space conditioning system shall be installed with controls that temporarily reset and temporarily operate the system as required to maintain a setback heating and/or a setpoint cooling thermostat setpoint.		
<input type="checkbox"/> 122(c) Each space conditioning system serving multiple zones with a combined conditioned floor area more than 25,000 square feet shall be provided with isolation zones. Each zone shall not exceed 25,000 square feet, shall be provided with isolation devices, such as valves or dampers, that allow the supply of heating or cooling to be setback or shut off independently of other isolation areas; and shall be controlled by a time control device as described above.		
<input checked="" type="checkbox"/> 122(a)(b) Each space conditioning system shall be controlled by an individual thermostat that responds to temperature within the zone. Where used to control heating, the control shall be adjustable down to 55 degrees F or lower. For cooling, the control shall be adjustable up to 85 degrees F or higher. Where used for both heating and cooling, the control shall be capable of providing a deadband of at least 3 degrees F within which the supply of heating and cooling is shut off or reduced to a minimum. Thermostats shall have numeric setpoints in degrees Fahrenheit (F) and adjustable setpoint stops accessible only to authorized personnel.		
<input checked="" type="checkbox"/> 122(c) Heat pumps shall be installed with controls to prevent electric resistance supplementary heater operation when the heating load can be met by the heat pump alone.		

EnergyPlus 4.0 by EnergySoft User Number: 4922 Job Number: Page 8 of 12

MECHANICAL MANDATORY MEASURES Part 2 of 2 MECH-MM

PROJECT NAME: 14-Mile Slough Pump Station Upgrades DATE: 1/30/2006

Description	Designer	Enforcement
<input checked="" type="checkbox"/> 121(a) Controls shall be provided to allow outside air dampers or devices to be operated at the ventilation rates as specified on these plans.		
<input type="checkbox"/> 122(i) Gravity or automatic dampers interlocked and closed on fan shutdown shall be provided on the outside air intakes and discharges of all space conditioning and exhaust systems.		
<input type="checkbox"/> 122(j) All gravity ventilating systems shall be provided with automatic or readily accessible manually operated dampers in all openings to the outside, except for combustion air openings.		
<input checked="" type="checkbox"/> 121(i) Air Balancing: The system shall be balanced in accordance with the National Environmental Balancing Bureau (NEBB) Procedural Standards (1993), or Associated Air Balance Council (AABC) National Standards (1990); or 121(i)(2) Outside Air Certification: The system shall provide the minimum outside air as shown on the mechanical drawings, and shall be measured and certified by the installing licensed C-20 mechanical contractor and certified by (1) the design mechanical engineer, (2) the installing licensed C-20 mechanical contractor, or (3) the person with overall responsibility for the design of the ventilation system; or 121(i)(3) Outside Air Measurement: The system shall be equipped with a calibrated local or remote device capable of measuring the quantity of outside air on a continuous basis and displaying that quantity on a readily accessible display device; or 121(i)(4) Another method approved by the Commission.		
<input type="checkbox"/> Service Water Heating Systems 113(b)(2) If a circulating hot water system is installed, it shall have a control capable of automatically turning off the circulating pump(s) when hot water is not required. 113(b)(3) Lavatories in restrooms of public facilities shall be equipped with controls to limit the outlet temperature to 110 degrees F. 113(b)(3) Lavatories in restrooms of public facilities shall be equipped with one of the following: Outlet devices that limit the flow of hot water to a maximum of 0.5 gallons per minute. Foot actuated control valves, and outlet devices that limit the flow of hot water to a maximum of 0.75 gallons per minute. Proximity sensor actuated control valves, and outlet devices that limit the flow of hot water to a maximum of 0.75 gallons per minute. Self-closing valves, and outlet devices that limit the flow of hot water to a maximum of 2.5 gallons per minute, and 0.25 gallons/cycle (non-circulating system). Self-closing valves, and outlet devices that limit the flow of hot water to a maximum of 2.5 gallons per minute, and 0.50 gallons/cycle (non-circulating system). Self-closing valves, and outlet devices that limit the flow of hot water to a maximum of 2.5 gallons per minute, and 0.75 gallons/cycle (foot switches and proximity sensor controls).		

EnergyPlus 4.0 by EnergySoft User Number: 4922 Job Number: Page 9 of 12



Contact Larry Froese Project 2006-0012

INTERFACE ENGINEERING

8950 CAL CENTER DR., SUITE 200, SACRAMENTO, CA 95826
PHONE 916.288.6200 FAX 916.288.6250

REFER TO BID SET FOR SIGNATURE

No. M30569 Exp. 06-30-2010

REV. No.	DISCRPTION	DATE	BY	Apr'd By
1				
2				
3				
4				
5				
6				

WEST YOST ASSOCIATES

Consulting Engineers

1260 Lake Boulevard Suite 240 Davis, California 95616 (530) 756-5905 FAX (530) 756-5991

RECORD DRAWINGS

14-Mile Slough Pump Station Upgrades

HVAC TITLE 24

DEPARTMENT OF MUNICIPAL UTILITIES CITY OF STOCKTON, CALIFORNIA

SCALE: AS SHOWN APPROVED BY: DATE: SHEET No. H3 57 of 89 SHEETS PROJECT No. 293-00-05-01

DESIGNED BY: LAF DRAWN BY: LAF CHECKED BY: LAF RECORD Dwg.:

ASSISTANT DIRECTOR, DEPT. OF MUNICIPAL UTILITIES

MISCELLANEOUS ELECTRICAL & INSTRUMENTATION ABBREVIATIONS			
&	AND	MTR	MOTOR
AT	AT	MUX	MULTIPLIER
A	AMBER, AMPERES	MV	MERCURY VAPOR
AC	ALTERNATING CURRENT	N	NEUTRAL
AFF	ABOVE FINISHED FLOOR	NC	NORMALLY CLOSED
AI	ANALOG INPUT	NIC	NOT IN CONTRACT
AIC	AMP INTERRUPTING CAPACITY SYMMETRICAL	NL	NIGHT LIGHT
ALT	ALTERNATOR	NO	NORMALLY OPEN
AM	AMMETER	NP	NAMEPLATE
AO	ANALOG OUTPUT	NTS	NOT TO SCALE
AWG	AMERICAN WIRE GAUGE	(N)	NEW
B	BLUE	OC	ON CENTER
BC	BARE COPPER	OL	OVERLOAD
BFC	BELOW FINISHED CEILING	ORP	OXIDATION REDUCTION POTENTIAL
BOD	BIOCHEMICAL OXYGEN DEMAND	P	PHASE, POLE
C	CONDUIT	PB	PUSHBUTTON
CAP	CAPACITOR	PBX	PULL BOX
CB	CIRCUIT BREAKER	PC	PERSONAL COMPUTER
CKT	CIRCUIT	PF	POWER FAIL
COAX	COAXIAL CABLE	PFR	POWER (PHASE) FAIL RELAY
COMM	COMMUNICATION PORT	PH	HYDROGEN ION CONCENTRATION
CPT	CONTROL POWER TRANSFORMER	PI	PULSE INPUT
CR	CONTROL RELAY	PLC	PROGRAMMABLE LOGIC CONTROLLER
CT	CURRENT TRANSFORMER	PMP	PUMP
CTQ	CONSTANT TORQUE	PNL	PANEL
CTR	CYCLE COUNTER	POT	POTENTIOMETER
CU	COPPER	PR	PAIR, TWISTED & SHIELDED CABLE
DC	DIRECT CURRENT	PRESS	PRESSURE
DET	DETAIL	PRI	PRIMARY
DI	DIGITAL INPUT	PROVIDE	FURNISH, INSTALL & CONNECT
DIAG	DIAGRAM	PRR	POWER RELAY
DISC	DISCONNECT	PS	PRESSURE SWITCH
DO	DIGITAL OUTPUT	PT	POTENTIAL TRANSFORMER
DPDT	DOUBLE POLE DOUBLE THROW	PTT	PUSH TO TEST
DWG	DRAWING	PV	PROCESS VARIABLE
ELEV	ELEVATION	PVC	POLY VINYL CHLORIDE
EMT	ELECTRICAL METALLIC TUBING	PWR	POWER
ETM	ELAPSED TIME METER	R	RED
(E)	EXISTING	RCT	REPEAT CYCLE TIMER
F	FRAME	REF	REFERENCE
FC	FAIL CLOSED	RIO	REMOTE I/O
FCS	FIELD CONTROL STATION	RMS	ROOT MEAN SQUARED
FLA	FULL LOAD AMPS	RT	RESET TIMER
FLP	FAIL LAST POSITION	RTD	RESISTANCE TEMPERATURE DETECTOR
FO	FAIL OPEN	RTM	RUN TIME METER
FLR	FLASHER RELAY	RTU	REMOTE TELEMETRY UNIT
FLUOR	FLUORESCENT	RVNR	REDUCED VOLTAGE NON-REVERSING
FLEX	FLEXIBLE, METAL LIQUID TIGHT CONDUIT	(R)	REWIRE, RELOCATE, REVISE, REUSE
FS	FLOW SWITCH OR FULL SPEED	S	SWITCH
FV, FVNR	FULL VOLTAGE NON-REVERSING	SCH	SCHEDULE
FVR	FULL VOLTAGE REVERSING	SEC	SECONDARY
FWD	FORWARD	SECS	SECONDS
(F)	FUTURE	SEL	SELECTOR
G	GREEN	SFA	SERVICE FACTOR AMPS
GALV	GALVANIZED	SP	SET POINT
GFI	GROUND FAULT CIRCUIT INTERRUPTER	SPEC	SPECIFICATION
GND	GROUND	SR	SENSING RELAY
GRS	GALVANIZED RIGID STEEL CONDUIT	SS	STAINLESS STEEL
GRS-PVC	PVC COATED GRS CONDUIT	SSS	SOLID SOFT STARTER
GS	GALVANIZED STEEL	STT	START
HI	HIGH	STP	STOP
HID	HIGH INTENSITY DISCHARGE	SV	SOLENOID VALVE
HIM	HUMAN INTERFACE MODULE	SW	SWITCH
HOA	HAND-OFF-AUTO	SWBD	SWITCHBOARD
HP	HORSEPOWER	SYMM	SYMMETRICAL
HPS	HIGH PRESSURE SODIUM	T	TRIP
HS	HAND SWITCH	TB	TERMINAL BLOCK
HTR	HEATER	TC	TIME CLOCK
HZ	HERTZ (CYCLES PER SECOND)	TDOD	TIME DELAY ON DE-ENERGIZATION
HZD	HAZARDOUS AREA, EXPLOSION PROOF	TDOE	TIME DELAY ON ENERGIZATION
I	INTERLOCK	TEL	TELEMETRY
I/O	INPUT/OUTPUT	TELCO	TELEPHONE COMPANY
ICR	INSTRUMENTATION CONTROL RELAY	TM	THERMAL MAGNETIC
INCAN	INCANDESCENT	TEMP	TEMPERATURE
INST	INSTANTANEOUS	TOC	TOTAL ORGANIC CARBON
ISC	SHORT CKT INTERRUPTING CURRENT (SYMM)	TR	TIME DELAY RELAY
ISR	INTRINSICALLY SAFE RELAY	TRIAD	TWISTED & SHIELDED 3 CONDUCTOR
J	JUNCTION BOX	TS	TEMPERATURE SWITCH
K	KILO, PREFIX	TSPR	TWISTED & SHIELDED PAIR
LA	LIGHTNING ARRESTOR	TYP	TYPICAL
LC	LIGHTING CONTACTOR	UG	UNDERGROUND
LEL	LOWER EXPLOSIVE LIMIT	UON	UNLESS OTHERWISE NOTED
LO	LOW	V	VOLTAGE
LOS	LOCK-OUT STOP SWITCH	VA	VOLT AMPS
LPU	LINE PROTECTION UNIT	VAR	VOLT AMP REACTIVE
LR	LATCHING RELAY	VFD	VARIABLE FREQUENCY DRIVE
LS	LEVEL SWITCH	VLV	VALVE
M	MOTOR CONTACTOR	VM	VOLTMETER
MAX	MAXIMUM	VTQ	VARIABLE TORQUE
MCC	MOTOR CONTROL CENTER	W	WHITE, WAITS
MCM	THOUSAND CIRCULAR MILS	WHM	WATT-HOUR METER
MCP	MOTOR CIRCUIT PROTECTOR	WM	WATTMETER
MD	MOISTURE DETECTION	WP	WATERPROOF, WEATHER PROOF
MH	MANHOLE	WS	TORQUE SWITCH
MH	METAL HALIDE	XFMR	TRANSFORMER
MIN	MINIMUM	XS	MISCELLANEOUS SWITCH
MINS	MINUTES	Y	YELLOW
MODEM	MODULATOR/DEMULATOR	Z	IMPEDANCE
MOV	MOTOR OPERATED VALVE	ZS	LIMIT SWITCH

SYMBOL	DESCRIPTION	SYMBOL	DESCRIPTION	SYMBOL	DESCRIPTION	SYMBOL	DESCRIPTION
SWITCHES - PROCESS				DEVICES - RELAY			
	FLOW SWITCH - CLOSURES UPON INCREASING FLOW		CONTROL RELAY CR1 WITH NORMALLY OPEN CONTACT ON LINE 28 & NORMALLY CLOSED CONTACT ON LINE 111		RESISTOR		PANEL OR EQUIPMENT WIRING
	FLOW SWITCH - OPENS UPON INCREASING FLOW		TIME DELAY RELAY TR2 - ADJUSTABLE TIME DELAY RANGE & SETTING AS SHOWN		POTENTIOMETER		FIELD WIRING
	LEVEL SWITCH - CLOSURES UPON INCREASING LEVEL		TIME DELAY ON ENERGIZATION TIME DELAY ON DE-ENERGIZATION		CAPACITOR, FIXED		CONDUCTORS - NOT CONNECTED
	LEVEL SWITCH - OPENS UPON INCREASING LEVEL		CONTACTOR OR STARTER M1		CAPACITOR, ADJUSTABLE		CONDUCTORS - CONNECTED
	PRESSURE SWITCH - CLOSURES UPON INCREASING PRESSURE (INCREASING VACUUM)		SOLENOID		DIODE, ZENER		GROUND
	PRESSURE SWITCH - OPENS UPON INCREASING PRESSURE (INCREASING VACUUM)		NORMALLY OPEN, RELAY CONTACT - ACTUATED BY RELAY CR1 COIL LOCATED ON LINE 105		VARIABLE TRANSIENT VOLTAGE SUPPRESSOR		CHASSIS OR FRAME GROUND
	TEMPERATURE SWITCH - CLOSURES UPON INCREASING TEMPERATURE		NORMALLY CLOSED, RELAY CONTACT - ACTUATED BY RELAY CR1		VOLTAGE SURGE SUPPRESSOR, AC		PLUG AND RECEPTACLE
	TEMPERATURE SWITCH - OPENS UPON INCREASING TEMPERATURE		NORMALLY OPEN, TIME DELAY RELAY CONTACT - CONTACT CLOSURES AFTER TR2 IS ENERGIZED		LIGHT EMITTING DIODE		INCOMING LINE
	LIMIT SWITCH - CLOSURES AT SET LIMIT		NORMALLY CLOSED, TIME DELAY RELAY CONTACT - CONTACT OPENS AFTER TR2 IS ENERGIZED		TRANSISTOR		TERMINAL BLOCKS
	LIMIT SWITCH - OPENS AT SET LIMIT		NORMALLY OPEN, TIME DELAY RELAY CONTACT - CONTACT OPENS AFTER TR2 IS DE-ENERGIZED		RESISTANCE TEMPERATURE DETECTOR (RTD)		TERMINALS
	PROXIMITY SWITCH - CLOSURES UPON DECREASING DISTANCE		NORMALLY CLOSED, TIME DELAY RELAY CONTACT - CONTACT CLOSURES AFTER TR2 IS DE-ENERGIZED		THERMISTOR		SHIELDED CABLE
	PROXIMITY SWITCH - OPENS UPON DECREASING DISTANCE		CONTACT OPENS AND CLOSURES IN A TIMED REPEAT CYCLE	DEVICES - MISCELLANEOUS			
	TORQUE SWITCH - CLOSURES UPON INCREASING TORQUE		AUDIBLE ALARM		TACHOMETER GENERATOR	PLAN - SYMBOLS	
	TORQUE SWITCH - OPENS UPON INCREASING TORQUE		BATTERY		HEATER		CONDUIT, EXPOSED
SWITCHES - OPERATOR				DEVICES - FRONT PANEL			
	TOGGLE OR DISCONNECT SWITCH		INDICATING LIGHT, LETTER "X" INDICATES COLOR: R=RED G=GREEN, A=AMBER, W=WHITE Y=YELLOW, B=BLUE		3 PHASE HEATER		CONDUIT STUBBED OUT & CAPPED
	PUSHBUTTON - NORMALLY OPEN, MOMENTARY ACTION		INDICATING LIGHT, PUSH TO TEST		3 PHASE MOTOR # = MOTOR HP		CONDUIT BENDS TOWARD OBSERVER
	PUSHBUTTON - NORMALLY CLOSED, MOMENTARY ACTION		AMP METER		SINGLE PHASE MOTOR		CONDUIT BENDS AWAY FROM OBSERVER
	PUSHBUTTON, MECHANICALLY INTERLOCKED, DOUBLE CIRCUIT - NORMALLY CLOSED AND NORMALLY OPEN, MAINTAINED ACTION		VOLT METER		TRANSFORMER		CONDUIT ENDS
	SELECTOR SWITCH, 3 POSITION - CONTACT STATUS SHOWN EXISTS AT POSITION OF H-HAND, O-OFF, OR A-AUTO		ELAPSED TIME METER	DEVICES - PROTECTIVE			
	SELECTOR SWITCH, 2 POSITION - CONTACT STATUS SHOWN EXISTS AT POSITION AS SHOWN		RUN TIME METER		DISCONNECT, 3 POLE		FIELD CONTROL STATION WITH JUNCTION BOX
DEVICES - PROTECTIVE					CIRCUIT BREAKER, 3 POLE THERMAL MAGNETIC (TM) OR MOTOR CIRCUIT PROTECT (MCP)		FIELD CONTROL STATION WITH #AMP DISCONNECT SWITCH
DEVICES - PROTECTIVE					THERMAL OVERLOAD CONTACT		FIELD MOUNTED DEVICE
DEVICES - PROTECTIVE					THERMAL OVERLOAD ELEMENT		SPECIAL RECEPTACLE
DEVICES - PROTECTIVE					FUSE WITH BLOWN FUSE INDICATING LIGHT		JUNCTION BOX
DEVICES - PROTECTIVE					FUSE		THERMOSTAT
DEVICES - PROTECTIVE					FUSE		LIGHTING, FANS, HEATERS
DEVICES - PROTECTIVE					FUSE		# - CIRCUIT BREAKER NUMBER
DEVICES - PROTECTIVE					FUSE		A - FIXTURE SCHEDULE REF.
DEVICES - PROTECTIVE					FUSE		o - CONTROL SWITCH REFERENCE
DEVICES - PROTECTIVE					FUSE		DUPLEX RECEPTACLE
DEVICES - PROTECTIVE					FUSE		TOGGLE SWITCH
DEVICES - PROTECTIVE					FUSE		# - CIRCUIT BREAKER NUMBER SUBSCRIPT - CIRCUIT CONTROLLED
DEVICES - PROTECTIVE					FUSE		SUPERSCRIPT - BLANK = 1 POLE 2 = 2 POLE 3 = 3 WAY
DEVICES - PROTECTIVE					FUSE		CONDUIT #

N:\Clients\293_Spanos\00-05-01 14-MSPS Upgrades\CAD\Drawings\0507CE001.dwg 11-13-08 12:28:40 PM preimer

T.E.E.M.
 (916) 457-8144
 FILE: 0507C E001

Underground Service Alert

TWO DAYS BEFORE YOU DIG
 Call TOLL FREE: 1-800-642-2444

REFER TO SET FOR SIGNATURE

REV. No.	DISCRPTION	DATE	BY	Apr'd By
1				
2				
3				
4				
5				
6				
7				

WEST YOST ASSOCIATES
 Consulting Engineers

1260 Lake Boulevard
 Suite 240
 Davis, California 95616
 (530) 756-5905
 FAX (530) 756-5991

RECORD DRAWINGS
14-Mile Slough Pump Station Upgrades


ELECTRICAL SYMBOLS AND ABBREVIATIONS

DEPARTMENT OF MUNICIPAL UTILITIES
 CITY OF STOCKTON, CALIFORNIA

SCALE:	APPROVED BY: DATE:	SHEET No.
DESIGNED BY: SMK		E1
DRAWN BY: ZK		58 of 89 SHEETS
CHECKED BY: XML	ASSISTANT DIRECTOR, DEPT. OF MUNICIPAL UTILITIES	PROJECT No. 293-00-05-01
RECORD Dwg.:		

INITIAL LOAD CALCULATIONS	UTILITY SERVICE						GENERATOR SERVICE	
	LOAD AMPS	QTY	LOAD VA	RUN AMPS	QTY	RUN VA	QTY	RUN VA
300 PUMP	361	4	1,200,519		4	1,200,519	2	600,260
1 GATE	2.1	2	3,492		2	3,492	1	1,746
1 HOIST	2.1	1	1,746		1	1,746	1	1,746
MCC-M (E)	158	1	131,715		1	131,715	1	131,715
BLOCK HEATER	15.4	1	12,800		1	12,800	0	12,800
PANELBOARD "LP"	9.7		8,058			8,058		8,058
SUBTOTAL	1,634		1,358,329	1,634		1,358,329		756,324
DIVERSITY FACTOR			100 %					
300 HP				300,130	0.25	75,032		
Largest motor @ 25% additional								
TOTAL						1,433,361		
/ 480 V, 3 Phase 4 Wire Service Amps =	1,724 Amps						AMPS=	910
	1.25 Multiplier							
	Service Size =						KVA=	756
	Main Size =						%GEN	
	% Main Load =						LOAD=	30.3%

ULTIMATE LOAD CALCULATIONS	UTILITY SERVICE						GENERATOR SERVICE	
	LOAD AMPS	QTY	LOAD VA	RUN AMPS	QTY	RUN VA	QTY	RUN VA
300 PUMP	361	6	1,800,779		5	1,500,649	5	1,500,649
1 VALVE	2.1	2	3,492		2	3,492	2	3,492
1 HOIST	2.1	1	1,746		11	19,205	1	1,746
MCC-M (E)	158	1	131,715		1	131,715	1	131,715
BLOCK HEATER	15.4	1	12,800		1	12,800	0	12,800
PANELBOARD "LP"	9.7		8,058			8,058		8,058
SUBTOTAL	2,356		1,958,589	2,016		1,675,918		1,658,459
DIVERSITY FACTOR			86 %					
300 HP				300,130	0.25	75,032		
Largest motor @ 25% additional								
TOTAL						1,750,950		
/ 480 V, 3 Phase 4 Wire Service Amps =	2,106 Amps						AMPS=	1,995
	1.25 Multiplier							
	Service Size =						KVA=	1,658
	Main Size =						%GEN	
	% Main Load =						LOAD=	66.3%

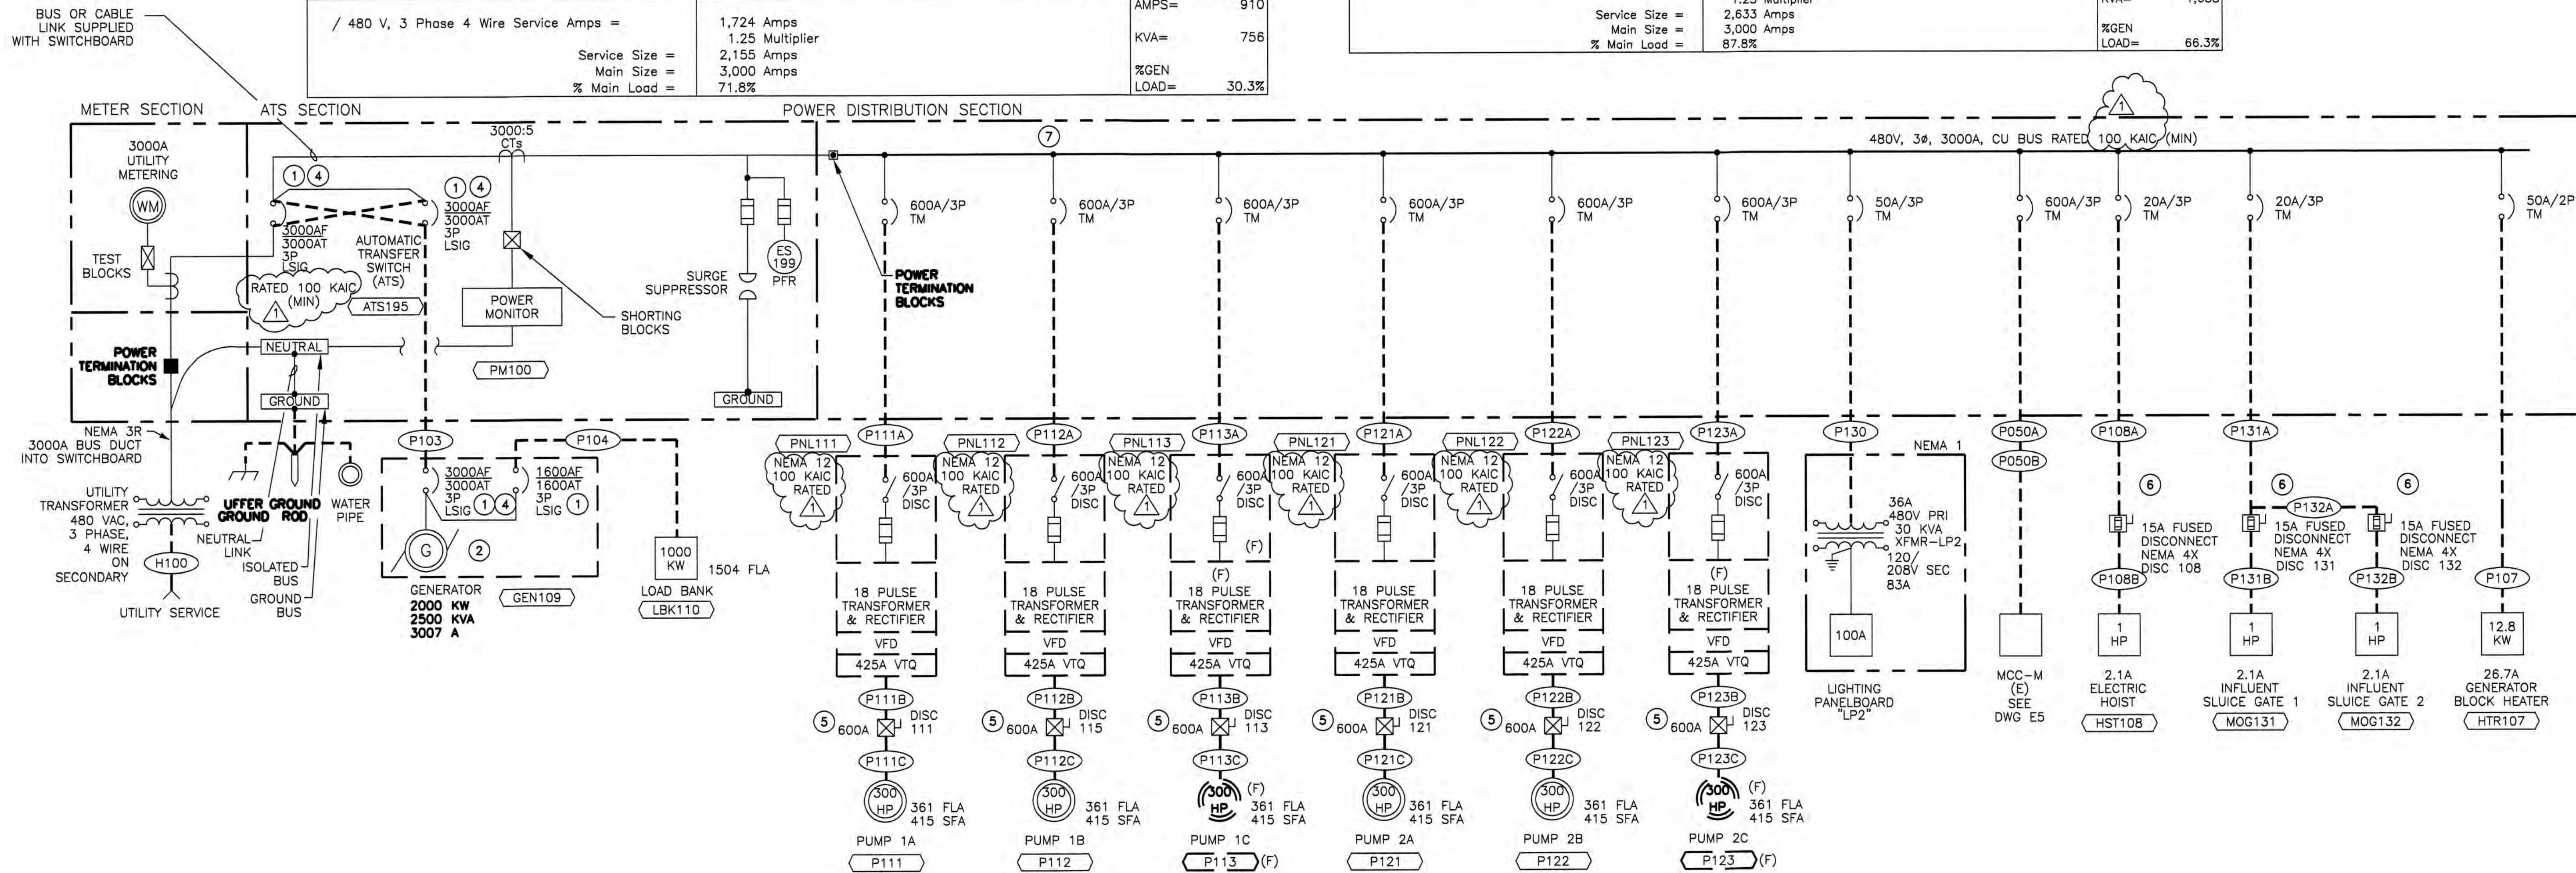

METER/MAIN SWITCHBOARD SWBD-2 ③

- NOTES:
- ① BREAKER SHALL HAVE ADJUSTABLE LONG, SHORT, INSTANTANEOUS & GROUND (LSIG) TRIP SETTINGS.
 - ② GROUND NEUTRAL PER GENERATOR MANUFACTURER'S RECOMMENDATION.
 - ③ ALL LUGS SHALL BE COPPER SIZE FOR WIRES LISTED IN "CONDUIT & WIRE ROUTING SCHEDULE".
 - ④ 100% RATED BREAKERS.
 - ⑤ NEMA 4X SS DISCONNECT SWITCH WITH MINIMUM AMP RATING SHOWN TO BE LOCATED BELOW FCS. MOUNT VFD TERMINATOR TO BACK OF FCS SUPPORT.
 - ⑥ PROVIDE & INSTALL FUSES SIZED TO PROTECT EQUIPMENT.
 - ⑦ SEE DWG E3 FOR ELEVATION DIAGRAM OF BREAKERS POSITION.



REFER TO SET FOR SIGNATURE


REV. No.	DISCRPTION	DATE	BY	Apr'd By
1	ADDENDUM NO.5	5/06	SK	PR
2				
3				
4				
5				
6				
7				

WEST YOST ASSOCIATES
 Consulting Engineers
 1260 Lake Boulevard
 Suite 240
 Davis, California 95616
 (530) 756-5905
 FAX (530) 756-5991

RECORD DRAWINGS
14-Mile Slough Pump Station Upgrades
METER/MAIN SWITCHBOARD SWBD-2 ONE LINE DIAGRAM

DEPARTMENT OF MUNICIPAL UTILITIES
 CITY OF STOCKTON, CALIFORNIA

SCALE: NONE APPROVED BY: DATE: SHEET No. **E2**
 DESIGNED BY: SMK
 DRAWN BY: ZK
 CHECKED BY: XML
 RECORD Dwg.: ASSISTANT DIRECTOR, DEPT. OF MUNICIPAL UTILITIES
 PROJECT No. 293-00-05-01

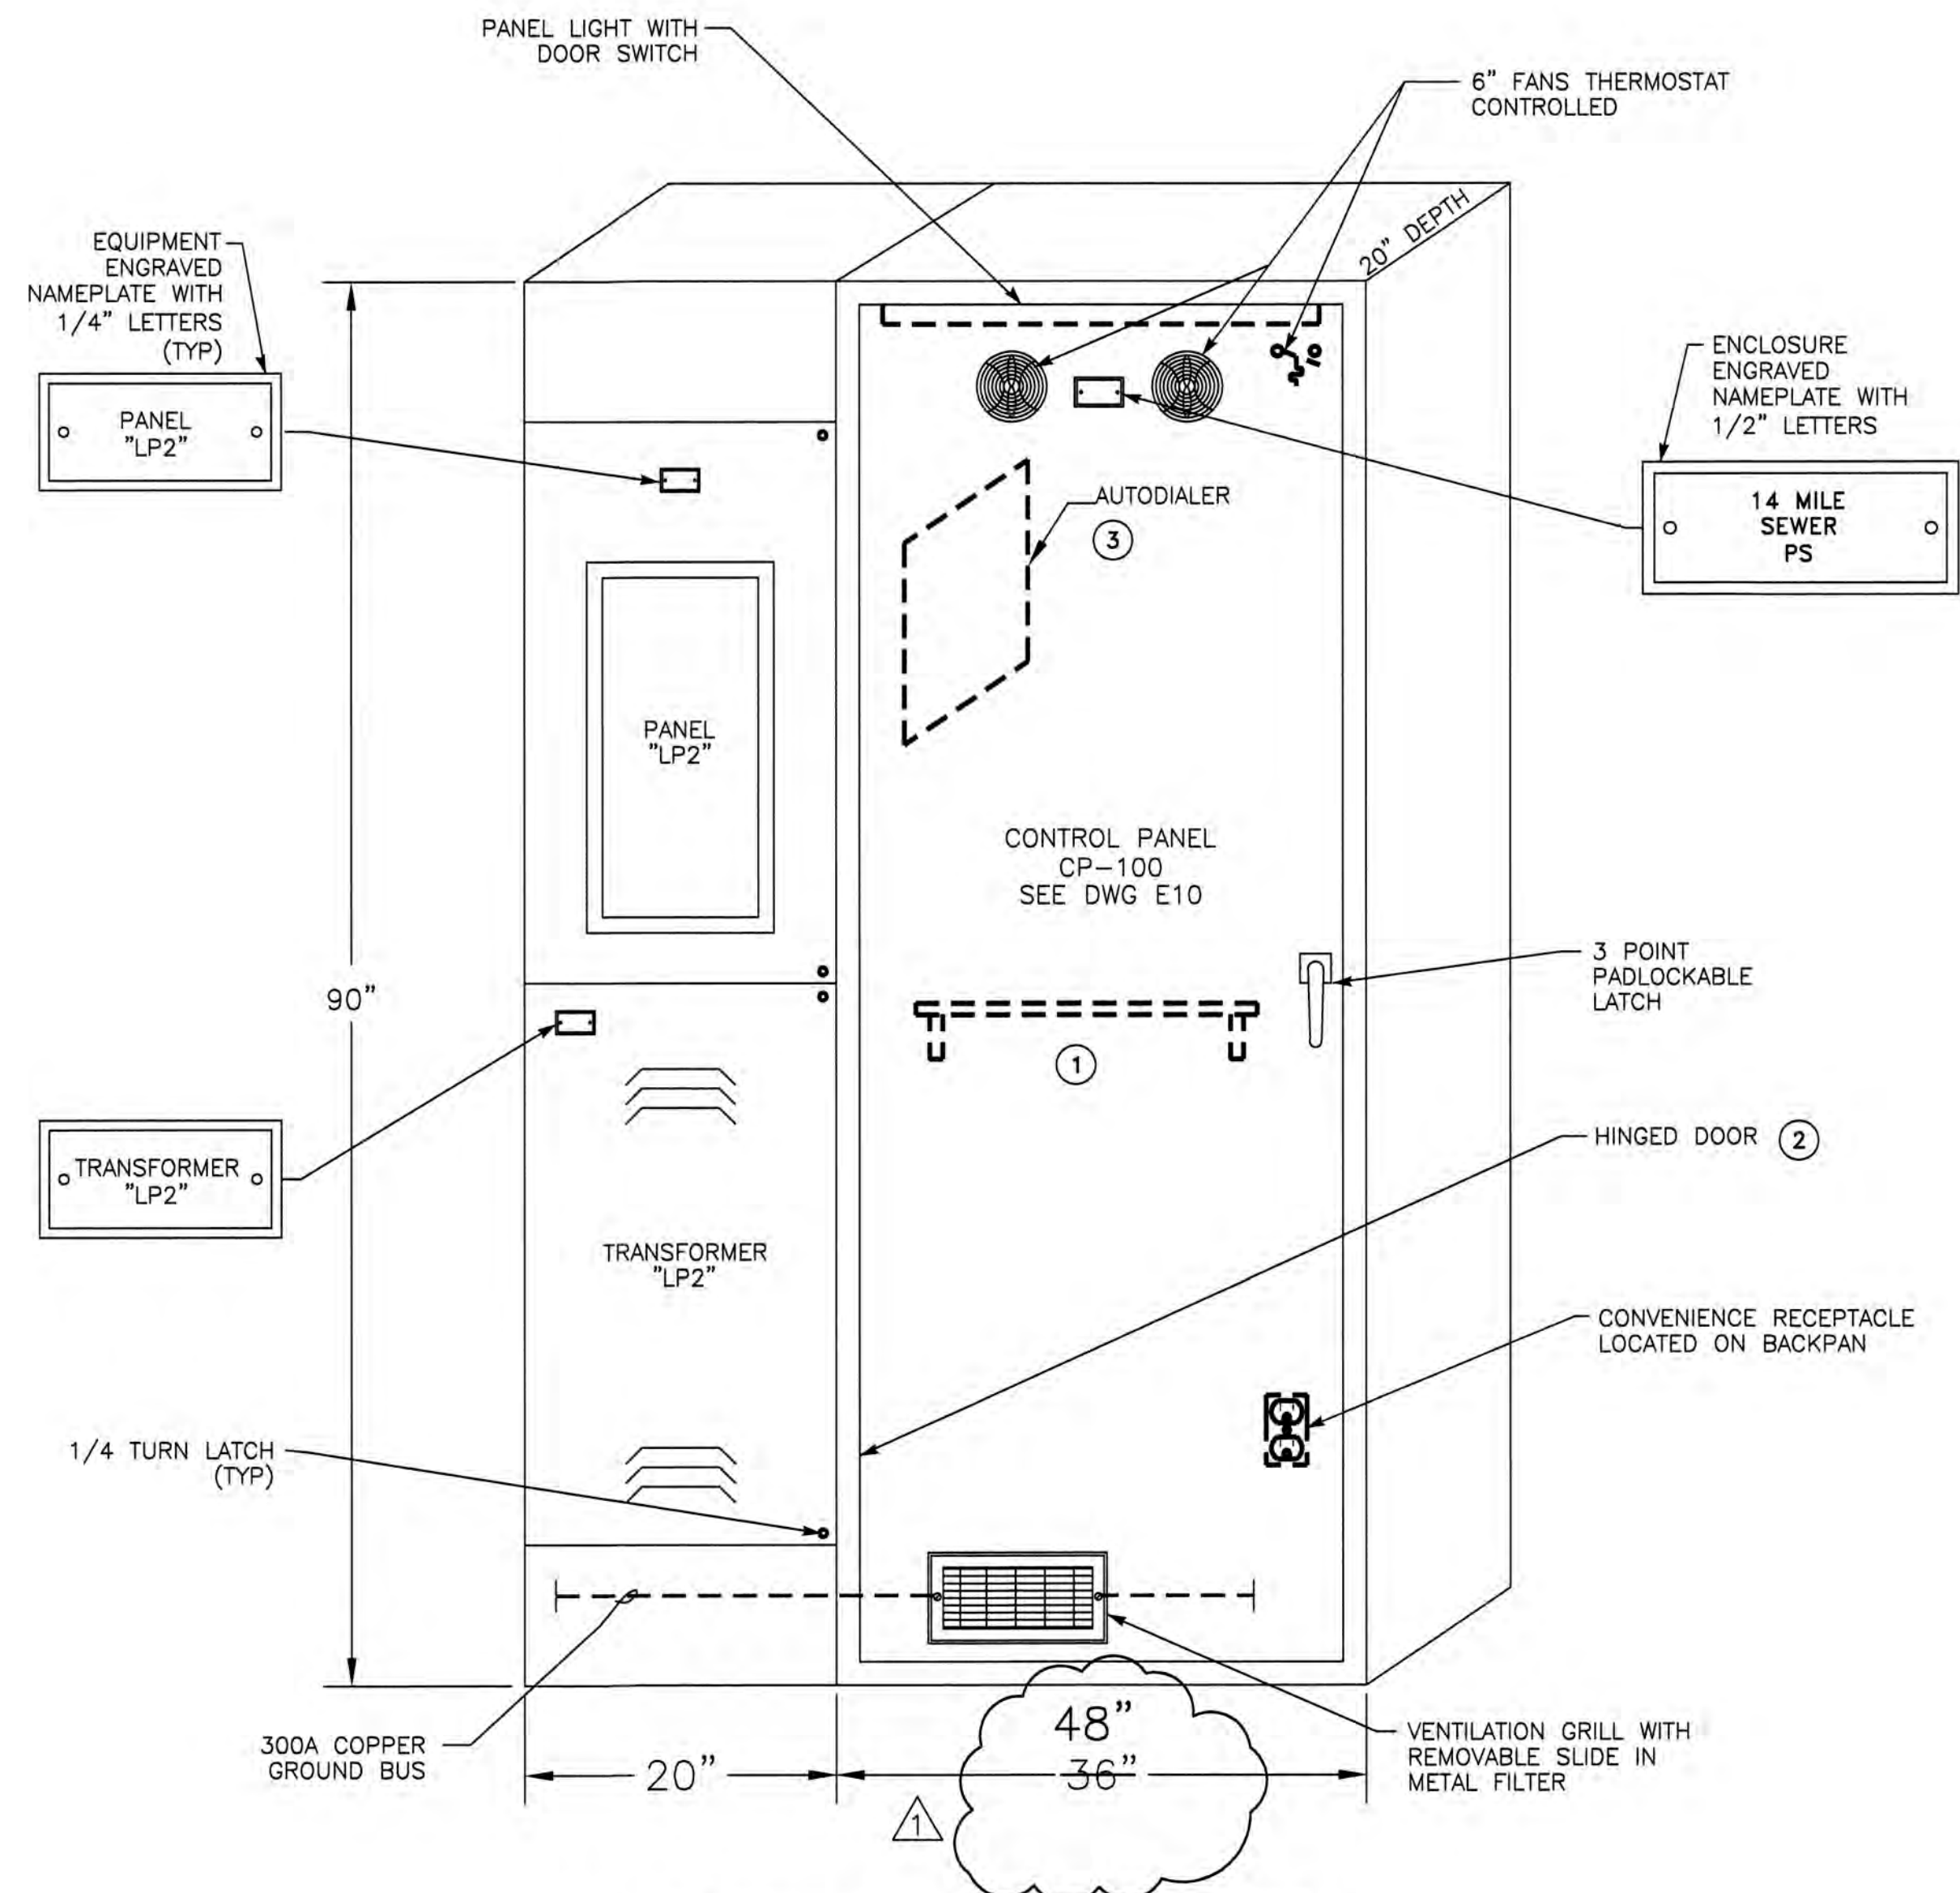

CONTROL PANEL ELEVATION

- NOTES: ① FOLD DOWN SHELF, 18" x 18" MOUNTED INSIDE DOOR, HOFFMAN ACSHELF 18 OR EQUAL.
 ② PROVIDE ADDITIONAL DOOR BRACING OR USE A TWO DOOR ENCLOSURE.
 ③ MOUNT AUTODIALER AND TELCO JACK TO FULL HEIGHT SIDE PAN.

		VOLTS 120 208		PANEL "LP2"		LOCATION ELECTRICAL ROOM		NEMA 1				
		PHASE 3		BUS AMPS 100A		ENCLOSURE FLUSH		TVSS YES				
		WIRE 4		MAIN BKR 100A		AIC RATING 14,000						
BKR NO.	DESCRIPTION	LOAD VA	LINE AMPS	AMPS/POLE	BKR NO.	PHASE	BKR NO.	AMPS/POLE	LINE AMPS	LOAD VA	DESCRIPTION	BKR NO.
1	LIGHTING - INSIDE BLDG	192	2	20/1	1	A	2	20/1	3	350	LIGHTING - OUTSIDE BLDG	2
3	LIGHTING - INSIDE BLDG	384	3	20/1	3	B	4	20/1	6	720	RECEPT - INSIDE BLDG	4
5	RECEPT - OUTDOOR GEN	720	6	20/1	5	C	6	20/1	3	380	SWITCHBOARD - 120V POWER	6
7	LIGHTING OUTDOOR GEN	420	4	20/1	7	A	8	20/1	2	220	CONTROL PANEL - MISC	8
9	RECEPT - INSIDE BLDG	720	6	20/1	9	B	10	20/1	8	1,000	CONTROL PANEL - UPS	10
11	RECEPT - OUTDOOR	900	8	20/1	11	C	12	20/1(L)	4	528	P141	12
13	LIGHTS-AREA POLE	600	5	20/1	13	A	14	20/1(L)	4	528	P142	14
15	RECEPT-AREA POLE	720	6	20/1	15	B	16	20/1	2	200	FSL173/4	16
17	RECEPT - HVAC 1	180	2	20/1	17	C	18	30/2	0	0	SPARE	18
19	RECEPT - HVAC 2	180	2	20/1	19	A	20		0	0	SPARE	20
21	IRRIGATION CONTROLLER	30	0	20/1	21	B	22	20/1	1	100	GENERATOR BATTERY CHARGER	22
23	RECEPT - FLOWMETER VAULT 1	500	4	20/1 (G)	23	C	24	20/1(G)	4	500	RECEPT - FLOWMETER VAULT 2	24
25	SPARE	0	0	40/2	25	A	26	20/1	0	0	SPARE	26
27	SPARE	0	0	20/1	27	B	28	20/1	0	0	SPARE	28
29	SPARE	0	0	20/1	29	C	30	20/1(H)	0	0	SPARE	30
31	SPARE	0	0	20/1	31	A	32	30/3	0	0	SPARE	32
33	SPARE	0	0	30/2	33	B	34		0	0	SPARE	34
35	SPARE	0	0	20/1	35	C	36		0	0	SPARE	36
37	SPARE	0	0	20/1(G)	37	A	38	100/3			MAIN	38
39	SPARE	0	0	20/1	39	B	40				SPARE	40
41	SPARE	0	0	20/1	41	C	42				SPARE	42

PHASE	A	B	C	PHASE	A	B	C
LEFT SIDE AMPS	12	15	19	RIGHT SIDE AMPS	9	17	12
LEFT SIDE KVA	1.39	1.85	2.30	RIGHT SIDE KVA	1.10	2	1
TOTAL KVA	10.07			LEFT SIDE KVA	1.39	2	2
TOTAL AMPS @ 208V, 3P	27.96			TOTAL PHASE KVA	2.49	4	4
DIVERSITY FACTOR	0.80			TOTAL PHASE AMPS	21	32	31
LOAD KVA	8.06			% OF AVERAGE	74	115	110

- NOTES: 1. MEANS OF WIRE COLOR CODING SHALL BE POSTED ON PANELBOARD PER NEC 210 (4)
 2. (G) INDICATES GFI BREAKER REQUIRED WITH 30 MA SENSITIVITY
 3. (H) INDICATES HACR RATED BREAKER.
 4. (L) PROVIDE PADLOCKING PROVISION IN ORDER TO LOCK BREAKER IN THE OFF POSITION.



RECORD DRAWINGS
14-Mile Slough Pump Station Upgrades
CONTROL PANEL ELEVATION



REFER TO SET FOR SIGNATURE

REV. No.	DISCRPTION	DATE	BY	Apr'd By
1	RECORD DRAWINGS	8/08	OS	

WEST YOST ASSOCIATES
 Consulting Engineers
 1260 Lake Boulevard Suite 240
 Davis, California 95616
 (530) 756-5905 FAX (530) 756-5991



DEPARTMENT OF MUNICIPAL UTILITIES
 CITY OF STOCKTON, CALIFORNIA

SCALE: NONE
 DESIGNED BY: SMK
 DRAWN BY: ZK
 CHECKED BY: XML
 RECORD Dwg.:

APPROVED BY: DATE: _____
 ASSISTANT DIRECTOR, DEPT. OF MUNICIPAL UTILITIES

SHEET No. **E4**
 61 of 89 SHEETS
 PROJECT No. 293-00-05-01

REVISED MCC-M LOAD CALCULATIONS	UTILITY SERVICE				GENERATOR SERVICE			
	LOAD AMPS	QTY LOAD	LOAD VA	RUN AMPS	QTY RUN	RUN VA	QTY RUN	RUN VA
5 EXHAUST FAN	7.6	2	12,637		2	12,637	2	12,637
5 AIR SCRUBBER	7.6	1	6,319		1	6,319	1	6,319
5 WELL PUMP	7.6	1	6,319		1	6,319	1	6,319
3 MIXER	4.8	1	3,991		1	3,991	1	3,991
OUTDOOR HVAC	26.6	2	44,230		2	44,230	2	44,230
4 GATES	11.0	4	36,581		2	18,290	2	18,290
AC UNIT	17.0	1	14,134		1	14,134	1	14,134
UNIT HEATER	12.0	2	20,000		1	10,000	1	10,000
PANELBOARD "LP"	4.0	1	3,326		1	3,326	1	3,326
PANELBOARD "PP-IIP"	3.0	1	2,494		1	2,494	1	2,494
SURGE TANK AIR COMPRESSOR	12.0	1	9,977		1	9,977	1	9,977
SUBTOTAL	192		160,005	158		131,715		131,715
DIVERSITY FACTOR			82 %					
5 HP Largest motor @ 25% additional				22,115	0.25	5,529		
TOTAL						137,243		
/ 480 V, 3 Phase 4 Wire Service Amps =	165 Amps						AMPS=	158
Service Size =	1.25 Multiplier						KVA=	132
Main Size =	206 Amps						%GEN	
% Main Load =	600 Amps						LOAD=	5.3%

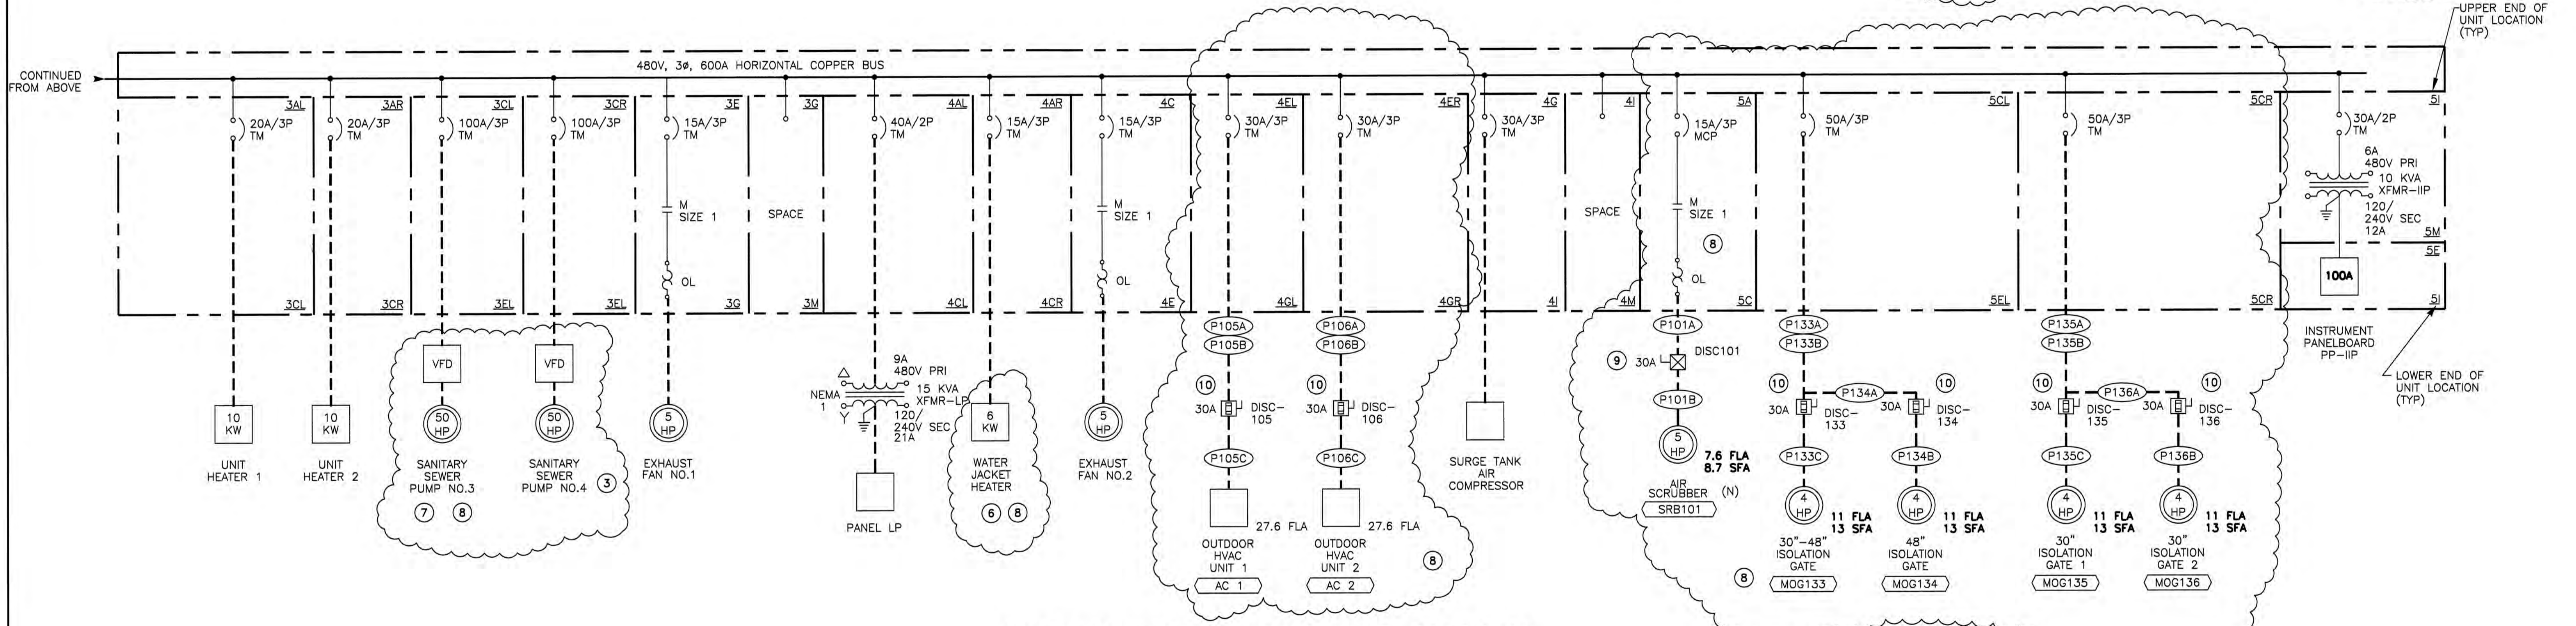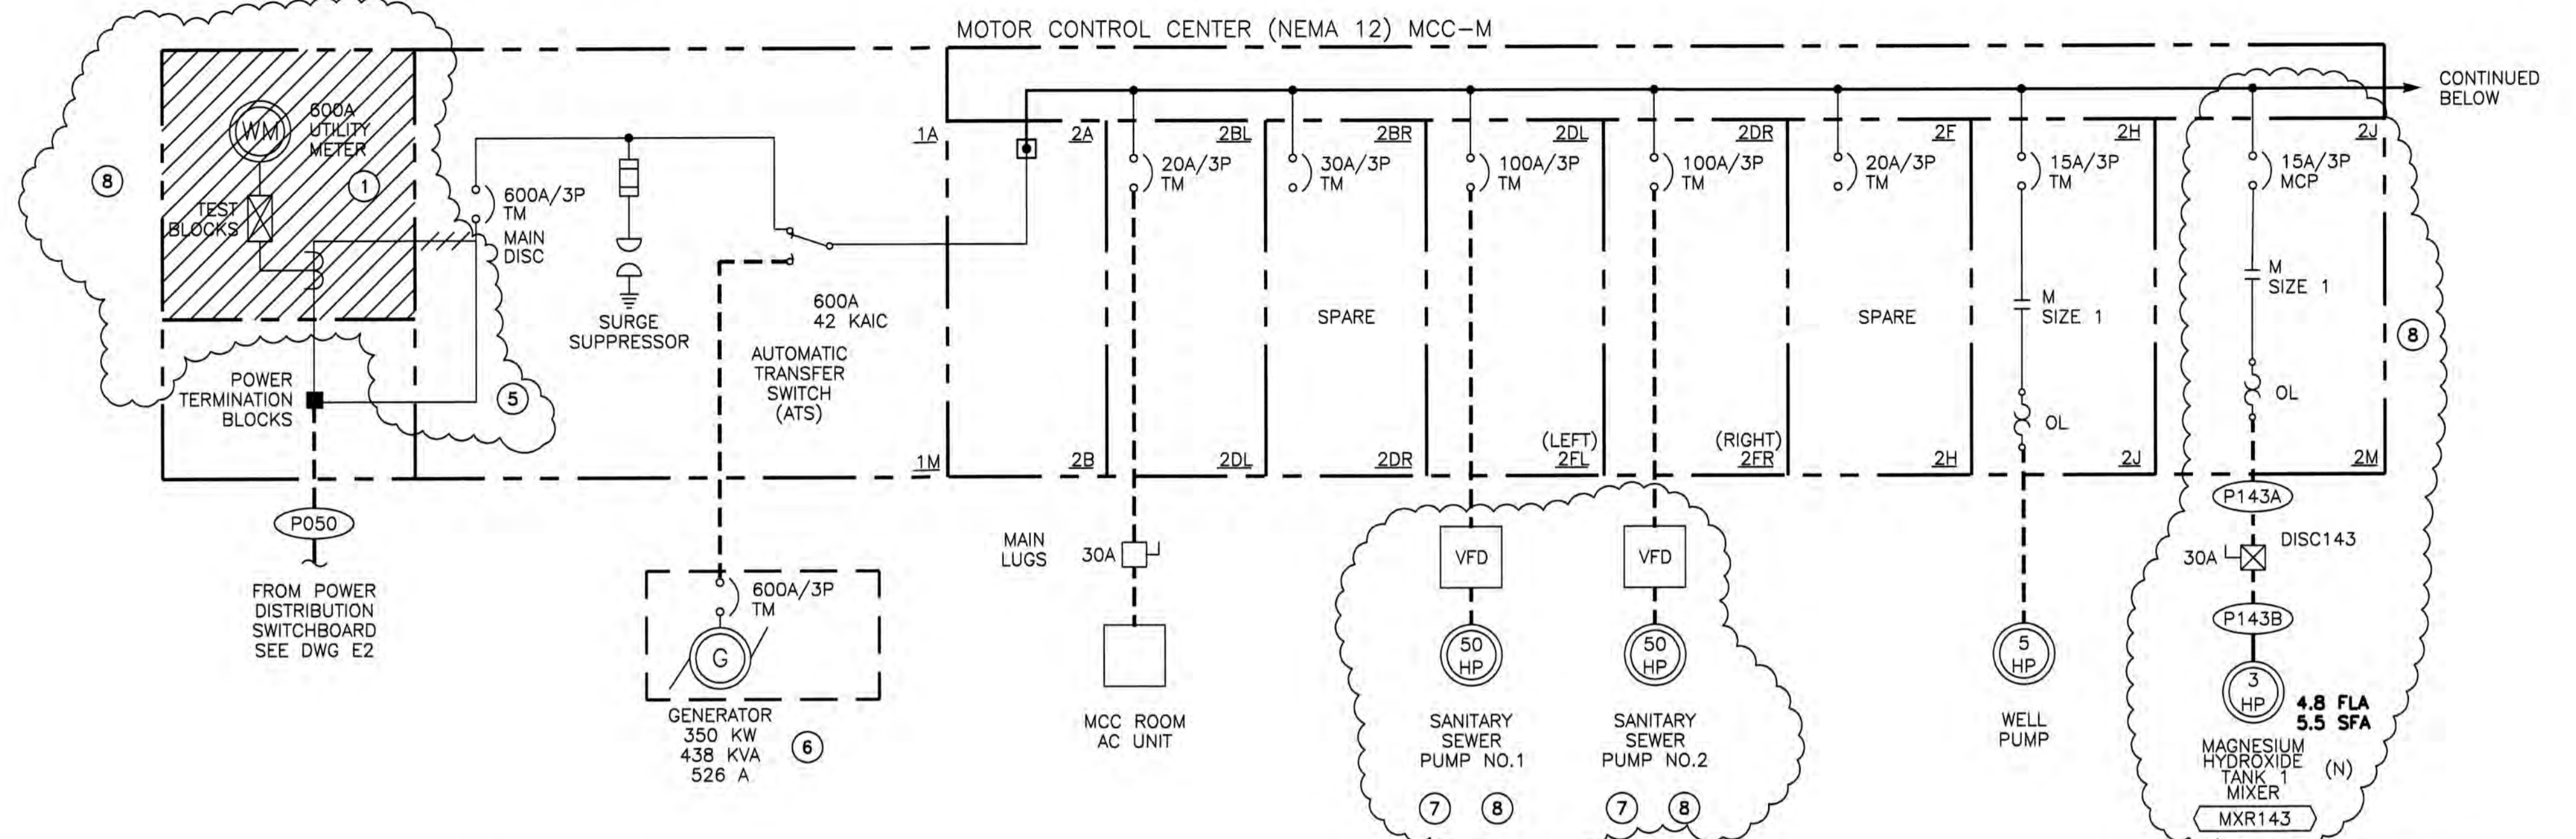

EXISTING MCC-M ONE LINE DIAGRAM

- NOTES:
- ① SPARE - NO LOAD CONNECTED.
 - ② EXISTING MCC IS SQUARE D SERIES 6.
 - ③ NOT INSTALLED.
 - ④ METERING TO BE REMOVED BY PG&E.
 - ⑤ INSTALL 600A JUMPER.
 - ⑥ GENERATOR TO REMAIN IN SERVICE UNTIL NEW POWER SERVICE TO MCC-M HAS BEEN COMPLETED & TESTED.
 - ⑦ PUMPS & VFD DRIVES TO REMAIN IN SERVICE UNTIL CUT OVER TO NEW PUMP STATION HAS BEEN COMPLETED & TESTED. REMOVE & TURN OVER VFD DRIVES & PUMPS TO OWNER. EXISTING BREAKERS TO BE SPARE.
 - ⑧ NEW WORK SHOWN IN BUBBLES.
 - ⑨ NEMA 4X SS DISCONNECT SWITCH WITH MINIMUM AMP RATING.
 - ⑩ NEMA 4X DISCONNECT SWITCH WITH MINIMUM AMP RATED SHOWN AND FUSES SIZED TO PROTECT EQUIPMENT.
 - ⑪ FEEDERS FROM LOAD SIDE OF ATS TO MCC-M TO BE PARALLEL 350'S RATED AT 600A



REFER TO SET FOR SIGNATURE

REV. No.	DISCRPTION	DATE	BY	Appr'd By
1	RECORD DRAWINGS	8/08	OS	




1260 Lake Boulevard
Suite 240
Davis, California 95616
(530) 756-5905
FAX (530) 756-5991

RECORD DRAWINGS
14-Mile Slough Pump Station Upgrades

EXISTING MCC-M
ONE LINE DIAGRAM

DEPARTMENT OF MUNICIPAL UTILITIES CITY OF STOCKTON, CALIFORNIA		SHEET No.
SCALE: NONE	APPROVED BY: DATE:	E5
DESIGNED BY: SMK		62 of 89 SHEETS
DRAWN BY: ZK		PROJECT No. 293-00-05-01
CHECKED BY: XML	ASSISTANT DIRECTOR, DEPT. OF MUNICIPAL UTILITIES	
RECORD Dwg.:		

NAMEPLATE SCHEDULE			
KEY	DEVICE	ENGRAVING	LETTER SIZE
1	BREAKER	MCC ROOM AC UNIT	1/4"
2	BREAKER	SPARE 30A BREAKER	1/4"
3	BREAKER	SANITARY SEWER PUMP NO. 1	1/4"
4	BREAKER	SANITARY SEWER PUMP NO. 2	1/4"
5	BREAKER	UNIT HEATER NO. 1	1/4"
6	BREAKER	UNIT HEATER NO. 2	1/4"
7	BREAKER	SANITARY SEWER PUMP NO. 3	1/4"
8	BREAKER	SANITARY SEWER PUMP NO. 4	1/4"
9	BREAKER	LIGHTING TRANSFORMER DISCONNECT	1/4"
10	BREAKER	WATER JACKET HEATER	1/4"
11	BREAKER	CTRL BLDG AC 1	1/4"
12	BREAKER	CTRL BLDG AC 2	1/4"
13	BREAKER	48" VALVES DISCONNECTS	1/4"
14	BREAKER	30" VALVES DISCONNECTS	1/4"

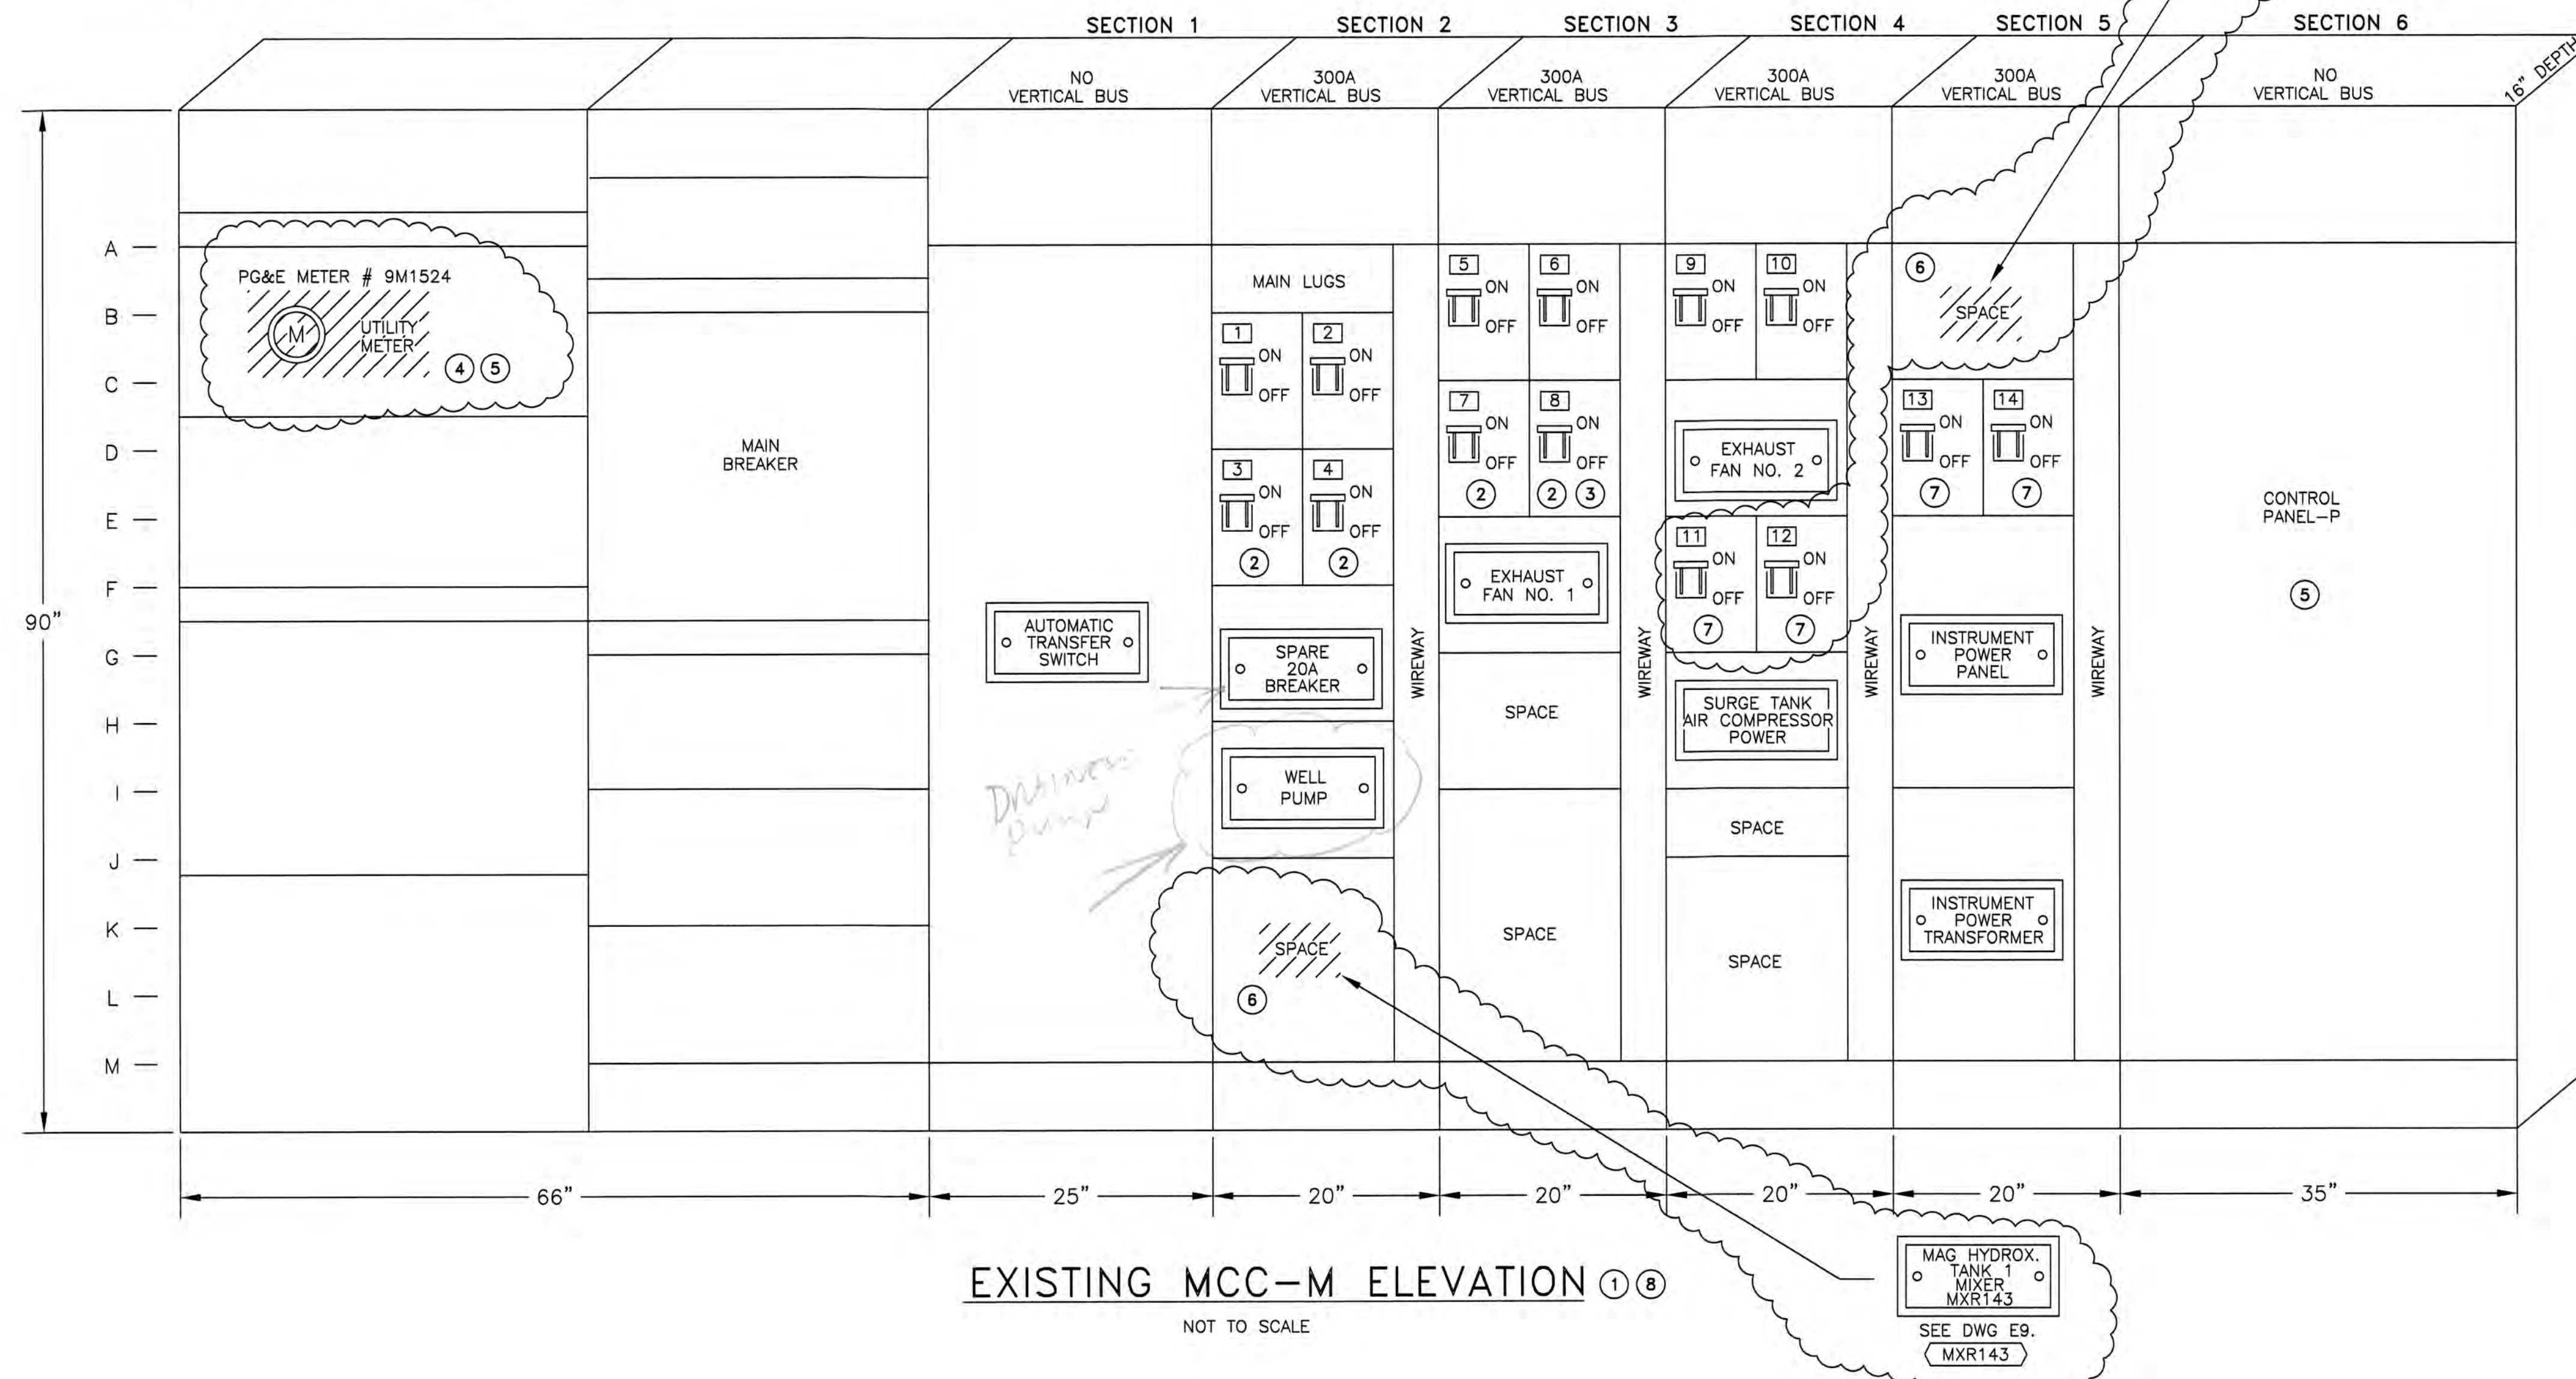

EXISTING MCC-M ELEVATION ① ⑧
NOT TO SCALE

- NOTES:
- ① EXISTING SQUARE D MCC.
 - ② PUMPS SHALL REMAIN IN SERVICE UNTIL CUT OVER TO NEW PUMPS, REPLACE NAMEPLATE WITH "100A SPARE BREAKER".
 - ③ SPARE - NO LOAD CONNECTED.
 - ④ AFTER NEW POWER SERVICE FEED FROM MCC-M HAS BEEN CONNECTED TO AND TESTED, CONTRACTOR TO HAVE PG&E REMOVE THEIR METER SOCKET & ASSOCIATED DEVICES. REMOVE & WASTE ALL OTHER EXISTING METERING DEVICES & WIRING.
 - ⑤ REPLACE DOOR WITH NEW DOOR PAINTED TO MATCH EXISTING DOOR.
 - ⑥ NEW MOTOR CONTROLS.
 - ⑦ NEW BREAKER WITH NAMEPLATE.
 - ⑧ NEW WORK SHOWN IN BUBBLES.



REFER TO SET FOR SIGNATURE


REV. No.	DISCRPTION	DATE	BY	Appr'd By
1	RECORD DRAWINGS			
2				
3				
4				
5				
6				
7				

WEST YOST ASSOCIATES
Consulting Engineers
1260 Lake Boulevard Suite 240 Davis, California 95616
(530) 756-5905 FAX (530) 756-5991

RECORD DRAWINGS
14-Mile Slough Pump Station Upgrades
EXISTING MCC-M ELEVATION


DEPARTMENT OF MUNICIPAL UTILITIES
CITY OF STOCKTON, CALIFORNIA

SCALE: NONE	APPROVED BY: DATE: _____	SHEET No. E6
DESIGNED BY: SMK		63 of 89 SHEETS
DRAWN BY: ZK		PROJECT No. 293-00-05-01
CHECKED BY: .XML	ASSISTANT DIRECTOR, DEPT. OF MUNICIPAL UTILITIES	
RECORD Dwg.:		

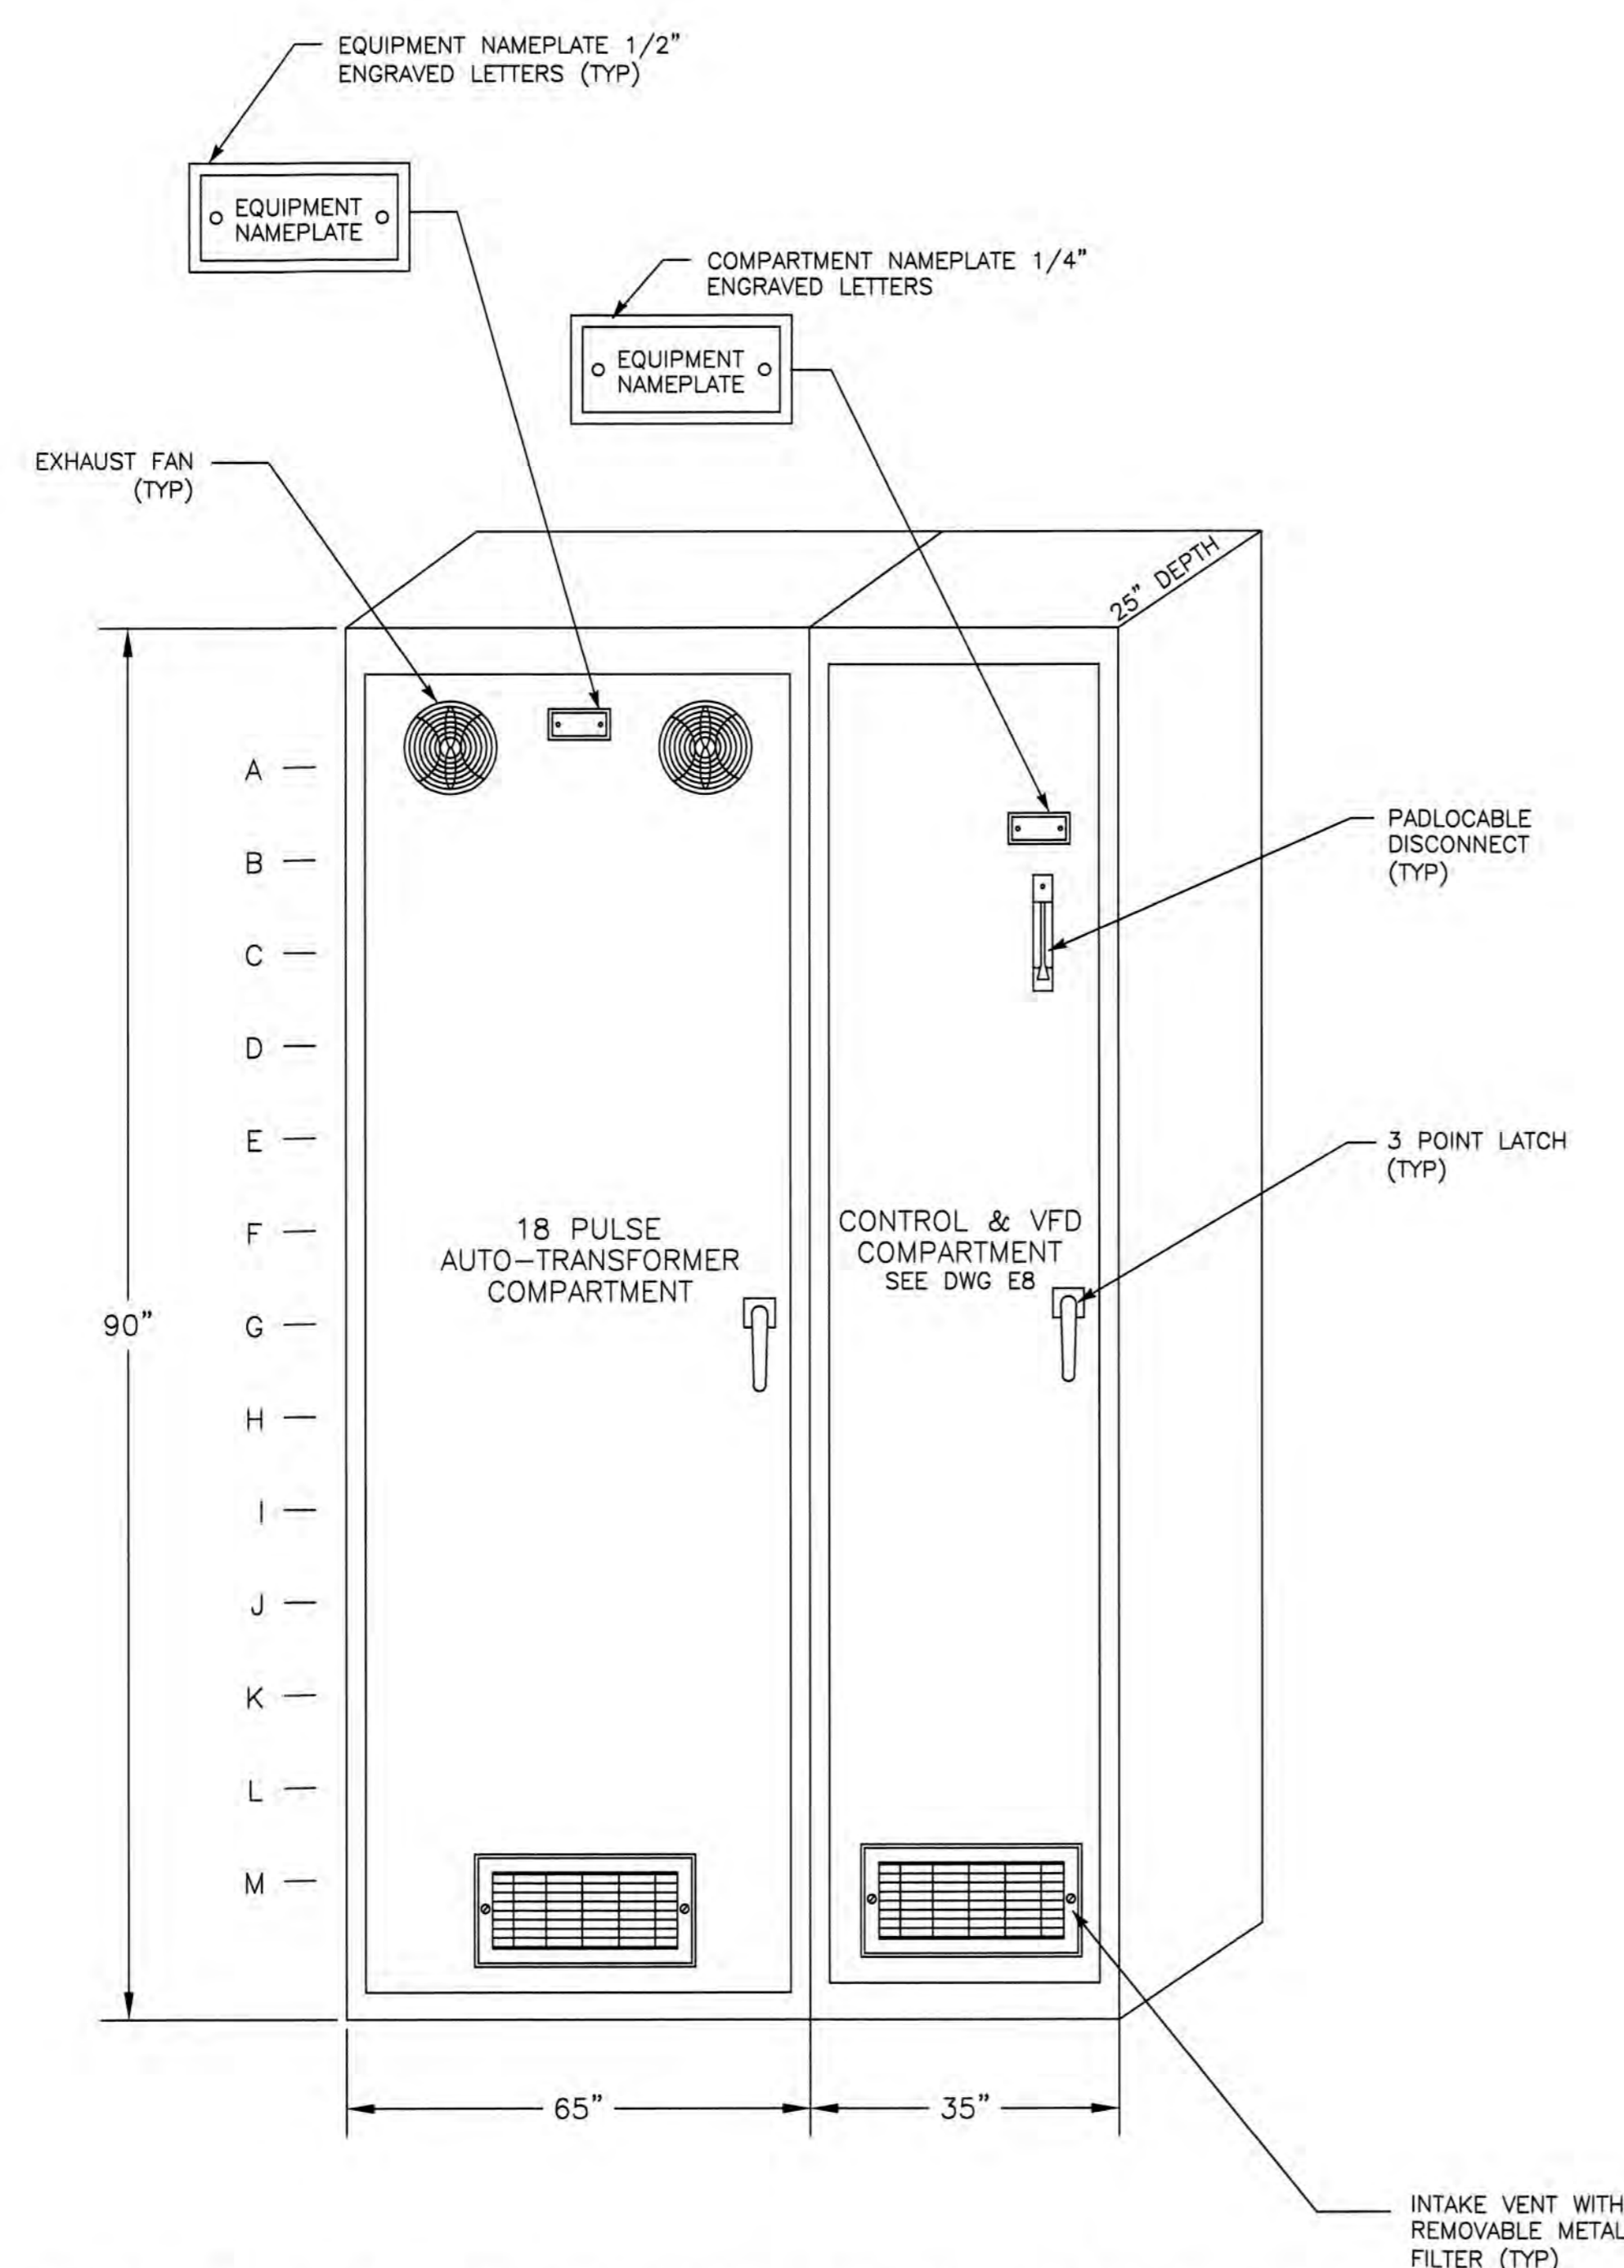


TYPICAL 18 PULSE VFD PANEL ELEVATIONS

- NOTES: ① EQUIPMENT NAMEPLATE TO CONTAIN EQUIPMENT DESCRIPTION AND EQUIPMENT NUMBER PER ELEVATION DIAGRAM MOUNT ON OR ABOVE DEVICE BOX ON FCS.
 ② INSTALL MOISTURE RELAY & ASSOCIATED DEVICES SUPPLIED WITH PUMP AND WIRING INSIDE FCS WHEN INDICATED ON P&ID.

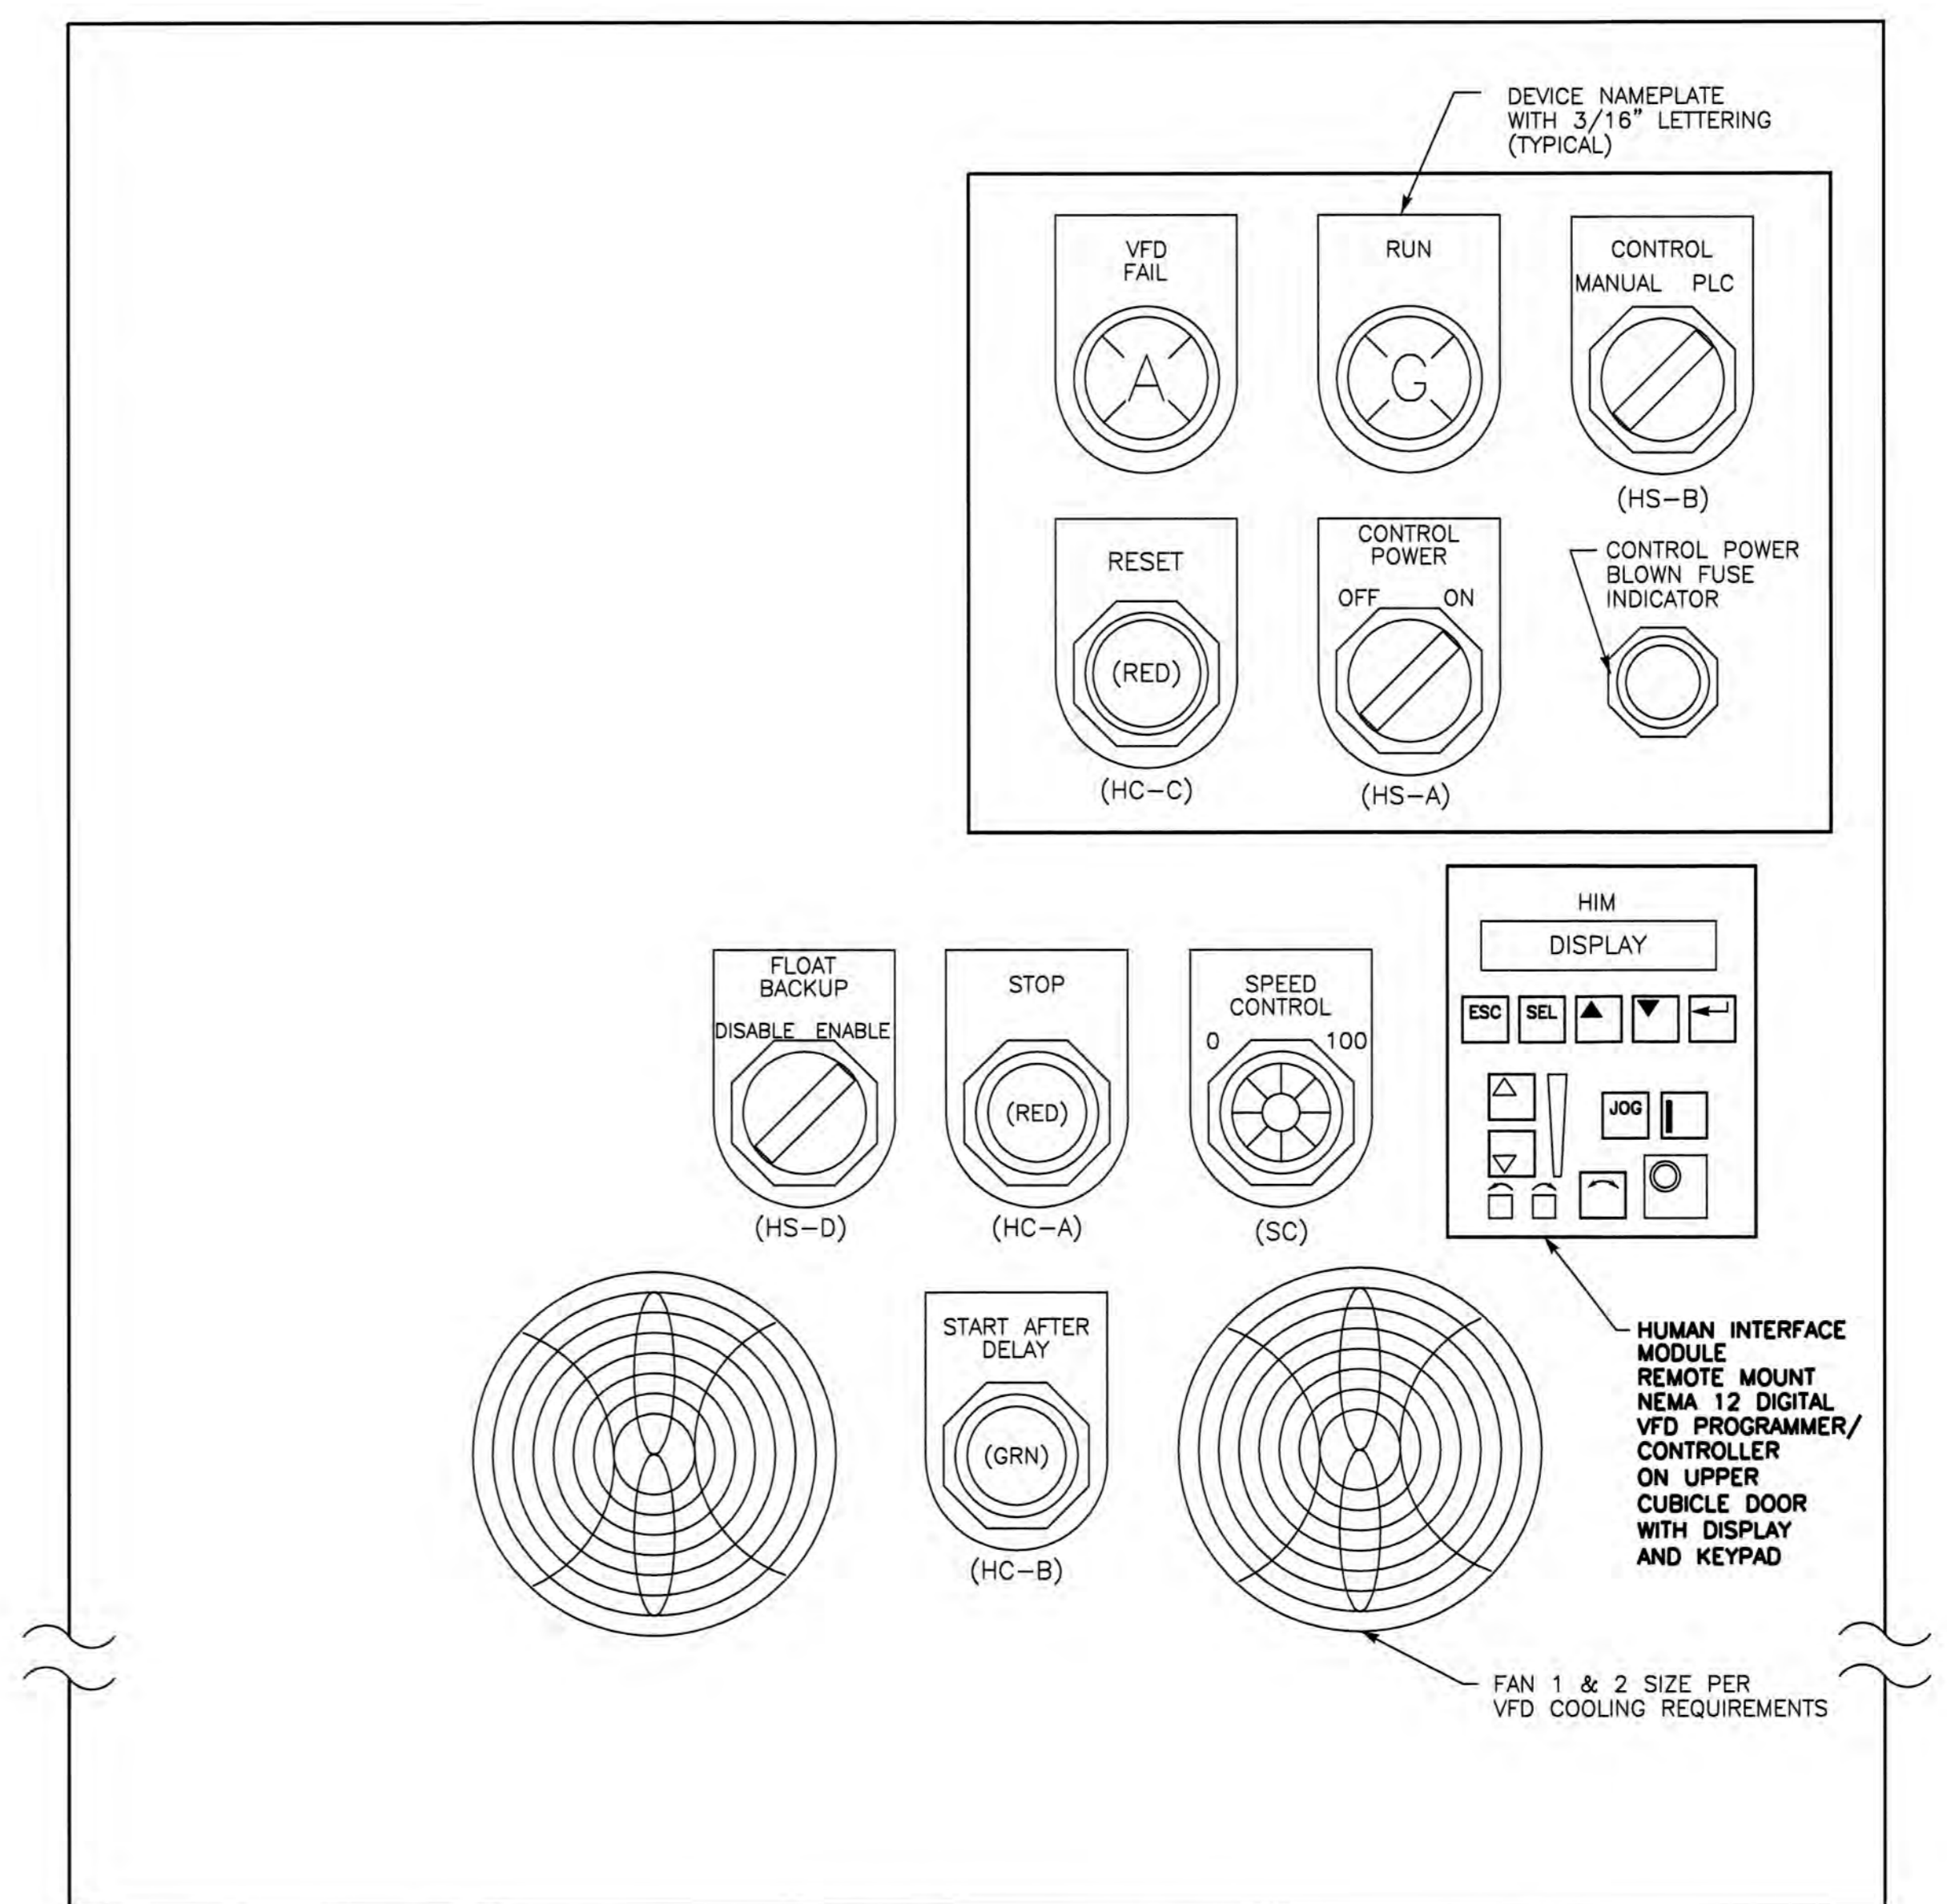

VFD PANEL LAYOUT

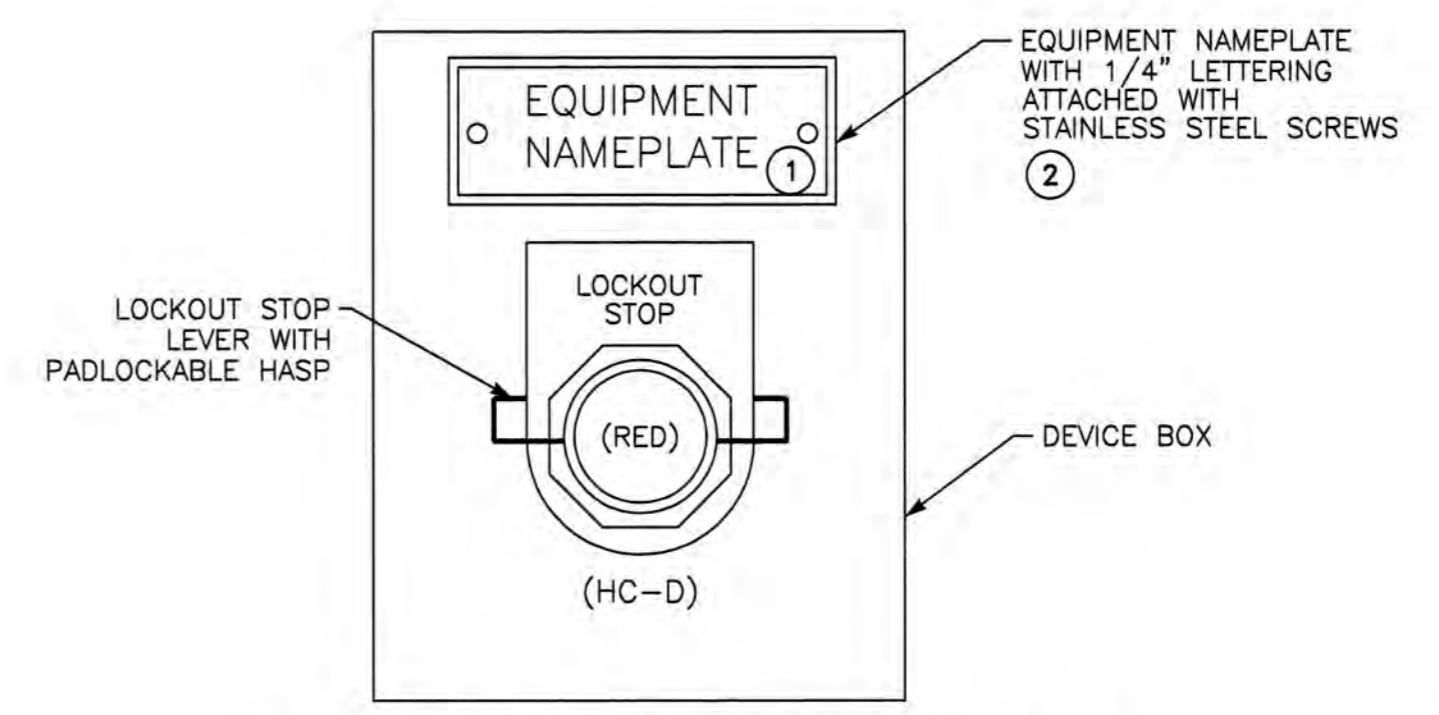

FIELD CONTROL STATION (FCS)




REFER TO SET FOR SIGNATURE

REV. No.	DISCRPTION	DATE	BY	Aprv'd By
1				
2				
3				
4				
5				
6				
7				


WEST YOST ASSOCIATES
 Consulting Engineers
 1260 Lake Boulevard Suite 240
 Davis, California 95616
 (530) 756-5905
 FAX (530) 756-5991

RECORD DRAWINGS
14-Mile Slough Pump Station Upgrades
 TYPICAL 18 PULSE VFD PANEL ELEVATION
 DEPARTMENT OF MUNICIPAL UTILITIES
 CITY OF STOCKTON, CALIFORNIA

SCALE: NONE	APPROVED BY: DATE: _____	SHEET No. E7
DESIGNED BY: SMK		64 of 89 SHEETS
DRAWN BY: ZK		PROJECT No. 293-00-05-01
CHECKED BY: XML	ASSISTANT DIRECTOR, DEPT. OF MUNICIPAL UTILITIES	
RECORD Dwg.:		

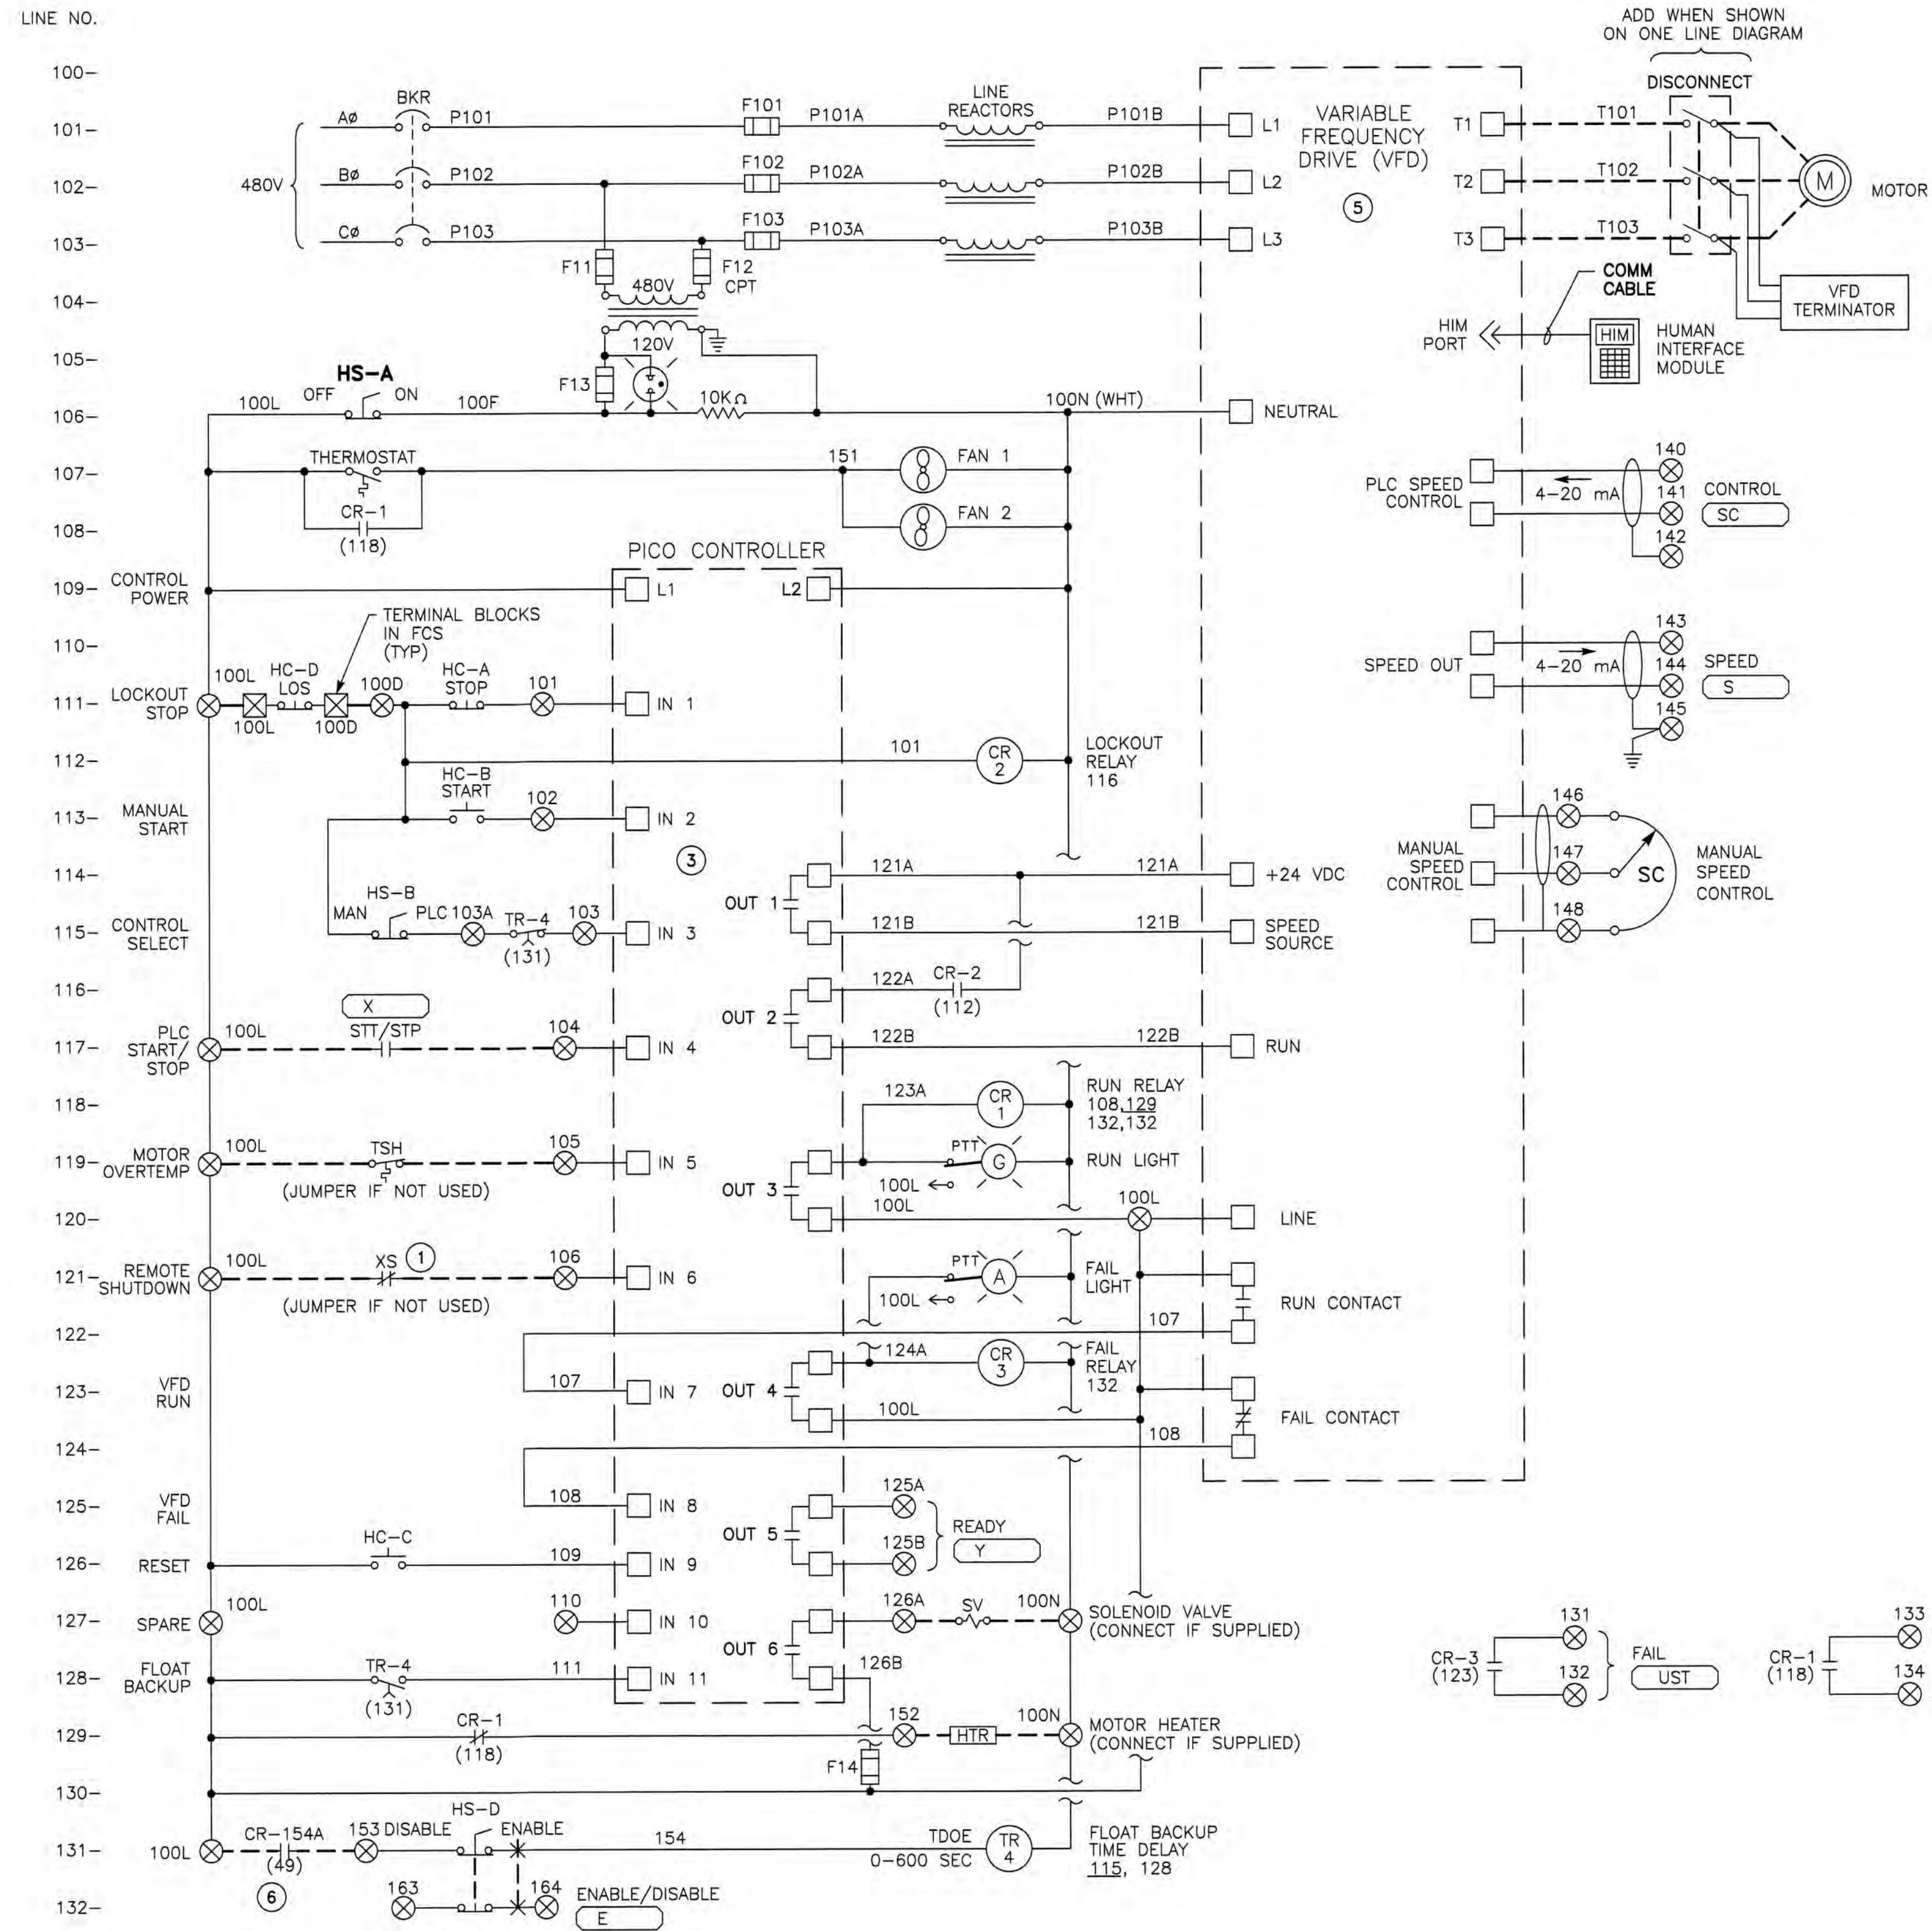

- NOTES:
- ① REMOTE SHUTDOWN XS => LSSL, ZSHH, PSHH, ETC., PER P&ID, JUMPER IF NOT USED. THESE ARE TO BE CONTACTS OFF OF AUXILIARY RELAY CONTACTS LOCATED IN MCC CONTROL PANEL DRIVEN FROM FIELD DEVICE.
 - ② USE 100 SERIES WIRES & TERMINAL #s FOR PNL 111, 200 #s FOR PNL 112 SERIES, ETC.
 - ③ PLACE 30K ohm, 5 WATT RESISTOR BETWEEN IN# AND 100N ON ANY PICO INPUT THAT HAS FIELD WIRING LENGTHS OVER 130 FEET, (AND DOES NOT FEED A RELAY COIL).
 - ④ INSTALL MOISTURE RELAY AND ASSOCIATED DEVICES SUPPLIED WITH PUMP AND WIRING INSIDE FCS WHEN INDICATED ON P&ID.
 - ⑤ VFD WITH ELECTRONIC OVERLOAD & BUILT-IN RFI FILTER.
 - ⑥ FLOAT BACKUP CONTROL PER DWG E11, DETAIL "A".

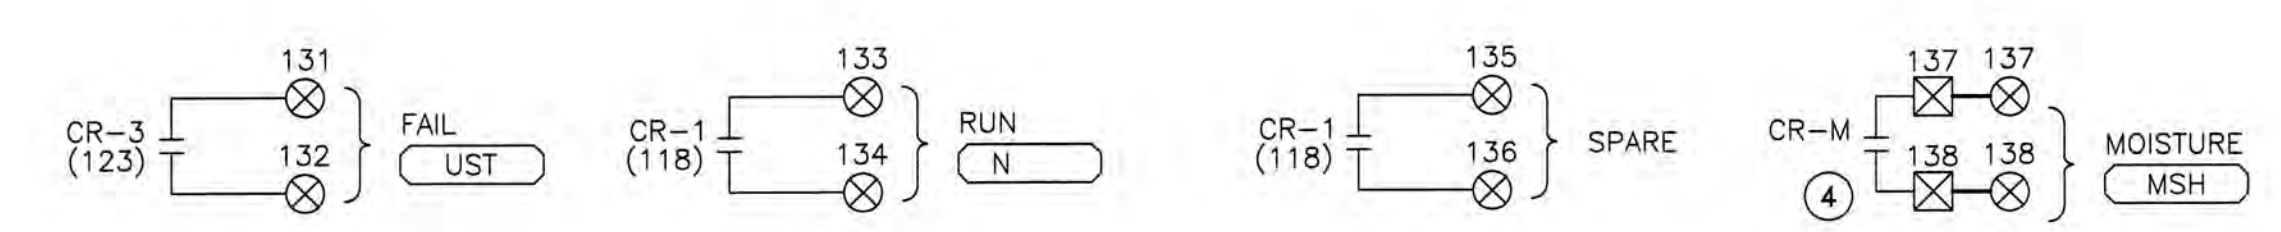

VARIABLE FREQUENCY DRIVE MCC START/STOP ELEMENTARY DIAGRAM ②



Underground Service Alert
 TWO DAYS BEFORE YOU DIG
 Call TOLL FREE: 1-800-642-2444


REFER TO SET FOR SIGNATURE

REV. No.	DISCRIPTION	DATE	BY	Appr'd By

WEST YOST ASSOCIATES
 Consulting Engineers
 1260 Lake Boulevard Suite 240 Davis, California 95616
 (530) 756-5905 FAX (530) 756-5991


RECORD DRAWINGS		
14-Mile Slough Pump Station Upgrades		
VFD DRIVE MCC START/STOP ELEMENTARY DIAGRAM		
DEPARTMENT OF MUNICIPAL UTILITIES CITY OF STOCKTON, CALIFORNIA		
SCALE: NONE	APPROVED BY: DATE: _____	SHEET No. E8
DESIGNED BY: SMK		65 of 89 SHEETS
DRAWN BY: ZK		PROJECT No. 293-00-05-01
CHECKED BY: XML	ASSISTANT DIRECTOR, DEPT. OF MUNICIPAL UTILITIES	
RECORD Dwg.:		

LINE NO.
101-
102-
103-
104-
105-
106-
107-
108-
109-
110-
111-
112-
113-
114-
115-
116-
117-
118-
119-
120-
121-

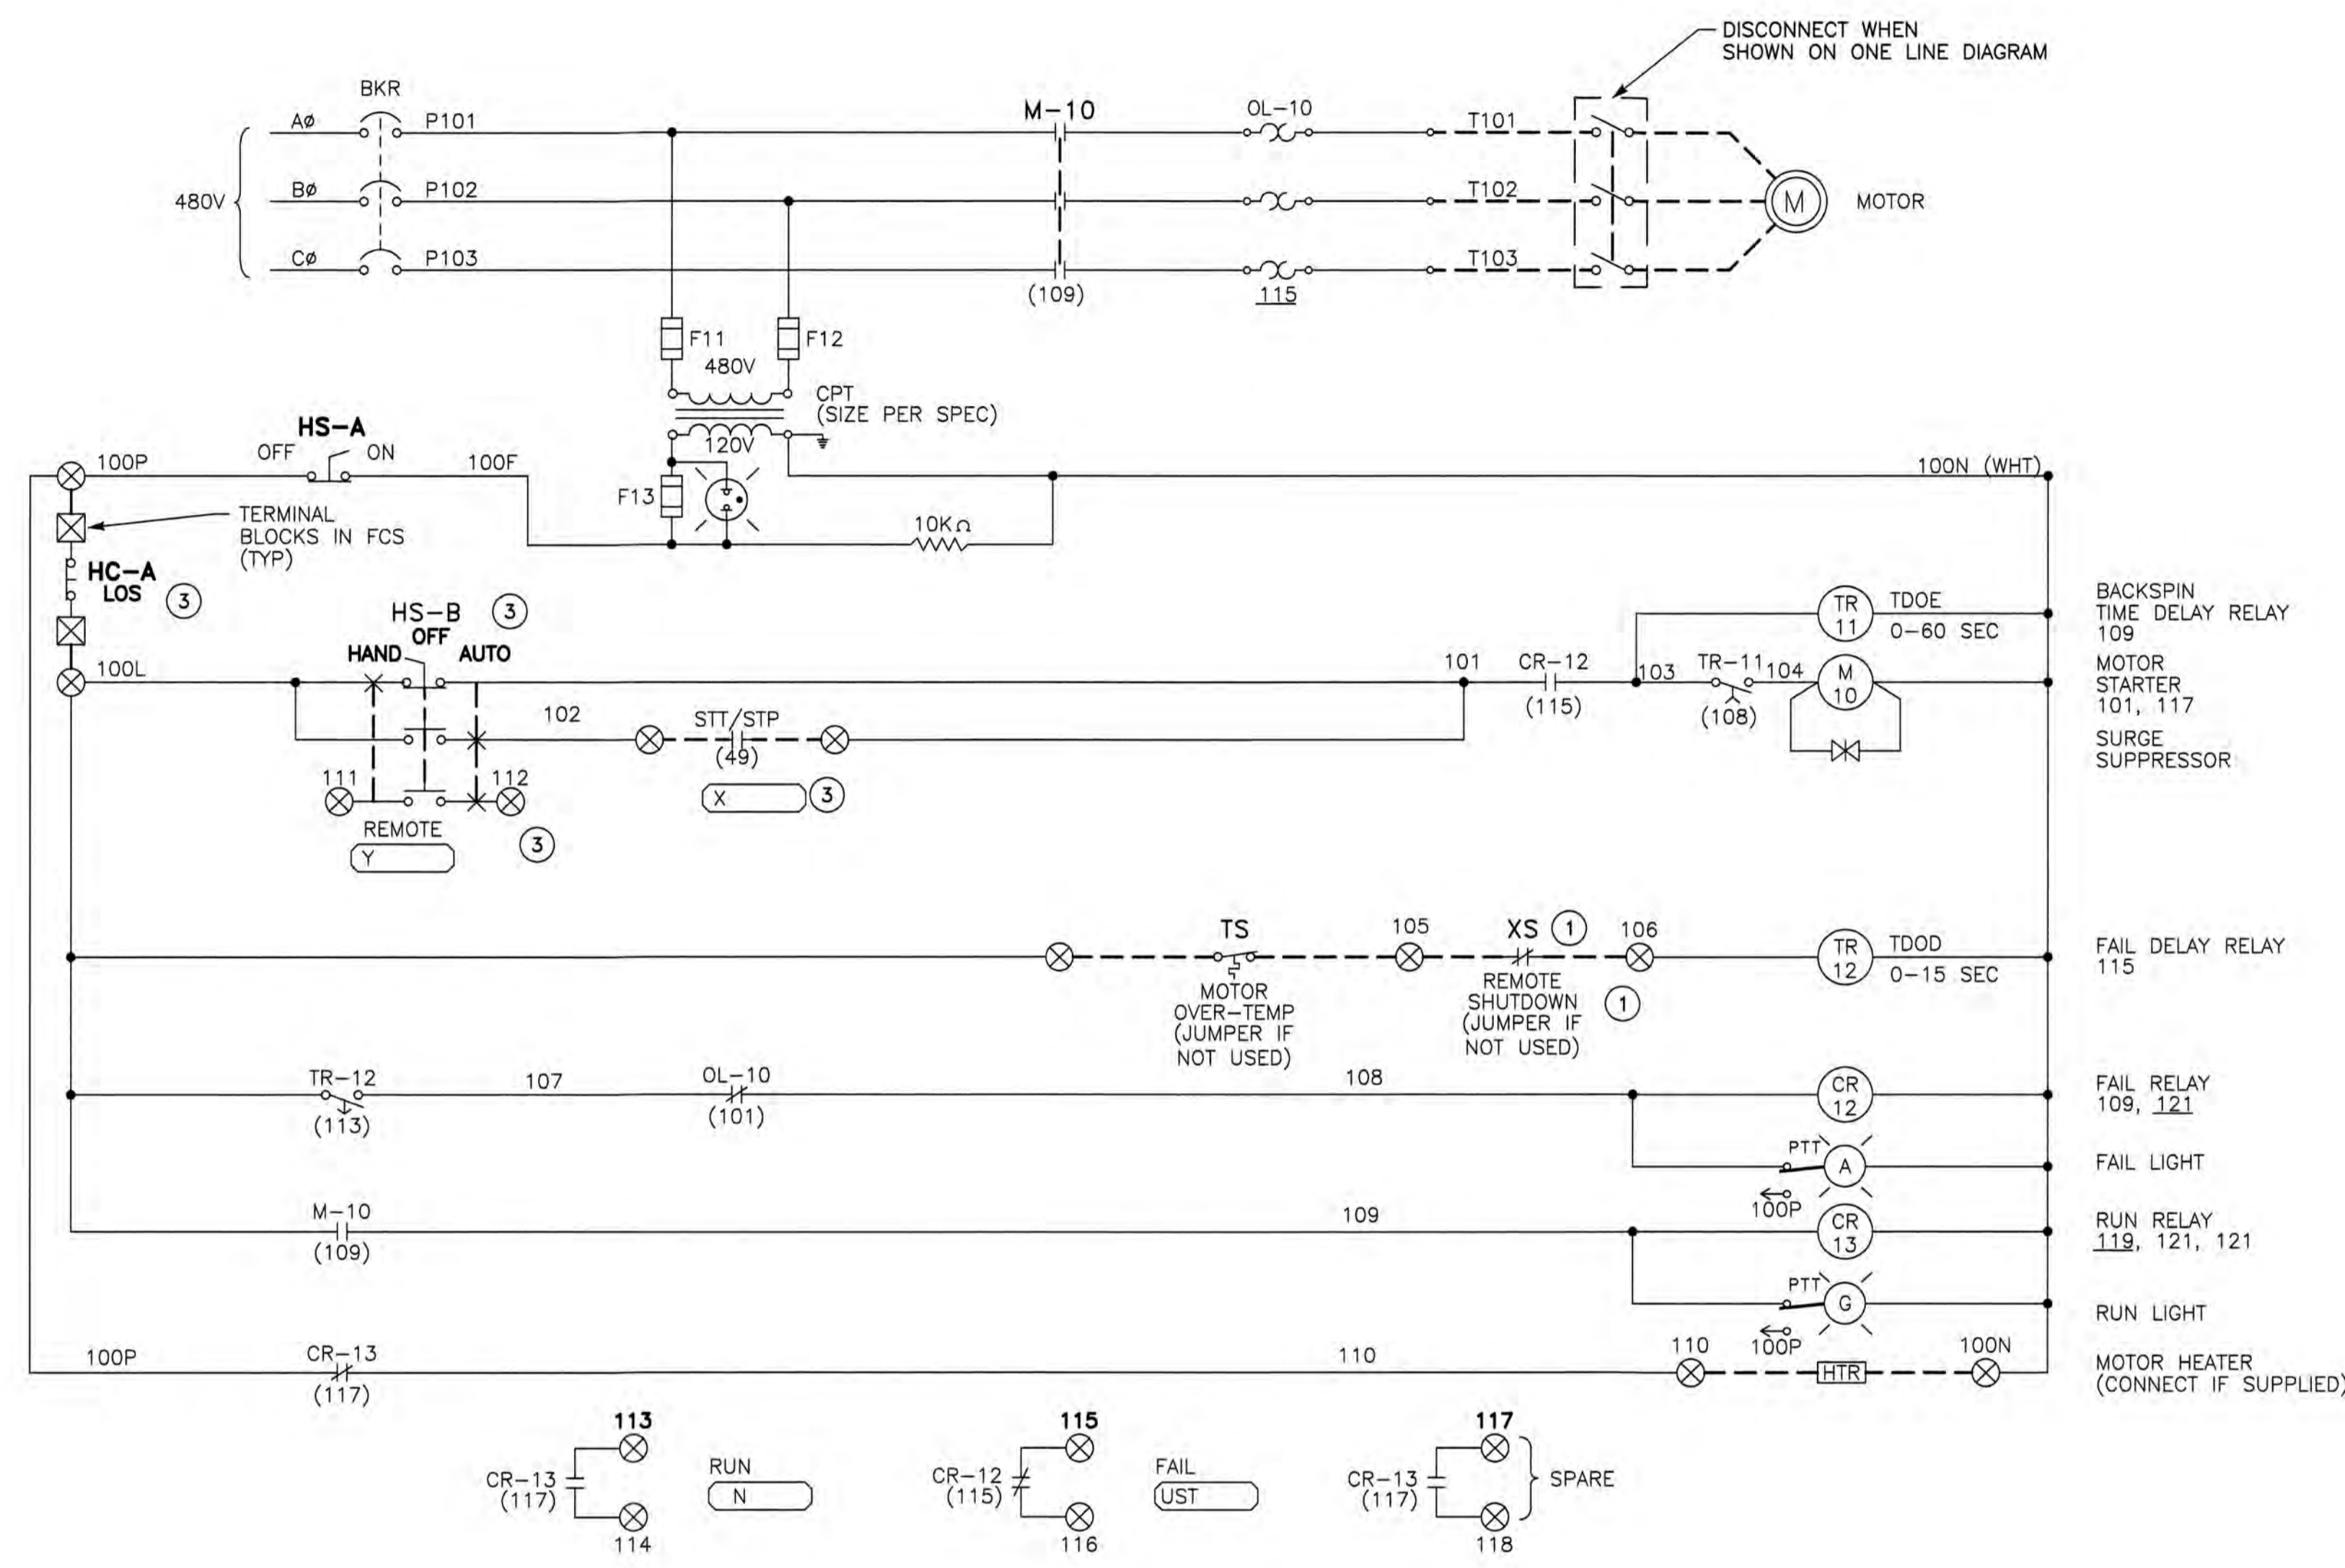


FULL SPEED ELEMENTARY DIAGRAM

- NOTE: ① REMOTE SHUTDOWN XS => LSLL, ZSHH, PSHH, ETC., PER P&ID, JUMPER IF NOT USED. THESE ARE TO BE CONTACTS OFF OF AUXILIARY RELAY CONTACTS LOCATED IN CONTROL PANEL DRIVEN FROM FIELD DEVICE.
- ② EQUIPMENT NAMEPLATE TO CONTAIN EQUIPMENT DESCRIPTION & EQUIPMENT NUMBER PER ELEVATION DIAGRAM. MOUNT ON OR ABOVE DEVICE BOX ON FCS.
- ③ INSTALL WHEN INDICATED ON P & ID.

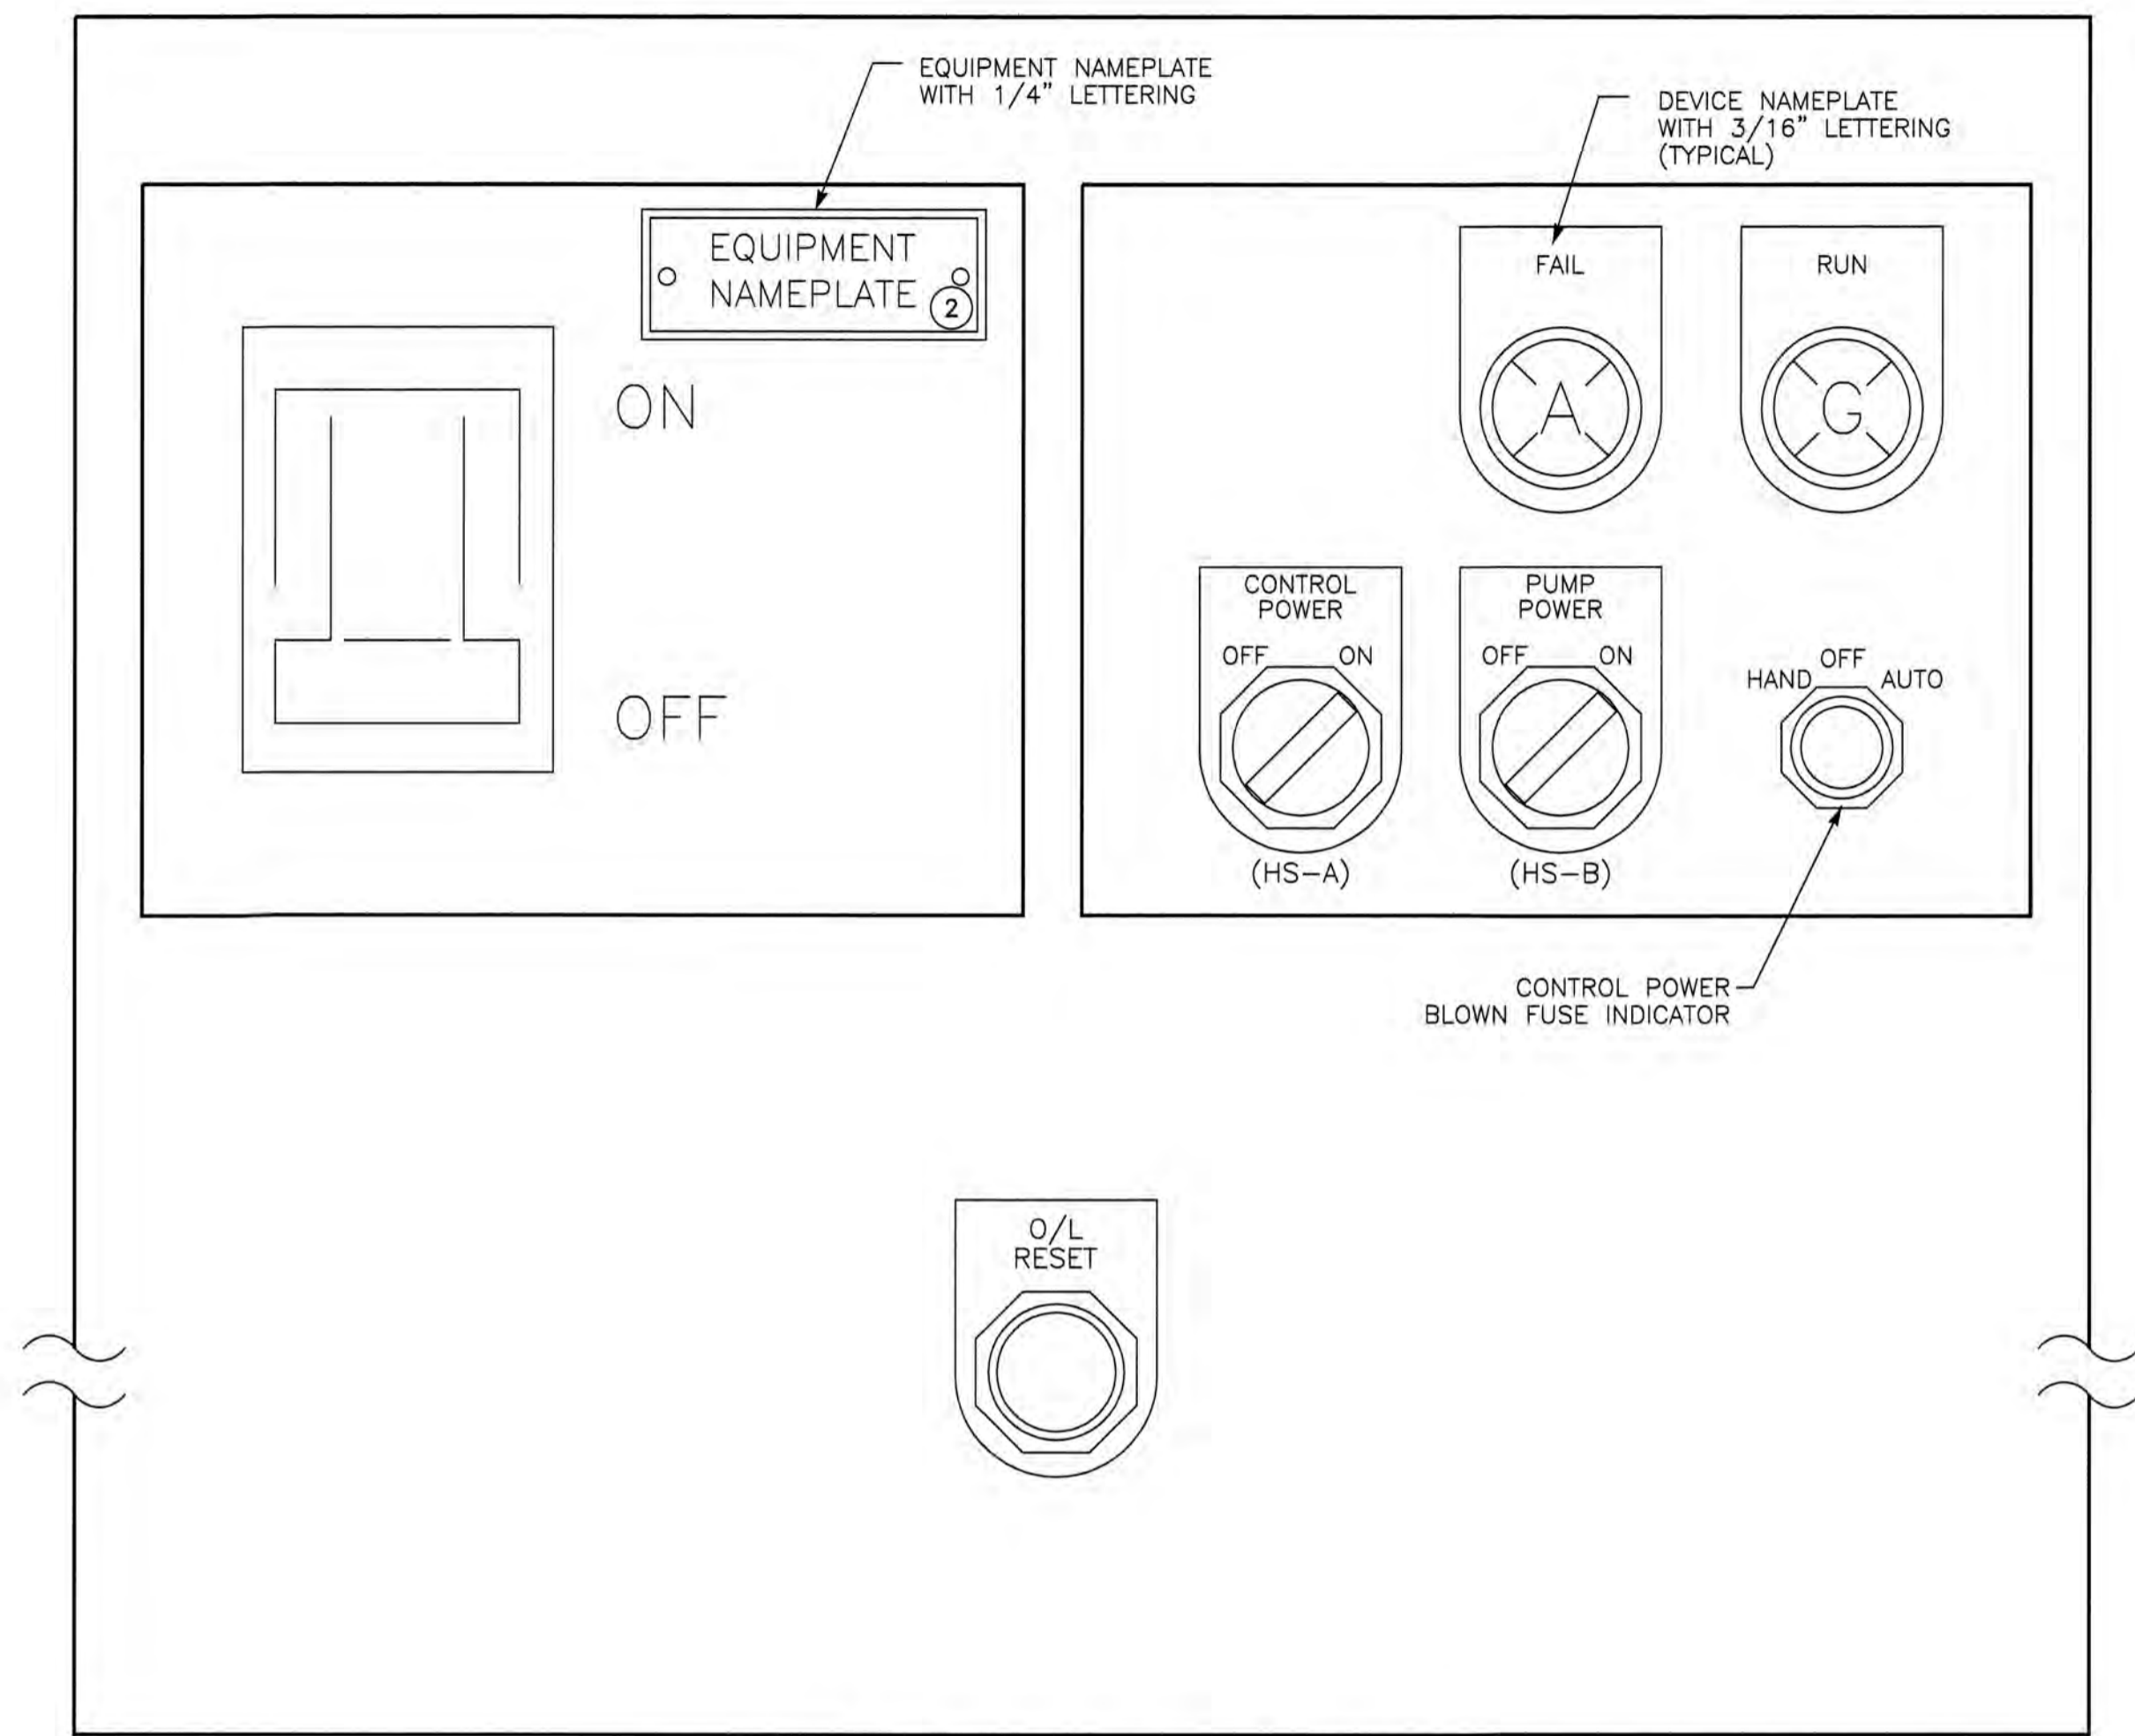

MCC CUBICLE LAYOUT

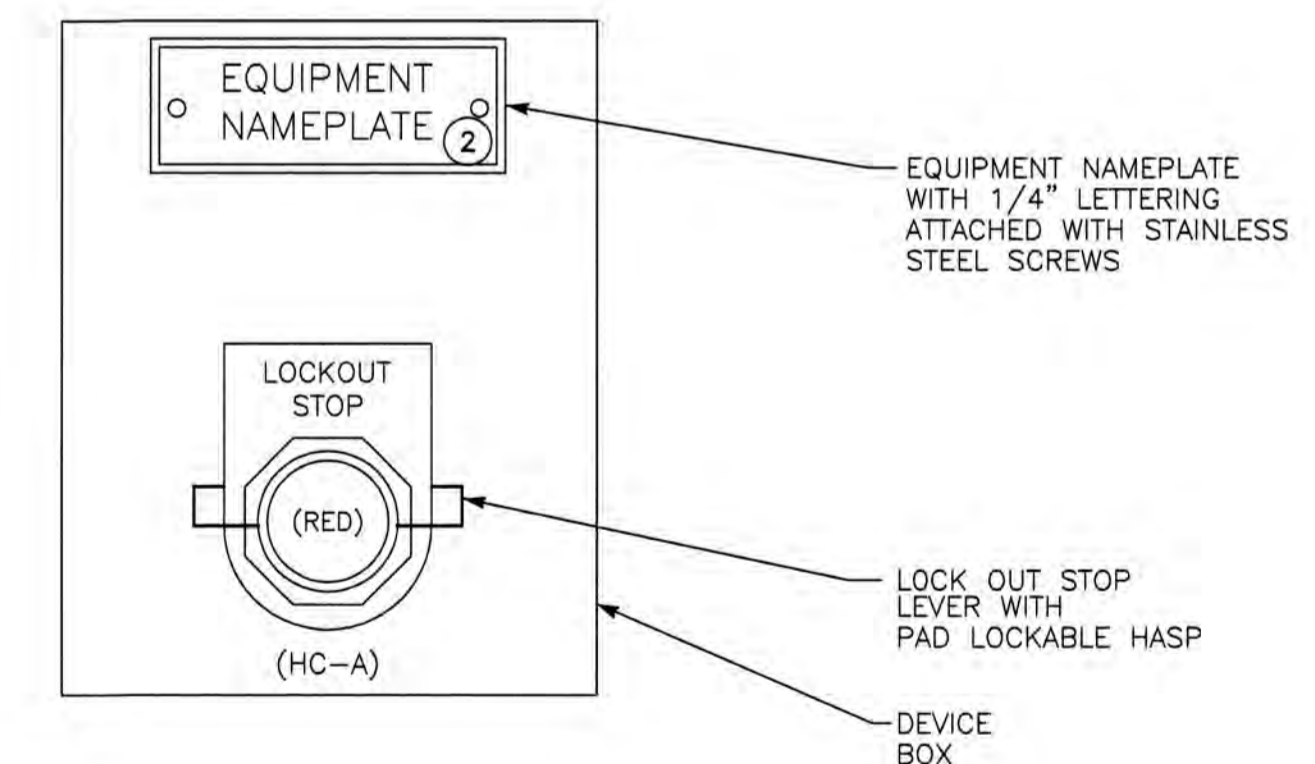

FIELD CONTROL STATION (FCS) ③
LOCATED AT EQUIPMENT


RECORD DRAWINGS		
14-Mile Slough Pump Station Upgrades		
FULL SPEED ELEMENTARY DIAGRAM		
DEPARTMENT OF MUNICIPAL UTILITIES CITY OF STOCKTON, CALIFORNIA		
SCALE: NONE	APPROVED BY: DATE: _____	SHEET No. E9
DESIGNED BY: SMK		66 of 89 SHEETS
DRAWN BY: ZK		PROJECT No. 293-00-05-01
CHECKED BY: XML	ASSISTANT DIRECTOR, DEPT. OF MUNICIPAL UTILITIES	
RECORD Dwg.:		




REFER TO BID SET FOR SIGNATURE

REV. No.	DISCRPTION	DATE	BY	Apr'd By

WEST YOST ASSOCIATES
Consulting Engineers
1280 Lake Boulevard
Suite 240
Davis, California 95616
(530) 756-5905
FAX (530) 756-5991

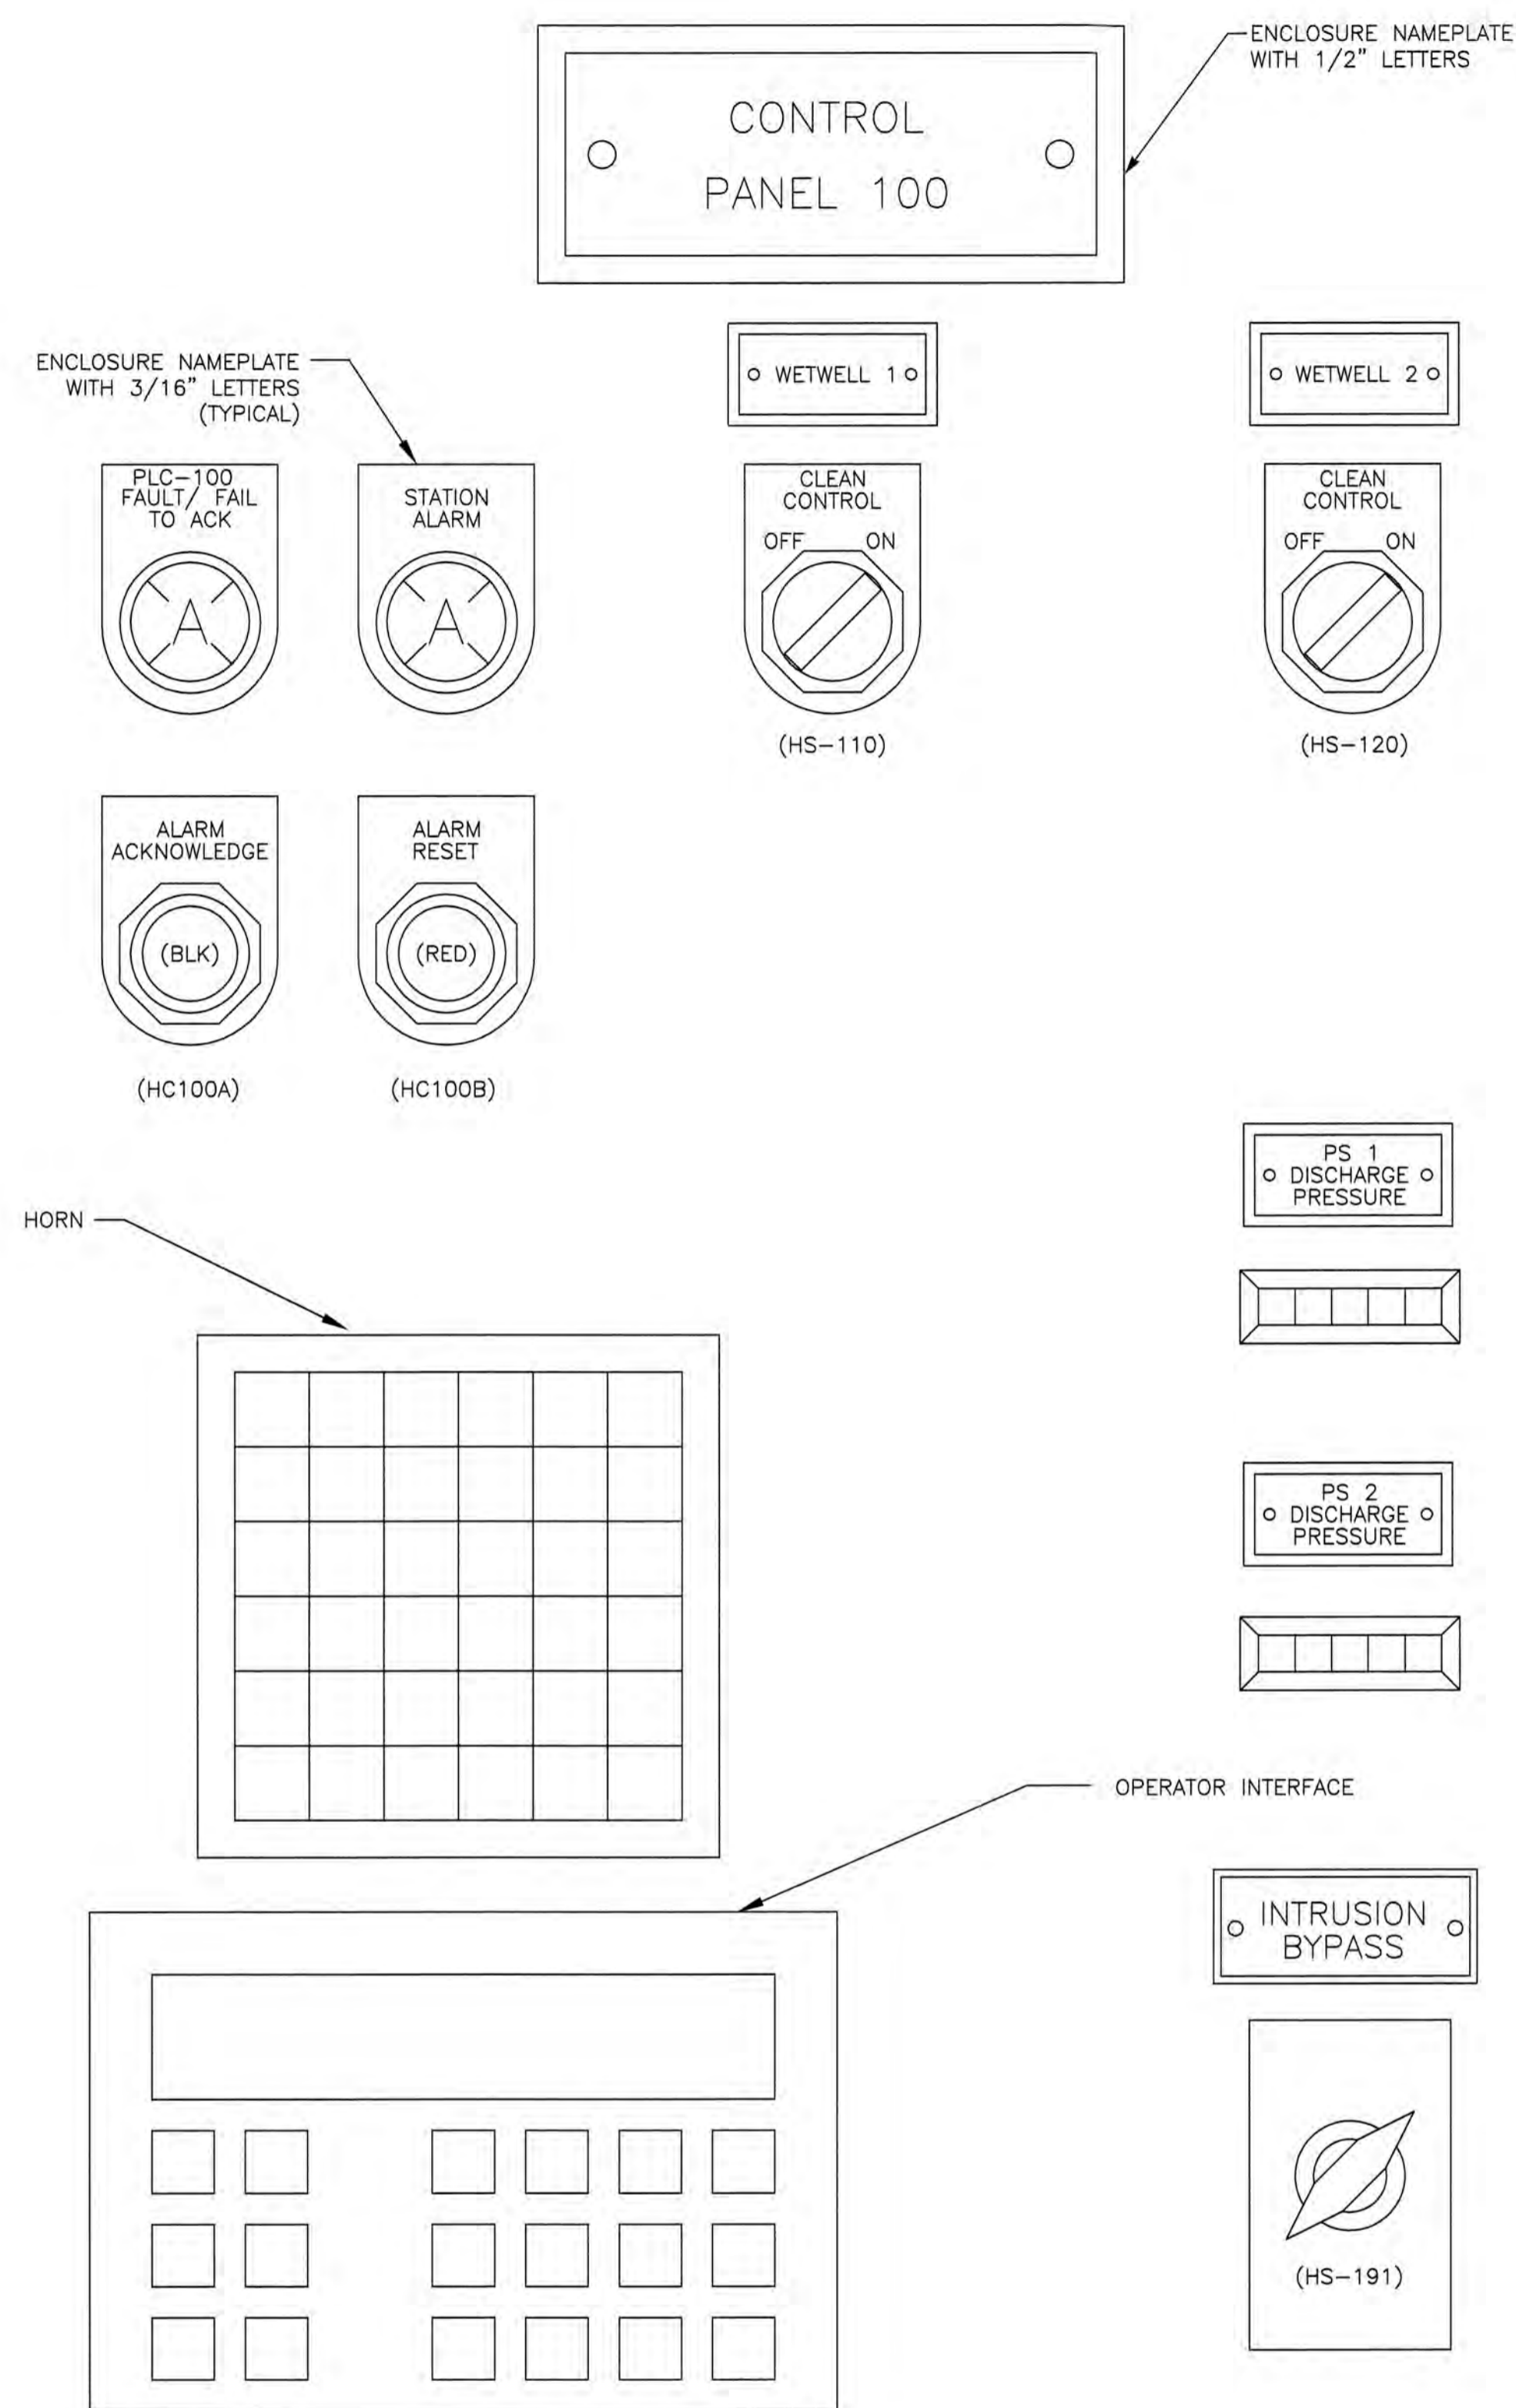

CONTROL PANEL 100 ELEVATION

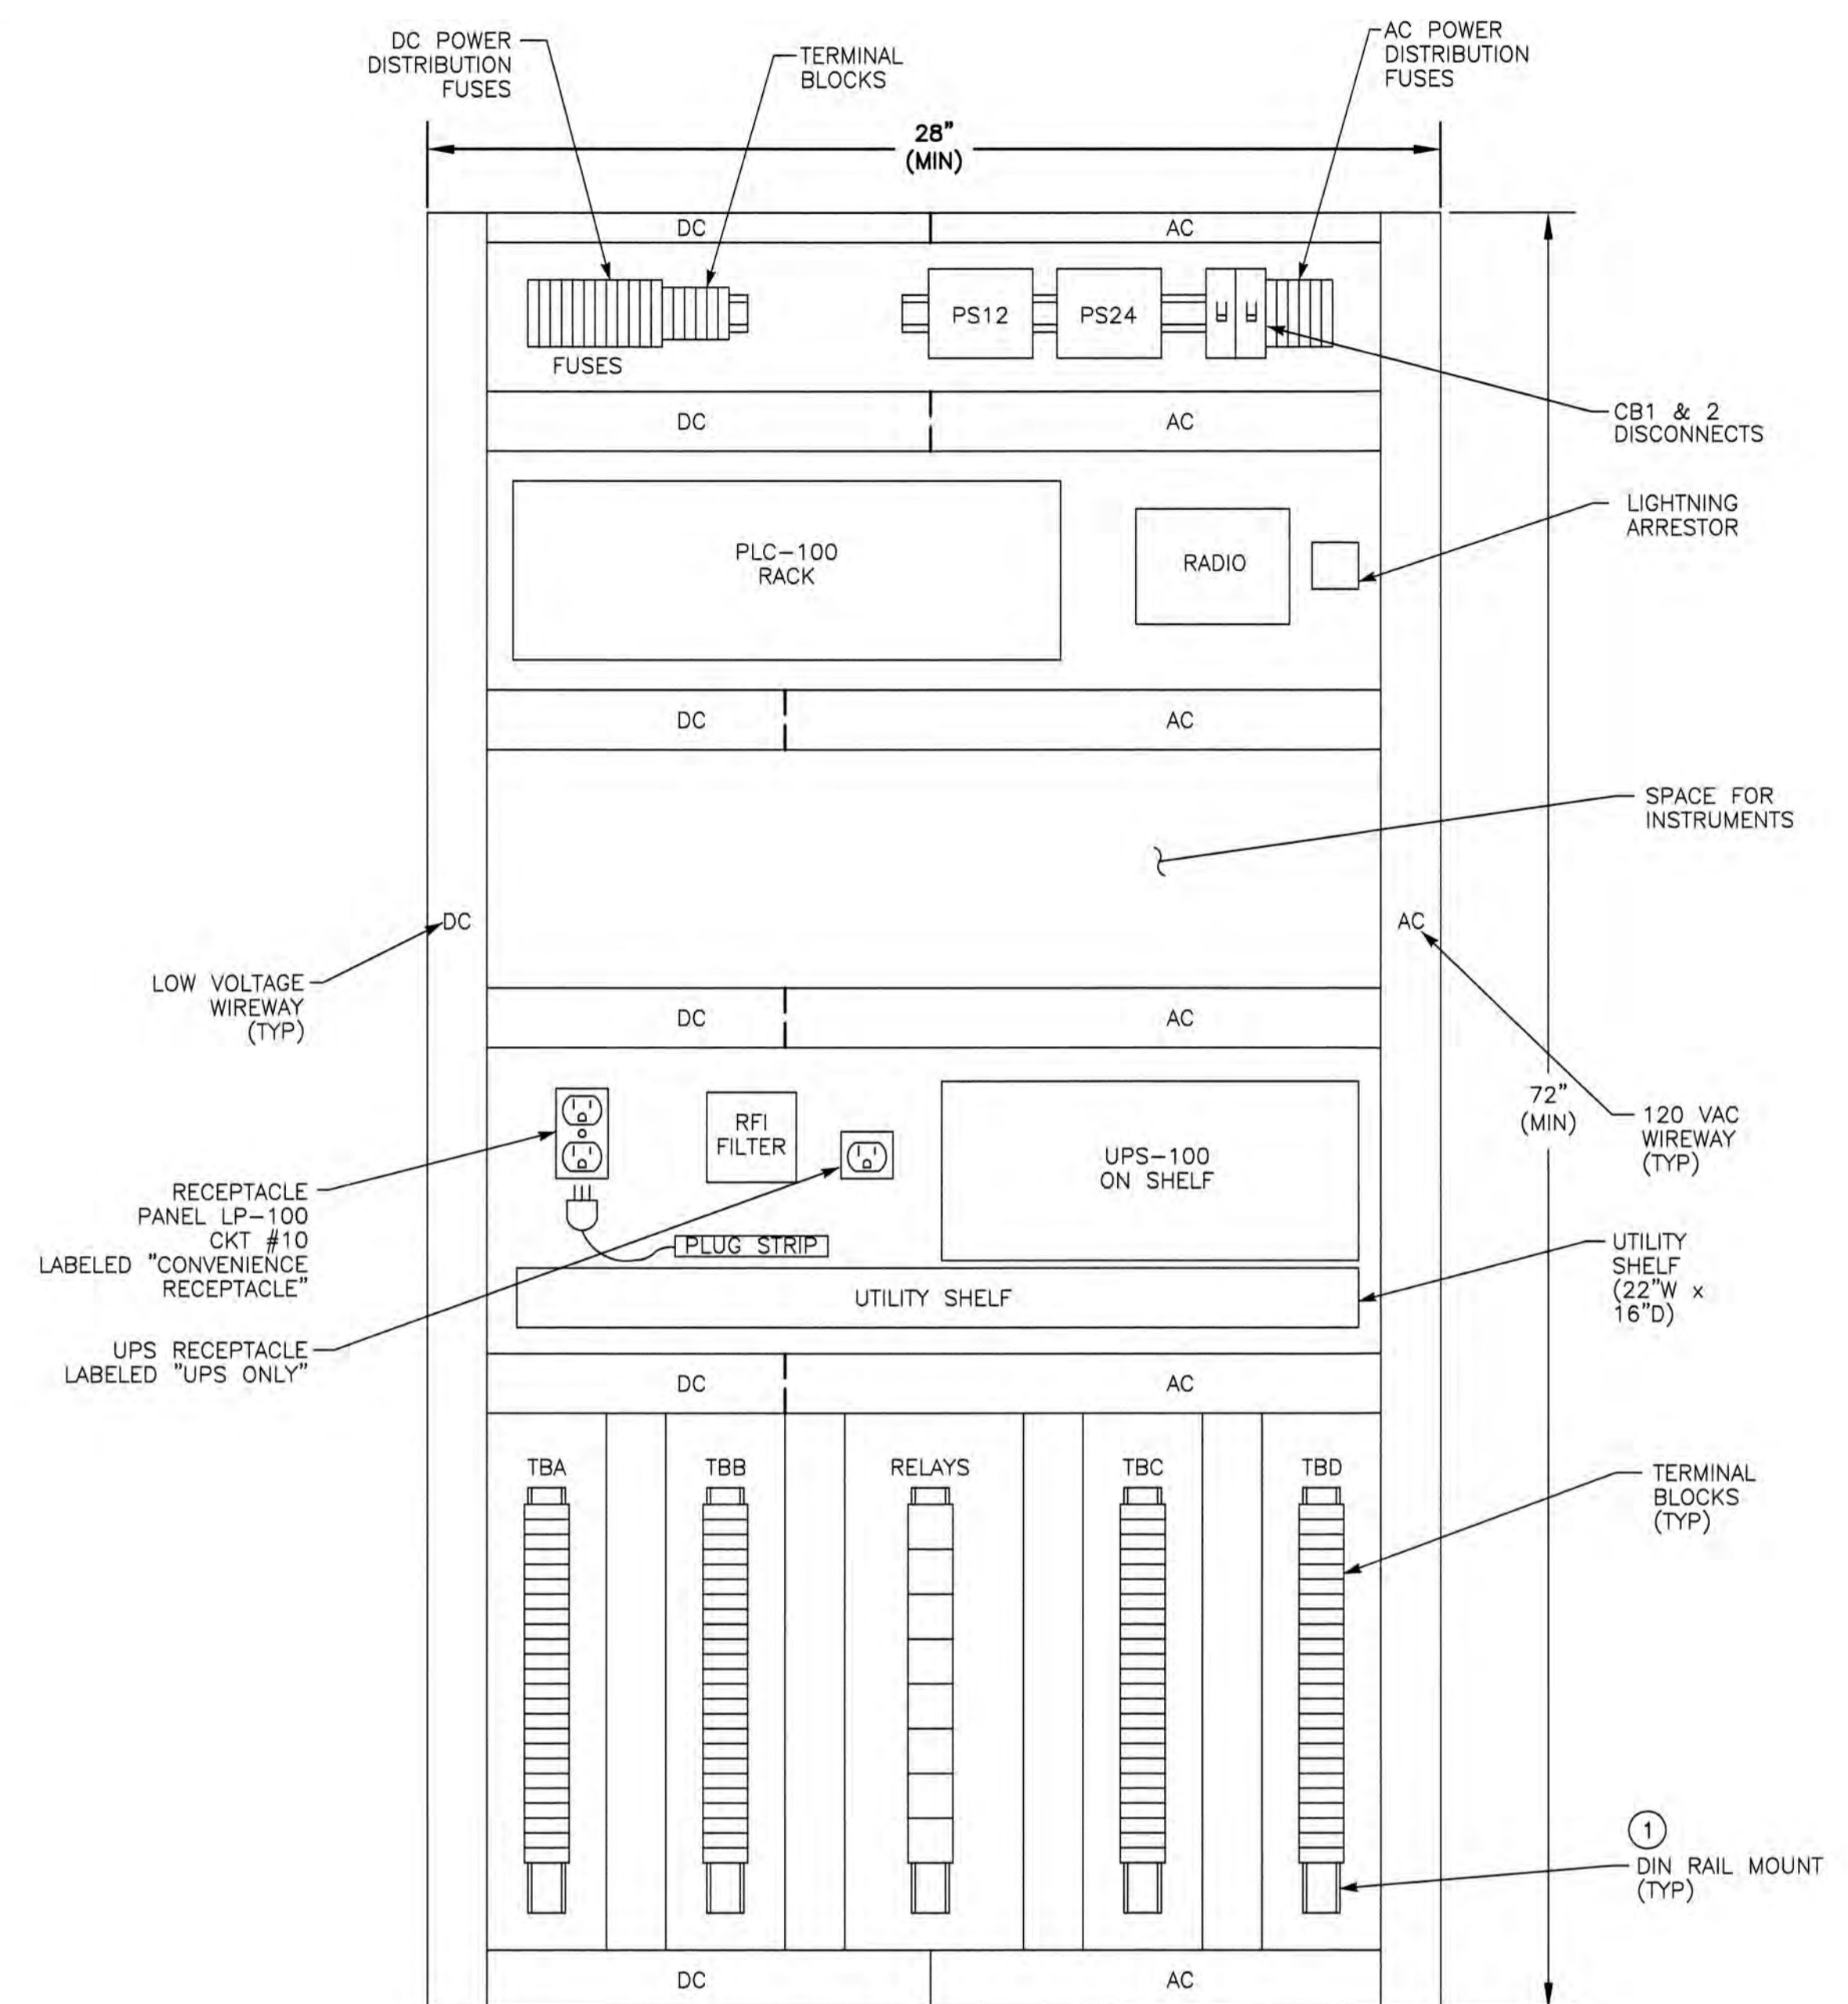

CP-100 BACKPAN LAYOUT ②

- NOT TO SCALE
- NOTES:
- ① PROVIDE ADDITIONAL DIN RAIL TO ADD A MINIMUM OF EIGHT TERMINAL BLOCKS TO EACH TERMINAL STRIP.
 - ② PROVIDE SIDEPANS ON BOTH SIDES OF ENCLOSURE FOR ADDITIONAL MOUNTING SPACE.
 - ③ CONTROL PANEL SHALL BE CONSTRUCTED BY AN U.L. APPROVED PANEL SHOP AND BEAR A U.L. LABEL.




REFER TO BID SET FOR SIGNATURE

REV. No.	DISCRIPTION	DATE	BY	Apr'd By
1	RECORD DRAWINGS			






1260 Lake Boulevard
Suite 240
Davis, California 95616
(530) 756-5905
FAX (530) 756-5991

RECORD DRAWINGS		
14-Mile Slough Pump Station Upgrades		
CONTROL PANEL 100 ELEVATION & BACKPAN LAYOUT		
DEPARTMENT OF MUNICIPAL UTILITIES CITY OF STOCKTON, CALIFORNIA		
SCALE: NONE	APPROVED BY: DATE: _____	SHEET No. E10
DESIGNED BY: SMK		67 of 89 SHEETS
DRAWN BY: ZK		PROJECT No. 293-00-05-01
CHECKED BY: XML	ASSISTANT DIRECTOR, DEPT. OF MUNICIPAL UTILITIES	
RECORD Dwg.:		

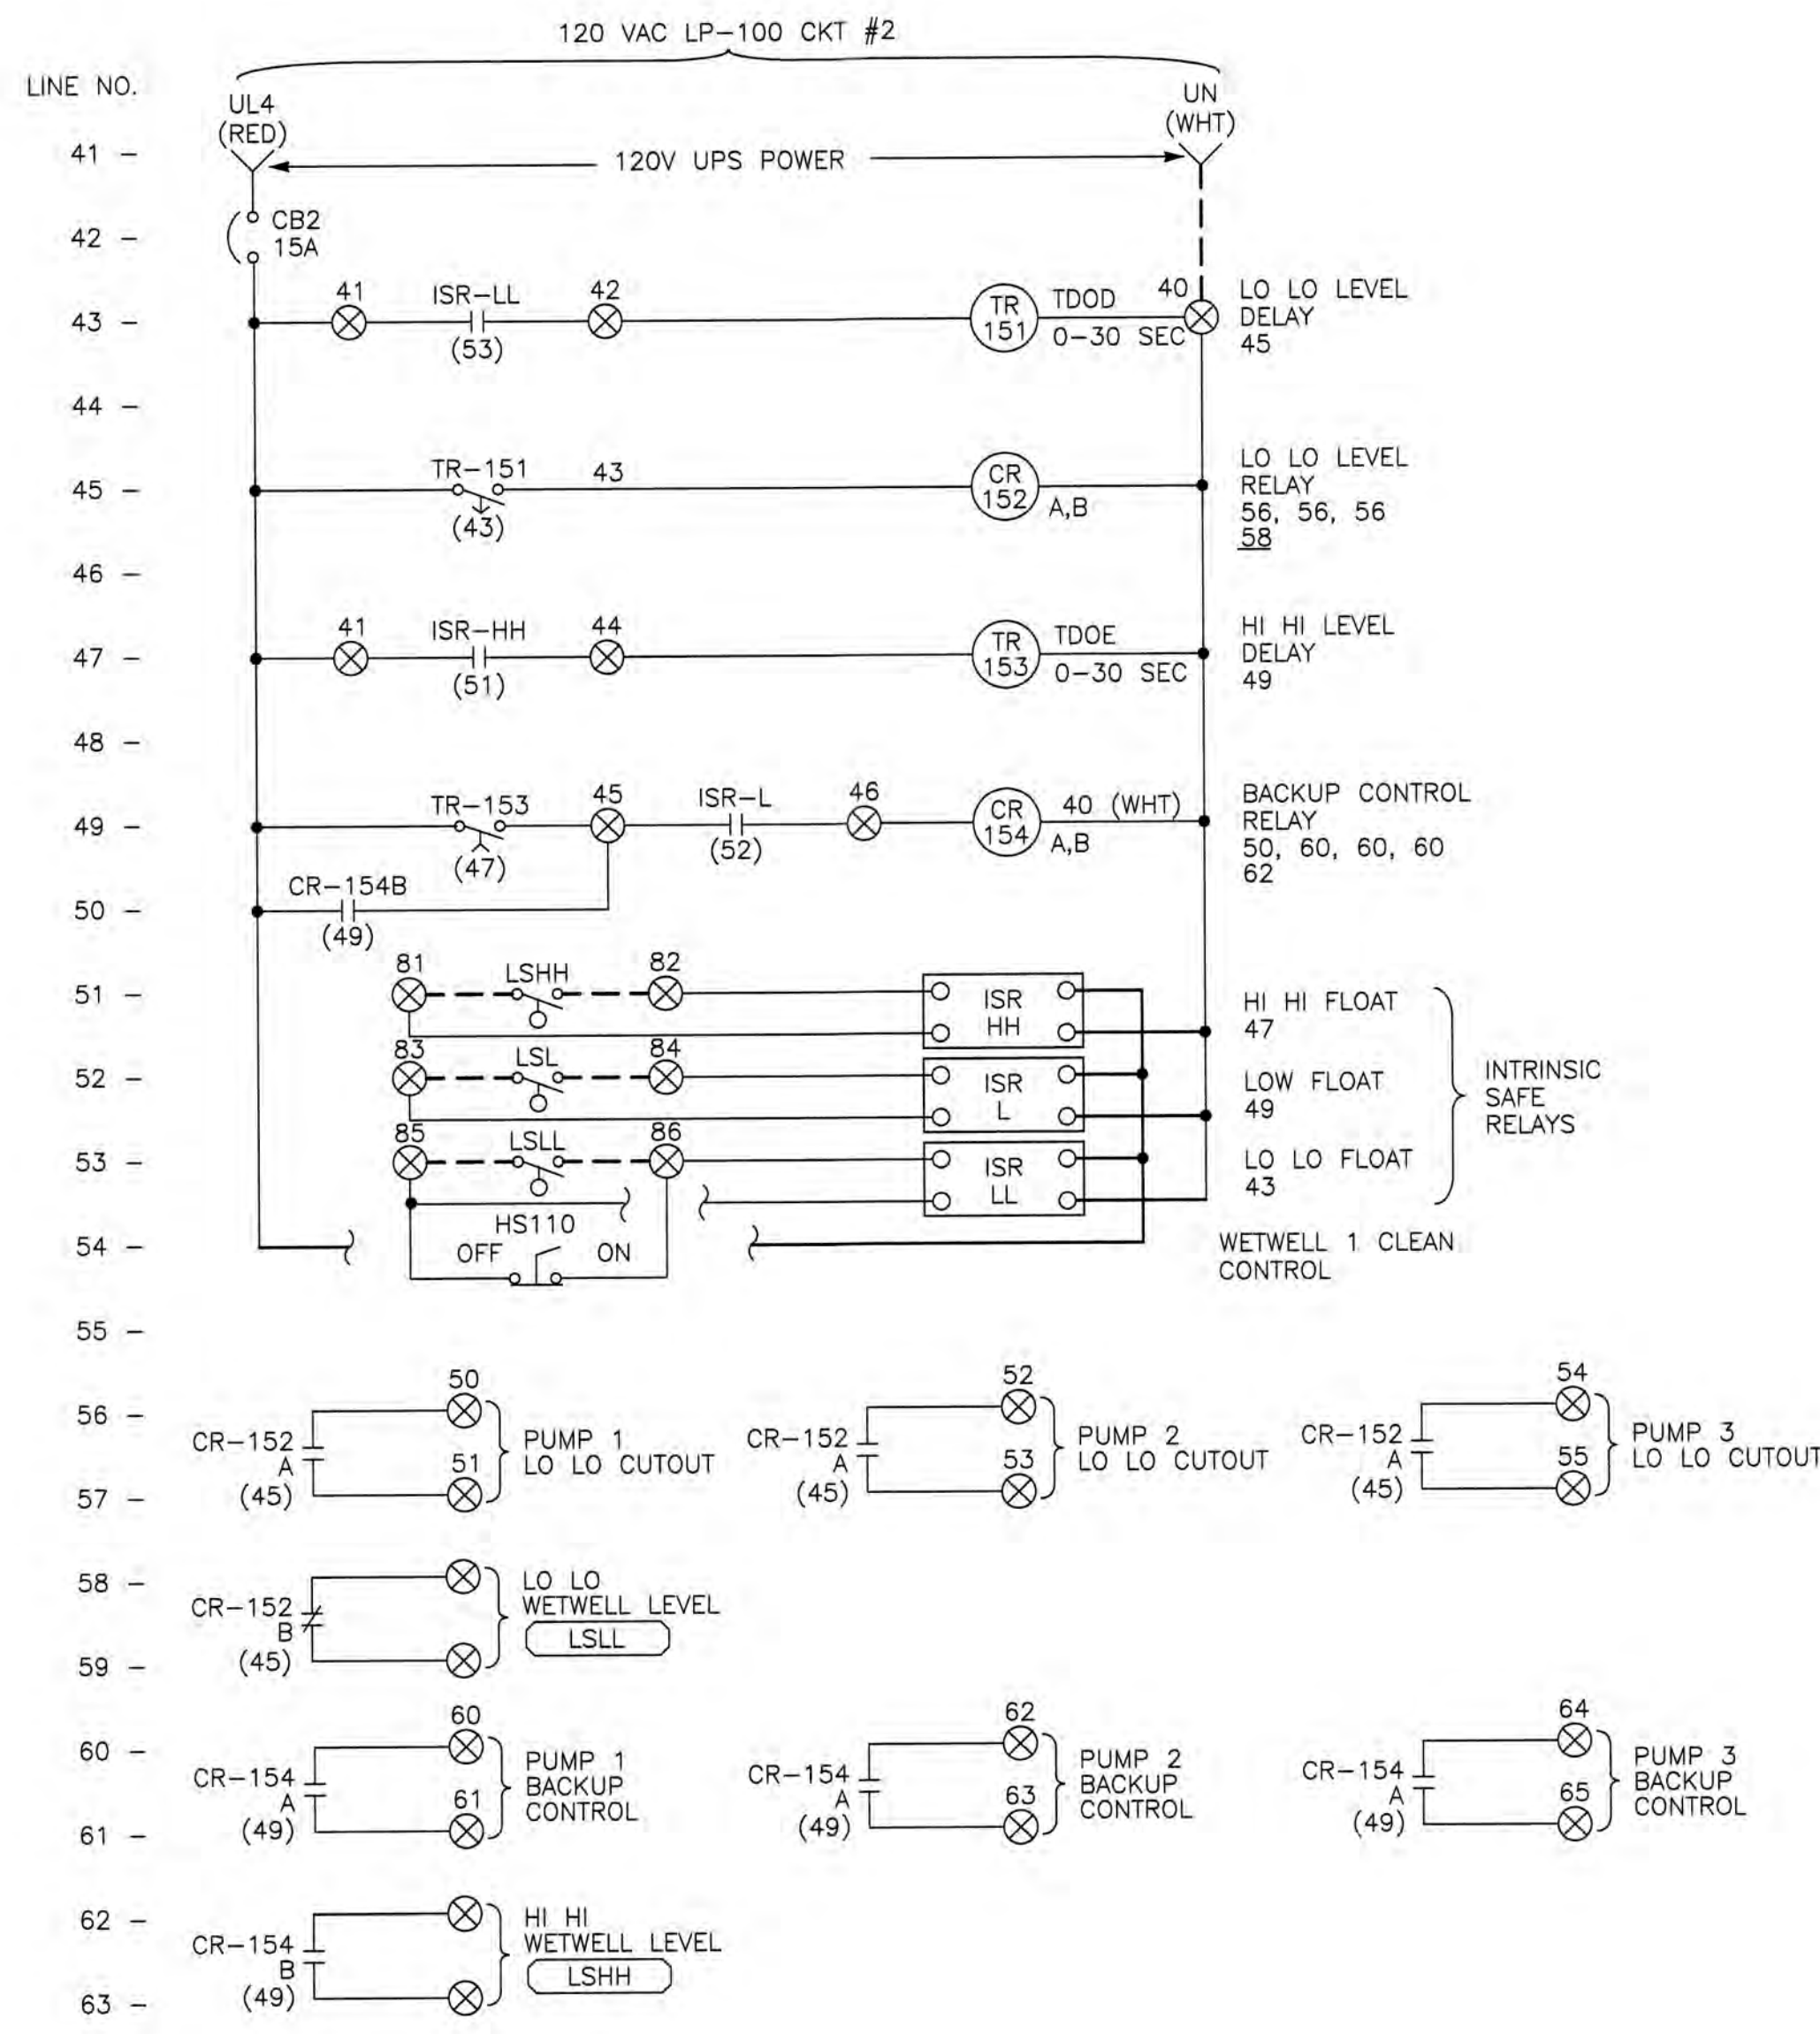



TYPICAL BACKUP CONTROLS ELEMENTARY DIAGRAM (A) E11

NOTES: ① TYPICAL FOR WETWELL 1 & 2.

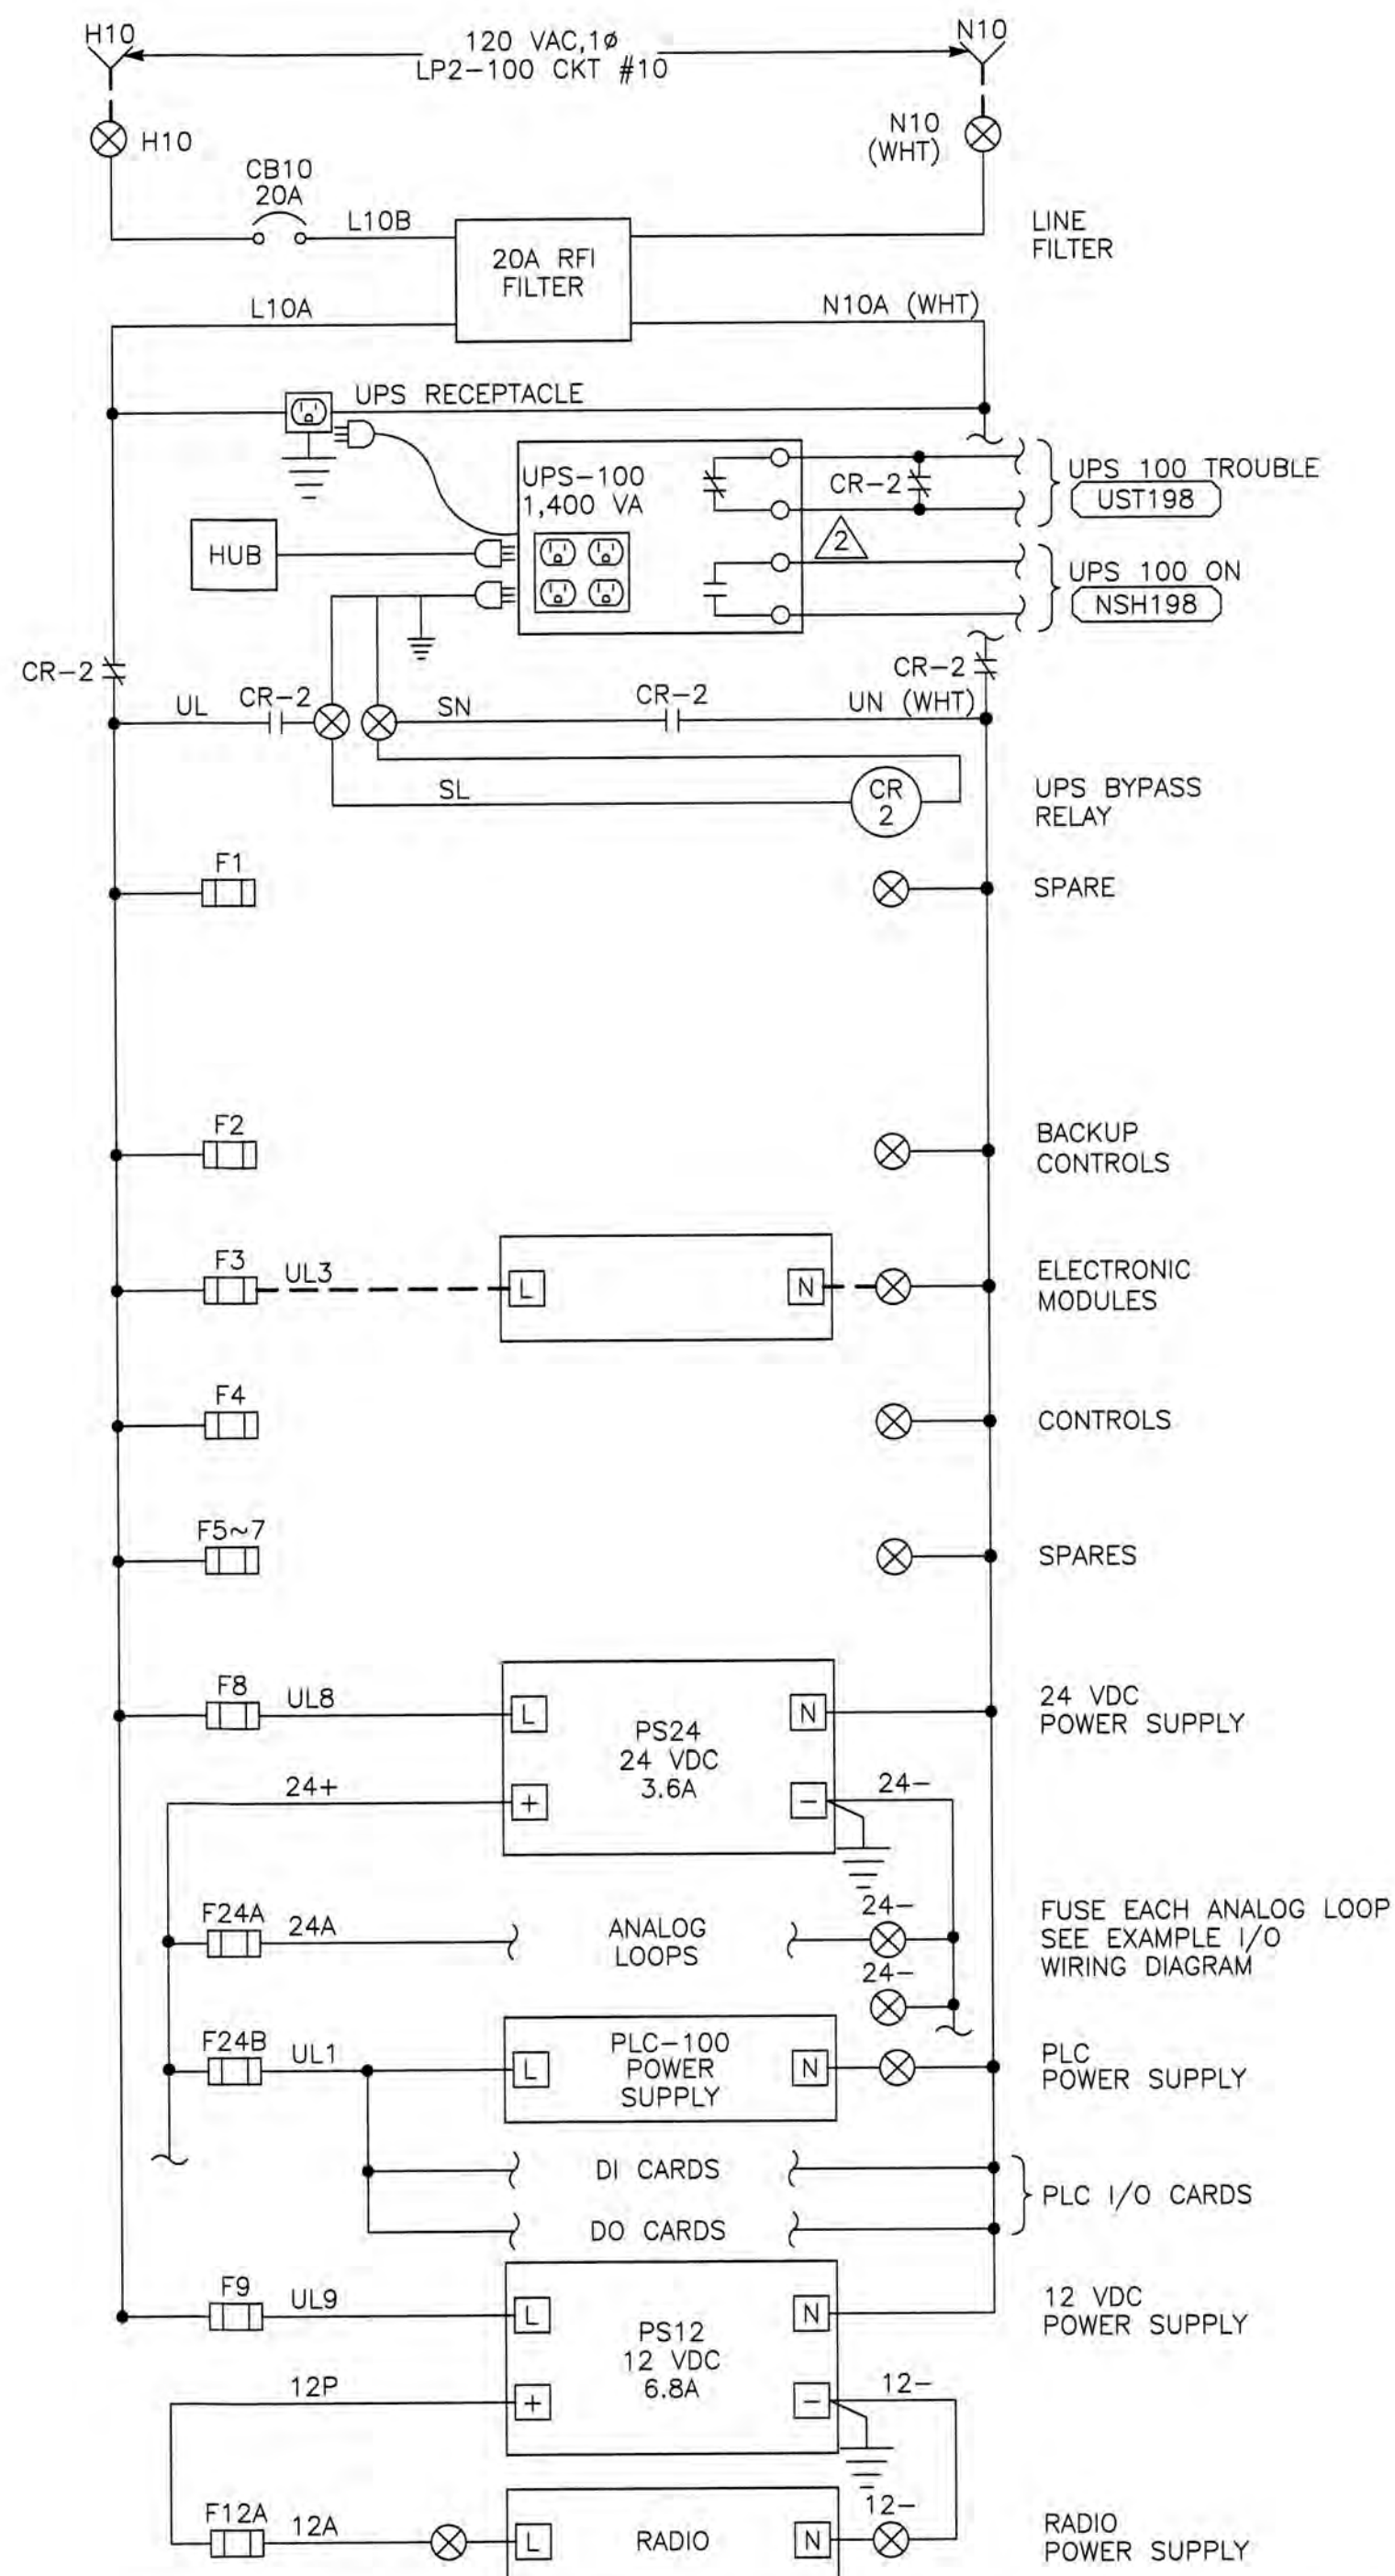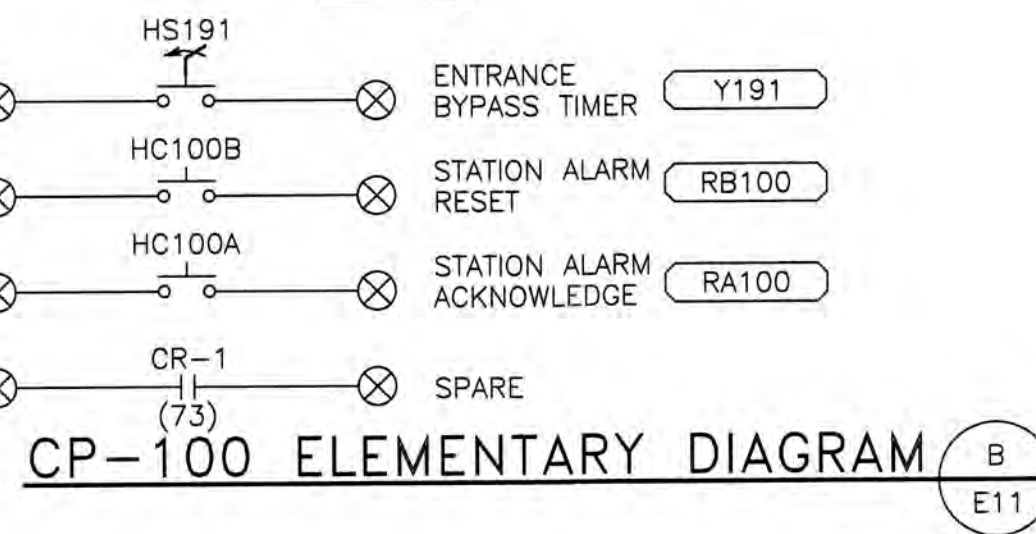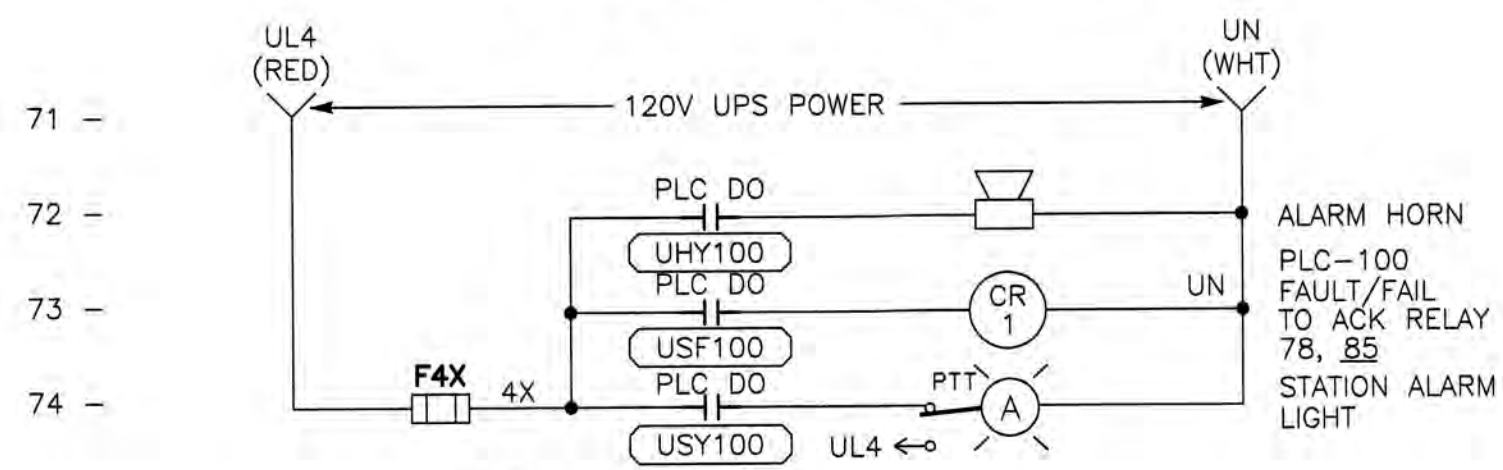

120 VAC POWER DISTRIBUTION DIAGRAM (C) E11

NOTES: ① DISTRIBUTION DIAGRAM REPRESENTATIVE OF MAJOR COMPONENTS ONLY. ADDITIONAL FUSES, CIRCUITS AND COMPONENT CONNECTIONS MAY BE REQUIRED FOR A FUNCTIONAL SYSTEM.
② PROVIDE & INSTALL INTERFACE RELAYS IF REQUIRED.

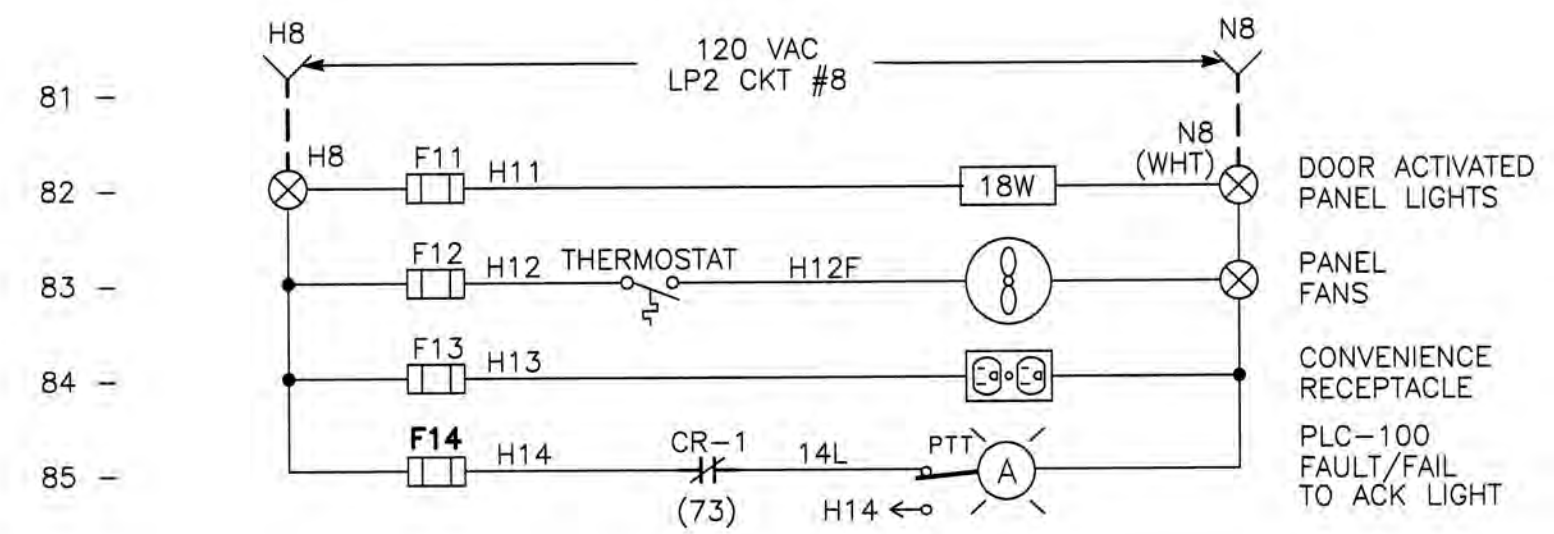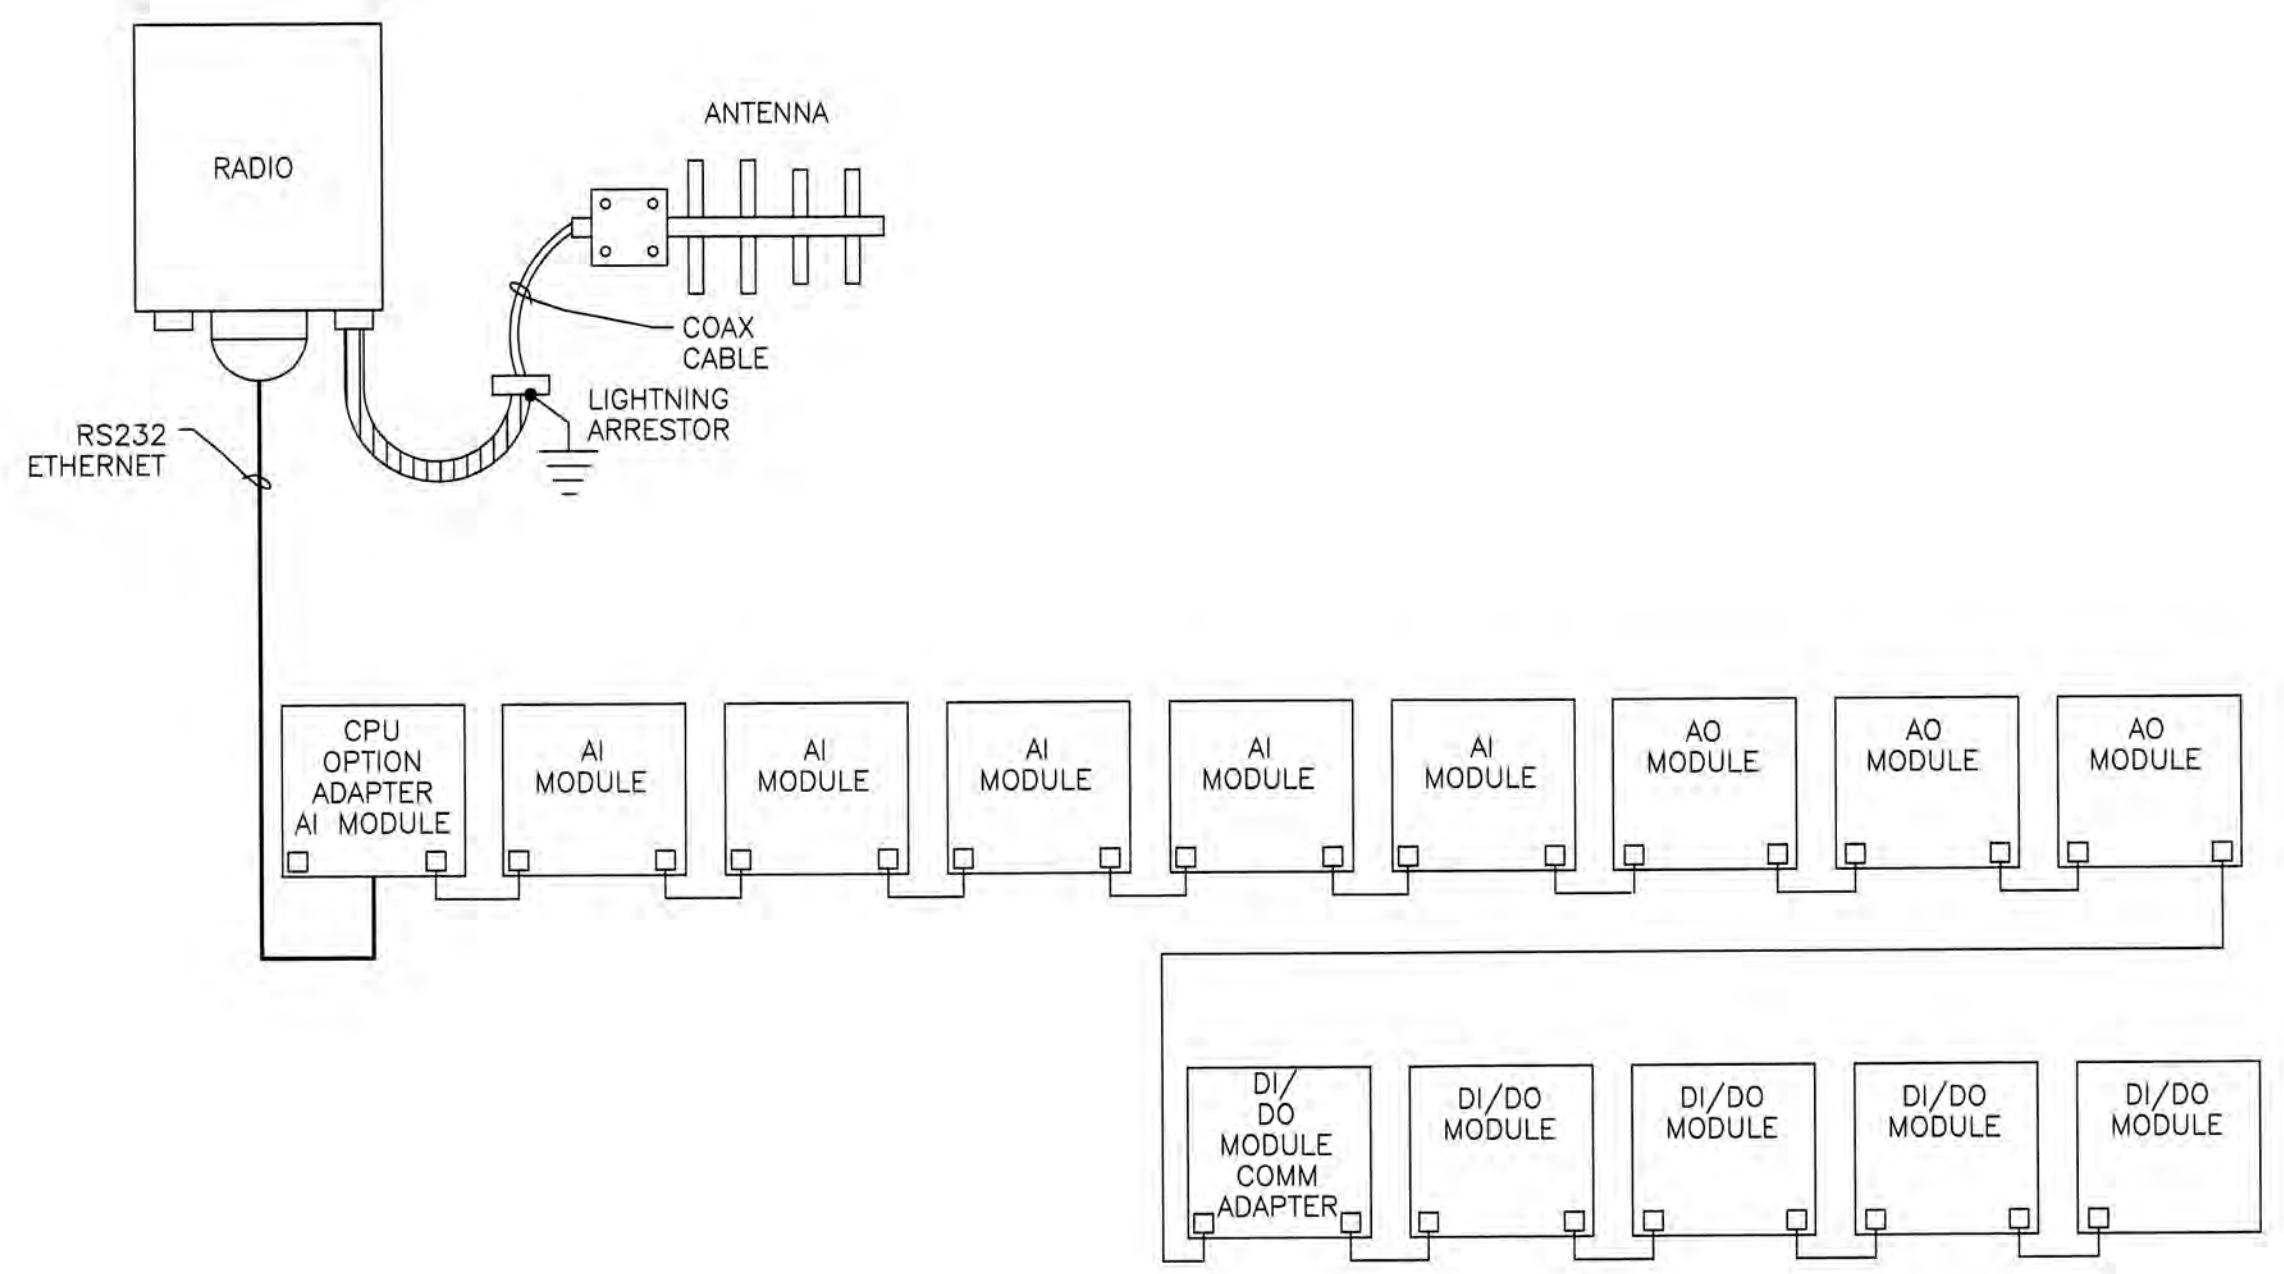

CP-100 UTILITY ELEMENTARY DIAGRAM (D) E11



REFER TO SET FOR SIGNATURE

REV. No.	DISCUSSION	DATE	BY	Apr'd By

WEST YOST ASSOCIATES

1260 Lake Boulevard Suite 240 Davis, California 95616 (530) 756-5905 FAX (530) 756-5991

RECORD DRAWINGS

14-Mile Slough Pump Station Upgrades

CP-100 ELEMENTARY DIAGRAM

DEPARTMENT OF MUNICIPAL UTILITIES CITY OF STOCKTON, CALIFORNIA

SCALE: NONE APPROVED BY: DATE: SHEET No. E11

DESIGNED BY: SMK

DRAWN BY: ZK

CHECKED BY: XML



RECORD Dwg.: ASSISTANT DIRECTOR, DEPT. OF MUNICIPAL UTILITIES

PROJECT No. 293-00-05-01

NOTES:

- CONDUIT SIZE & TYPE; WIRE FILL FOR CONDUITS TO BE DESIGNATED NEXT TO CONDUIT NUMBER ELLIPSE.
- THESE ARE THE CONTRACTOR DESIGNATED DRAWING NUMBERS.
- NOT MORE THAN TWO WIRES PER TERMINAL BLOCK.
- ALL TERMINAL BLOCKS TO BE PLACED IN NUMERICAL ORDER.
- ALL NEUTRALS SHALL BE WHITE WIRE COLOR.
- #12 GND TO DEVICES SHALL BE BONDED TO #8 GND LUG.

REFERENCE DOCUMENTS		
DRAWING #	DESCRIPTION	MANUFACTURER
P712	P&ID DIAGRAM	DESIGN
E717	ELECTRICAL SITE PLAN	DESIGN
PAGE 32, 36	CONDUIT AND CABLE SCHEDULE	DESIGN
(2) 1354-11	LOOP DIAGRAM	CONTRACTOR
(2) 1354-68	ELEMENTARY DIAGRAM	CONTRACTOR

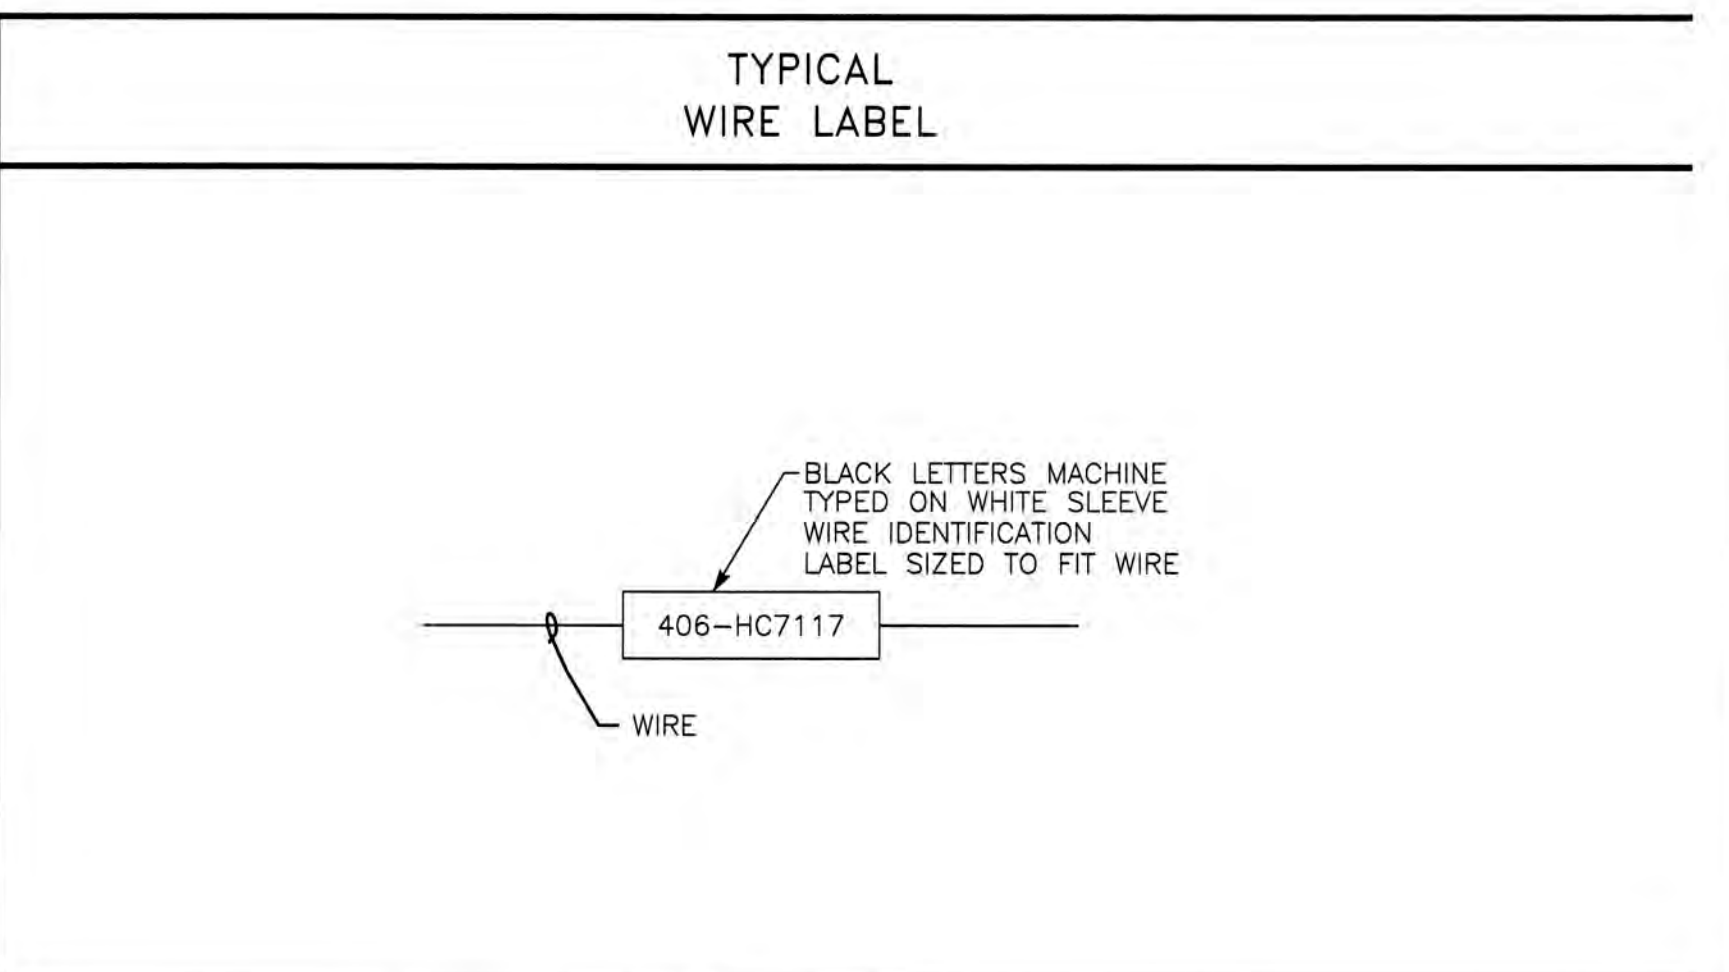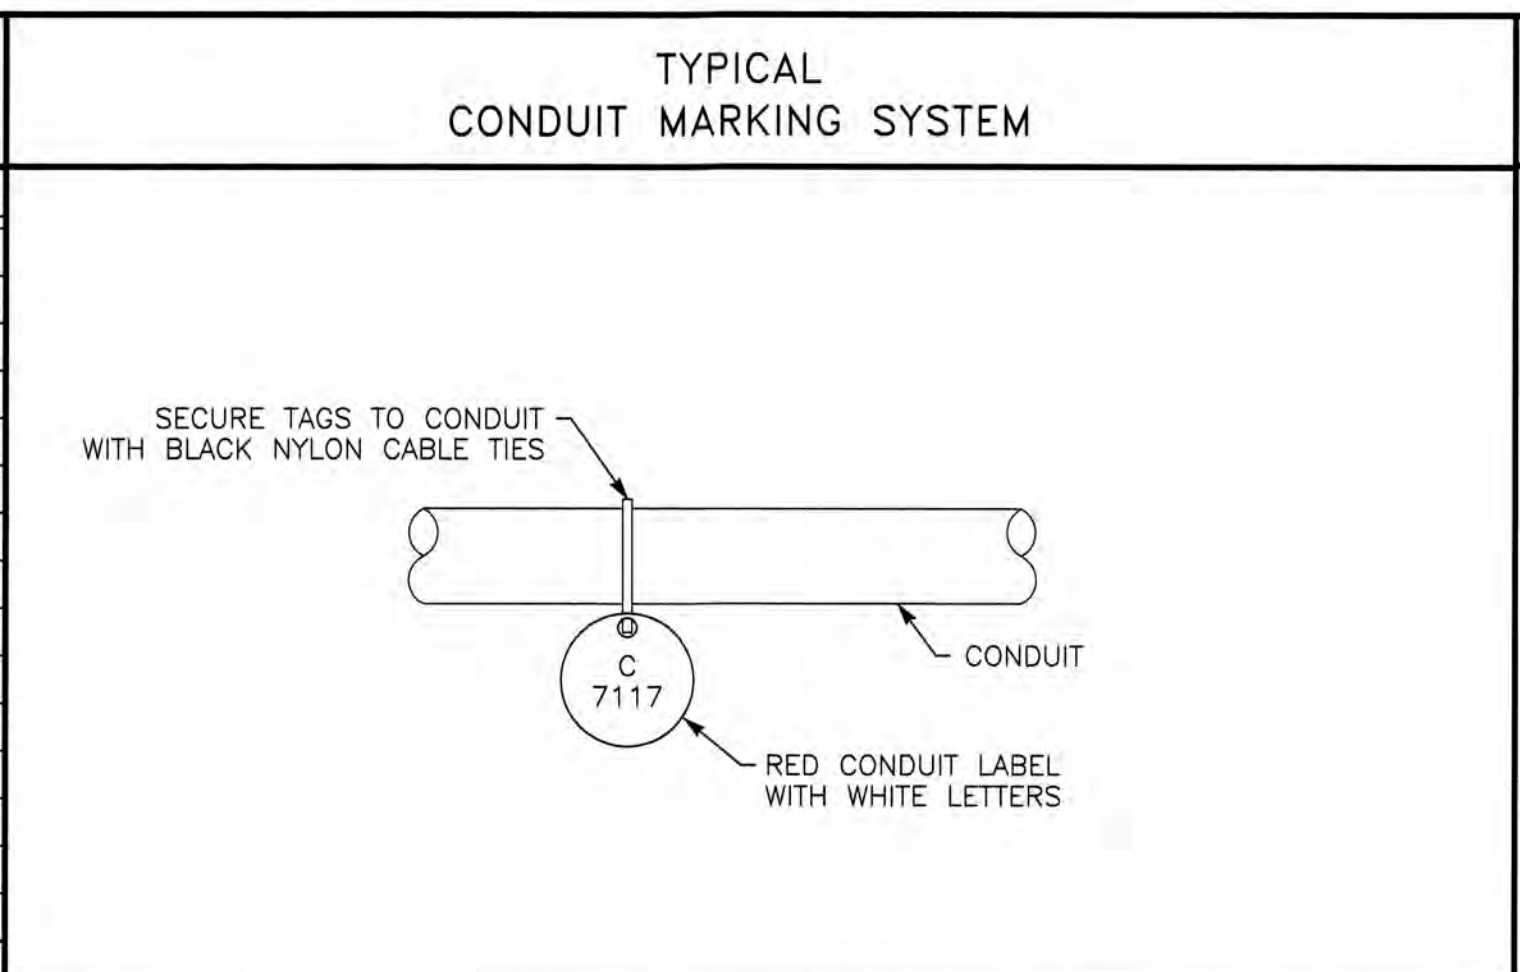


EQUIPMENT

FIELD

MCC-4 SECTION 1 CUBICLE A~E

CONTROL PANEL NO.2

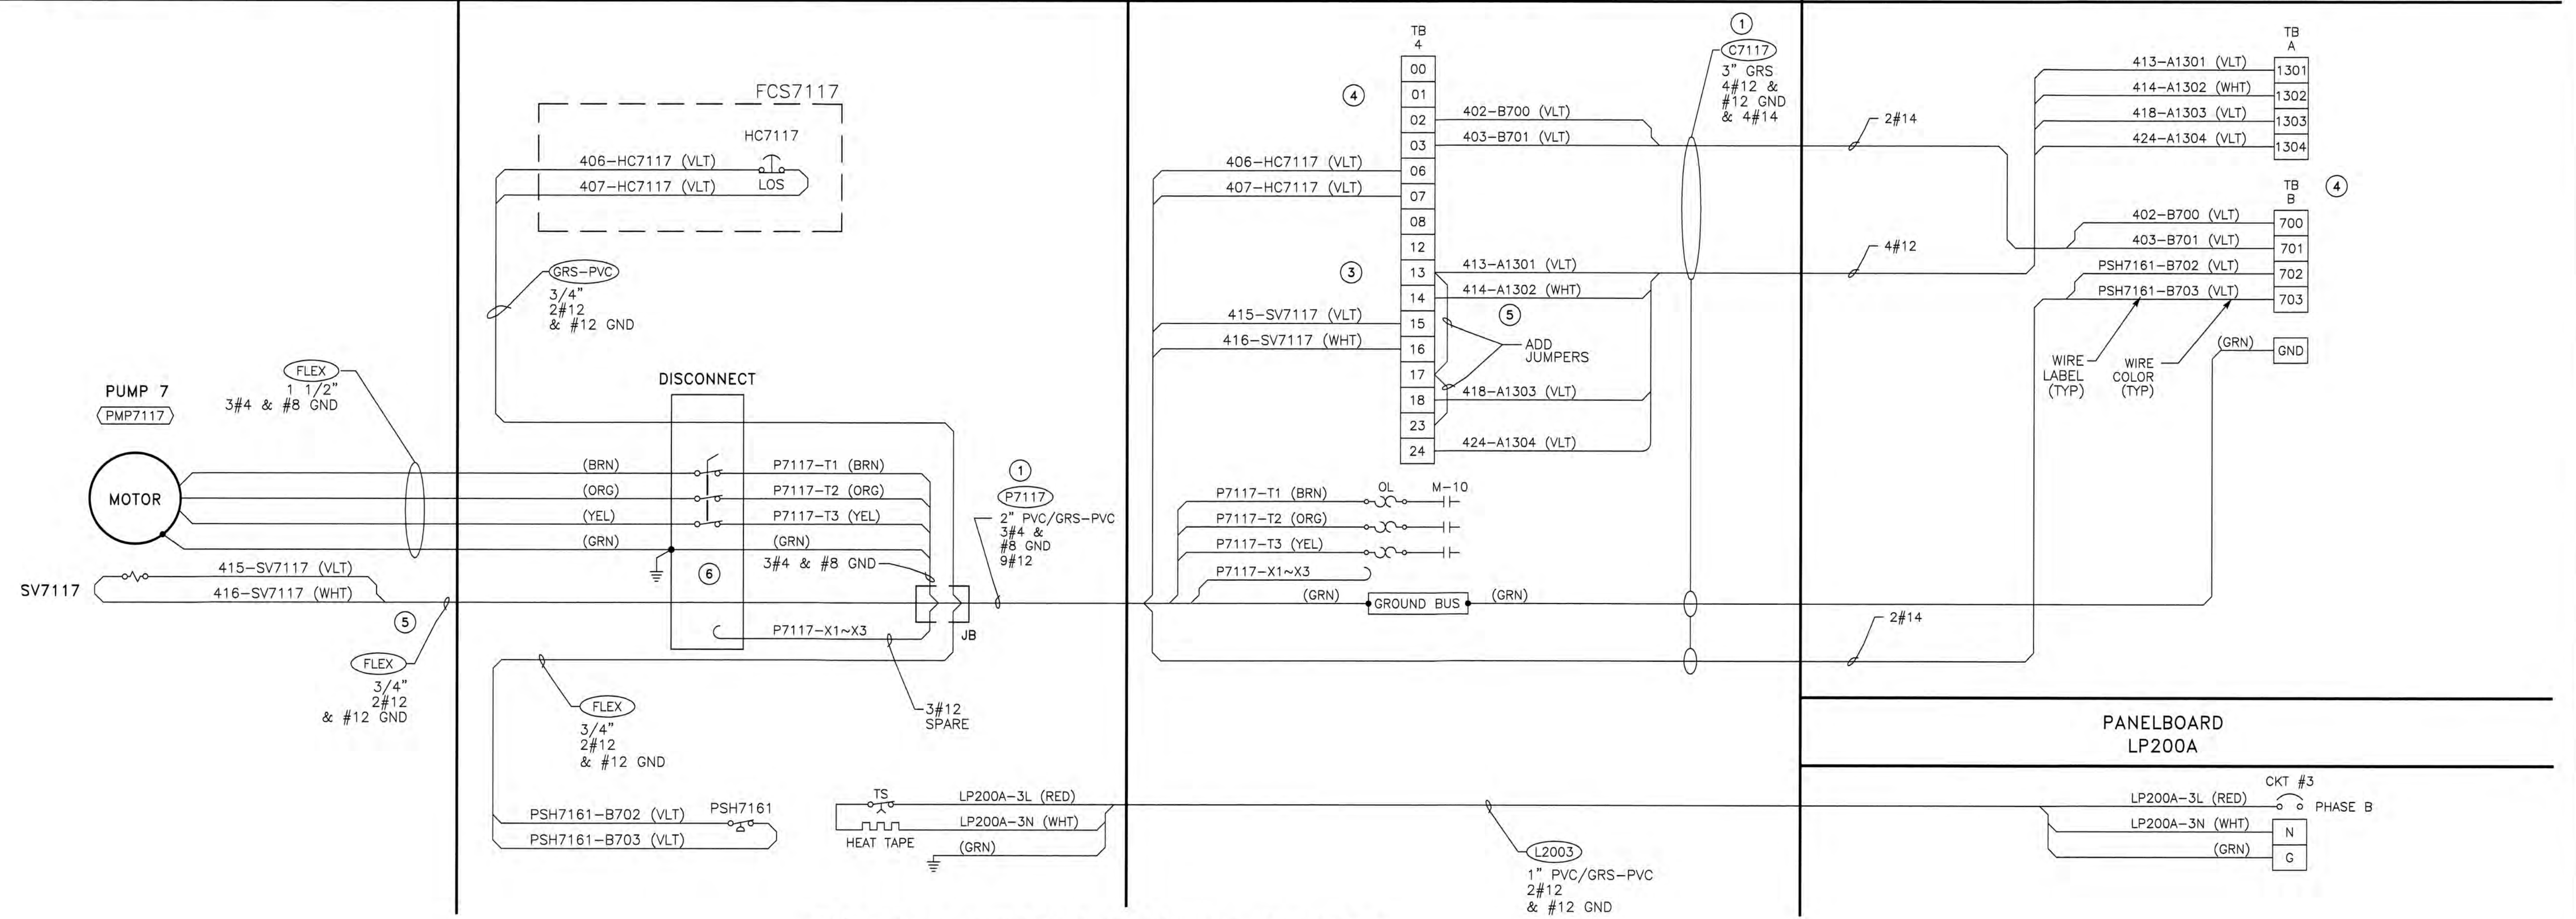

EXAMPLE INTERCONNECTION DIAGRAM

(THIS DRAWING ILLUSTRATES THE FORMAT THAT SHALL BE FOLLOWED IN PREPARATION OF ALL INTERCONNECT DWGS)



REFER TO BID SET FOR SIGNATURE


REV. No.	DESCRIPTION	DATE	BY	APR'D. BY

WEST YOST ASSOCIATES
Consulting Engineers
1260 Lake Boulevard Suite 240 Davis, California 95616
(530) 756-5905 FAX (530) 756-5991


RECORD DRAWINGS
14-Mile Slough Pump Station Upgrades
EXAMPLE INTERCONNECTION DIAGRAM

DEPARTMENT OF MUNICIPAL UTILITIES
CITY OF STOCKTON, CALIFORNIA

SCALE: NONE APPROVED BY: DATE: SHEET No. **E12**
DESIGNED BY: SMK
DRAWN BY: ZK
CHECKED BY: XML
RECORD DWG.: ASSISTANT DIRECTOR, DEPT. OF MUNICIPAL UTILITIES
PROJECT No. 293-00-05-01

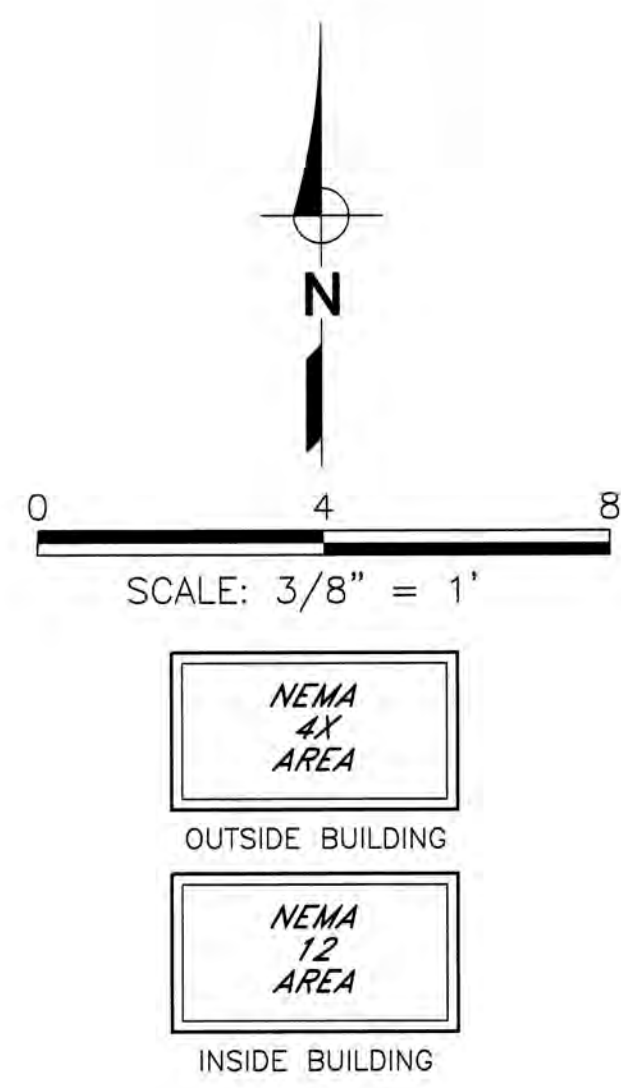

CODE LETTER	FIXTURE TYPE	FINISH	FIXTURE LAMPS	WATTS/FIXTURE	MANUFACTURER OR APPROVED EQUAL	MOUNTING ARRANGEMENT	NOTES
A	FLUORESCENT LUMINAIRE, 4 FT MOLDED FIBERGLASS POLYESTER BODY HIGH IMPACT ACRYLIC LENS	WHITE	32W T8 2 EACH 120 VAC	64	DAY-BRITE VAPORLUME V2HW	SWIVEL CANOPY AND STEMS 10 FT FROM FLOOR	UL LISTED FOR WET LOCATIONS 130' AMBIENT LOW TEMP ELECTRONIC BALLAST
B	SECURITY LIGHT HEAVY DUTY, WEATHERPROOF POWDER COAT FINISH, ALUMINUM CASE	DARK BRONZE	70W HPS 1 EACH 120 VAC	70	DAY-BRITE WALL LIGHT MEDIUM WLM	WALL MOUNT ON BUILDING	WITH PHOTOCELL CONTROL PE (WHERE SHOWN) U.L. LISTED FOR WET LOCATIONS LIGHT SWITCH ENABLE/DISABLE
C	AREA LIGHT RECTANGULAR SHAPE WITH WIRE GUARD SQUARE POLE ARM MOUNTED FIXTURE TYPE 3 DISTRIBUTION	DARK BRONZE	150W HPS 1 EACH MULTI-VOLTAGE	150	LITHONIA KAD-150S	MOUNT ON POLE PER DWG E21 DET C	U.L. LISTED FOR WET LOCATIONS FUSE IN HAND HOLE PHOTOCELL PE
E	EMERGENCY LIGHT PACK WITH INTEGRAL BATTERY CHARGER NEMA 4X ENCLOSURE	GREY	9W TUNGSTEN 2 EACH 12 VOLT	18	MCPHILBEN NX	WALL MOUNT AT 8 FT	EXTERNAL MOUNTING FEET TEST SWITCH NICKEL CADMIUM BATTERIES, 120VAC
X	EXIT LIGHTING WITH NICAD BATTERY STEEL HOUSING, DIRECTION KNOCKOUTS SELF POWERED, GREEN LETTERS	WHITE	LED TYPE 120 VAC	3.8	EMERGI-LITE LWSNX-X14	UNIVERSAL MOUNT	UL LISTED TEST SWITCH

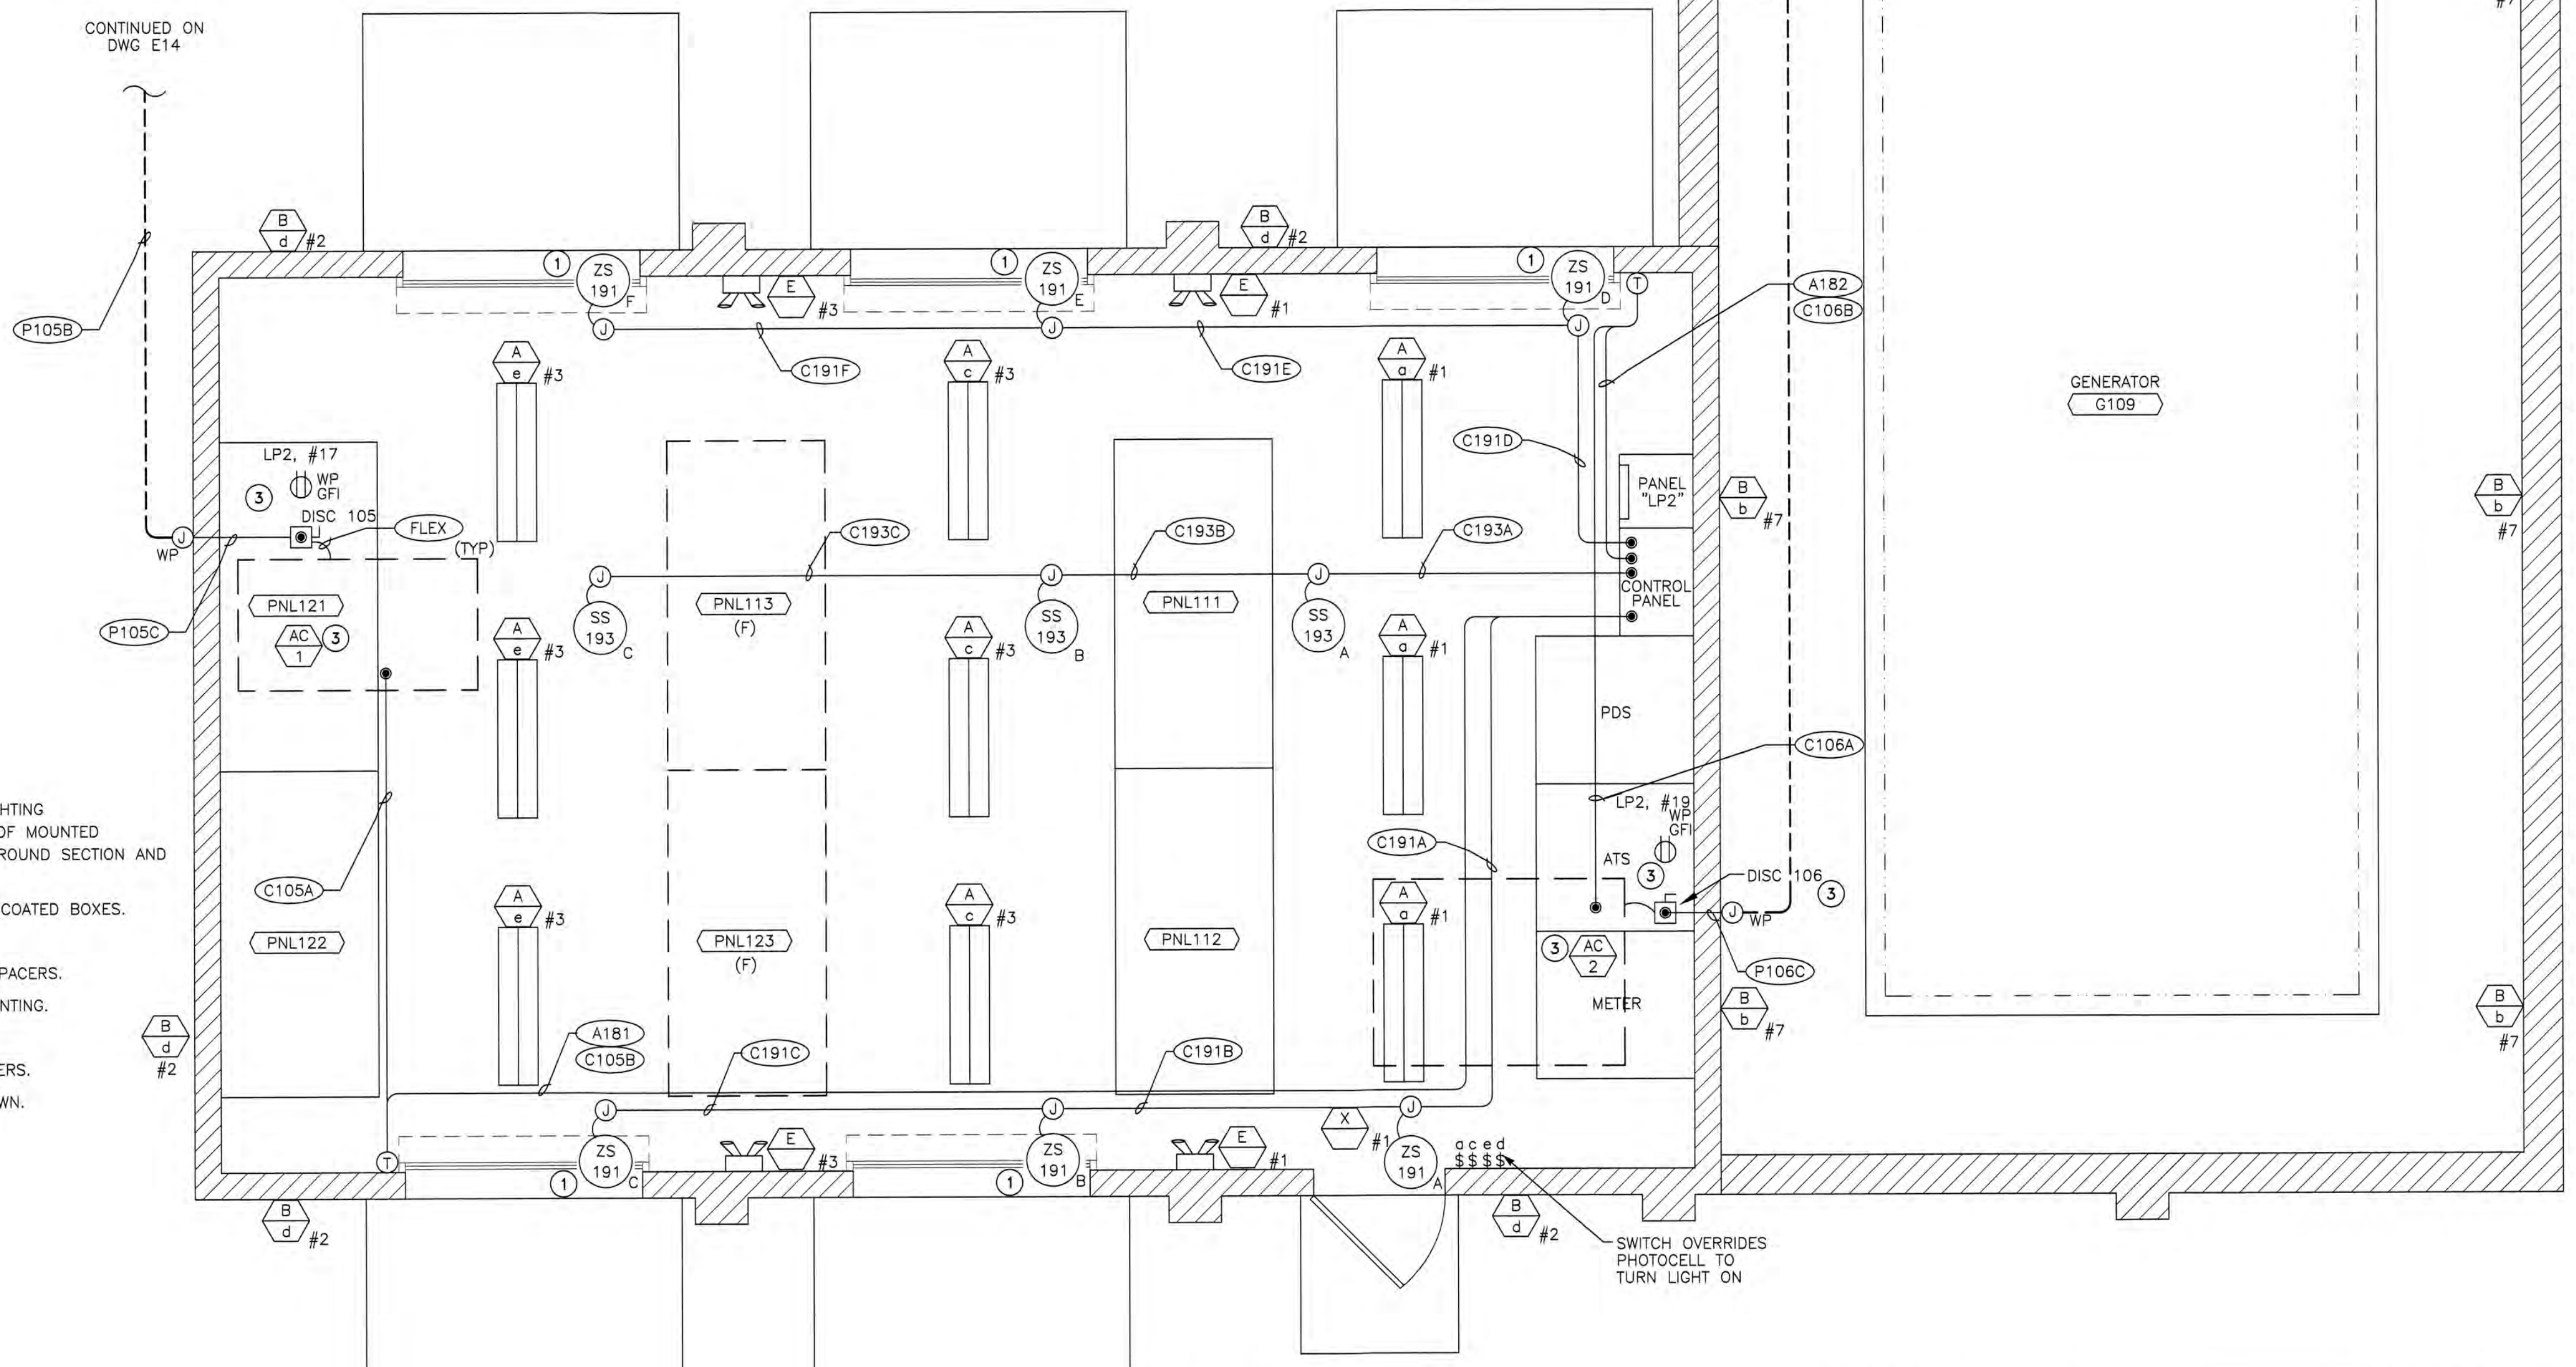

- GENERAL NOTES THAT APPLY TO LIGHTING AND RECEPTACLE PLAN**
1. PROVIDE AND INSTALL NECESSARY WIRES IN SURFACE MOUNT 3/4" (MIN) EMT CONDUIT FOR LIGHTING AND RECEPTACLE ARRANGEMENT AS SHOWN IN NEMA 12 AREAS. IN NEMA 4X AREAS & FOR ROOF MOUNTED RECEPTACLES USE GRS-PVC CONDUITS. IF CONDUITS ARE ROUTED UNDERGROUND, THE UNDERGROUND SECTION AND CONCEALED RISER TO FIRST DEVICE BOX MAY BE PVC-40.
 2. DEVICE BOXES AND CONDUIT BODIES SHALL BE METALLIC. IN NEMA 4X AREAS USE SS OR PVC COATED BOXES.
 3. CONDUCTORS SHALL BE COPPER TYPE THHN, #12 AWG (MINIMUM).
 4. MOUNT INDIVIDUAL CONDUITS USING SINGLE BOLT GALVANIZED PIPE STRAPS AND CLAMP BACK SPACERS.
 5. USE SS EXPANSION WEDGE ANCHORS OR EPOXY ANCHORS AS NECESSARY FOR EQUIPMENT MOUNTING.
 6. PROVIDE AND INSTALL FIXTURES PER SCHEDULE THIS PAGE, QUANTITY AS SHOWN IN DRAWING.
 7. PROVIDE AND INSTALL ALL DEVICE BOXES, JUNCTION BOXES, RECEPTACLES, SWITCHES, AND COVERS.
 8. DEVICES TO BE GROUND FAULT INTERRUPTER (GFI) TYPE AND WEATHERPROOF (WP) WHERE SHOWN.
 9. SEE ELECTRICAL SYMBOLS AND ABBREVIATIONS DRAWING FOR SYMBOL DEFINITION.
 10. ALL WORK SHALL CONFORM TO LOCAL CODES AND 2005 NATIONAL ELECTRIC CODE.
 11. PAINT CONDUITS TO MATCH COLOR OF SURFACE ATTACHED TO.

CONTROL BUILDING ELECTRICAL REFLECTIVE PLAN ②

- NOTES: ① MOUNT INTRUSION SWITCH AT THE BOTTOM OF ROLL-UP DOOR.
 ② CIRCUITS SHOWN ARE POWERED FROM PANEL "LP2".
 ③ LOCATED ON ROOF.



REFER TO BID SET FOR SIGNATURE

REV. No.	DISCRPTION	DATE	BY	Apr'd By
1				
2				
3				
4				
5				
6				

WEST YOST ASSOCIATES
 Consulting Engineers
 1260 Lake Boulevard
 Suite 240
 Davis, California 95616
 (530) 756-5905
 FAX (530) 756-5991




RECORD DRAWINGS
14-Mile Slough Pump Station Upgrades
CONTROL BUILDING ELECTRICAL REFLECTIVE PLAN

DEPARTMENT OF MUNICIPAL UTILITIES
 CITY OF STOCKTON, CALIFORNIA

SCALE: 3/8" = 1'
 DESIGNED BY: SMK
 DRAWN BY: ZK
 CHECKED BY: XML
 RECORD DWG.:

APPROVED BY: DATE: _____
 ASSISTANT DIRECTOR,
 DEPT. OF MUNICIPAL UTILITIES

SHEET No. **E13A**
 70 of 89 SHEETS
 PROJECT No. 293-00-05-01

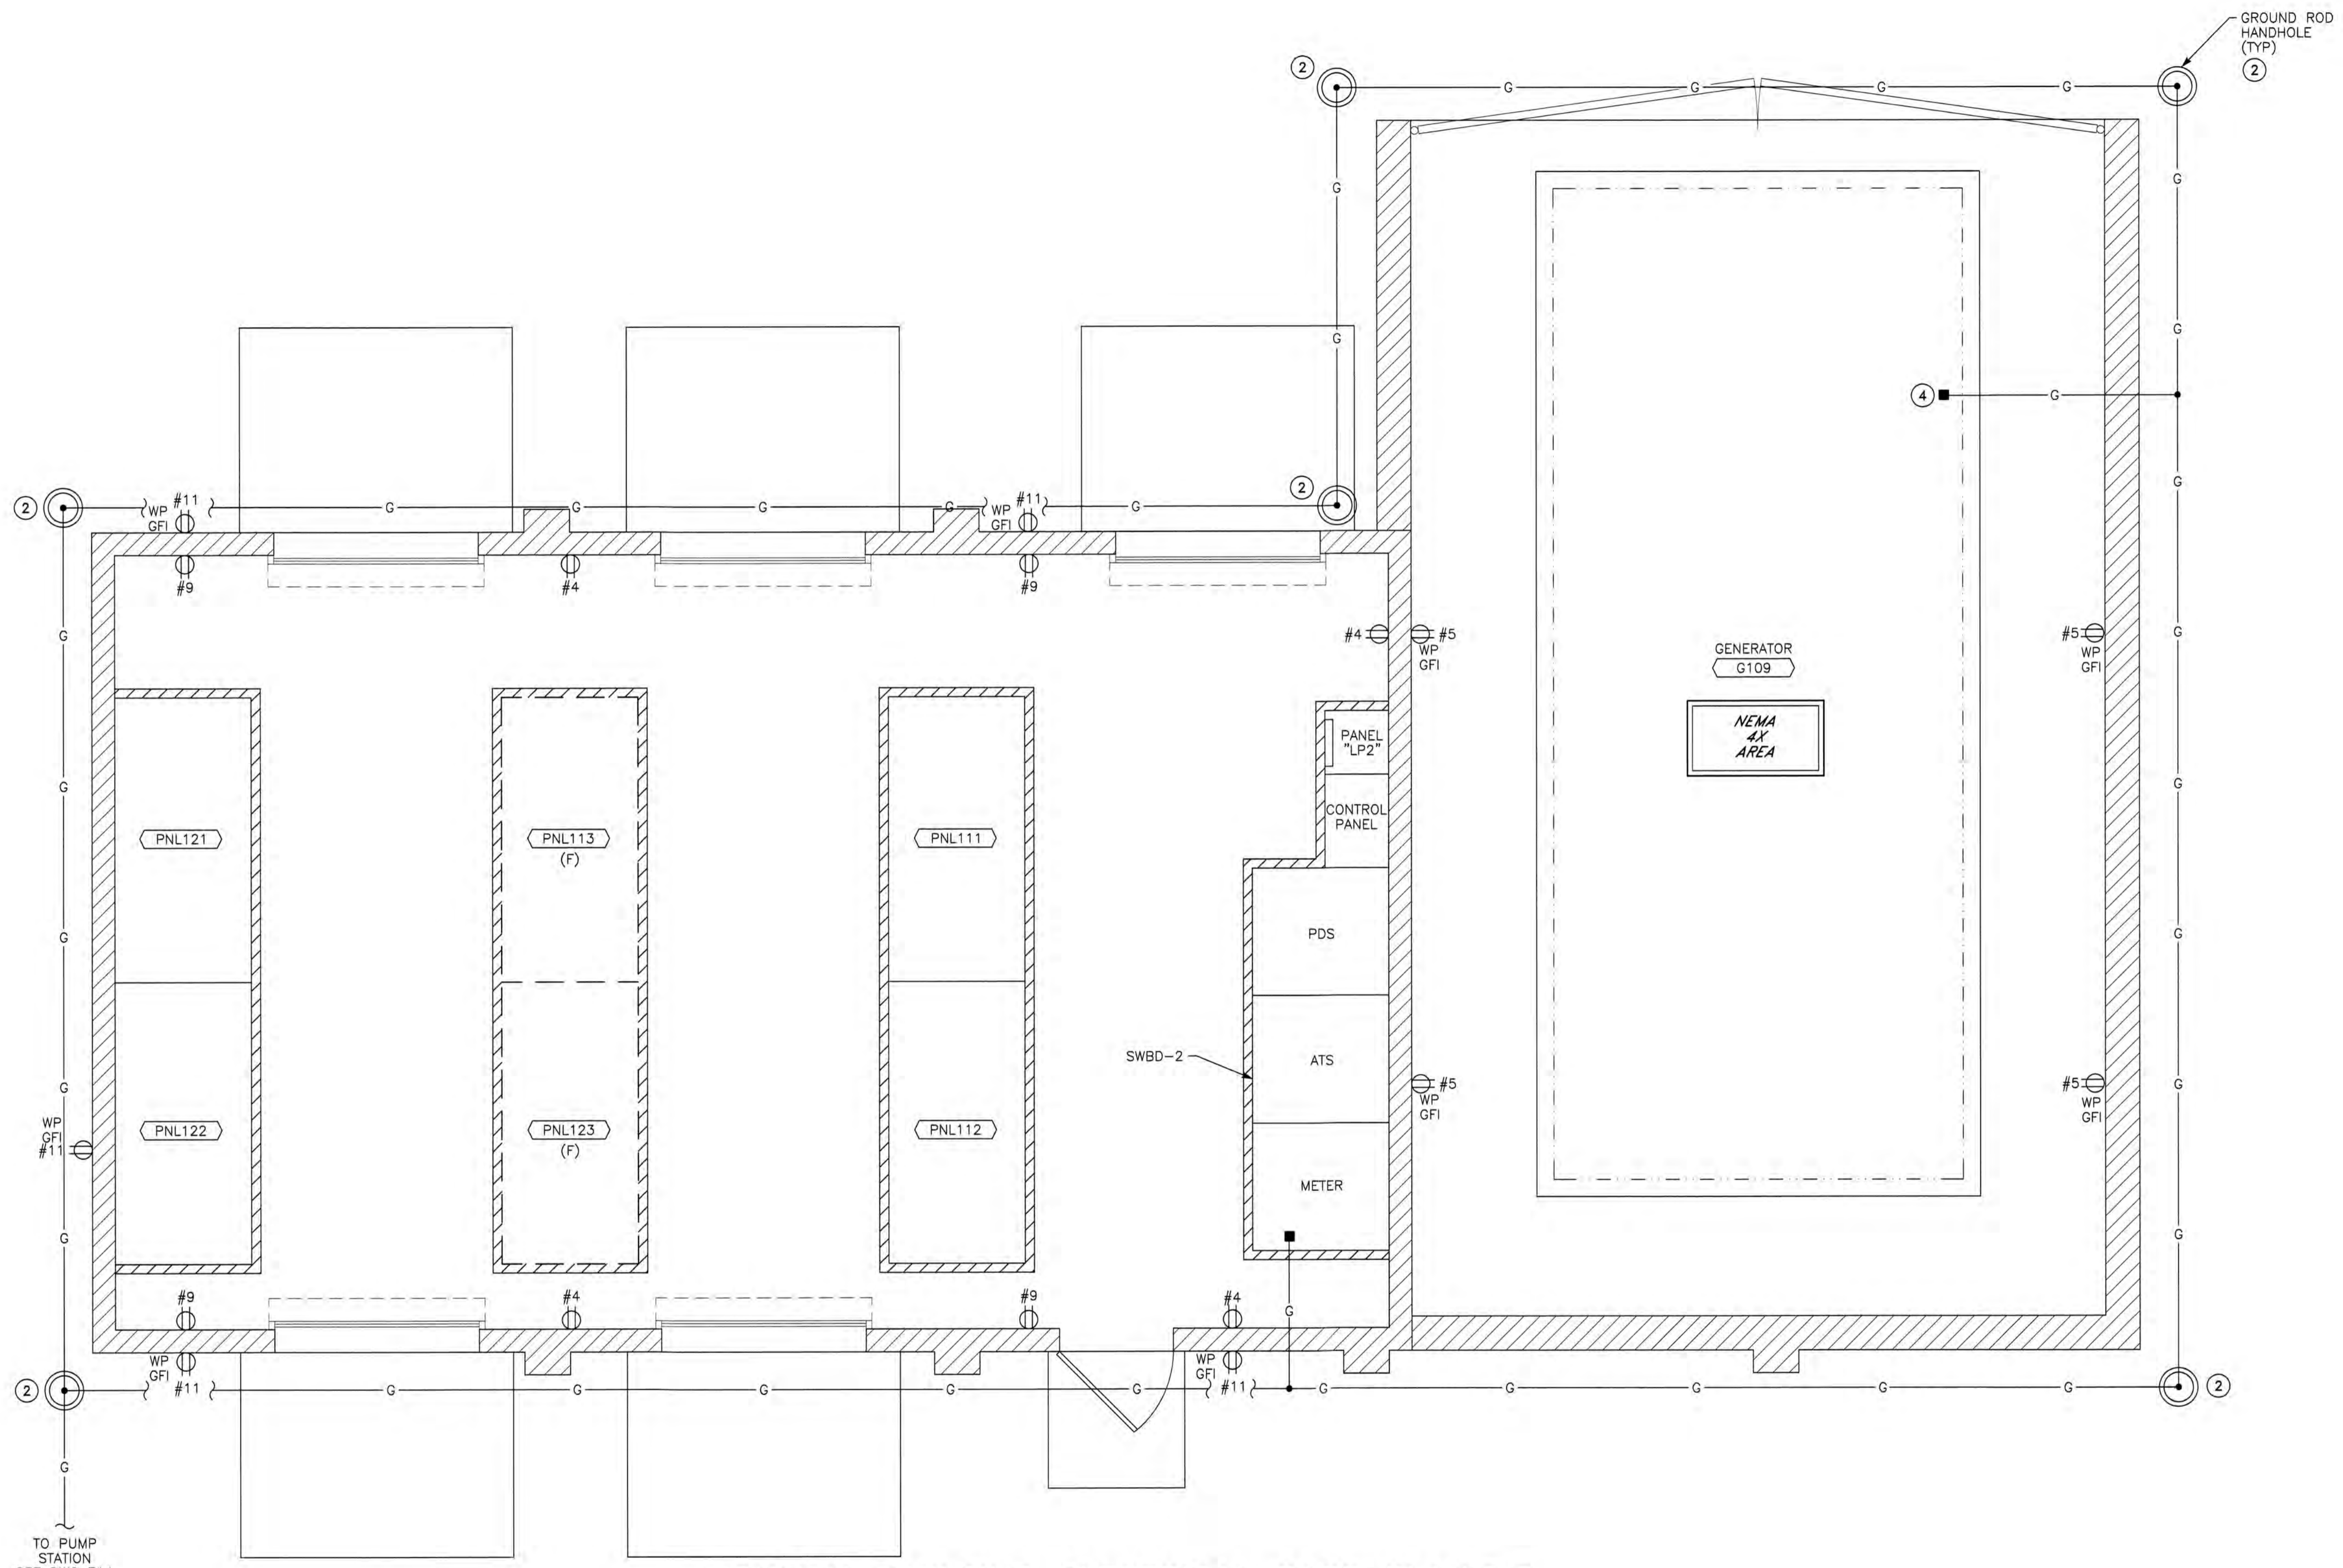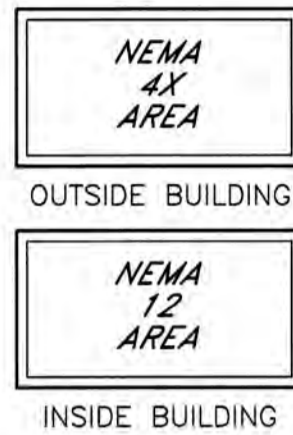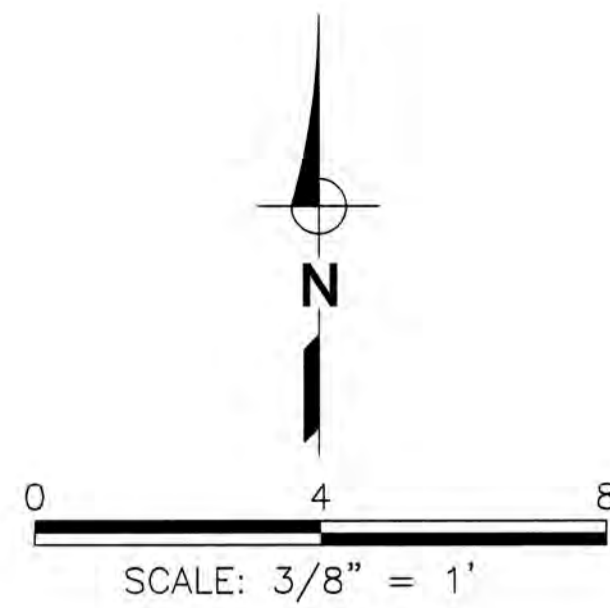

CONTROL BUILDING ELECTRICAL BASE PLAN ① ③

- NOTES: ① SEE DWG E13A FOR CONDUIT & WIRE INSTALLATION REQUIREMENTS. CIRCUITS SHOWN ARE FED FROM PANEL "LP2".
- ② GROUND RING & GROUND BONDS TO CONSIST OF #2/0 BARE COPPER WITH 30" MINIMUM COVER. INSTALL GROUND ROD HANDHOLE PER DWG E23, DETAIL "E".
- ③ HOUSEKEEPING CONCRETE PAD PER DWG E21, DETAIL "A".
- ④ BOLT GROUND TO EQUIPMENT METAL FRAME WITH U.L. APPROVED GROUND CLAMPS.



Underground Service Alert




 TWO DAYS BEFORE YOU DIG
 Call TOLL FREE: 1-800-642-2444

REFER TO SET FOR SIGNATURE


REV. No.	DISCRPTION	DATE	BY	Apr'd By
1				
2				
3				
4				
5				
6				

WEST YOST ASSOCIATES
 Consulting Engineers
 1260 Lake Boulevard
 Suite 240
 Davis, California 95616
 (530) 756-5905
 FAX (530) 756-5991

RECORD DRAWINGS		
14-Mile Slough Pump Station Upgrades		
CONTROL BUILDING ELECTRICAL BASE PLAN		
DEPARTMENT OF MUNICIPAL UTILITIES CITY OF STOCKTON, CALIFORNIA		
SCALE: 3/8" = 1'	APPROVED BY: DATE: _____	SHEET No.
DESIGNED BY: SMK		E13B
DRAWN BY: ZK		71 of 89 SHEETS
CHECKED BY: XML		PROJECT No. 293-00-05-01
RECORD Dwg.:	ASSISTANT DIRECTOR, DEPT. OF MUNICIPAL UTILITIES	

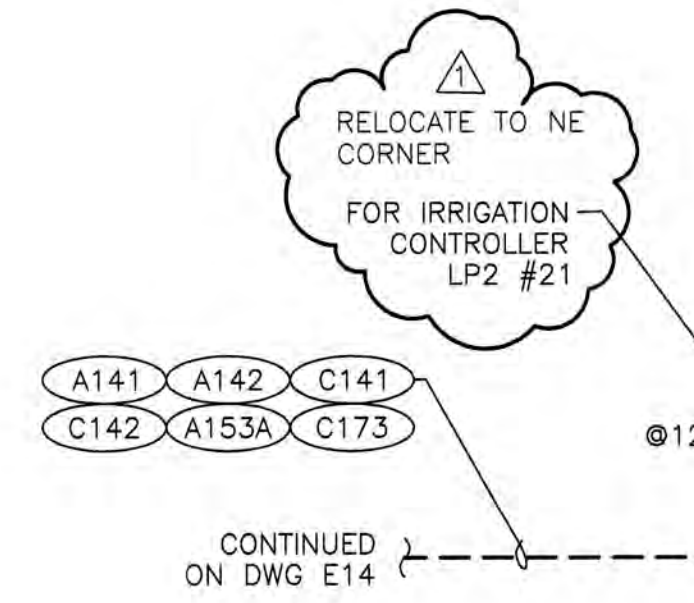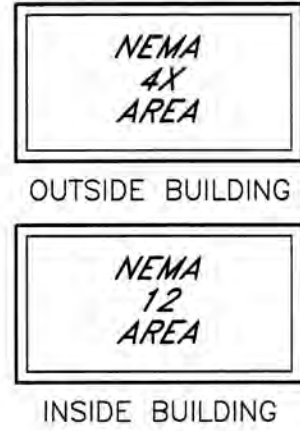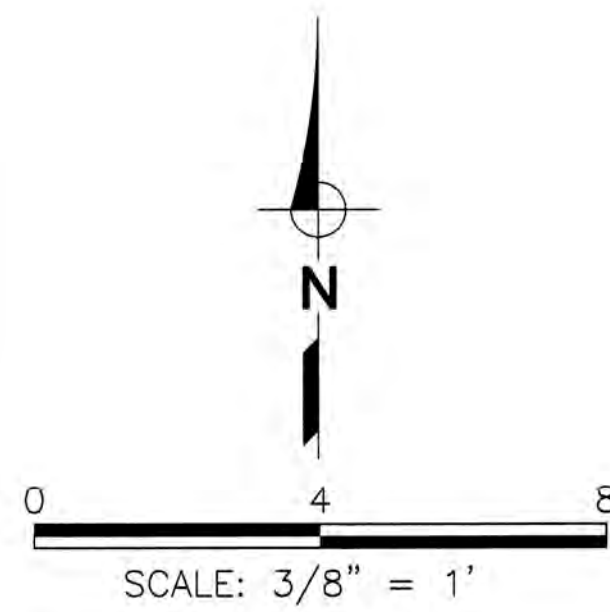

- NOTES:
- ① EXPOSED CONDUIT TRANSITIONS PER DWG E23, DETAIL "G".
 - ② CONDUITS UNDER BUILDING TO BE PLACED IN CONCRETE SLURRY.
 - ③ CAP "P" CONDUIT FLUSH WITH SURFACE. CAP "A" & "C" CONDUITS 3" ABOVE BASE.
 - ④ BUS DUCT TO BE SUPPLIED BY CONTRACTOR THAT MATES TO TRANSFORMER & SERVICE SWITCHBOARD, DIMENSIONS DETERMINED BY PG&E ENGINEERED DWGS.
 - ⑤ PLACE A WATERTIGHT SEAL AROUND BUS DUCT WHERE IT PENETRATES THE WALL.
 - ⑥ STUB-UP CONDUITS AT LOCATIONS RECOMMENDED BY GENERATOR MANUFACTURER.
 - ⑦ GEN BATTERY CHARGER LP #22. GEN BLOCK HEATER LP #18,20.
 - ⑧ CONTRACTOR TO COORDINATE WITH SYSTEM SUPPLIER TO STUB-UP CONDUITS BELOW VFD/SS PANELS.
 - ⑨ LEVEL SWITCHES LOCATED IN SUB-BASE FUEL TANK.

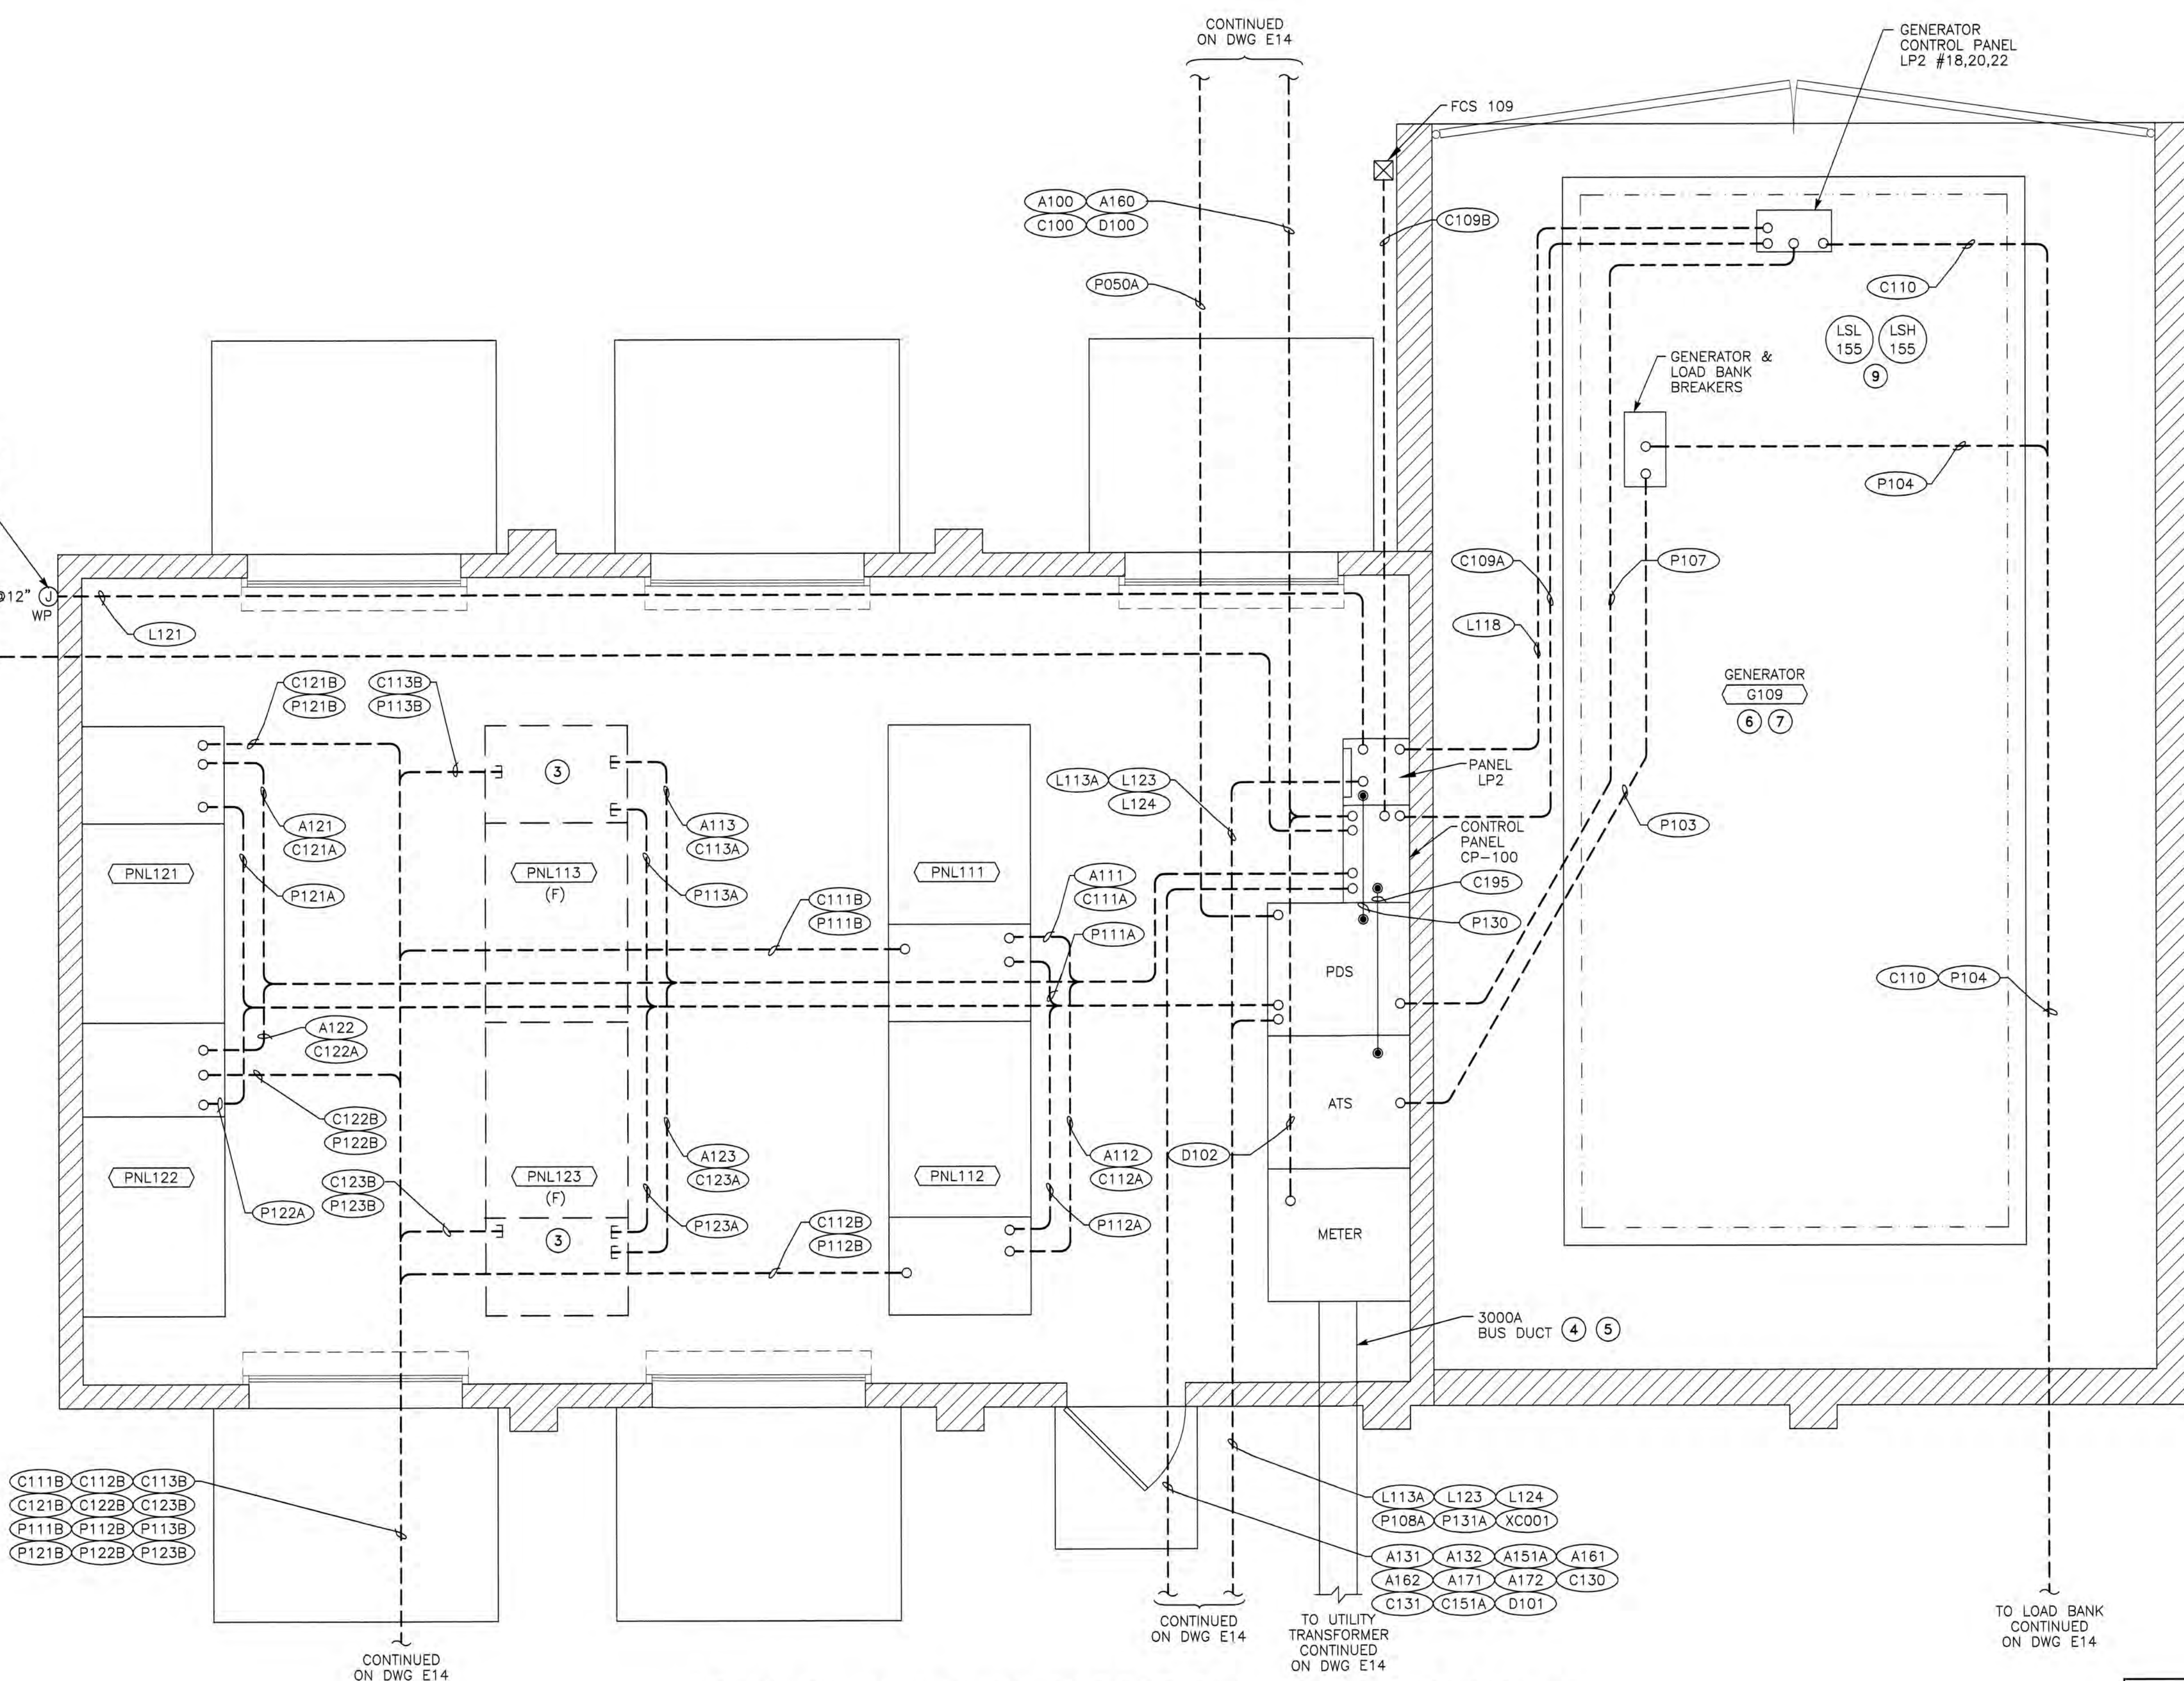

CONTROL BUILDING ELECTRICAL POWER PLAN ①②



Underground Service Alert

TWO DAYS BEFORE YOU DIG

Call TOLL FREE: 1-800-642-2444

REFER TO BID SET FOR SIGNATURE

REV. No.	DISCRIPTION	DATE	BY	Apr'd By
1	RECORD DRAWINGS	8/08	OS	
2				
3				
4				
5				
6				
7				



WEST YOST ASSOCIATES
Consulting Engineers

1260 Lake Boulevard
Suite 240
Davis, California 95616
(530) 756-5905
FAX (530) 756-5991

RECORD DRAWINGS
14-Mile Slough Pump Station Upgrades
CONTROL BUILDING ELECTRICAL POWER PLAN

DEPARTMENT OF MUNICIPAL UTILITIES
CITY OF STOCKTON, CALIFORNIA

SCALE: NONE	APPROVED BY: DATE: _____	SHEET No. E13C
DESIGNED BY: SMK		72 of 89 SHEETS
DRAWN BY: ZK		PROJECT No. 293-00-05-01
CHECKED BY: XML	ASSISTANT DIRECTOR, DEPT. OF MUNICIPAL UTILITIES	
RECORD Dwg.:		

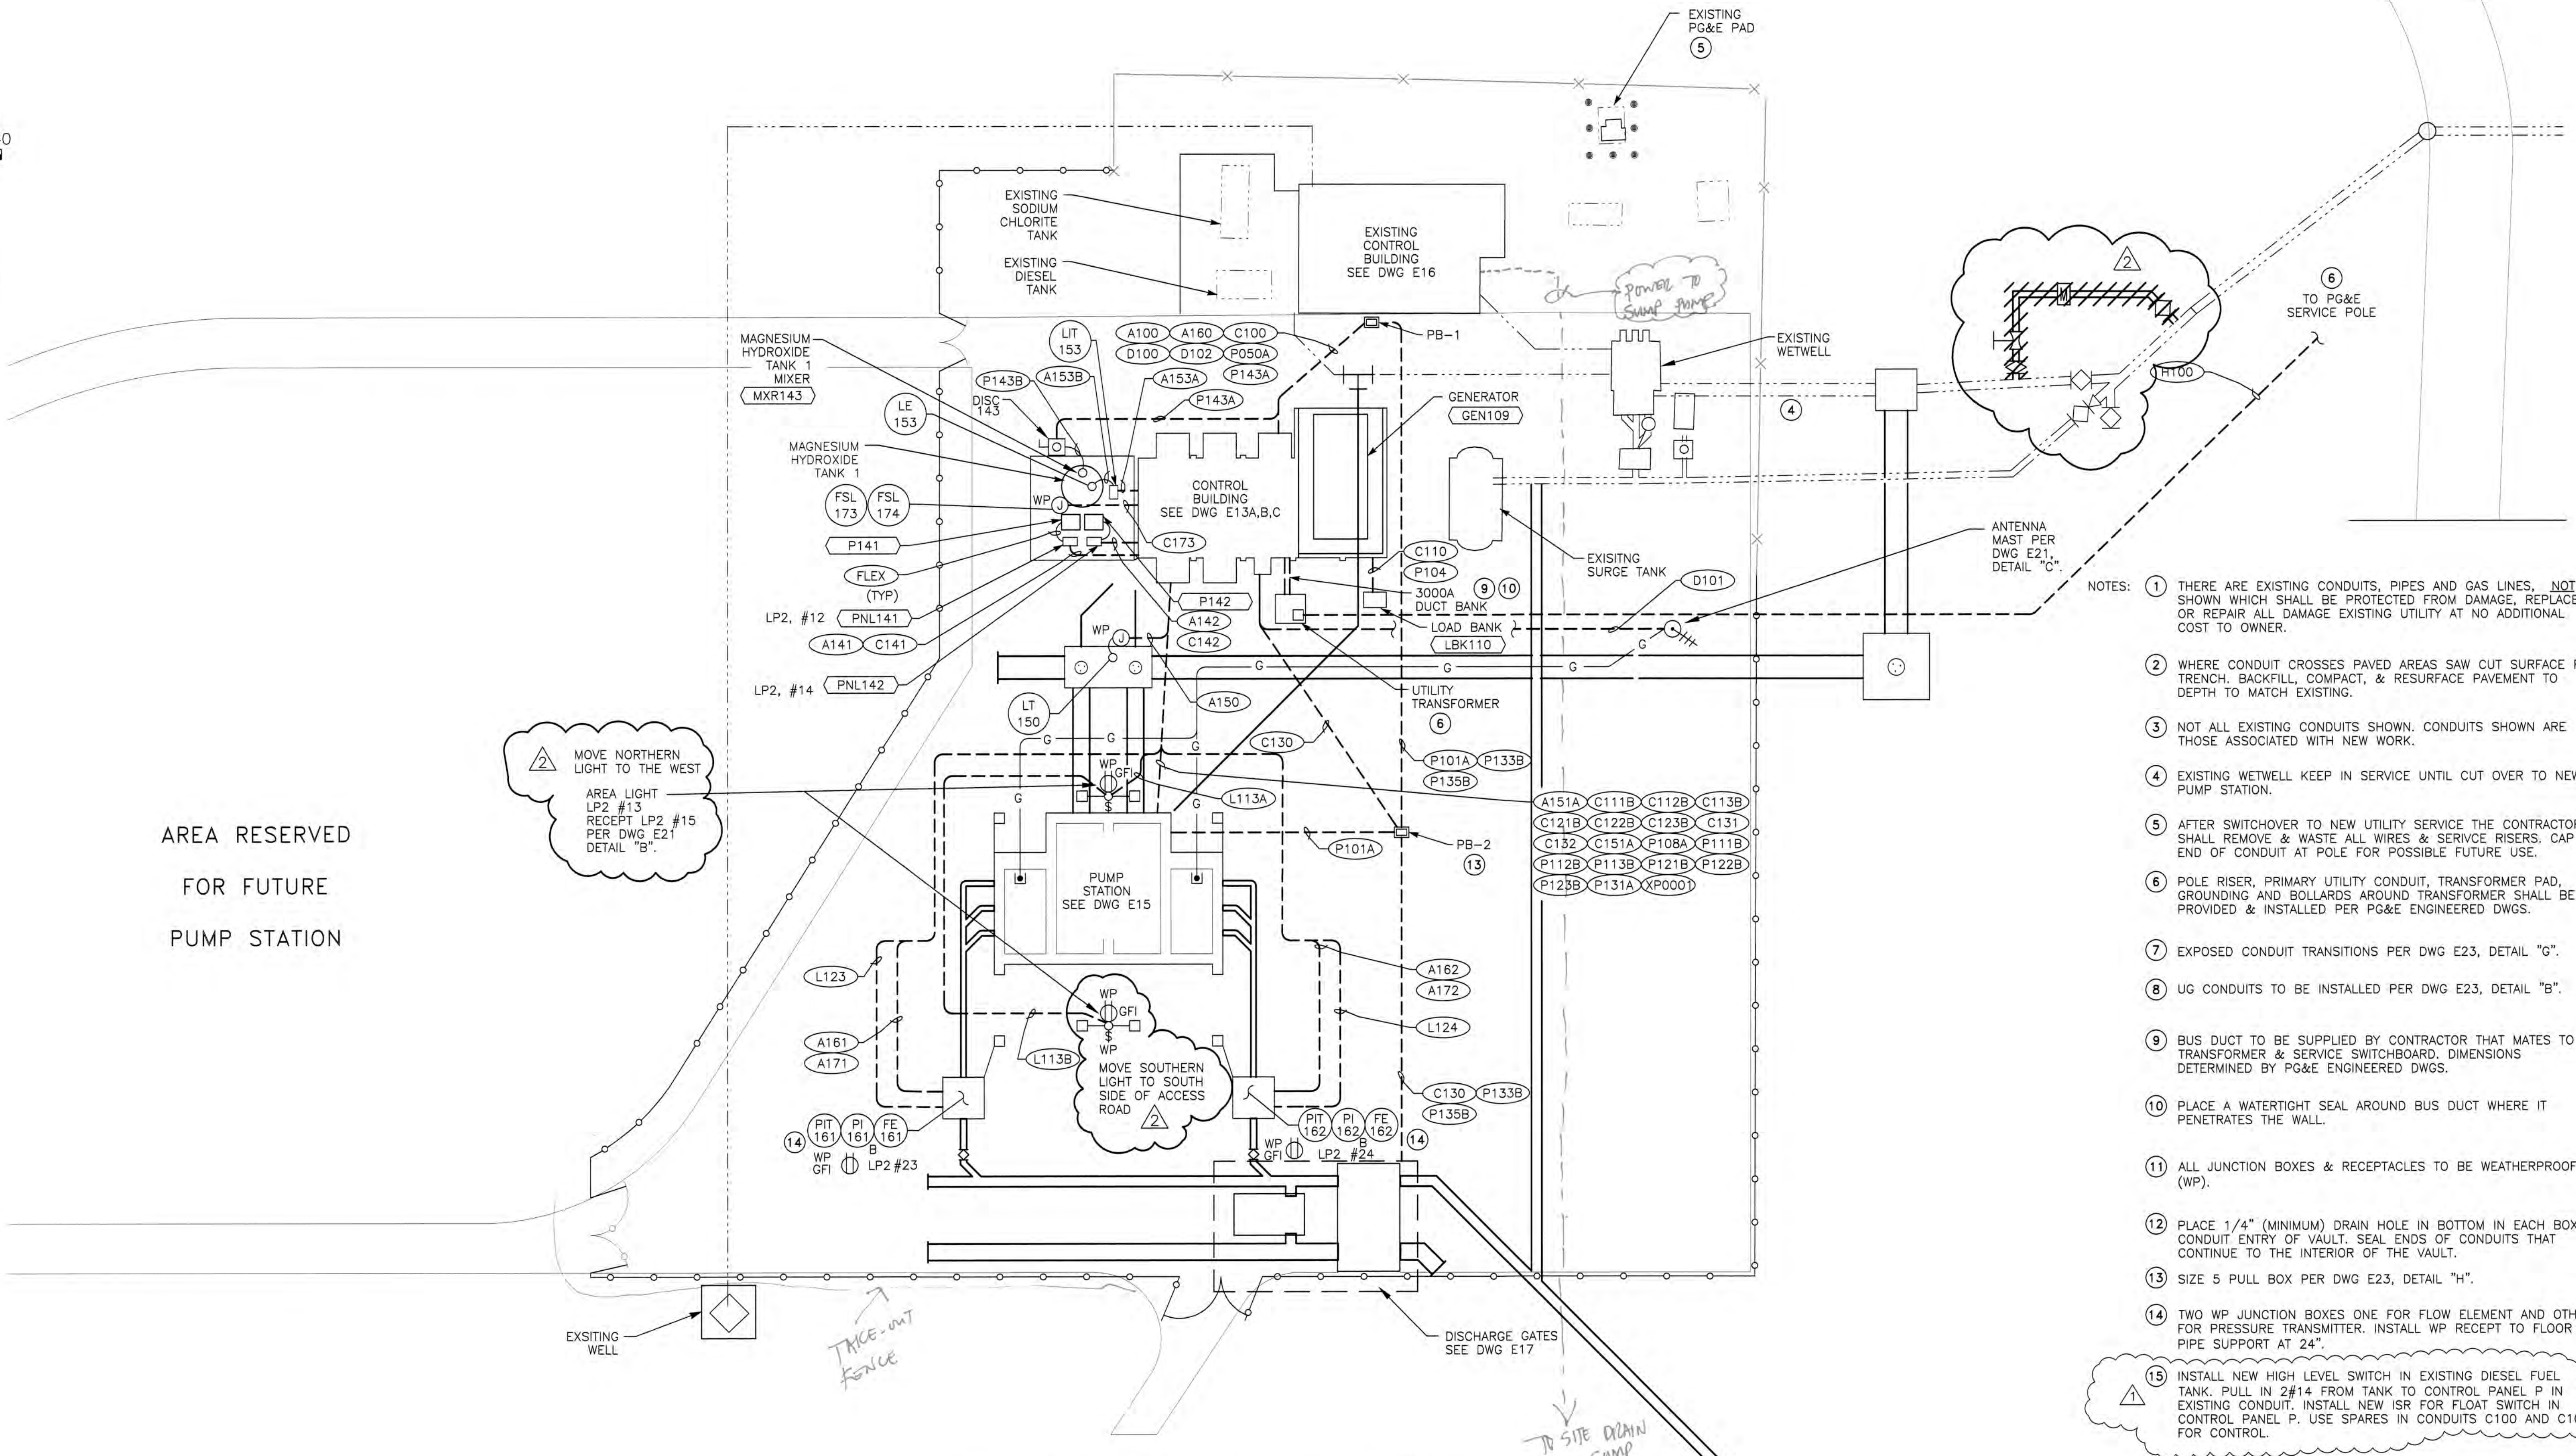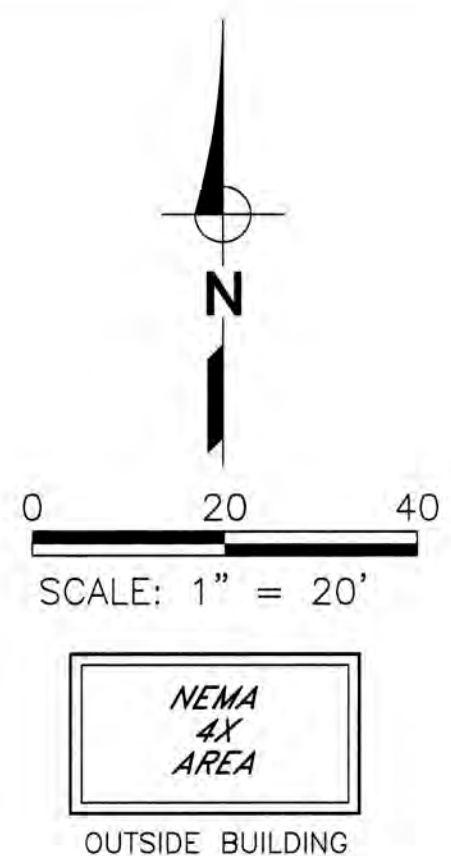

- NOTES:
- 1 THERE ARE EXISTING CONDUITS, PIPES AND GAS LINES, NOT SHOWN WHICH SHALL BE PROTECTED FROM DAMAGE, REPLACE OR REPAIR ALL DAMAGE EXISTING UTILITY AT NO ADDITIONAL COST TO OWNER.
 - 2 WHERE CONDUIT CROSSES PAVED AREAS SAW CUT SURFACE FOR TRENCH, BACKFILL, COMPACT, & RESURFACE PAVEMENT TO DEPTH TO MATCH EXISTING.
 - 3 NOT ALL EXISTING CONDUITS SHOWN. CONDUITS SHOWN ARE THOSE ASSOCIATED WITH NEW WORK.
 - 4 EXISTING WETWELL KEEP IN SERVICE UNTIL CUT OVER TO NEW PUMP STATION.
 - 5 AFTER SWITCHOVER TO NEW UTILITY SERVICE THE CONTRACTOR SHALL REMOVE & WASTE ALL WIRES & SERVICE RISERS, CAP END OF CONDUIT AT POLE FOR POSSIBLE FUTURE USE.
 - 6 POLE RISER, PRIMARY UTILITY CONDUIT, TRANSFORMER PAD, GROUNDING AND BOLLARDS AROUND TRANSFORMER SHALL BE PROVIDED & INSTALLED PER PG&E ENGINEERED DWGS.
 - 7 EXPOSED CONDUIT TRANSITIONS PER DWG E23, DETAIL "G".
 - 8 UG CONDUITS TO BE INSTALLED PER DWG E23, DETAIL "B".
 - 9 BUS DUCT TO BE SUPPLIED BY CONTRACTOR THAT MATES TO TRANSFORMER & SERVICE SWITCHBOARD. DIMENSIONS DETERMINED BY PG&E ENGINEERED DWGS.
 - 10 PLACE A WATERTIGHT SEAL AROUND BUS DUCT WHERE IT PENETRATES THE WALL.
 - 11 ALL JUNCTION BOXES & RECEPTACLES TO BE WEATHERPROOF (WP).
 - 12 PLACE 1/4" (MINIMUM) DRAIN HOLE IN BOTTOM IN EACH BOX AT CONDUIT ENTRY OF VAULT. SEAL ENDS OF CONDUITS THAT CONTINUE TO THE INTERIOR OF THE VAULT.
 - 13 SIZE 5 PULL BOX PER DWG E23, DETAIL "H".
 - 14 TWO WP JUNCTION BOXES ONE FOR FLOW ELEMENT AND OTHER FOR PRESSURE TRANSMITTER. INSTALL WP RECEPT TO FLOOR PIPE SUPPORT AT 24".
 - 15 INSTALL NEW HIGH LEVEL SWITCH IN EXISTING DIESEL FUEL TANK. PULL IN 2#14 FROM TANK TO CONTROL PANEL P IN EXISTING CONDUIT. INSTALL NEW ISR FOR FLOAT SWITCH IN CONTROL PANEL P. USE SPARES IN CONDUITS C100 AND C109A FOR CONTROL.

OVERALL ELECTRICAL SITE PLAN ① ② ③ ⑦ ⑧ ⑪ ⑫ ⑮





REFER TO SET FOR SIGNATURE

REV. No.	DISCRPTION	DATE	BY	App'd By
ADDENDUM NO.2		5/06	SK	PF
RECORD DRAWINGS		6/08	CLB	PDF

WEST YOST ASSOCIATES
 Consulting Engineers
 1260 Lake Boulevard
 Suite 240
 Davis, California 95616
 (530) 756-5905
 FAX (530) 756-5991

RECORD DRAWINGS		
14-Mile Slough Pump Station Upgrades		
OVERALL ELECTRICAL SITE PLAN		
DEPARTMENT OF MUNICIPAL UTILITIES CITY OF STOCKTON, CALIFORNIA		
SCALE: 1" = 20'	APPROVED BY: DATE:	SHEET No.
DESIGNED BY: SMK		E14
DRAWN BY: ZK		73 of 89 SHEETS
CHECKED BY: XML	ASSISTANT DIRECTOR, DEPT. OF MUNICIPAL UTILITIES	PROJECT No. 293-00-05-01
RECORD DWG.:		

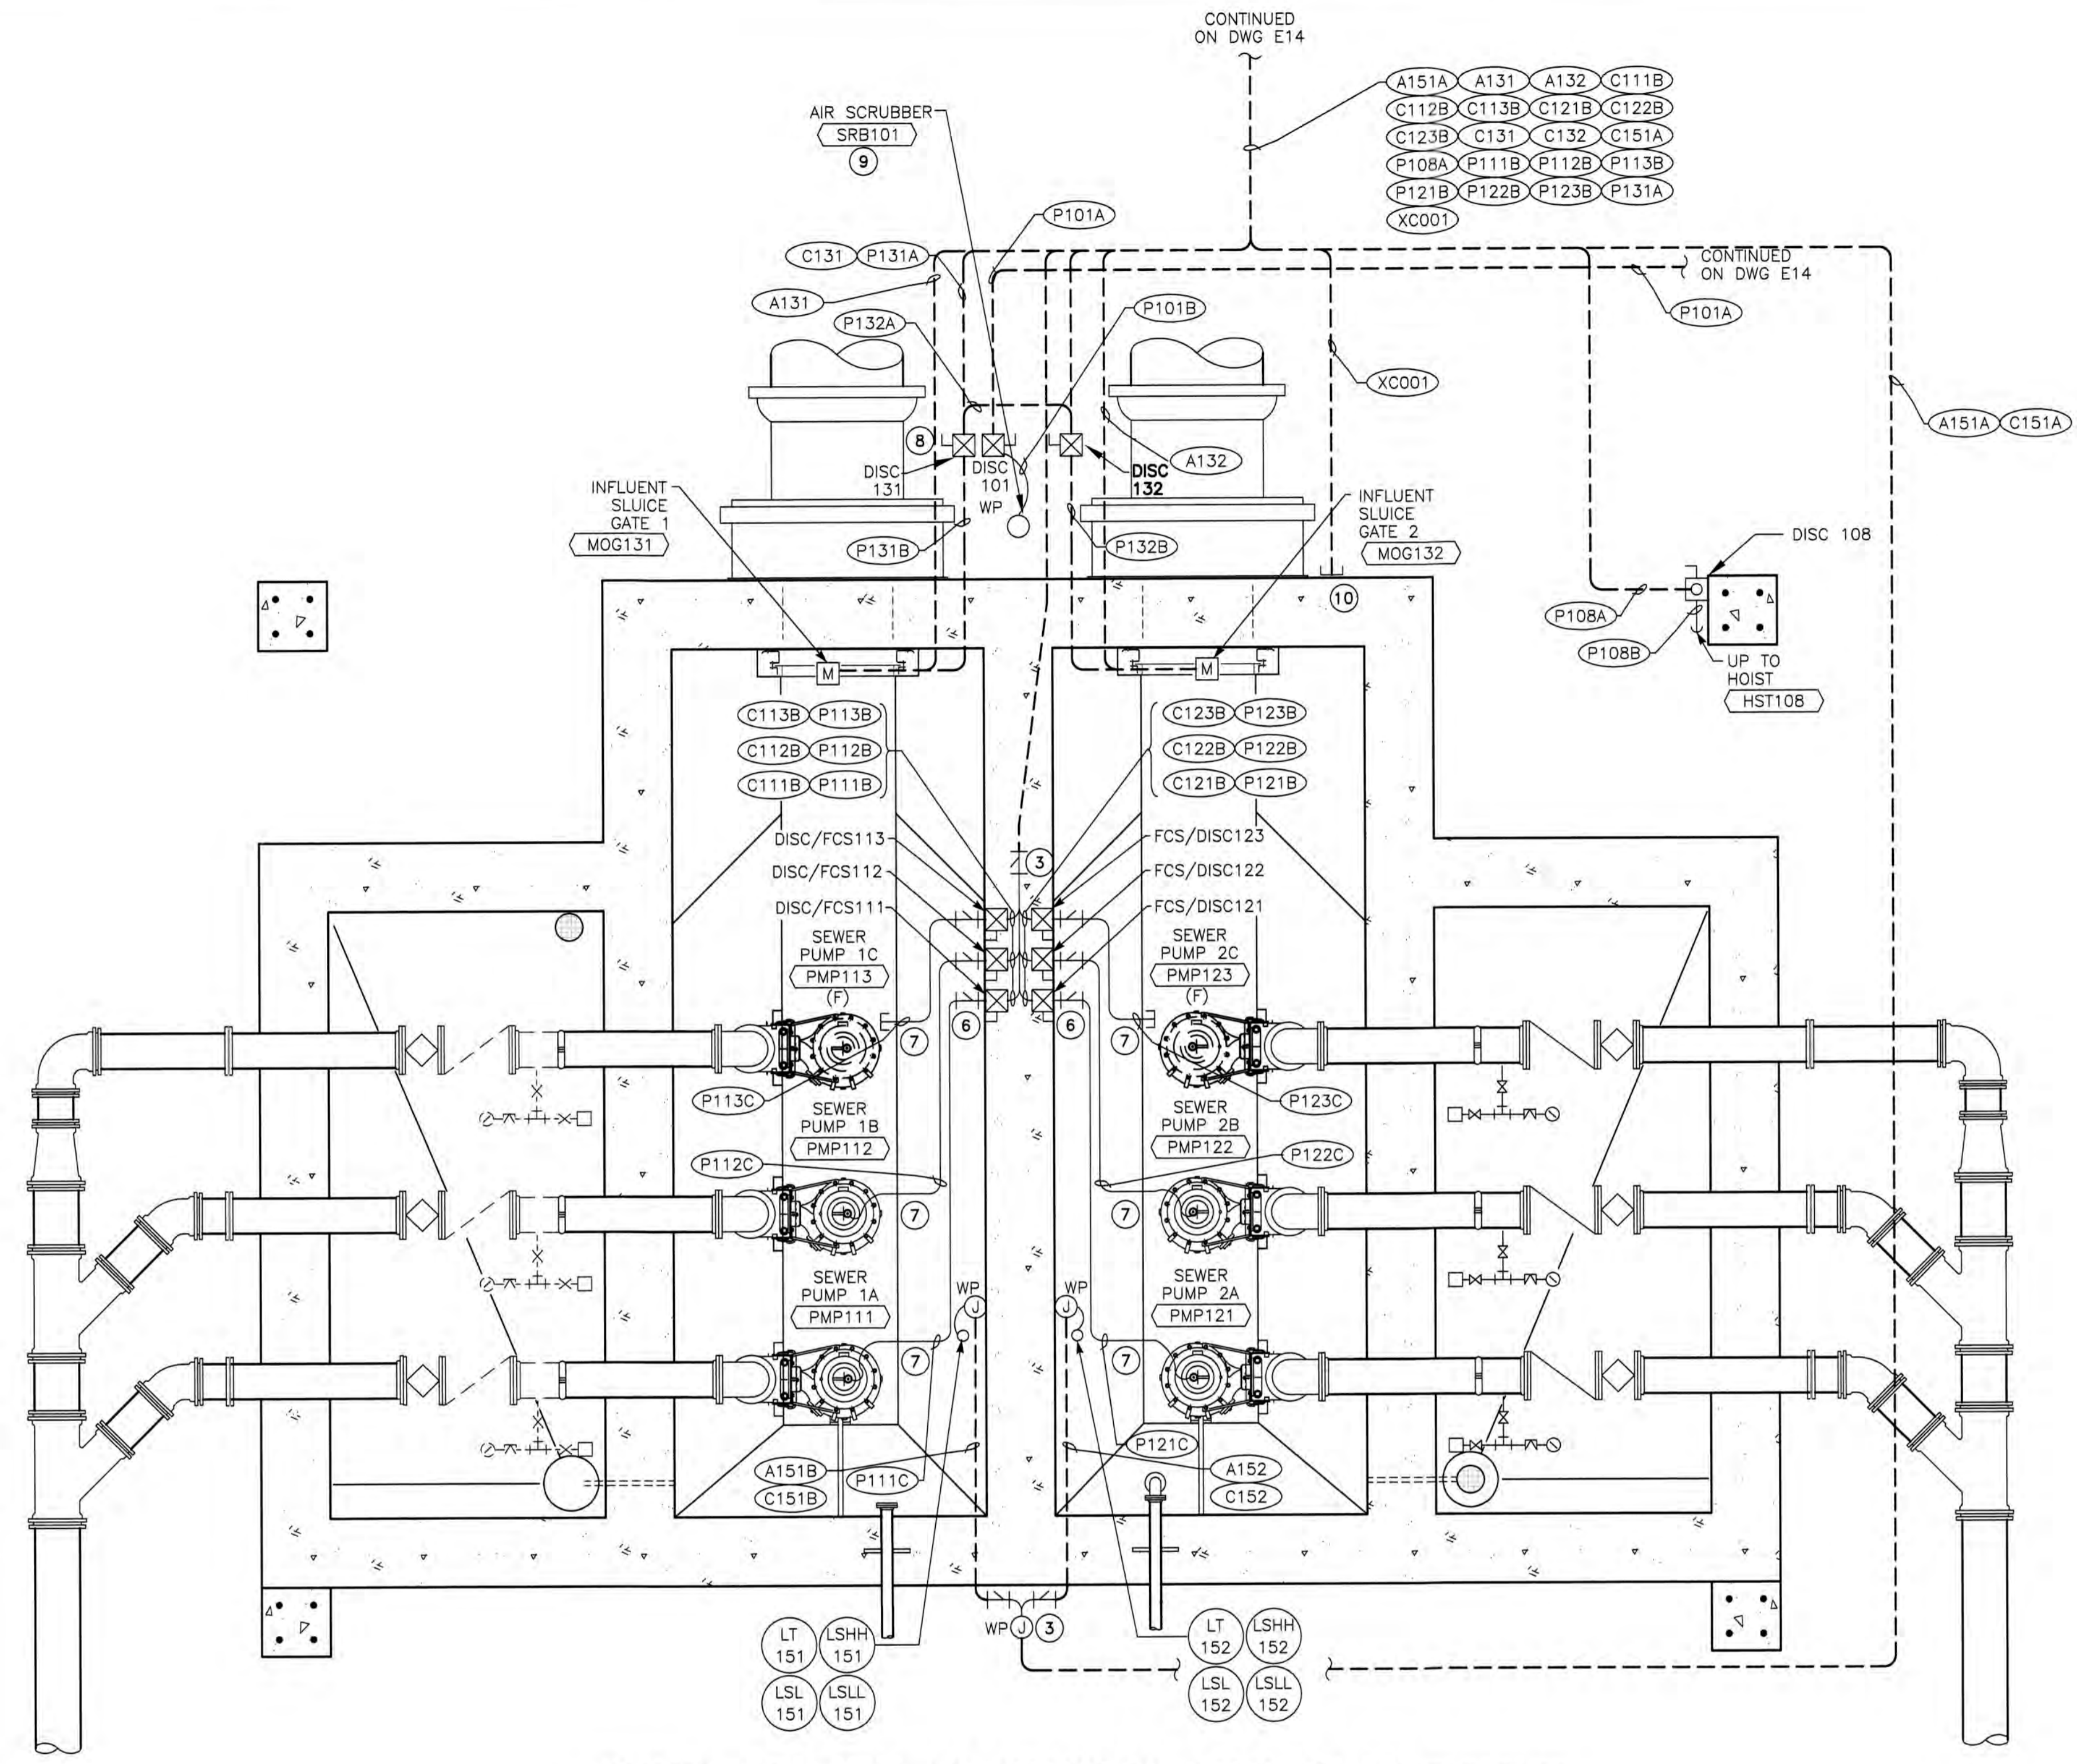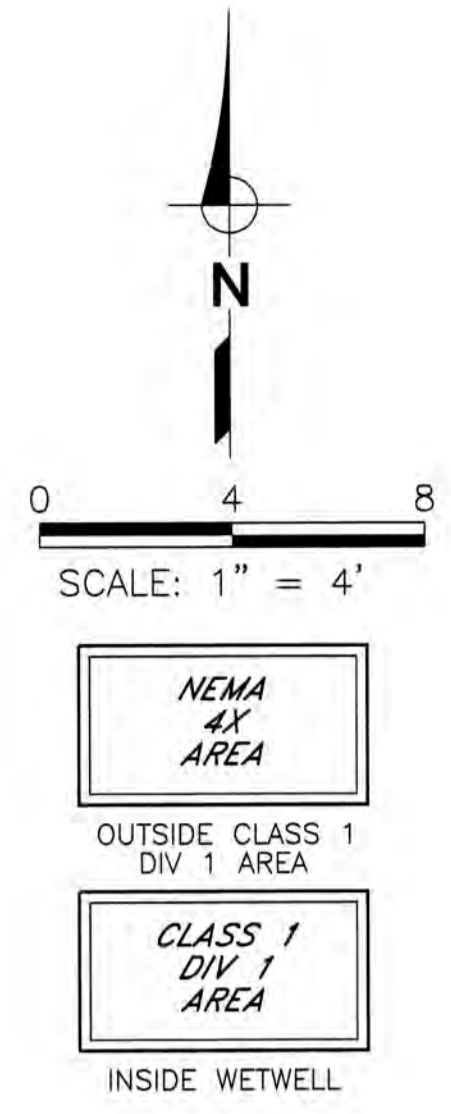

PUMP STATION ELECTRICAL SITE PLAN ①②④⑤

- NOTES:
- ① UG CONDUITS TO BE INSTALLED PER DWG E23, DETAIL "B".
 - ② EXPOSED CONDUIT TRANSITIONS PER DWG E23, DETAIL "G".
 - ③ PLACE "EYS" TYPE EXPLOSION-PROOF BARRIER AT EACH TRANSITION OF DISCONNECT UG THAT GOES TO MCC. FILL WITH CHICO COMPOUND CROUSE-HINDS SERIES EYS OR EQUAL. LOCATE "EYS" BELOW DISCONNECT SWITCH.
 - ④ ALL JUNCTION BOXES, SWITCHES, RECEPTACLES, DISCONNECT, & FIELD CONTROL STATIONS SHALL BE MOUNTED 18" ABOVE FLOOR AND HAVE EYS FITTING COMPLYING WITH ALL CLASS 1, DIV 1 REQUIREMENTS.
 - ⑤ ALL JUNCTION BOXES IN CLASS 1, DIV 1 AREA SHALL BE EXPLOSION RATED.
 - ⑥ PLACE "EYS" TYPE BARRIER AT TRANSITION FROM PUMP TO DISCONNECT. FILL WITH EXPANSION TYPE FOAM. LOCATE "EYS" BELOW DISCONNECT SWITCH.
 - ⑦ STAINLESS STEEL KELLUM GROUP PER DWG E21 DETAIL "E" SIZED FOR PUMP MANUFACTURER CABLE.
 - ⑧ INSTALL DISCONNECTS DISC 101,131 & 132 PER DWG E22 DETAIL "G".
 - ⑨ COORDINATE FINAL LOCATION IN FIELD.
 - ⑩ STUB OUT 6" ABOVE GRADE AND CAP CONDUITS.



Underground Service Alert

TWO DAYS BEFORE YOU DIG

Call TOLL FREE: 1-800-642-2444




REFER TO SET FOR SIGNATURE

REV. No.	DISCRPTION	DATE	BY	App'v'd By
1				
2				
3				
4				
5				
6				
7				

WEST YOST ASSOCIATES
Consulting Engineers

1260 Lake Boulevard
Suite 240
Davis, California 95616
(530) 756-5905
FAX (530) 756-5991

RECORD DRAWINGS		
14-Mile Slough Pump Station Upgrades		
PUMP STATION ELECTRICAL SITE PLAN		
DEPARTMENT OF MUNICIPAL UTILITIES CITY OF STOCKTON, CALIFORNIA		
SCALE: 1/4" = 1'	APPROVED BY: DATE: _____	SHEET No.
DESIGNED BY: SMK		E15
DRAWN BY: ZK		74 of 89 SHEETS
CHECKED BY: XML	ASSISTANT DIRECTOR, DEPT. OF MUNICIPAL UTILITIES	PROJECT No. 293-00-05-01
RECORD Dwg.:		

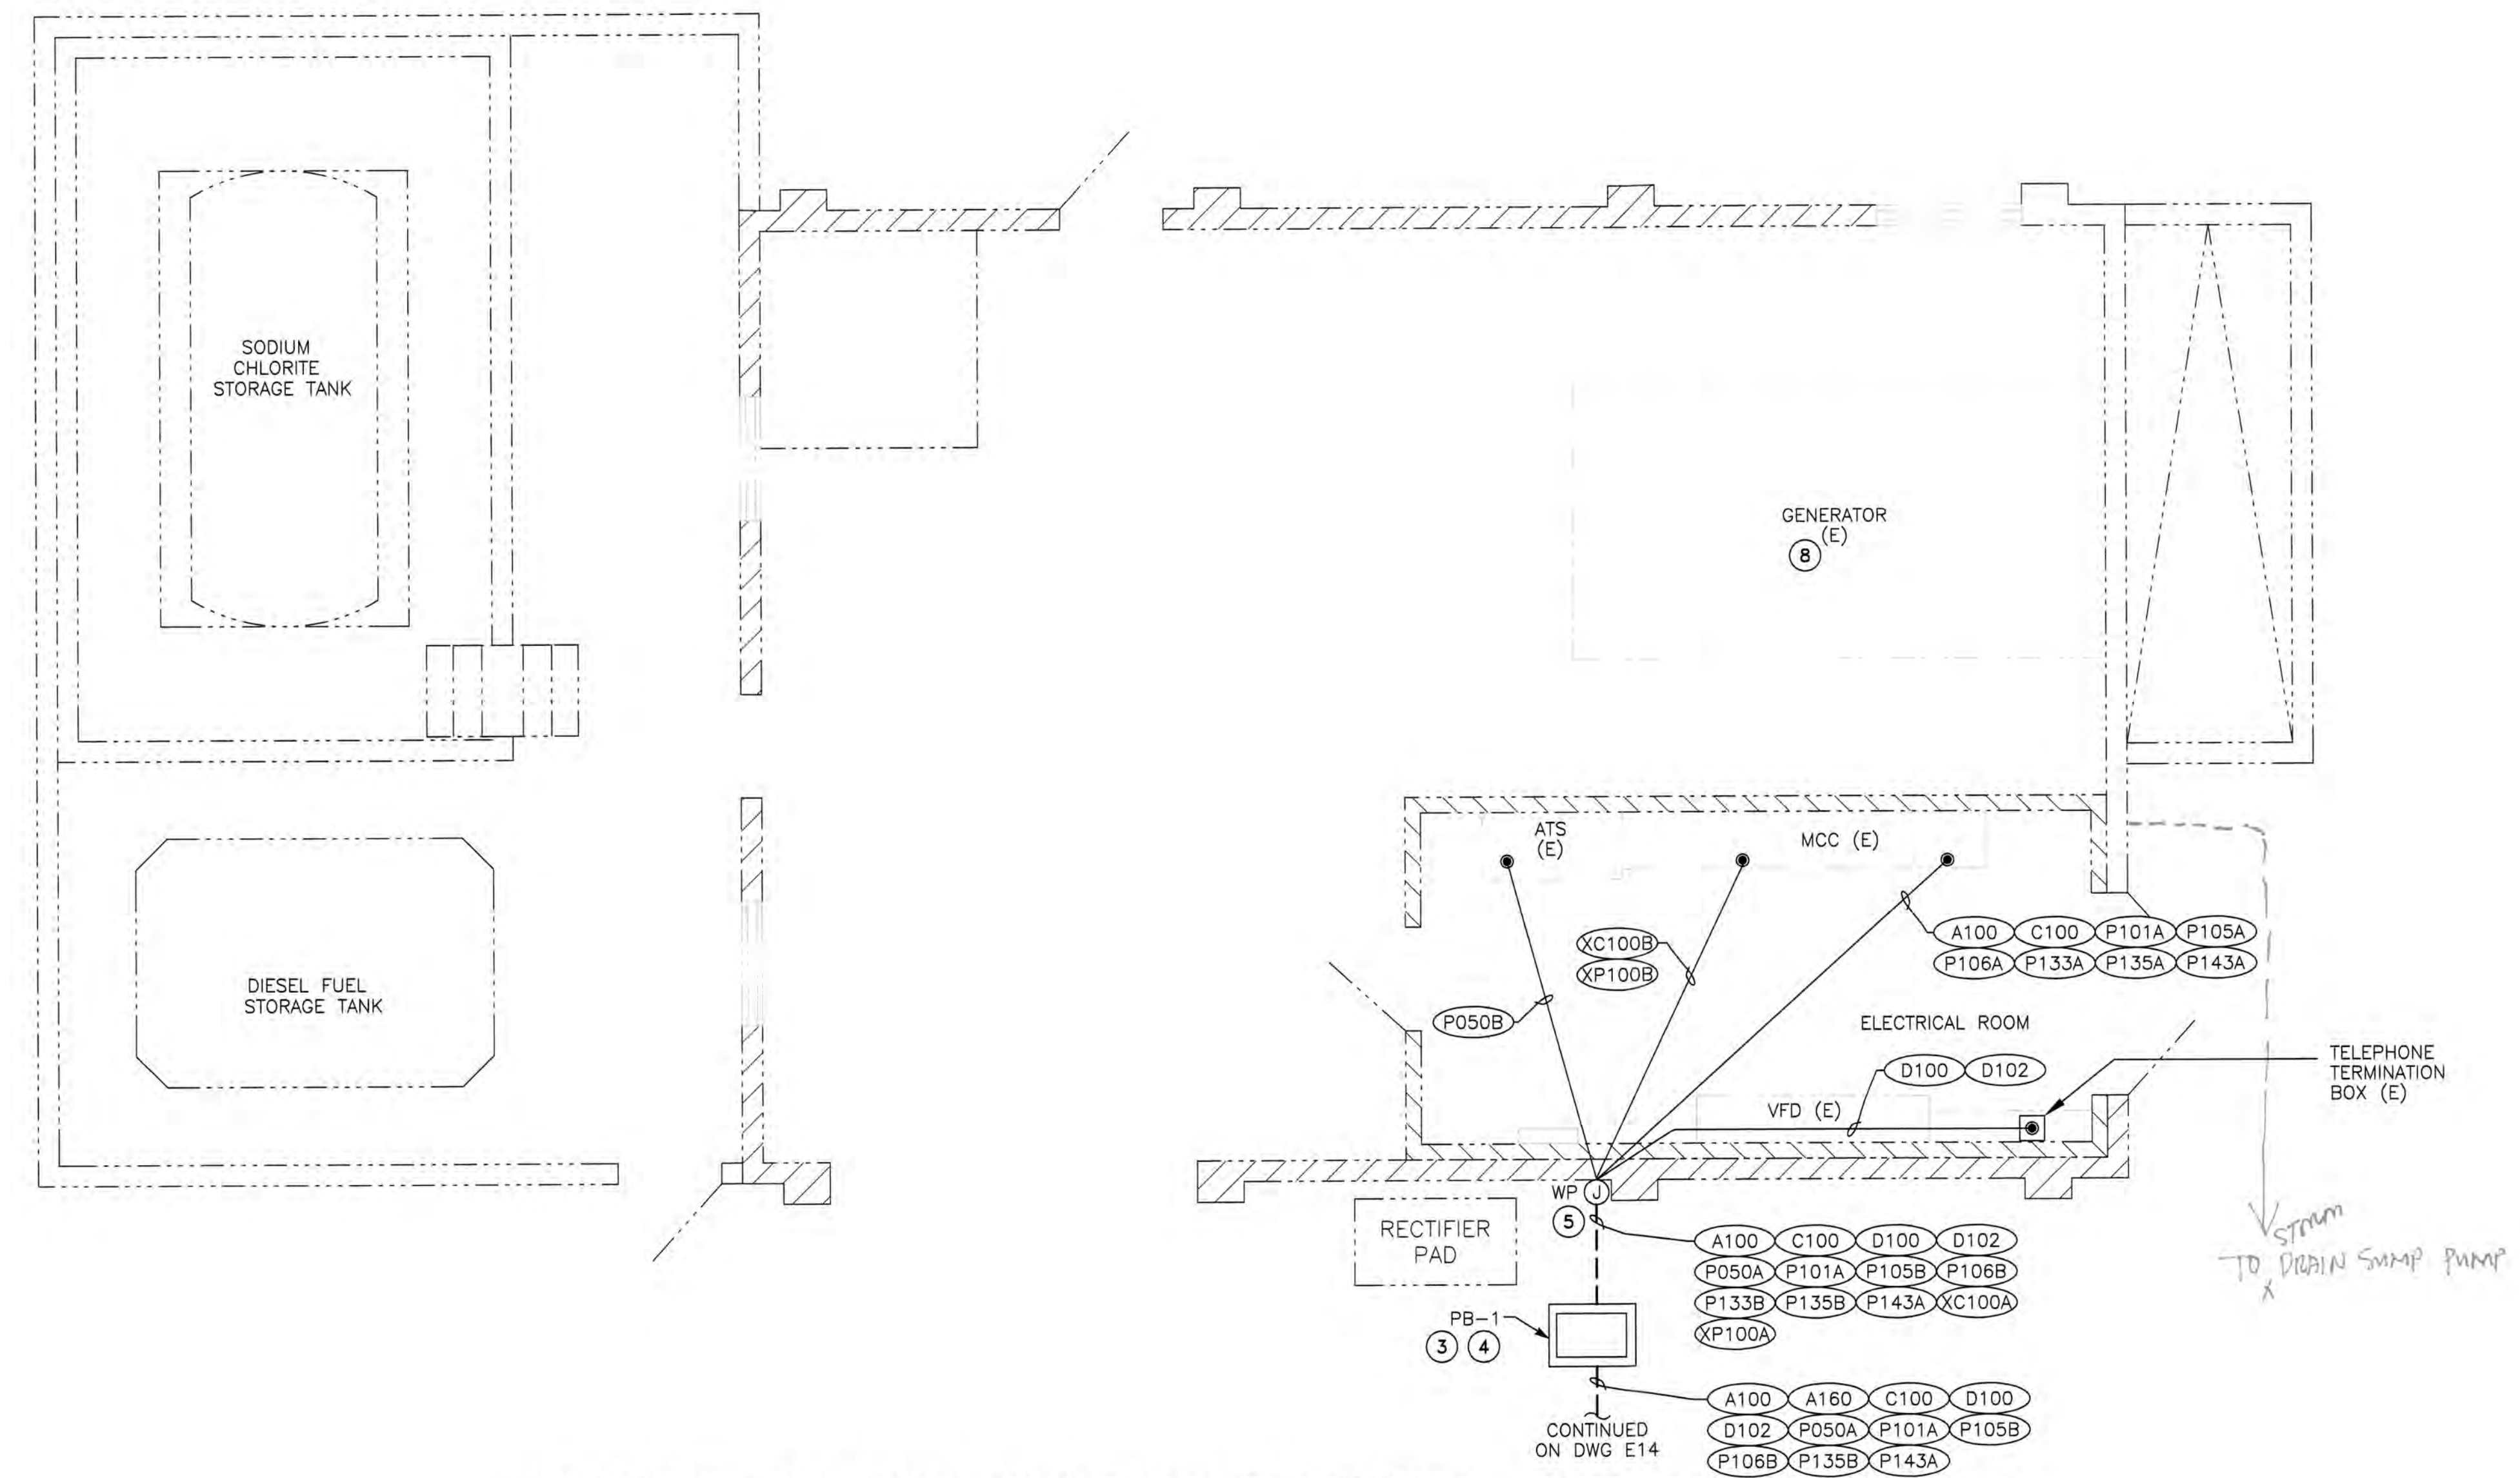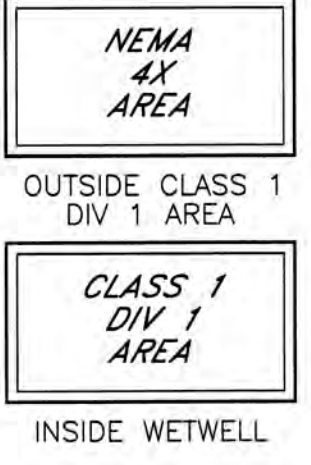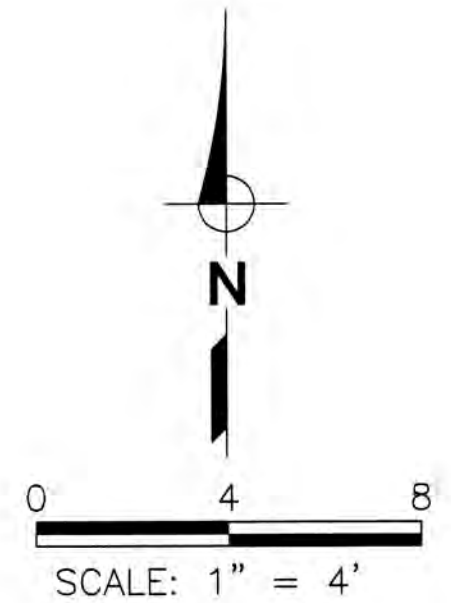

EXISTING CONTROL BUILDING ELECTRICAL SITE PLAN ① ② ③ ④ ⑤ ⑥ ⑦ ⑧ ⑨ ⑩

- NOTES:
- ① UG CONDUITS TO BE INSTALLED PER DWG E23, DETAIL "B".
 - ② EXPOSED CONDUIT TRANSITIONS PER DWG E23, DETAIL "G".
 - ③ INSTALL 17" x 30" PULL BOX PER DWG E23, DETAIL "H".
 - ④ A & C CONDUITS SHALL BE IN ONE SIDE AND P CONDUITS IN THE OTHER SIDE.
 - ⑤ INSTALL WEATHERPROOF TRANSITION JUNCTION BOX AT ALL TRANSITIONS. CONTRACTOR SHALL CUT HOLES FOR ALL WALL PENETRATIONS. SEAL AROUND CONDUITS AND PAINT TO MATCH EXISTING SURFACE COLOR. CONDUITS TO TERMINATE INTO SIDE OR BOTTOM OF PANELS.
 - ⑥ SUPPORT ALL OVERHEAD CONDUITS PER DWG E23, DETAIL "A".
 - ⑦ PUMPS & VFD DRIVES TO REMAIN IN SERVICE UNTIL CUT OVER TO NEW PUMP STATION HAS BEEN COMPLETED & TESTED. REMOVE & TURN OVER VFD DRIVES & PUMPS TO OWNER. EXISTING BREAKERS TO BE SPARE.
 - ⑧ TURN OVER GENERATOR & DAY TANK TO CITY AFTER NEW POWER SERVICE HAS BEEN COMPLETED AND TESTED. "SAFETY" CONDUITS TO GENERATOR.
 - ⑨ NOT ALL EXISTING CONDUITS SHOWN. CONDUITS SHOWN ARE THOSE ASSOCIATE WITH NEW WORK.
 - ⑩ THESE ARE EXISTING CONDUITS, PIPES AND GAS LINES, NOT SHOWN WHICH SHALL BE PROTECTED FROM DAMAGE. REPLACE OR REPAIR ALL DAMAGE EXISTING UTILITY AT NO ADDITIONAL COST TO OWNER.

T.E.E.M.
 (916) 457-8144
 FILE: 0507C E016

RECORD DRAWINGS
14-Mile Slough Pump Station Upgrades
EXISTING CONTROL BUILDING
ELECTRICAL SITE PLAN

DEPARTMENT OF MUNICIPAL UTILITIES CITY OF STOCKTON, CALIFORNIA		SHEET No.
SCALE: 1/4" = 1'	APPROVED BY: DATE: _____	E16
DESIGNED BY: SMK	ASSISTANT DIRECTOR, DEPT. OF MUNICIPAL UTILITIES	75 of 89 SHEETS
DRAWN BY: ZK		PROJECT No. 293-00-05-01
CHECKED BY: XML		
RECORD Dwg.:		



Underground Service Alert

 TWO DAYS BEFORE YOU DIG
 Call TOLL FREE: 1-800-642-2444

REFER TO BID SET FOR SIGNATURE

REV. No.	DISCRPTION	DATE	BY	Appr'd By
1				
2				
3				
4				
5				
6				
7				

WEST YOST ASSOCIATES
 Consulting Engineers
 1260 Lake Boulevard
 Suite 240
 Davis, California 95616
 (530) 756-5905
 FAX (530) 756-5991

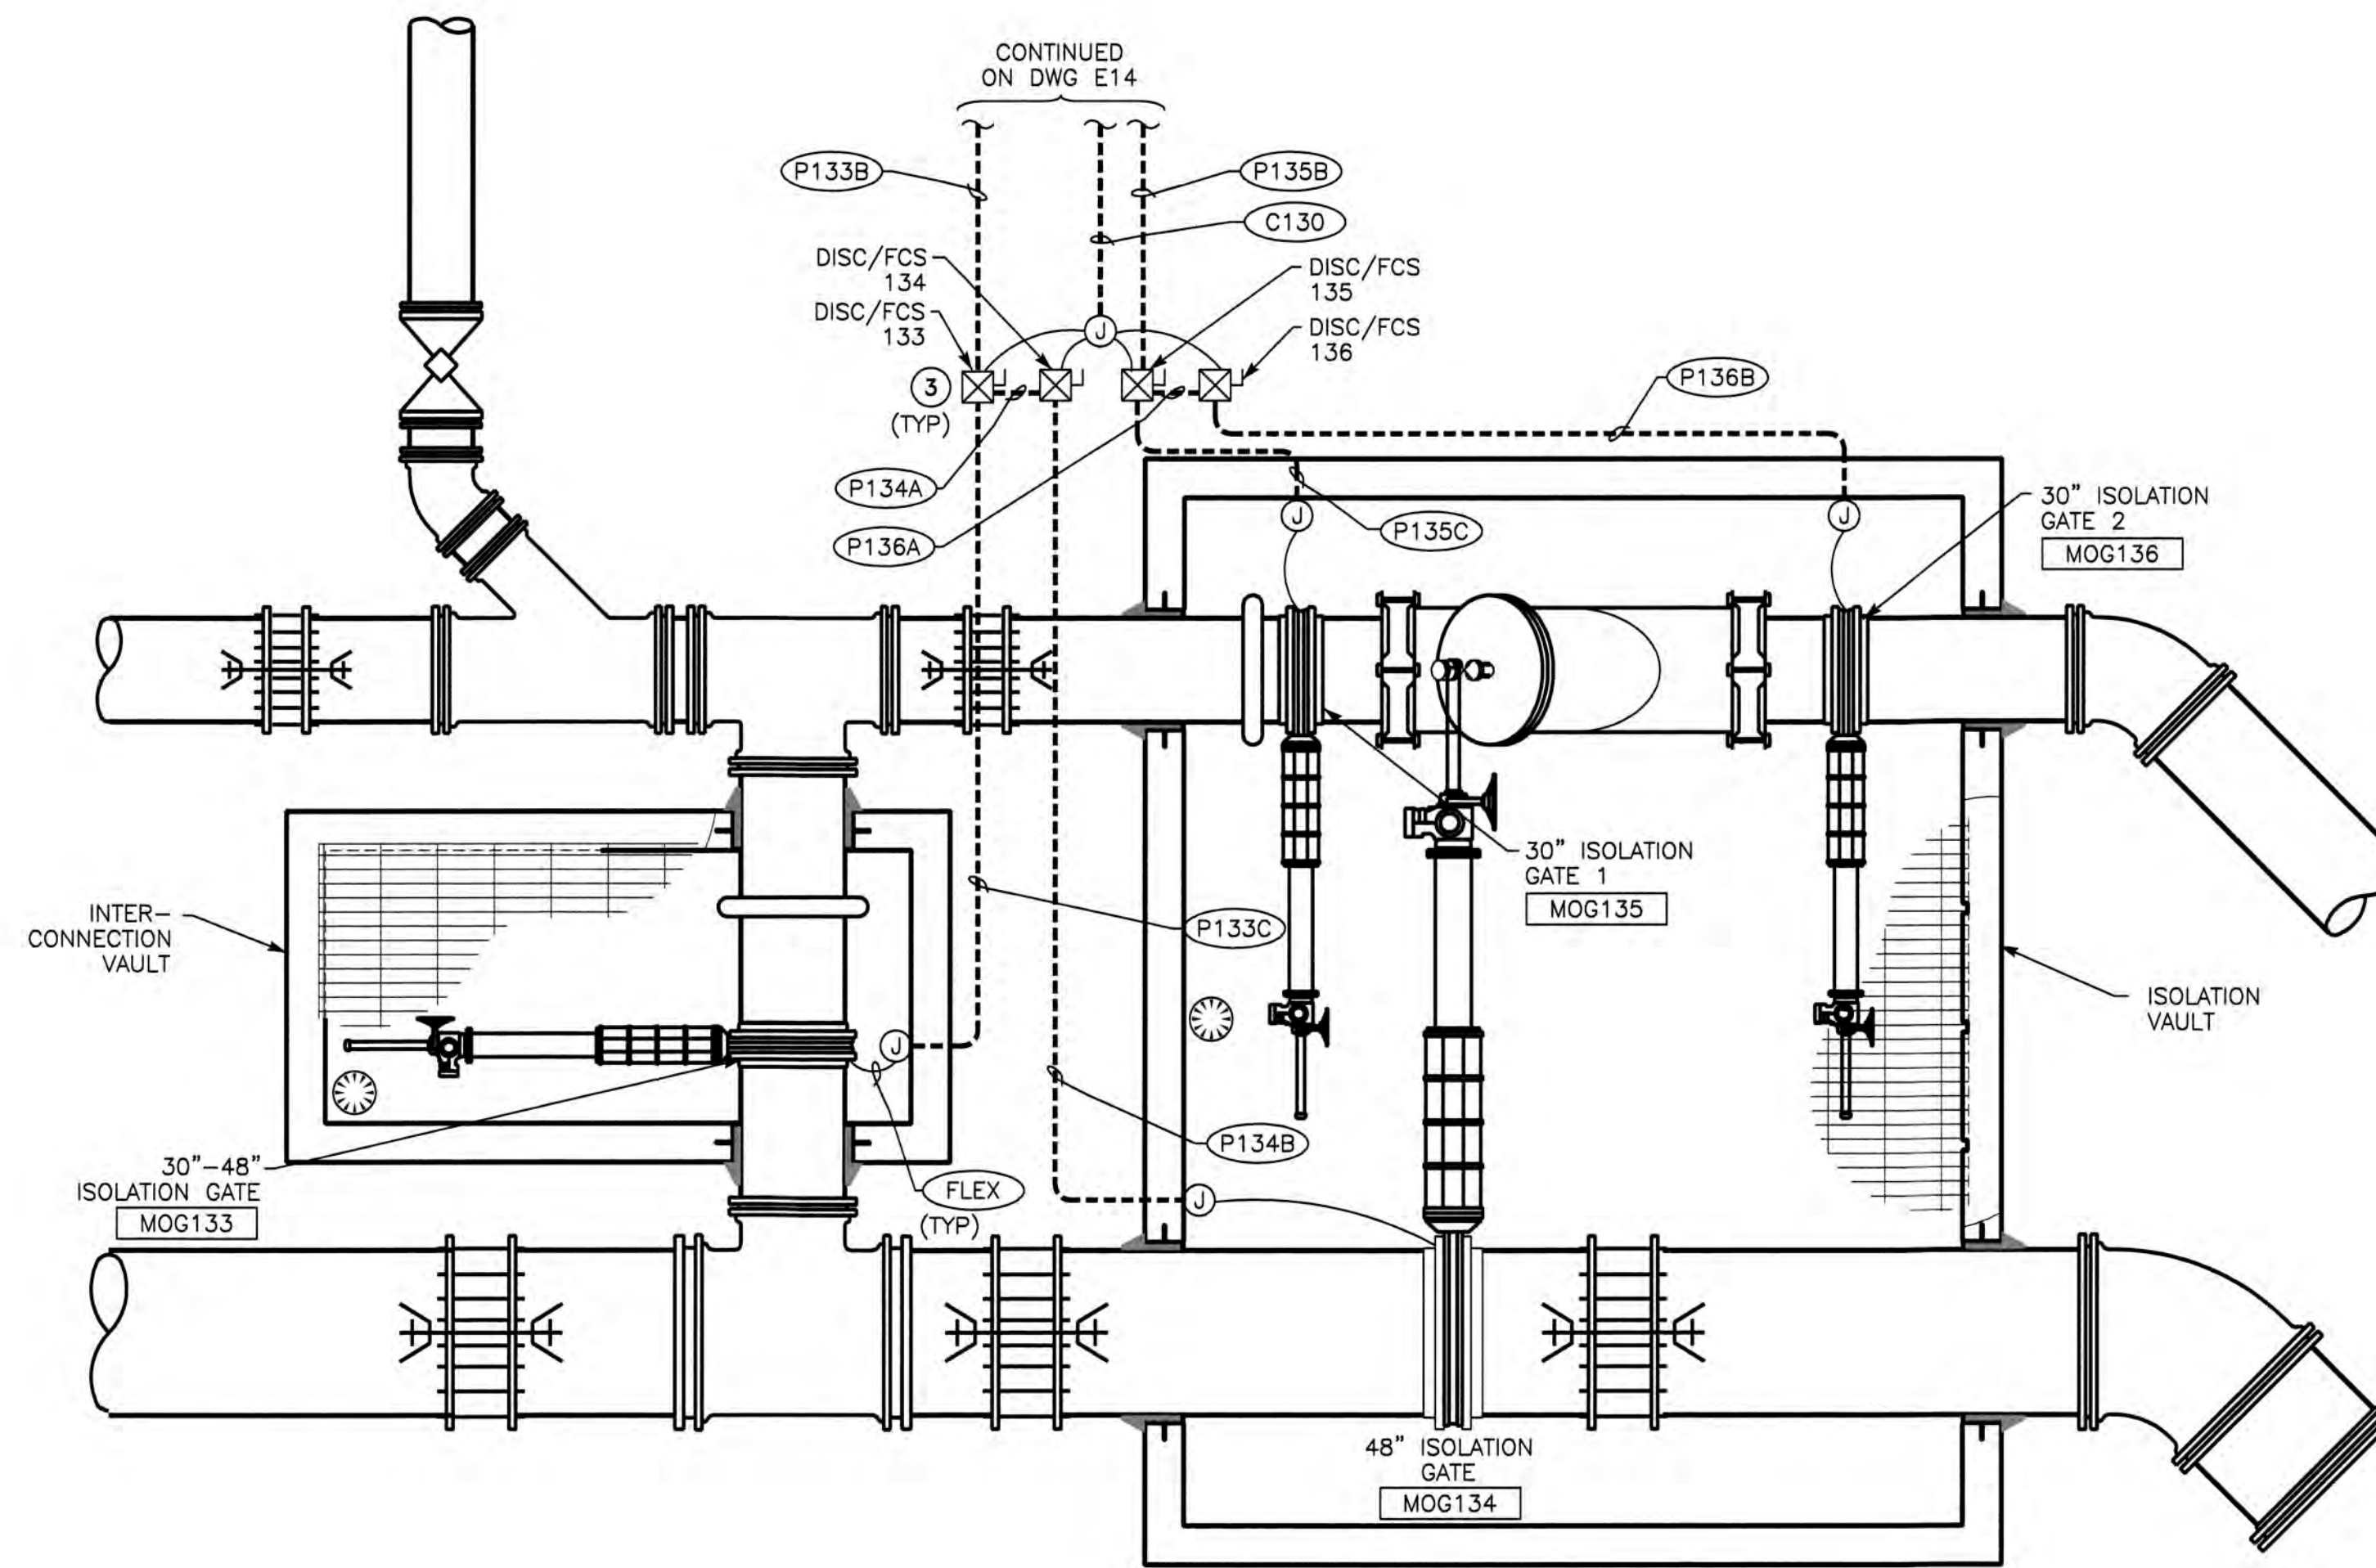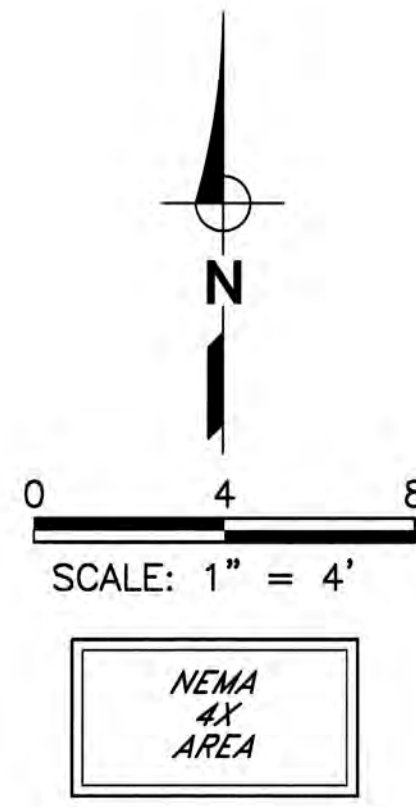

DISCHARGE GATE ELECTRICAL SITE PLAN ①②④

- NOTES: ① UG CONDUITS TO BE INSTALLED PER DWG E23, DETAIL "B".
 ② EXPOSED CONDUIT TRANSITIONS PER DWG E23, DETAIL "G".
 ③ 30A NEMA 4X SS FUSED DISCONNECT SWITCH WITH FUSES SIZED TO PROTECT EQUIPMENT. LOCATE DISCONNECT BELOW VALVE CONTROLLER.
 ④ ALL JUNCTION BOXES TO BE WEATHERPROOF (WP).



**REFER TO
 BID SET
 FOR
 SIGNATURE**

REV. No.	DISCRPTION	DATE	BY	Apr'd By
1				
2				
3				
4				
5				
6				




1260 Lake Boulevard
 Suite 240
 Davis, California 95616
 (530) 756-5905
 FAX (530) 756-5991

RECORD DRAWINGS		
14-Mile Slough Pump Station Upgrades		
DISCHARGE GATE ELECTRICAL SITE PLAN		
<small>DEPARTMENT OF MUNICIPAL UTILITIES CITY OF STOCKTON, CALIFORNIA</small>		
SCALE: 1"=4'	APPROVED BY: DATE: _____	SHEET No. _____
DESIGNED BY: SMK		E17
DRAWN BY: ZK		76 of 89 SHEETS
CHECKED BY: XML	ASSISTANT DIRECTOR, DEPT. OF MUNICIPAL UTILITIES	PROJECT No. 293-00-05-01
RECORD Dwg.:		


REF DWG	CONDUIT NO.	FROM	TO	CONDUIT QTY	CONDUIT SIZE	TYPE	POWER WIRE QTY	POWER WIRE SIZE	GND SIZE	CONTROL WIRE QTY	CONTROL WIRE SIZE	SIGNAL WIRE QTY	SIGNAL WIRE SIZE	NOTES
E15	A 100	CP-100	MCC-M (E)	1	1-1/2"	GRS-PVC	-	-	#12	-	-	6	#16 TSPR	
E13C	A 111	CP-100	PNL111	1	1"	GRS-PVC	-	-	#12	-	-	3	#16 TSPR	
E13C	A 112	CP-100	PNL112	1	1"	GRS-PVC	-	-	#12	-	-	3	#16 TSPR	
E13C	A 113	CP-100	PNL113 (F)	1	1"	GRS-PVC	-	-	-	-	-	-	-	PULL ROPE
E13C	A 121	CP-100	PNL121	1	1"	GRS-PVC	-	-	#12	-	-	3	#16 TSPR	
E13C	A 122	CP-100	PNL122	1	1"	GRS-PVC	-	-	#12	-	-	3	#16 TSPR	
E13C	A 123	CP-100	PNL123 (F)	1	1"	GRS-PVC	-	-	-	-	-	-	-	PULL ROPE
E15	A 131	CP-100	MOG131	1	1"	GRS-PVC	-	-	#12	-	-	3	#16 TSPR	
E15	A 132	CP-100	MOG132	1	1"	GRS-PVC	-	-	#12	-	-	3	#16 TSPR	
E14	A 141	CP-100	PNL141	1	1"	GRS-PVC	-	-	#12	-	-	2	#16 TSPR	
E14	A 142	CP-100	PNL142	1	1"	GRS-PVC	-	-	#12	-	-	2	#16 TSPR	
E14	A 150	CP-100	LT150	1	1"	GRS-PVC	-	-	#12	2	#14	2	#16 TSPR	
E15	A 151 A	CP-100	LT151/2 JB	1	1-1/2"	GRS-PVC	-	-	#12	6	#14	3	#16 TSPR	
E15	A 151 B	LT151/2 JB	LT151	1	1"	GRS-PVC	-	-	-	-	-	-	-	MNFR CBL
E15	A 152	LT151/2 JB	LT152	1	1"	GRS-PVC	-	-	-	-	-	-	-	MNFR CBL
E14	A 153 A	CP-100	LIT153	1	1"	GRS-PVC	-	-	#12	2	#14	1	#16 TSPR	
E14	A 153 B	LIT153	LE153	1	1"	GRS-PVC	-	-	-	-	-	-	-	MNFR CBL
E14	A 160	CP-100	PIT160	1	1"	GRS-PVC	-	-	#12	2	#14	2	#16 TSPR	
E14	A 161	CP-100	PIT161	1	1"	GRS-PVC	-	-	#12	2	#14	2	#16 TSPR	
E14	A 162	CP-100	PIT162	1	1"	GRS-PVC	-	-	#12	2	#14	2	#16 TSPR	
E14	A 171	CP-100	FE171	1	1"	GRS-PVC	-	-	#8	-	-	-	-	MNFR CBL
E14	A 172	CP-100	FE172	1	1"	GRS-PVC	-	-	#8	-	-	-	-	MNFR CBL
E13A	A 181	CP-100	T-STAT 1	1	1"	GRS	-	-	#12	-	-	2	#16 TSPR	
E13A	A 182	CP-100	T-STAT 2	1	1"	GRS	-	-	#12	-	-	2	#16 TSPR	
E16	C 100	CP-100	MCC-M (E)	1	2"	PVC-40	-	-	#12	40	#14	-	-	GRS INSIDE BLDG
E13A	C 105 A	AC1	T-STAT 1	1	1"	GRS-PVC	-	-	#12	4	#14	-	-	
E13A	C 105 B	T-STAT 1	CP-100	1	1"	GRS	-	-	#12	4	#14	-	-	
E13A	C 106 A	AC2	T-STAT 2	1	1"	GRS-PVC	-	-	#12	4	#14	-	-	
E13A	C 106 B	T-STAT 2	CP-100	1	1"	GRS	-	-	#12	4	#14	-	-	
E13C	C 109 A	CP-100	GEN109	1	1"	GRS-PVC	-	-	#12	12	#14	-	-	
E13C	C 109 B	CP-100	FCS109	1	1"	GRS-PVC	-	-	#12	6	#14	-	-	
E14	C 110	GEN109	LBK110	1	1"	GRS-PVC	-	-	#12	6	#14	-	-	
E13C	C 111 A	CP-100	PNL111	1	1"	GRS-PVC	-	-	#12	16	#14	-	-	
E15	C 111 B	PNL111	FCS111	1	1"	GRS-PVC	-	-	#12	10	#14	-	-	
E13C	C 112 A	CP-100	PNL112	1	1"	GRS-PVC	-	-	#12	16	#14	-	-	
E15	C 112 B	PNL112	FCS112	1	1"	GRS-PVC	-	-	#12	10	#14	-	-	
E13C	C 113 A	CP-100	PNL113 (F)	1	1"	GRS-PVC	-	-	-	-	-	-	-	PULL ROPE
E15	C 113 B	PNL113 (F)	FCS113	1	1"	GRS-PVC	-	-	-	-	-	-	-	PULL ROPE
E13C	C 121 A	CP-100	PNL121	1	1"	GRS-PVC	-	-	#12	16	#14	-	-	
E15	C 121 B	PNL121	FCS121	1	1"	GRS-PVC	-	-	#12	10	#14	-	-	
E13C	C 122 A	CP-100	PNL122	1	1"	GRS-PVC	-	-	#12	16	#14	-	-	
E15	C 122 B	PNL122	FCS122	1	1"	GRS-PVC	-	-	#12	10	#14	-	-	
E13C	C 123 A	CP-100	PNL123 (F)	1	1"	GRS-PVC	-	-	-	-	-	-	-	PULL ROPE
E15	C 123 B	PNL123 (F)	FCS123	1	1"	GRS-PVC	-	-	-	-	-	-	-	PULL ROPE
E17	C 130	CP-100	VALVE J-BOX	1	1-1/2"	GRS-PVC	-	-	#12	50	#14	-	-	
E15	C 131	CP-100	DICS131	1	1"	PVC-40	-	-	#12	8	#14	-	-	
E14	C 141	CP-100	PNL141	1	1"	GRS-PVC	2	#12	#12	8	#14	-	-	LP2 #12
E14	C 142	CP-100	PNL142	1	1"	GRS-PVC	2	#12	#12	8	#14	-	-	LP2 #14
E15	C 151 A	CP-100	LIT151/2 JB	1	1"	PVC-40	-	-	#12	16	#14	-	-	
E15	C 151 B	LIT151/2 JB	LSL/LSLL/LSHH151	1	1"	GRS-PVC	-	-	#12	8	#14	-	-	
E15	C 152	LIT151/2 JB	LSL/LSLL/LSHH152	1	1"	GRS-PVC	-	-	#12	8	#14	-	-	
E14	C 173	CP-100	FSL173/4 JB	1	1"	GRS-PVC	2	#12	#12	10	#14	-	-	LP2 #16
E13A	C 191 A	CP-100	ZS191A JB	1	1"	GRS	-	-	#12	8	#14	-	-	
E13A	C 191 B	ZS191A JB	ZS191B JB	1	1"	GRS	-	-	#12	6	#14	-	-	
E13A	C 191 C	ZS191B JB	ZS191C JB	1	1"	GRS	-	-	#12	4	#14	-	-	
E13A	C 191 D	CP-100	ZS191D JB	1	1"	GRS	-	-	#12	8	#14	-	-	
E13A	C 191 E	ZS191D JB	ZS191E JB	1	1"	GRS	-	-	#12	6	#14	-	-	
E13A	C 191 F	ZS191E JB	ZS191F	1	1"	GRS	-	-	#12	4	#14	-	-	
E13A	C 193 A	CP-100	ZS193A	1	1"	GRS	2	#12	#14	8	#14	-	-	
E13A	C 193 B	ZS193A	ZS193B	1	1"	GRS	2	#12	#14	6	#14	-	-	
E13A	C 193 C	ZS193B	ZS193C	1	1"	GRS	2	#12	#14	4	#14	-	-	
E13C	C 195	CP-100	ATS195	1	1"	GRS	-	-	#12	8	#14	-	-	
E15	D 100	CP-100	TELCO PANEL (E)	1	1"	GRS-PVC	-	-	#12	-	-	3	4PR CAT 5	
E14	D 101	CP-100	ANTENNA	1	2"	GRS-PVC	-	-	#8	-	-	1	1/2"COAX	

REF DWG	CONDUIT NO.	FROM	TO	CONDUIT QTY	CONDUIT SIZE	TYPE	POWER WIRE QTY	POWER WIRE SIZE	GND SIZE	CONTROL WIRE QTY	CONTROL WIRE SIZE	SIGNAL WIRE QTY	SIGNAL WIRE SIZE	NOTES
E16	D 102	SWBD-2	TELCO PANEL (E)	1	1"	GRS-PVC	-	-	#12	-	-	1	4PR CAT 5	
E14	H 100	UTILITY	UTILITY XFMR	2	5"	PVC-40	-	-	-	-	-	-	-	PULL ROPE
E14	L 113 A	LP2	AREA LIGHT	1	1"	PVC-40	4	#10	#10	-	-	-	-	
E14	L 113 B	AREA LIGHT	AREA LIGHT	1	1"	PVC-40	4	#10	#10	-	-	-	-	
E13C	L 118	LP2	GEN109	1	1"	PVC-40	6	#10	#10	-	-	-	-	
E13C	L 121	LP2	IRRIGATION CONTROLLER	1	1"	GRS-PVC	-	-	-	-	-	-	-	PULL ROPE
E14	L 123	LP2	FLOWMETER VAULT 1 RECEPT	1	1"	PVC-40	2	#10	#10	-	-	-	-	
E14	L 124	LP2	FLOWMETER VAULT 2 RECEPT	1	1"	PVC-40	2	#10	#10	-	-	-	-	
E14	P 050 A	SWBD-2	J-BOX	2	3"	PVC-40	3	#350 MCM	#1/0	-	-	-	-	
E16	P 050 B	J-BOX	MCC-M (E)	2	3"	GRS	3	#350 MCM	#1/0	-	-	-	-	
E15	P 101 A	MCC-M (E)	DISC101	1	1"	PVC-40	3	#10	#10	-	-	-	-	GRS INSIDE BLDG
E15	P 101 B	DISC101	SRB101	1	1"	GRS-PVC	3	#10	#10	-	-	-	-	
E13C	P 103	SWBD-2	GEN109	8	4"	PVC-40	3	#500 MCM	#500 MCM	-	-	-	-	
E14	P 104	GEN109	LBK110	4	4"	PVC-40	3	#500 MCM	#250 MCM	-	-	-	-	
E16	P 105 A	MCC-M (E)	J-BOX	1	1"	GRS	3	#10	#10	-	-	-	-	
E16	P 105 B	J-BOX	J-BOX	1	1"	PVC-40	3	#10	#10	-	-	-	-	
E13A	P 105 C	J-BOX	AC1	1	1"	GRS-PVC	3	#10	#10	-	-	-	-	
E16	P 106 A	MCC-M (E)	J-BOX	1	1"	GRS	3	#10	#10	-	-	-	-	
E13A	P 106 B	J-BOX	J-BOX	1	1"	PVC-40	3	#10	#10	-	-	-	-	
E13A	P 106 C	J-BOX	AC2	1	1"	GRS-PVC	3	#10	#10	-	-	-	-	
E14	P 107	SWBD-2	HTR106	1	1"	PVC-40	2	#6	#8	-	-	-	-	
E15	P 108 A	SWBD-2	DISC108	1	1"	PVC-40	3	#10	#10	-	-	-	-	
E15	P 108 B	DISC108	HST108	1	1"	GRS-PVC	3	#10	#10	-	-	-	-	
E13C	P 111 A	SWBD-2	PNL111	2	3"	PVC-40	3	#350 MCM	#1/0	-	-	-	-	
E15	P 111 B	PNL111	DISC111	2	4"	PVC-40	3	#350 MCM	#1/0	-	-	-	-	VFD RATED CABLE
E15	P 111 C	DISC111	P111	2	4"	GRS-PVC	MNFR CBL	-	-	-	-	-	-	
E13C	P 112 A	SWBD-2	PNL112	2	3"	PVC-40	3	#350 MCM	#1/0	-	-	-	-	
E15	P 112 B	PNL112	DISC112	2	4"	PVC-40	3	#350 MCM	#1/0	-	-	-	-	VFD RATED CABLE
E15	P 112 C	DISC112	P112	2	4"	GRS-PVC	MNFR CBL	-	-	-	-	-	-	
E13C	P 113 A	SWBD-2	PNL113 (F)	2	3"	PVC-40	-	-	-	-	-	-	-	PULL ROPE
E15	P 113 B	PNL113 (F)	DISC113	2	4"	PVC-40	-	-	-	-	-	-	-	PULL ROPE
E15	P 113 C	DISC113	P113 (F)	2	4"	GRS-PVC	-	-	-	-	-	-	-	PULL ROPE
E13C	P 121 A	SWBD-2	PNL121	2	3"	PVC-40	3	#350 MCM	#1/0	-	-	-	-	
E15	P 121 B	PNL121	DISC121	2	4"	PVC-40	3	#350 MCM	#1/0	-	-	-	-	VFD RATED CABLE
E15	P 121 C	DISC121	P121	2	4"	GRS-PVC	MNFR CBL	-	-	-	-	-	-	
E13C	P 122 A	SWBD-2	PNL122	2	3"	PVC-40	3	#350 MCM	#1/0	-	-	-	-	
E15	P 122 B	PNL122	DISC122	2	4"	PVC-40	3	#350 MCM	#1/0	-	-	-	-	VFD RATED CABLE
E15	P 122 C	FCS122	P122	2	4"	GRS-PVC	MNFR CBL	-	-	-	-	-	-	
E13C	P 123 A	SWBD-2	PNL123 (F)	2	3"	PVC-40	-	-	-	-	-	-	-	PULL ROPE
E15	P 123 B	PNL123 (F)	FCS123	2	4"	PVC-40	-	-	-	-	-	-	-	PULL ROPE
E15	P 123 C	FCS123	P123 (F)	2	4"	GRS-PVC	-	-	-	-	-	-	-	PULL ROPE
E13C	P 130	SWBD-2	XFMR-LP2	1	1-1/2"	GRS	3	#8	#8	-	-	-	-	
E15	P 131 A	SWBD-2	DISC131	1	1"	PVC-40	3	#8	#8	-	-	-	-	
E15	P 131 B	DISC131	MOG131	1	1"	GRS-PVC	3	#10	#10	4	#14	-	-	
E15	P 132 A	DISC131	DISC132	1	1"	GRS-PVC	3	#10	#10	4	#14	-	-	
E15	P 132 B	DISC132	MOG132	1	1"	GRS-PVC	3	#10	#10	4	#14	-	-	
E16	P 133 A	MCC-M (E)	J-BOX	1	1-1/2"	GRS	3	#8	#8	-	-	-	-	
E1														

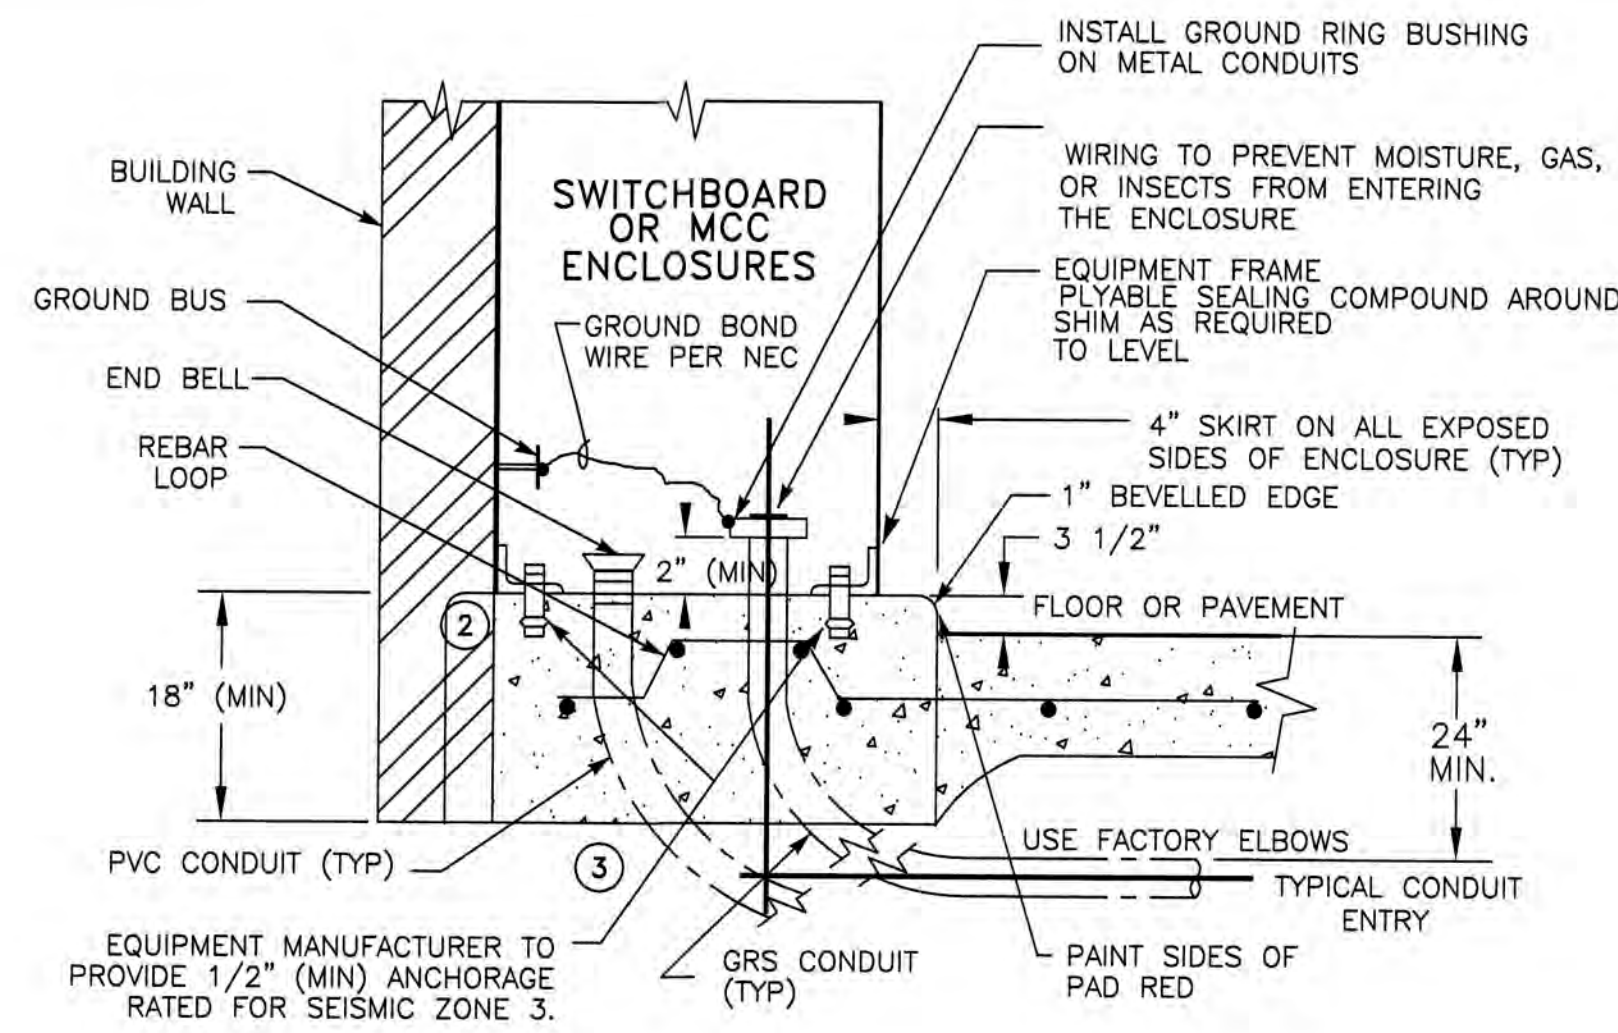


EQUIPMENT CONCRETE PAD (A) E21
NOT TO SCALE DETAIL

- NOTES:
- CONCRETE PAD ABOVE FLOOR TO BE POURED AFTER MAIN PAD HAD BEEN POURED. PAD ABOVE FLOOR TO BE CLASS "A" CONCRETE COMPOSITION ACCURATELY LEVELED WITHIN 1/16 INCH. REBAR TO BE #4 @ 12" CROSSWAYS & VERTICAL EVERY 6" (MINIMUM) OR AS CALLED OUT IN STRUCTURAL DRAWINGS.
 - IF NO BUILDING WALL EXTEND PAD 4" BEYOND ENCLOSURE ON BACK & SIDES.
 - CONCRETE DUCT BANKS SHALL EXTEND & CONNECT INTO EQUIPMENT CONCRETE PAD.

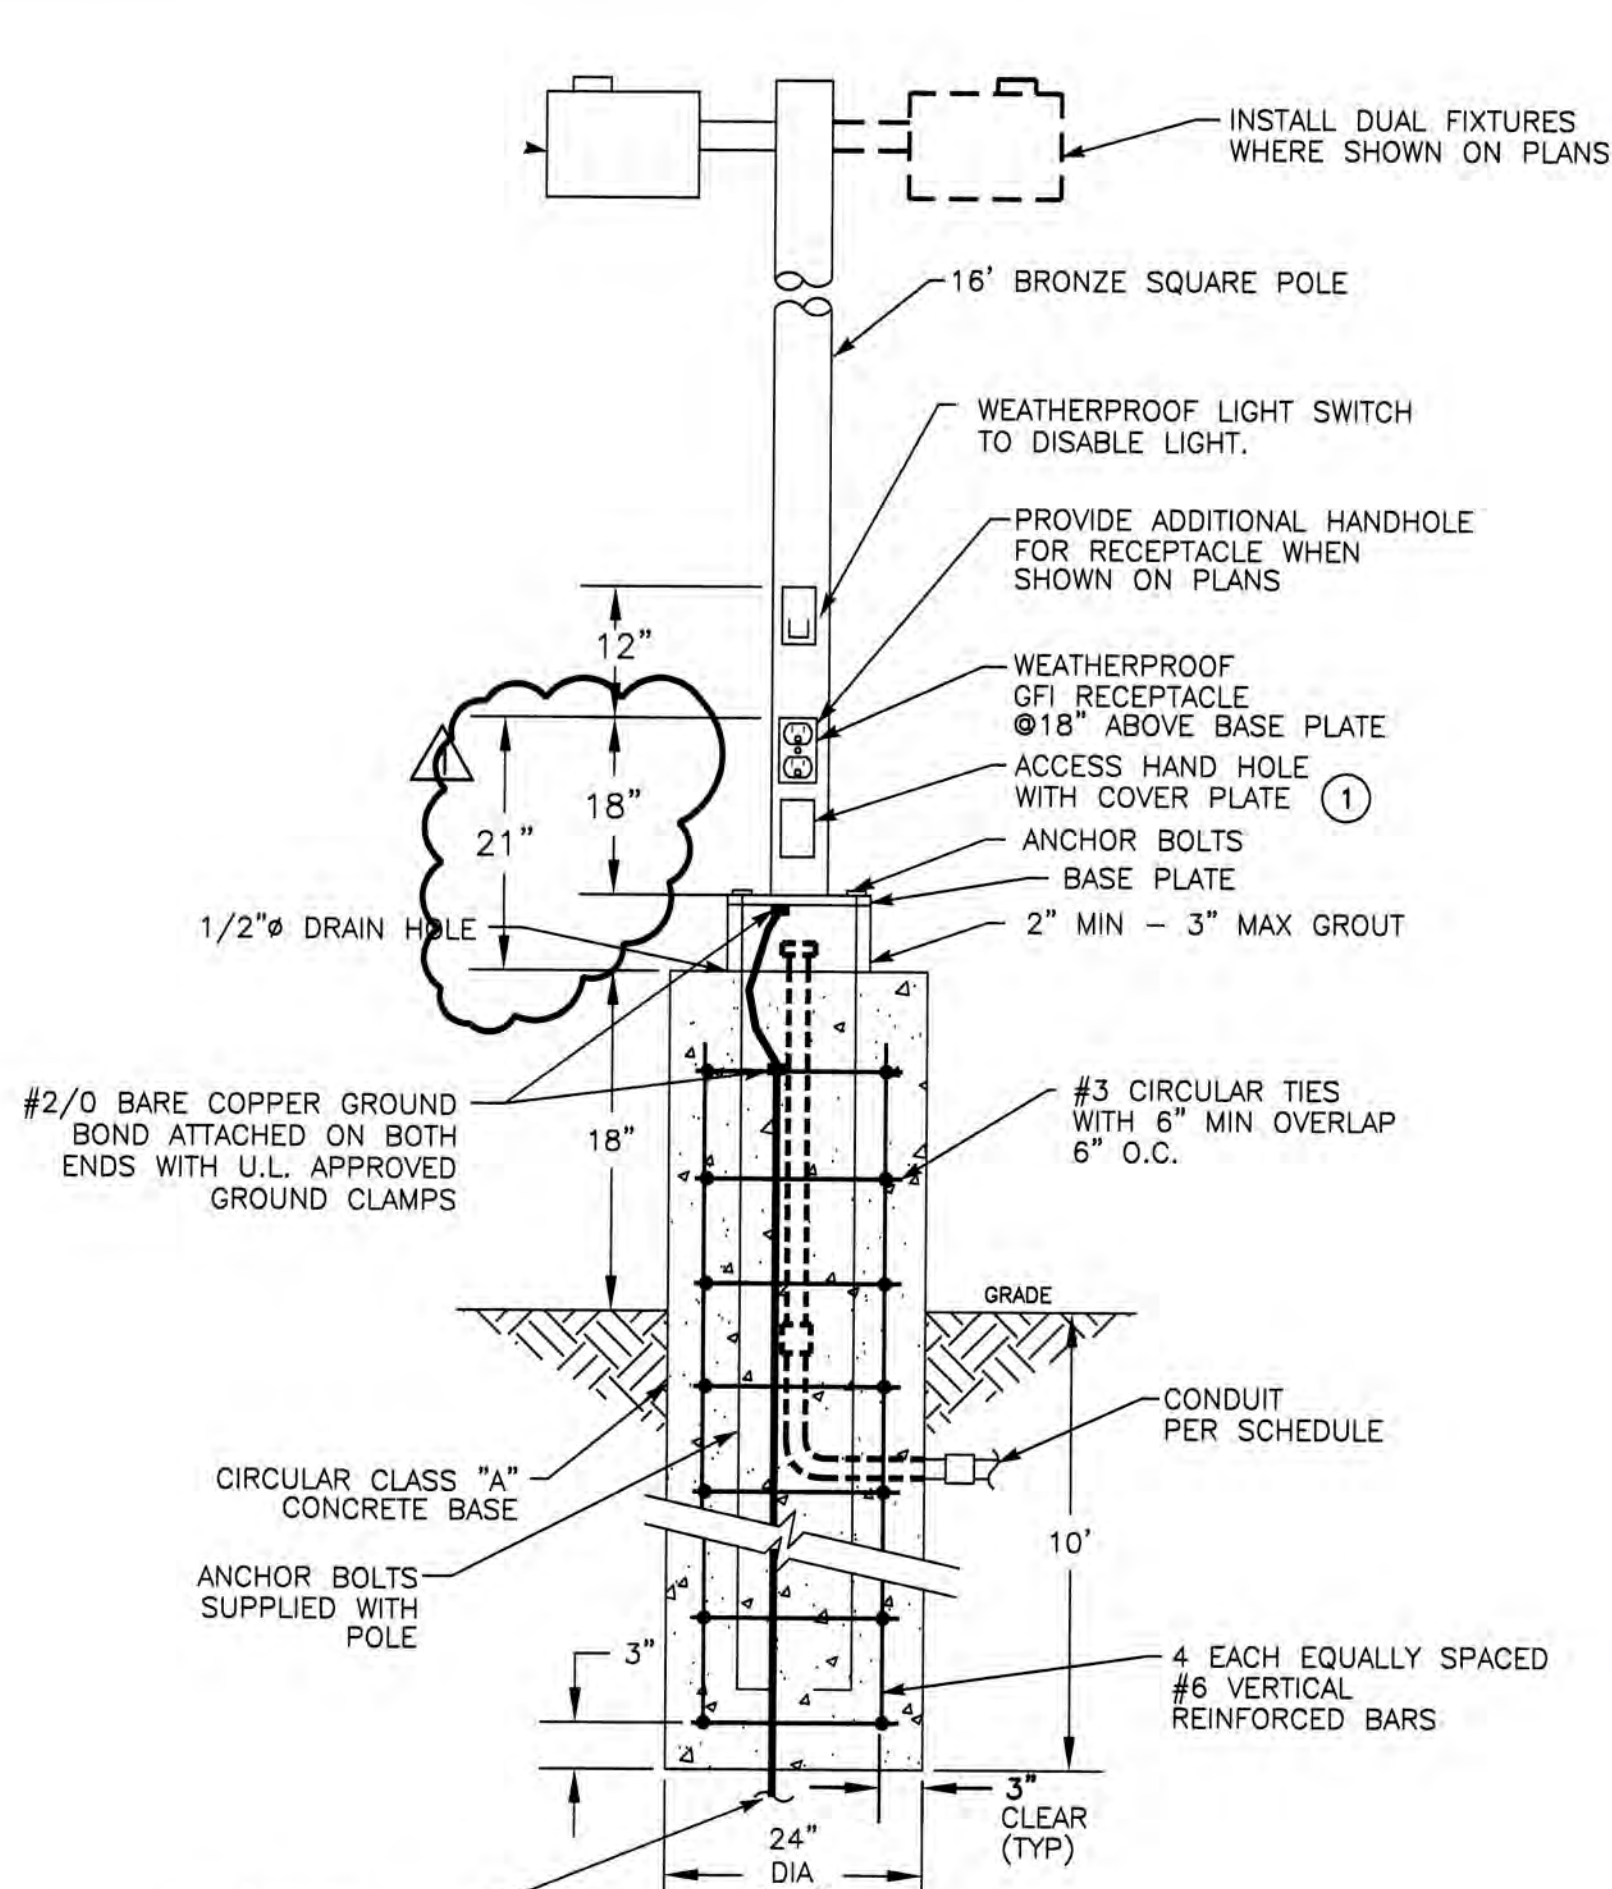


AREA LIGHT (B) E21
NOT TO SCALE DETAIL

- NOTES:
- PROVIDE 2 POLE FUSE HOLDER WITH FUSES & RUBBER BOOTS ON LIGHT WIRING FEED INSIDE HANDHOLE.

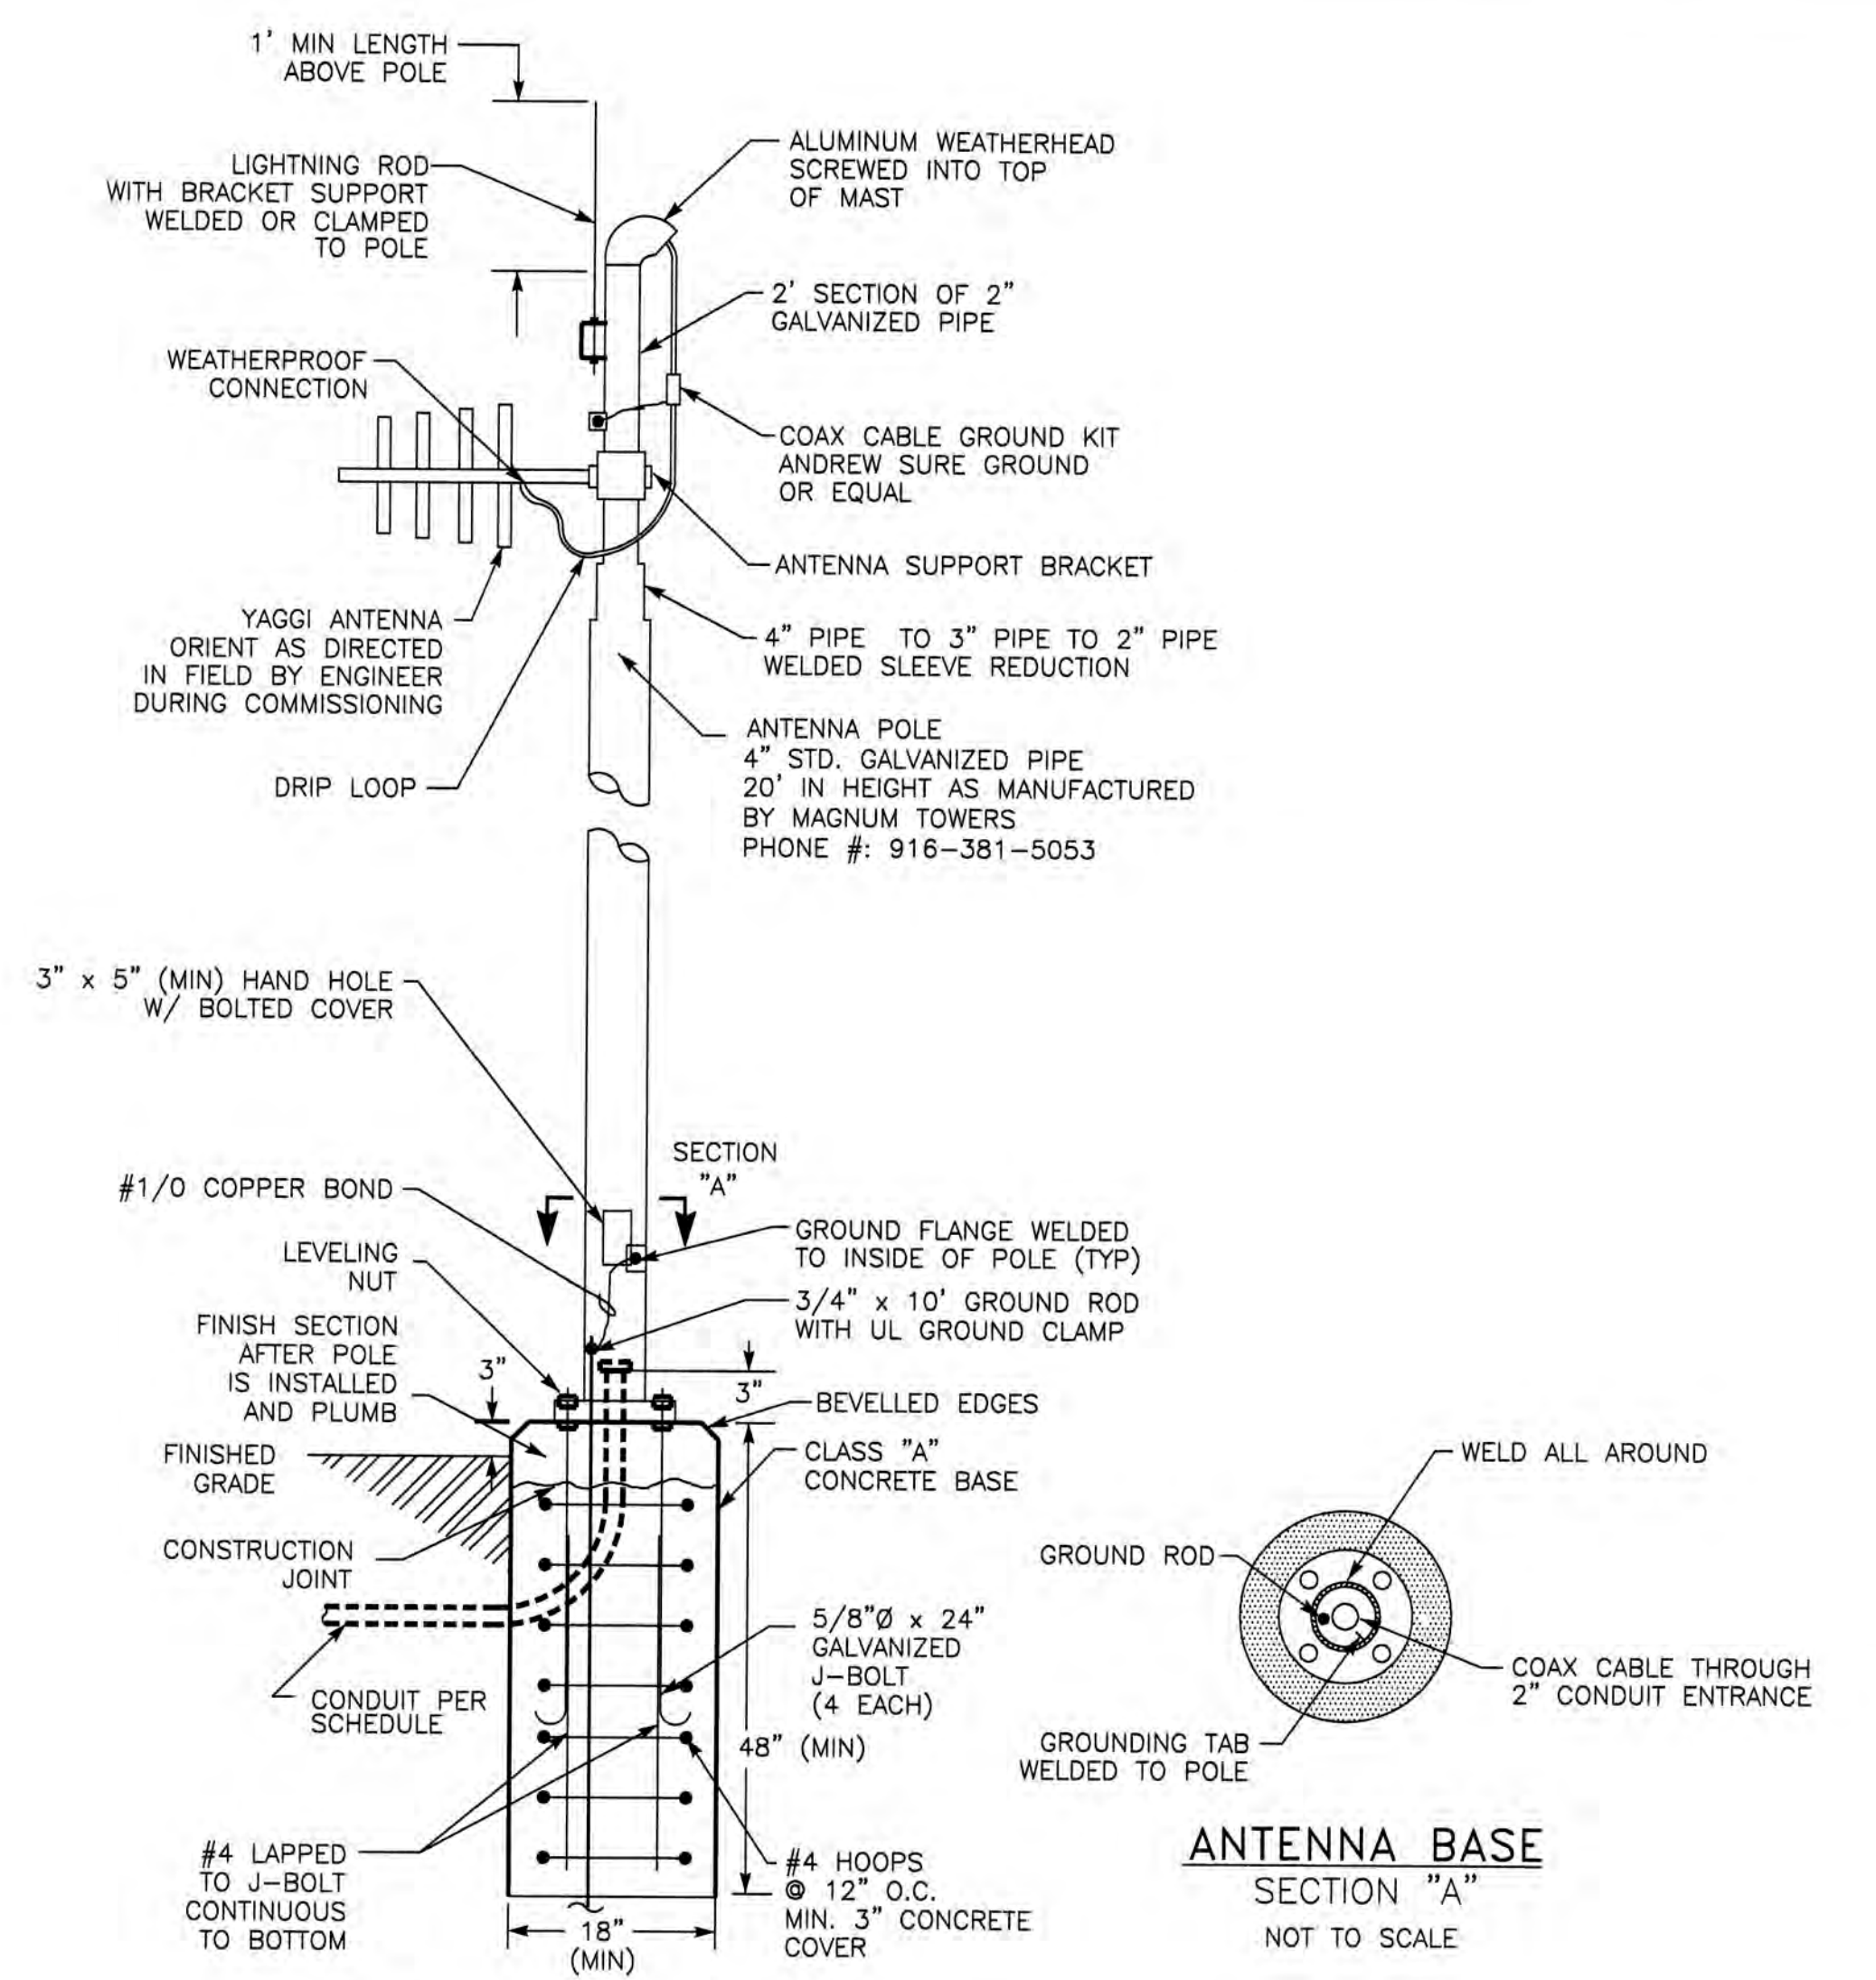


ANTENNA MAST INSTALLATION (C) E21
NOT TO SCALE DETAIL

ANTENNA BASE SECTION "A"
NOT TO SCALE

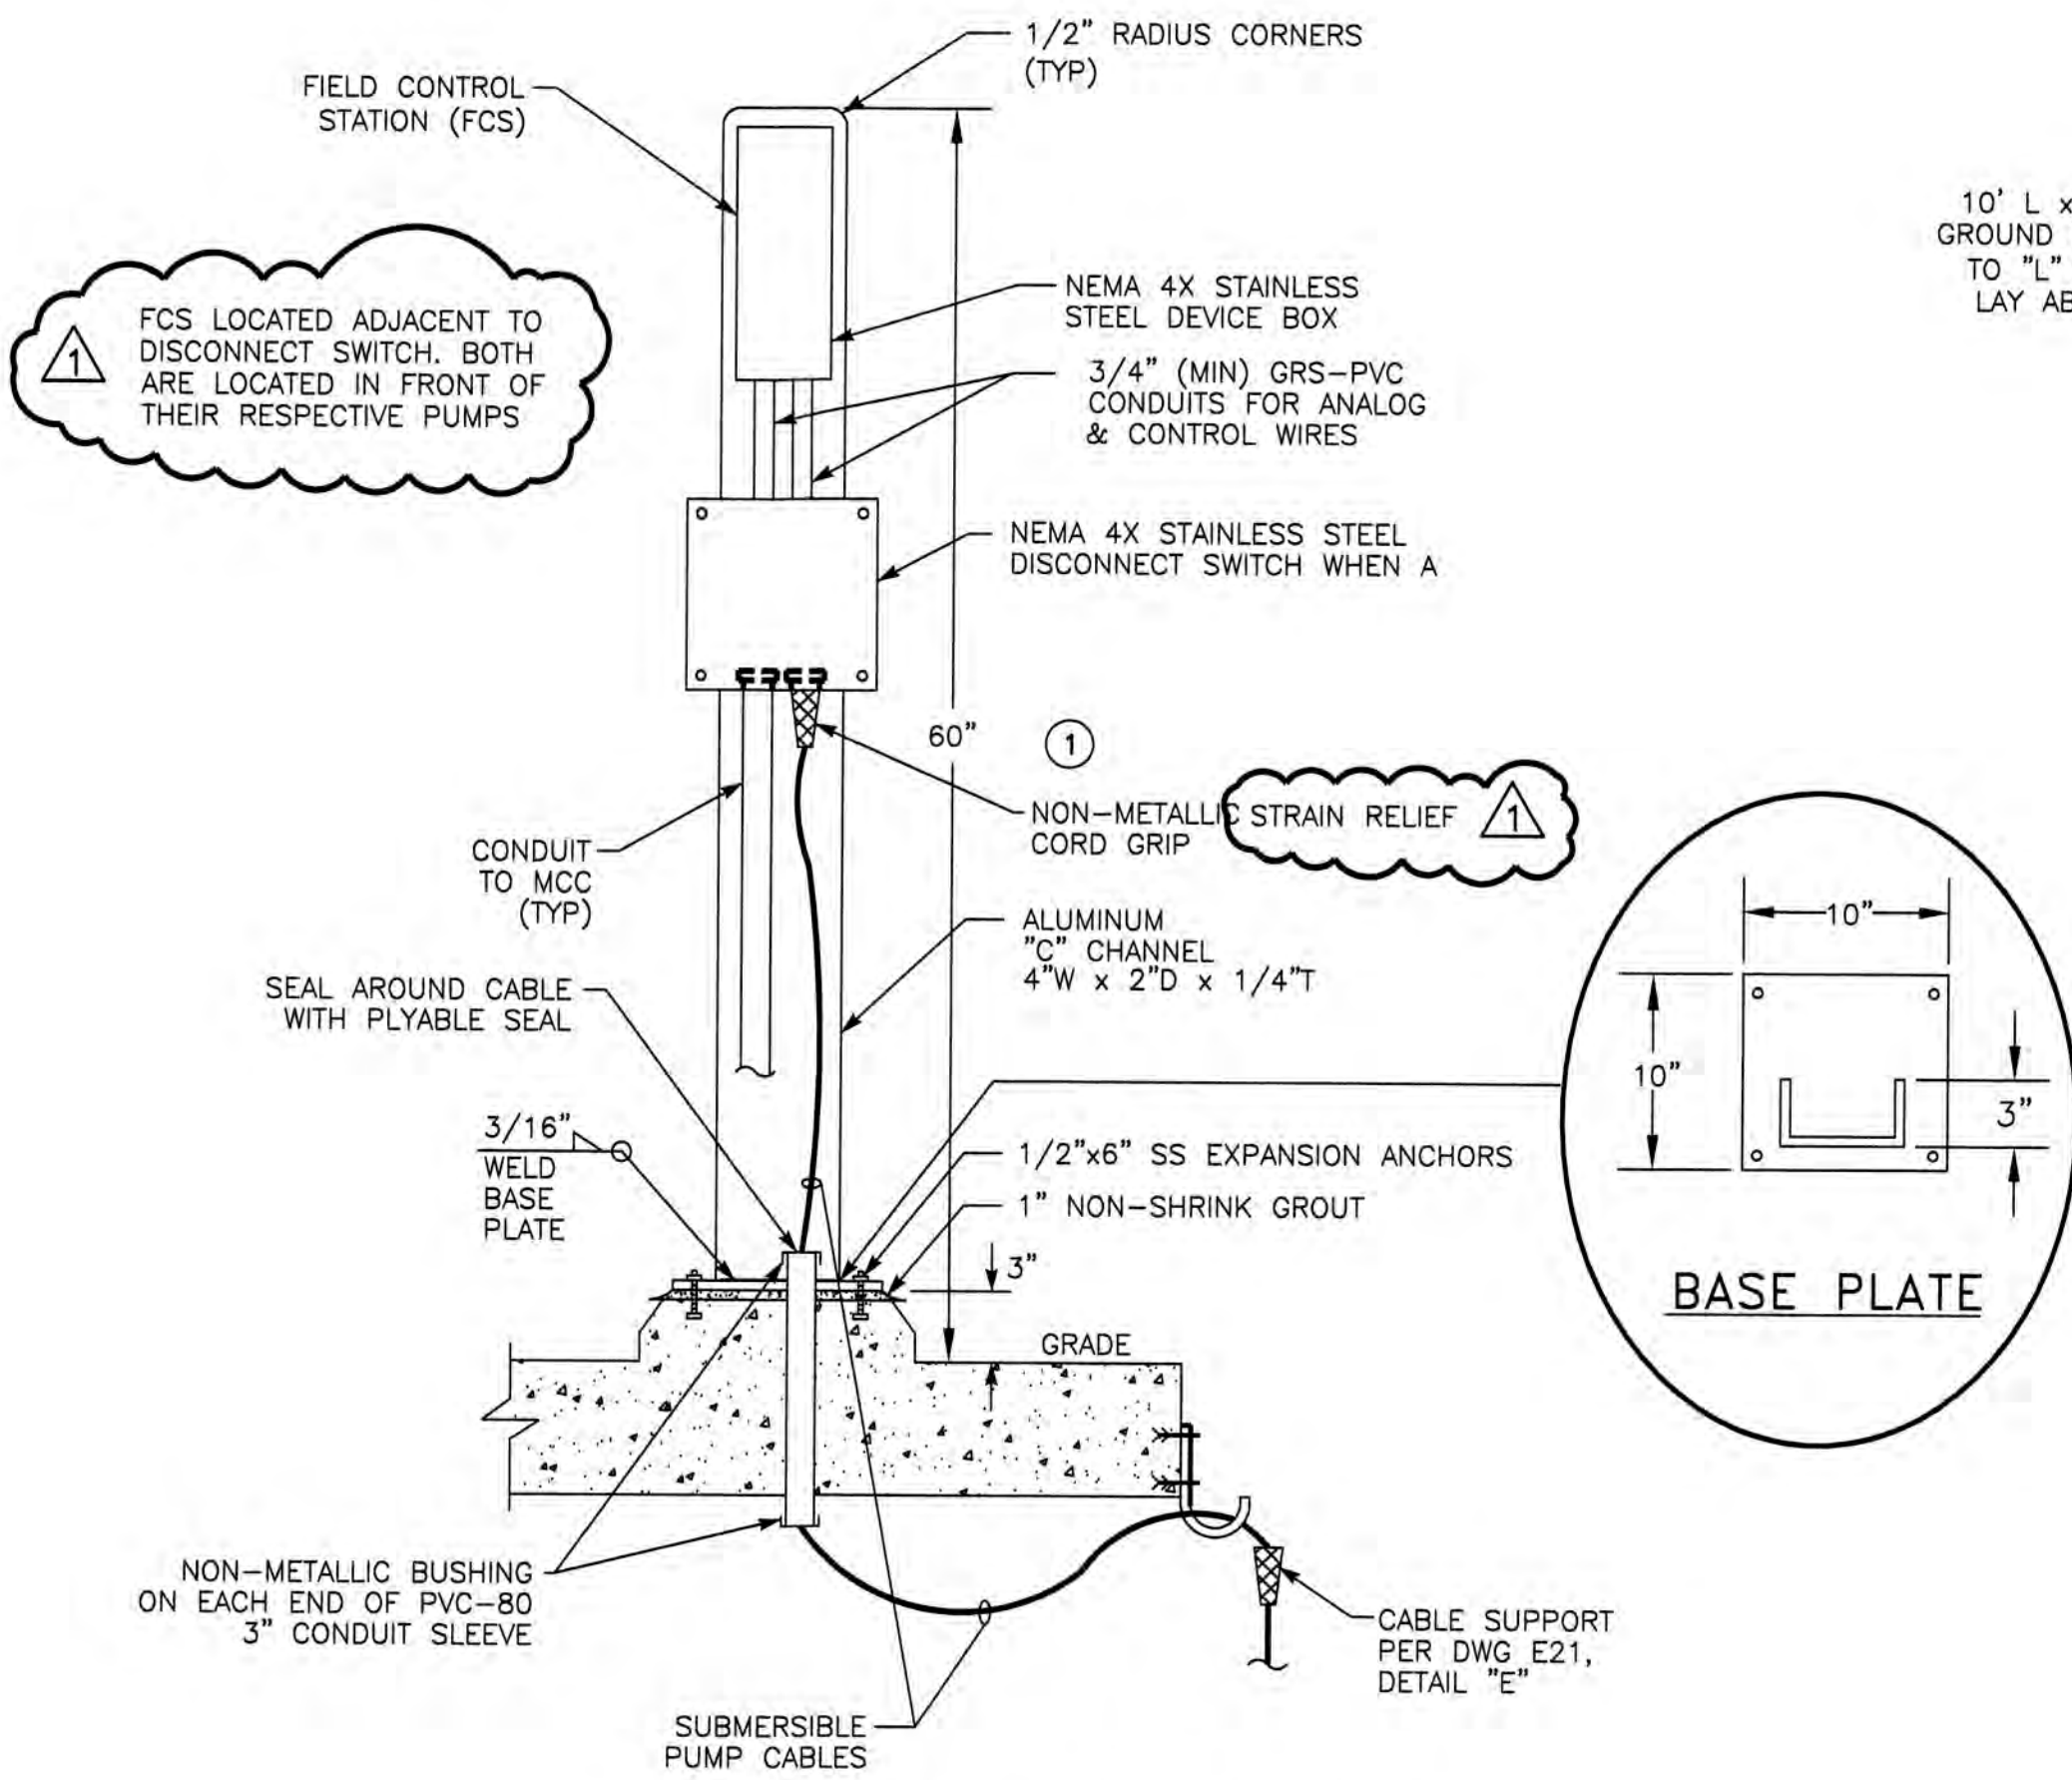

PUMP CABLE ISOLATION (D) E21
NOT TO SCALE DETAIL

- NOTES:
- PLACE SS TRANSITION BOX BELOW DISCONNECT IF DISCONNECT SWITCH DOES NOT HAVE ENTRY AREA FOR ALL CONDUITS.

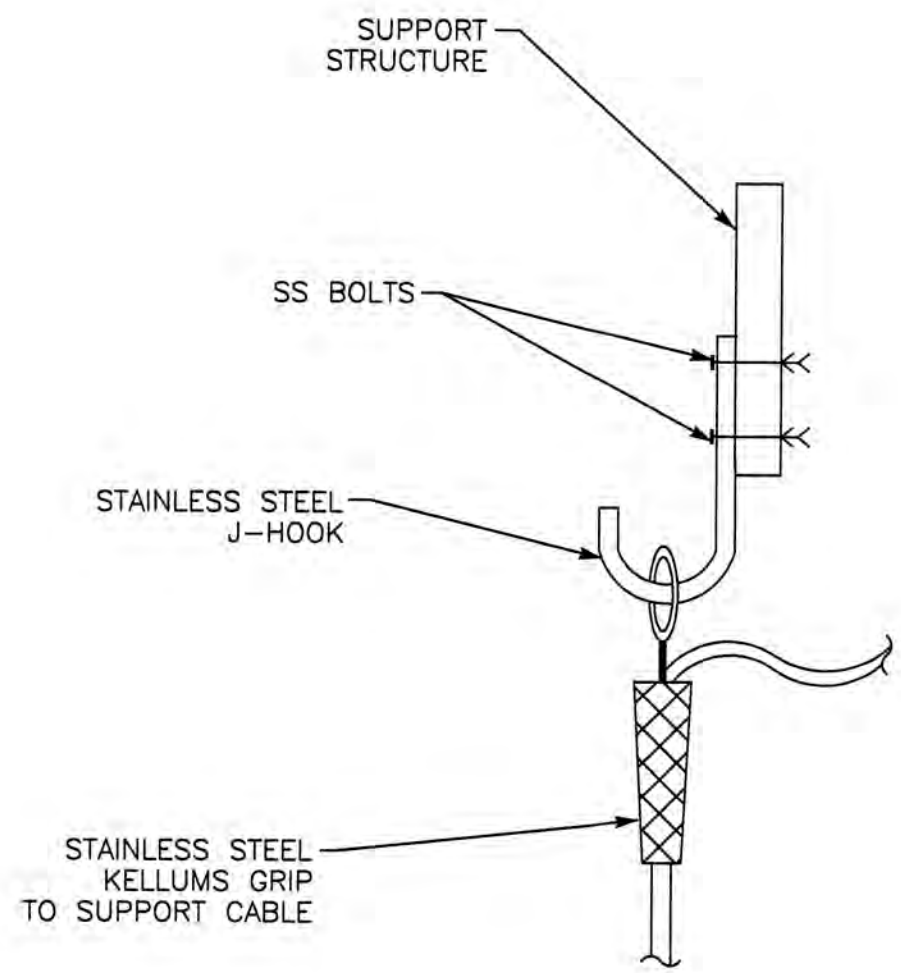

CABLE SUPPORT (E) E21
NOT TO SCALE DETAIL

T.E.E.M.
(916) 457-8144
FILE: 0507C E021


Underground Service Alert
TWO DAYS BEFORE YOU DIG
Call TOLL FREE: 1-800-642-2444

REFER TO BID SET FOR SIGNATURE

REV. No.	DISCRPTION	DATE	BY	APR'D By
1	RECORD DRAWINGS	6/08	CLB	PDF
2				
3				
4				
5				
6				

WEST YOST ASSOCIATES
Consulting Engineers
1260 Lake Boulevard Suite 240 Davis, California 95616
(530) 756-5905 FAX (530) 756-5991


RECORD DRAWINGS		
14-Mile Slough Pump Station Upgrades		
TYPICAL ELECTRICAL DETAILS NO.1		
SCALE: NONE	APPROVED BY: DATE:	SHEET No.
DESIGNED BY: SMK		E21
DRAWN BY: ZK		79 of 89 SHEETS
CHECKED BY: XML	ASSISTANT DIRECTOR, DEPT. OF MUNICIPAL UTILITIES	PROJECT No. 293-00-05-01
RECORD Dwg.:		

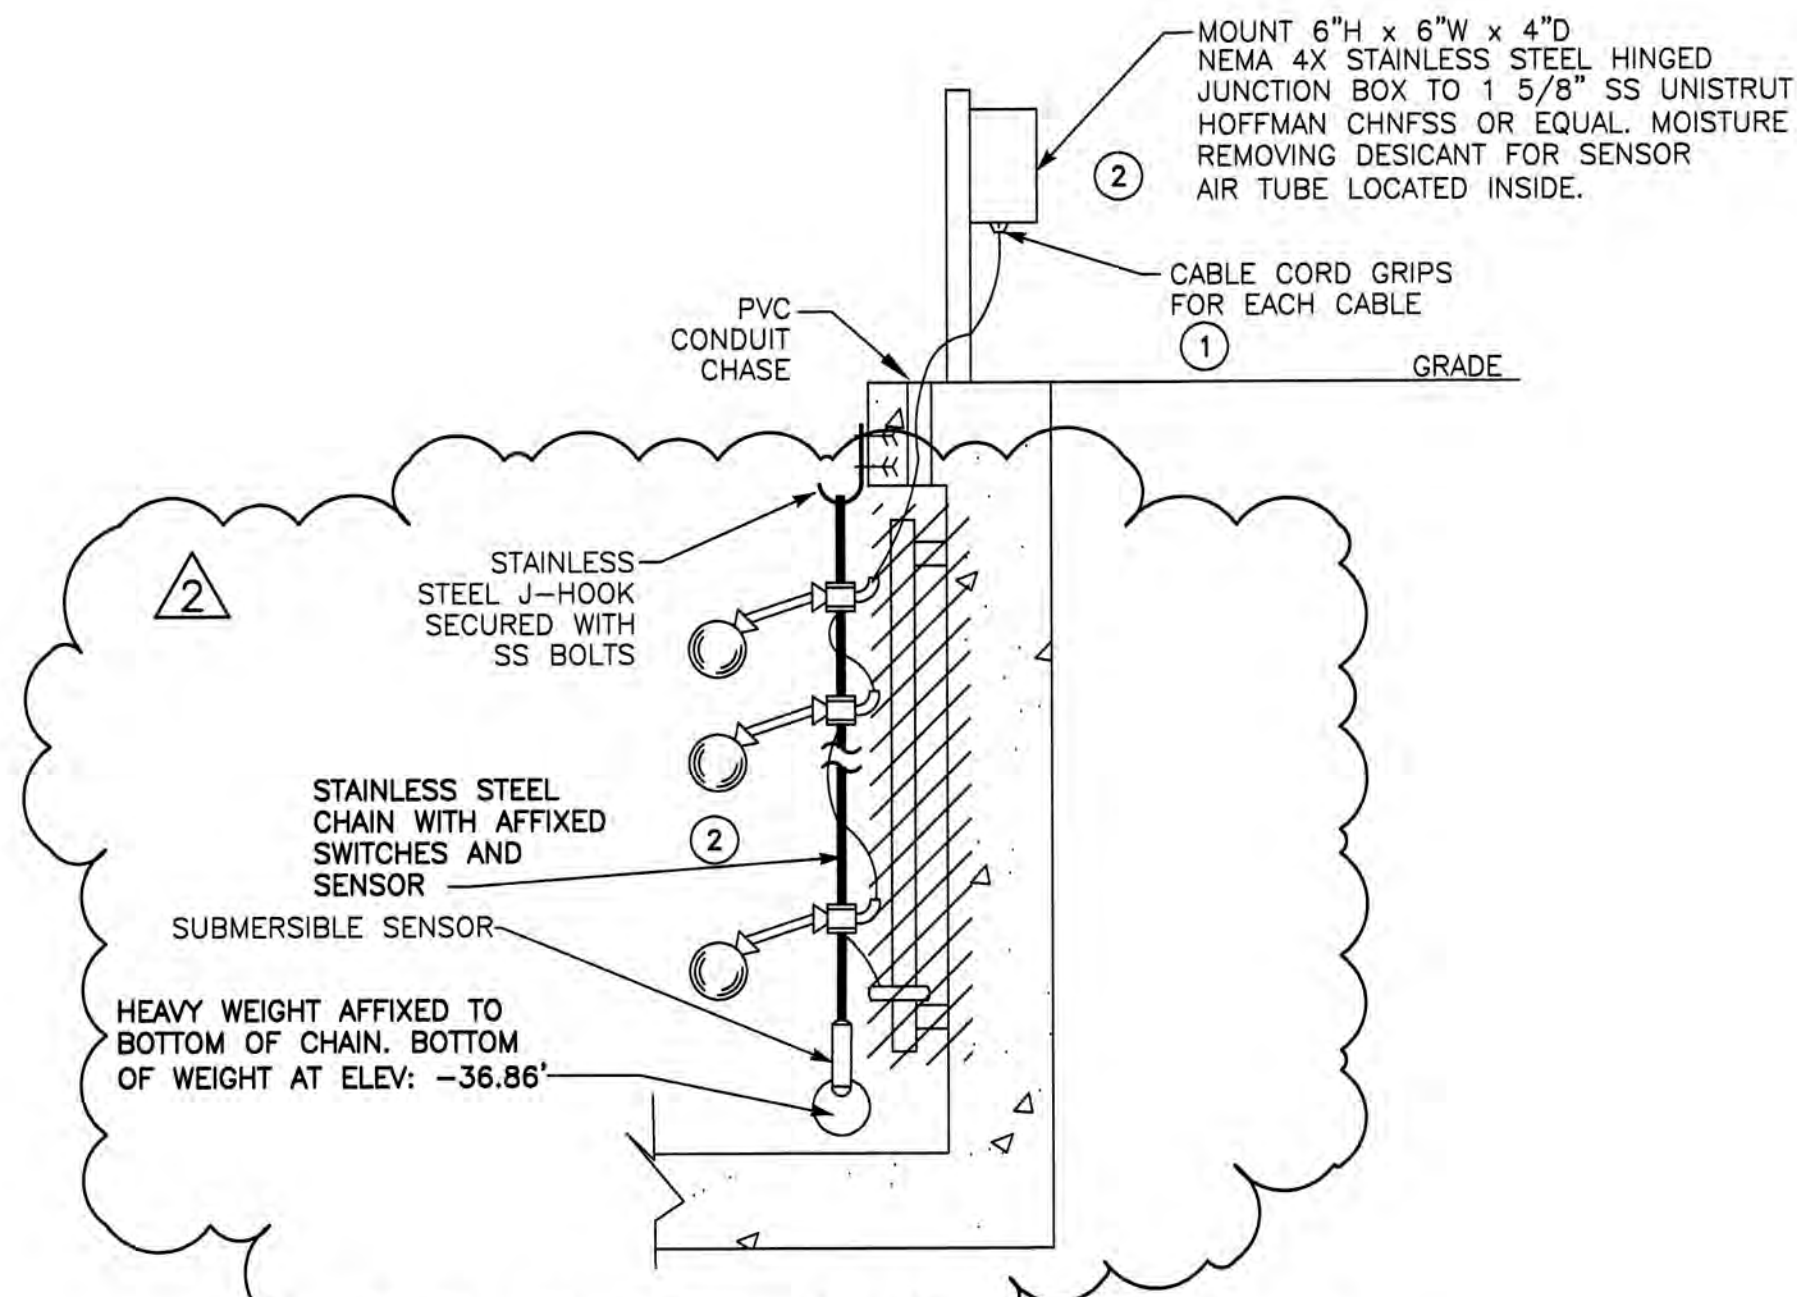

SUBMERSIBLE LEVEL TRANSMITTER & FLOAT SWITCH CABLE (A) E22

NOT TO SCALE

- NOTES: ① ATTACH CABLE TO JUNCTION BOX WITH NYLON FITTING, STAINLESS STEEL CORD GRIP; HUBBELL/KELLEMS SERIES 74 OR EQUAL.
- ② LEVEL SWITCHES TO BE SUSPENDED WITH STAINLESS STEEL CABLE MOUNTING KIT. CONSOLIDATED ELECTRIC OR APPROVED EQUAL.

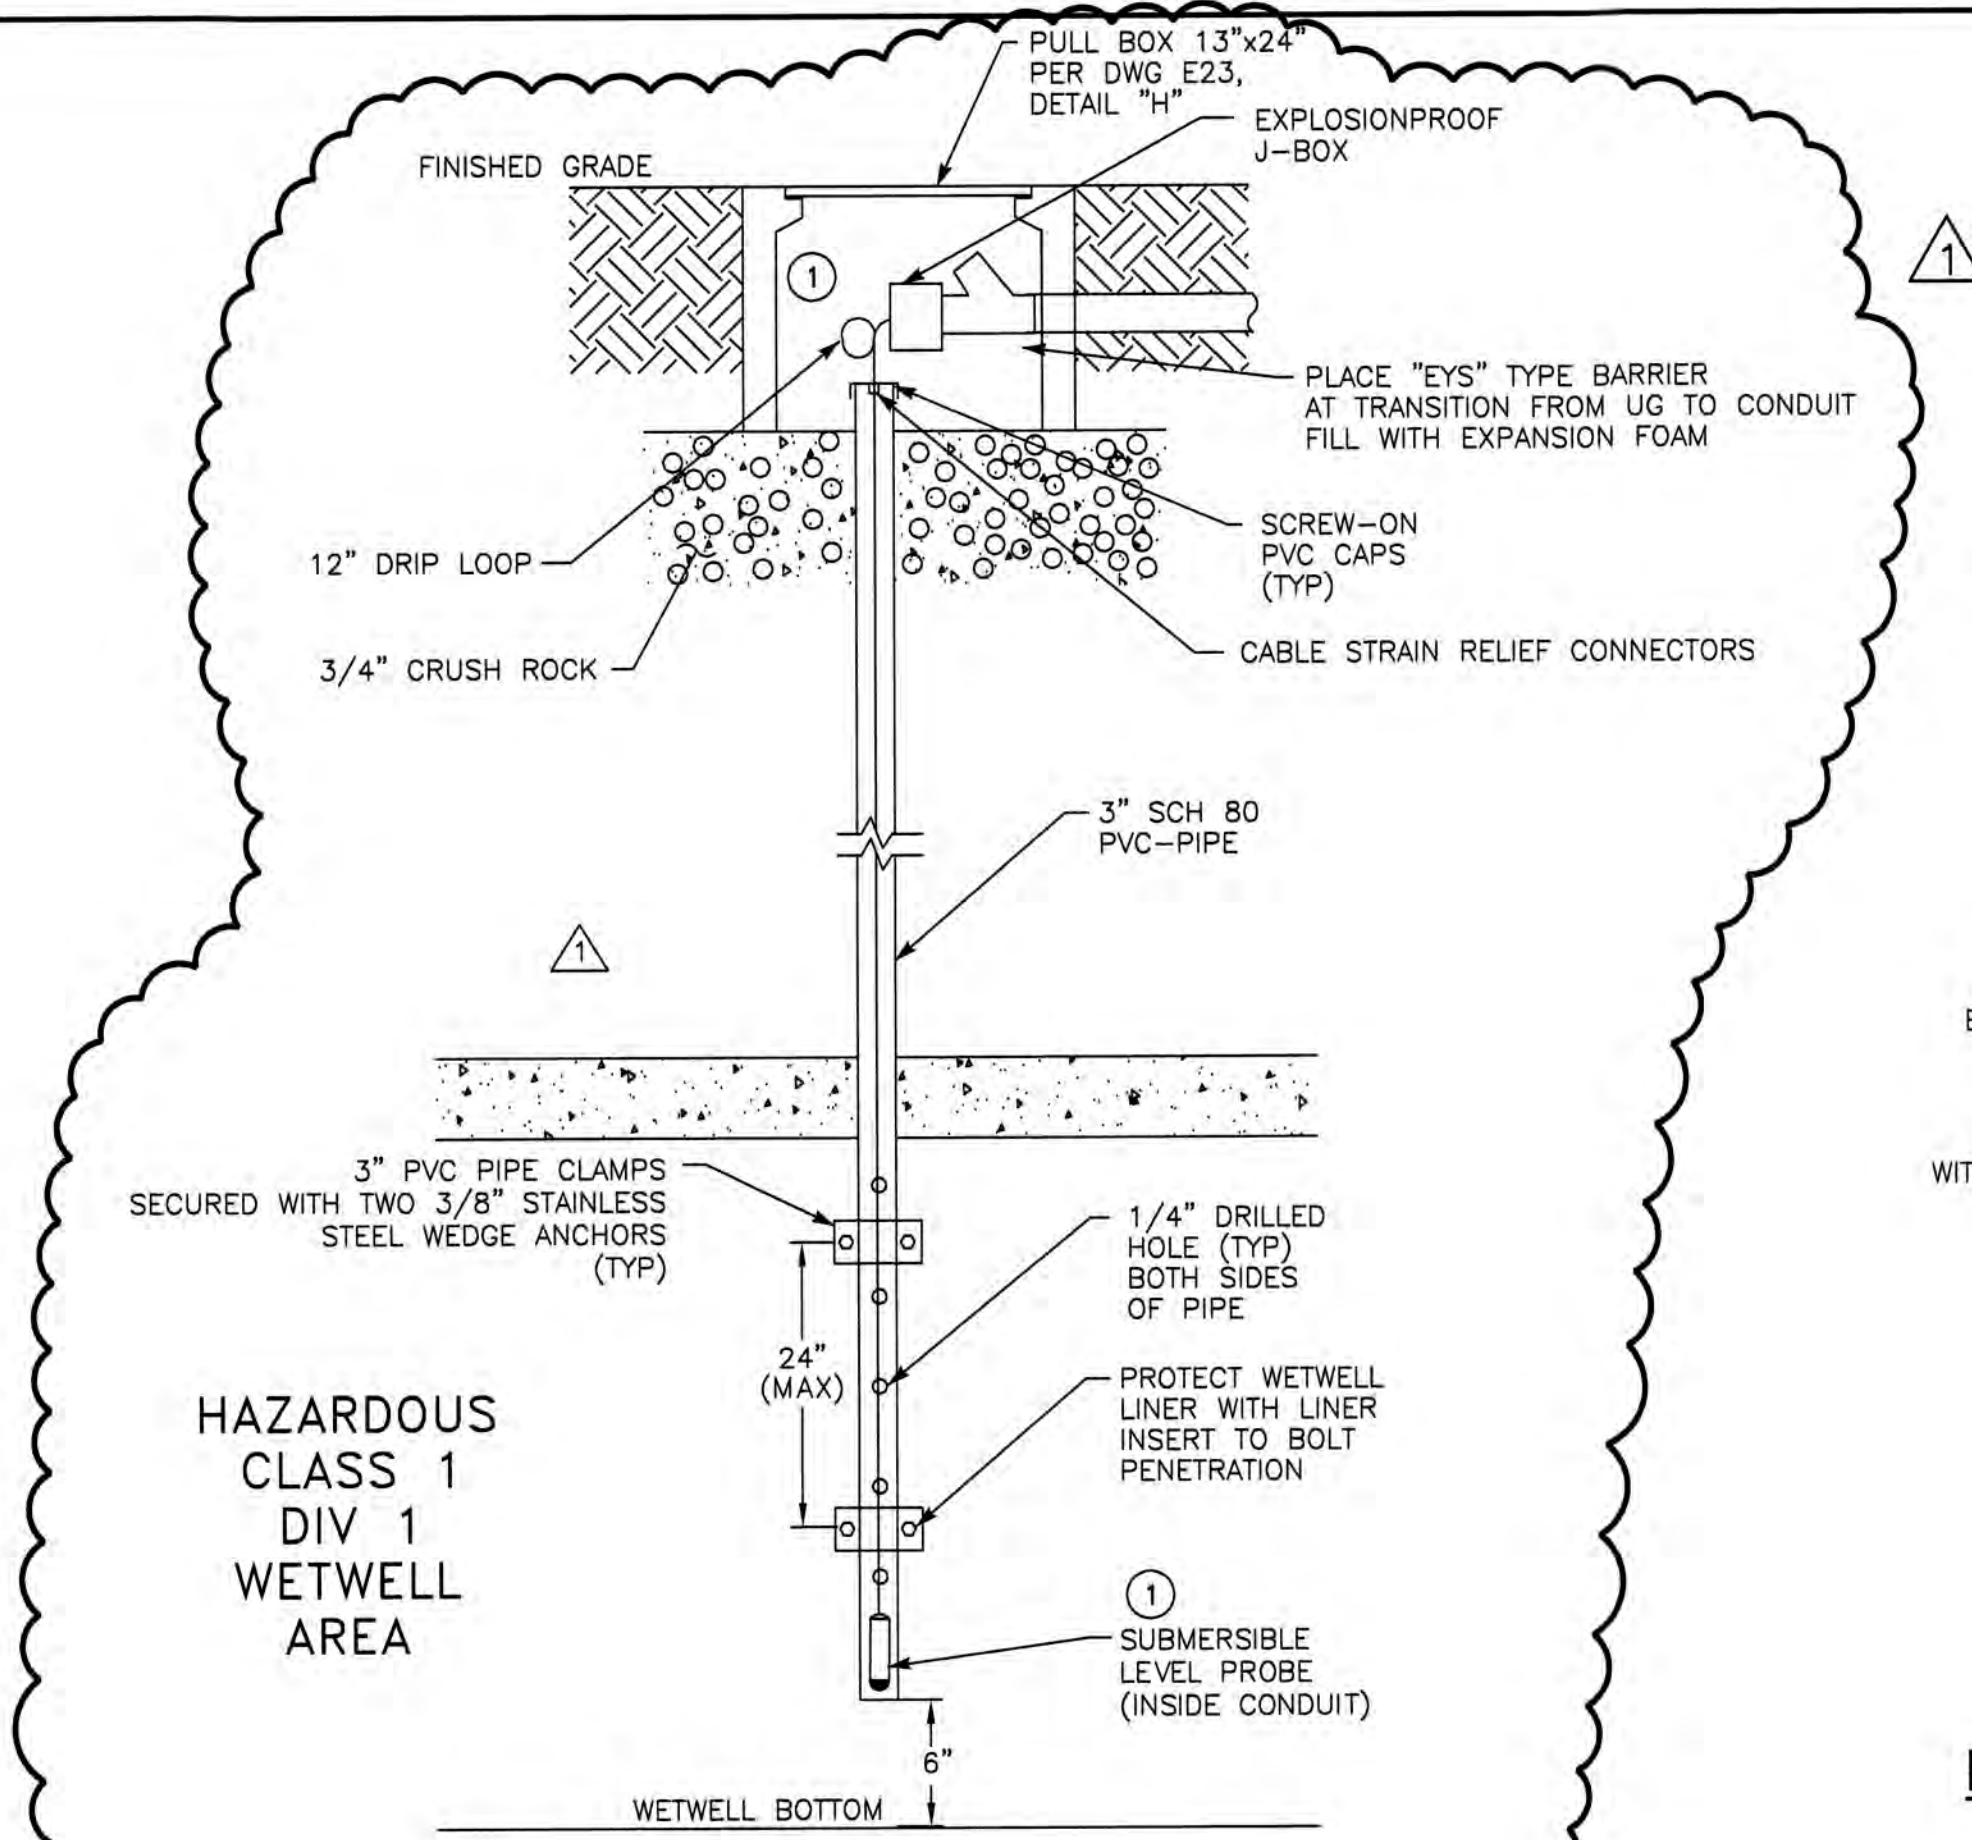


HAZARDOUS CLASS 1 DIV 1 WETWELL AREA (B) E22

SUBMERSIBLE LEVEL TRANSMITTER (B) E22


NOT TO SCALE

- NOTES: ① INSTALL MOISTURE REMOVING DESSICANT FOR SENSOR AIR TUBE.

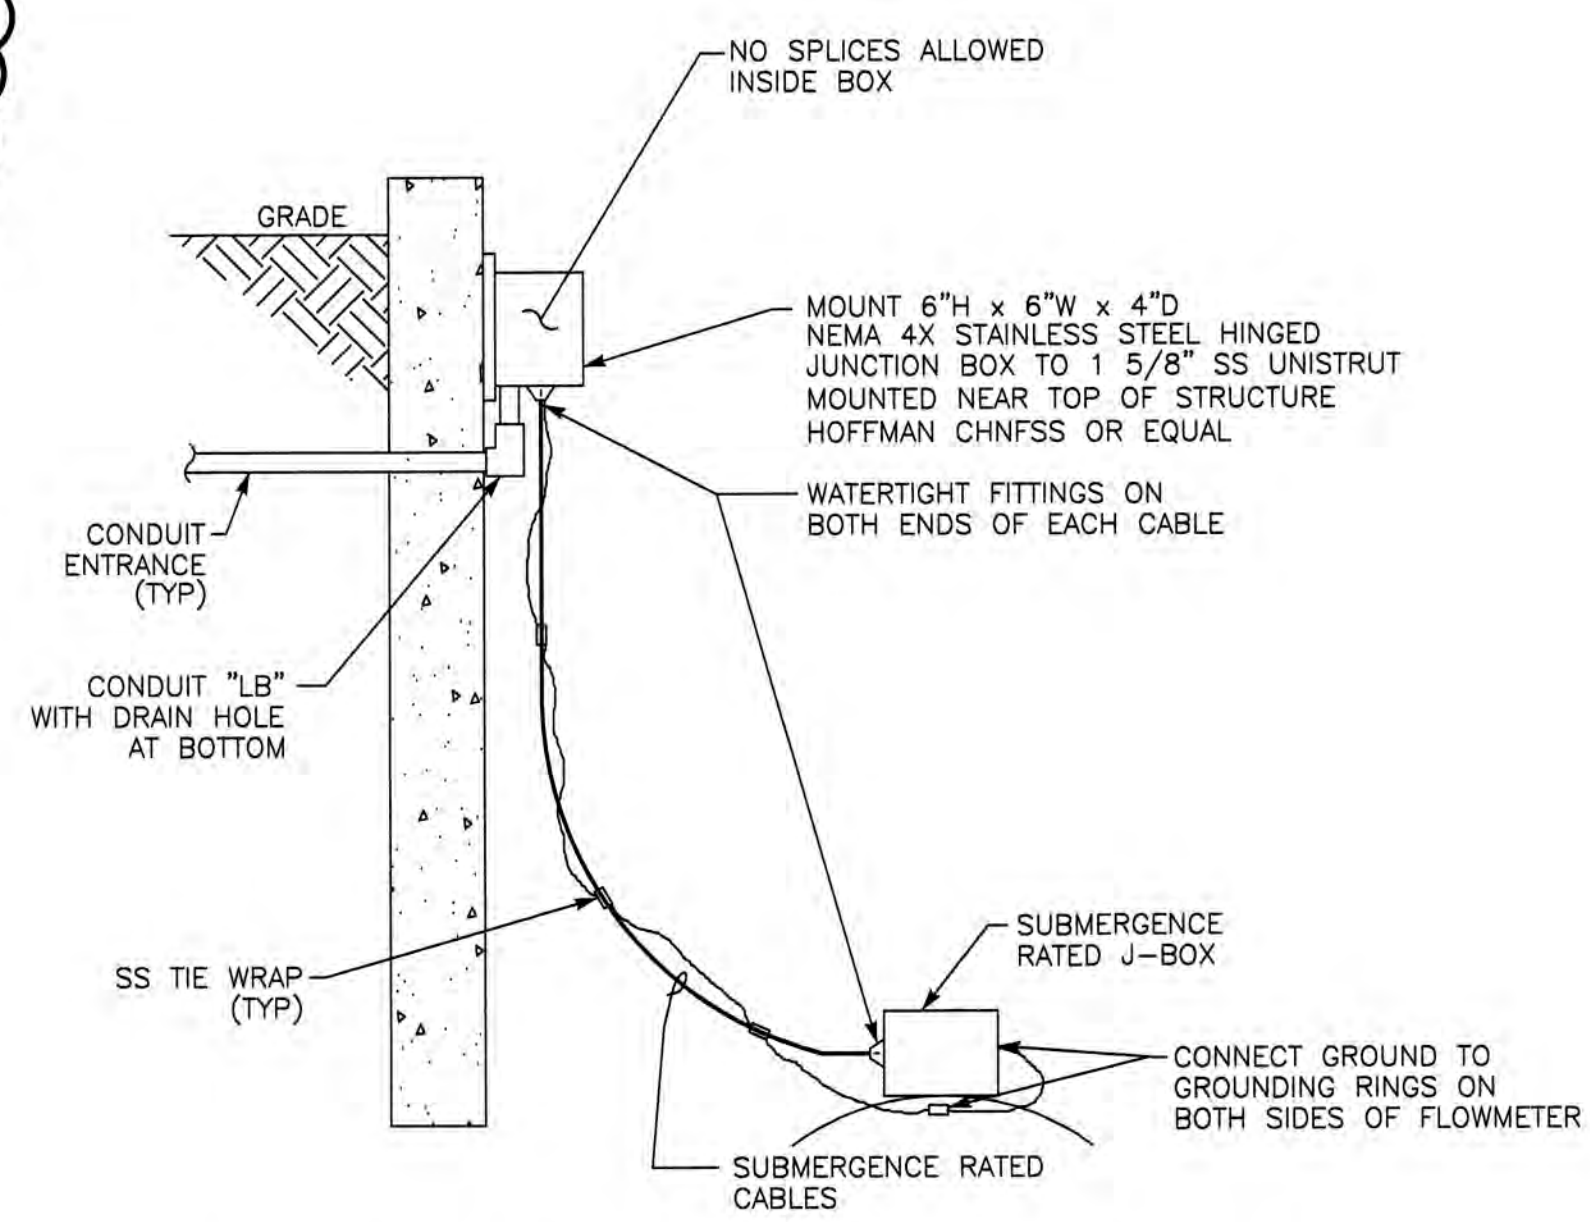


BELOW GRADE FLOWMETER INSTALLATION (C) E22

NOT TO SCALE

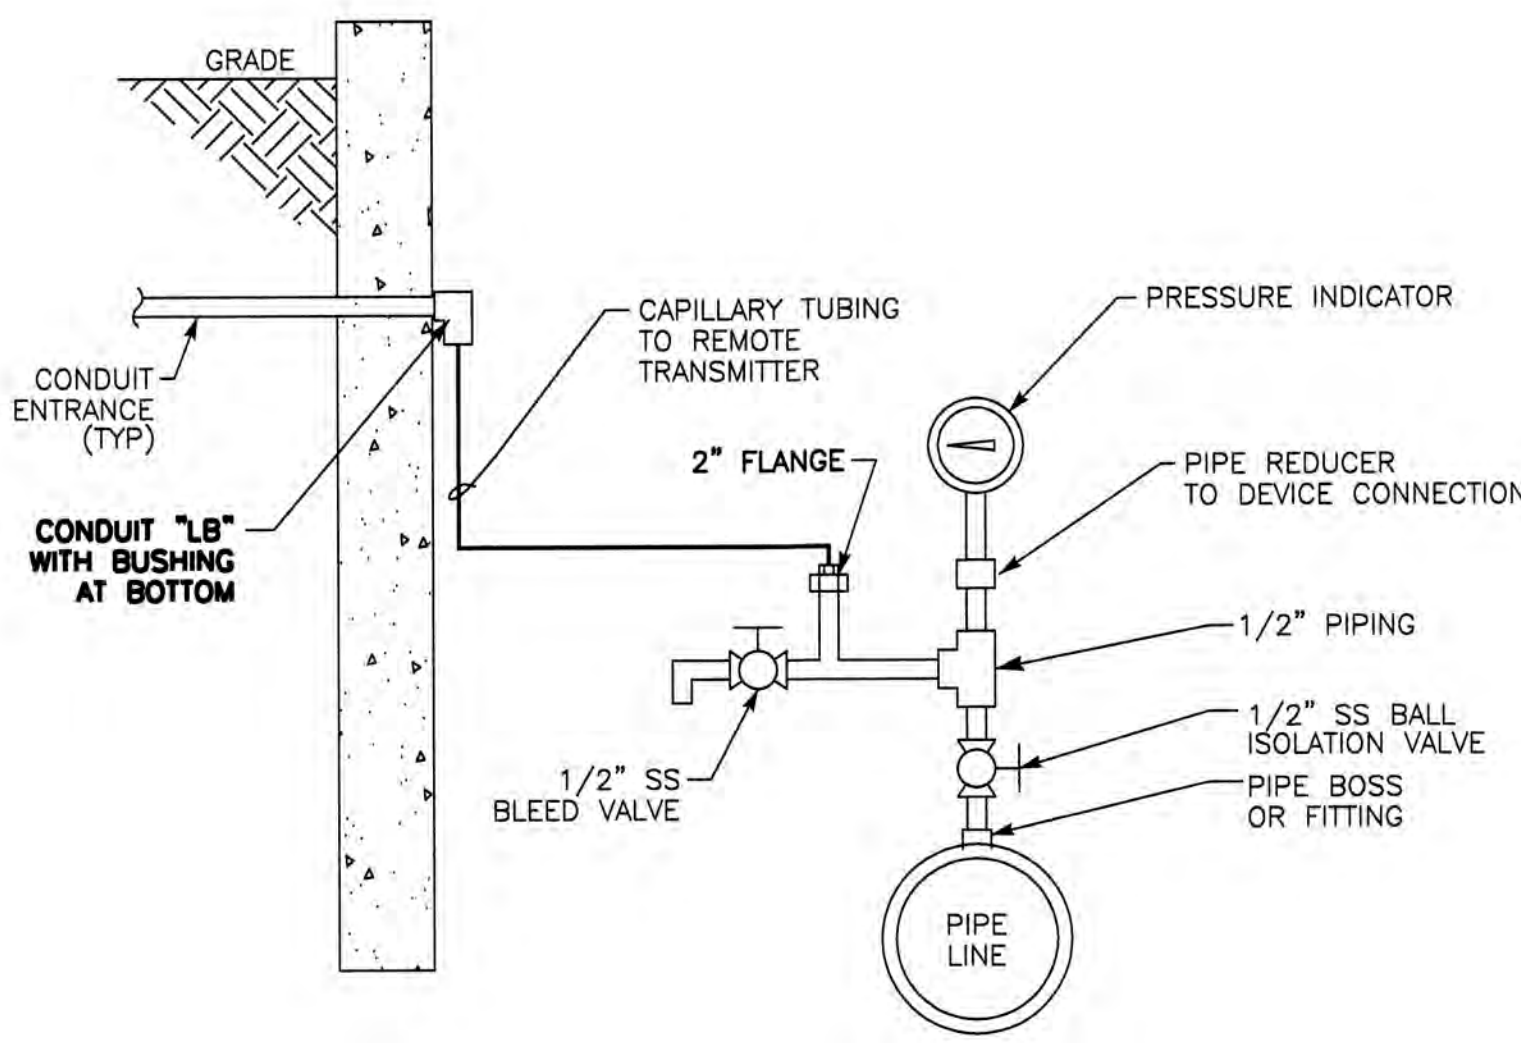

PRESSURE INDICATOR (D) E22


NOT TO SCALE

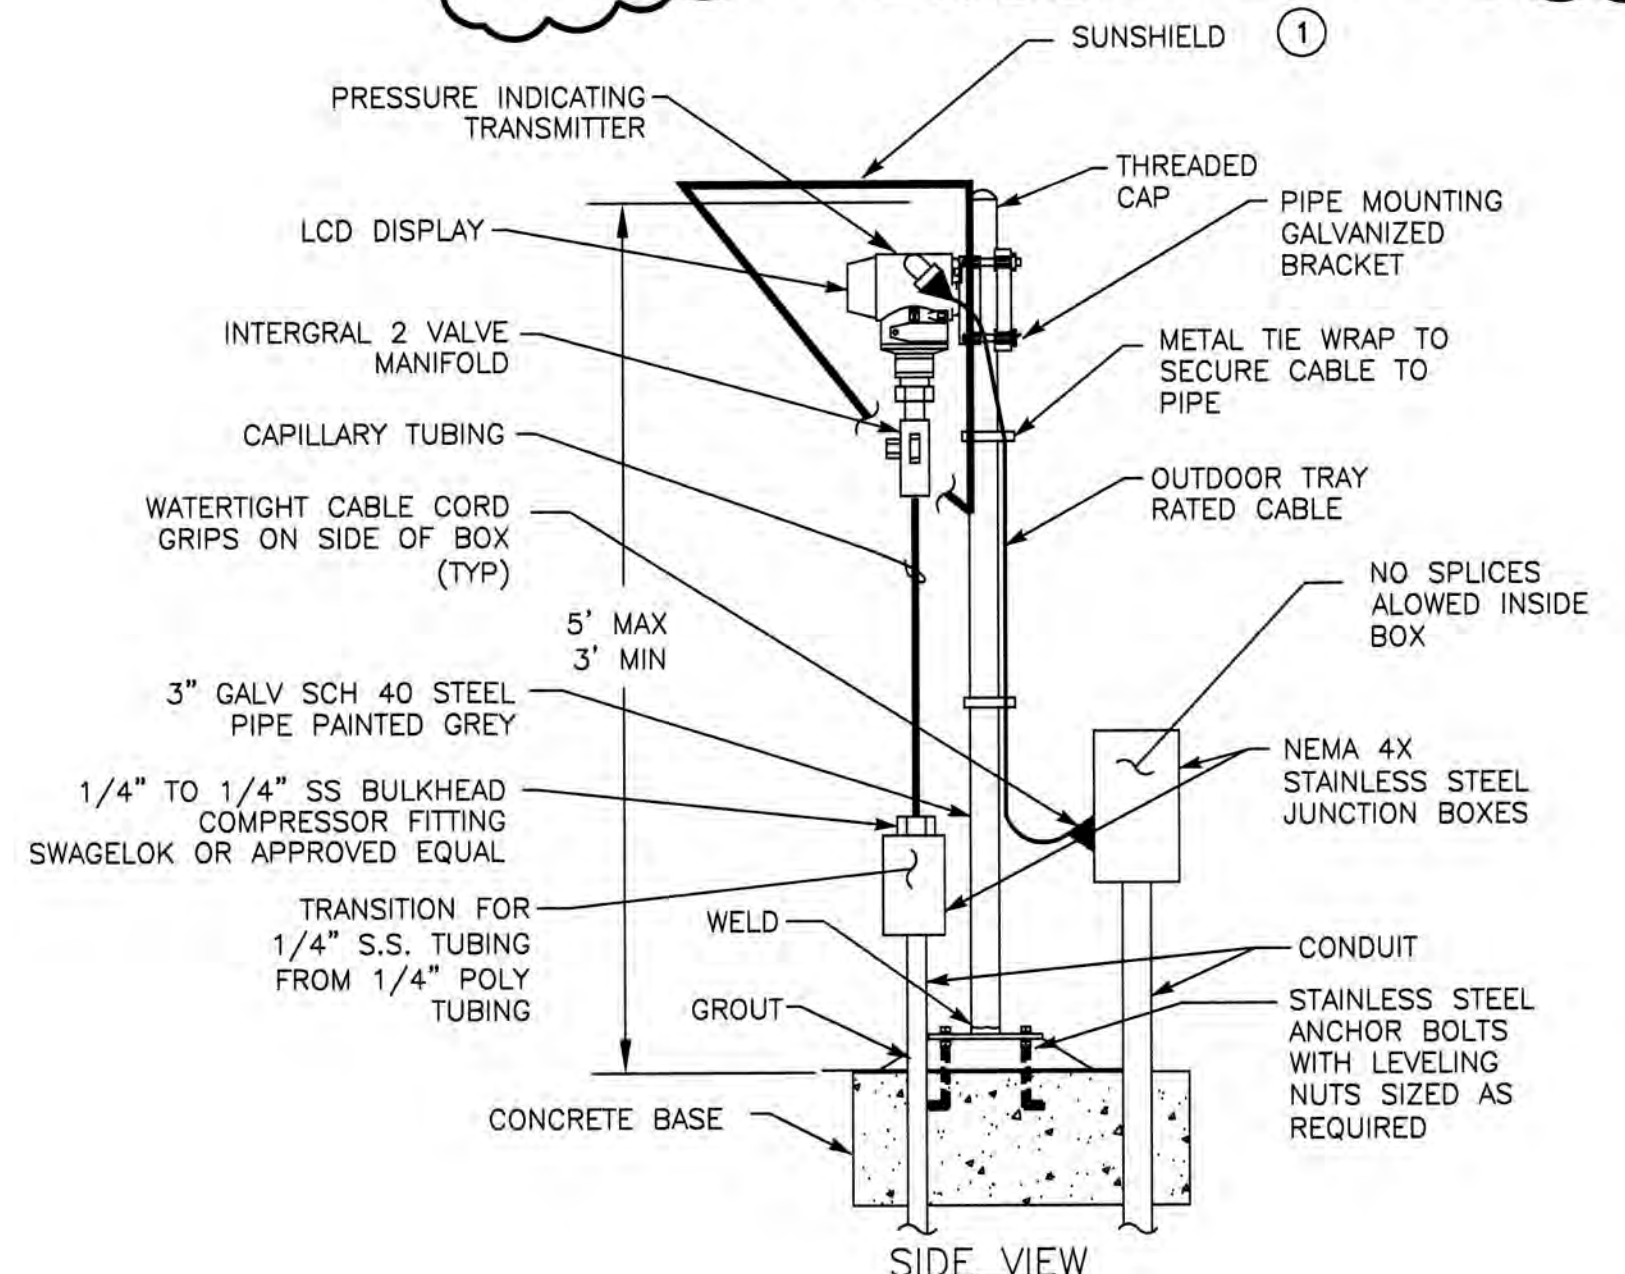

FLOOR PIPE SUPPORT (E) E22

NOT TO SCALE

- NOTES: ① USA BLUEBOOK SUNSHIELD OR EQUAL.

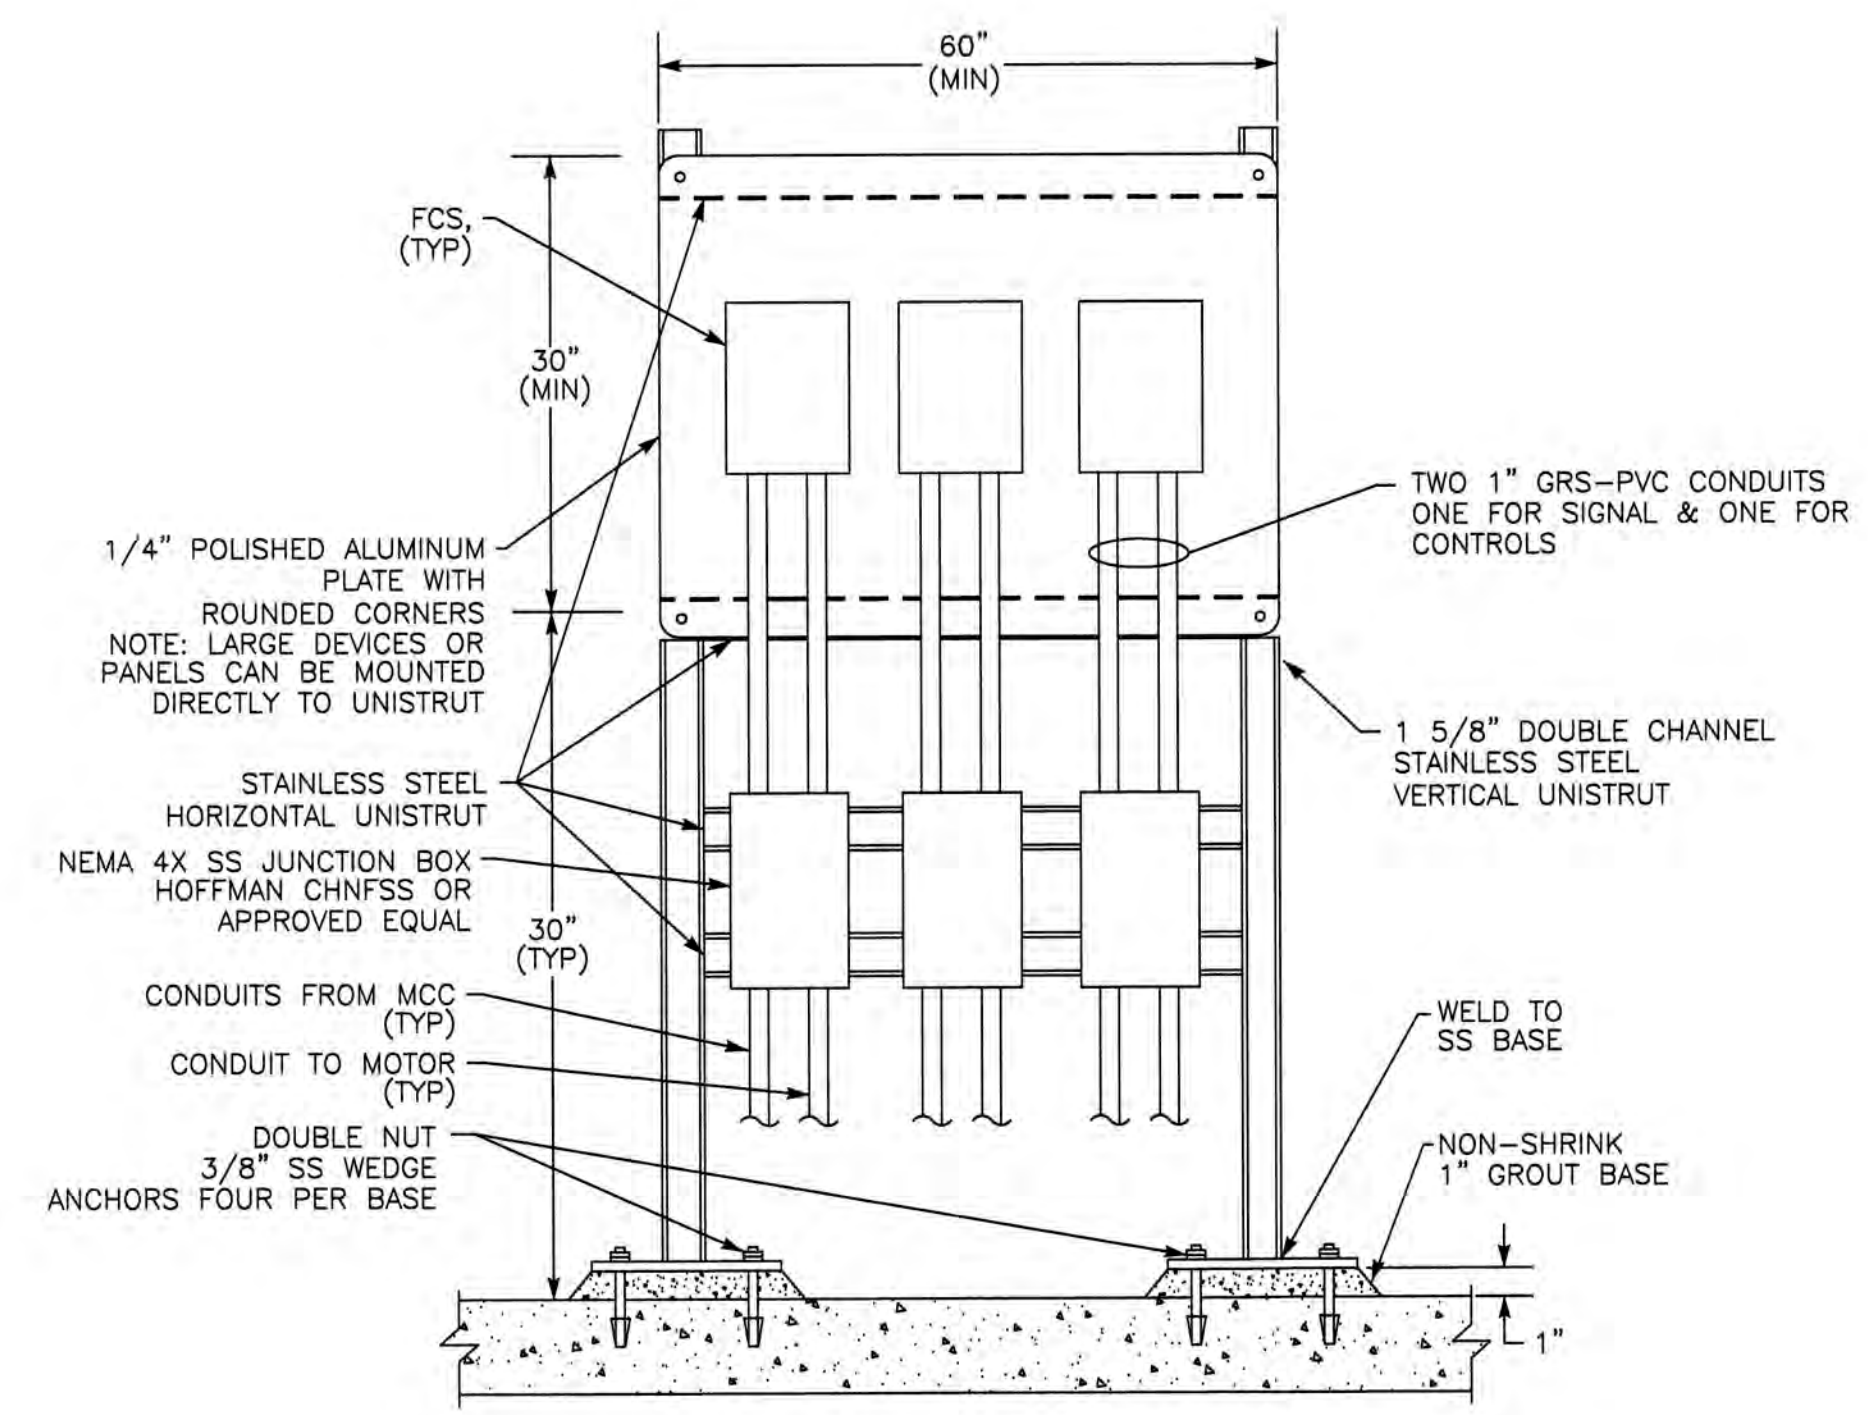

FCS SUPPORT (G) E22

NOT TO SCALE



REFER TO SET FOR SIGNATURE





REV. No.	DISCRPTION	DATE	BY	Aprv'd By
1	LP150 ON SHEET E14	2/07	SK	PDF
2	RECORD DRAWINGS	8/08	CLB	PDF
3				
4				
5				
6				

WEST YOST ASSOCIATES
 Consulting Engineers
 1260 Lake Boulevard Suite 240
 Davis, California 95616
 (530) 756-5905
 FAX (530) 756-5991





RECORD DRAWINGS
14-Mile Slough Pump Station Upgrades
 TYPICAL ELECTRICAL DETAILS NO.2

DEPARTMENT OF MUNICIPAL UTILITIES
 CITY OF STOCKTON, CALIFORNIA

SCALE:	APPROVED BY: DATE:	SHEET No.
DESIGNED BY: SMK		E22
DRAWN BY: ZK		80 of 89 SHEETS
CHECKED BY: XML	ASSISTANT DIRECTOR, DEPT. OF MUNICIPAL UTILITIES	PROJECT No. 293-00-05-01
RECORD DWG.:		

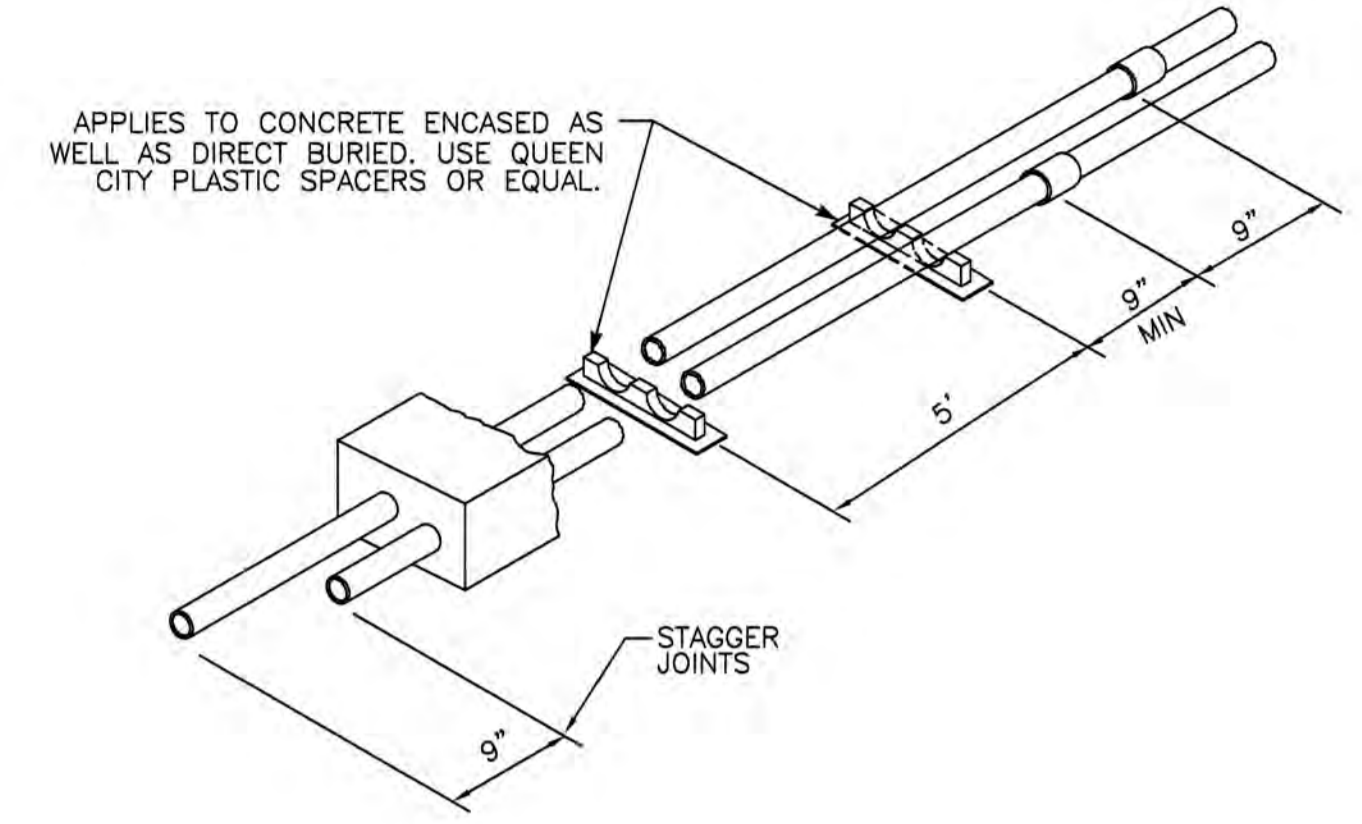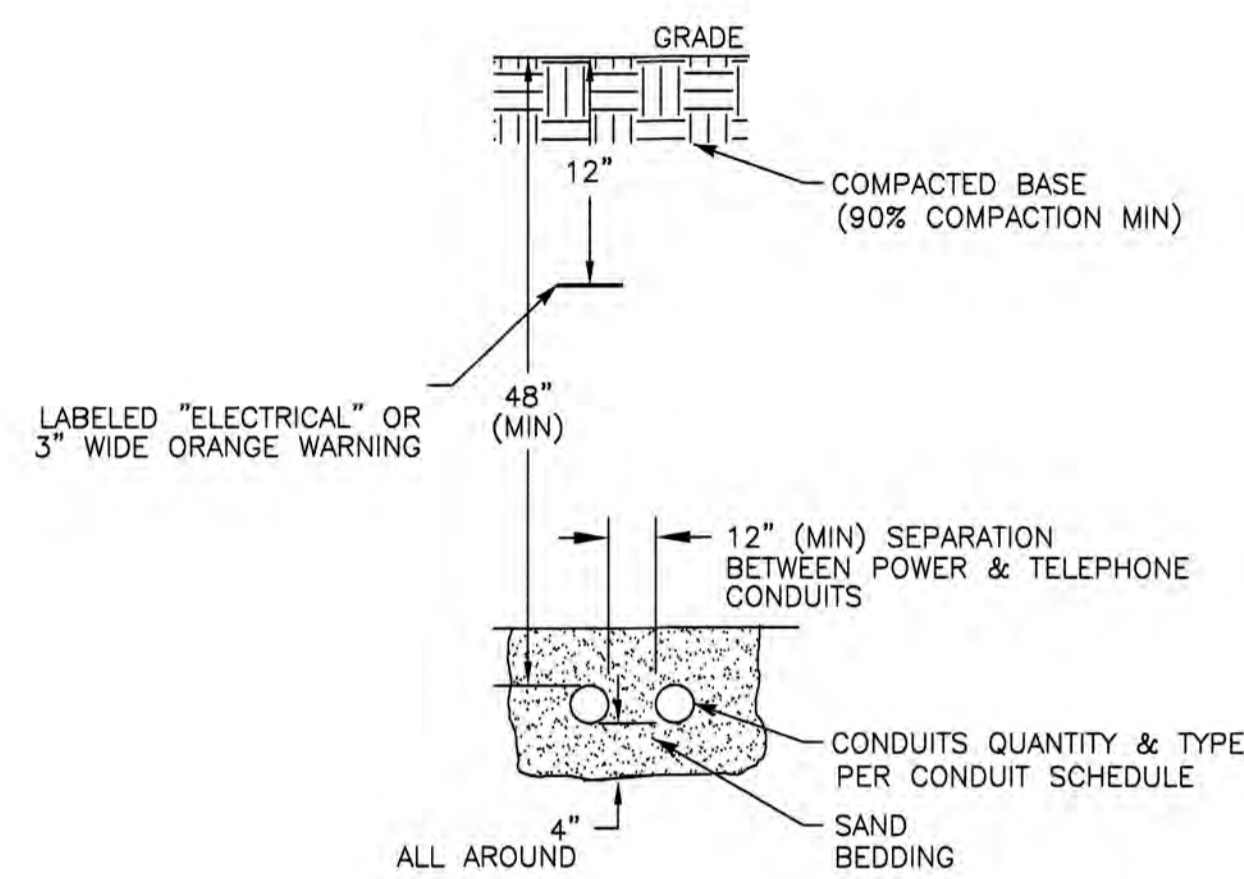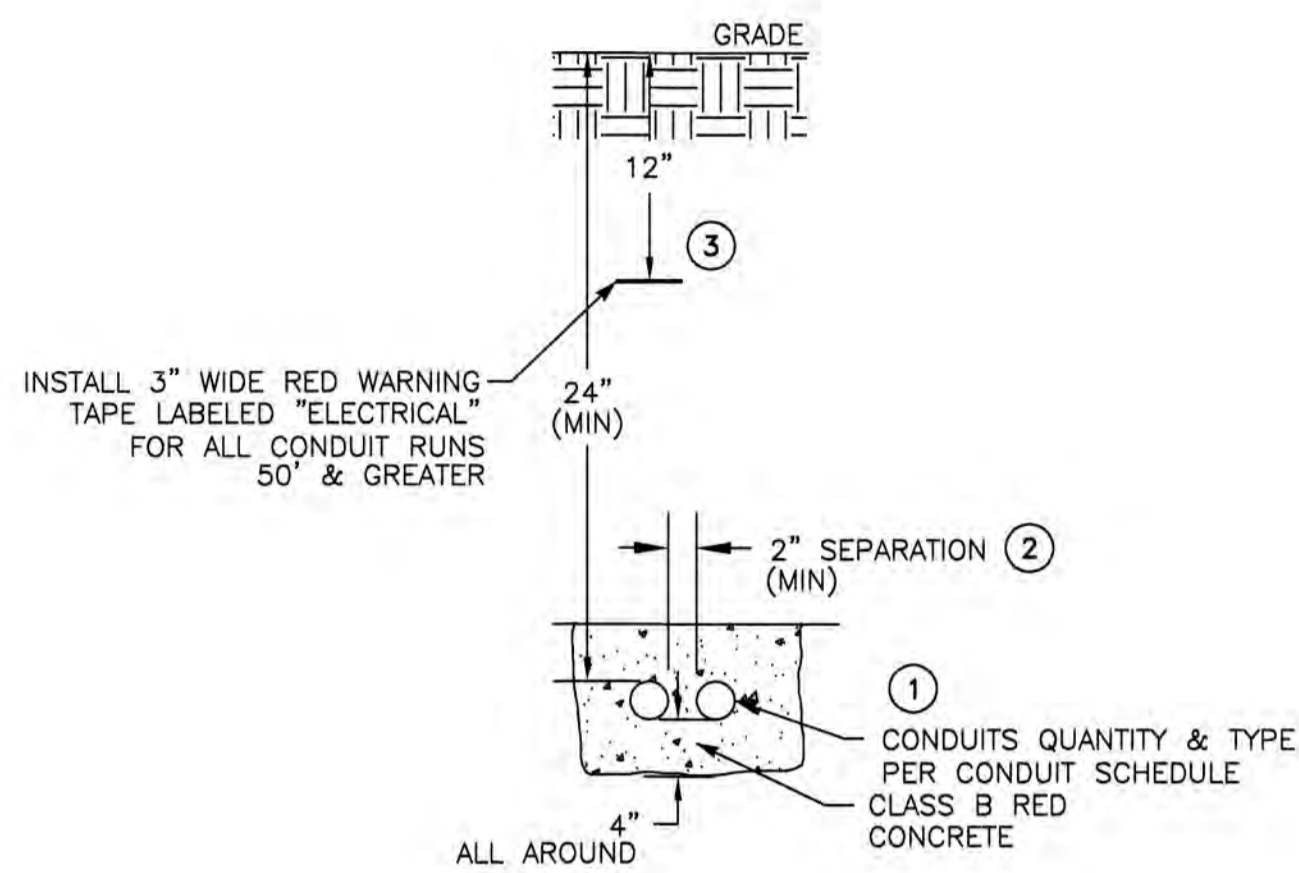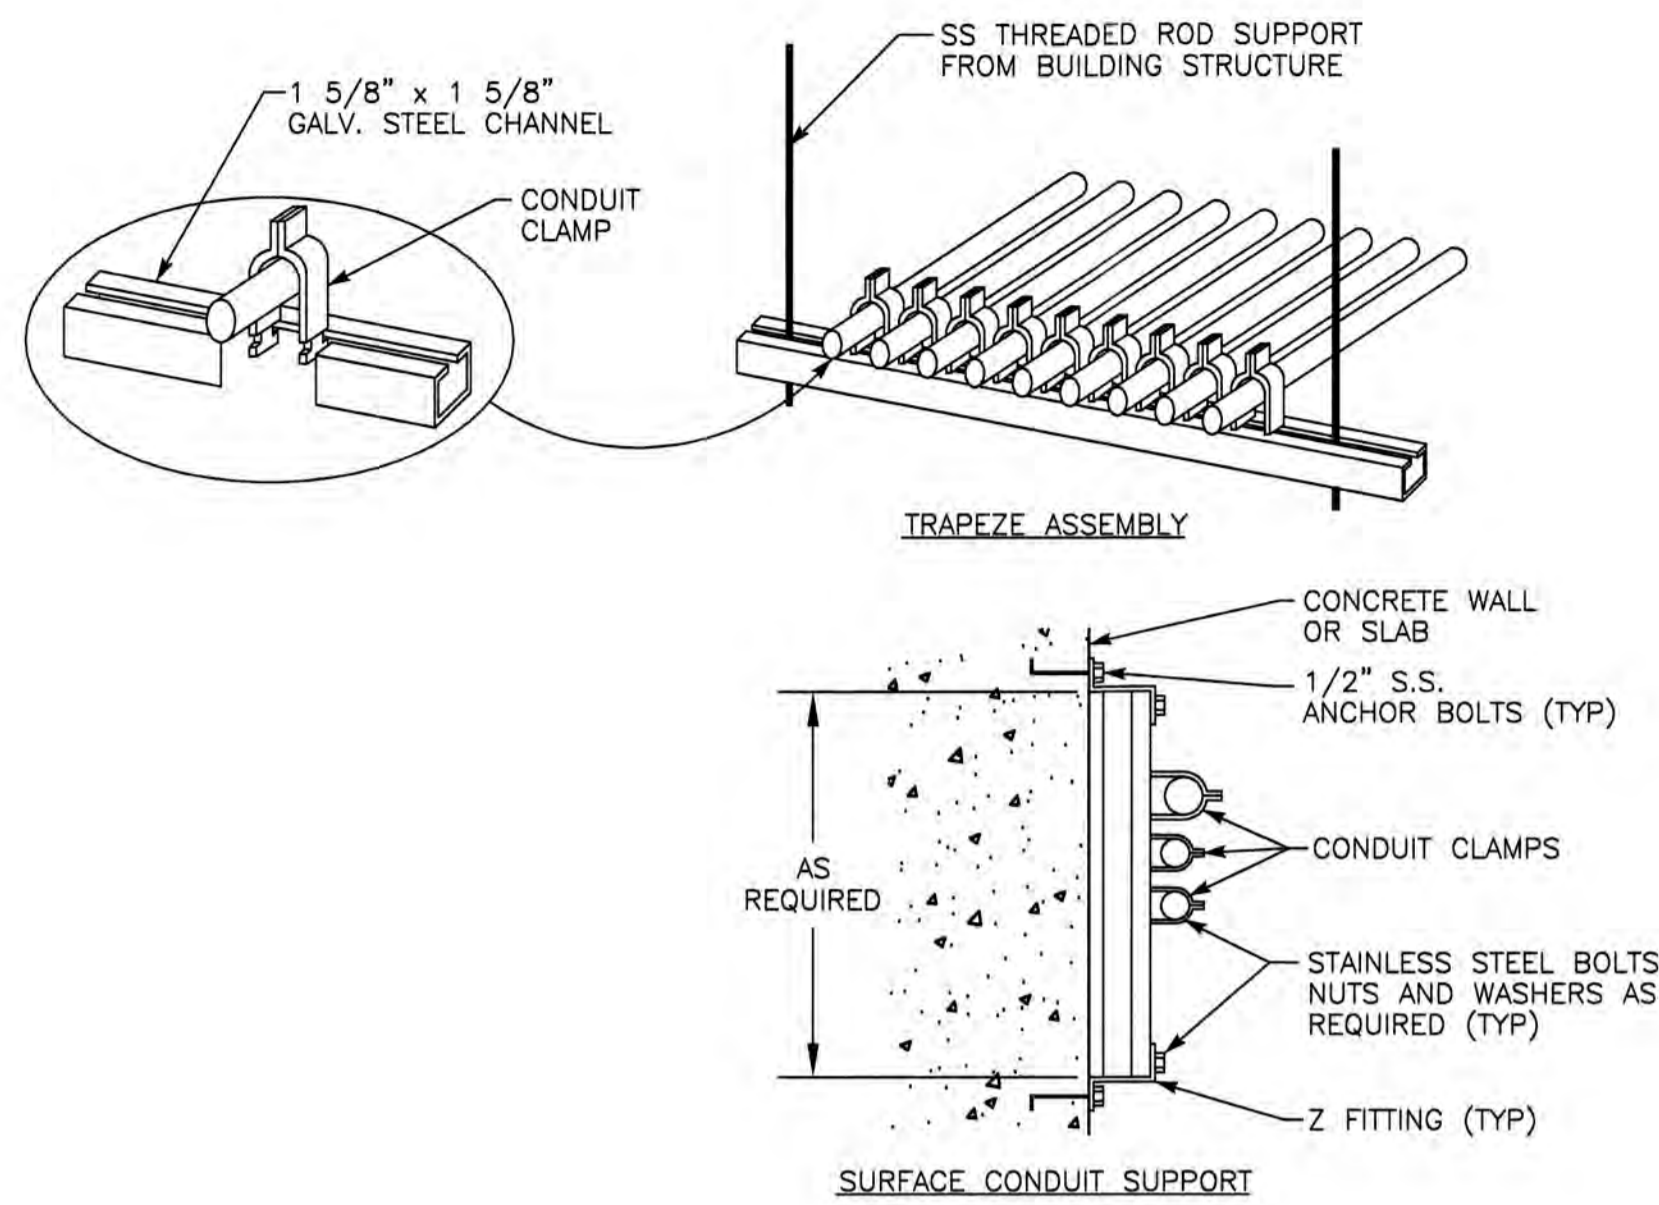

- NOTES: ① PLACE CONDUIT RUNS OF 4 CONDUITS OR GREATER IN PLASTIC SPACERS (RATED FOR DIRECT BURIAL) EVERY 5' ALONG LENGTH OF RUN.
② PROVIDE 12" (MIN) SEPARATION BETWEEN "A, C & D" TYPE GROUP AND "L & P" TYPE GROUP CONDUITS.
③ TRENCHING & COMPACTED BACKFILL PER SPECIFICATIONS SECTION 02300-EARTHWORK.

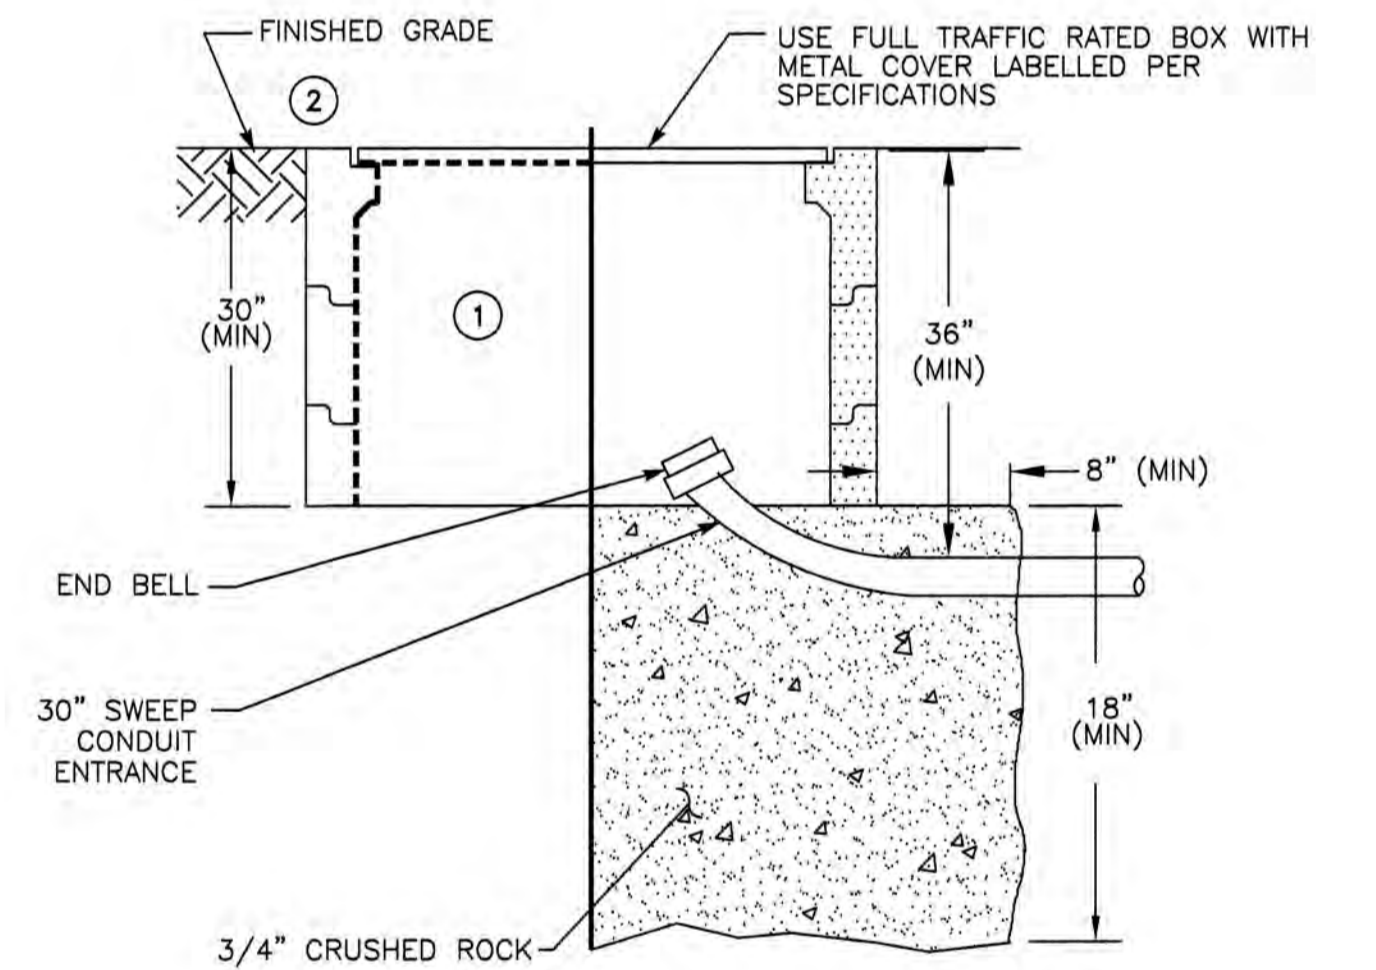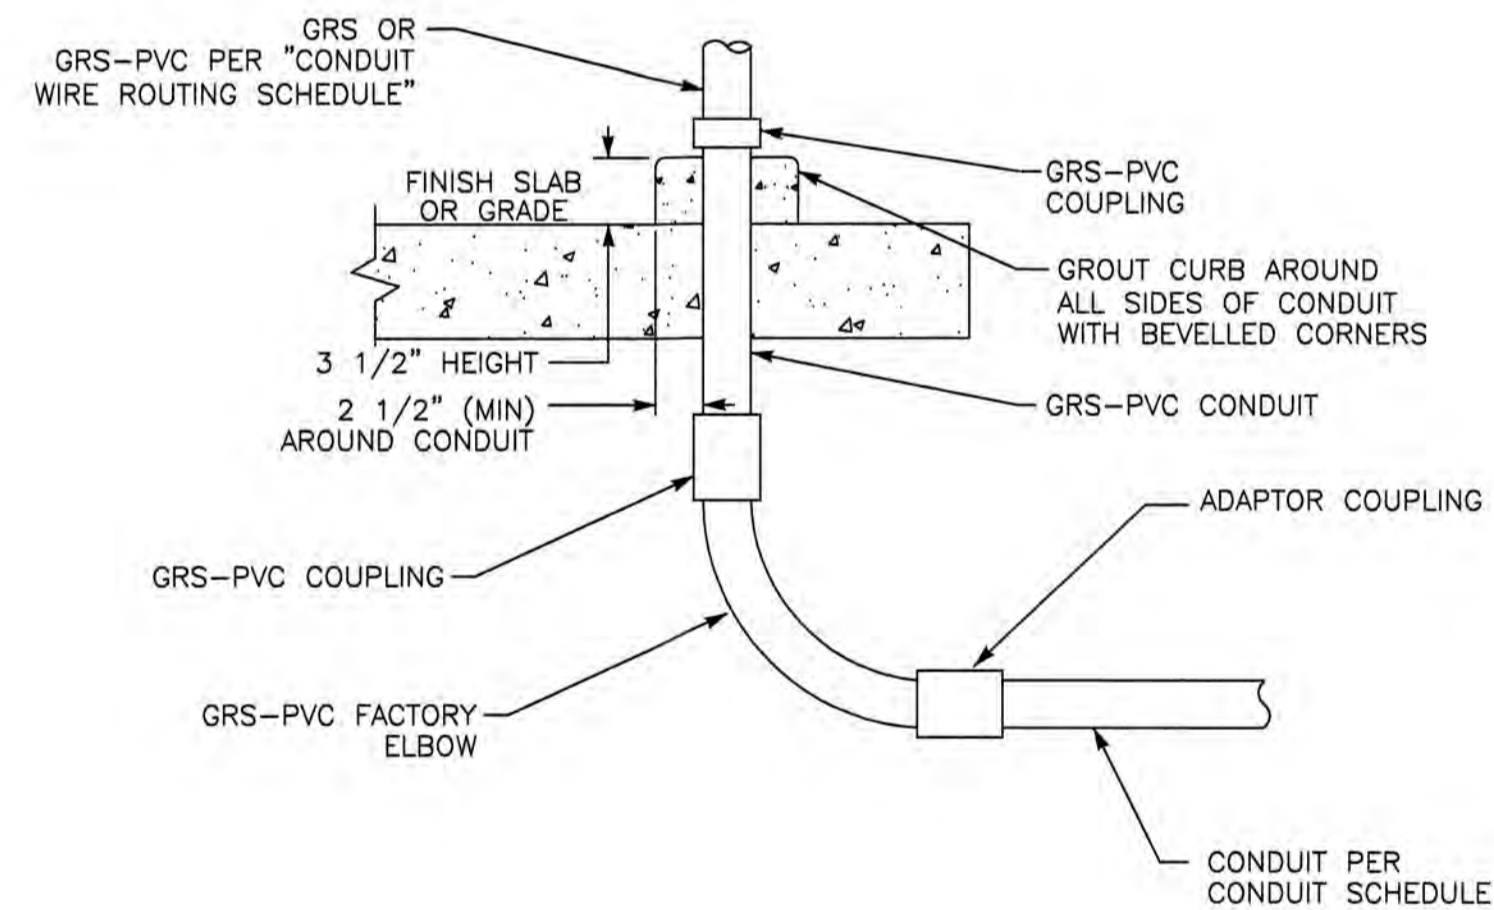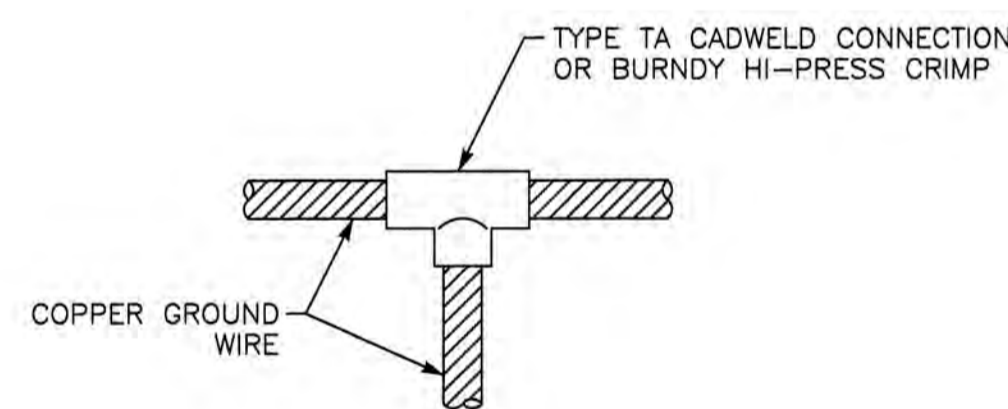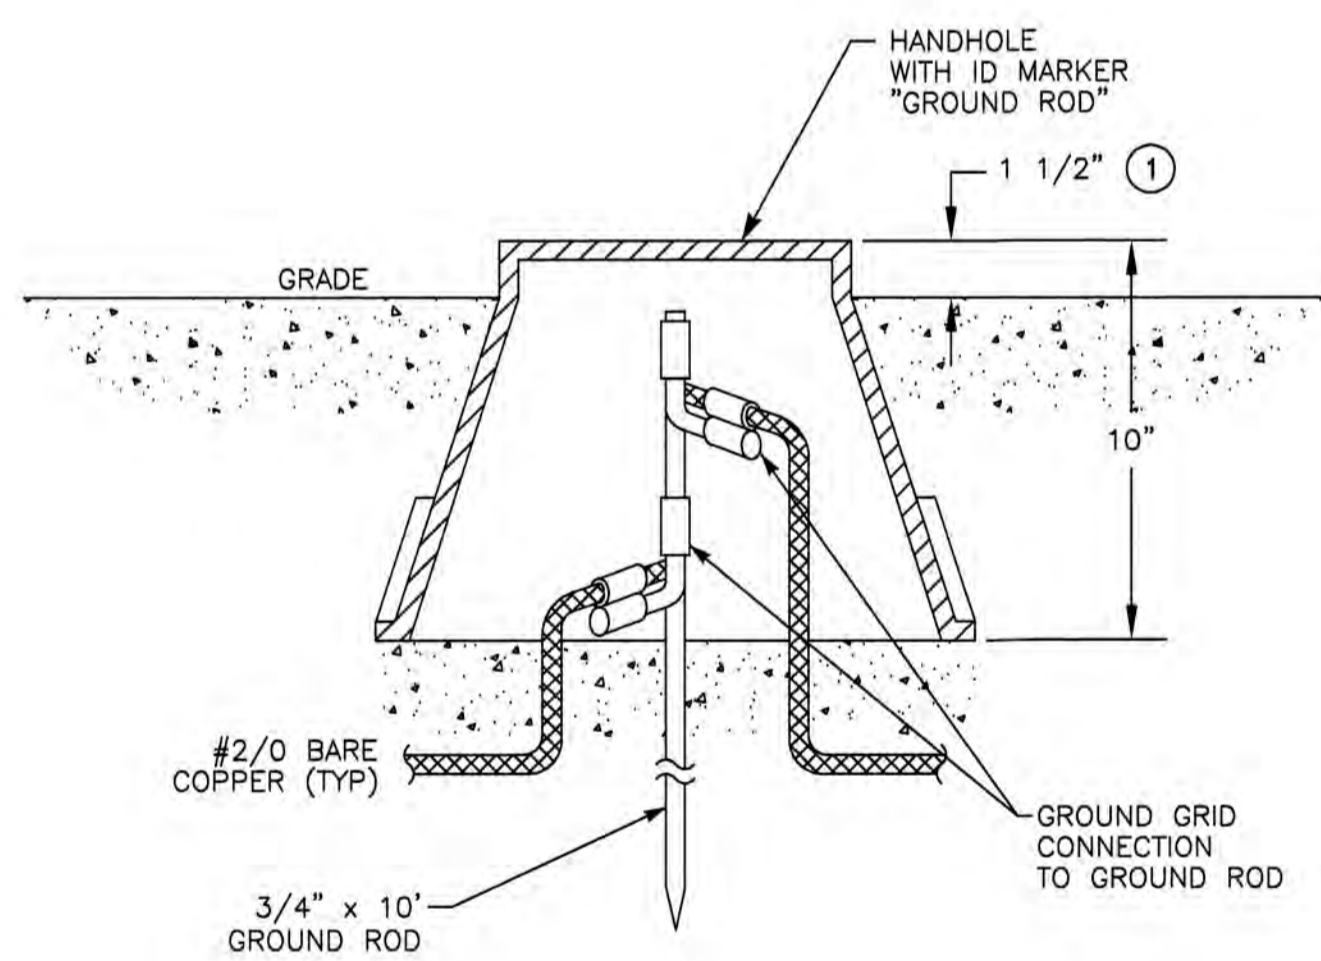

- NOTES: ① FULL TRAFFIC RATED CHRISTY B BOX OR EQUAL.
② ADD EXTENSIONS WHERE NECESSARY TO RAISE COVER TO FINISHED GRADE.



RECORD DRAWINGS		
14-Mile Slough Pump Station Upgrades		
TYPICAL ELECTRICAL DETAILS NO.3		
DEPARTMENT OF MUNICIPAL UTILITIES CITY OF STOCKTON, CALIFORNIA		
SCALE: NONE	APPROVED BY: DATE: _____	SHEET No. E23
DESIGNED BY: SMK		81 of 89 SHEETS
DRAWN BY: ZK		PROJECT No. 293-00-05-01
CHECKED BY: XML	ASSISTANT DIRECTOR, DEPT. OF MUNICIPAL UTILITIES	
RECORD Dwg.:		



REFER TO BID SET FOR SIGNATURE


REV. No.	DISCRPTION	DATE	BY	Apr'd By
1				
2				
3				
4				
5				
6				




1260 Lake Boulevard
Suite 240
Davis, California 95616
(530) 756-5905
FAX (530) 756-5991

SYMBOL	DESCRIPTION	SYMBOL	DESCRIPTION
P & I DIAGRAM SYMBOLS			
	FIELD MOUNTED INSTRUMENT		VALVE (GENERAL)
	FACE MOUNTED INSTRUMENT ON LOCAL PANEL, OPERATOR ACCESSIBLE		GATE (GENERAL)
	FACE MOUNTED INSTRUMENT ON FIELD PANEL, OPERATOR ACCESSIBLE		CHECK VALVE (GENERAL)
	INSTRUMENT MOUNTED IN LOCAL PANEL, OPERATOR INACCESSIBLE		PUMP (GENERAL)
	INSTRUMENT MOUNTED IN FIELD PANEL, OPERATOR INACCESSIBLE		
	OPERATION PERFORMED WITH LOGIC OR HARDWIRED DEVICES		VALVE/GATE NUMBER
	REFERENCE ELEMENTARY DWG. #		EQUIPMENT NUMBER
	PLC OR COMPUTER FUNCTION PERFORMING OPERATION WITH VISUAL INDICATION		ELECTRIC SIGNAL
	PLC OR COMPUTER FUNCTION PERFORMING OPERATION WITH VISUAL ALARM INDICATION		LOGIC OR DATA SIGNAL
	PLC OR COMPUTER PERFORMING INTERNAL OPERATION		PNEUMATIC SIGNAL
	PLC OR COMPUTER PERFORMING INTERNAL ALARM OPERATION		CAPILLARY TUBING (FILLED SYSTEM)
	PROPORTIONAL, INTEGRAL, AND DIFFERENTIAL PARAMETERS		HYDRAULIC SIGNAL
	RATIO AND BIAS PARAMETERS		SONIC OR ELECTROMAGNETIC SIGNAL
	AUDIBLE ALARM (BUZZER OR HORN)		ELECTRIC SUPPLY FROM PANELBOARD CKT
	ANNUNCIATOR WINDOW R - ROW # C - COLUMN #		SERVICE AIR
	LAMP INDICATION (STATUS OR ALARM)		INSTRUMENT AIR
	DISCRETE INPUT		
	DISCRETE OUTPUT		
	ANALOG INPUT		
	ANALOG OUTPUT		
	JUMP TAG FROM ONE AREA TO ANOTHER AREA OF DRAWING		
	"g" TAG CONNECT POINT ON EACH DRAWING		
	CONTINUED ON DWG P-X		
	AUTODIALER PRIORITY # PC BASED SOFTWARE		

INSTRUMENT IDENTIFICATION LETTERS				
FIRST - LETTER	SUCCEEDING - LETTER			
MEASURED OF INITIATING VARIABLE	MODIFIER	READOUT PASSIVE FUNCTION	OUTPUT FUNCTION	MODIFIER
A ANALYSIS		ALARM		
B BURNER, COMBUSTION		USER'S CHOICE	USER'S CHOICE	USER'S CHOICE
C CONDUCTIVITY			CONTROLLER	
D DENSITY	DIFFERENTIAL			
E VOLTAGE		SENSOR, PRIMARY ELEMENT		
F FLOW RATE	RATIO (FRACTION)			
G GENERAL		GLASS VIEWING DEVICE		
H HAND				HIGH, OPENED
I CURRENT (ELEC.)		INDICATING, INDICATOR		
J POWER	SCAN			
K TIME, TIME SCHEDULE	TIME RATE OF CHANGE		CONTROL STATION	
L LEVEL		LIGHT		LOW, CLOSED
M MOISTURE	MOMENTARY			MIDDLE
N STATUS		STATUS	USER'S CHOICE	USER'S CHOICE
O OPERATOR		ORIFICE, RESTRICTION		
P PRESSURE, VACUUM		POINT (TEST) CONNECTION		
Q QUANTITY	INTERGRATE, TOTALIZE			
R RESET		RECORD		
S SPEED, FREQUENCY	SAFETY		SWITCH	
T TEMPERATURE			TRANSMITTER	TEST
U MULTIVARIABLE		MULTIFUNCTION	MULTIFUNCTION	MULTIFUNCTION
V VIBRATION, MECH. ANALYSIS			VALVE, DAMPER LOUVER	
W WEIGHT, FORCE		WELL		
X SWITCH	X AXIS	UNCLASSIFIED	UNCLASSIFIED	UNCLASSIFIED
Y EVENT, STATE OR PRESENCE	Y AXIS		RELAY, COMPUTER, CONVERTOR	
Z POSITION	Z AXIS		DRIVER, ACTUATOR, UNCLASSIFIED FINAL CONTROL ELEMENT	

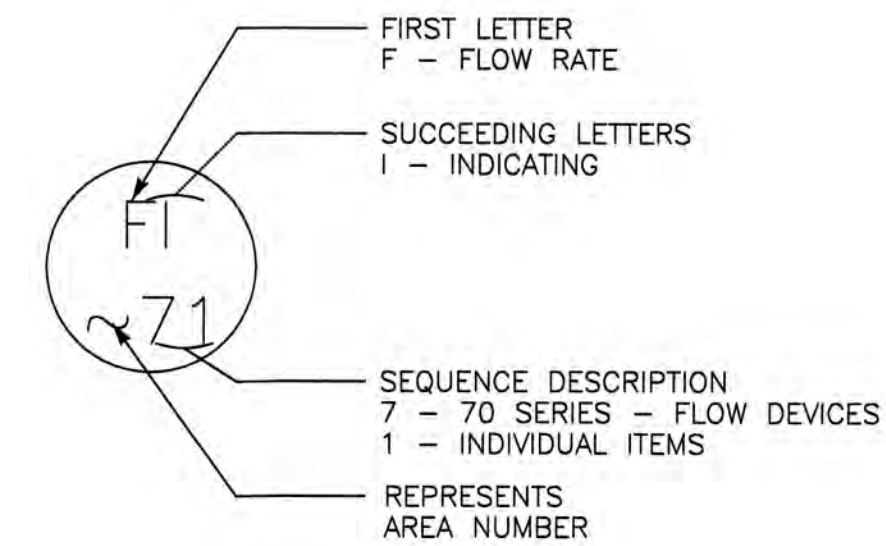

P&ID INSTRUMENT IDENTIFICATION EXAMPLE

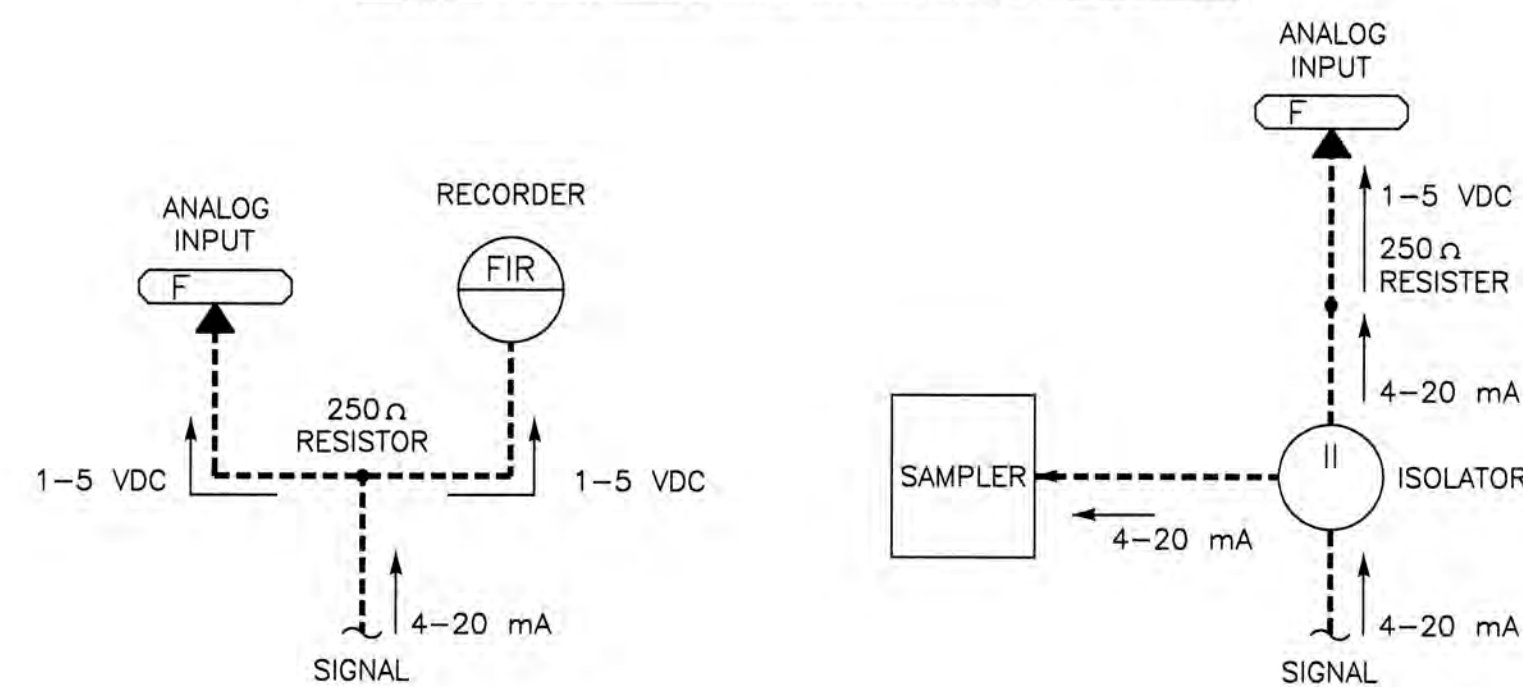

TYPICAL SIGNAL FLOWS

NUMBERING SEQUENCE	
SEQUENCE NUMBER	DESCRIPTION
00	COMMON ALARM
01-09	INDIVIDUAL ITEMS
10	MECHANICAL
20	MECHANICAL
30	MECHANICAL
40	MECHANICAL
50	LEVEL DEVICES
60	PRESSURE DEVICES
70	FLOW DEVICES
80	ANALYTICAL DEVICES
90	SAFETY & SECURITY DEVICES



REFER TO BID SET FOR SIGNATURE

REV. No.	DISCRPTION	DATE	BY	Aprv'd By
1				
2				
3				
4				
5				
6				
7				



1260 Lake Boulevard
Suite 240
Davis, California 95616
(530) 756-5905
FAX (530) 756-5991

RECORD DRAWINGS

14-Mile Slough Pump Station Upgrades

INSTRUMENTATION SYMBOLS & ABBREVIATIONS

DEPARTMENT OF MUNICIPAL UTILITIES
CITY OF STOCKTON, CALIFORNIA

SCALE: NONE	APPROVED BY: DATE:	SHEET No.
DESIGNED BY: SMK		11
DRAWN BY: ZK		82 of 89 SHEETS
CHECKED BY: XML		PROJECT No. 293-00-05-01
RECORD Dwg.:	ASSISTANT DIRECTOR, DEPT. OF MUNICIPAL UTILITIES	

CENTRAL/AUTODIALER

SCADA OPERATOR INTERFACE OI DISPLAY

PROGRAMMABLE LOGIC CONTROLLER PLC-100

CONTROL PANEL CP-100 (N)

FIELD CONTROL STATION FCS

FIELD

CENTRAL/AUTODIALER


SCADA OI

PLC-100

CP-100 (N)

FCS

FIELD

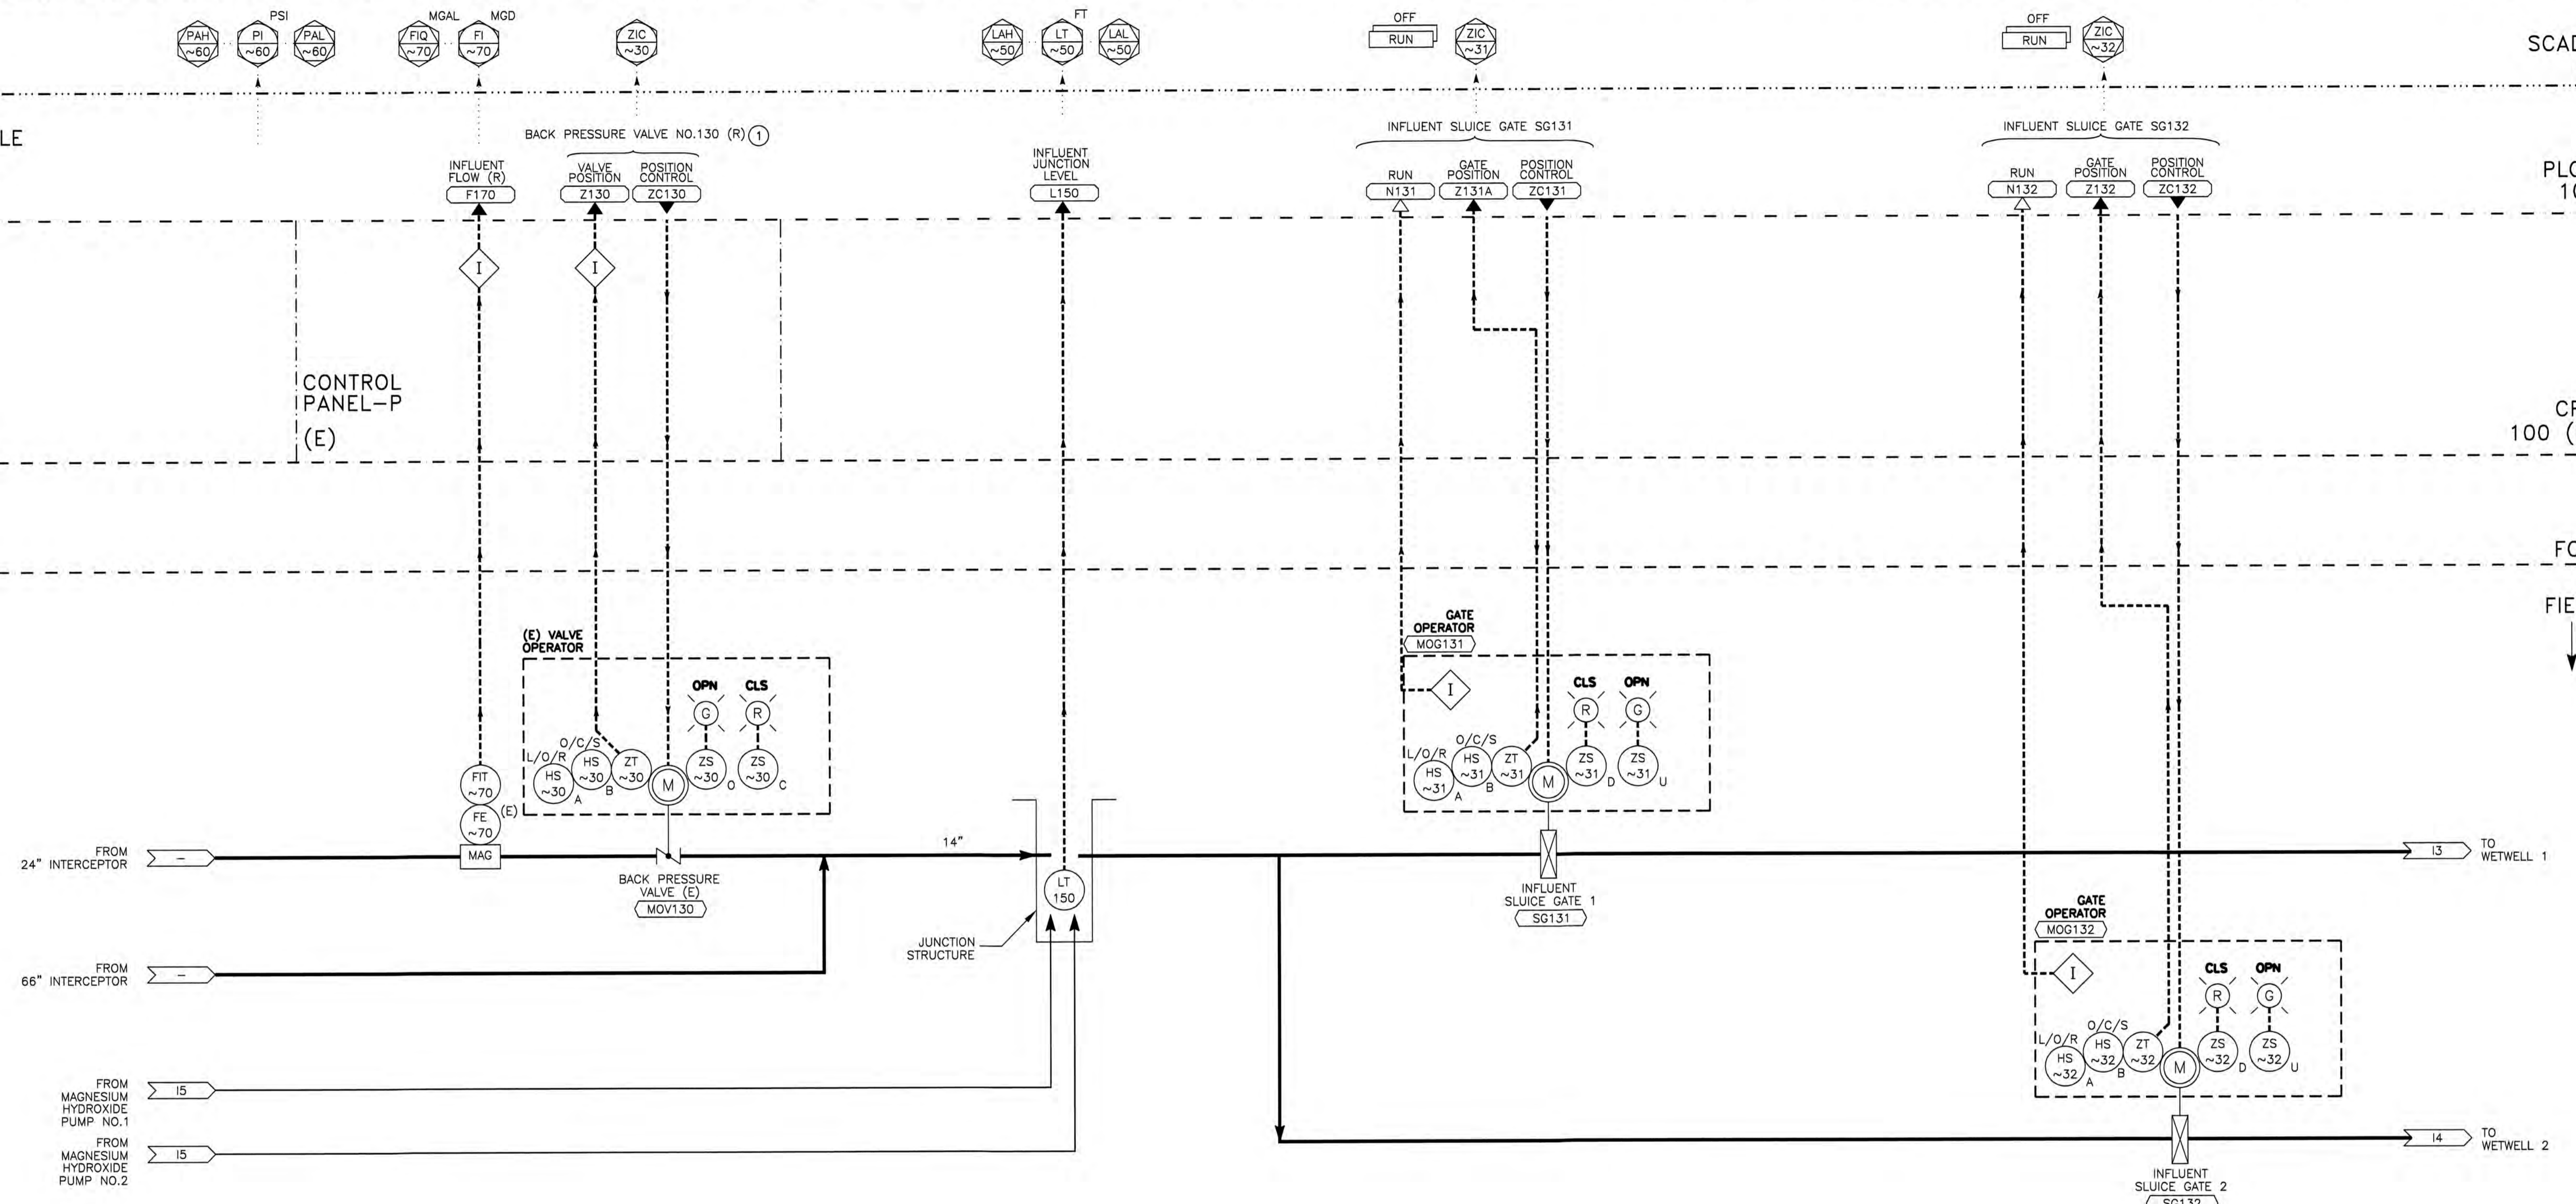

HEADWORKS

NOTES: ① ROUTE EXISTING I/O TO NEW PLC. PROVIDE AND INSTALL ISOLATORS AS REQUIRED.

AREA PREFIX 1~



RECORD DRAWINGS
14-Mile Slough Pump Station Upgrades
HEADWORKS P & ID

DEPARTMENT OF MUNICIPAL UTILITIES
CITY OF STOCKTON, CALIFORNIA


SCALE: NONE APPROVED BY: DATE: SHEET No. 12
DESIGNED BY: SMK 83 of 89 SHEETS
DRAWN BY: ZK PROJECT No. 293-00-05-01
CHECKED BY: XML ASSISTANT DIRECTOR, DEPT. OF MUNICIPAL UTILITIES
RECORD Dwg.:

Underground Service Alert
TWO DAYS BEFORE YOU DIG
Call TOLL FREE: 1-800-642-2444

REFER TO SET FOR SIGNATURE

REV. No.	DISCRPTION	DATE	BY	Apr'd By

WEST YOST ASSOCIATES
Consulting Engineers
1260 Lake Boulevard Suite 240
Davis, California 95616
(530) 756-5905
FAX (530) 756-5991

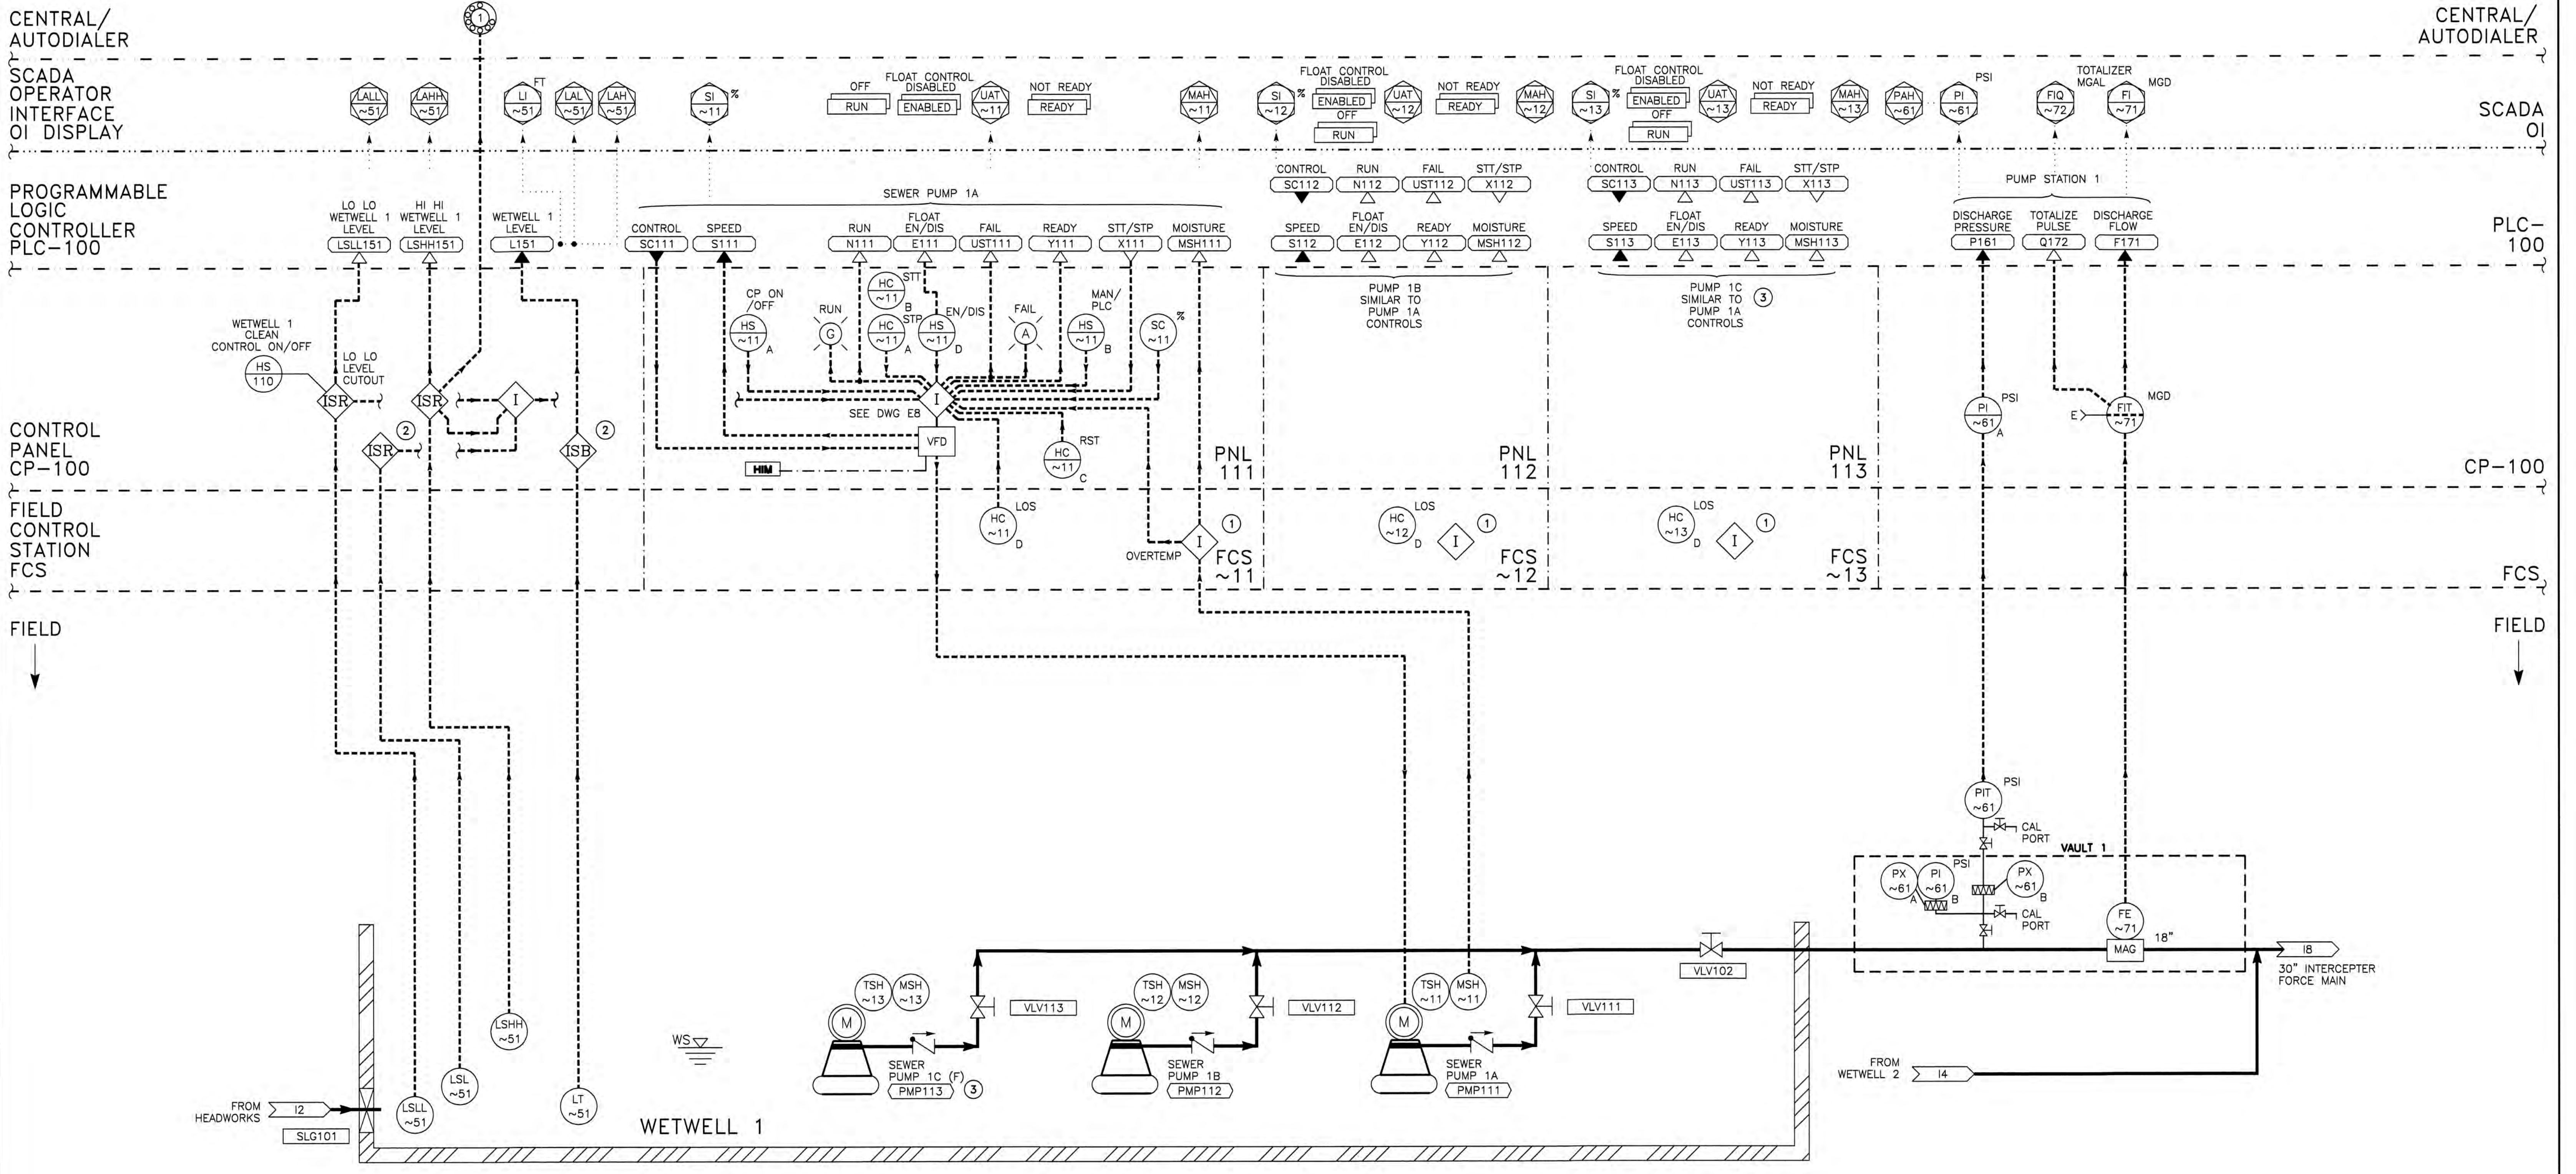

PUMP STATION 1

- NOTES:
- ① 120 VAC MOISTURE/OVERTEMP RELAY SUPPLIED BY PUMP SUPPLIER AND INSTALLED IN FCS MCC SYSTEM SUPPLIER.
 - ② ISB=> INTRINSIC SAFE BARRIER.
ISR=> INTRINSIC SAFE RELAY.
 - ③ PUMPS & ASSOCIATED CONTROLS SHOWN ARE FUTURE, PLC I/O SHALL BE PROVIDED & WIRED TO TERMINAL BLOCKS.

AREA
PREFIX
1~



REFER TO BID SET FOR SIGNATURE


REV. No.	DISCRIPTION	DATE	BY	Apr'd By
1				
2				
3				
4				
5				
6				

WEST YOST ASSOCIATES
Consulting Engineers
1260 Lake Boulevard
Suite 240
Davis, California 95616
(530) 756-5905
FAX (530) 756-5991

RECORD DRAWINGS
14-Mile Slough Pump Station Upgrades
PUMP STATION 1 P & ID

DEPARTMENT OF MUNICIPAL UTILITIES
CITY OF STOCKTON, CALIFORNIA

SCALE: NONE APPROVED BY: DATE: SHEET No. 13
DESIGNED BY: SMK
DRAWN BY: ZK 84 of 89 SHEETS
CHECKED BY: XML ASSISTANT DIRECTOR, DEPT. OF MUNICIPAL UTILITIES PROJECT No. 293-00-05-01
RECORD Dwg.:

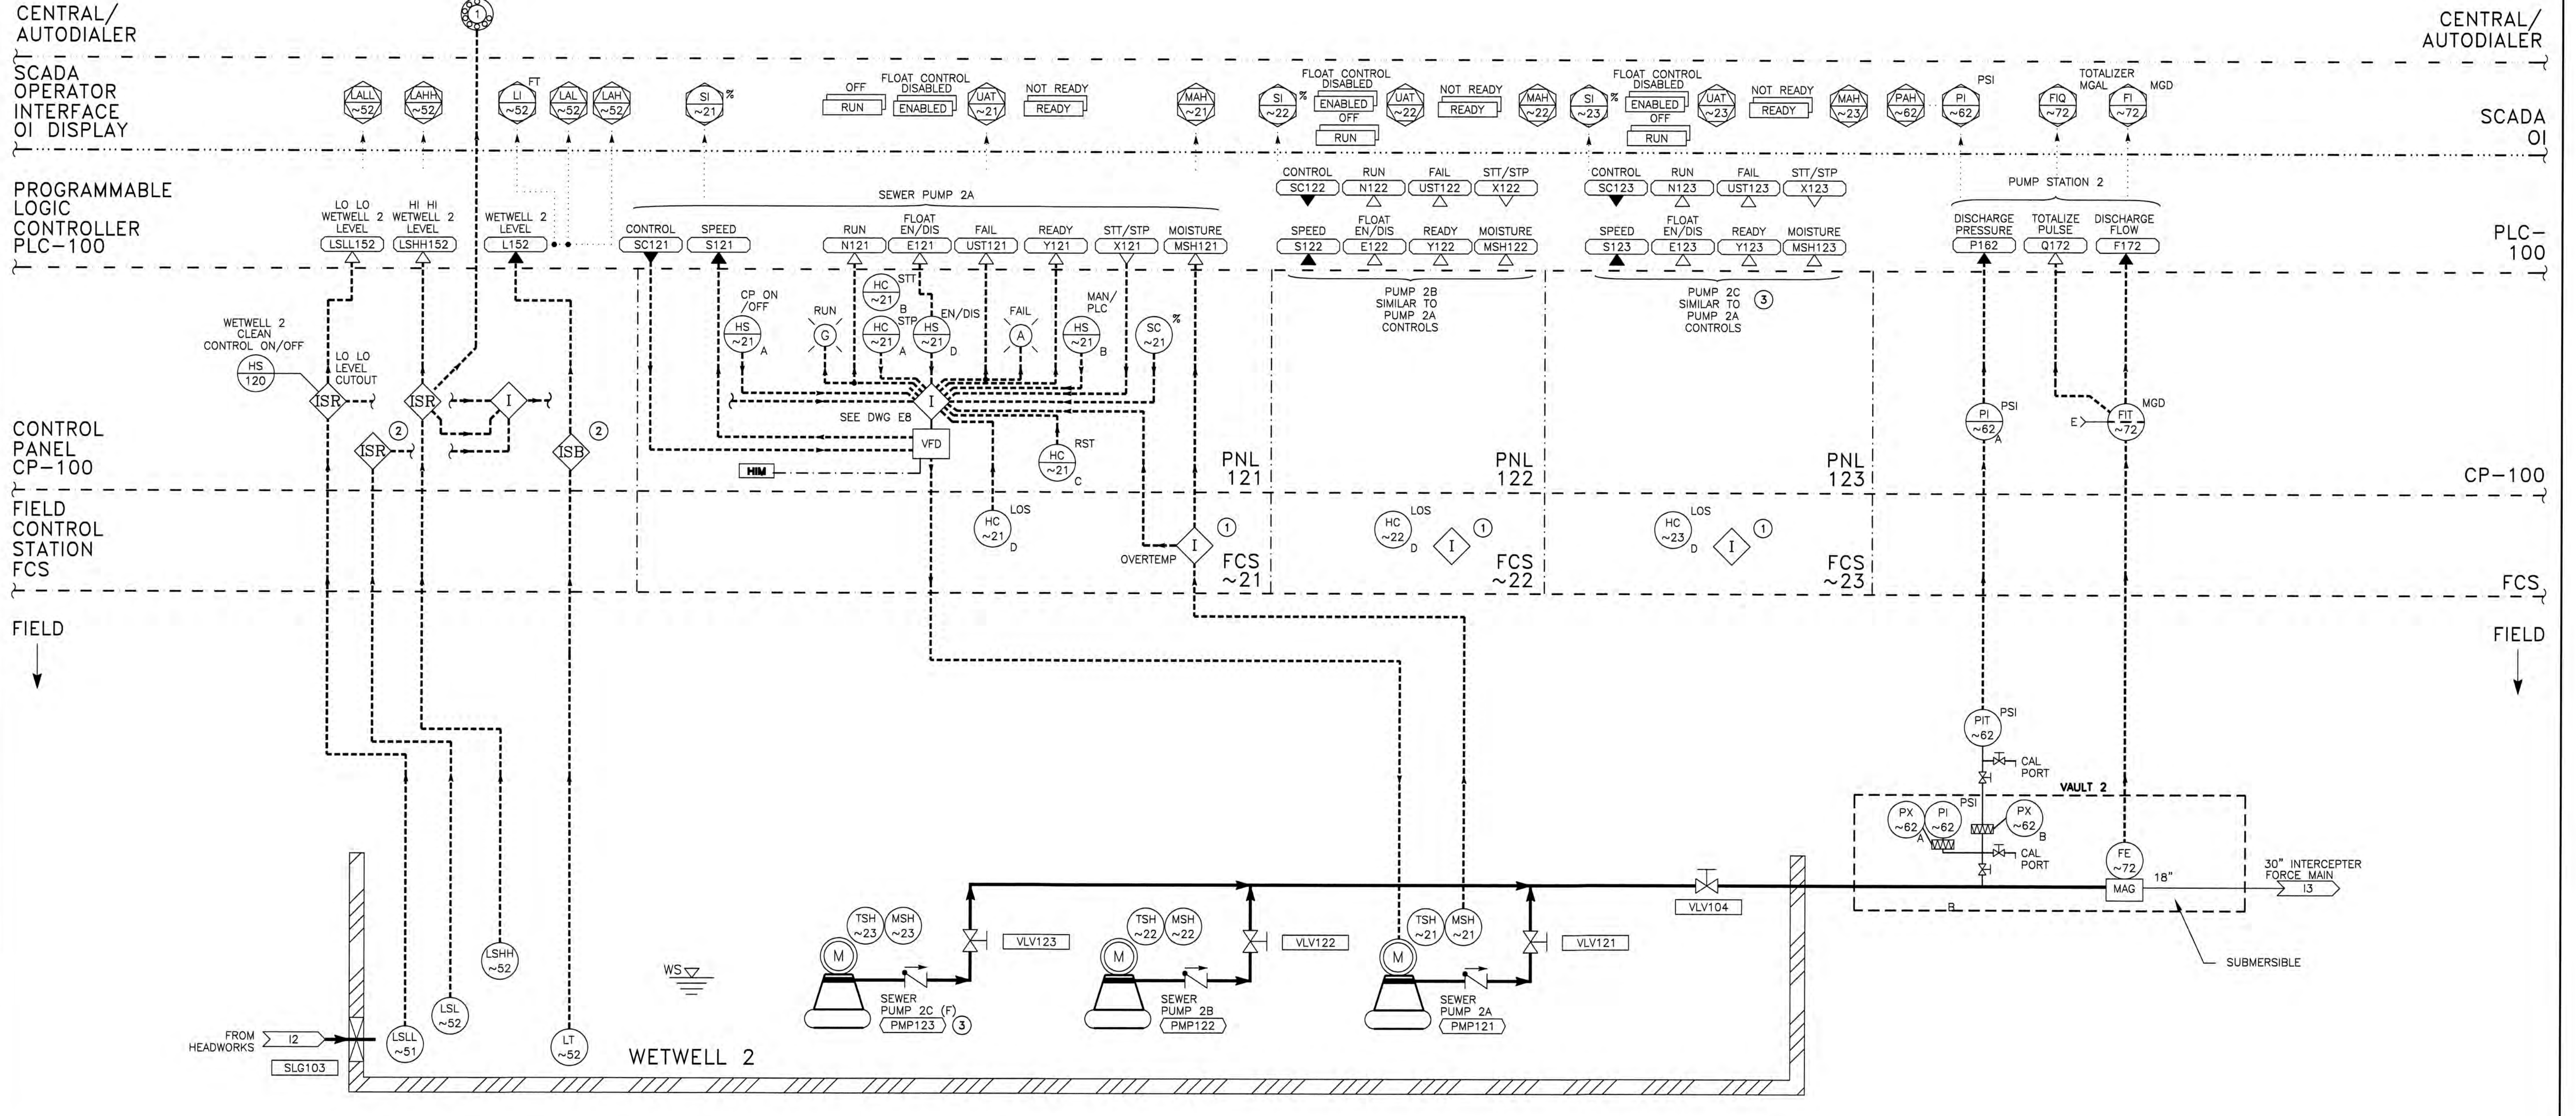

PUMP STATION 2

- NOTES:
- ① MOISTURE/OVERTEMP RELAY SUPPLIED BY PUMP SUPPLIER AND INSTALLED IN FCS MCC SYSTEM SUPPLIER.
 - ② ISB=> INTRINSIC SAFE BARRIER. ISR=> INTRINSIC SAFE RELAY.
 - ③ PUMPS & ASSOCIATED CONTROLS SHOWN ARE FUTURE, PLC I/O SHALL BE PROVIDED & WIRED TO TERMINAL BLOCKS.

AREA PREFIX
1~



REFER TO BID SET FOR SIGNATURE

REV. No.	DISCRPTION	DATE	BY	Apr'd By

WEST YOST ASSOCIATES
 Consulting Engineers
 1260 Lake Boulevard
 Suite 240
 Davis, California 95616
 (530) 756-5905
 FAX (530) 756-5991

RECORD DRAWINGS
14-Mile Slough Pump Station Upgrades
PUMP STATION 2
P & ID

DEPARTMENT OF MUNICIPAL UTILITIES
 CITY OF STOCKTON, CALIFORNIA

SCALE: NONE	APPROVED BY: DATE: _____	SHEET No.
DESIGNED BY: SMK	ASSISTANT DIRECTOR, DEPT. OF MUNICIPAL UTILITIES	14
DRAWN BY: ZK		85 of 89 SHEETS
CHECKED BY: XML		PROJECT No. 293-00-05-01
RECORD Dwg.:		

CENTRAL/
AUTODIALER

CENTRAL/
AUTODIALER

SCADA
OPERATOR
INTERFACE
OI DISPLAY

SCADA
OI

PROGRAMMABLE
LOGIC
CONTROLLER
PLC-100

PLC-100

MOTOR
CONTROL
CENTER
MCC-M


CP-100

FIELD
CONTROL
STATION
FCS

FCS

FIELD

FIELD

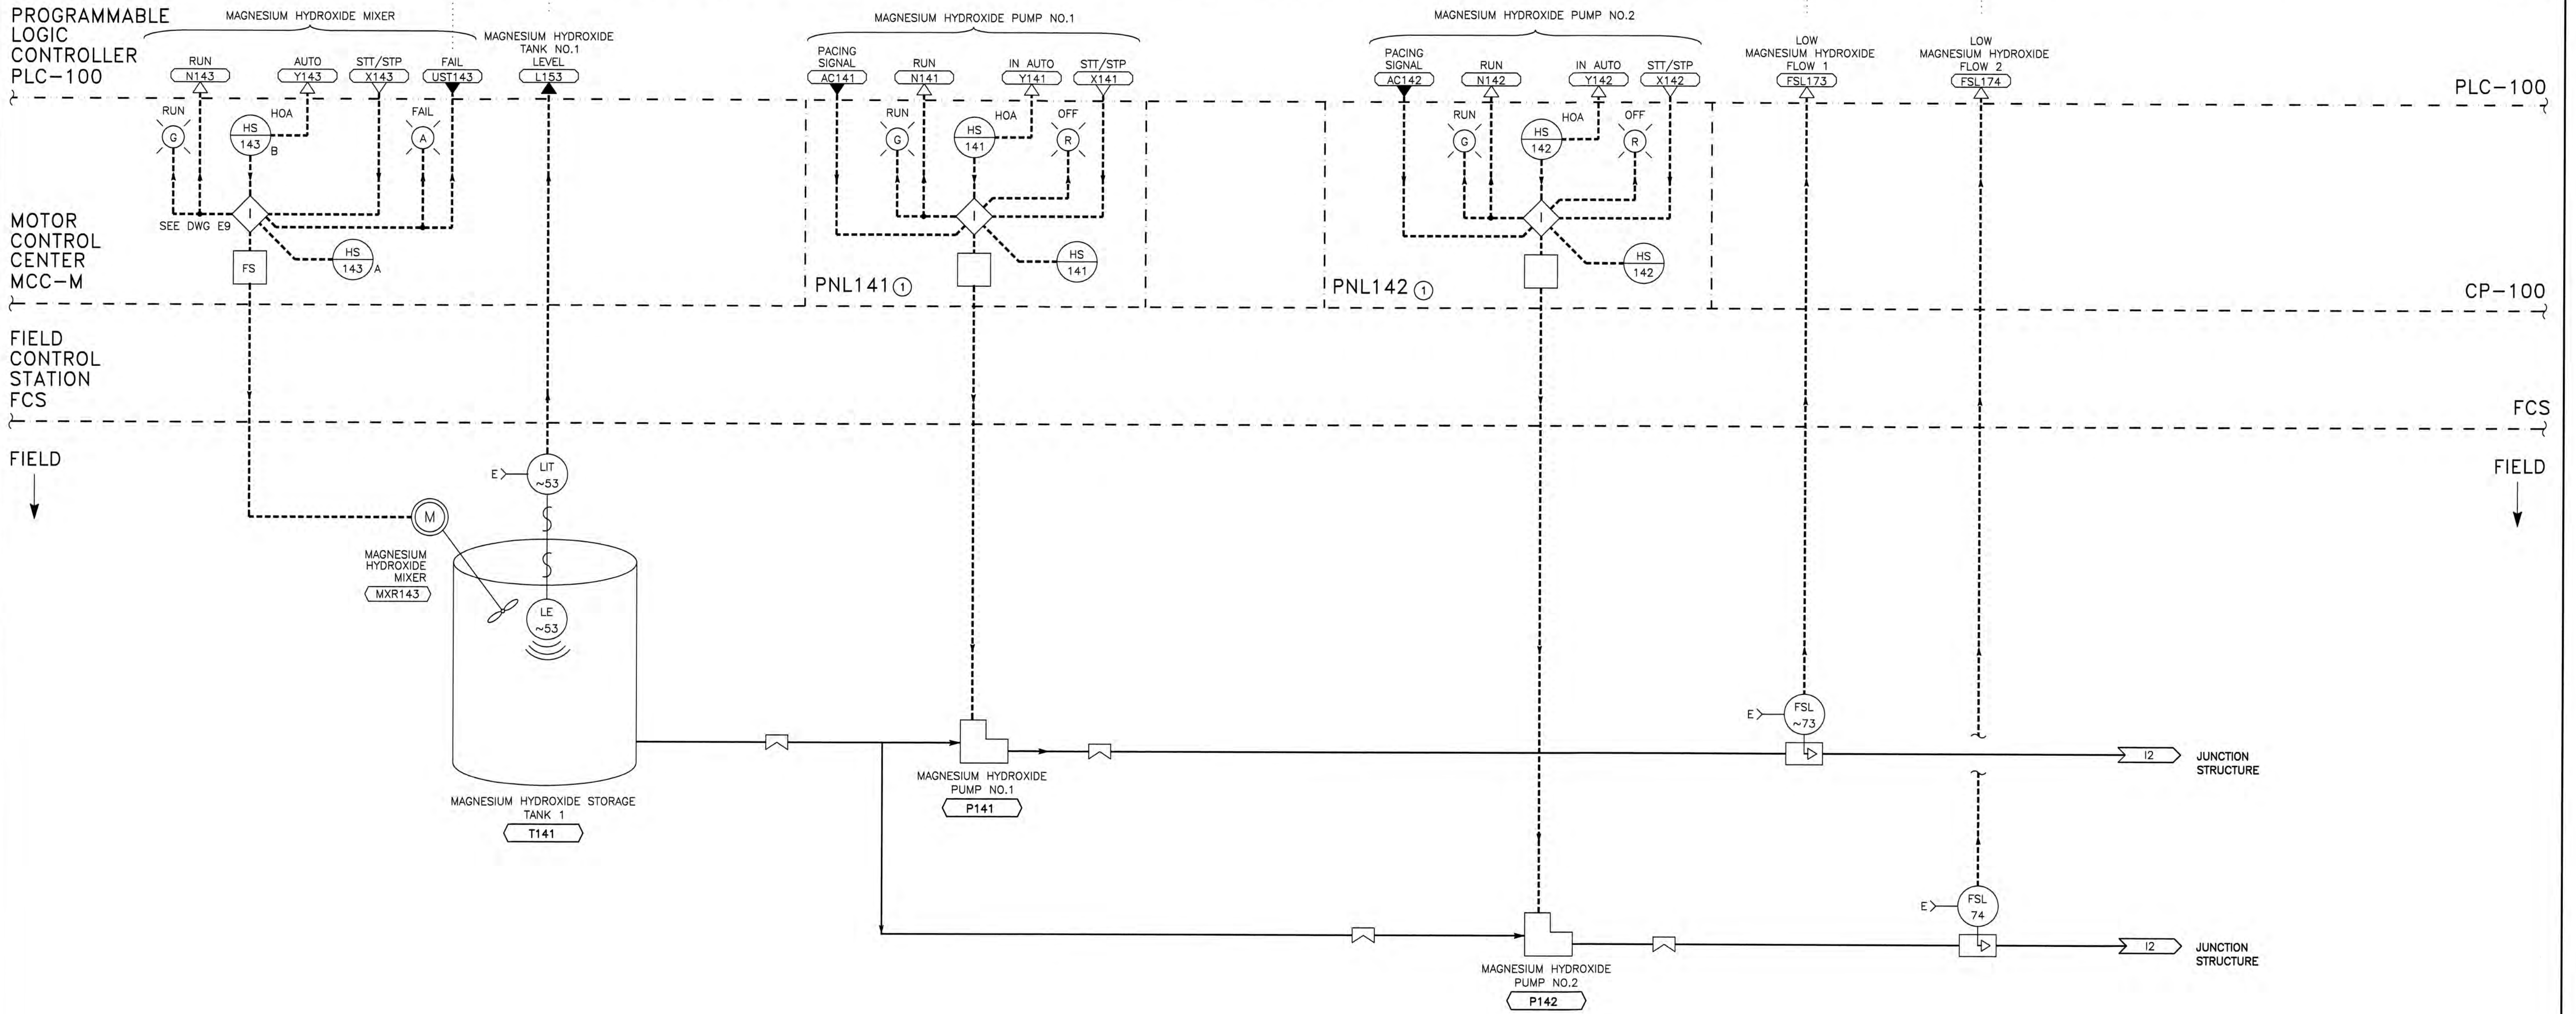

MAGNESIUM HYDROXIDE SYSTEM

NOTES: ① SEE MAGNESIUM HYDROXIDE SPEC FOR CONTROL PANEL OPERATOR CONTROLS.

AREA
PREFIX
1~



RECORD DRAWINGS
14-Mile Slough Pump Station Upgrades
 MAGNESIUM HYDROXIDE SYSTEM
 P & ID




REFER TO BID SET FOR SIGNATURE

REV. No.	DISCRIPTION	DATE	BY	App'd By

WEST YOST ASSOCIATES
 Consulting Engineers
 1260 Lake Boulevard Suite 240
 Davis, California 95616
 (530) 756-5905
 FAX (530) 756-5991

DEPARTMENT OF MUNICIPAL UTILITIES
 CITY OF STOCKTON, CALIFORNIA

SCALE: NONE	APPROVED BY: DATE: _____	SHEET No. 15
DESIGNED BY: SMK	ASSISTANT DIRECTOR, DEPT. OF MUNICIPAL UTILITIES	86 of 89 SHEETS
DRAWN BY: ZK		PROJECT No. 293-00-05-01
CHECKED BY: XML		
RECORD Dwg.:		

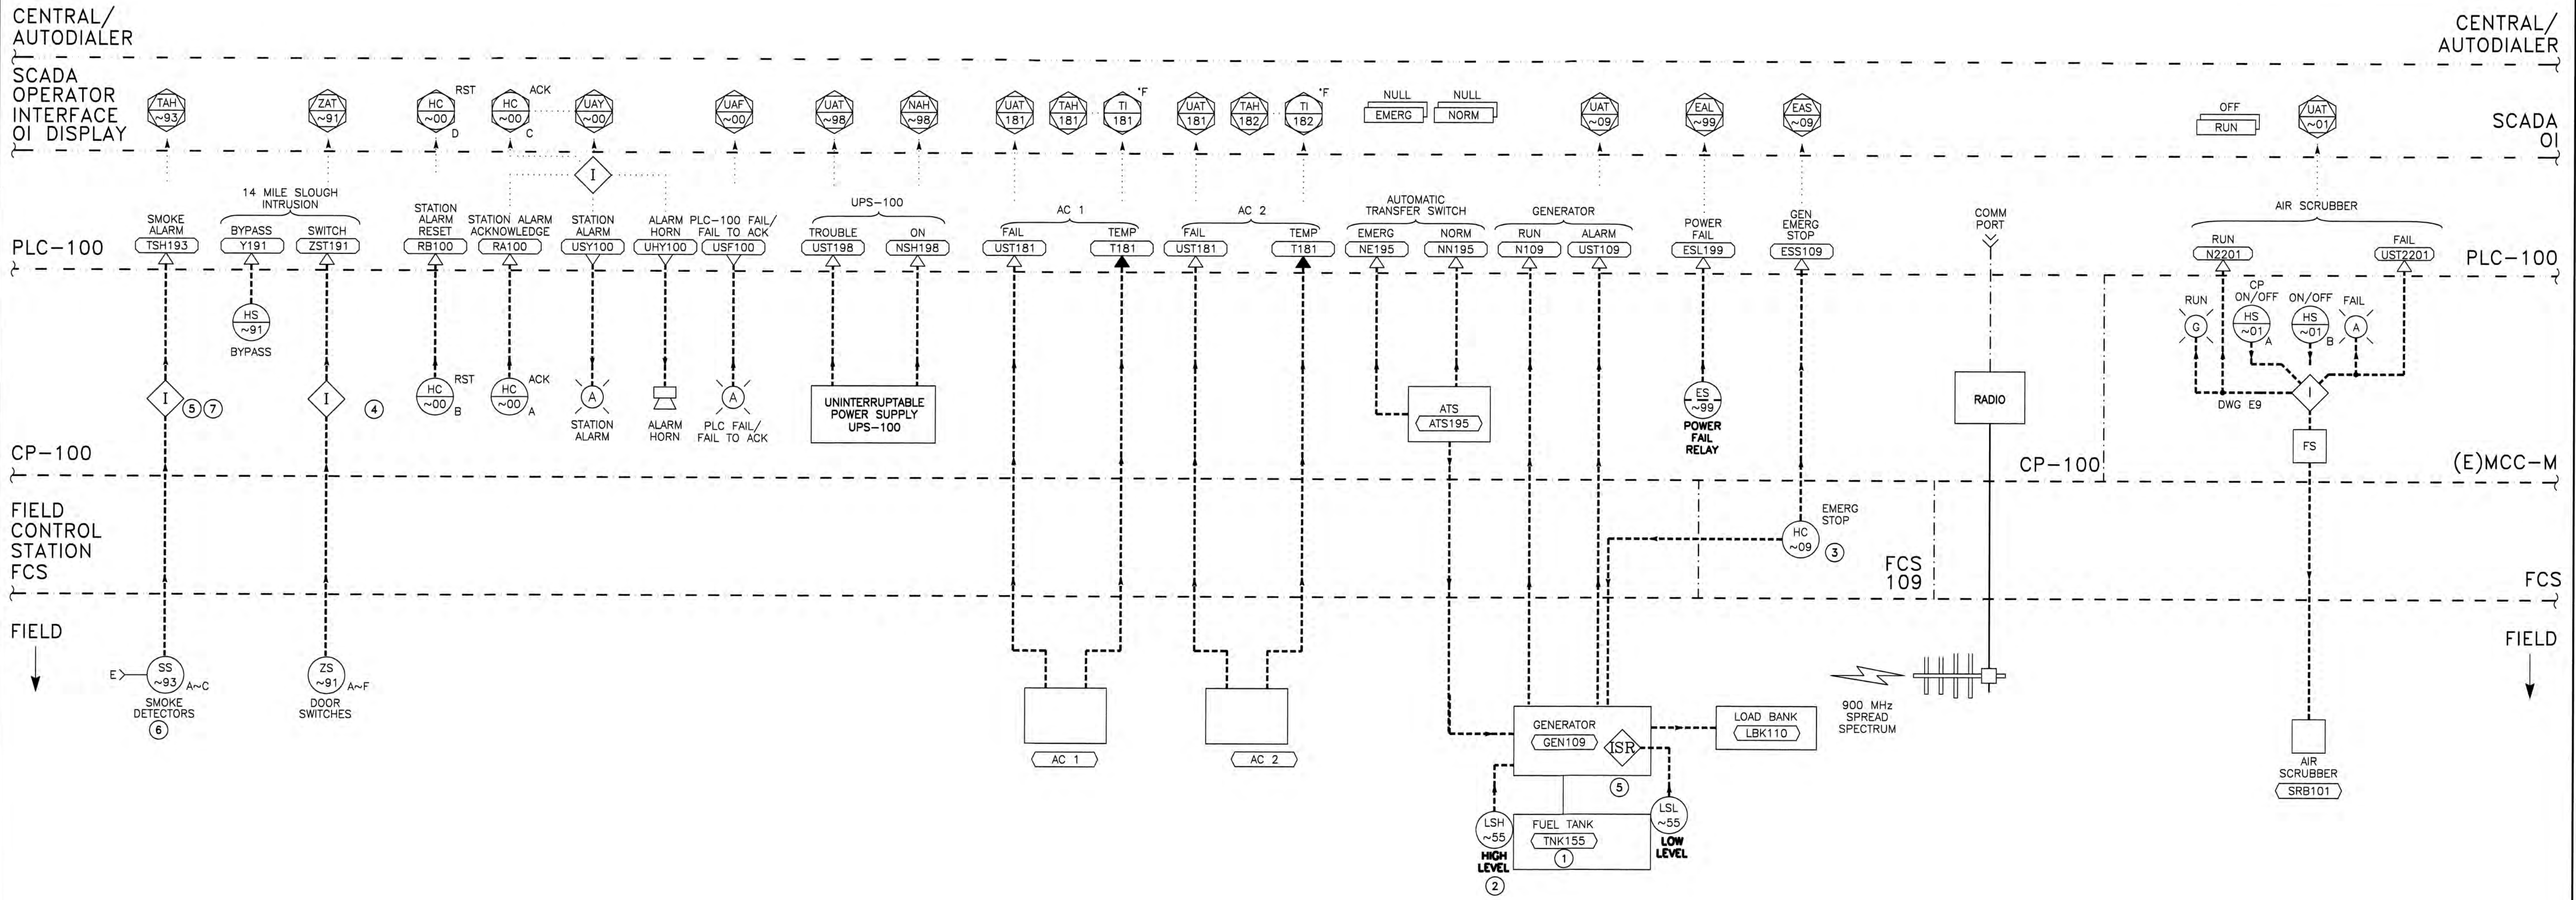

CP-100 AUXILIARY SYSTEMS

- NOTES:
- ① DOUBLE WALLED SUB-BASE FUEL TANK WITH HIGH & LOW LEVEL SWITCHES.
 - ② RED HIGH TANK ALARM LIGHT & AUDIBLE NOTIFICATION AT TANK SHALL OCCUR UPON FUEL LEVEL REACHING 90% CAPACITY.
 - ③ LOCATED OUTSIDE BY GENERATOR.
 - ④ WIRE SWITCHES IN SERIES ON TERMINAL BLOCKS.
 - ⑤ PLACE INTRINSIC SAFE RELAYS (ISR) INSIDE PANELS TO ISOLATE SIGNALS.
 - ⑥ POWERED FROM UPS-100.
 - ⑦ 24VDC INTERPOSING RELAYS.



AREA
PREFIX
1~

RECORD DRAWINGS		
14-Mile Slough Pump Station Upgrades		
CP-100 AUXILIARY SYSTEMS P & ID		
DEPARTMENT OF MUNICIPAL UTILITIES CITY OF STOCKTON, CALIFORNIA		
SCALE: NONE	APPROVED BY: DATE: _____	SHEET No. _____
DESIGNED BY: SMK		16
DRAWN BY: ZK		87 of 89 SHEETS
CHECKED BY: XML		PROJECT No. 293-00-05-01
RECORD Dwg.:	ASSISTANT DIRECTOR, DEPT. OF MUNICIPAL UTILITIES	



**REFER TO
BID SET
FOR
SIGNATURE**

REV. No.	DISCRPTION	DATE	BY	Apr'd By
1				
2				
3				
4				
5				
6				
7				

WEST YOST ASSOCIATES
Consulting Engineers
1260 Lake Boulevard
Suite 240
Davis, California 95616
(530) 756-5905
FAX (530) 756-5991

CENTRAL/
AUTODIALER

SCADA
OPERATOR
INTERFACE
OI DISPLAY

PROGRAMMABLE
LOGIC
CONTROLLER
PLC-100

CP-100

FIELD
CONTROL
STATION
FCS

FIELD

CENTRAL/
AUTODIALER


SCADA
OI

PLC-100

CP-100

FCS

FIELD

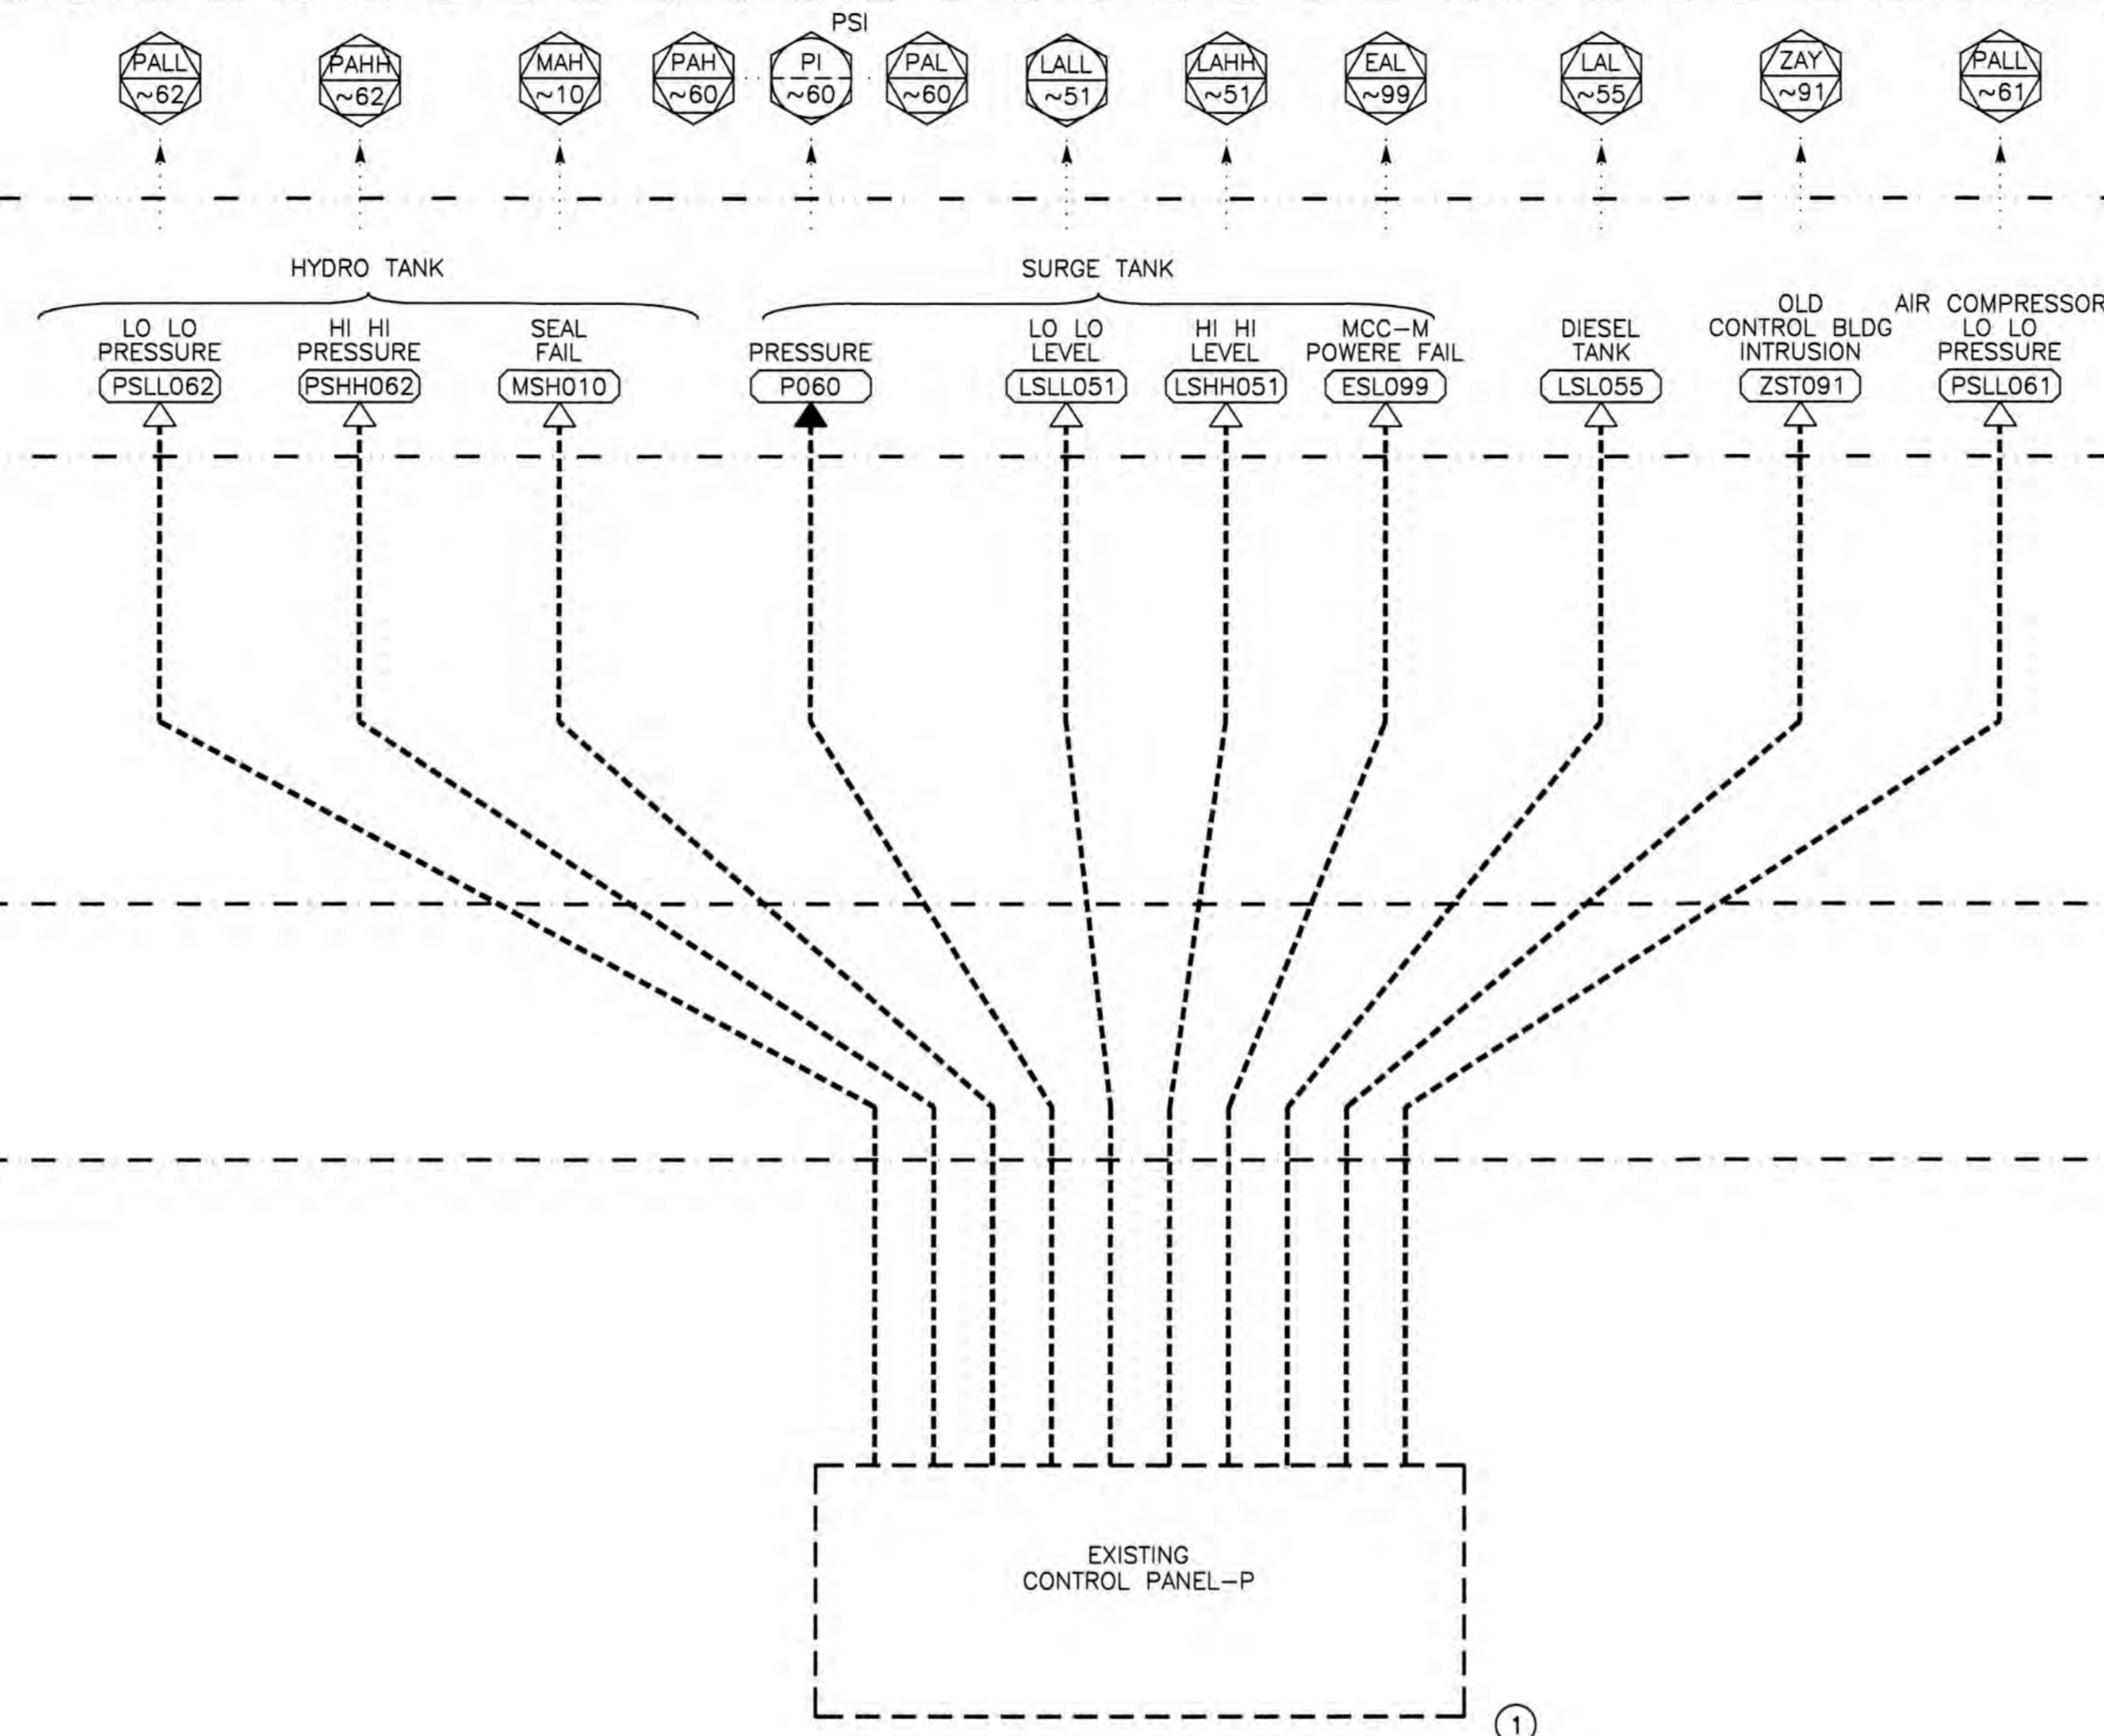

REMOTE MONITORING SYSTEM

NOTES: ① PROVIDE & INSTALL INTERPOSING RELAYS AND ISOLATORS TO EXTEND EXISTING POINTS TO NEW PLC.

AREA
PREFIX
0~



(916) 457-8144
FILE: 0507C 1007



**REFER TO
BID SET
FOR
SIGNATURE**

REV. No.	DISCRPTION	DATE	BY	Aprv'd By
1				
2				
3				
4				
5				
6				



1260 Lake Boulevard
Suite 240
Davis, California 95616
(530) 756-5905
FAX (530) 756-5991

RECORD DRAWINGS		
14-Mile Slough Pump Station Upgrades		
REMOTE MONITORING SYSTEM P & ID		
DEPARTMENT OF MUNICIPAL UTILITIES CITY OF STOCKTON, CALIFORNIA		
SCALE: NONE	APPROVED BY: DATE: _____	SHEET No.
DESIGNED BY: SMK		17
DRAWN BY: ZK		88 of 89 SHEETS
CHECKED BY: XML	ASSISTANT DIRECTOR, DEPT. OF MUNICIPAL UTILITIES	PROJECT No. 293-00-05-01
RECORD Dwg.:		

CENTRAL/
AUTODIALER
SCADA
OPERATOR
INTERFACE
OI DISPLAY

CENTRAL/
AUTODIALER
SCADA
OI

PROGRAMMABLE
LOGIC
CONTROLLER
PLC-100

PLC-
100

CONTROL
PANEL
CP-100 (N)


CP-
100 (N)

FIELD
CONTROL
STATION
FCS

FCS

FIELD

FIELD

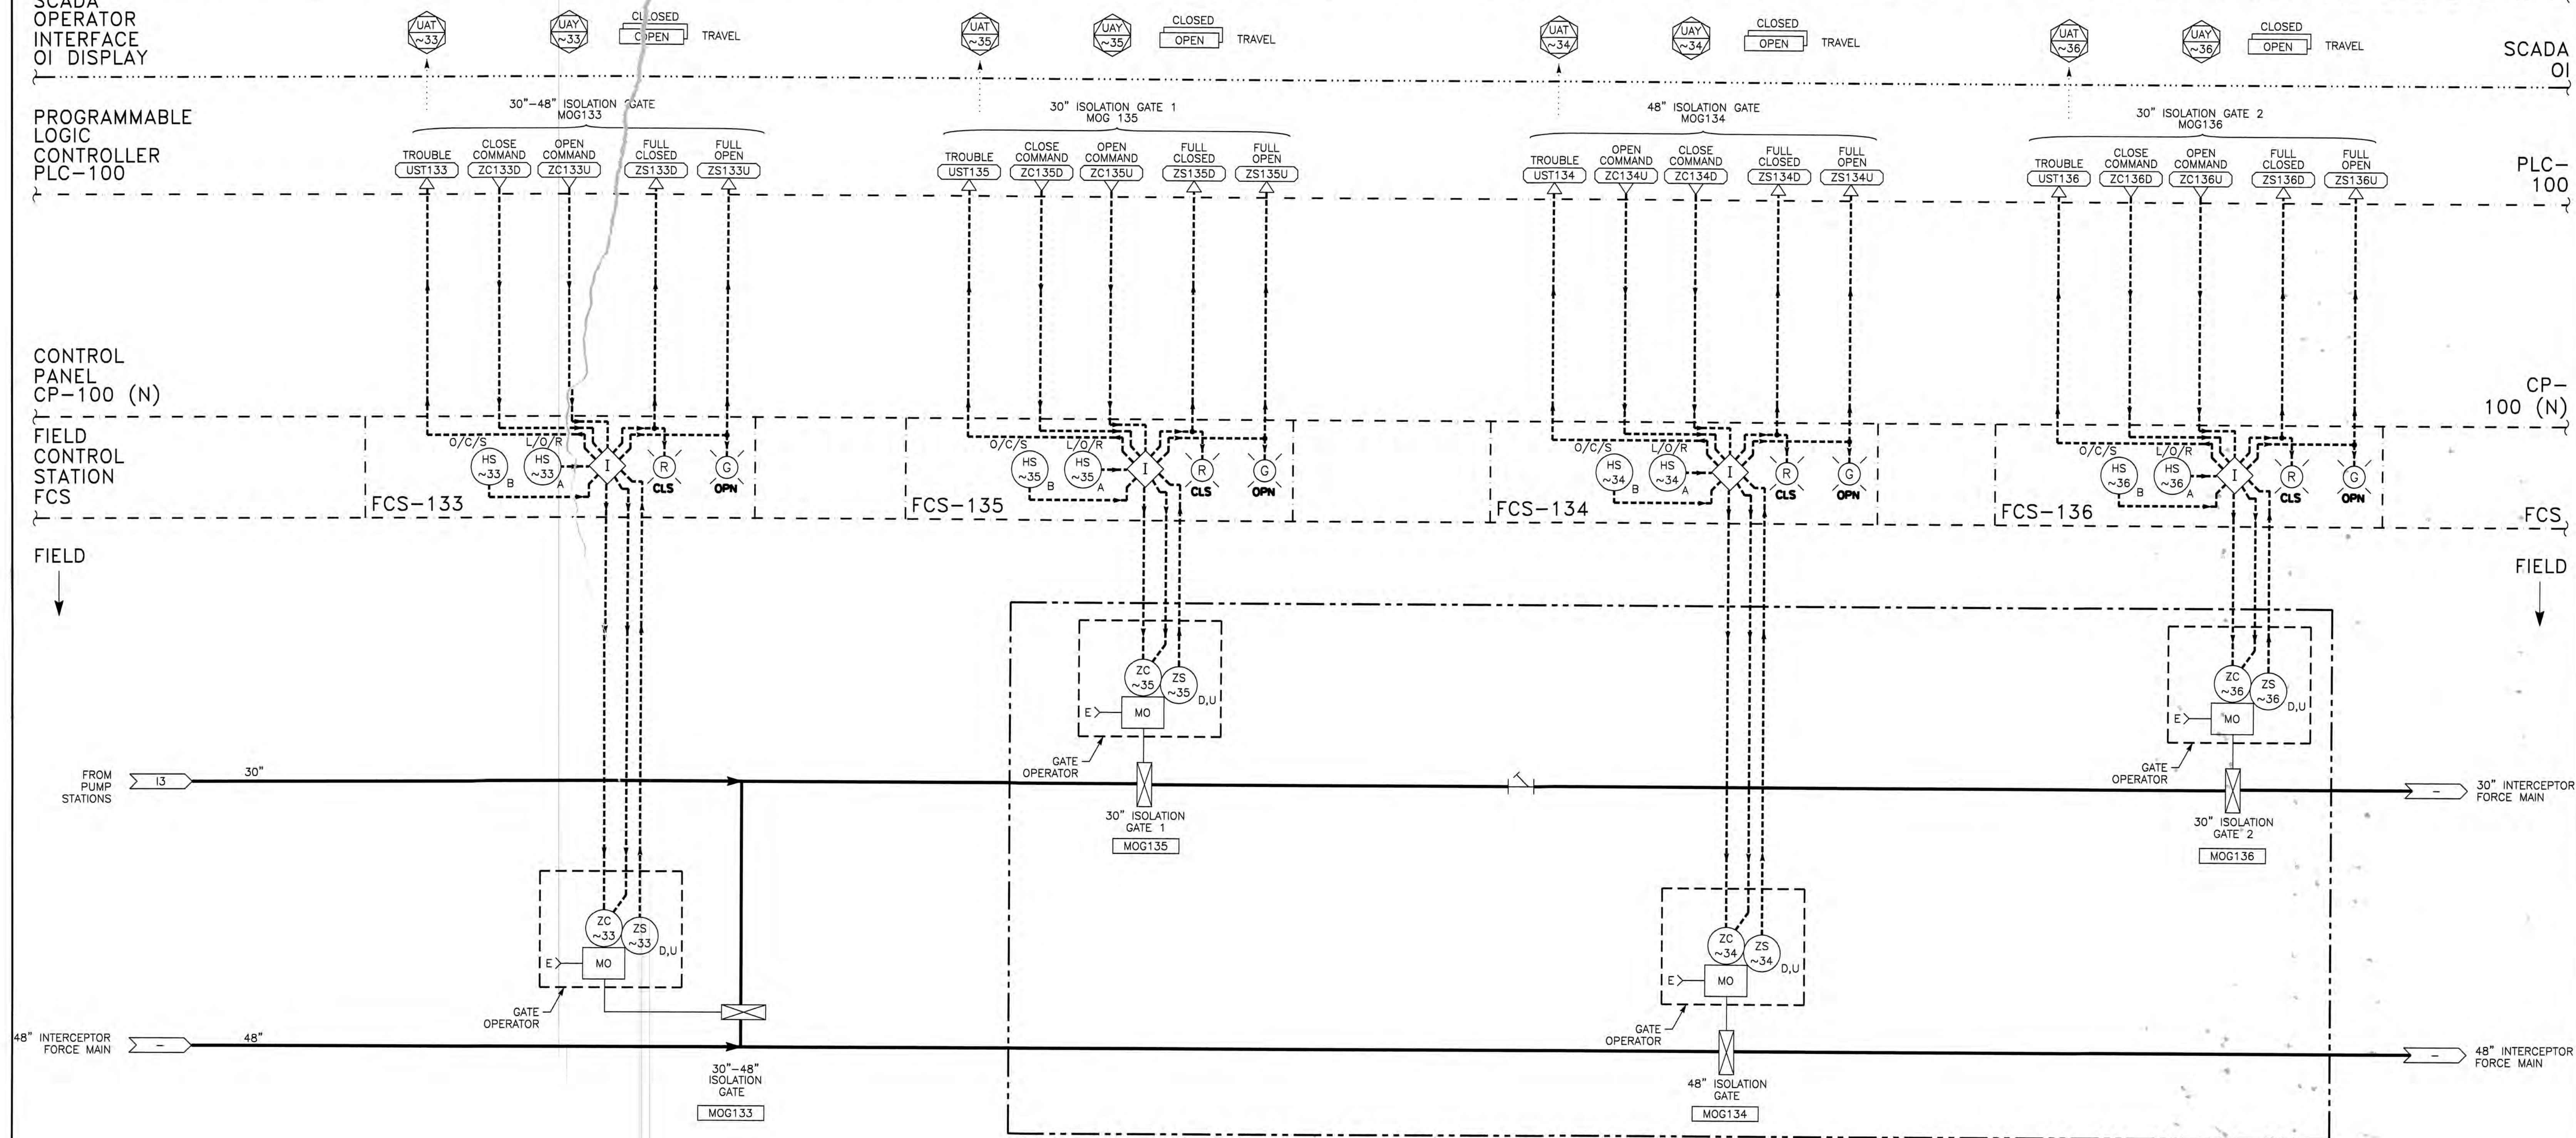

DISCHARGE GATE CONTROL

AREA
PREFIX
1~



Underground Service Alert
TWO DAYS
BEFORE
YOU DIG
Call TOLL FREE: 1-800-642-2444

**REFER TO
BID SET
FOR
SIGNATURE**

REV. No.	DISCRPTION	DATE	BY	Apr'd By
1				
2				
3				
4				
5				
6				

WEST YOST ASSOCIATES
Consulting Engineers
1260 Lake Boulevard
Suite 240
Davis, California 95616
(530) 756-5905
FAX (530) 756-5991

RECORD DRAWINGS
14-Mile Slough Pump Station Upgrades
DISCHARGE GATE CONTROL
P & ID

DEPARTMENT OF MUNICIPAL UTILITIES
CITY OF STOCKTON, CALIFORNIA

SCALE: NONE	APPROVED BY: DATE:	SHEET No. 18
DESIGNED BY: SMK		89 of 89 SHEETS
DRAWN BY: ZK		PROJECT No. 293-00-05-01
CHECKED BY: XML	ASSISTANT DIRECTOR, DEPT. OF MUNICIPAL UTILITIES	
RECORD Dwg.:		