Stribley Community Center

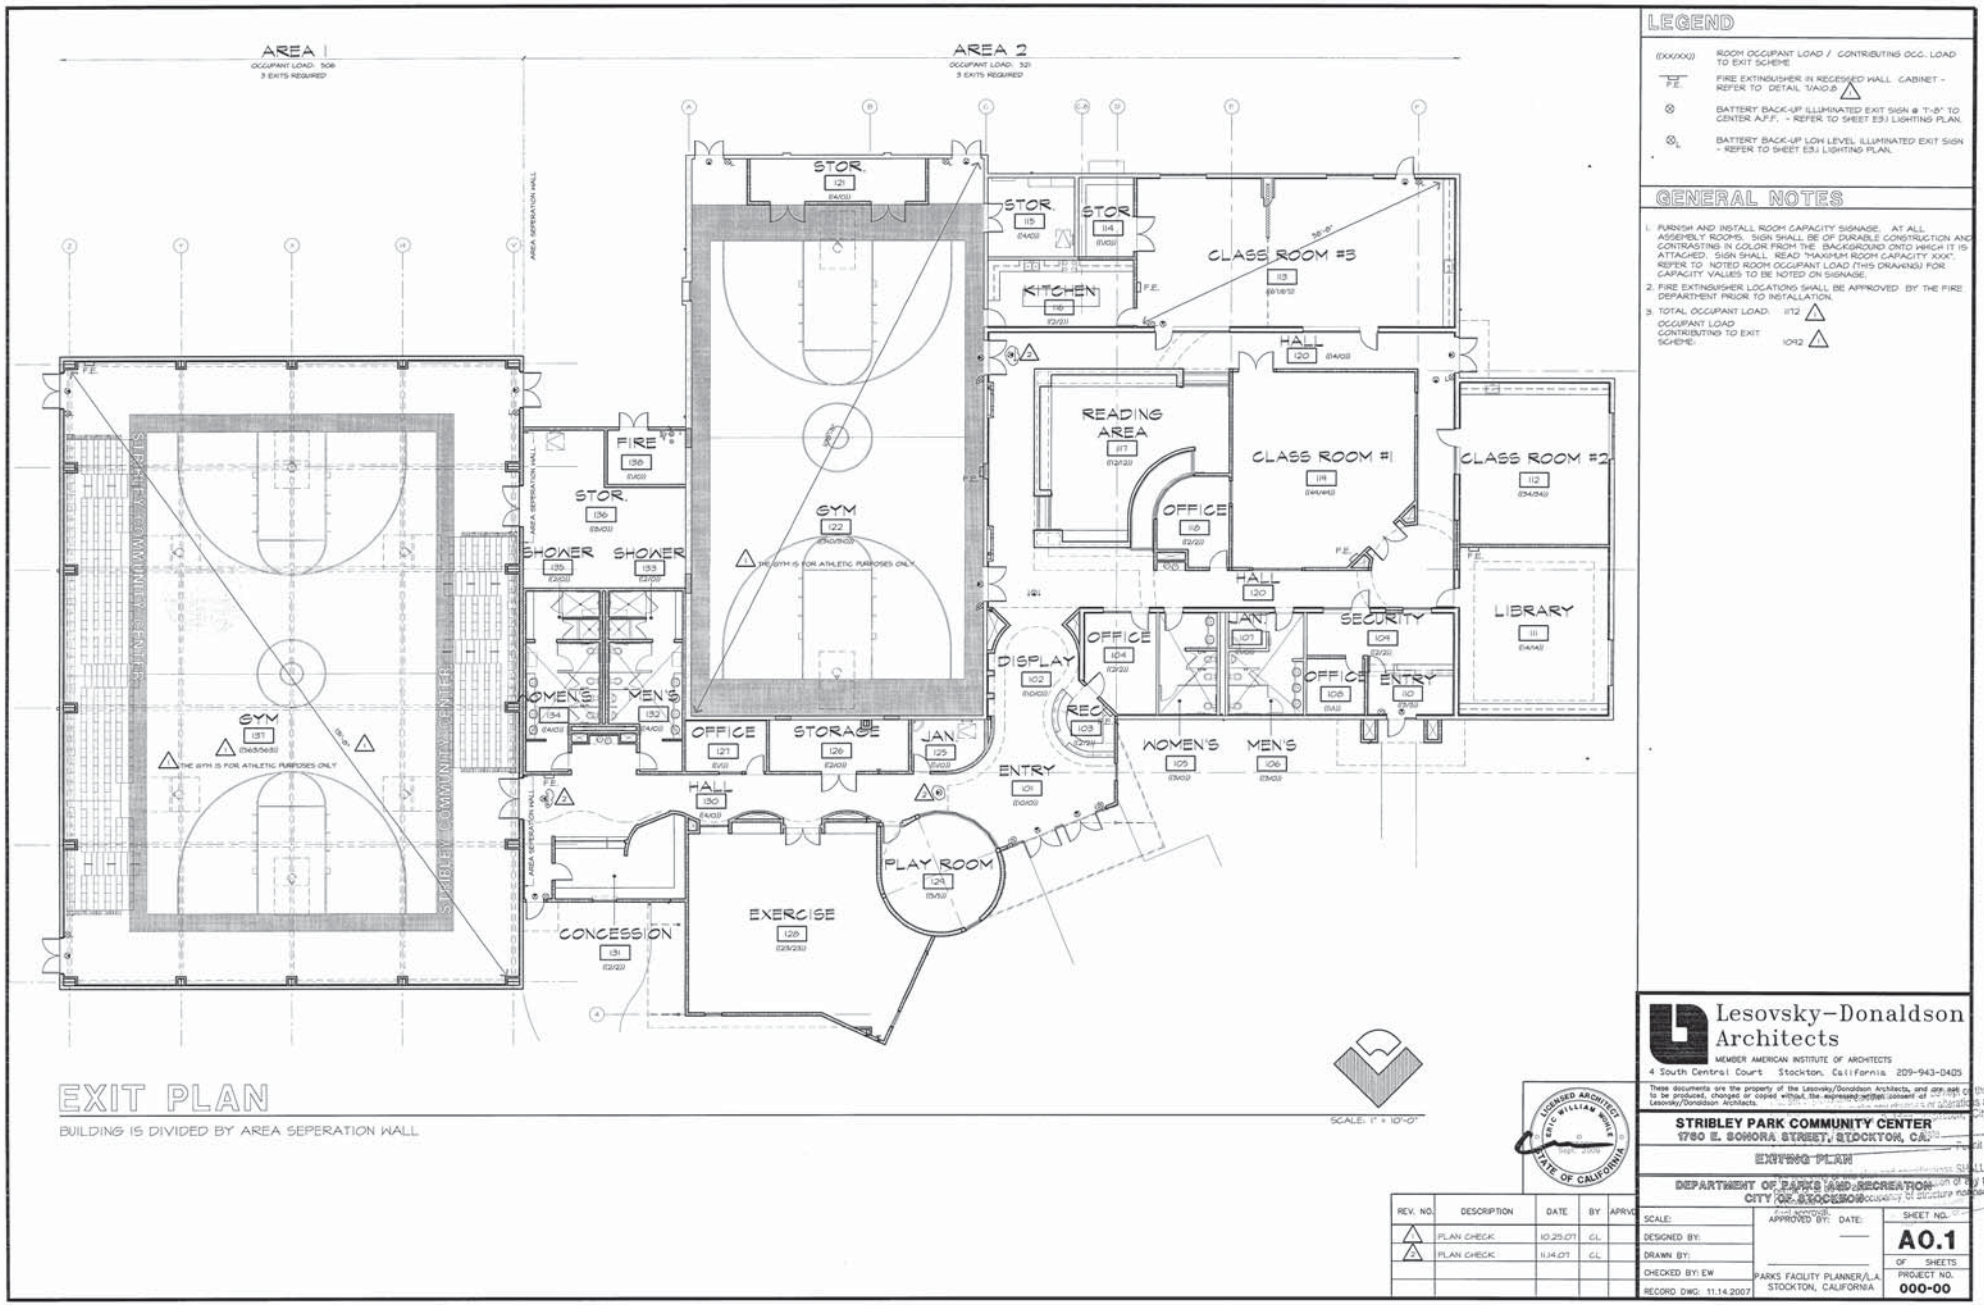

LEGEND

((XX/XXX))	ROOM OCCUPANT LOAD / CONTRIBUTING OCC. LOAD TO EXIT SCHEME
F.E.	FIRE EXTINGUISHER IN RECESSED WALL CABINET - REFER TO DETAIL 1/A10.0
⊗	BATTERY BACK-UP ILLUMINATED EXIT SIGN @ 7'-0" TO CENTER A.F.F. - REFER TO SHEET E3.1 LIGHTING PLAN.
⊗L	BATTERY BACK-UP LOW LEVEL ILLUMINATED EXIT SIGN - REFER TO SHEET E3.1 LIGHTING PLAN.

GENERAL NOTES

1. FURNISH AND INSTALL ROOM CAPACITY SIGNAGE. AT ALL ASSEMBLY ROOMS. SIGN SHALL BE OF DURABLE CONSTRUCTION AND CONTRASTING IN COLOR FROM THE BACKGROUND ONTO WHICH IT IS ATTACHED. SIGN SHALL READ "MAXIMUM ROOM CAPACITY XXX". REFER TO NOTED ROOM OCCUPANT LOAD (THIS DRAWING) FOR CAPACITY VALUES TO BE NOTED ON SIGNAGE.
2. FIRE EXTINGUISHER LOCATIONS SHALL BE APPROVED BY THE FIRE DEPARTMENT PRIOR TO INSTALLATION.
3. TOTAL OCCUPANT LOAD: 1112
   OCCUPANT LOAD CONTRIBUTING TO EXIT SCHEME: 1092

EXIT PLAN

BUILDING IS DIVIDED BY AREA SEPERATION WALL

SCALE: 1" = 10'-0"

Lesovsky–Donaldson Architects
MEMBER AMERICAN INSTITUTE OF ARCHITECTS
4 South Central Court Stockton, California 209-943-0405

These documents are the property of the Lesovsky/Donaldson Architects, and are not to be produced, changed or copied without the expressed written consent of Lesovsky/Donaldson Architects.

LICENSED ARCHITECT ERIC WILLIAM WHITE STATE OF CALIFORNIA

STRIBLEY PARK COMMUNITY CENTER
1780 E. SONORA STREET, STOCKTON, CA.

EXITING PLAN

DEPARTMENT OF PARKS AND RECREATION
CITY OF STOCKTON

REV. NO.	DESCRIPTION	DATE	BY	APRVD
1	PLAN CHECK	10.25.07	CL	
2	PLAN CHECK	11.14.07	CL	

SCALE:	APPROVED BY: DATE:	SHEET NO. A0.1
DESIGNED BY:		OF SHEETS
DRAWN BY:		
CHECKED BY: EW	PARKS FACILITY PLANNER/L.A. STOCKTON, CALIFORNIA	PROJECT NO. 000-00
RECORD DWG. 11.14.2007		